

April 6, 2023

ADDENDUM NUMBER TWO (2)

Project: SCSD Raleigh Football Renovation
Smith County School District
Raleigh, MS
PN: 22050

FROM: Dean Architecture
661 Sunnybrook Road, Suite 140
Ridgeland, MS 39157
(601) 939-7717

The following additions, changes, clarifications and/or substitutions to the Project Drawings as indicated, are hereby made a part of the Contract Documents. Acknowledge receipt of this Addendum by inserting its number and date in the Proposal Form where indicated.

Drawings

Item #1: Sheet A100 and A101.1:

For all subcontractors who may be considering submitting a bid on the fencing portion of the project, please be advised:

The fencing subcontractor shall survey the existing on-site conditions and furnish fencing as called for here and described on Sheet A100.1.

1. All new fencing, no matter the type, shall match in height to the existing fencing that is demolished and removed. Verify at site.
2. All totally new fencing, no matter the type, shall match in height to existing fence that the new will adjoin to. Verify at site.
3. All replacement fencing gates, no matter the type, shall match in dimension to the gates that are demolished and removed. Verify at site.
4. Around the west and south side of the stadium, the fencing subcontractor shall determine the exact length of fencing that will be required to replace that is removed. See demolition note #3 and renovation note #8 on sheet A100.1.
5. All totally new gates shall match in height to the new fencing, no matter the type, that is installed where the existing fencing is demolished or totally new fencing is installed.

Item #2: Sheet A100:

Add Supplemental Drawing R-1/A100 that is included with this addendum, to clarify the new gate location at the base of the existing run of steps at the north end of the home side bleachers.


Item #3: Sheet A100.1:

At the work referenced at the Athletic Field house Building, the general contractor shall survey the existing structure to determine the amount of siding and trim that will be painted under the base bid or replaced under Alternate #2.


SCSD Raleigh Football Renovation
Smith County School District
Addendum #2
April 6, 2023
PN: 22050

END OF ADDENDUM NUMBER TWO (2)


Dean Architecture, P.A.



J. Alan Grant, AIA, Principal

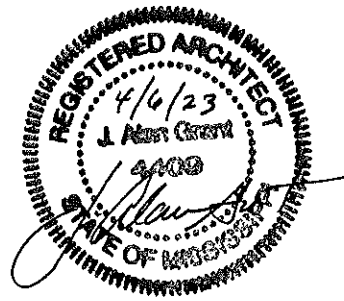

PLEASE ATTACH THIS ADDENDUM TO THE INSIDE FRONT COVER OF EACH SET OF SPECIFICATIONS.

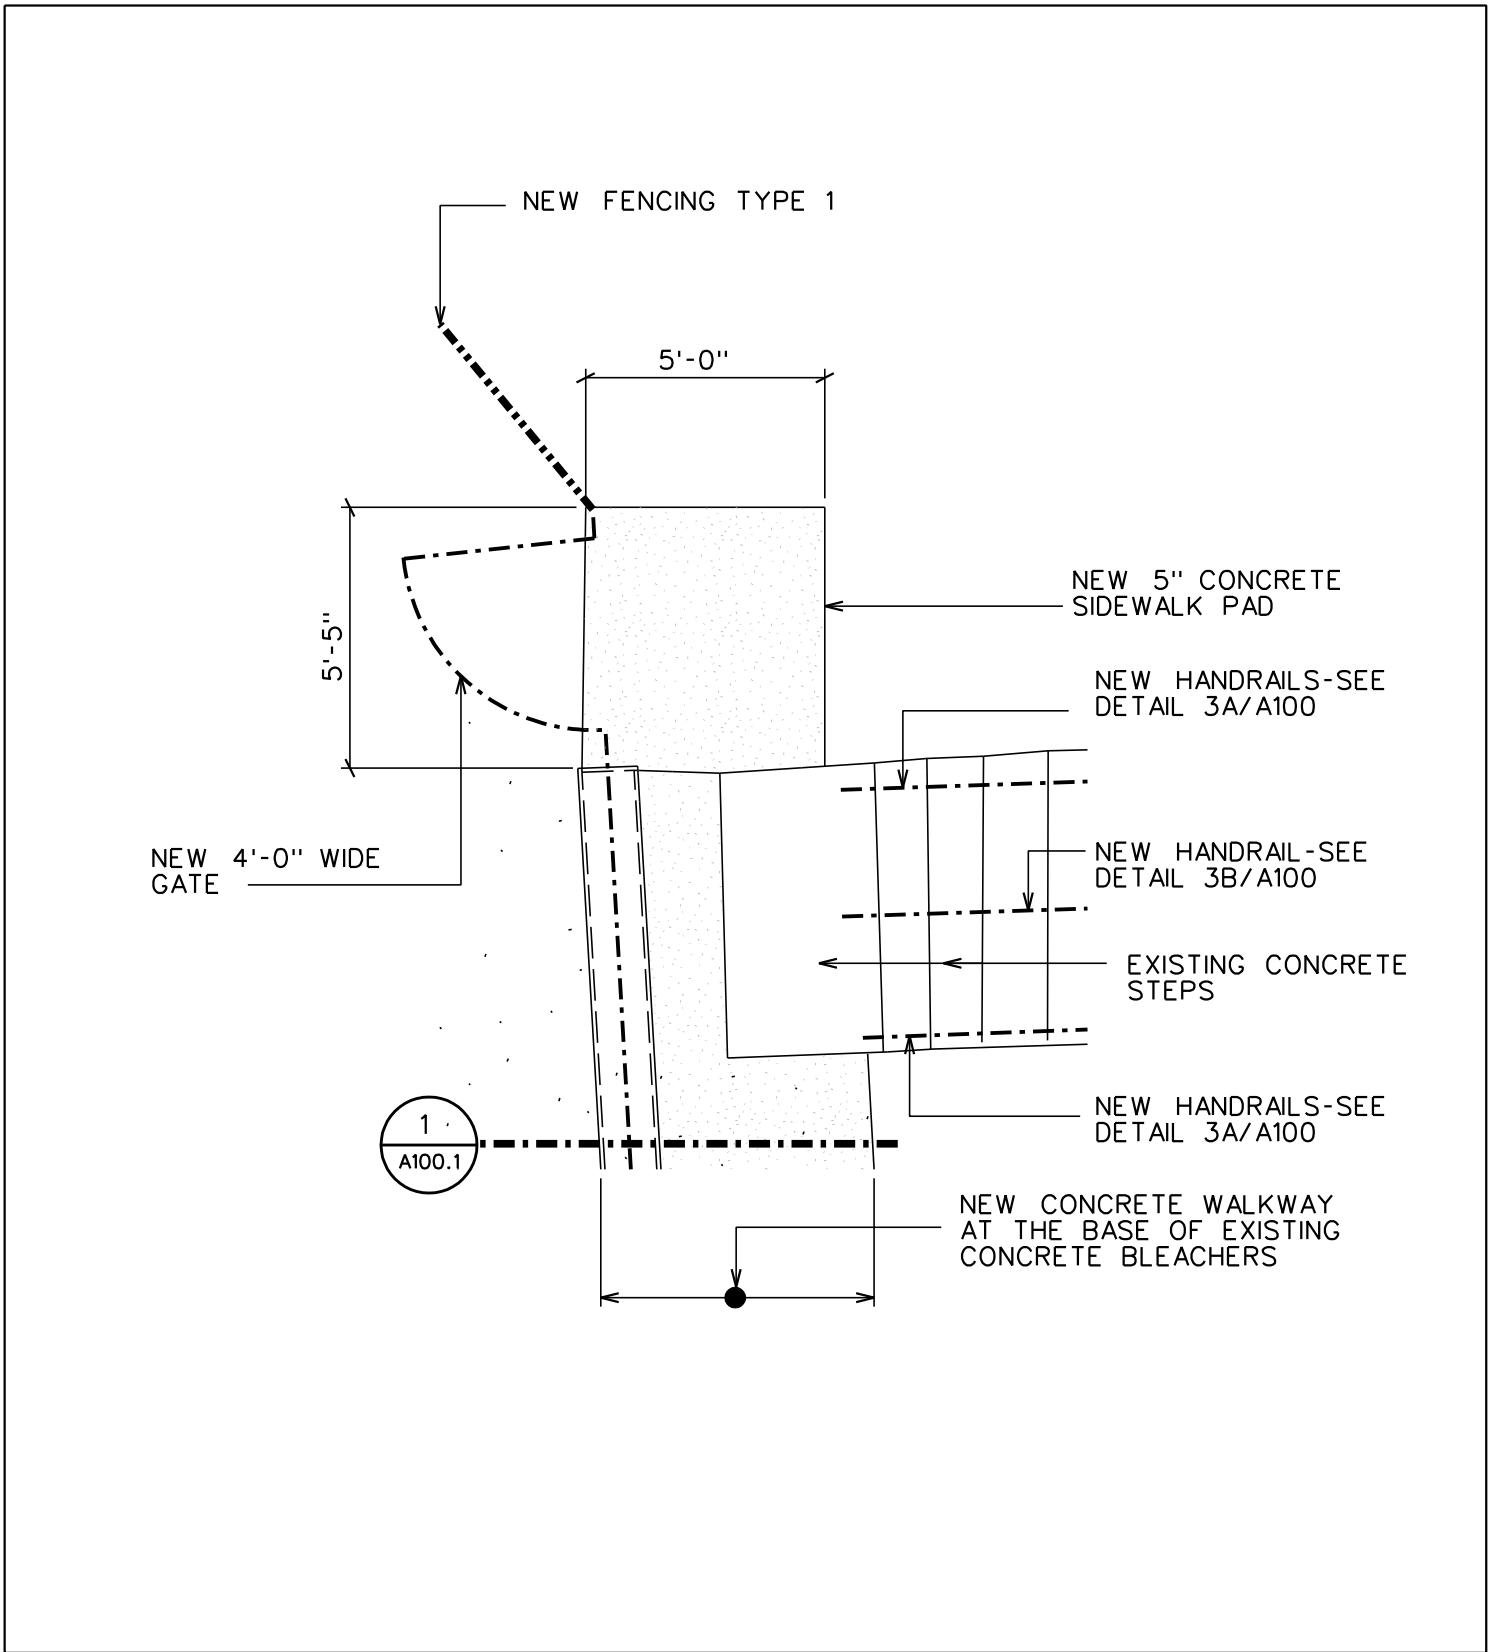

PROJECT RALEIGH FOOTBALL STADIUM RENOVATIONS
 PROJECT NO. 22050
 DATE: APRIL 3, 2023

SUPPLEMENTAL DRAWING



Dean and Dean/Associates
 architects a professional association
 ARCHITECTURE • PLANNING INTERIOR DESIGN

CLARIFICATION DETAIL OF GATE
 LOCATION AT THE BASE OF EXISTING
 STEPS AT NORTH END OF BLEACHERS

DWG. NO.
 R-1/A100