

September 25, 2023
GS# 612-021, Bath House Renovation
Lake Lowndes State Park, Columbus, MS

Addendum No. 1

This Addendum forms part of the Contract Documents for the above referenced project. All other requirements of the original Contract Documents shall remain in effect except as specifically modified in this Addendum. Bidder is to acknowledge receipt of this Addendum with their bid proposal. Failure to do so may subject the Bidder to disqualification. This Addendum is issued to all known Plan Holders.

1. A Pre-Bid Meeting was held on September 14, 2023. See this addendum for resolution of questions asked and other information discussed at this meeting. See the Pre-Bid Conference Meeting Minutes, sign-in sheet and discussion points attached. The Pre-Bid minutes and discussion points are included as part of this addendum. The attached **Discussion Points and Pre-Bid Conference Meeting Minutes** contain many of the requirements for this project. The contractor will be responsible for adhering to these and all rules associated with this facility.
2. See the attached Bureau's Instructions to Bidders for electronic bidding requirements to be included as part of this addendum.
3. The manufacturer's standard drawings (floor plans, exterior elevations and building sections are provided for reference only to assist the contractor to understand the configuration and dimensions of the building. These drawings are provided for reference only and show multiple options that may or may not apply to this project. See the specification for the complete listing of the construction requirements of the building, finishes, textures, accessories, fixtures, equipment, colors, etc. The building is to be supplied, installed and connected to the utilities as indicated in both the contract drawings and specifications. The building is to be placed as indicated on the site plan in the location indicated for the "Proposed Bathhouse".

Drawings and Specifications: The following General Notes shall apply to all drawings and specification sections:

4. The contract time will be changed to 270 days. See the new Proposal Form Section 00 4200 that reflects this change, that is attached to this addendum and to be used for your bid.
5. Drawing Sheet C500, Note 3: This note describes the structural fill as "70% passing the #200 Sieve". This requirement for "70% passing the #200 Sieve" will not be required. However, all other requirements for structural fill referenced in this note will remain in place and must meet the noted plasticity index and liquid limit requirements.
6. The precast building manufacturer/supplier is not considered to be a sub-contractor. They are considered to be a supplier.
7. The contractor will be allowed to use the areas immediately adjacent to the bath house for staging. In general, the road in front of the building must remain accessible by the public unless prior permission is given by the park staff. At a minimum, the two RV spaces that are immediately adjacent to the existing bath house will be vacant once construction activities begin and will be available for the contractor's use. Any other areas that the contractor would like to use require prior approval from the Owner. In the event that any additional RV space(s) would need to be vacant for specific activities (for example when the crane is

offloading/setting the new bath house), this will need to be requested in advance from the park staff so that they will have enough notice to not rent those spaces and to make any other accommodations to meet their operational needs. This type of request can be made in writing or coordinated at the monthly progress meetings. 6' tall chain link fencing will be required around all active work and staging areas. Fencing on pavement must be supported with weights/sandbags so that the existing pavement is not damaged. Windscreen will not be required.

8. The area between the main road and the bath house site may be temporarily accessed to provide access to the site to deliver the new bath house. However, the pavement edge (shoulder), ditches, campsite features, grassed areas, etc. must be protected and restored to their original condition. Protection in the form of matting, temporary gravel, etc. are to be placed at the contractor's discretion and then removed/restored once the delivery is complete. All damaged site grades, grassed area, etc. must be repaired to match the adjacent and original conditions.
9. MDWFP will not hold the contractor responsible for damage to the main road in the park that leads to the jobsite provided that the contractor takes reasonable precautions. For example: Stay on the center portion of the road as much as possible so that the shoulder of the road is not damaged. Do not make sharp turns in a manner that will cause wheels to "grind" into the pavement. Do not drive tracked equipment that may damage the pavement on the road.
10. Weekend work may be allowed with prior approval from the park staff. Approval will be completely dependent upon planned State Park activities and be at the discretion of the park staff.

Contents: This addendum consists of **2 (8 ½" x 11") sheets and 13 attachment sheets.**

End of Addendum No. for: GS# 612-021, Bath House Renovation, Lake Lowndes State Park, Columbus, MS





GS# 612-021

Bath House Renovation

Lake Lowndes State Park, MS

Pre-Bid Meeting September 14, 2023 @ 10:30 am

Project Contacts:

Mr. Michael Collins, – MDWFP

Mr. Shomari Rawls, Project Manager - BOB

Scott Comish, Project Manager – Shafer-Zahner-Zanher

Bid Date: Thursday, September 28, 2023 @ 2:00:00 pm @ the Bureau of Building, Grounds and Real Property Management (see **Advertisement For Bids, Section 00 11000** for official information). Official Time is by the Bureau of Building. See Advertisement for RFx # if you are bidding electronically.

Meeting Attendees: See attached sign in sheet.

Current Bidders List: 2 General Contractors (currently), see sign-in sheet for meeting attendees
If you are a sub-contractor looking for GC's contact our office for a current list

Construction days: ~~150~~ (Changed to **270 days**, see addendum) days for project (see *Proposal Form*)
Notice to Proceed – by BOB. Must hold price per specifications.

Contract Administration: Architects will be on site regularly once construction begins. Using Agency and BOB construction administrators will also visit regularly.

Construction Progress Meetings held monthly as required by Division 1.

Commissioning- none on this project.

Construction Access: Discuss: weekends, Sunday work, holidays, etc. **Weekend work may be allowed with prior permission depending upon planned activities at the State Park, parking permits will not be required.**
Restricted “no work” days due to events: **None noted.**

Staging Areas/Fencing/Access – Discuss: **See addenda for requirements.**

Protection: (responsibility of the Contractor, see specs.) **Note that the contractor is responsible for protecting all adjacent site features, construction and materials.** 6' chain link fencing is required around all active work areas and lay down areas. Windscreen is not required.

Scope of work: Discuss: **In general, demolition of existing structure, reroute utilities, supply/set up/connect new precast building and connect to utilities. Sidewalks and pavement. See drawings and specifications for complete requirements.**

Bidding rules: Pay attention to *Instructions To Bidders*. See Bidders Checklist.
Pay particular attention to Special Conditions

BOB is the owner- Contract is between BOB and Contractor.

Common mistakes: -Certificate of Responsibility number on envelope.
-Any changes to bid on outside of envelope. Initial and date.
-Acknowledge addenda.

GS# 612-021

BATH HOUSE RENOVATION

LOWNDES COUNTY STATE PARK

Pre-Bid Meeting 9/14/2023

Discussion points/Meeting Minutes:

- The park will be in operation and adjacent RV spots may be in use
- Site and construction in progress must be protected at all times.
- All interior and exterior finishes must be protected.
- Details were developed by using on site observation and partial original drawings, some conditions are assumed. Variation may exist in the details and actual conditions, contractor to coordinate.

Scope of Work:

- See drawings/specifications for complete description of work.
 - Demolish existing structure. See asbestos report and removal specifications.
 - Rework utility rough ins as indicated and required by the building manufacturer.
 - Prepare the site as indicated and required by the building manufacturer.
 - Provide, deliver and set up the new building per the contract documents and required by the building manufacturer for the given conditions. Provide all accessories and accommodations that are listed in the specifications and indicated on the drawings. See finish requirements. Conduit required for future owner supplied/installed heaters.
 - Make all connections and finish out all rough in locations for a complete and finished building.
 - New sidewalks and pavement. Alternate for additional pavement.
- **The new precast Bath House is defined by specifications (all accessories, finishes, fixtures, textures, etc.). The manufacturer's drawings for the building that is the basis of design are provided along with the Pre-bid handouts. These drawings are provided for informational purposes and are not specific to this project. The actual building is defined by the specifications that is to be provided and installed on the prepared site and connected to the utilities as defined in the drawings. This building is shown on the site plans as "Proposed Bathhouse". The specified Bath House is to be provided and installed in the location shown on the Site Plans in a manner as defined in the specifications.**
- The manufacturer's drawing are available at this location: [CXT-CheyenneDrawings \(cxtinc.com\)](http://CXT-CheyenneDrawings(cxtinc.com)) Note these drawings are somewhat generic, see the project specifications for the specific requirements, accessories, finishes, etc. required for this project. The manufacturer's "stub up" drawings for the utility rough-ins is available here: [Model \(cxtinc.com\)](http://Model(cxtinc.com)) Note that this information is to be used in coordination with the engineering drawings for this project.
- The contractor is responsible for coordinating with the manufacturer to provide a complete, connected, installed, finished building. The contractor is responsible for understanding what services are provided by the manufacturer and performing all additional necessary work for the project to be completed as indicated.

Questions/Clarifications:

- Access: **Laydown and storage areas** as defined by owner.
- No field office is required.
- Port-a-Jon is required.
- Limit access to adjacent portions of the park
- Fencing is required ~~with wind screens~~ (wind screens not required) around all active work or laydown areas.
- Liquidated Damages are \$250.00 per day.
- Objectional workmen: will be removed from the site and not be allowed to return.
- The contractor is not to interrupt utilities or egress/access without prior permission and notice.



STATE OF MISSISSIPPI
GOVERNOR PHIL BRYANT

DEPARTMENT OF FINANCE AND ADMINISTRATION

Liz Welch
EXECUTIVE DIRECTOR

M E M O R A N D U M

TO: Contractors, through the AGC, ABC, and MBOC

FROM: Bureau of Building, Grounds and Real Property Management

DATE: May 30, 2023 (links modified)

SUBJECT: Electronic Construction Bidding per Law effective 1/1/2018

Beginning January of 2018, the Mississippi Department of Finance and Administration / Bureau of Building Grounds and Real Property Management started receiving construction bids electronically as required by House Bill 1106, Laws of 2017. Electronic bids are at the discretion of the Bidder/Supplier. Paper bids WILL STILL BE received as stipulated in the Advertisement / Request for Bids The instrument being used to carry out this is a program called MAGIC which is available to all State of Mississippi departments, agencies, and Bidders/Suppliers. (MAGIC is the State's Accounting System.)

TO BID USING MAGIC: Potential Bidder/Supplier must first register (see below). When the Bidder/Supplier registers themselves, they will automatically receive their Magic sign-in information. (The Bureau of Building, et al, can assist with this, and, if so, will notify the Bidder/Supplier by email of doing so, so they can contact Magic to get their sign-in information for bidding electronically) Construction Bidders/Suppliers who have received awards in recent years through the Bureau of Building, et al, should already have their company information properly entered. Those companies should still verify that their system "Product Code" is set to "90922" [for construction] in order to receive "system generated Bid Notices" for construction projects. (Bid Opportunities will continue to be in the newspaper, on the Magic Portal, and on the Bureau of Building, et al, web.) When registering, a company should enter their company information EXACTLY as shown per the Mississippi Secretary of State's listing and per their W9. Contact Magic at: mash@dfa.ms.gov or 601-359-1343. A tutorial is available at: <http://uperform.magic.ms.gov/gm/folder-1.11.7512?originalContext=1.11.8507> (when registering, the MS SoS, MBOC, and W9 should all agree.)

HOW BIDDER/SUPPLIER REGISTERES THEMSELVES:

www.dfa.ms.gov

vendor registration (middle of the page)

down the page to State of Mississippi Supplier Registration

Complete that form

And “send” (top left or bottom of form on left)

This is the current link for the info above: https://sus.magic.ms.gov/sap/bc/webdynpro/sapsrm/wda_e_suco_sreg?sap-client=100#

TO ADD THE PRODUCT CODE 90922 once in your MAGIC Address Table click the steps below:

1. Click on Suppliers Self Service Tab.
2. Click Company Data.
3. Click the Process Button.
4. Click Add Categories in the Product Categories section
5. Add the product Categories from here (90922 for construction)

TO VIEW ADVERTISED PROJECT INFORMATION on line

1. DFA Web site
2. Supplier/Vendor
3. Mississippi Procurement Portal
4. (RFx) Procurement Opportunities and Public Notifications
5. Advanced Search Options
6. Major Procurement Category: Select Construction
7. Dept/Agency: Select MS DEPT FINANCE AND ADMINISTRATION 6. SEARCH

Another option from the DFA/BoB web site is to:

1. Select DFA Offices
2. Select Bureau of Building Grounds and Real Property Management.
3. Bid and RFP Notice
4. Construction Solicitations and Bid Tabs
5. Locate the GS# at left of the list and the RFx number at the right.


On both lists, the RFx number for each project is listed which is required in MAGIC when preparing bids.

For additional information regarding registration in MAGIC, contact MMRS at (601) 359-1343 or by email at mash@dfa.ms.gov.


/pgw

ALL PIPING INDICATED ON THIS SHEET IS NOT BY CXT


THIS DRAWING IS SUPPLIED FOR REFERENCE ONLY. PLEASE CONTACT CXT ENGINEERING DEPARTMENT FOR BUILDING SPECIFIC CONTROLLED DOCUMENTS PRIOR TO ANY FIELD WORK.

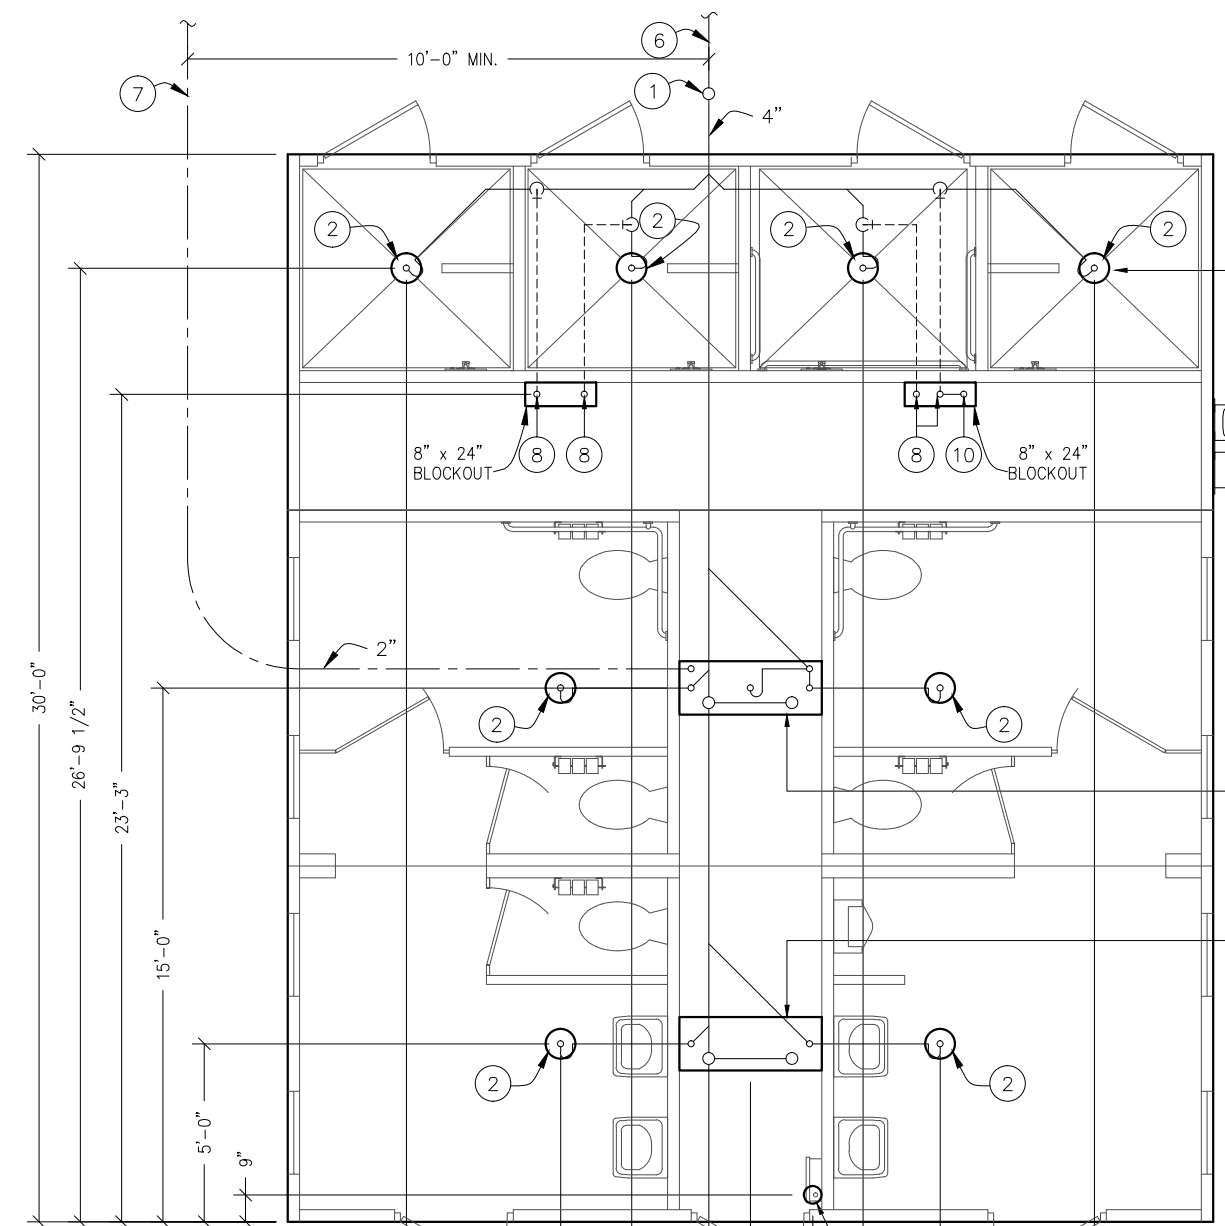

FOR REFERENCE ONLY

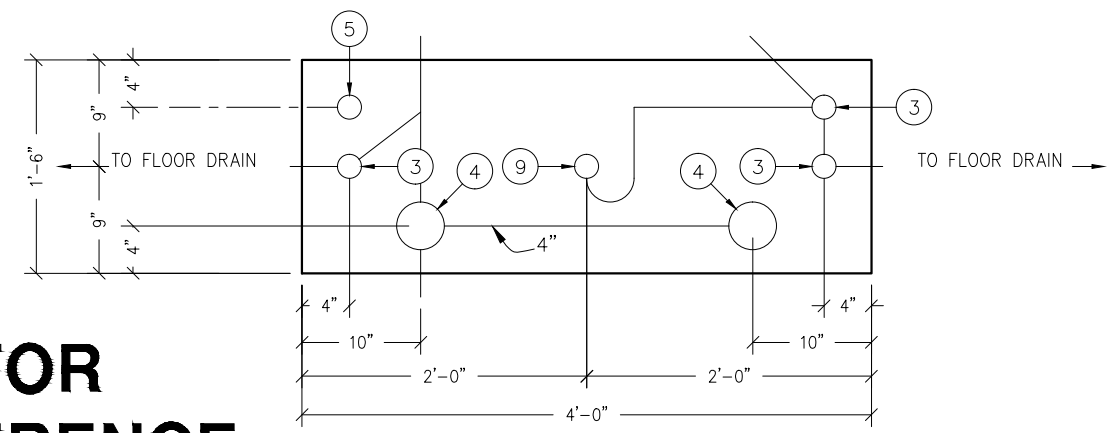


18" x 48" BLOCKOUT DETAIL "A"

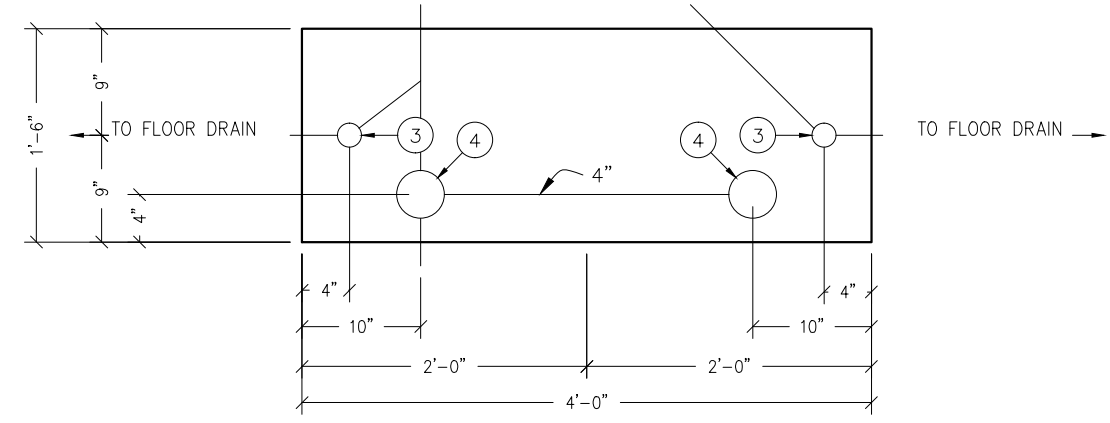

18" x 48" BLOCKOUT DETAIL "B"

PIPING LEGEND

- BELOW FLOOR WASTE PIPING SCH 40 ABS TYPE DWV
- - - BELOW FLOOR VENT PIPING SCH 40 ABS TYPE DWV
- - - 2" TYPE "K" ANNEALED "SOFT" COPPER WATER SERVICE

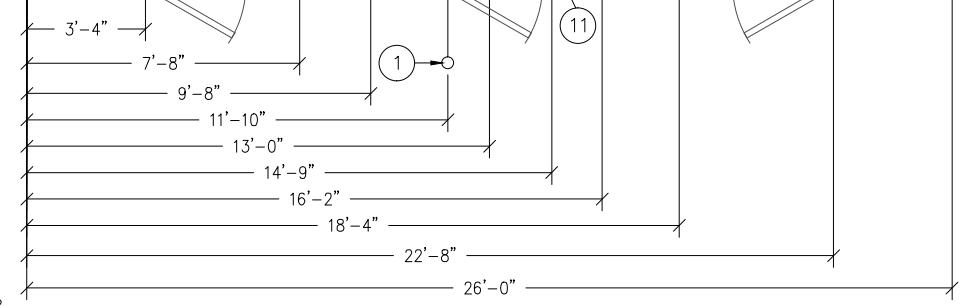


FLOOR DRAIN BLOCKOUTS & BELOW FLOOR PIPING

BELOW FLOOR PIPING — KEY NOTES

1. 4" CLEAN OUT TO GRADE.
2. 2" FLOOR DRAIN. FIELD INSTALLED TRAP PRIMER SYSTEM IF REQUIRED BY AUTHORITY HAVING JURISDICTION. (10" DIA BLOCKOUT)
3. 2" VENT PIPES EXTENDED 12" ABOVE FINISHED FLOOR LEVEL, PROVIDE TEST PLUGS. (18" x 48" BLOCKOUT)
4. 4" WASTE PIPE EXTENDED 12" ABOVE FINISHED FLOOR LEVEL, PROVIDE TEST PLUG. (18" x 48" BLOCKOUT)
5. 2" TYPE K ANNEALED "SOFT" COPPER WATER SERVICE EXTENDED 12" ABOVE FINISHED FLOOR LEVEL, PROVIDE CAP AT END. (18" x 48" BLOCKOUT)
6. 30" MIN. BURY, PROVIDE TRACER TAPE.
7. MIN. BURY PER LOCAL REQUIREMENTS TO PROTECT AGAINST FREEZING AND DAMAGE.
8. 2" VENT PIPES EXTENDED 12" ABOVE FINISHED FLOOR LEVEL, PROVIDE TEST PLUGS. (8" x 2'-0" BLOCKOUT)
9. 2" FLOOR DRAIN. FIELD INSTALLED TRAP PRIMER SYSTEM IF REQUIRED BY AUTHORITY HAVING JURISDICTION. (1'-6" x 4'-0" BLOCKOUT)
10. 2" WASTE PIPE EXTENDED 12" ABOVE FINISHED FLOOR LEVEL. (8" x 2'-0" BLOCKOUT)
11. ELECTRICAL STUB UP. (6" DIA BLOCKOUT)

FLOOR DRAIN DETAIL NOTES

- A. CAST-IN DRAIN HOUSING (10" INSIDE DIM — PROVIDED BY CXT)
- B. FIELD INSTALLED GROUT, SLOPE TO DRAIN (CXT PROVIDED—INSTALLATION NOT BY CXT)
- C. 2" WASTE PIPE — STUB UP 12" ABOVE GRADE (NOT BY CXT)
- D. TAPPED P-TRAP ADAPTER (NOT BY CXT)
- E. P-TRAP ASSEMBLY (NOT BY CXT)
- F. 1/2" O.D. COPPER TRAP PRIMER LINE (NOT BY CXT)
- G. 2" FLOOR DRAIN VENT RISER — STUB UP 12" ABOVE GRADE (NOT BY CXT)
- H. TRAP PRIMER MANIFOLD (PRE-PLUMBED AND INSTALLED BY CXT)
- I. 1/2" SHUT OFF VALVE (PRE-PLUMBED AND INSTALLED BY CXT)

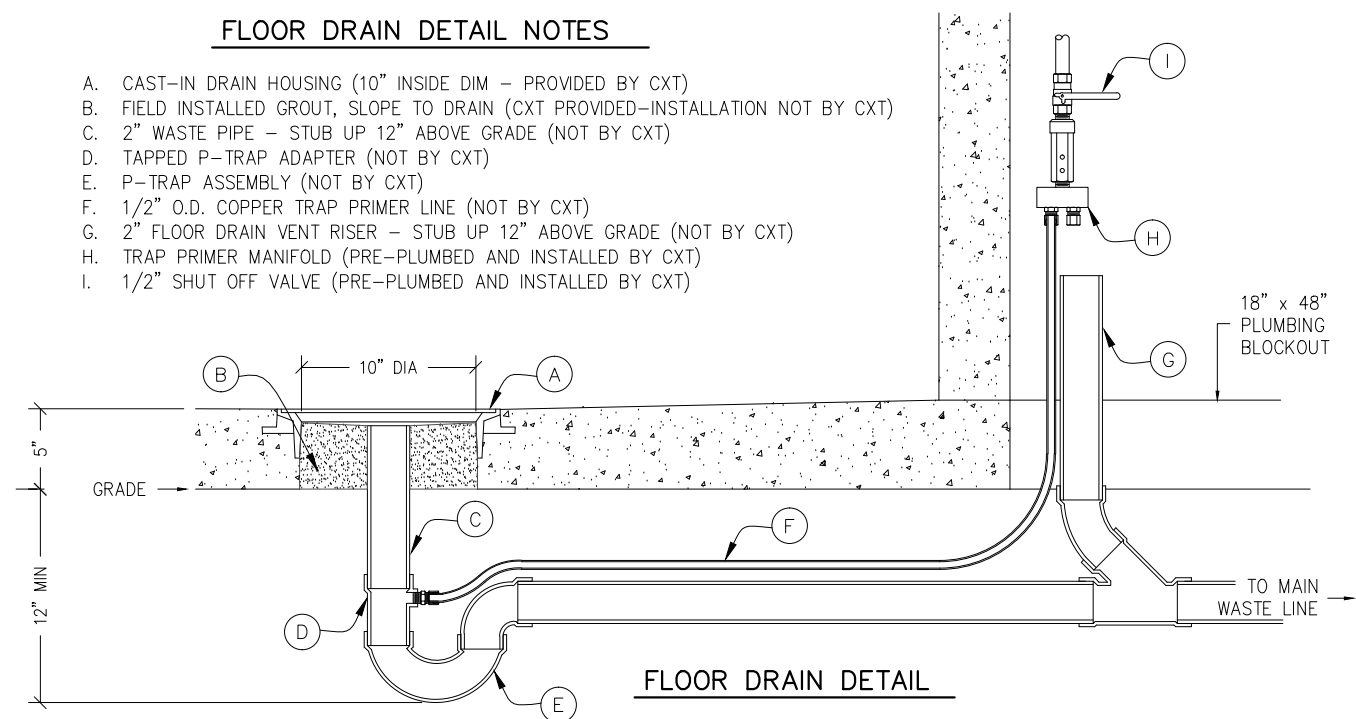

FLOOR DRAIN DETAIL

3808 N. Sullivan Bldg. #7 Spokane, WA 99216
CXT
Precast Products
 901 N. Highway 77 Hillsboro, TX 76645


PROJECT TITLE
CHEYENNE
 CXT STANDARD BUILDING

NOTICE
 The information contained herein is proprietary and the exclusive property of CXT Incorporated. The information may only be used by the original recipient for the purpose intended. Reproduction or distribution of this information is strictly prohibited without the prior written consent of CXT Incorporated. By allowing use of this information, CXT Incorporated grants no warranty, express or implied, including a warranty of merchantability or of fitness for a particular purpose.
 CXT Incorporated

REV.	DESCRIPTION	APPROVAL	DATE
SCALE	3/16"=1'-0"	DATE	04-30-16
DRAWN	DANA B	FILE NO.	FOR REF
CHECKED	RDW	PLOT	64

FLOOR DRAIN LOCATIONS & BELOW FLOOR PIPING
 DWG NO. CH-37 SHEET REV.

ADA COMPLIANT SLIP RESISTANT
2' x 2' SIMULATED TILE SURFACE
(TYP ALL SHOWER ROOMS)

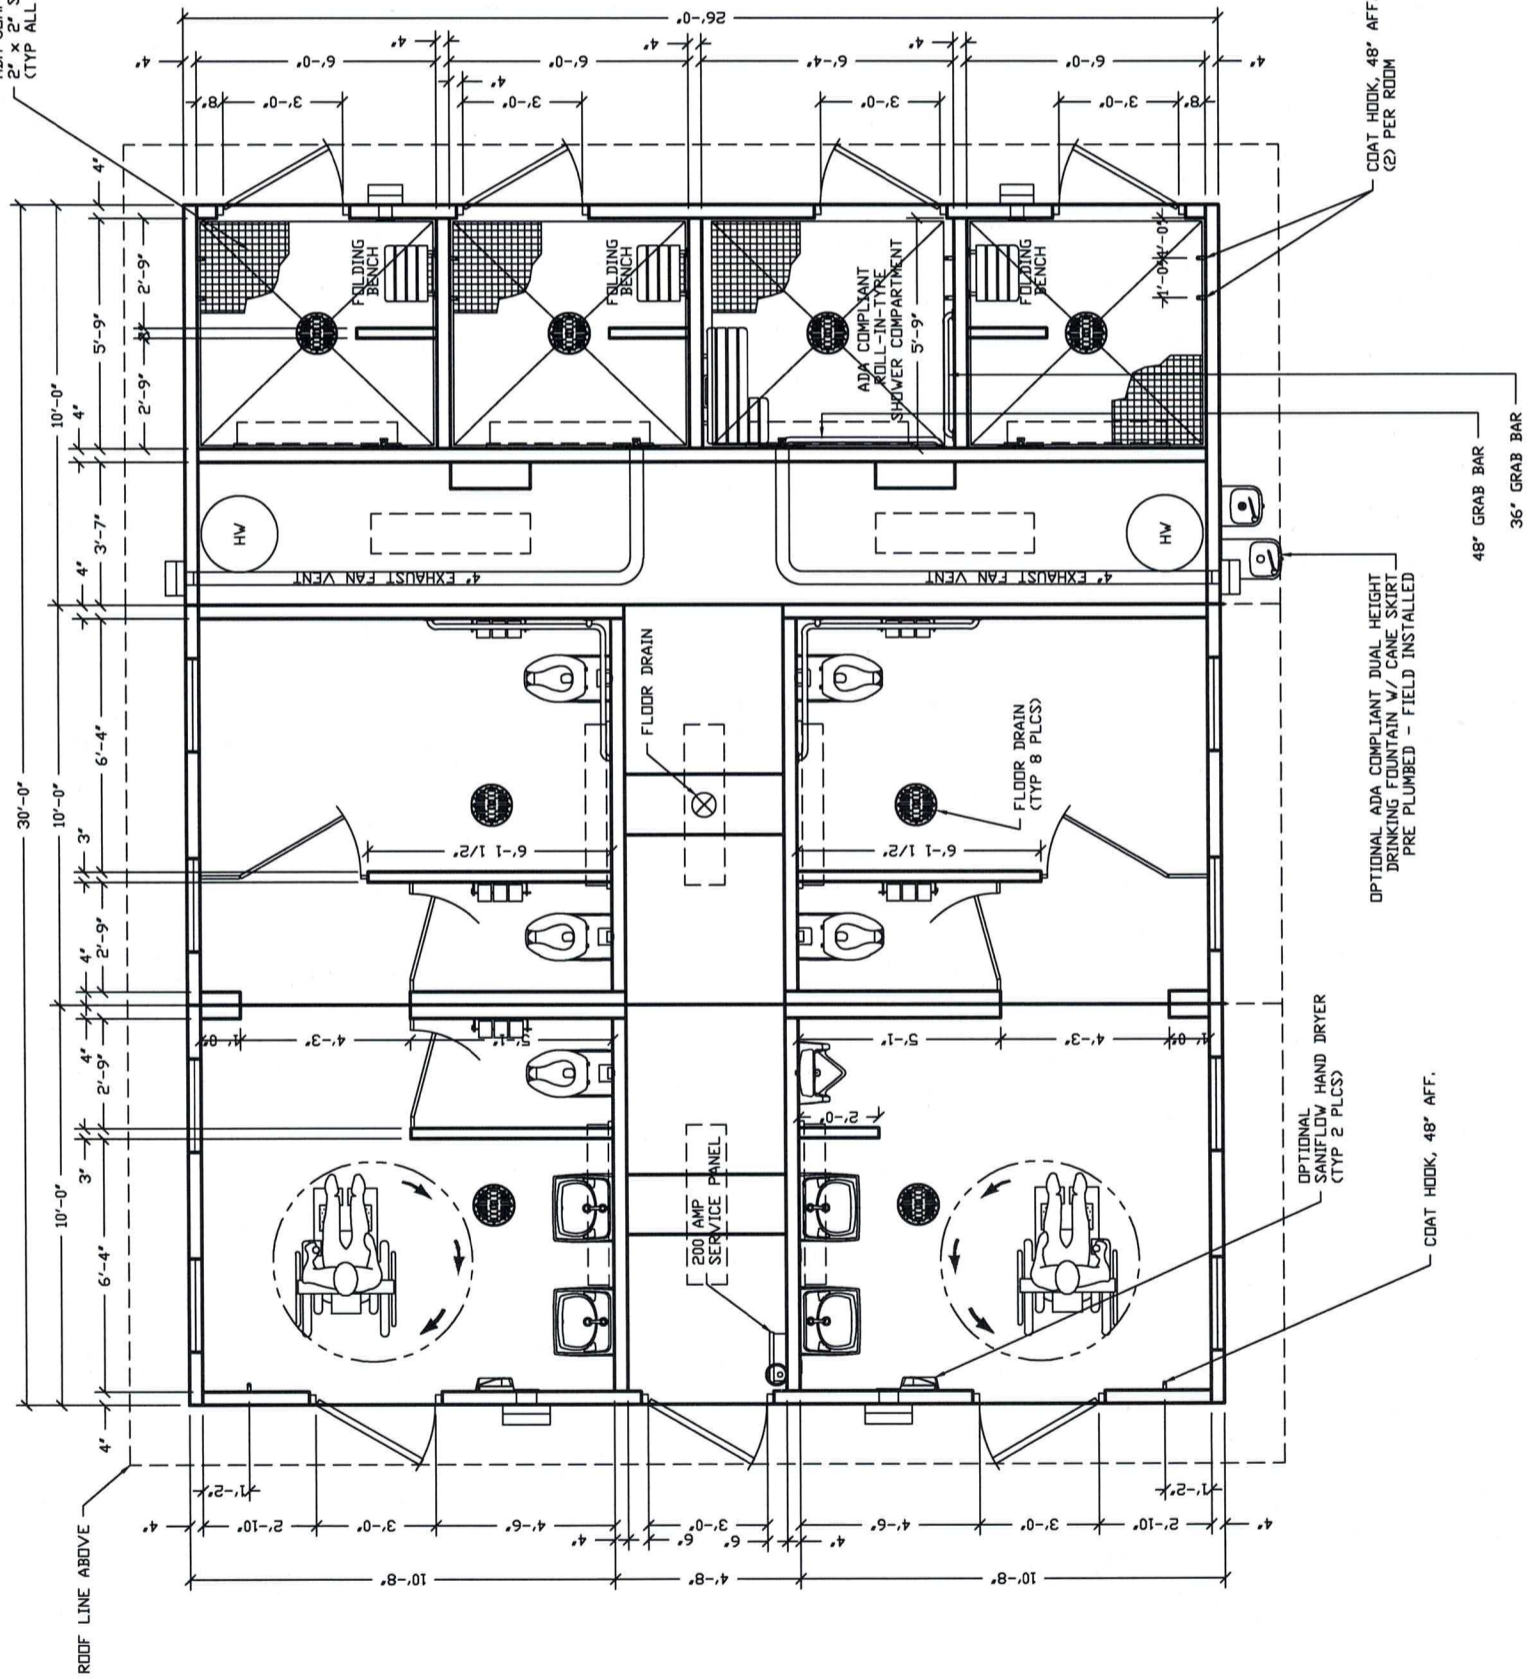

**FOR
REFERENCE
ONLY**

**SEE SPECIFICATIONS FOR COMPLETE
REQUIREMENTS FOR THE BUILDING
CONSTRUCTION, FINISHES,
TEXTURES, ACCESSORIES, FIXTURES,
EQUIPMENT, COLORS, ETC. THE
BUILDING IS TO BE SUPPLIED,
INSTALLED AND CONNECTED TO
UTILITIES AS INDICATED ON THE
CONTRACT DRAWINGS AND
SPECIFICATIONS (IN THE LOCATION
SHOWN AS "PROPOSED BATHHOUSE".
ADDITIONALLY, FOLLOW ALL
MANUFACTURERS
RECOMMENDATIONS FOR
INSTALLATION.**



PROJECT NAME
CHEYENNE
CXT STANDARD BUILDING


SCALE
1/4"=1'-0"

REV.	DESCRIPTION	DATE	BY
1	ISSUE FOR PERMIT	04-30-16	PD-CH03
2	REVISED		AB
3	REVISED		AB
DWG NO. **CH-03**
SHEET

FLOOR PLAN

FOR
REFERENCE
ONLY

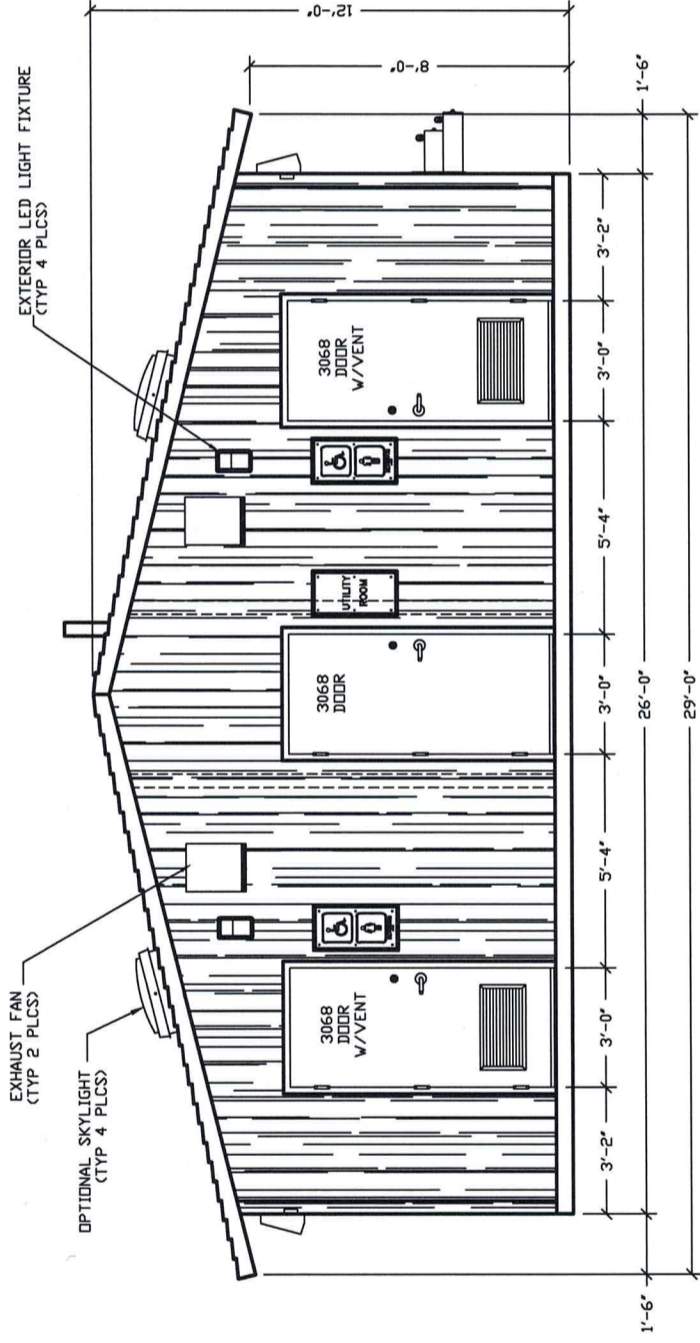

FRONT ELEVATION

BARNWOOD TEXTURE
TYP ALL EXTERIOR WALLS


CEDAR SHAKE ROOF TEXTURE

SLIDING DOOR STOP
GLYNN-JOHNSON (TYP 4 PLCS)

WET LOCATION EXHAUST FAN
(TYP 2 PLCS)

STAINLESS STEEL SPRING HINGE
(TYP ALL SHOWER DOORS)

OPTIONAL ADA COMPLIANT DUAL HEIGHT
DRINKING FOUNTAIN W/ CANE SKIRT
PRE PLUMBED - FIELD INSTALLED

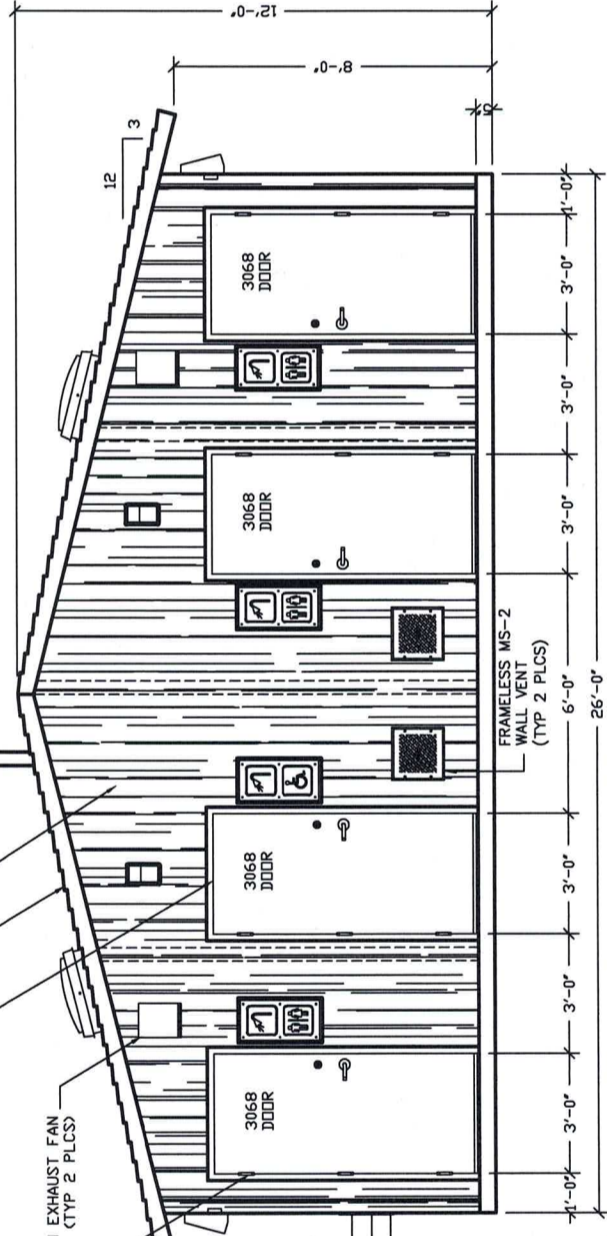

REAR ELEVATION

SEE SPECIFICATIONS FOR COMPLETE REQUIREMENTS FOR THE BUILDING CONSTRUCTION, FINISHES, TEXTURES, ACCESSORIES, FIXTURES, EQUIPMENT, COLORS, ETC. THE BUILDING IS TO BE SUPPLIED, INSTALLED AND CONNECTED TO UTILITIES AS INDICATED ON THE CONTRACT DRAWINGS AND SPECIFICATIONS (IN THE LOCATION SHOWN AS "PROPOSED BATHHOUSE". ADDITIONALLY, FOLLOW ALL RECOMMENDATIONS FOR MANUFACTURERS FOR INSTALLATION.



PROJECT FILE
CHEYENNE
CXT STANDARD BUILDING

NOTICE
The information contained herein is proprietary and the exclusive property of CXT Incorporated. The information is provided for your use only and is not to be reproduced, stored in a retrieval system, or transmitted in any form or by any means, electronic, mechanical, photocopying, recording, or by any information storage and retrieval system, without the prior written consent of CXT Incorporated. CXT Incorporated grants no warranty, approval or license, including a warranty of merchantability or of fitness for a particular purpose. CXT Incorporated

NO.	DATE	DESCRIPTION	BY	CHKD
1	04-30-18	ISSUED FOR PERMIT	AK	AK
2	04-30-18	REVISED PER COMMENTS	AK	AK
3	04-30-18	REVISED PER COMMENTS	AK	AK
4	04-30-18	REVISED PER COMMENTS	AK	AK
5	04-30-18	REVISED PER COMMENTS	AK	AK
6	04-30-18	REVISED PER COMMENTS	AK	AK
7	04-30-18	REVISED PER COMMENTS	AK	AK
8	04-30-18	REVISED PER COMMENTS	AK	AK
9	04-30-18	REVISED PER COMMENTS	AK	AK
10	04-30-18	REVISED PER COMMENTS	AK	AK



SCALE: 1/4"=1'-0"
DATE: 04-30-18
DRAWN BY: AK
CHECKED BY: AK

PROJECT NO.:
SHEET NO.:
REV.:

CH-04

**FOR
REFERENCE
ONLY**

SEE SPECIFICATIONS FOR COMPLETE REQUIREMENTS FOR THE BUILDING CONSTRUCTION, FINISHES, TEXTURES, ACCESSORIES, FIXTURES, EQUIPMENT, COLORS, ETC. THE BUILDING IS TO BE SUPPLIED, INSTALLED AND CONNECTED TO UTILITIES AS INDICATED ON THE CONTRACT DRAWINGS AND SPECIFICATIONS (IN THE LOCATION SHOWN AS "PROPOSED BATHHOUSE".
ADDITIONALLY, FOLLOW ALL MANUFACTURERS RECOMMENDATIONS FOR INSTALLATION.

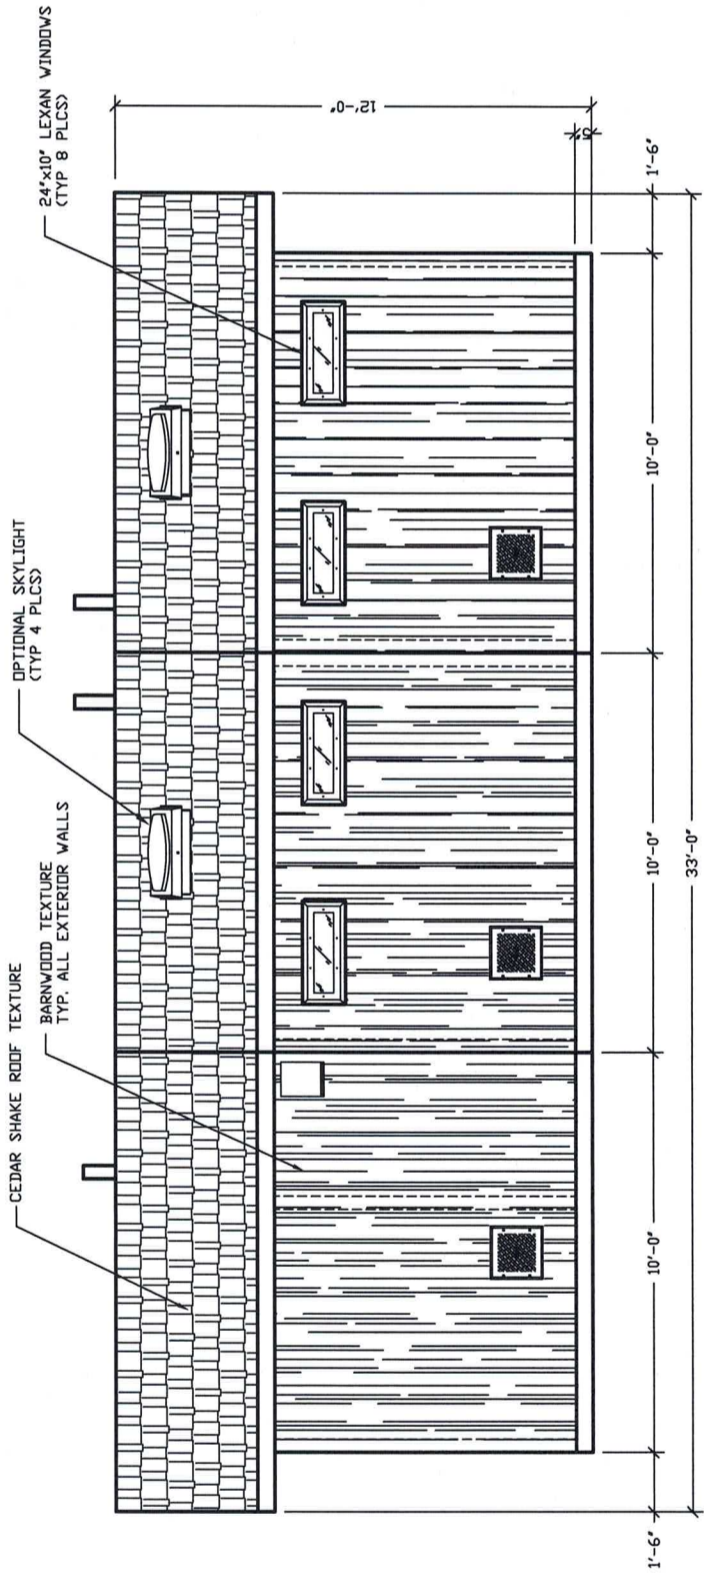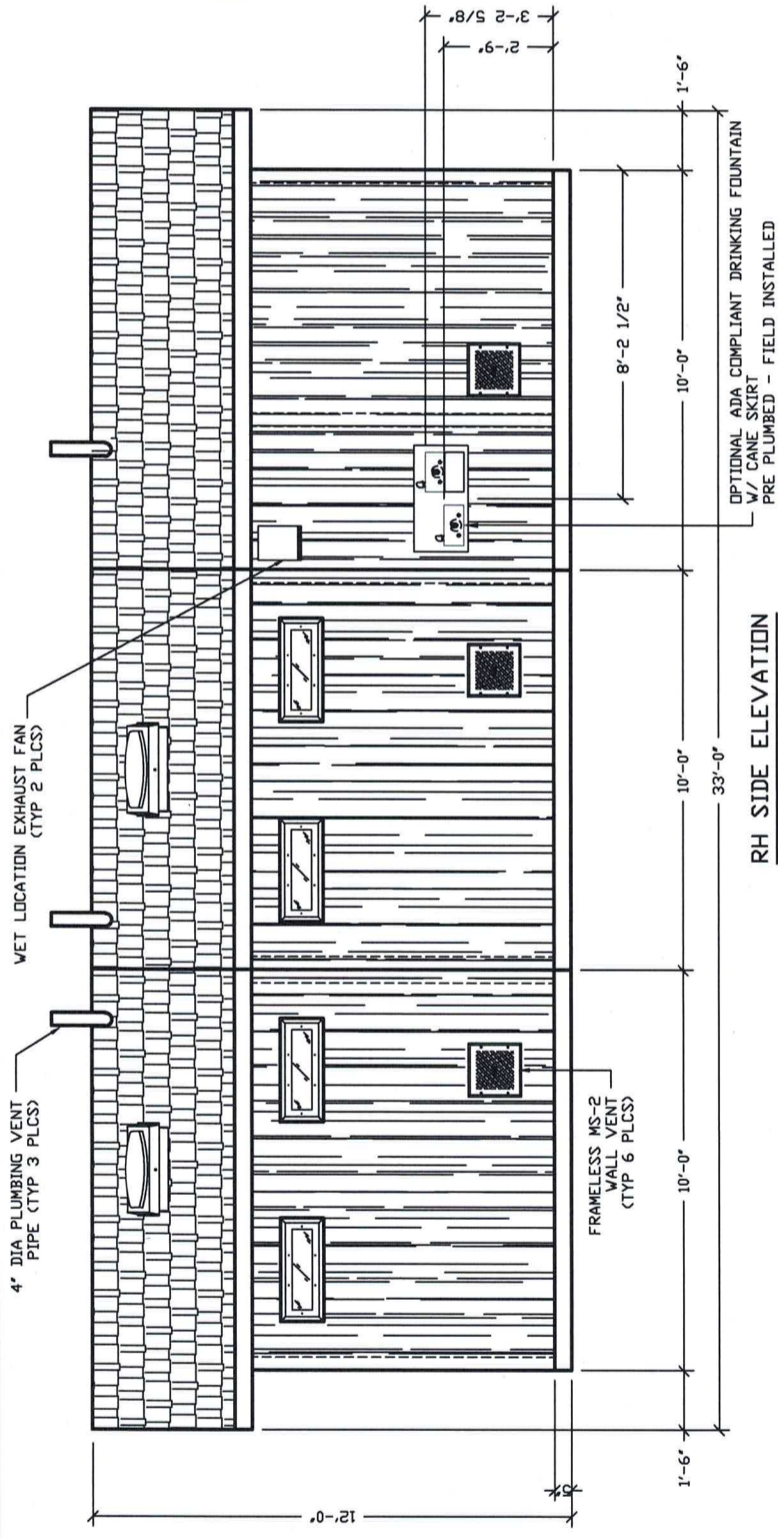


CHEYENNE
 CXT STANDARD BUILDING

NOTICE
 The information contained herein is proprietary and the exclusive property of CXT Incorporated. The information is provided for your use only and is not to be distributed, reproduced, or otherwise used without the prior written consent of CXT Incorporated. CXT Incorporated grants no warranty, express or implied, including a warranty of merchantability or of fitness for a particular purpose. CXT Incorporated

REV.	DATE	BY
1/4-17	04-30-18	48
CHECKED	DATE	BY
	04-30-18	48
	DATE	BY
	04-30-18	48

BUILDING ELEVATIONS
 DWG NO. **CH-05**
 SHEET REV.

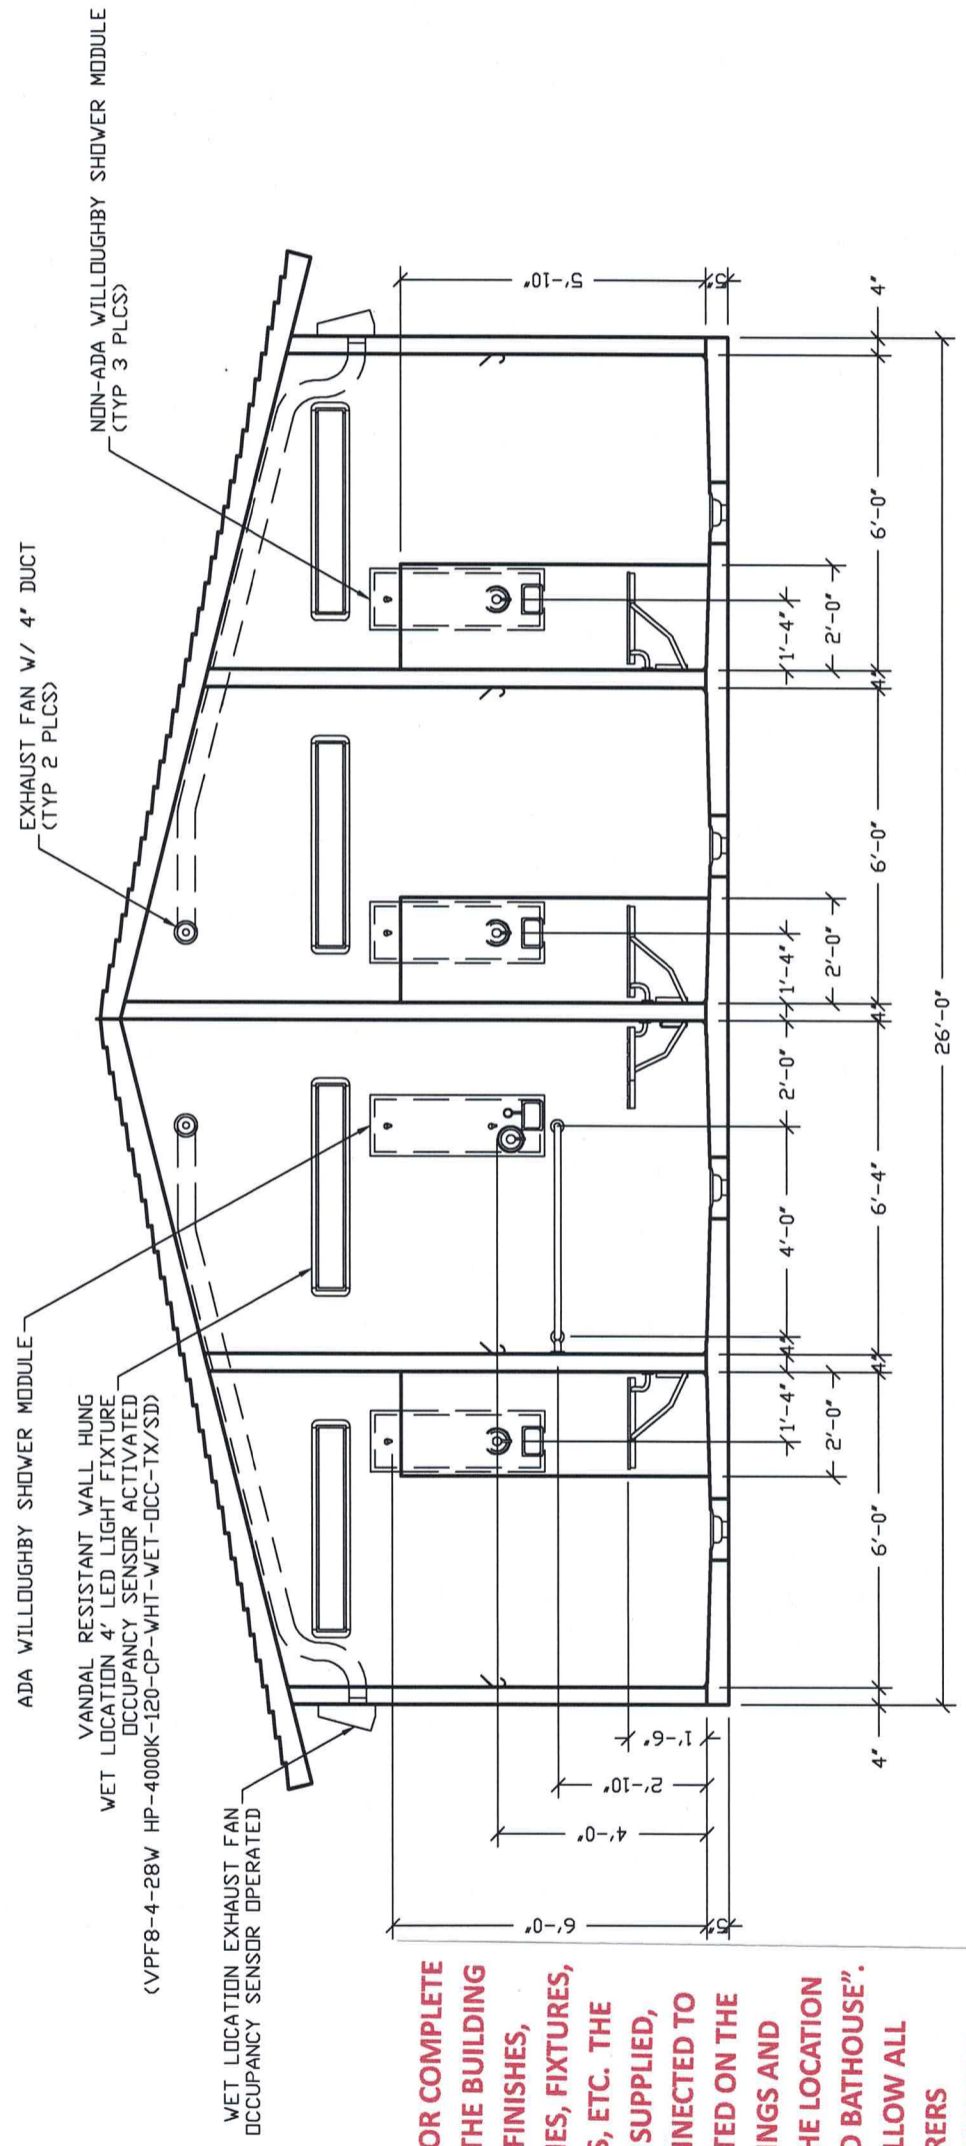

SEE SPECIFICATIONS FOR COMPLETE REQUIREMENTS FOR THE BUILDING CONSTRUCTION, FINISHES, TEXTURES, ACCESSORIES, FIXTURES, EQUIPMENT, COLORS, ETC. THE BUILDING IS TO BE SUPPLIED, INSTALLED AND CONNECTED TO UTILITIES AS INDICATED ON THE CONTRACT DRAWINGS AND SPECIFICATIONS (IN THE LOCATION SHOWN AS "PROPOSED BATHHOUSE". ADDITIONALLY, FOLLOW ALL MANUFACTURERS RECOMMENDATIONS FOR INSTALLATION.

FOR
REFERENCE
ONLY



PROJECT FILE
CHEYENNE
CXT STANDARD BUILDING

NOTICE
The information contained herein is proprietary and the exclusive property of CXT Incorporated. The information herein is provided for your information only and is not intended to be used for any other purpose. Reproduction or distribution of this information is strictly prohibited without the prior written consent of CXT Incorporated. CXT Incorporated grants no warranty, express or implied, including a warranty of merchantability or of fitness for a particular purpose. CXT Incorporated

NO.	DATE	BY
1	1/2-1-0	04-05-16
SCALE	DATE	FILE NO.
1/4"=1'-0"	04-05-16	16-CH07
CHECKED	PLG	AK

INTERIOR ELEVATIONS
SHOWER
CH-07
SHEET
REV.



OFFICE OF ARCHITECTURE

GS# 612-021,
Bath House Renovation
Lake Lowndes State Park

Sign-In Sheet

NAME FIRM EMAIL

Scott Comish Shafer-Zahner-Zahner scomish@szzarch.com

Shumari Rawls
Ricky Mordecai
Bo B
Borke-Mordecai
Shumari.rawls@dfa.ms.gov
rmordecai@burksmordecai.net

Penny Wyers
James Robbins as well
Lake Lowndes
penny.wyers@wfp.ms.gov

Joe Morgan JMorgan Company joemorgan@jucoservices.com

GARRY STEGALL BOB
Garry.Stegall@DFA.Ms.Gov

Michael Collins MDWFP
Michael.Collins@wfp.ms.gov

PROPOSAL FORM

SECTION 00 4200

To: Bureau of Building, Grounds and Real Property Management
501 North West Street, Suite 1401B [Woolfolk Building]
Jackson, Mississippi 39201

Re: Project # 612-021
Project Title Bath House Renovation
Location Lake Lowndes State Park

I propose to complete all work in accordance with the Project Manual and Drawings within 270 consecutive calendar days for the sum of: (Professional must specify number of days)

BASE BID: (Write in the amount of the base bid in words and numbers. In case of conflict, the written word governs.)

Words: _____ Dollars (\$ _____)

ALTERNATES: (Write in the amount of all of the alternates in words and numbers. In case of conflict, the written word governs.)

Alternate #1 Adds Deducts

Words: _____ Dollars

(\$ _____)

Description What is the additional cost to mill the existing asphalt and install an overlay as indicated on drawing sheets C100 and C200 as "ADD ALTERNATE".

All related notes, details and specifications apply to this work.

Alternate #2 Adds Deducts

Words: _____ Dollars

(\$ _____)

Description N/A

Alternate #3 Adds Deducts

Words: _____ Dollars

(\$ _____)

Description N/A

Alternate #4 Adds Deducts

Words: _____ Dollars

(\$ _____)

Description N/A

Alternate #5 Adds Deducts

Words: _____ Dollars

(\$ _____)

Description N/A

ADDENDA ACKNOWLEDGMENT: (modified dates August 2016)

No. _____ No. _____ No. _____
No. _____ No. _____ No. _____

ACCEPTANCE:

I certify that I am authorized to enter into a binding contract, if this Proposal is accepted.

Signature _____ Date _____
Name and Title _____
Name of Business _____

Complete spelling of bidder's name and address - **exact as recorded at the Secretary of State**

[<http://www.sos.state.ms.us/busserv/corp/soskb/csearch.asp>] which should be the same as you applied for at the Mississippi State Board of

Contractors [<http://www.msdoc.us/Search2.CFM>] (see 2.07, 3.01, 5.01) **PLEASE LOOK IT UP at SoS. SoS rules when the 2 are different.**

Address _____ (mailing)
Address _____ (physical)
City/State/Zip Code _____ County _____
Phone _____ Fax _____ Email _____

- **BIDDER'S CERTIFICATE OF RESPONSIBILITY NUMBER(S):** _____
- **MINORITY BUSINESS ENTERPRISE?** Yes _____ No _____ (to assist with Code 57-1-57)

- Attach copy of Non-Resident Bidder's Preference Law (5.04 of Bidder's Checklist)

- **Mechanical / Plumbing / Electrical Contractors:** (modified Dec 2013 SoS per 10/17/12 Addendum 1 & Feb 2014; 021219 sub over \$50,000.00; modified 04/06/2020)

Regarding said Divisions of the Specifications of the BoB Standard Form of Agreement Between The Owner and The Contractor: List any Mechanical/Plumbing and/or Electrical Sub-Contractors that will perform work of this contract; regardless of cost even for under \$50,000.00. COR must be included where sub-contract exceeds \$50,000.00. If no sub-contractor is listed, and such work is within scope of contract and over \$50,000.00, bidder's own COR classification(s) must be sufficient to self-perform any such work. If no sub-contractor is listed, then use of sub-contractor to perform such scope will not be permitted. This is in accordance with 5.05 and 5.06 of the Bidder's Checklist.

Mechanical Contractor: _____ Certificate of Responsibility No. _____
Plumbing Contractor: _____ Certificate of Responsibility No. _____
Electrical Contractor: _____ Certificate of Responsibility No. _____

■