

**The W Nursing School
Neshoba General
Philadelphia, MS**

**From: Foil Wyatt Architects & Planners, PLLC
4316 Old Canton Rd., Suite 101
Jackson, MS 39211**

Addendum No. 2

June 10, 2026

This addendum forms a part of the contract documents and modifies the original plans and specifications dated June 4, 2026.

Plans:

Item 2.1: Sheet C-103

Replace: The original sheets with the enclosed revised sheet dated 6/9/26.

Note: See Site Plan for corrected elevations. See curb schedule for corrected elevations.

Item 2.2: Sheet A-101

Replace: The original sheets with the enclosed revised sheet dated 6/9/26.

Note: See clouded notes for exterior wall referenced sections.

Item 2.3: Sheet A-103

Replace: The original sheets with the enclosed revised sheet dated 6/9/26.

Note: See clouded notes for dimensions at Room 305. See details 2, 3, and 4 for partition construction A, B, and C.

Item 2.4: Sheet A-105

Replace: The original sheets with the enclosed revised sheet dated 6/9/26.

Note: See clouded notes for tube columns to support folding partition beam at 4/A105 and 6/A105. See clouded detail 5/A105 of "lay-in" ceiling to "drywall" ceilings.

Item 2.5: Sheet A-106

Replace: The original sheets with the enclosed revised sheet dated 6/9/26.

Note: See clouded section references are noted of different ceiling materials.

Item 2.6: Sheet A-107

Replace: The original sheets with the enclosed revised sheet dated 6/9/26.

Note: See clouded configuration 11/A107 of the condense units at the north end of the project.

Item 2.7: Sheet A-109

Replace: The original sheets with the enclosed revised sheet dated 6/9/26.

Note: See clouded west wall of room 305 that shows the folding partition panels along the west wall.

Item 2.8: Sheet A-403

Replace: The original sheets with the enclosed revised sheet dated 6/9/26.

Note: See clouded Detail 4A/A403 to include cast stone.

Item 2.9: Sheet A-501

Replace: The original sheets with the enclosed revised sheet dated 6/9/26.

Note: See clouded millwork detail references.

Item 2.10: Sheet A-502

Replace: The original sheets with the enclosed revised sheet dated 6/9/26.

Note: See clouded millwork detail references.

Item 2.11: Sheet A-503

Replace: The original sheets with the enclosed revised sheet dated 6/9/26.

Note: See wall guard at 3/A502 clouded millwork detail references.

Item 2.12: Sheet A-504

Replace: The original sheets with the enclosed revised sheet dated 6/9/26.

Note: See wall guard at 3/A502 clouded millwork detail references.

Item 2.13: Sheet A-505

Replace: The original sheets with the enclosed revised sheet dated 6/9/26.

Note: See wall guard at 3/A502 clouded millwork detail references.

Item 2.14: Sheet A-506

Replace: The original sheets with the enclosed revised sheet dated 6/9/26.



Note: See clouded millwork detail references.

Item 2.15: Sheet A-701


Replace: The original sheets with the enclosed revised sheet dated 6/9/26.

Note: See clouded millwork detail 5/A701.

End of Addendum No. 2

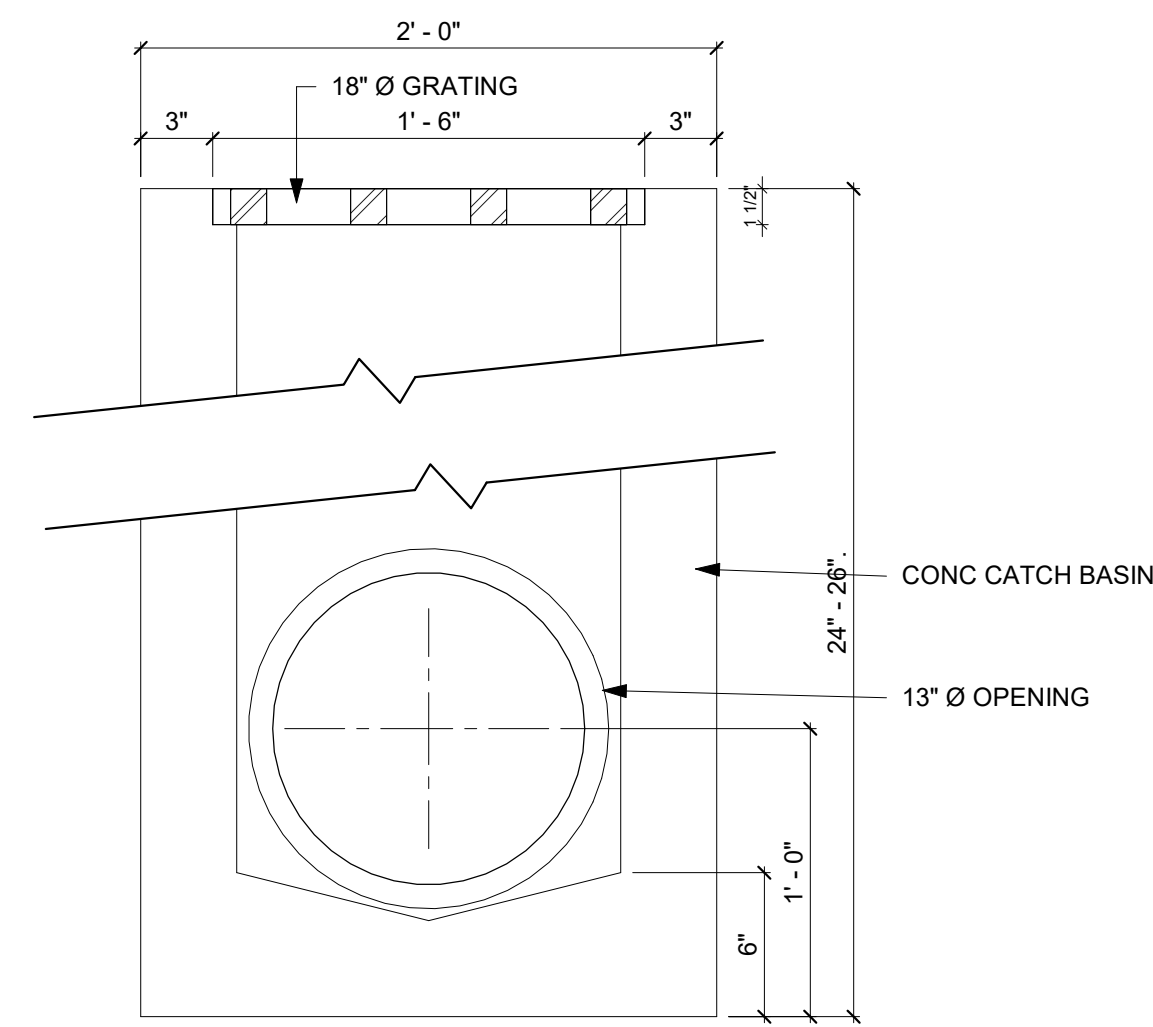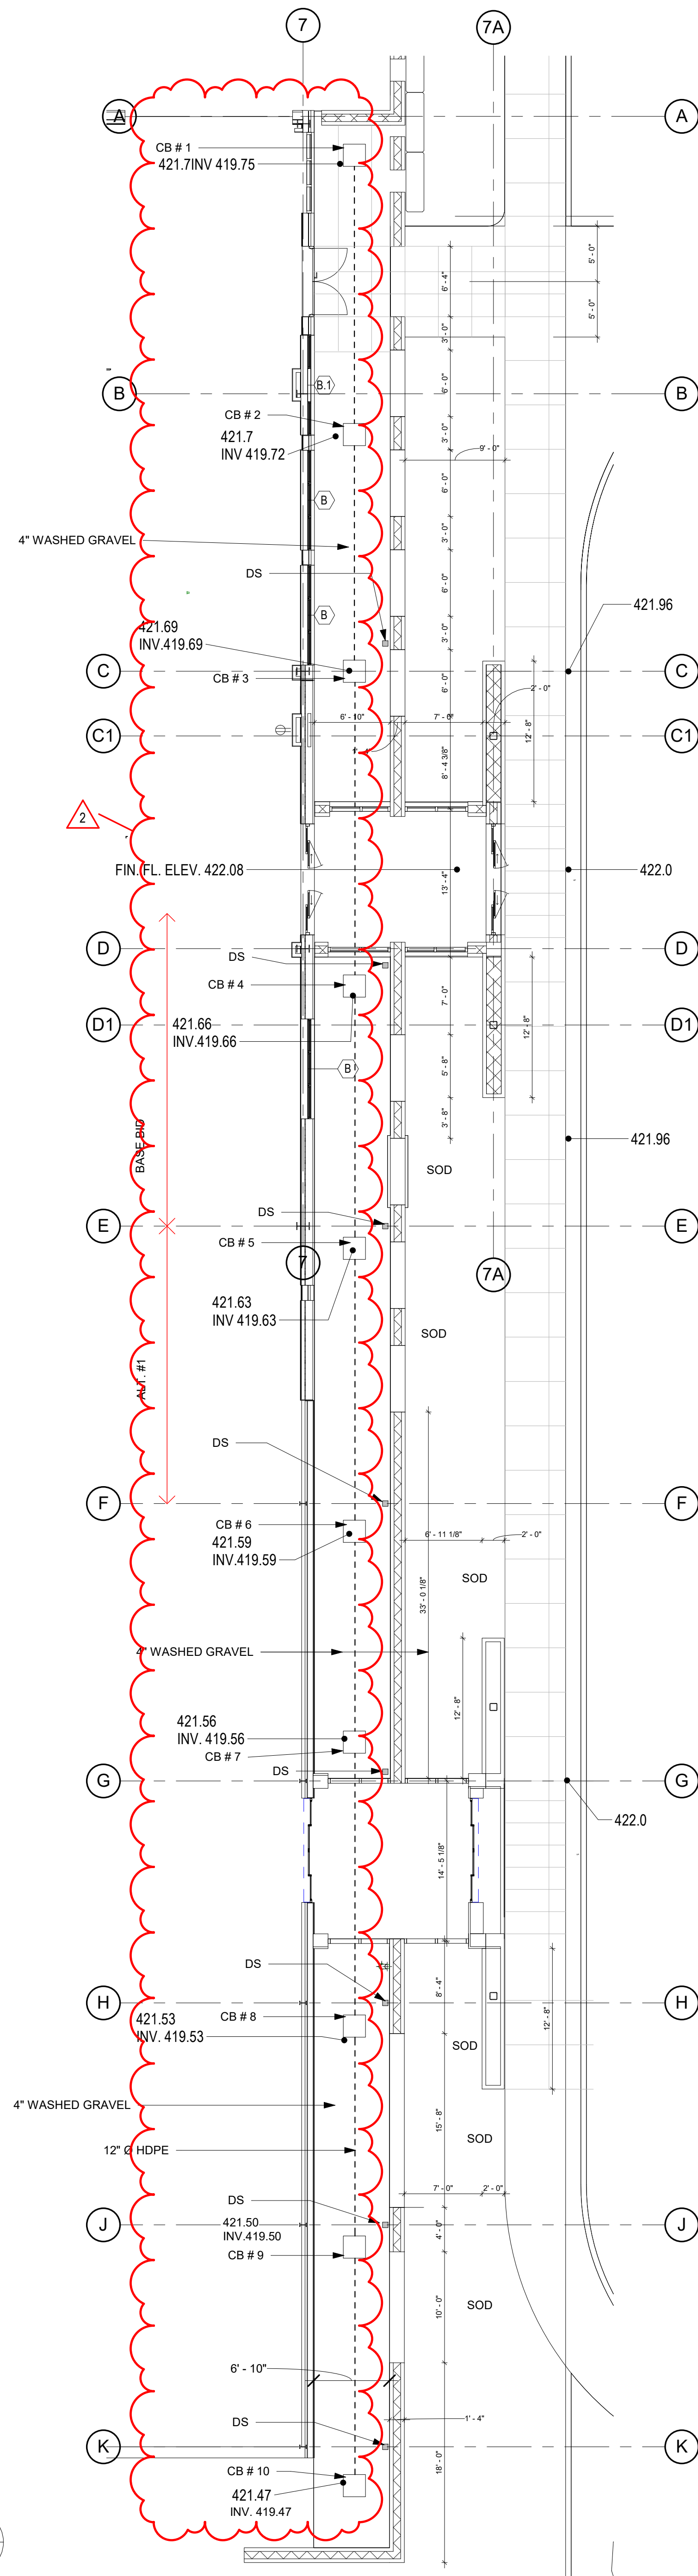

2 CATCH BASIN DETAILS
1 1/2" = 1'-0"

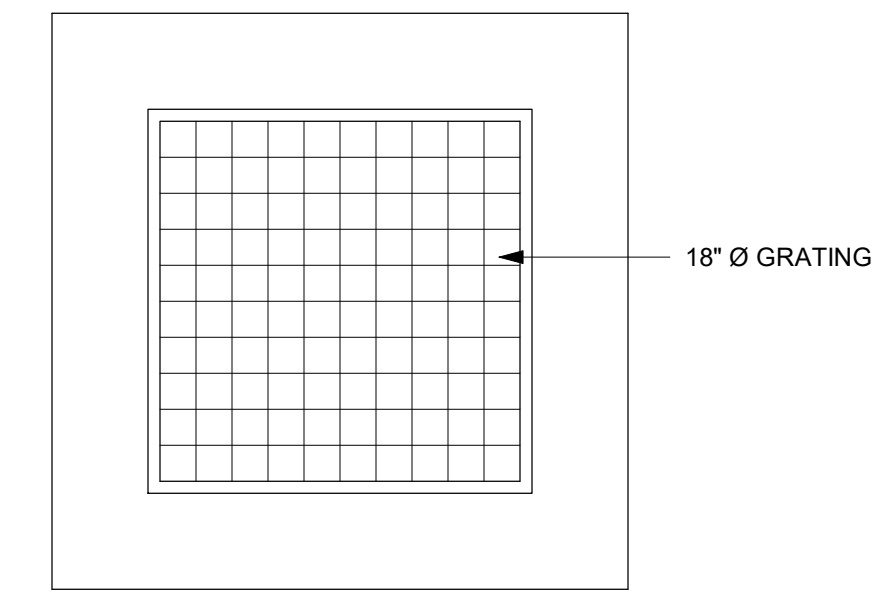


3 CATCH BASIN GRATING DETAILS
1 1/2" = 1'-0"

CATCH BASIN SCHEDULE:

	TOP	INV
CB.1	421.75	419.75
CB.2	421.72	419.72
CB.3	421.69	419.69
CB.4	421.66	419.66
CB.5	421.63	419.63
CB.6	421.59	419.59
CB.7	421.56	419.56
CB.8	421.53	419.53
CB.9	421.50	419.50
CB.10	421.47	419.47
OUTLET:		419.23

1 LEVEL 01_PARTIAL SITE PLAN
1/8" = 1'-0"

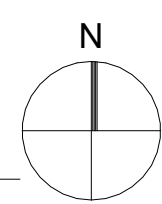

FoilWATT
Architects & Planners, PLLC
SUITE 200
150 NORTH STATE STREET
MEMPHIS, TN 38103
TELEPHONE: (901) 552-3071
FAX: (901) 552-3072
WWW.FOILWATT.COM

THE W NURSING SCHOOL
AT NESHOBIA GENERAL HOSPITAL


Philadelphia, MS 38350

project no.
1661 - 23
date
04 JUNE 2026

drawn by
DLC

SITE DRAINAGE
PLAN

sheet no.
C-103

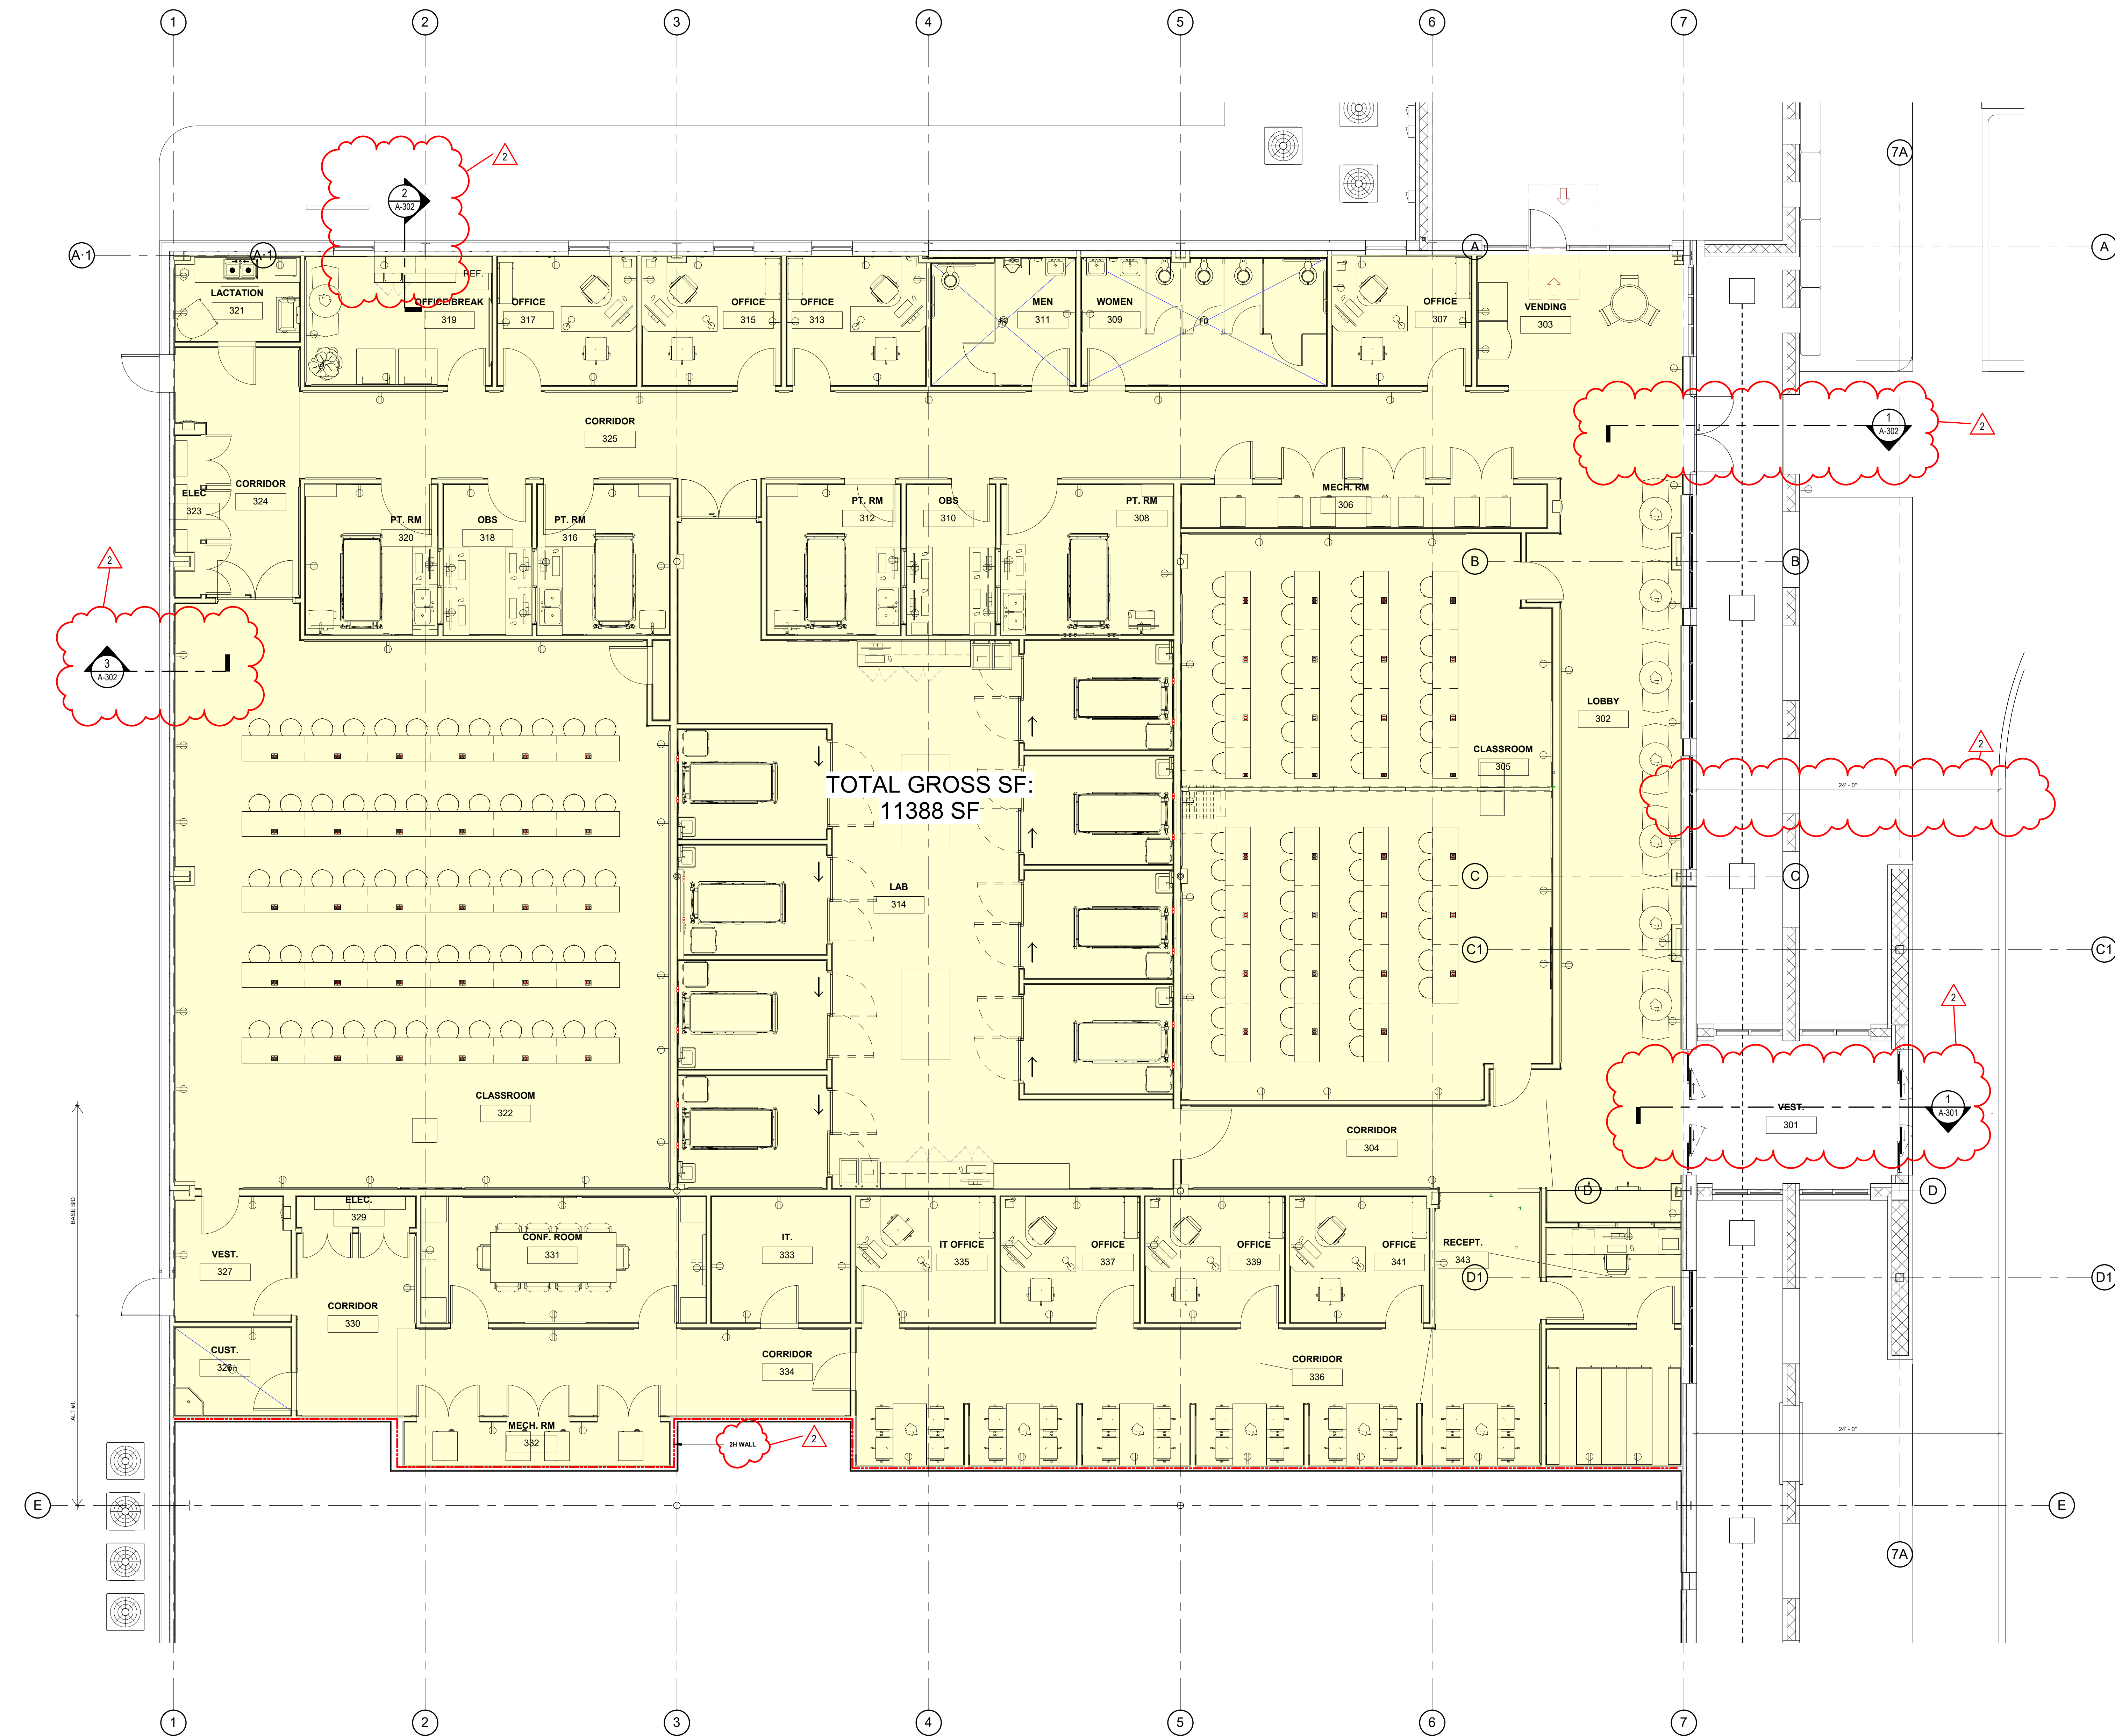

AREA PLAN
SCALE: 3/16" = 1' - 0"

1
A-105



FoilWATT
Architects & Planners, PLLC
SUITE 200
150 NORTH STATE STREET
MEMPHIS, TN 38103
TELEPHONE (901) 552-3071
FAX (901) 552-3071
WWW.FOILWATT.COM

THE W NURSING SCHOOL
AT Neshoba General Hospital

Philadelphia, MS 38350


project no.
1661 - 23
date
04 JUNE 2026
revised
6-9-2026

drawn by
DLC


AREA PLAN

sheet no.
A-101
of

CONSTRUCTION DOCUMENTS

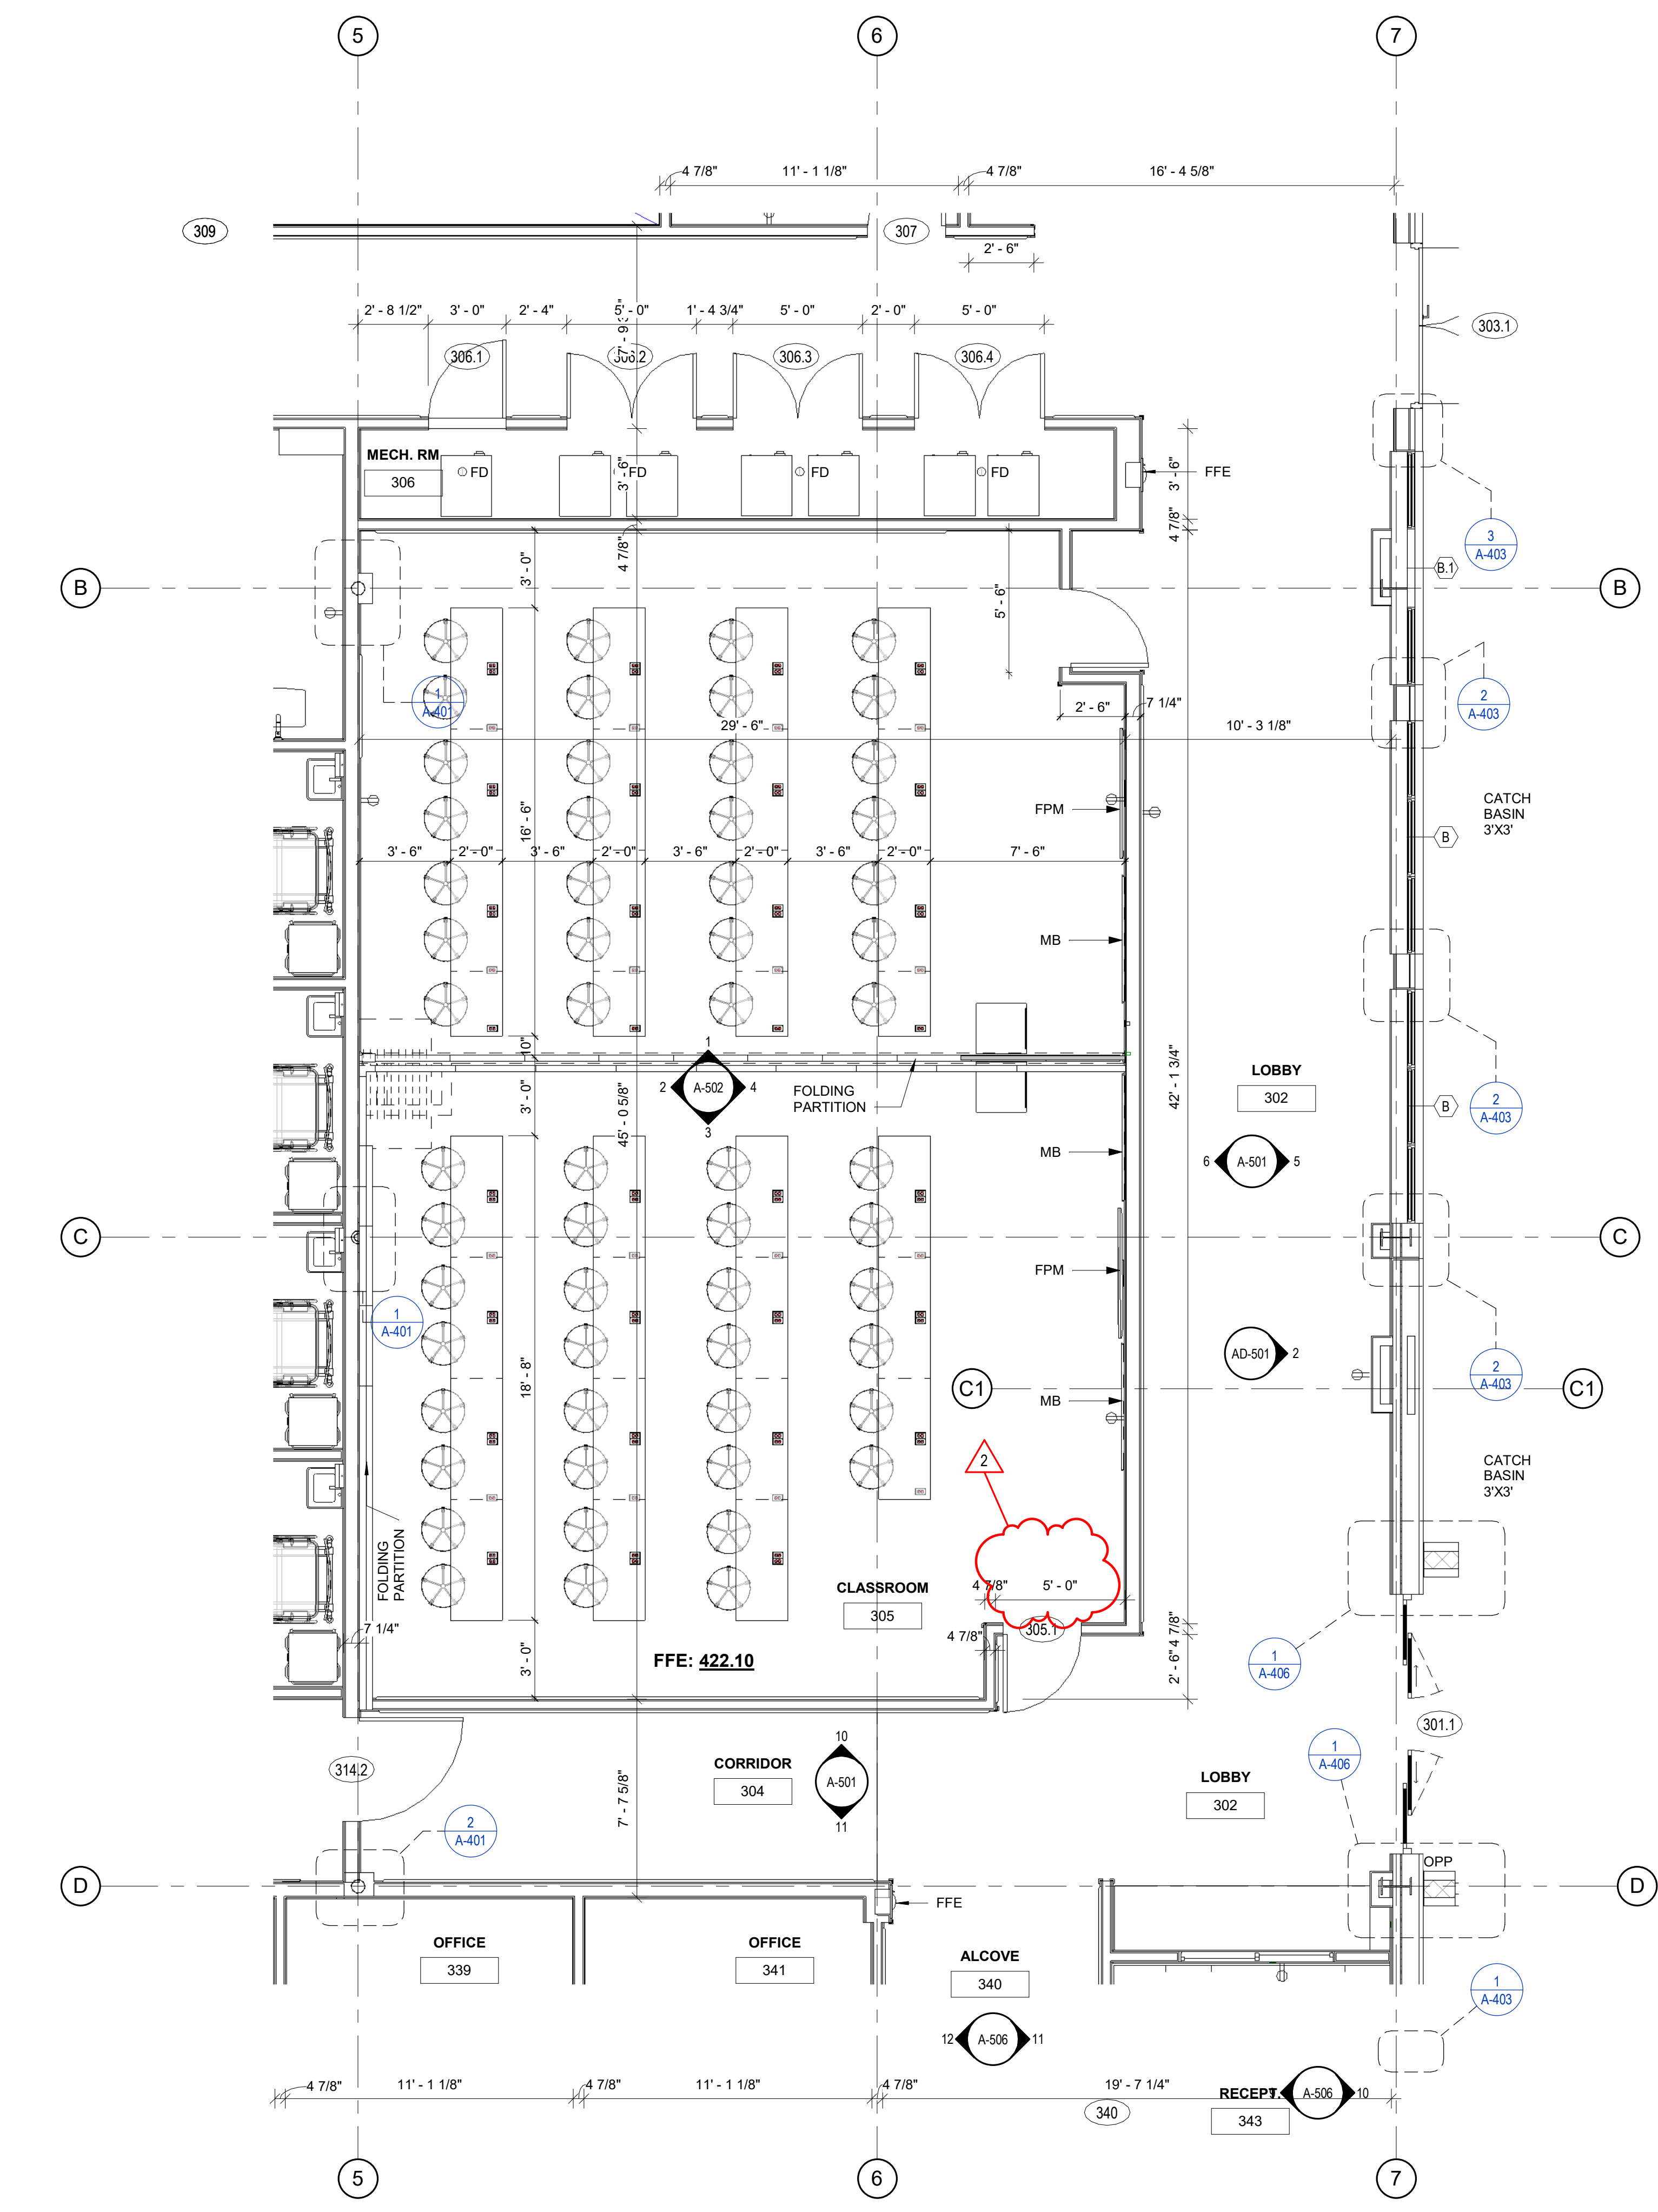

1 FLOOR PLAN NORTH
1/4" = 1'-0"

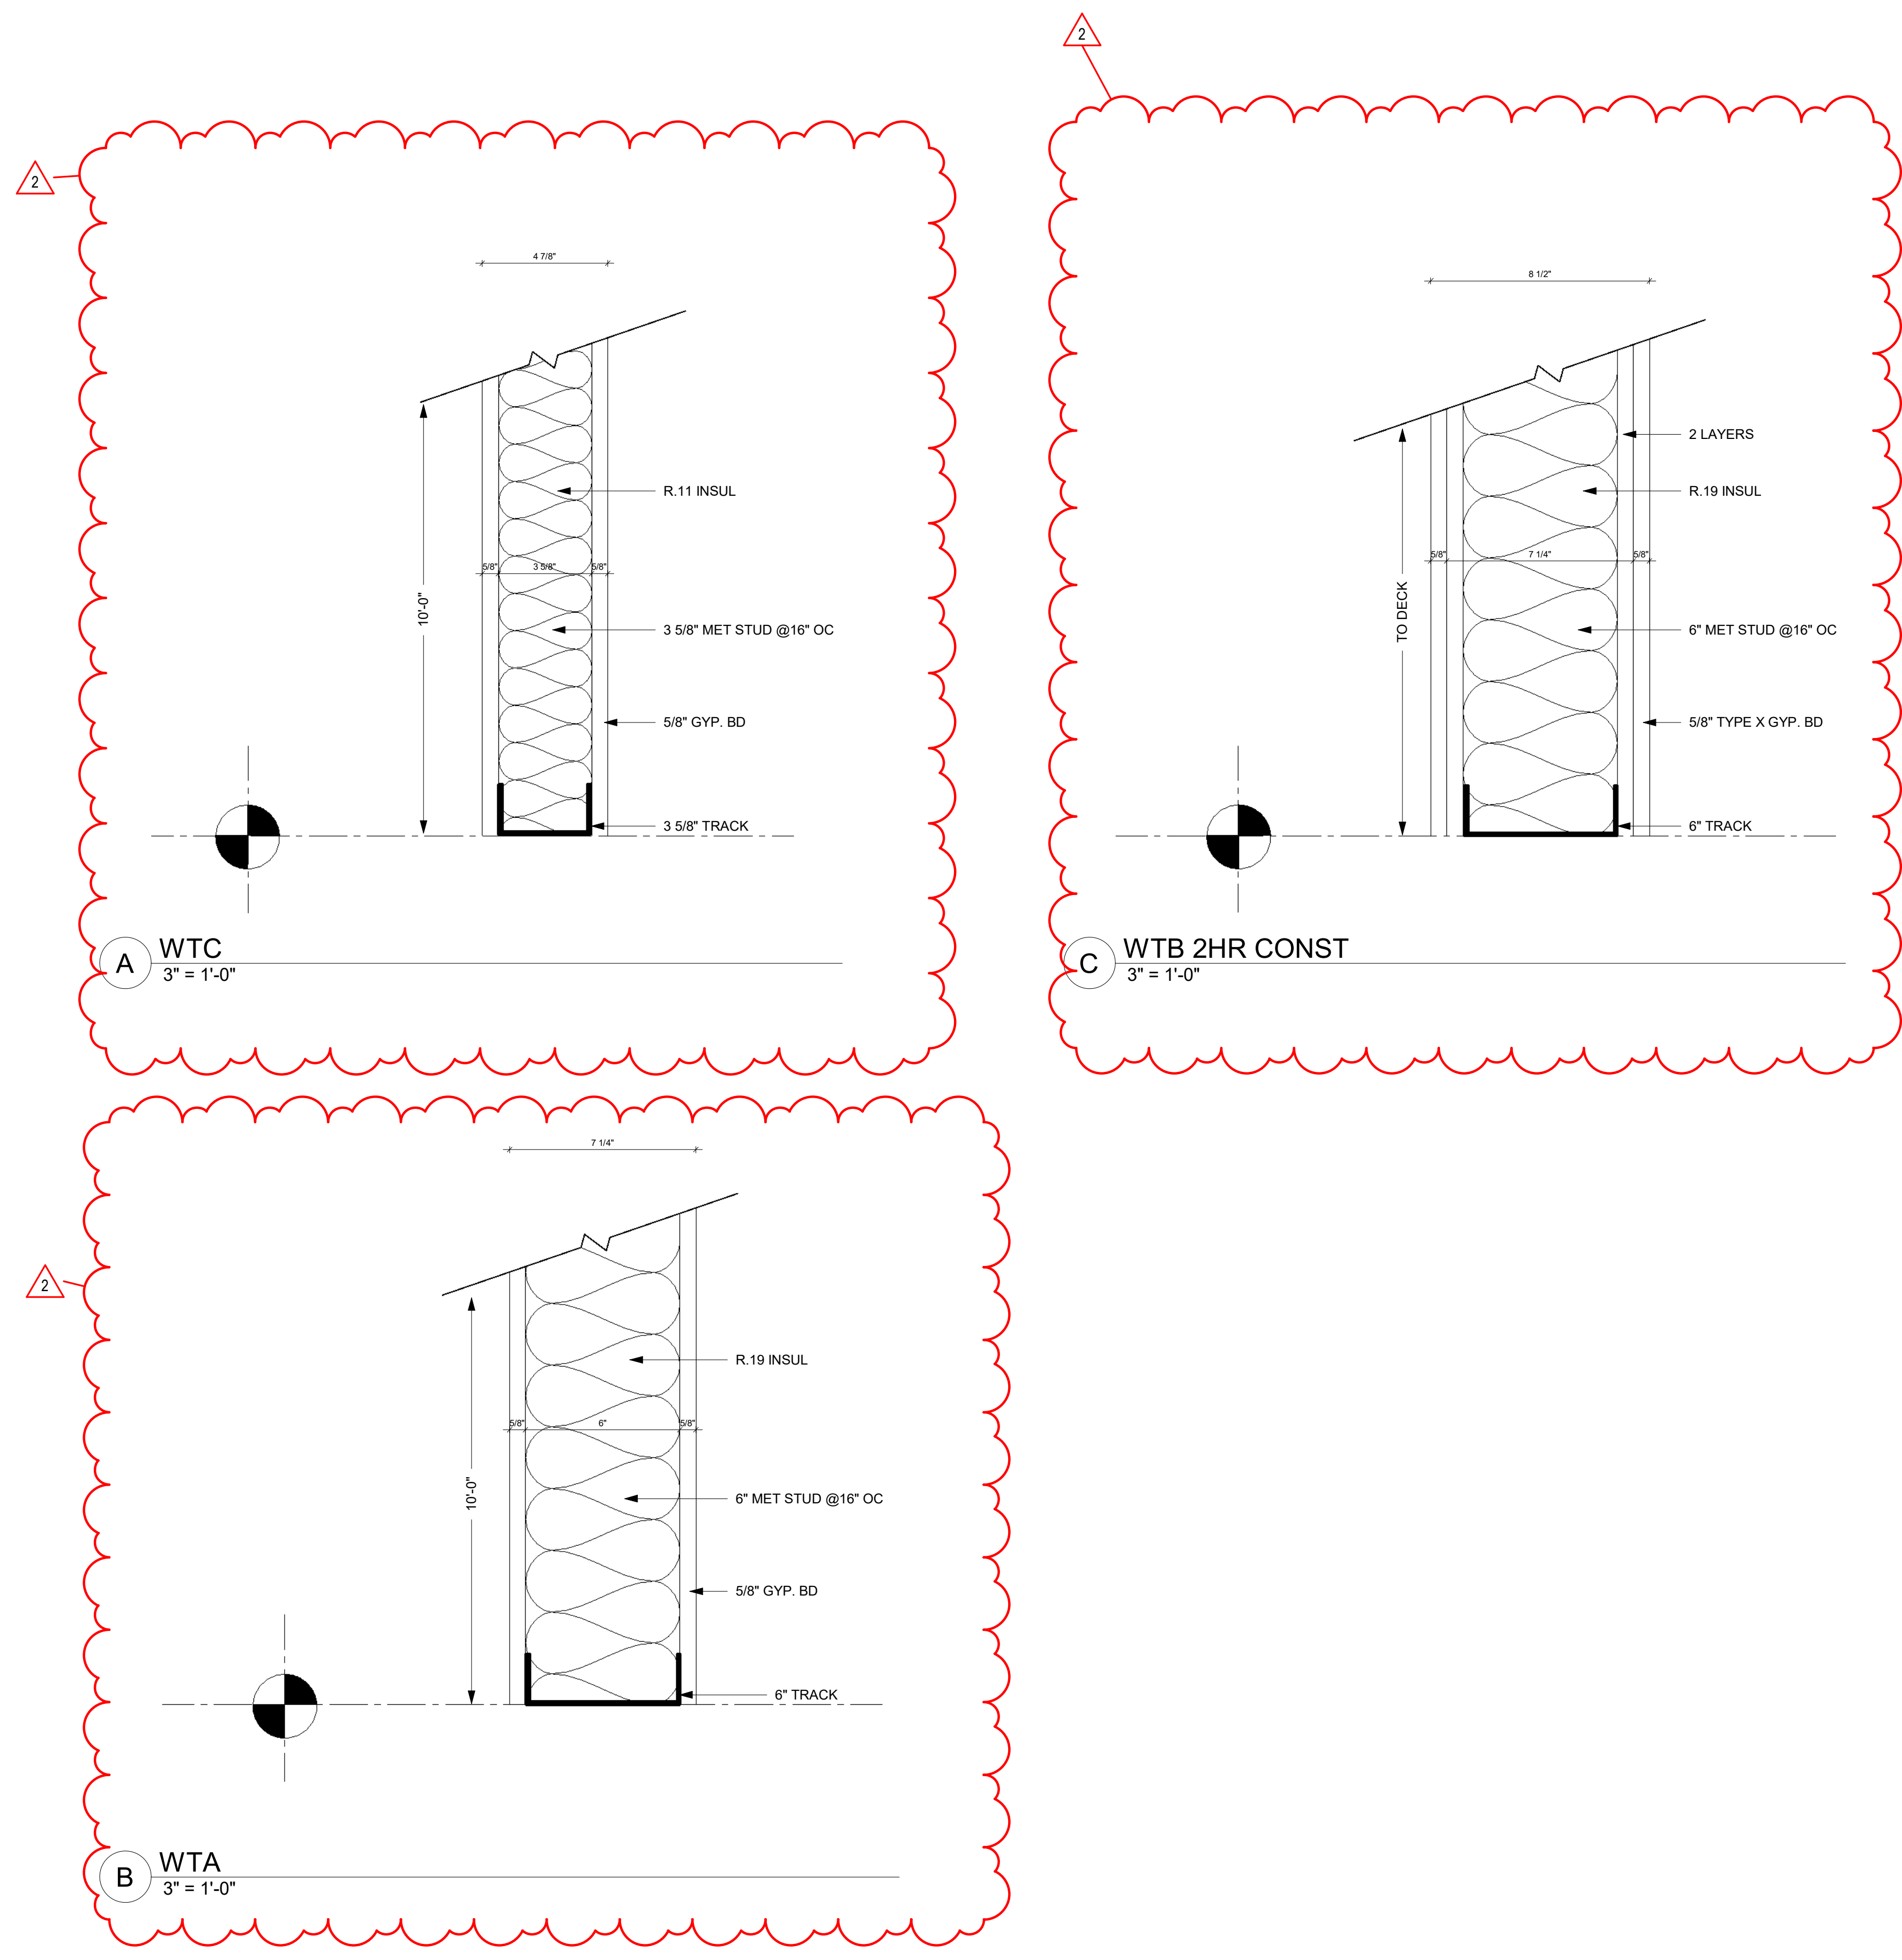

FoilWatt
Architects & Planners, PLLC
SUITE 200
1500 NORTH STATE STREET
MEMPHIS, TN 38103
TELEPHONE (901) 552-3711
FAX (901) 552-3711
WWW.FOILWATT.COM

THE W NURSING SCHOOL
AT NESHOBIA GENERAL HOSPITAL
Philadelphia, MS 38350

project no.
1661 - 23
date
04 JUNE 2026
revised
2 6-9-2026

drawn by
DLC

ENLARGED FP-
CLASSROOM 305

sheet no.
A-103
of

THE W NURSING SCHOOL
AT NESHOPA GENERAL HOSPITAL

Philadelphia, MS 39350

project no.
1661 - 23

date
04 JUNE 2026


revised
6.9.2026

drawn by
DLC

CLASS ROOM PLANS


sheet no.

A-105





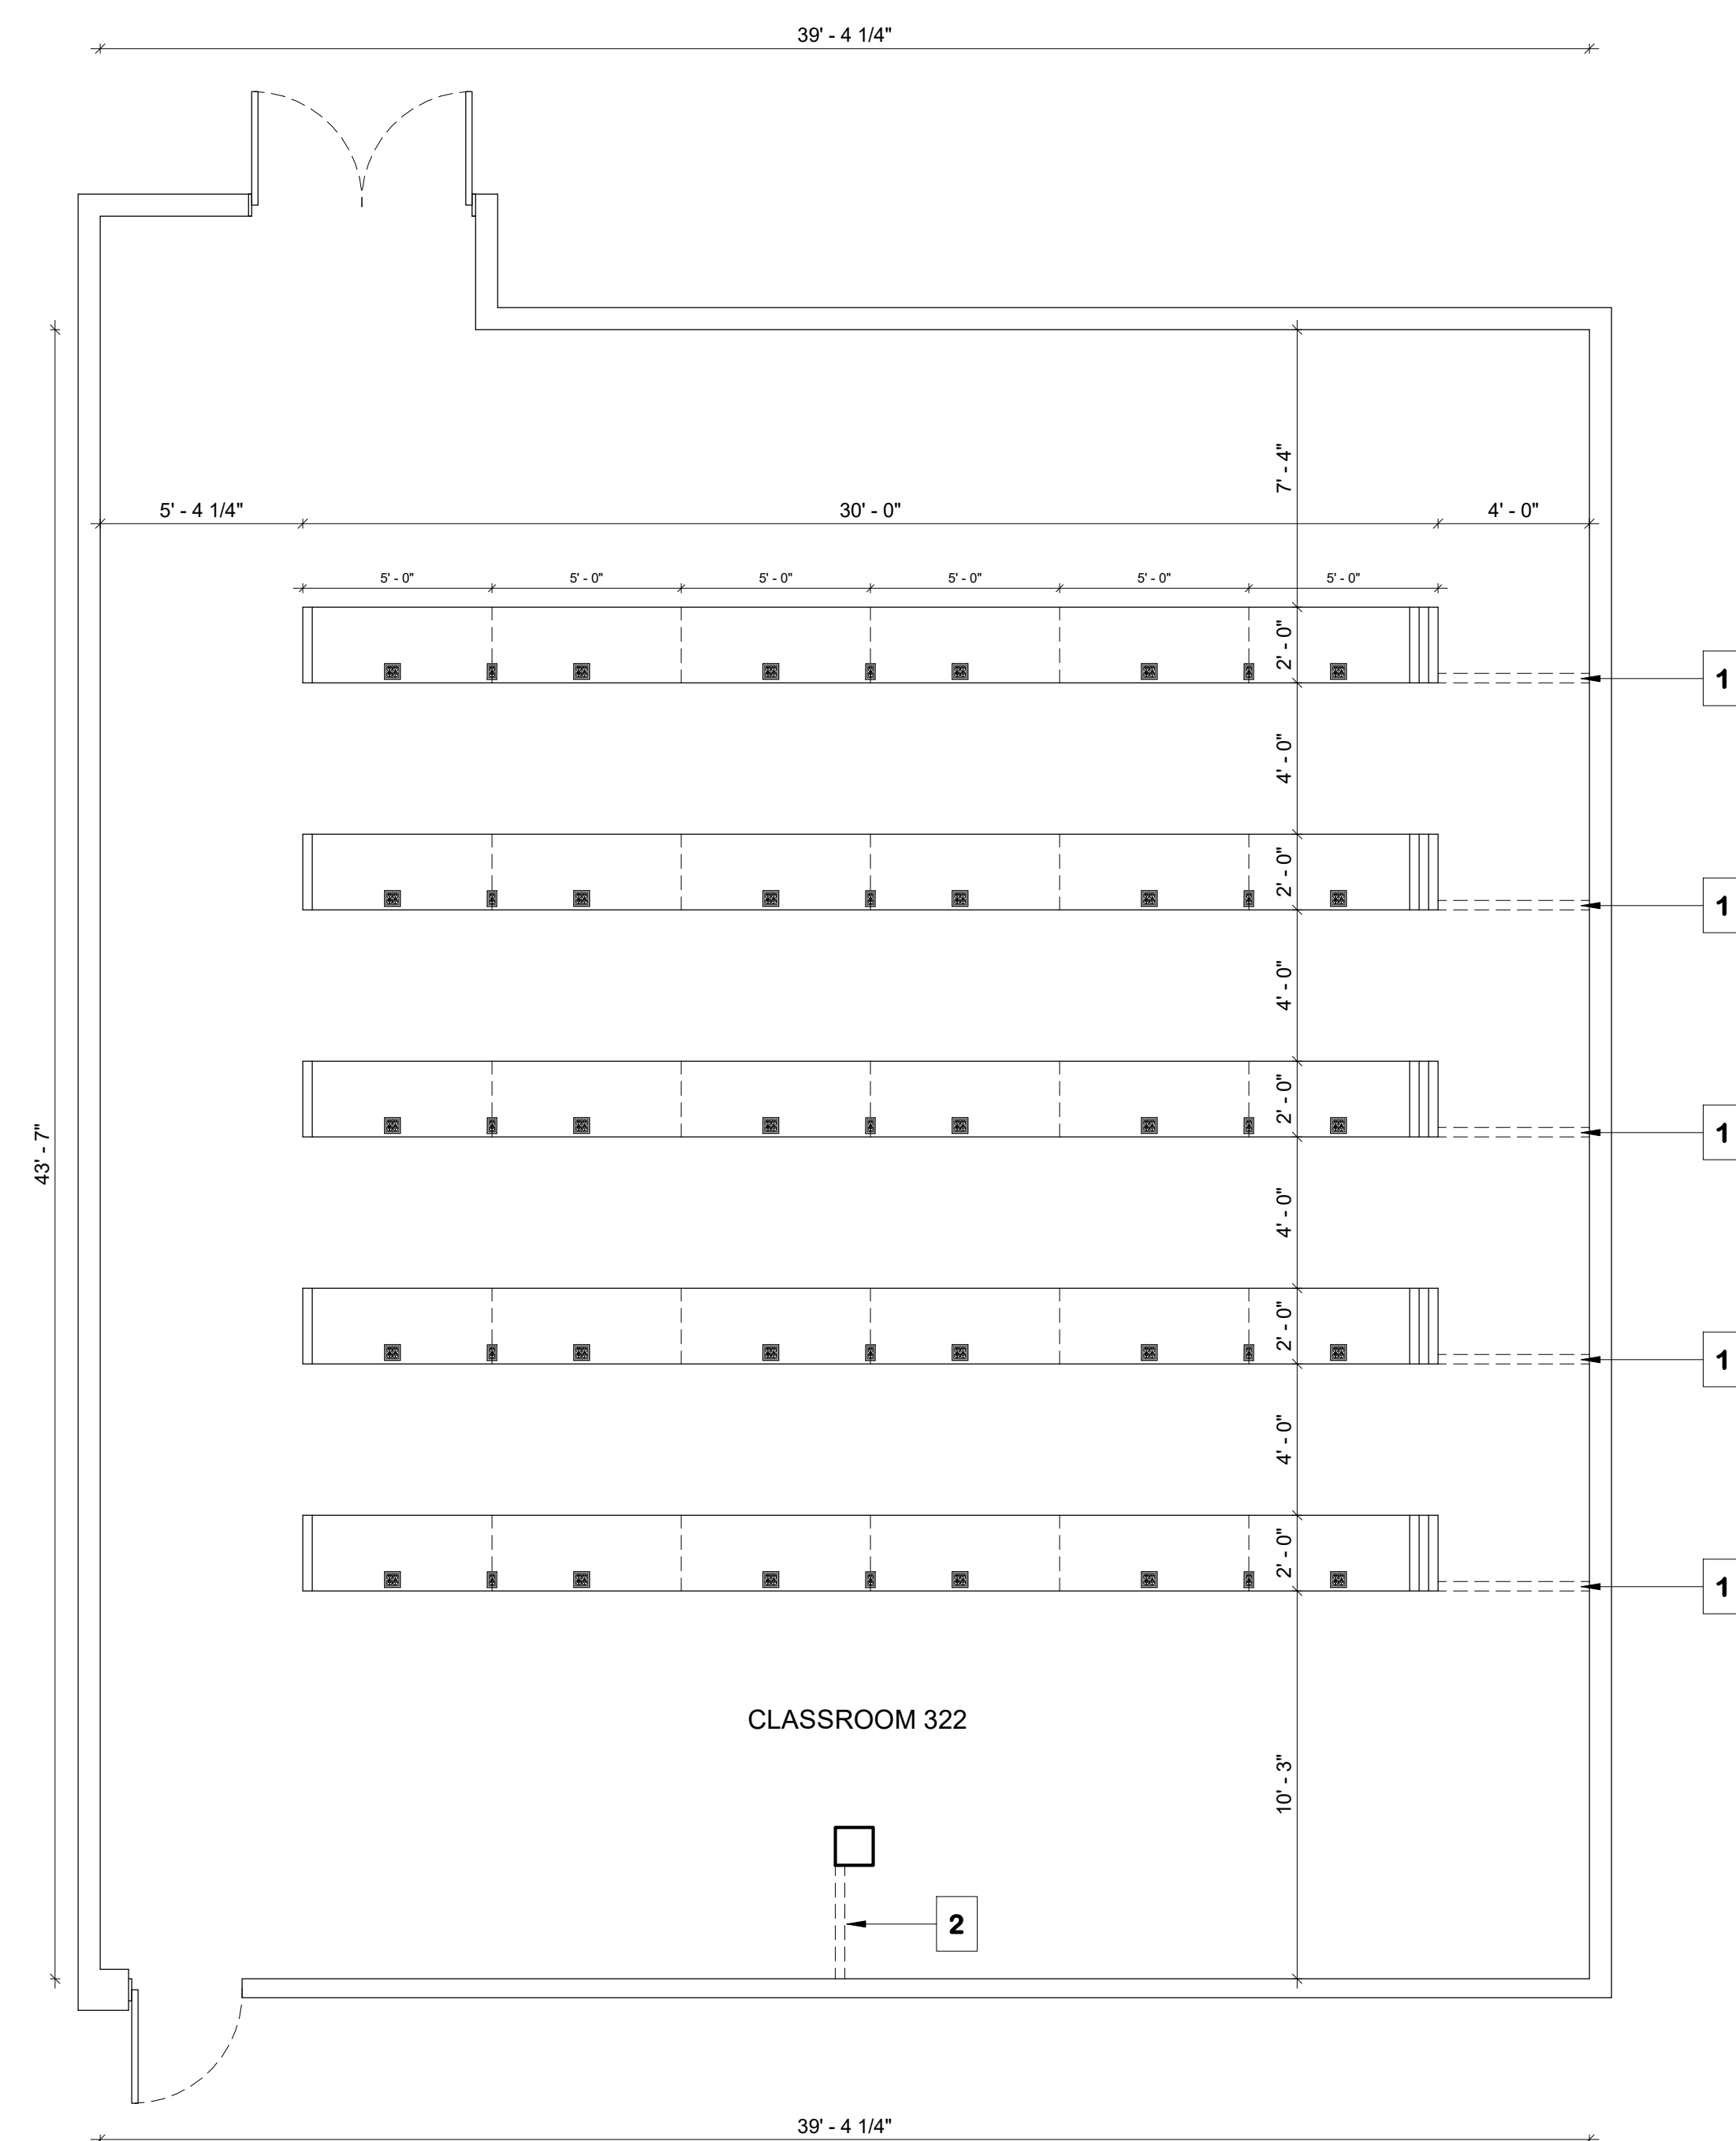


NOTE 1: REMOVE 12" WIDE X 5'-0"
SECTION OF EXISTING CONC.
SLAB FOR 3 EA CONDUITS

NOTE 2: REMOVE 8" WIDE X 4'-0"
SECTION OF EXISTING CONC.
SLAB FOR 1 EA POWER CONDUIT
AND 1 EA DATA CONDUIT TERMINATE
IN FLOOR BOX

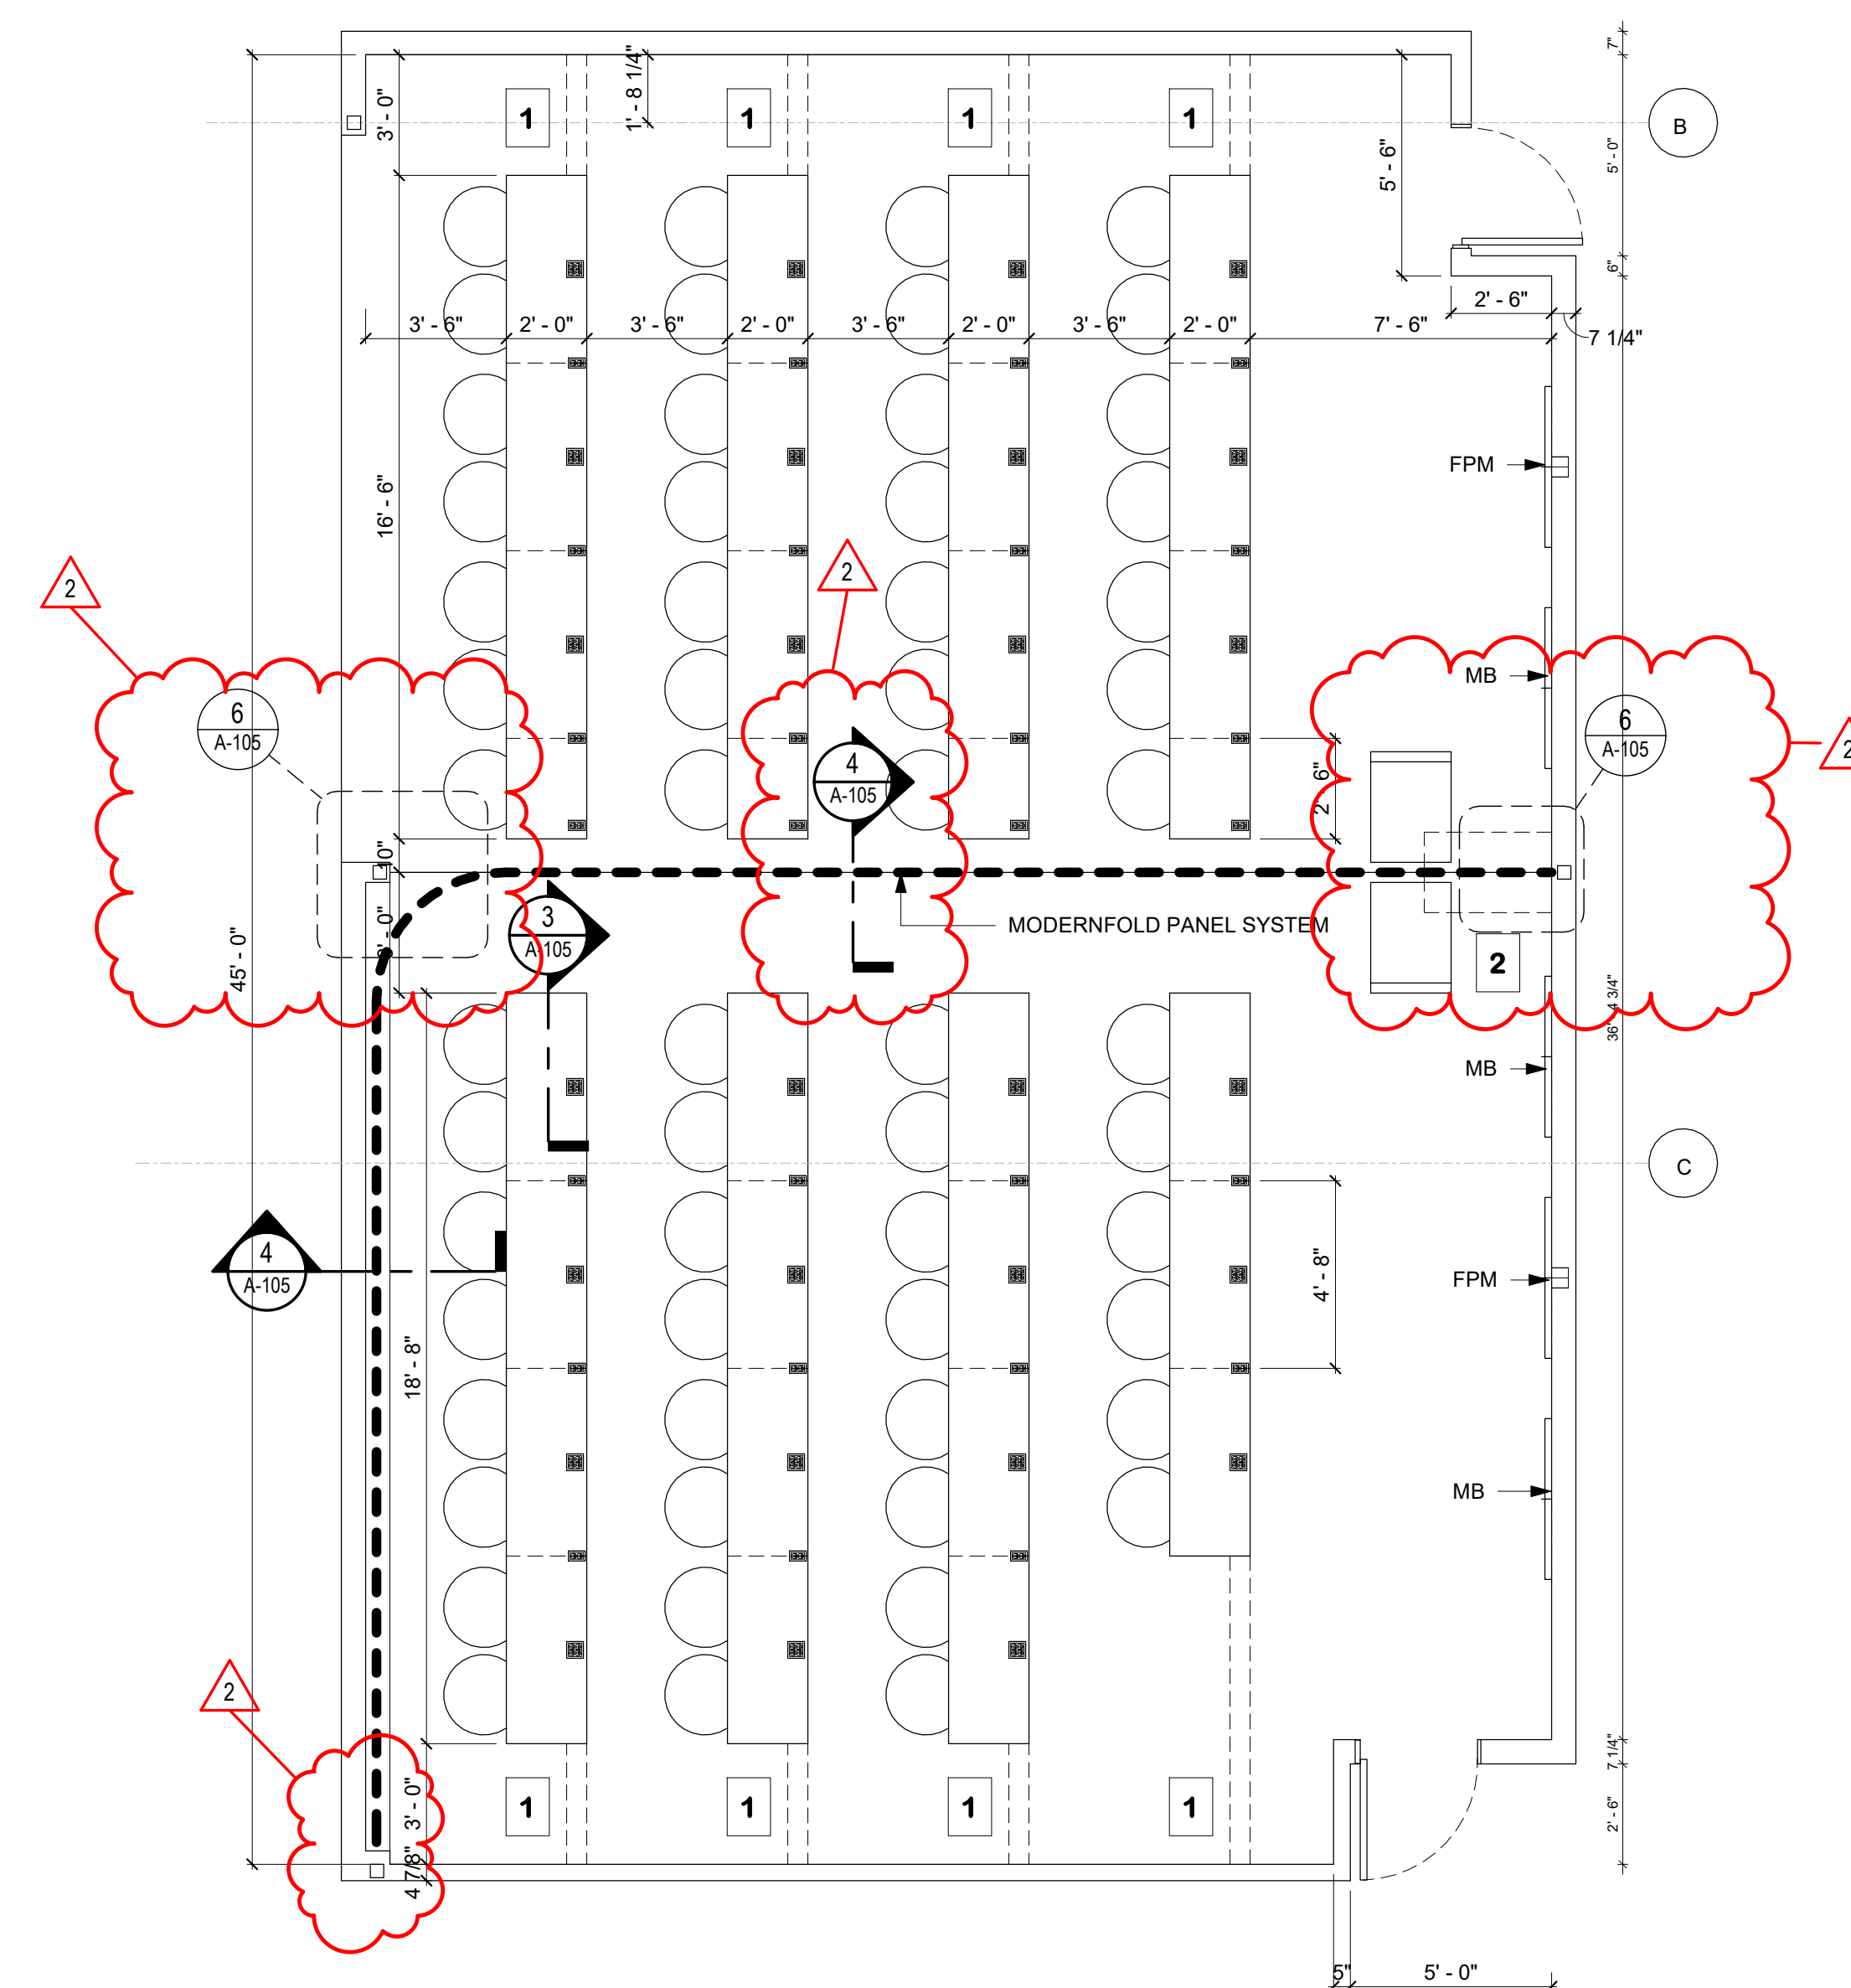

NOTE 1:	REMOVE 12" WIDE X 48" SLAB TO INSTALL POWER CONDUITS
NOTE 2:	REMOVE 24" WIDE X 36" SLAB TO INSTALL POWER & DATA CONDUIT

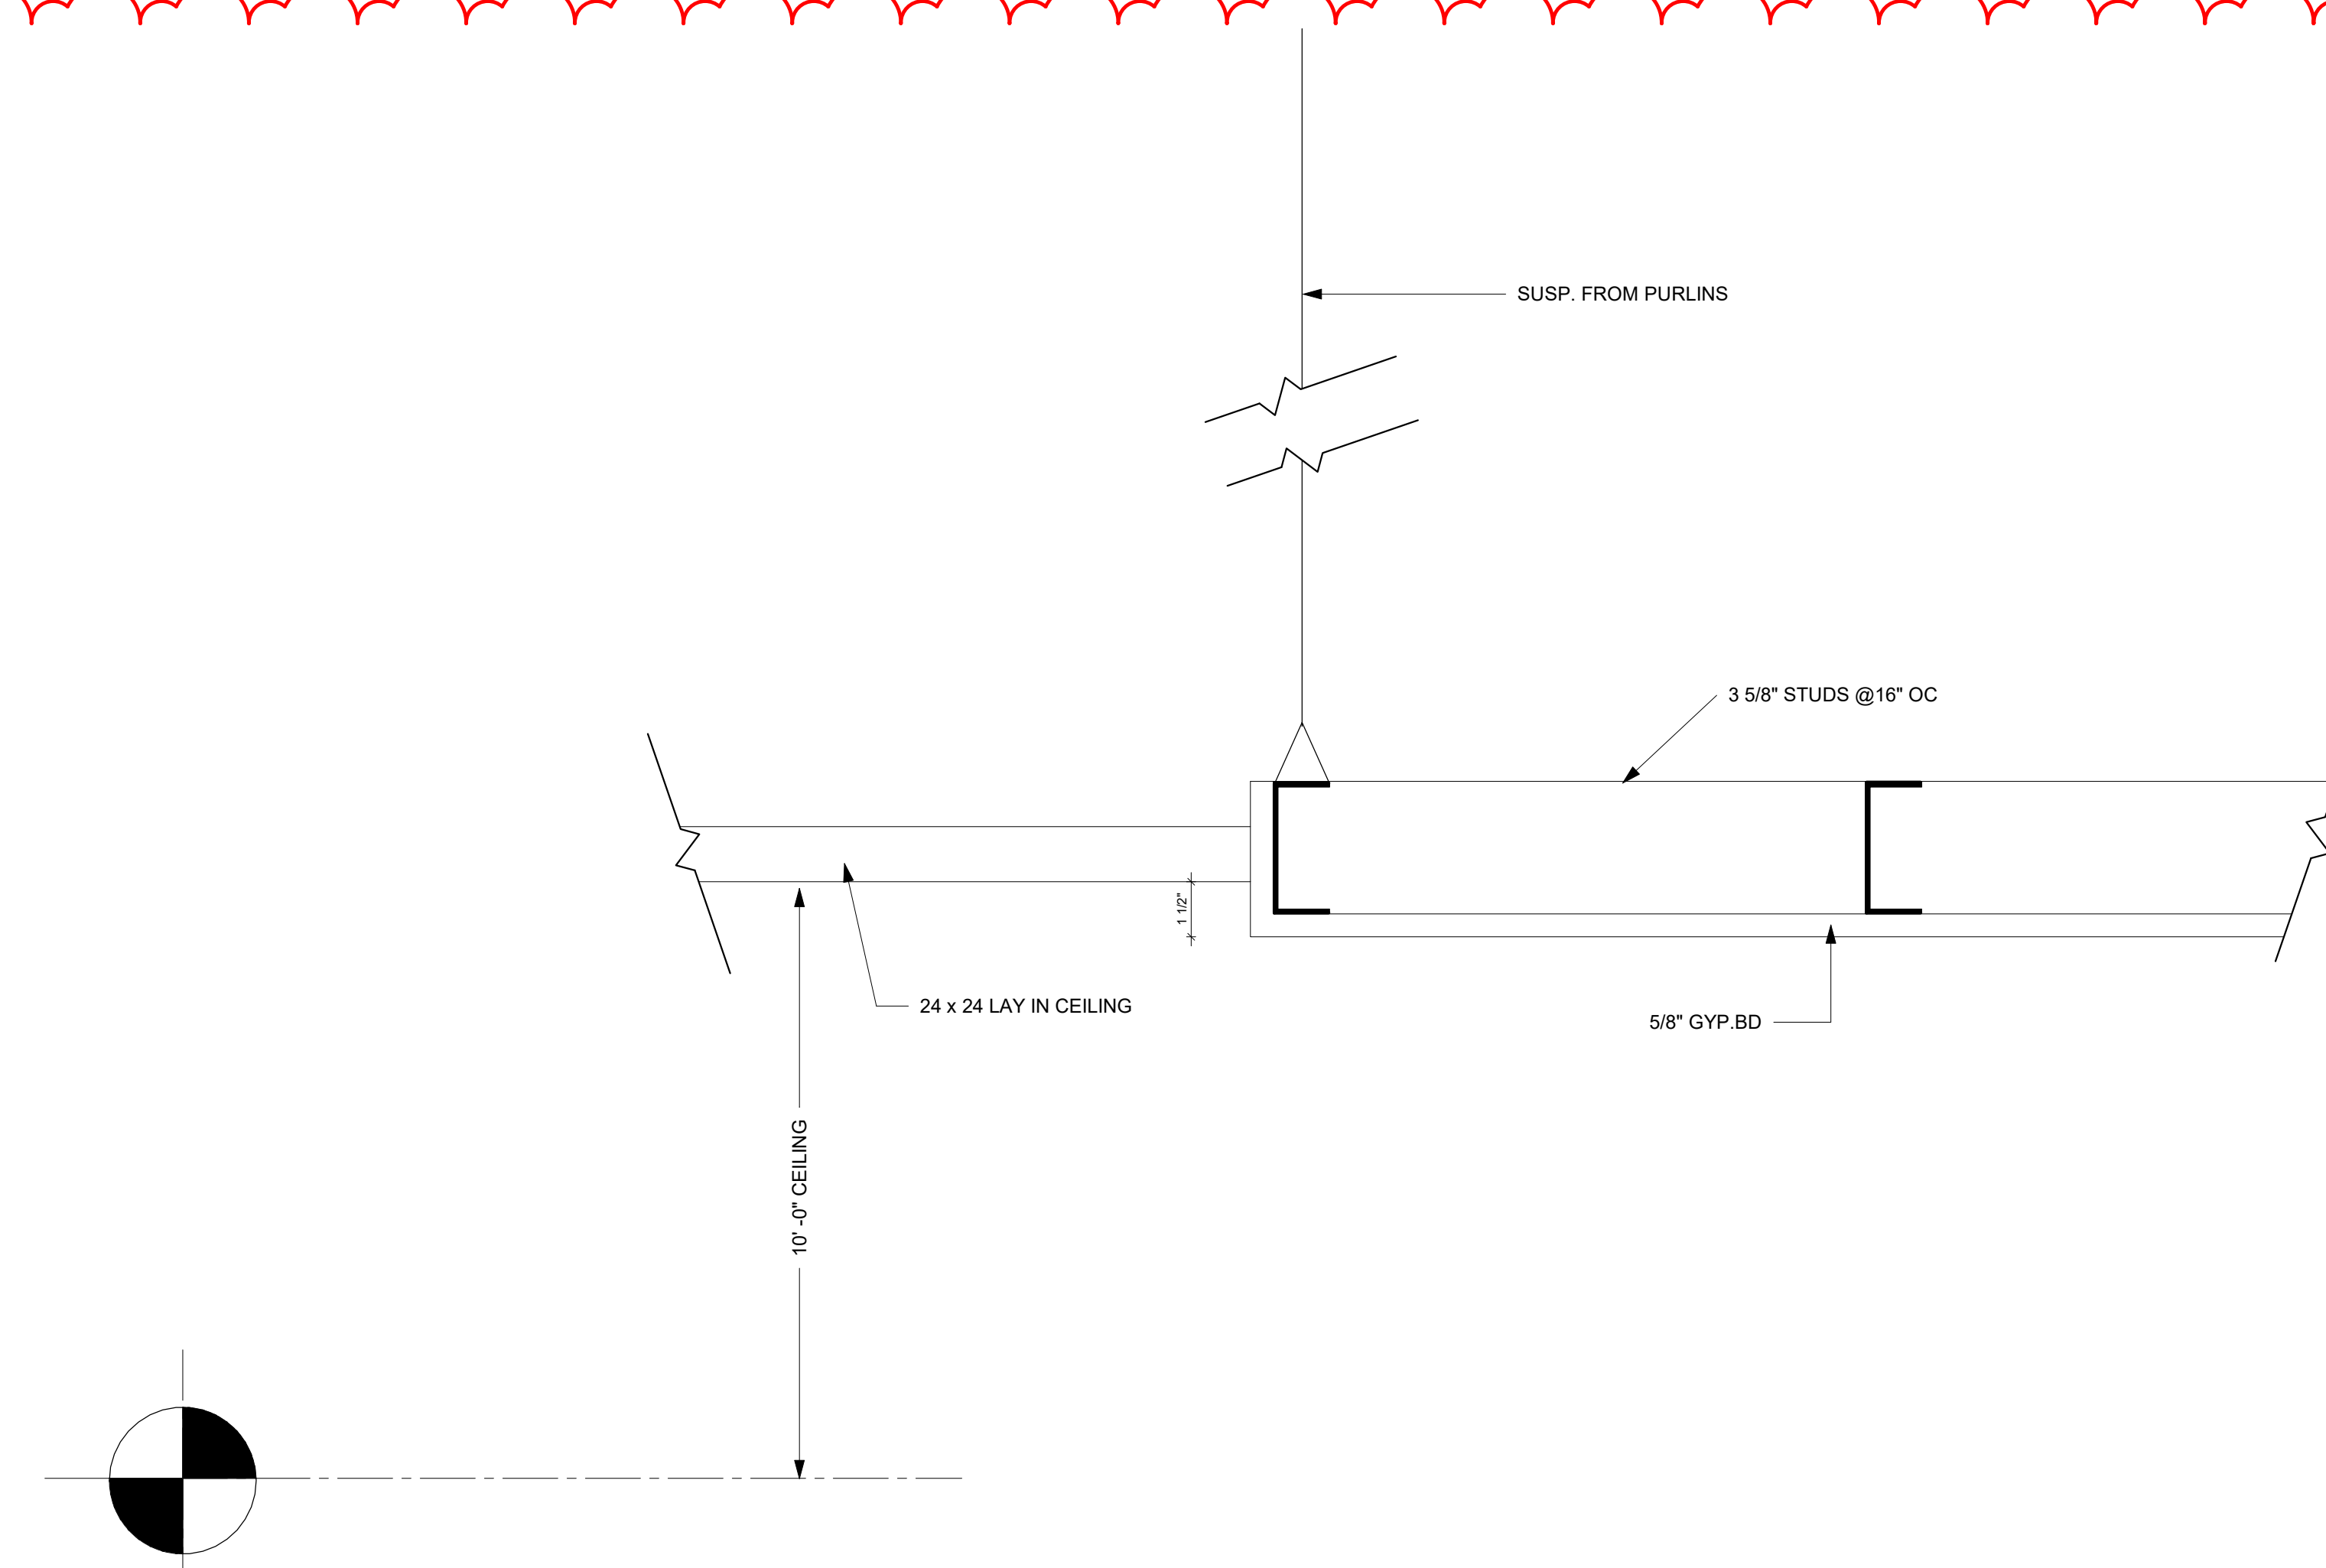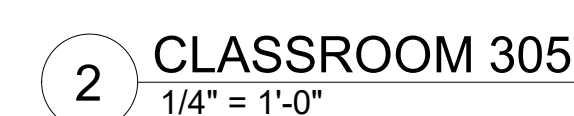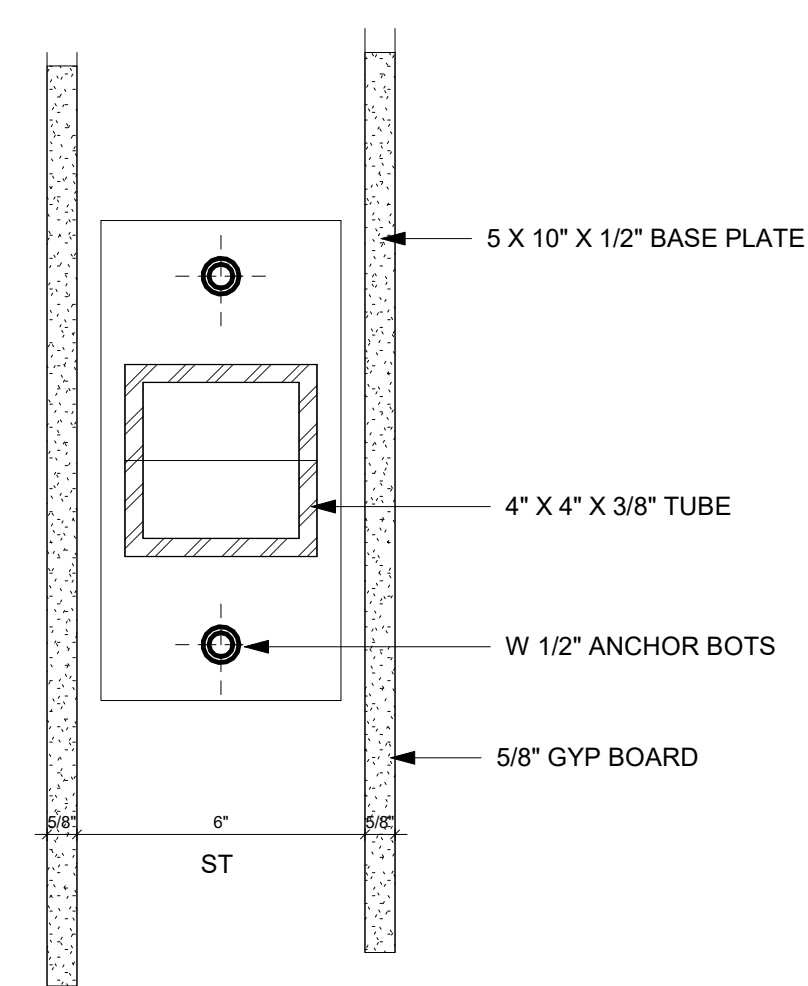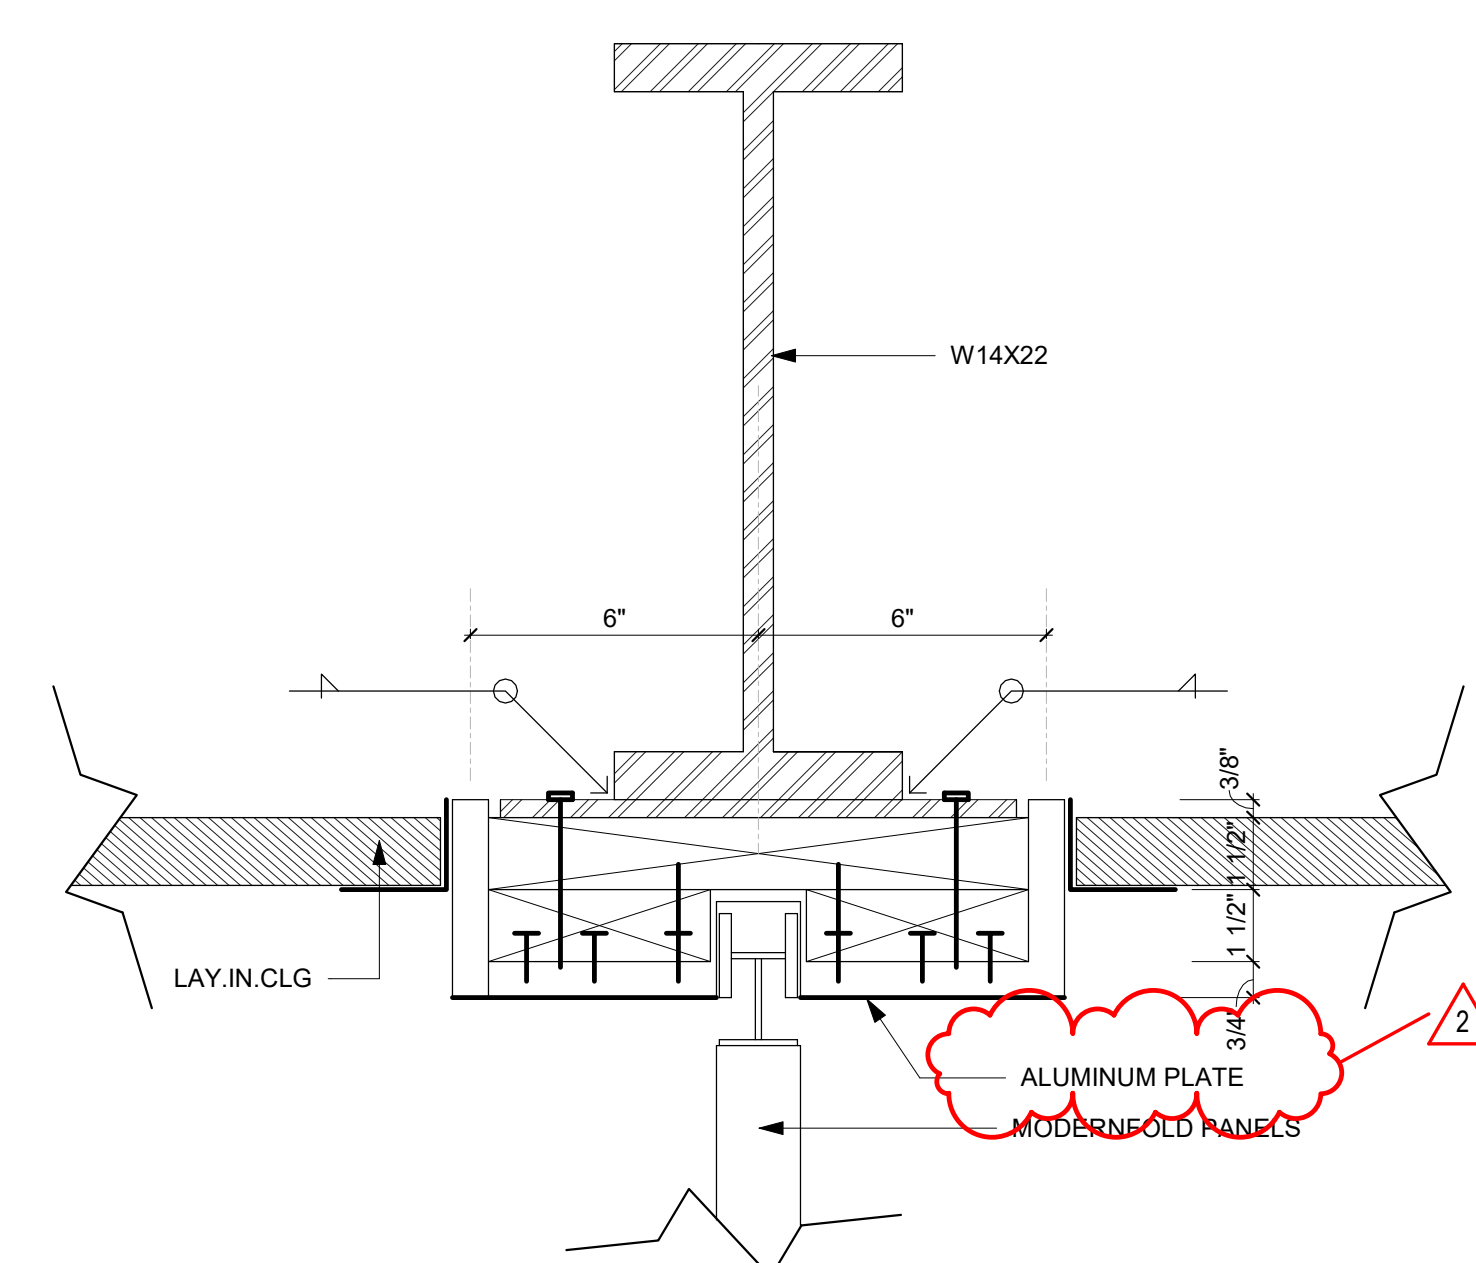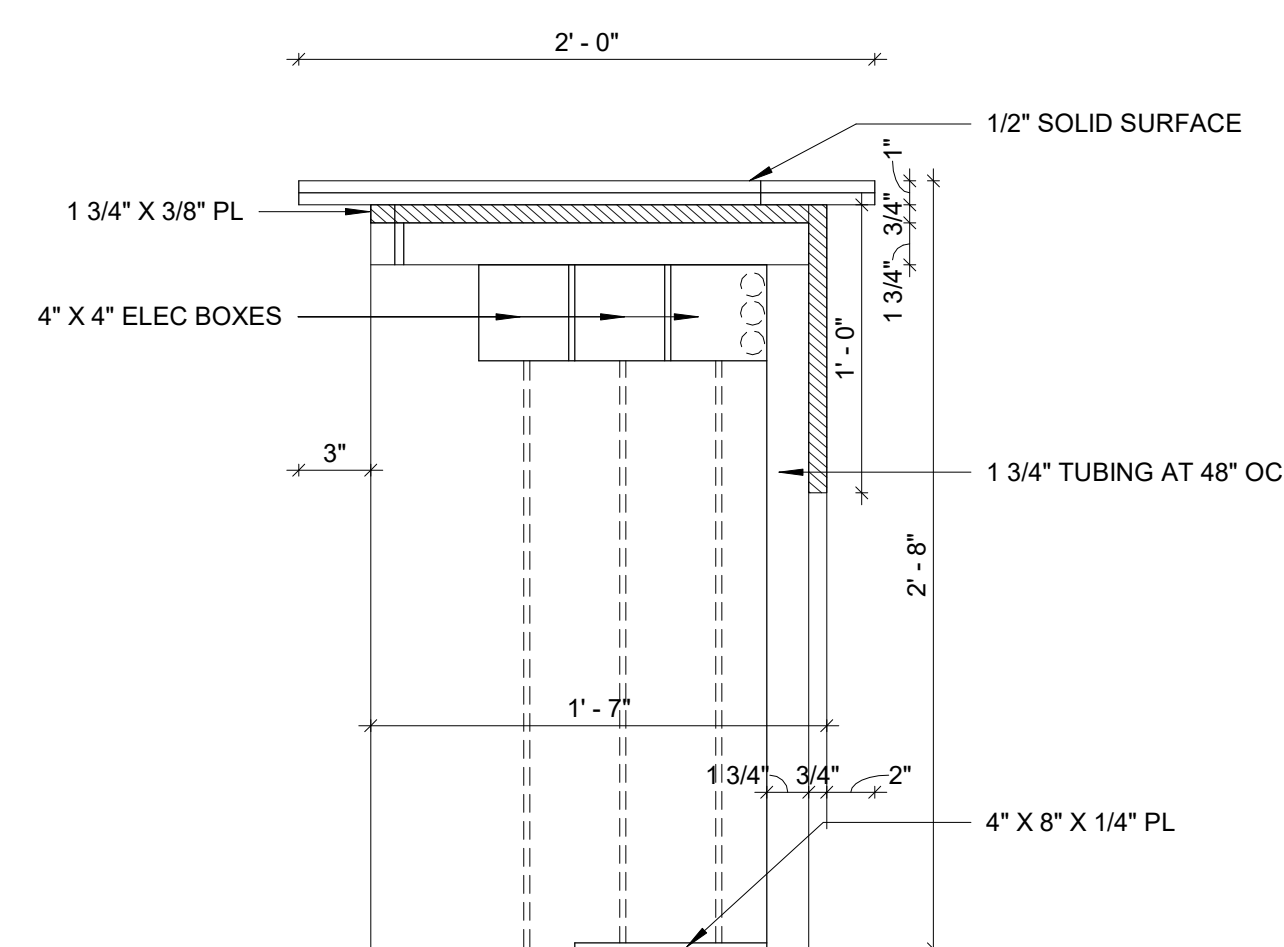

CONSTRUCTION DOCUMENTS



FoilWatt
Architects & Planners, PLLC
SUITE 200
150 NORTH STATE STREET
MEMPHIS, TN 38103
TELEPHONE (901) 555-3071
FAX (901) 555-3071
WWW.FOILWATT.COM

THE W NURSING SCHOOL
AT NESHOBIA GENERAL HOSPITAL

Philadelphia, MS 38350


project no.
1661 - 23
date
04 JUNE 2026
revised
2 6-9-2026

drawn by
DLC


**REFLECTED
CEILING PLAN**

sheet no.
A-106
of


CONSTRUCTION DOCUMENTS

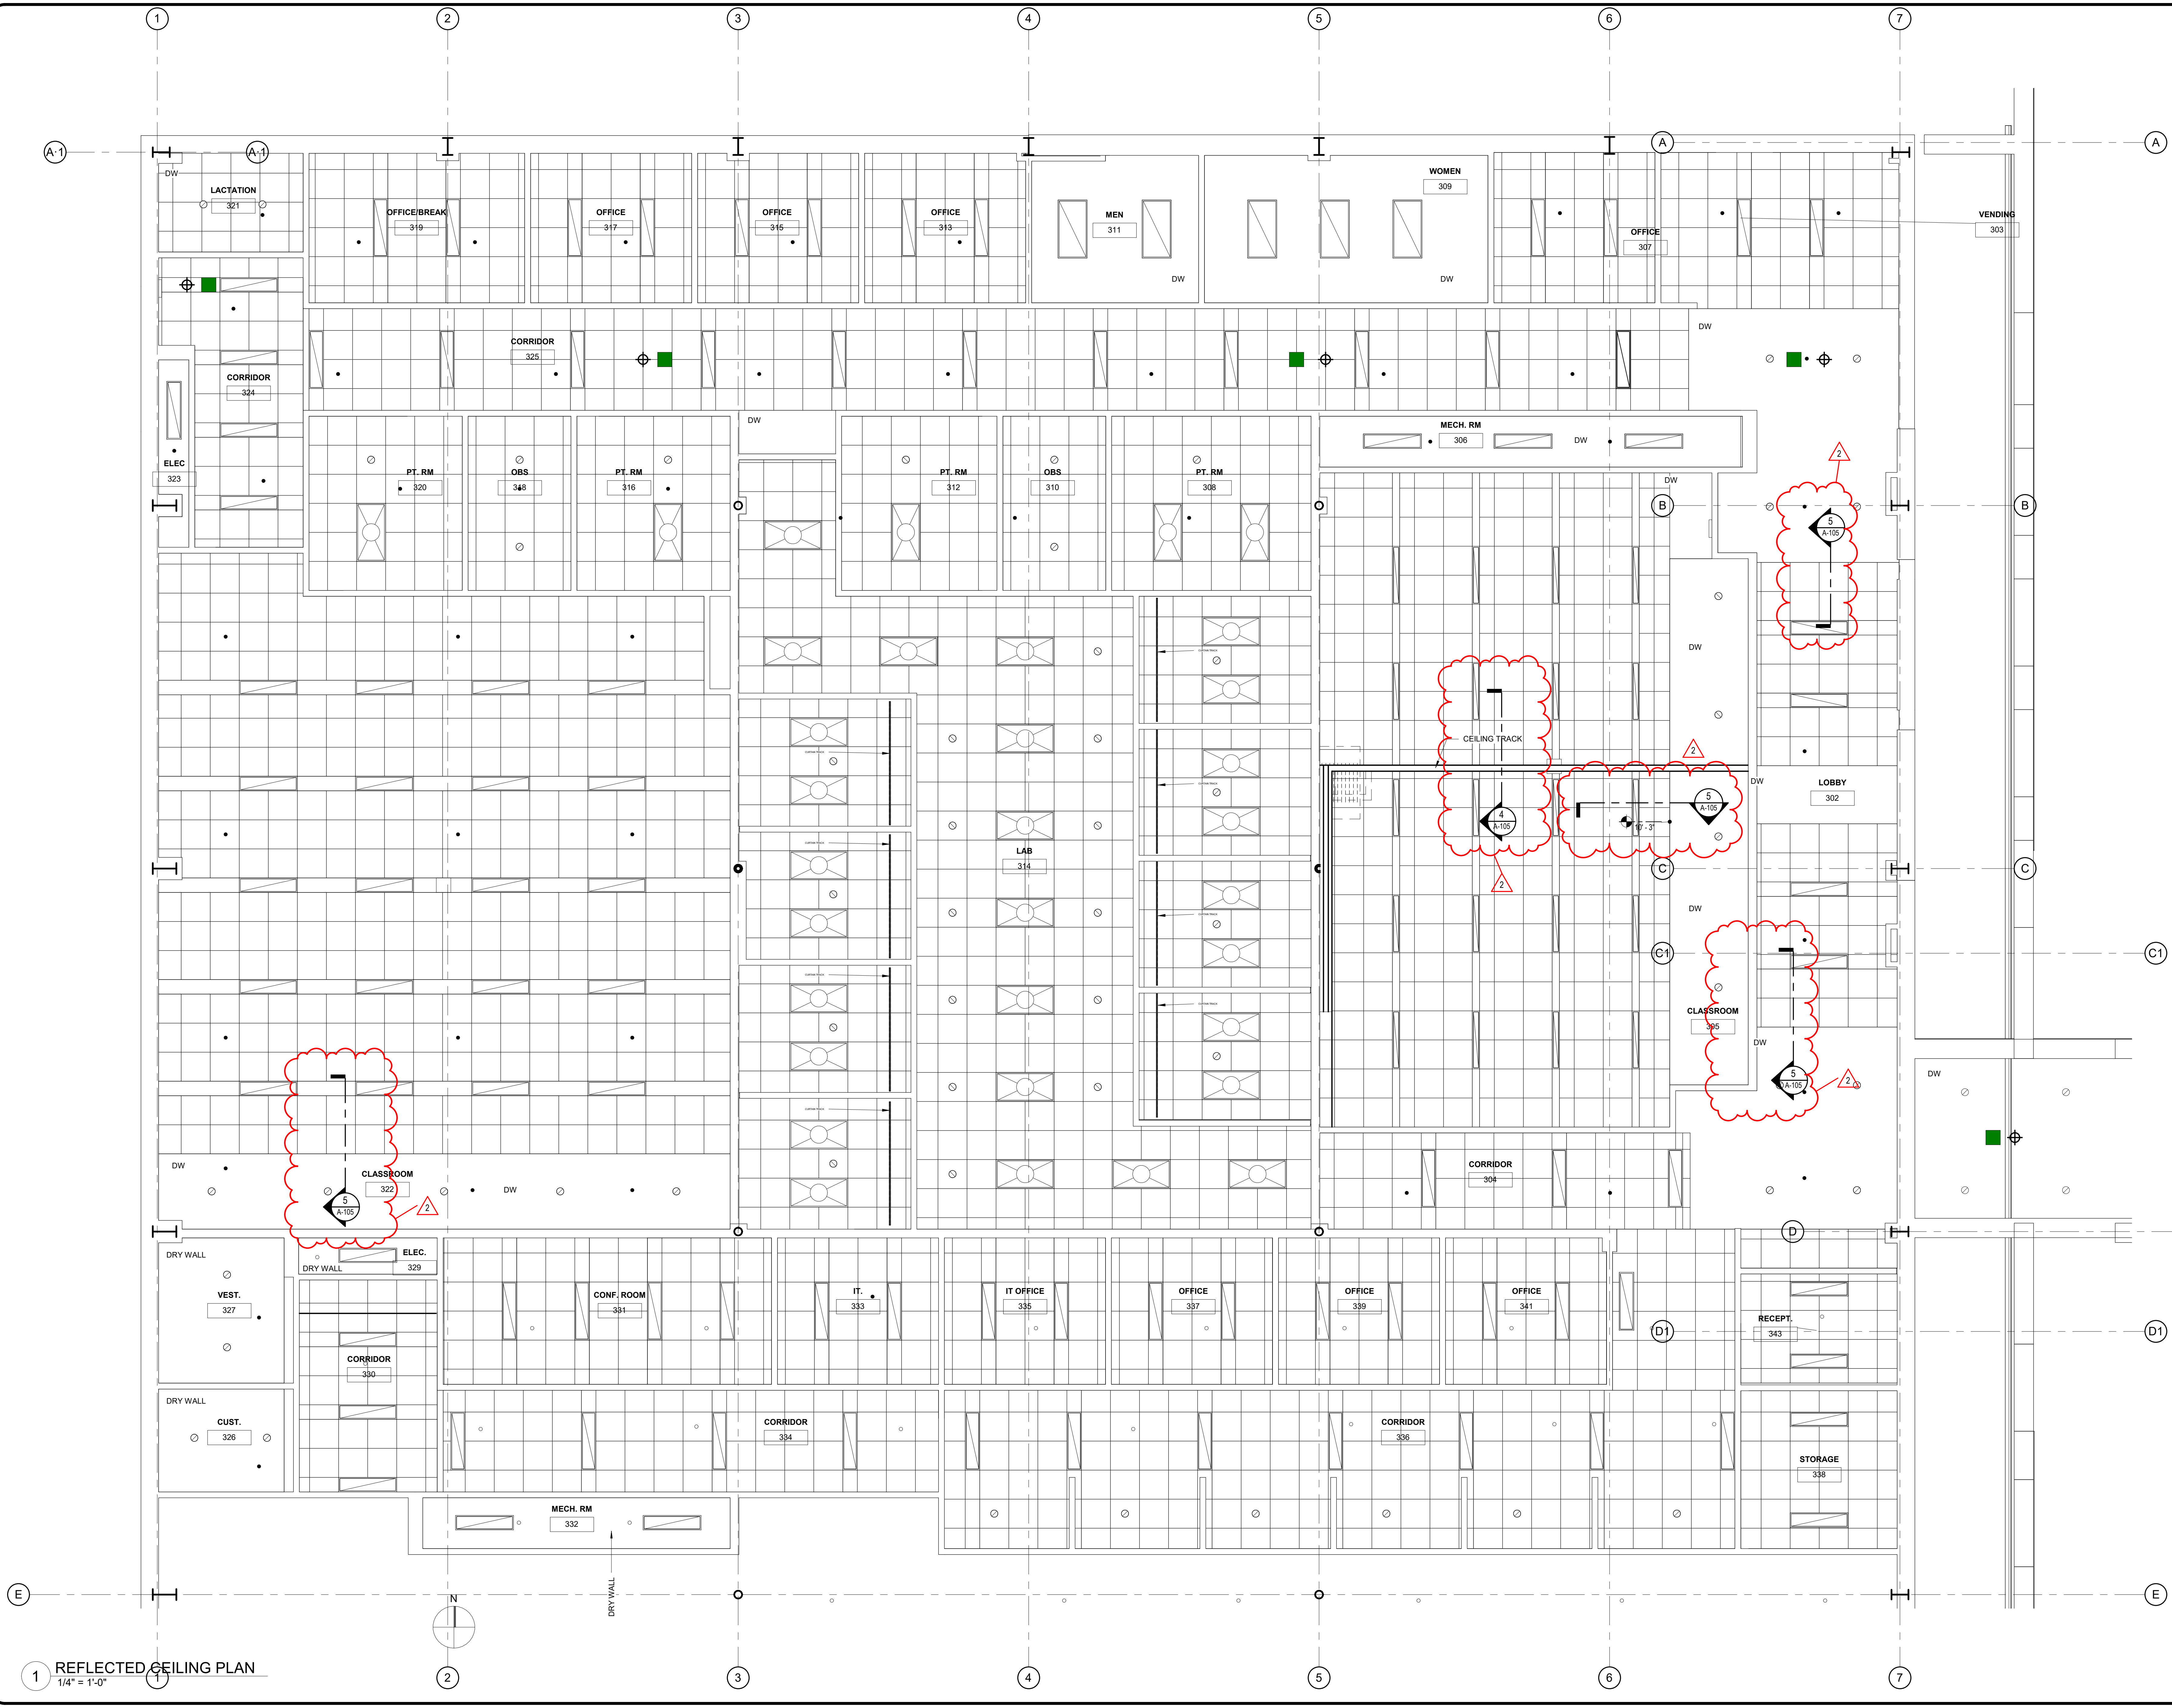


1 REFLECTED CEILING PLAN
1/4" = 1'-0"

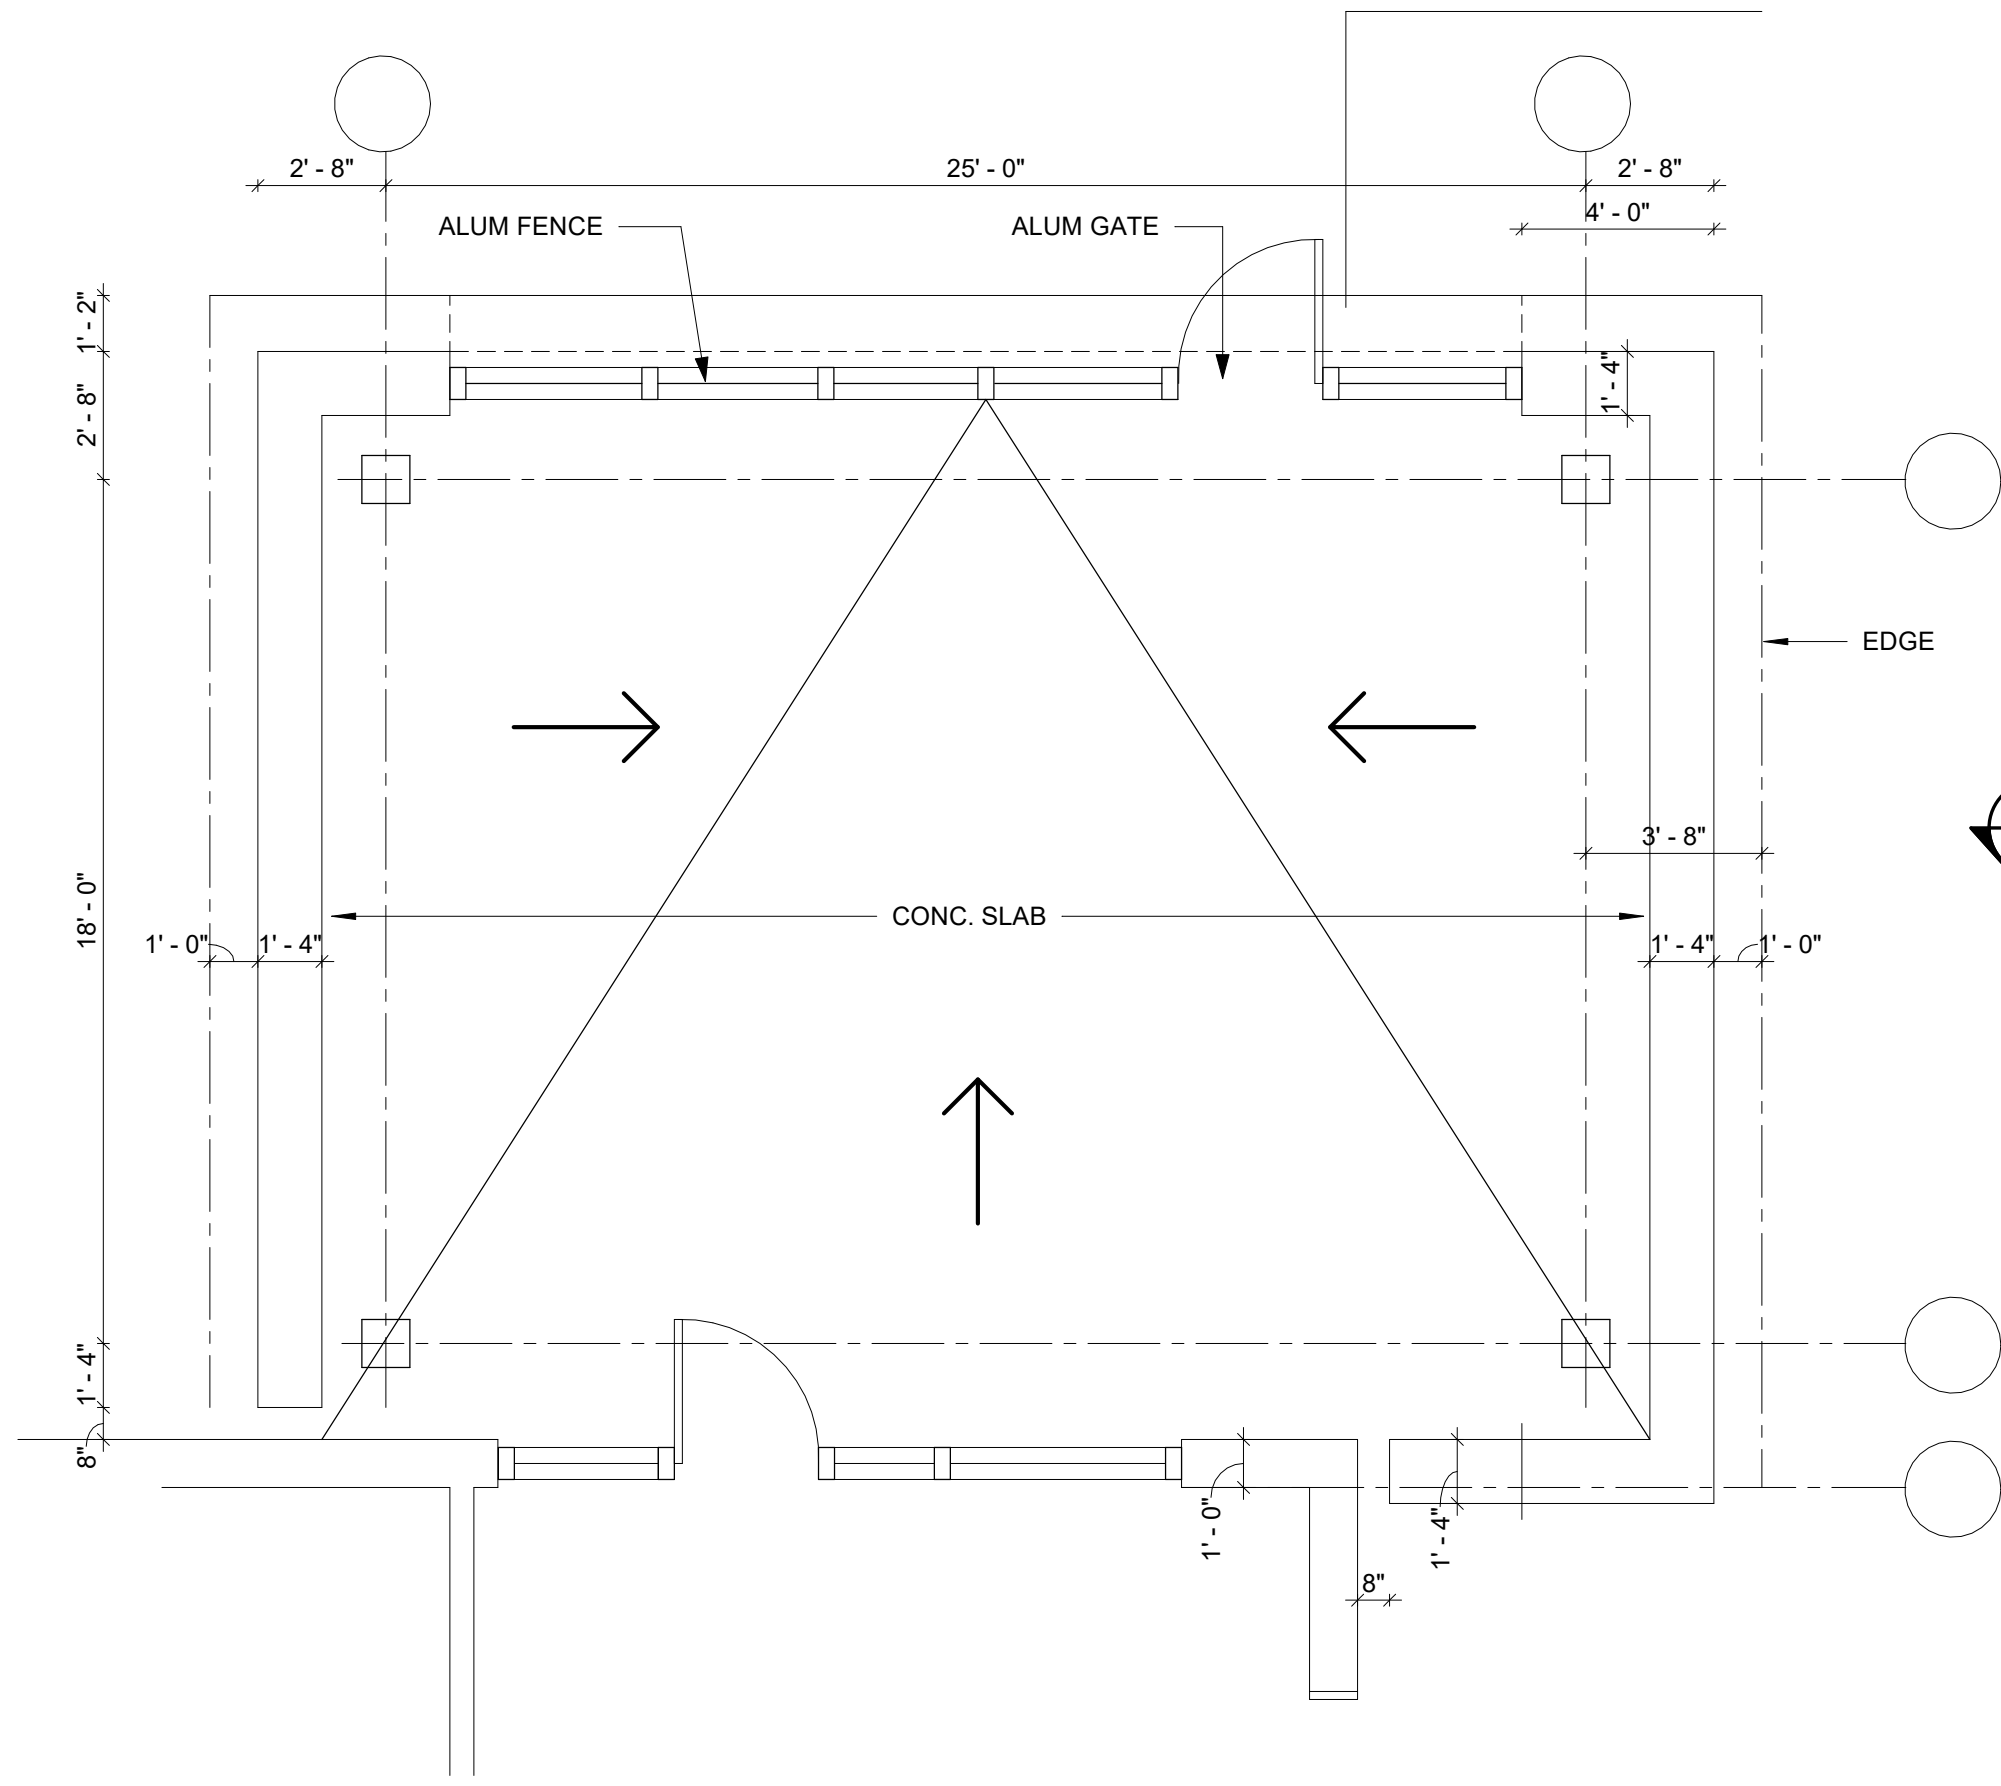


1 TERRACE PLAN
1/4" = 1'-0"

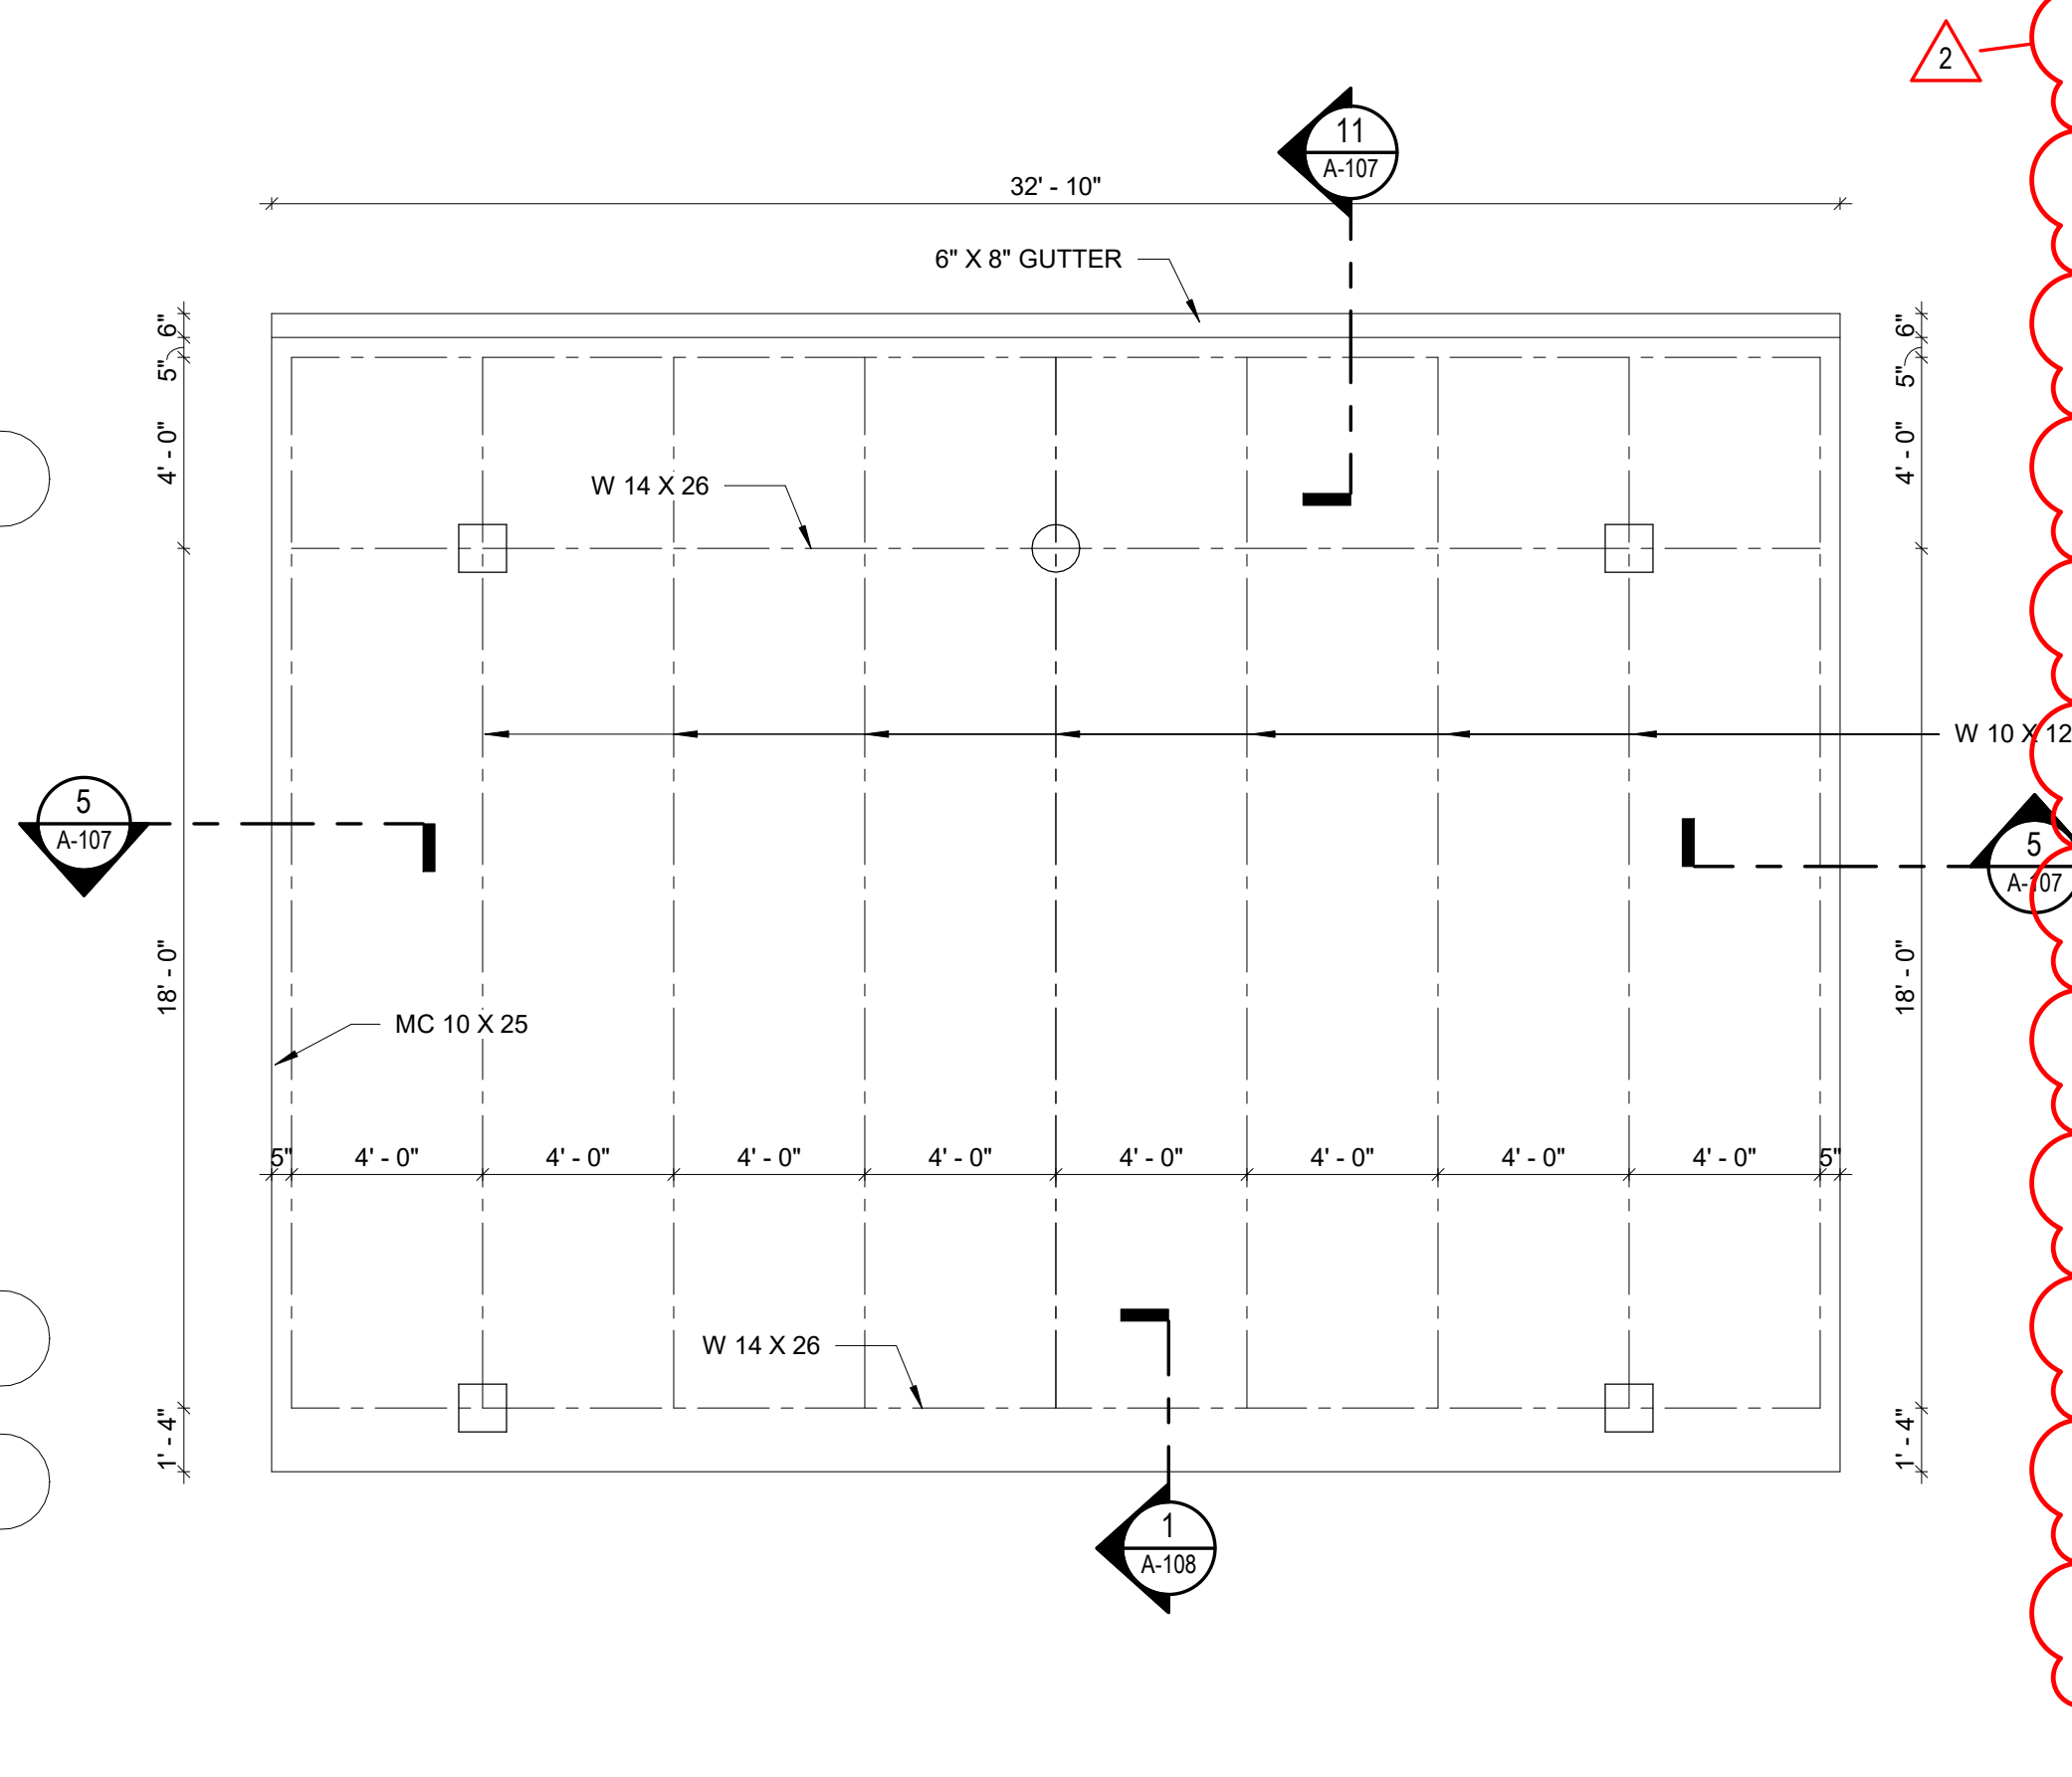


2 ROOF FRAMING PLAN ALT. (#2)
1/4" = 1'-0"

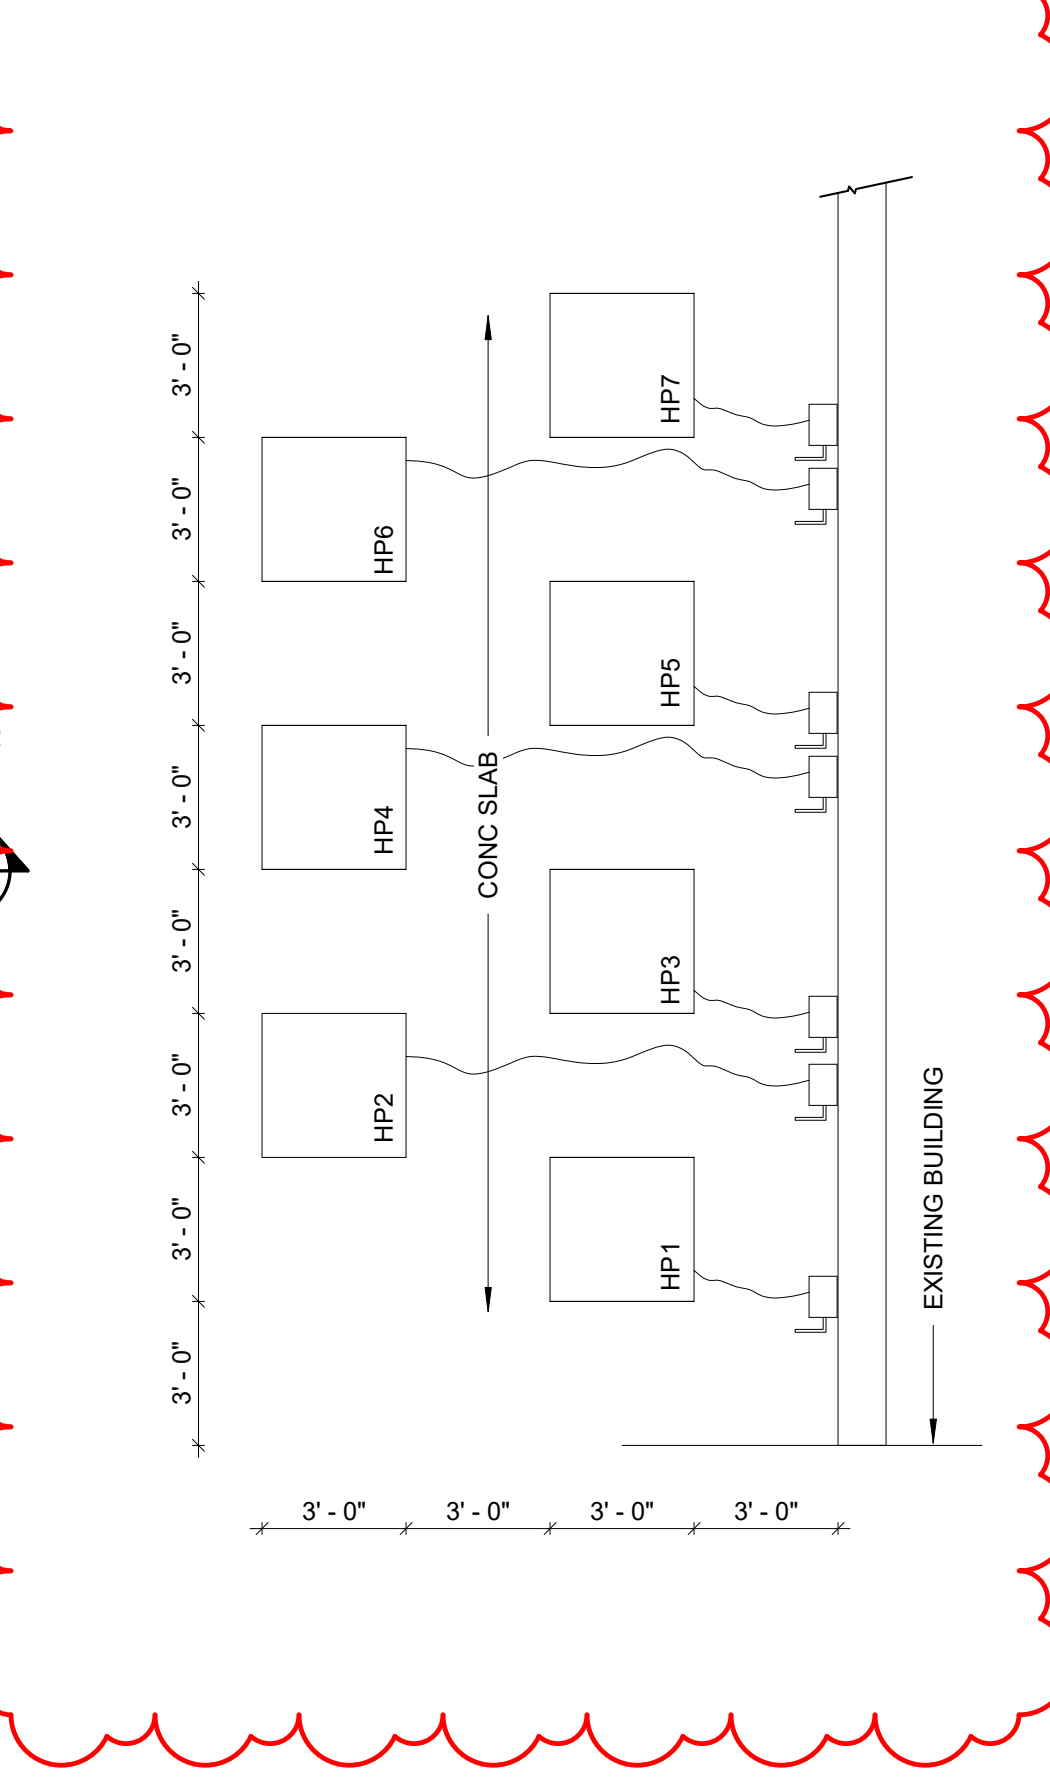


11 PLAN OF CONDENSER UNITS
1/4" = 1'-0"

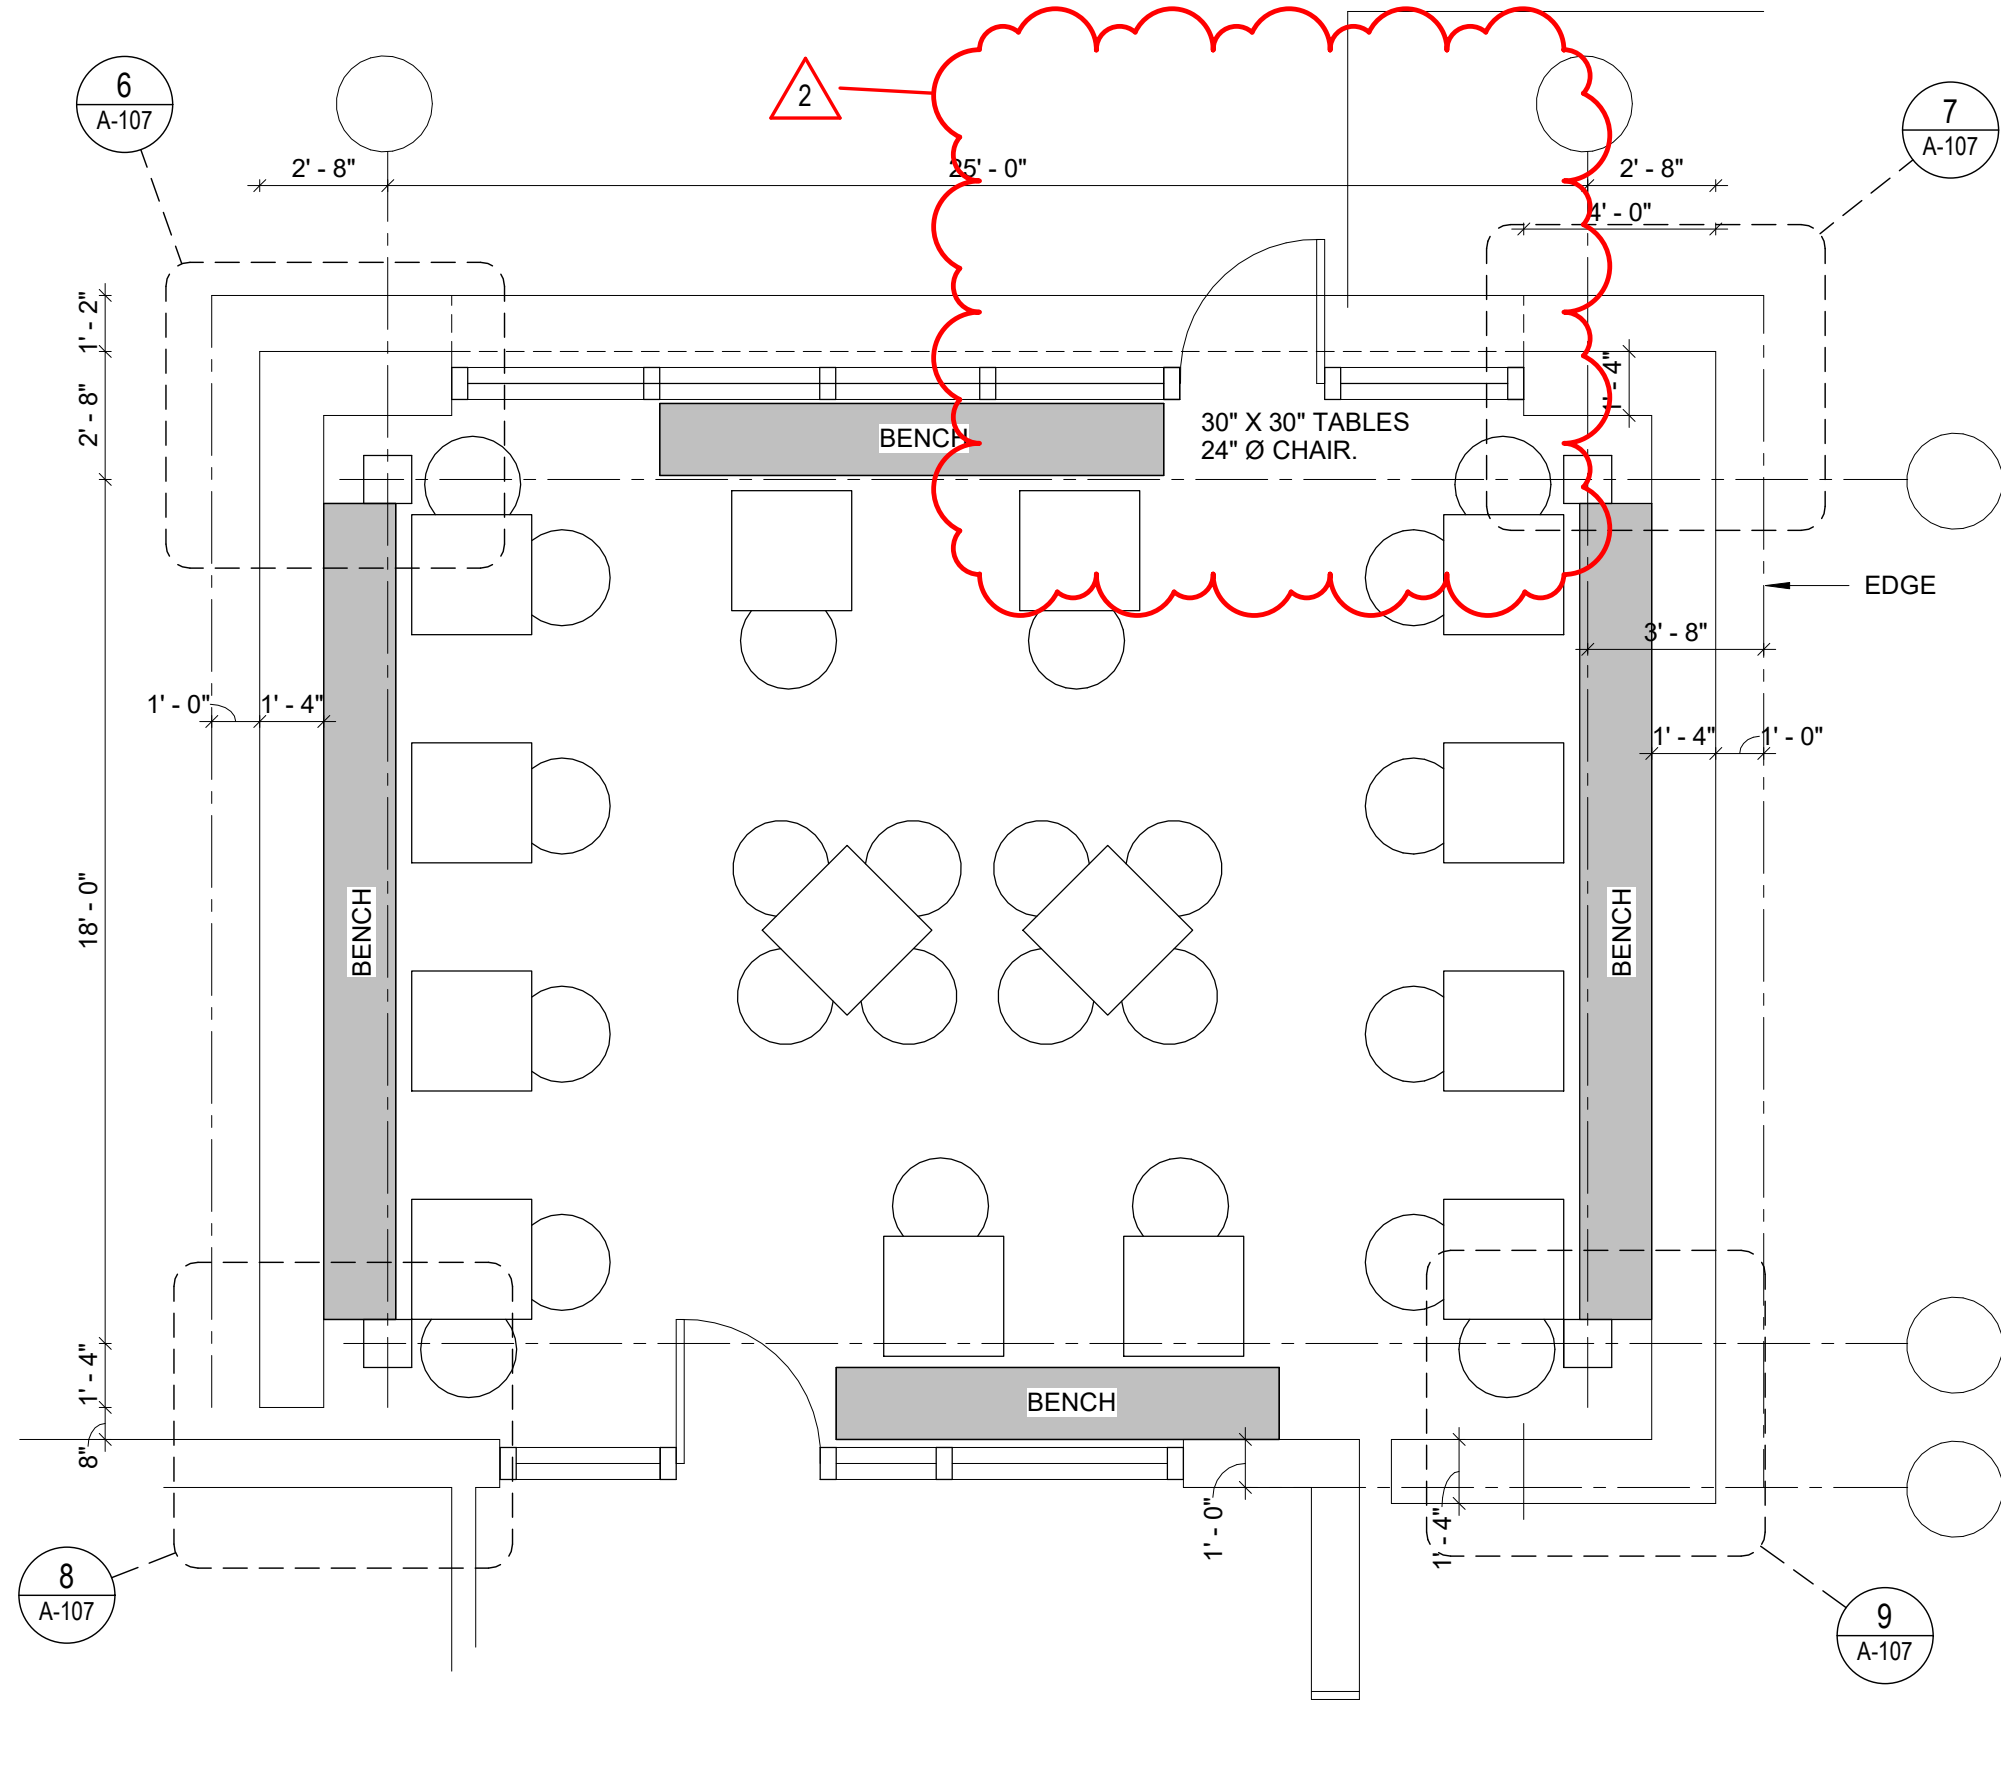


3 FURNITURE PLAN
1/4" = 1'-0"

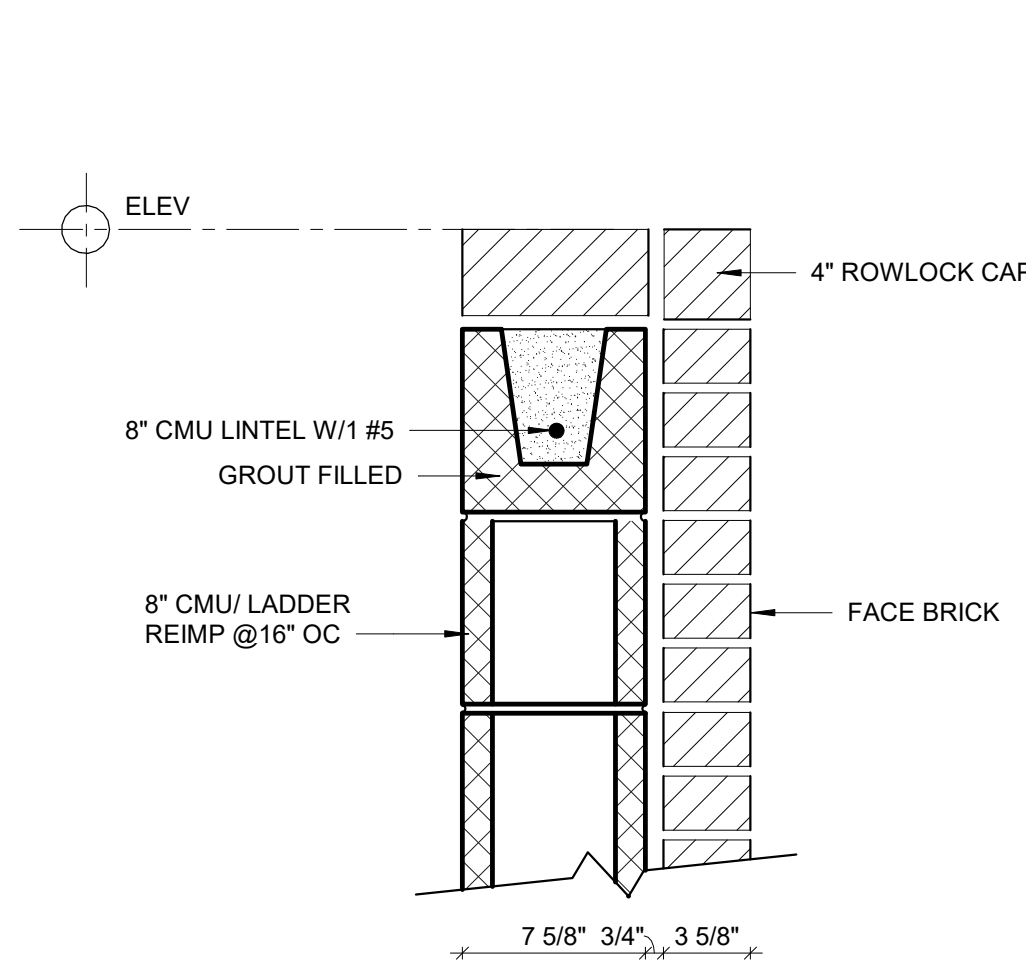


4 SECTION AT TOP OF SCREEN WALL
1 1/2" = 1'-0"

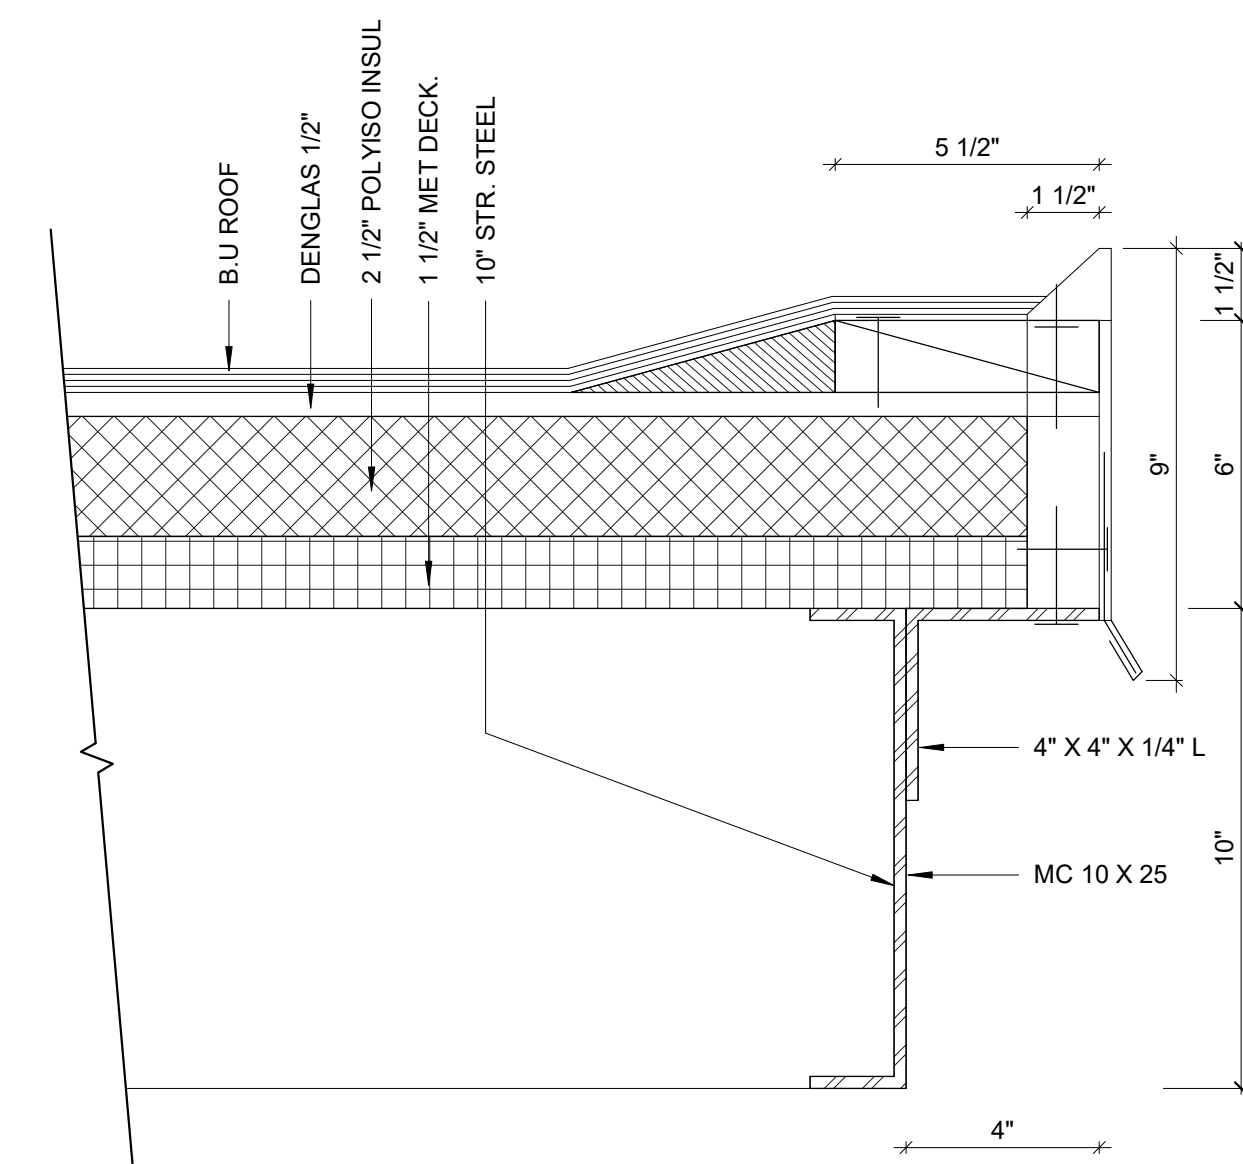


5 ROOF EDGE SECTION (ALT #2)
3" = 1'-0"

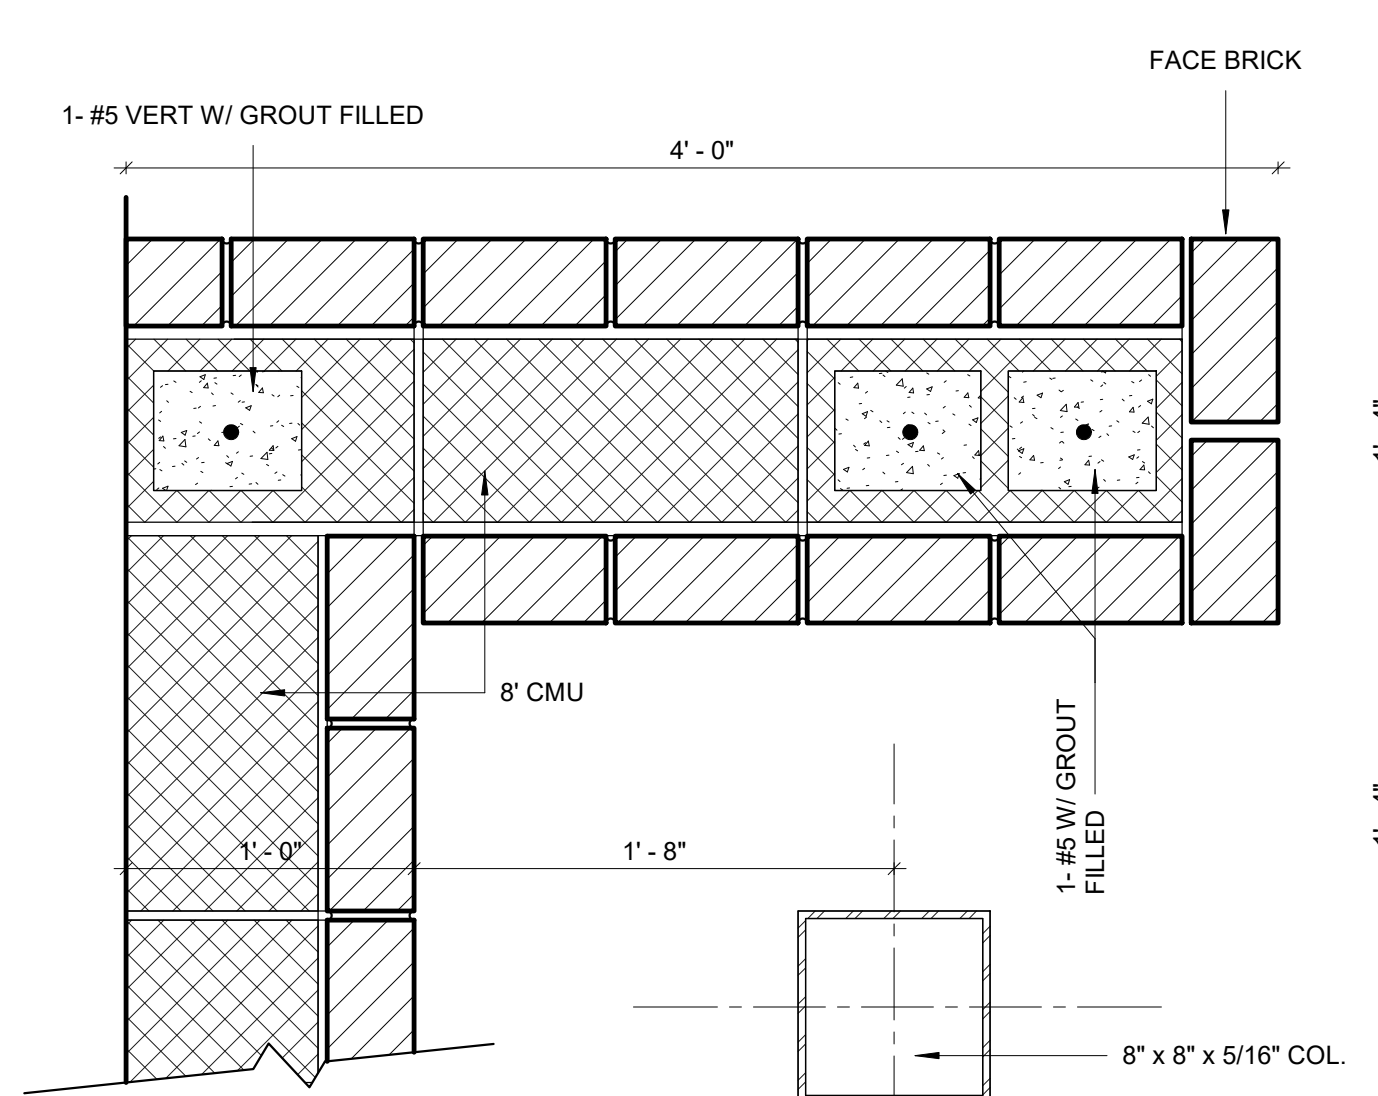


6 PLAN AT N.W CORNER AT SCREEN WALL
1 1/2" = 1'-0"

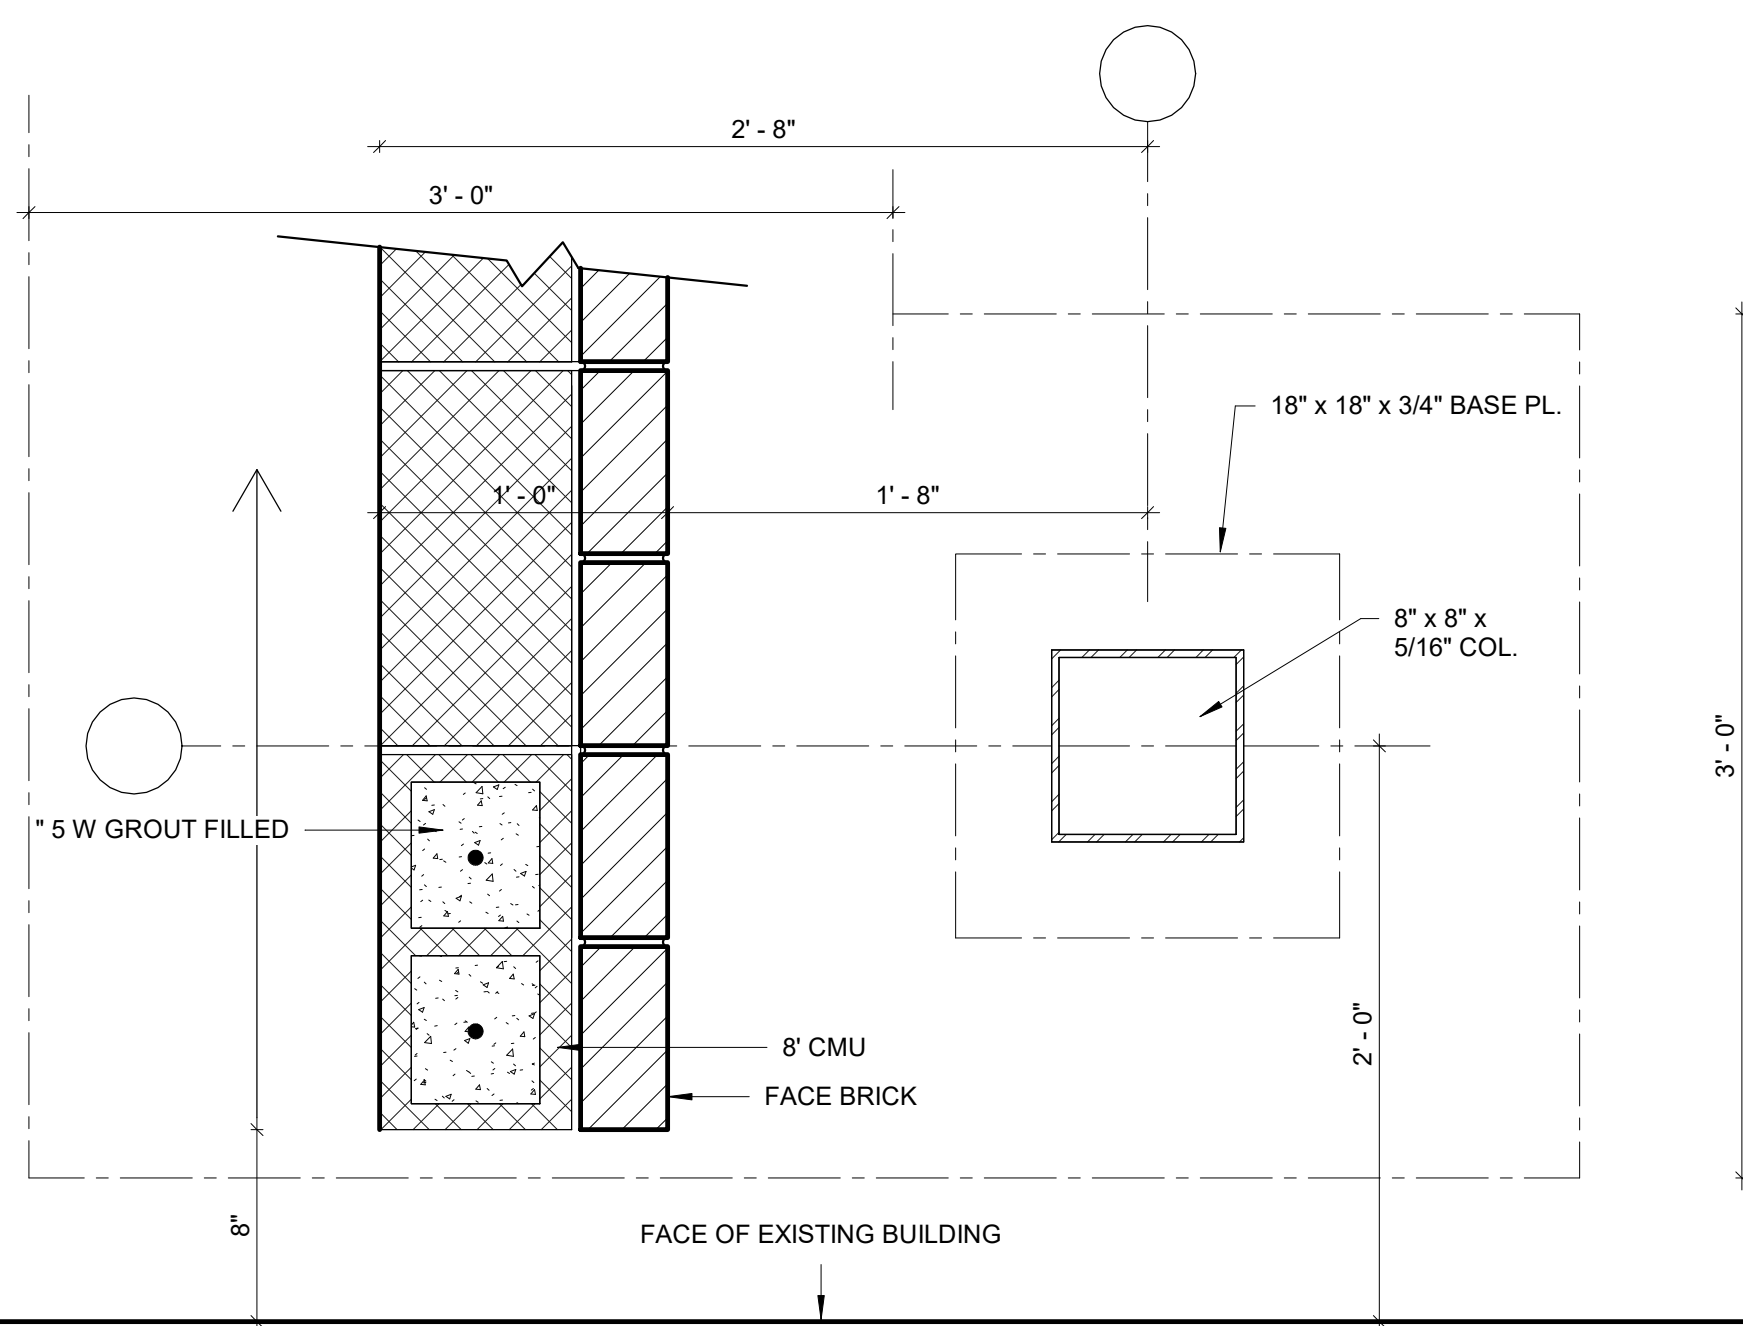


8 PLAN AT S.W. CORNER OF TERRACE
1 1/2" = 1'-0"

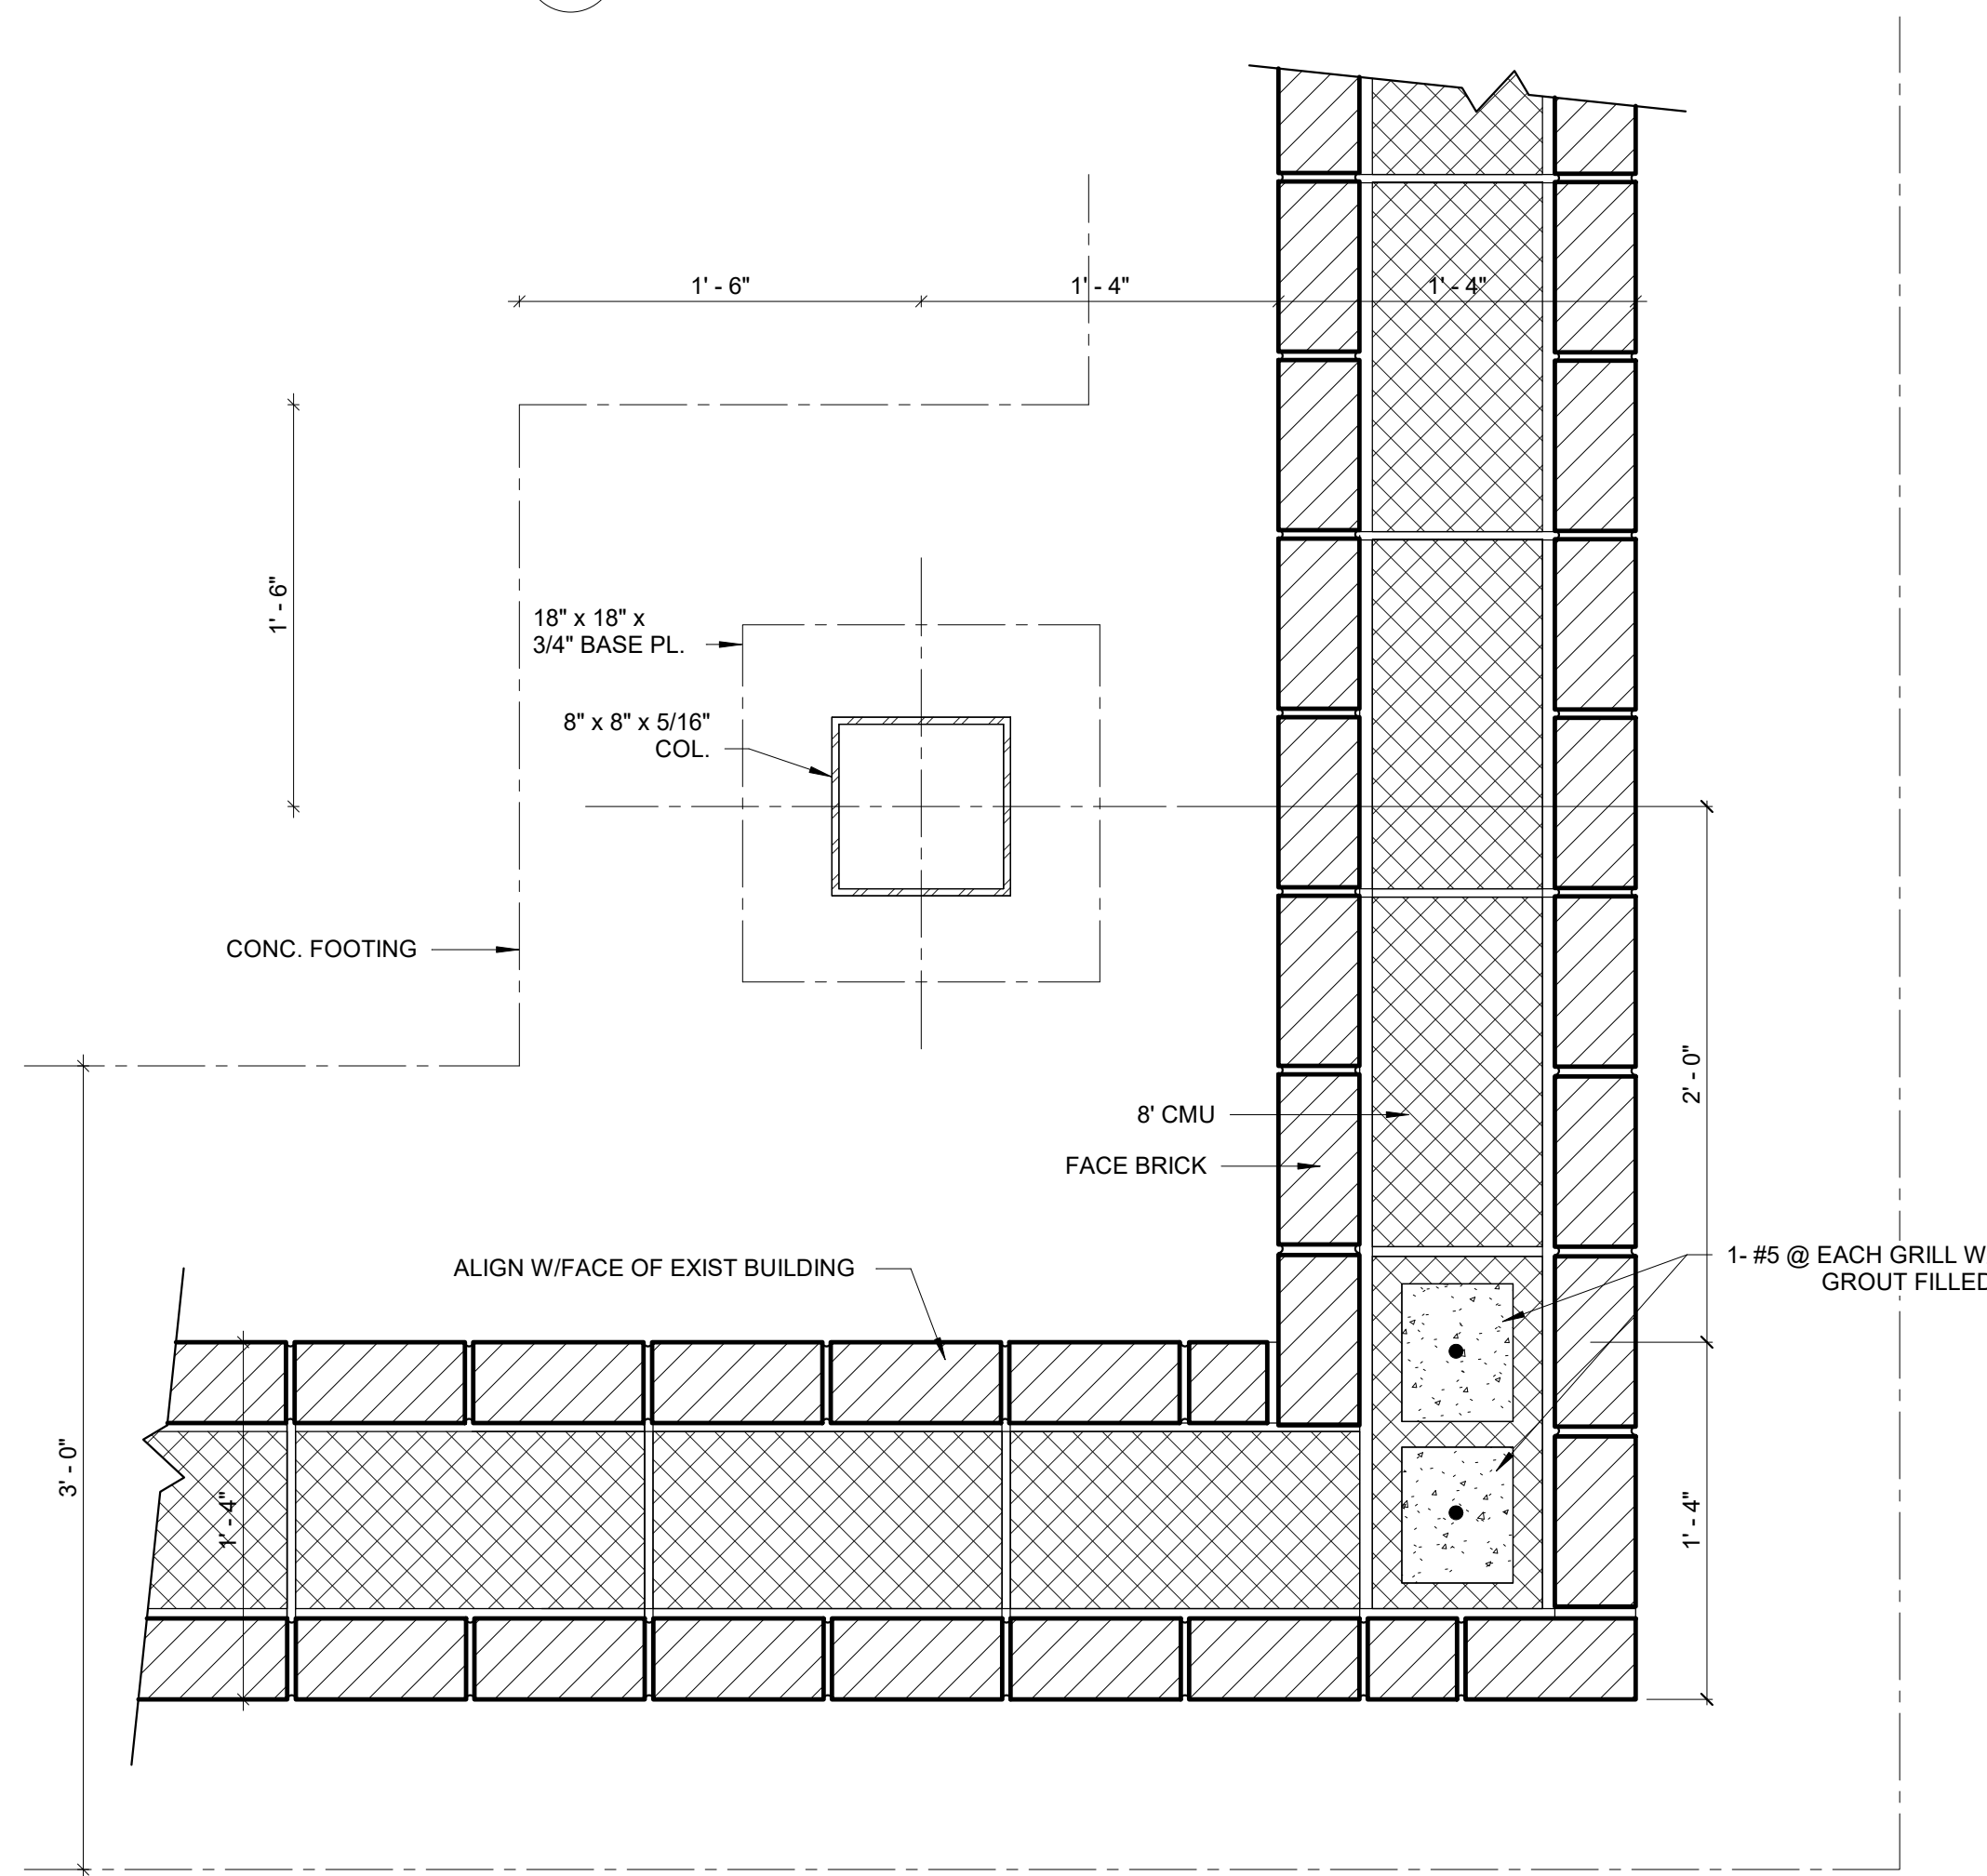

9 PLAN AT S.E. CORNER OF TERRACE
1 1/2" = 1'-0"

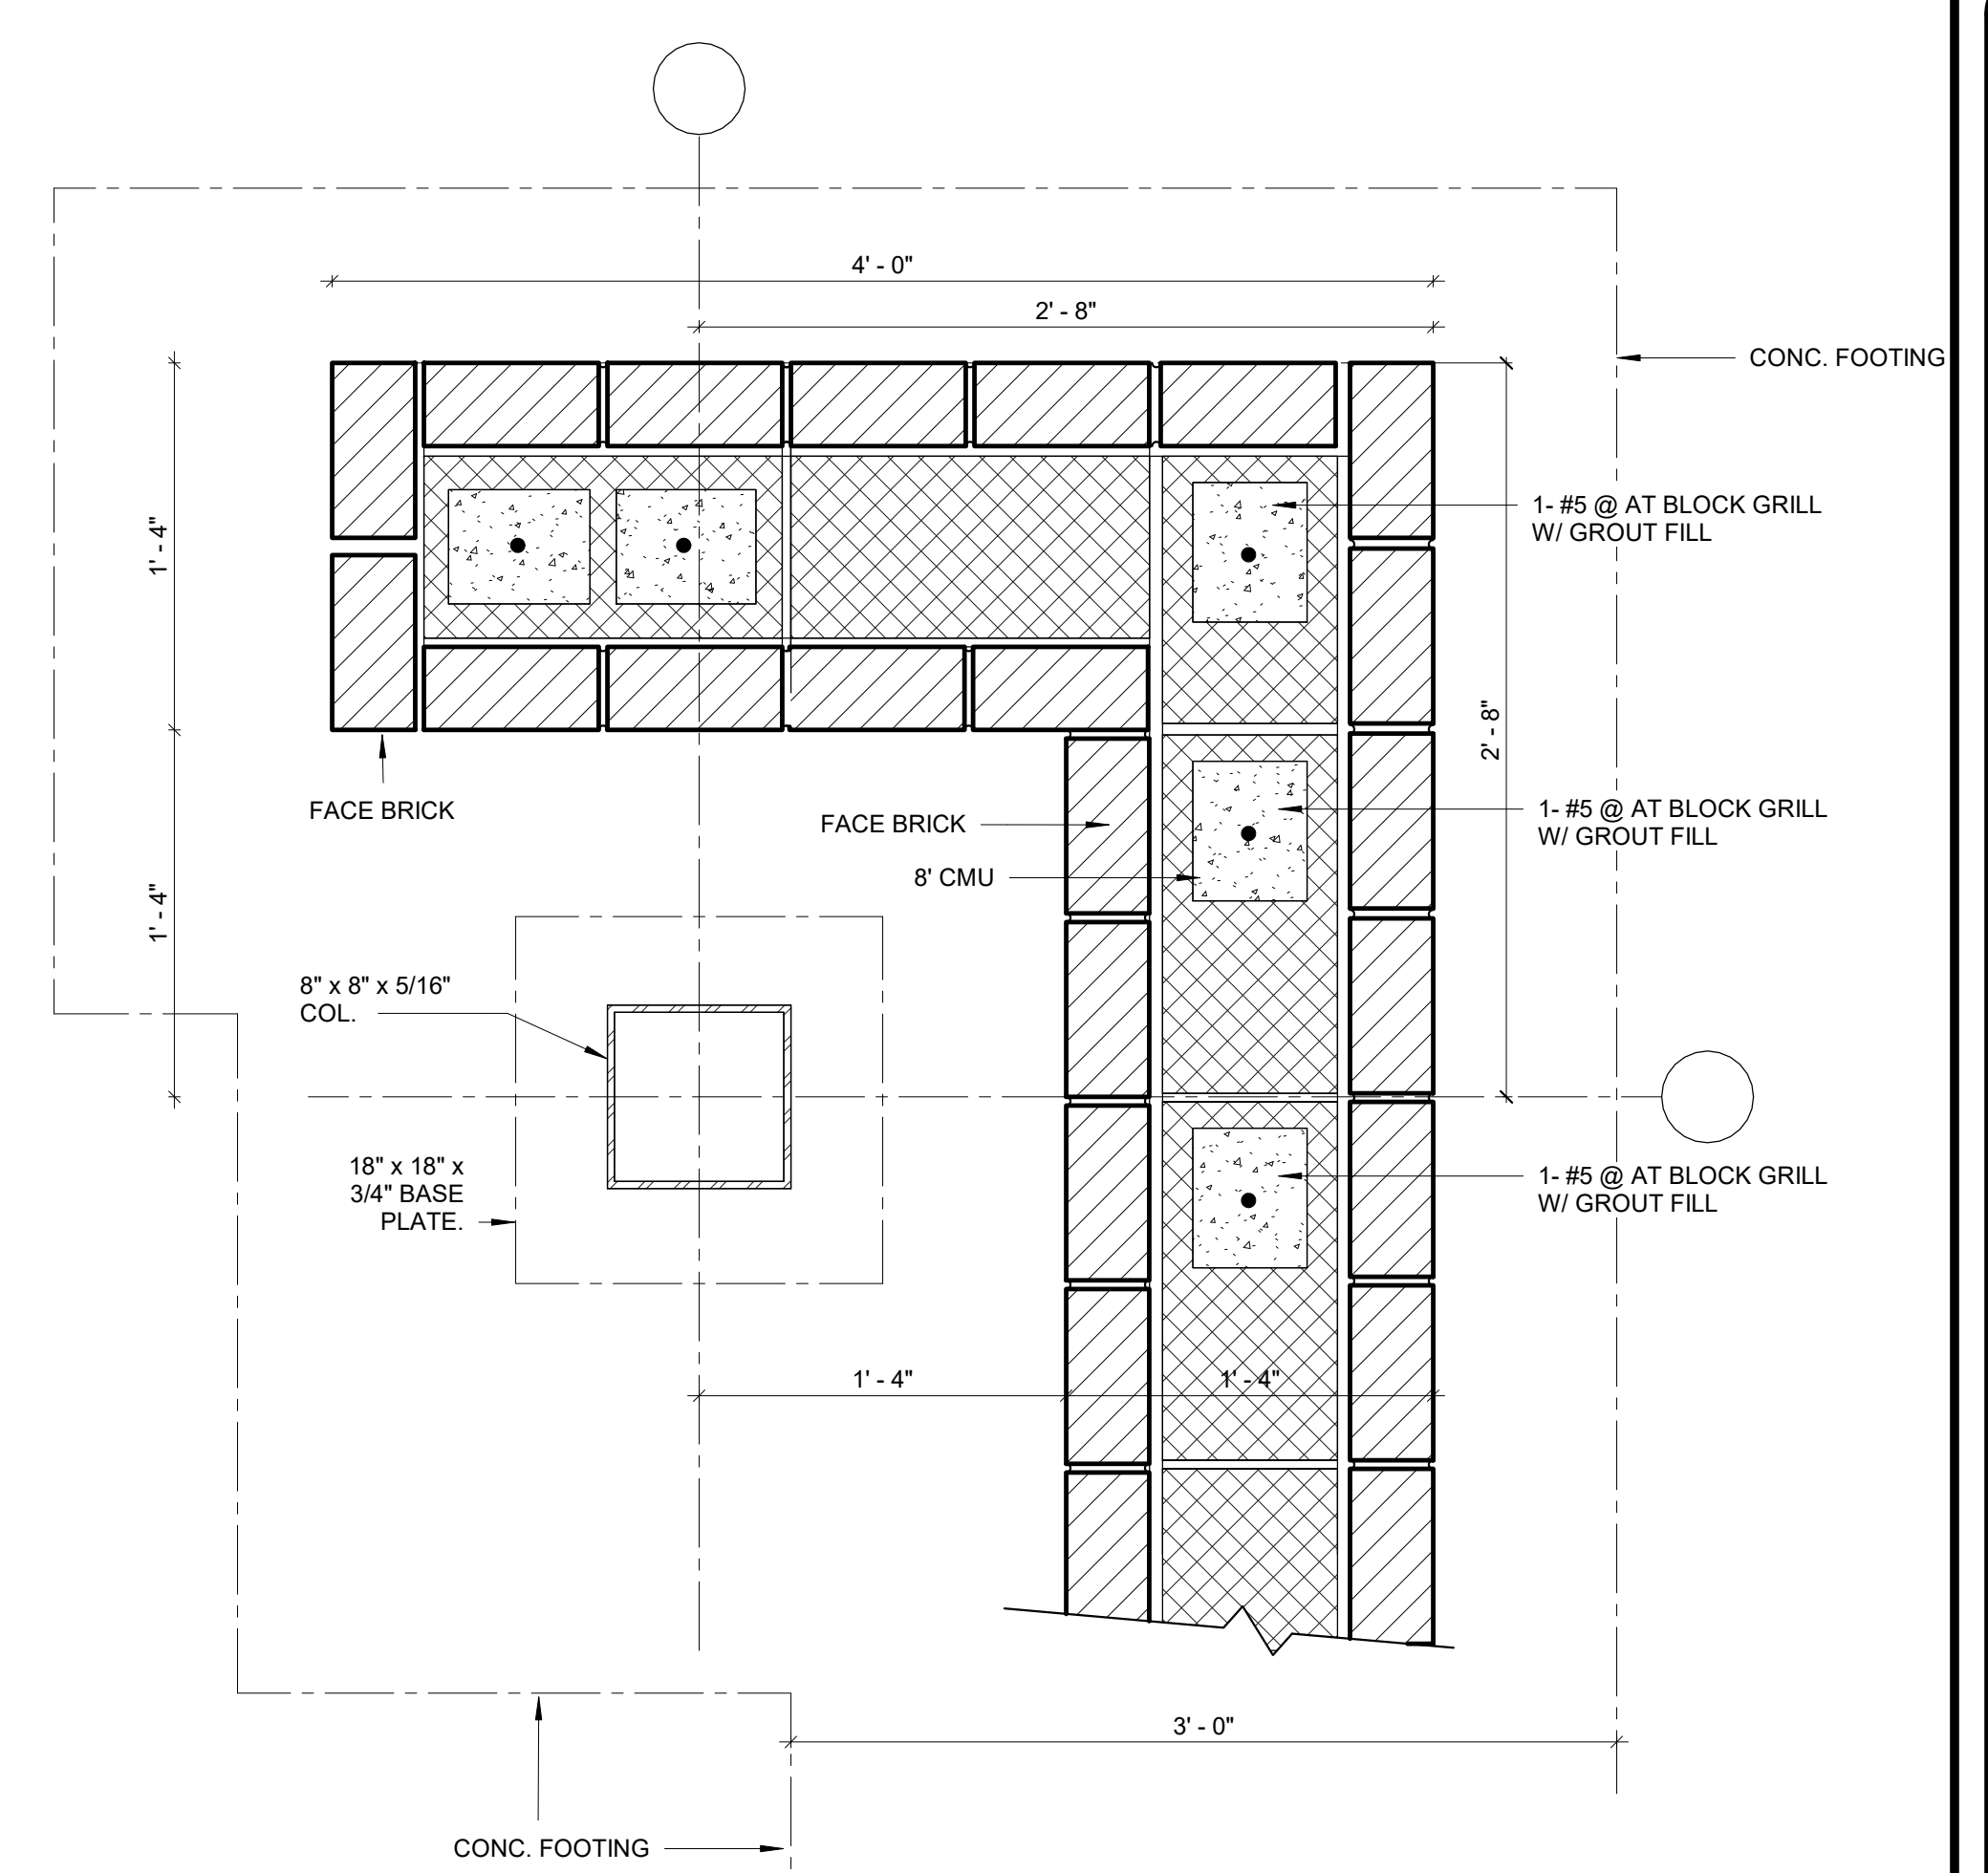

7 PLAN AT N.E. CORNER OF TERRACE
1 1/2" = 1'-0"

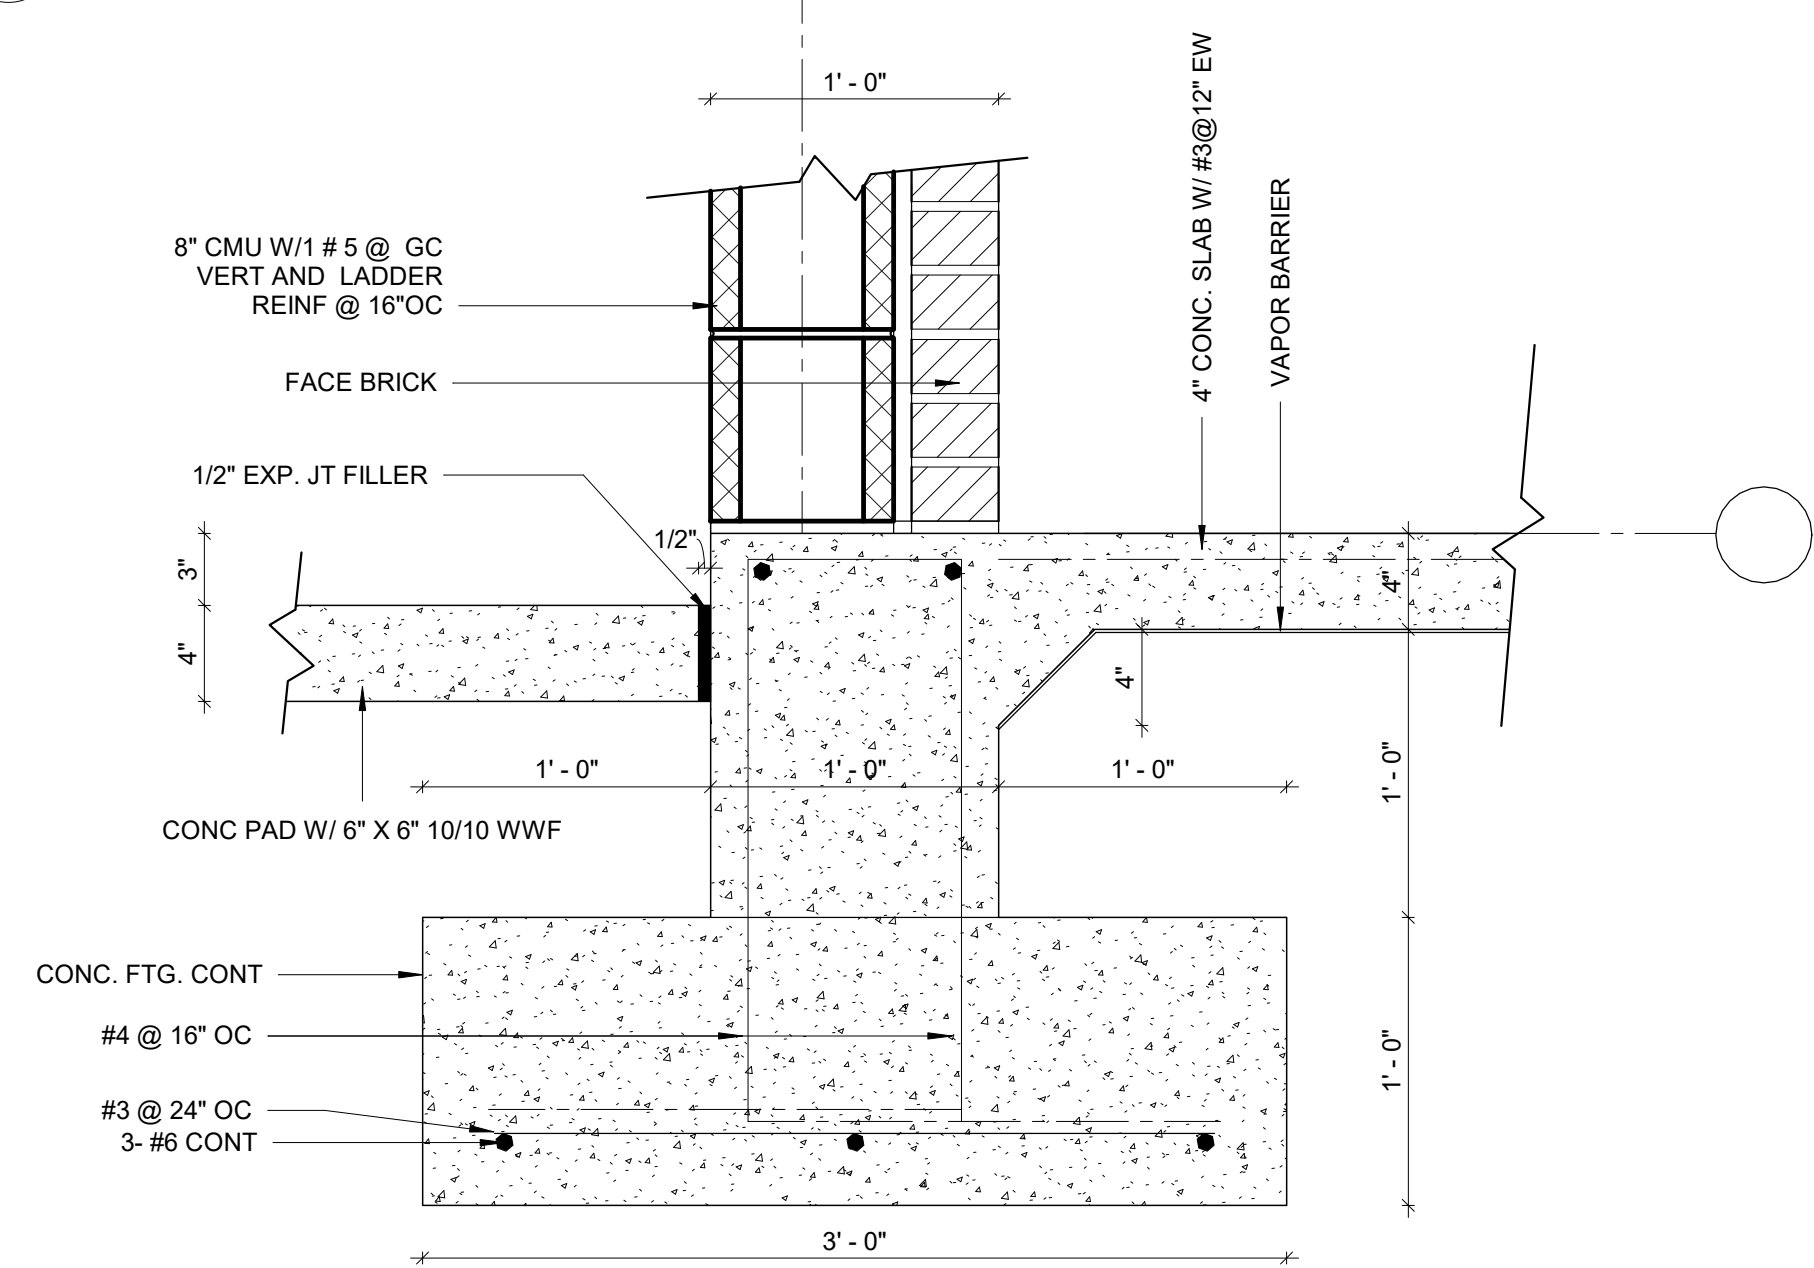

10 SECTION AT WEST SCREEN WALL
1 1/2" = 1'-0"



FoilWatt
Architects & Planners, PLLC
SUITE 200
150 NORTH STATE STREET
MEMPHIS, TN 38103
TELEPHONE (901) 552-3071
FAX (901) 552-3071
WWW.FOILWATT.COM

THE W NURSING SCHOOL
AT NESHOBIA GENERAL HOSPITAL

Philadelphia, MS 38350

project no.
1661 - 23
04 JUNE 2026
revised
2 6-9-2026

drawn by
DLC

TERRACE PLAN

sheet no.
A-107

of

CONSTRUCTION DOCUMENTS



THE W NURSING SCHOOL
AT NESHOBIA GENERAL HOSPITAL

Philadelphia, MS 38350

project no.
1661 - 23
date
04 JUNE 2026
revised
2 6-9-2026


drawn by
DLC

FURNITURE PLAN


sheet no.
A-109
of




FURNITURE PLAN NORTH
SCALE: 1/4" = 1' - 0"

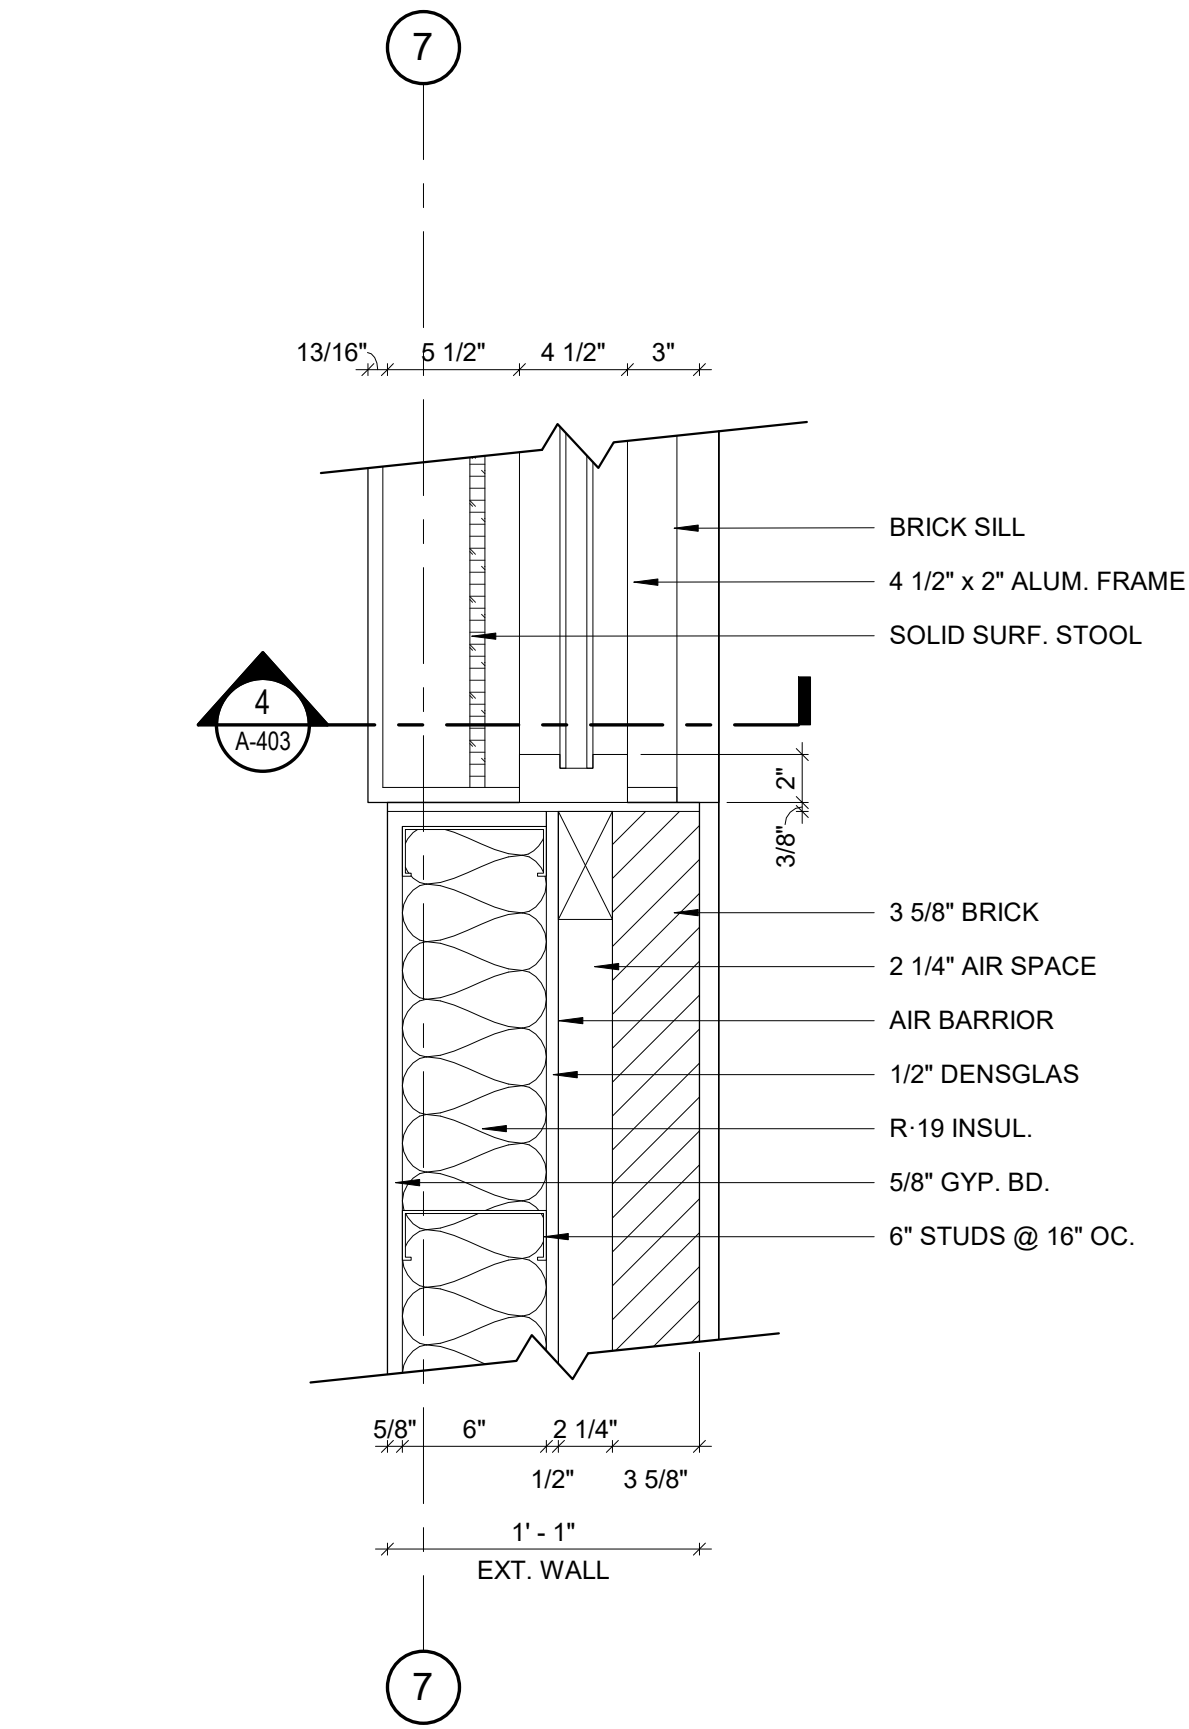


1 WALL & WINDOW DETAIL A JAMB
1 1/2" = 1'-0"

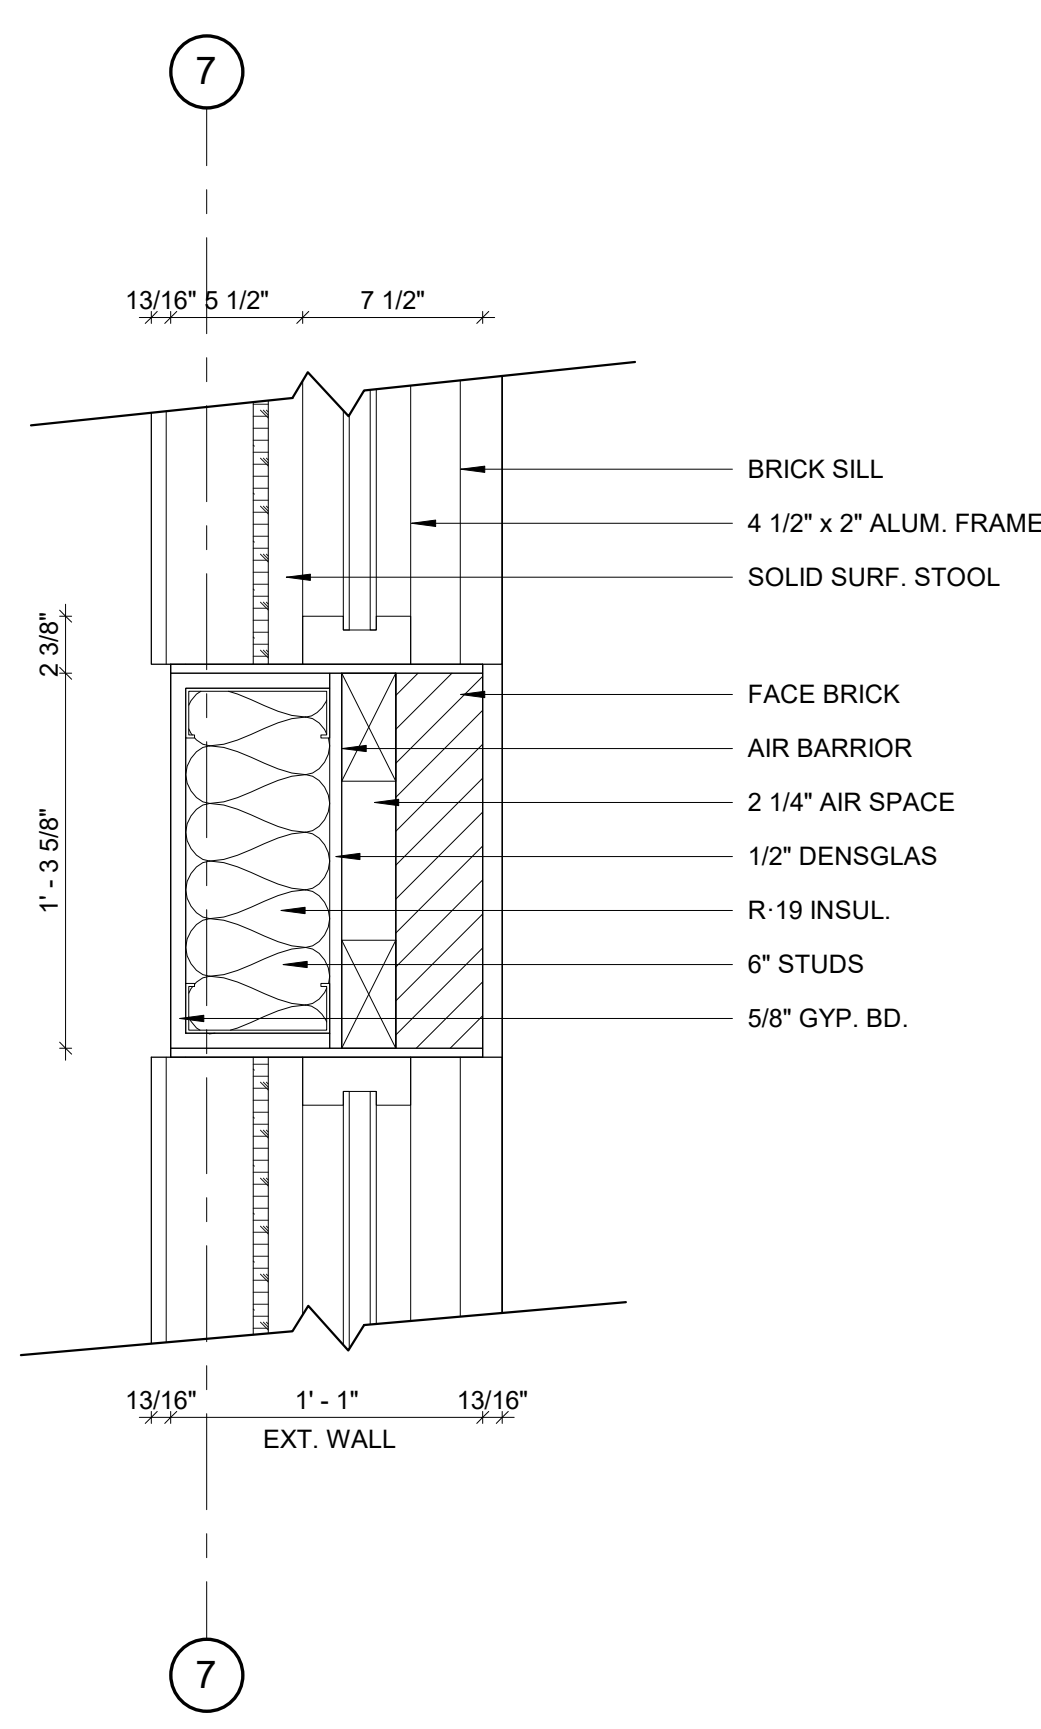


2 MULLION DETAIL
1 1/2" = 1'-0"

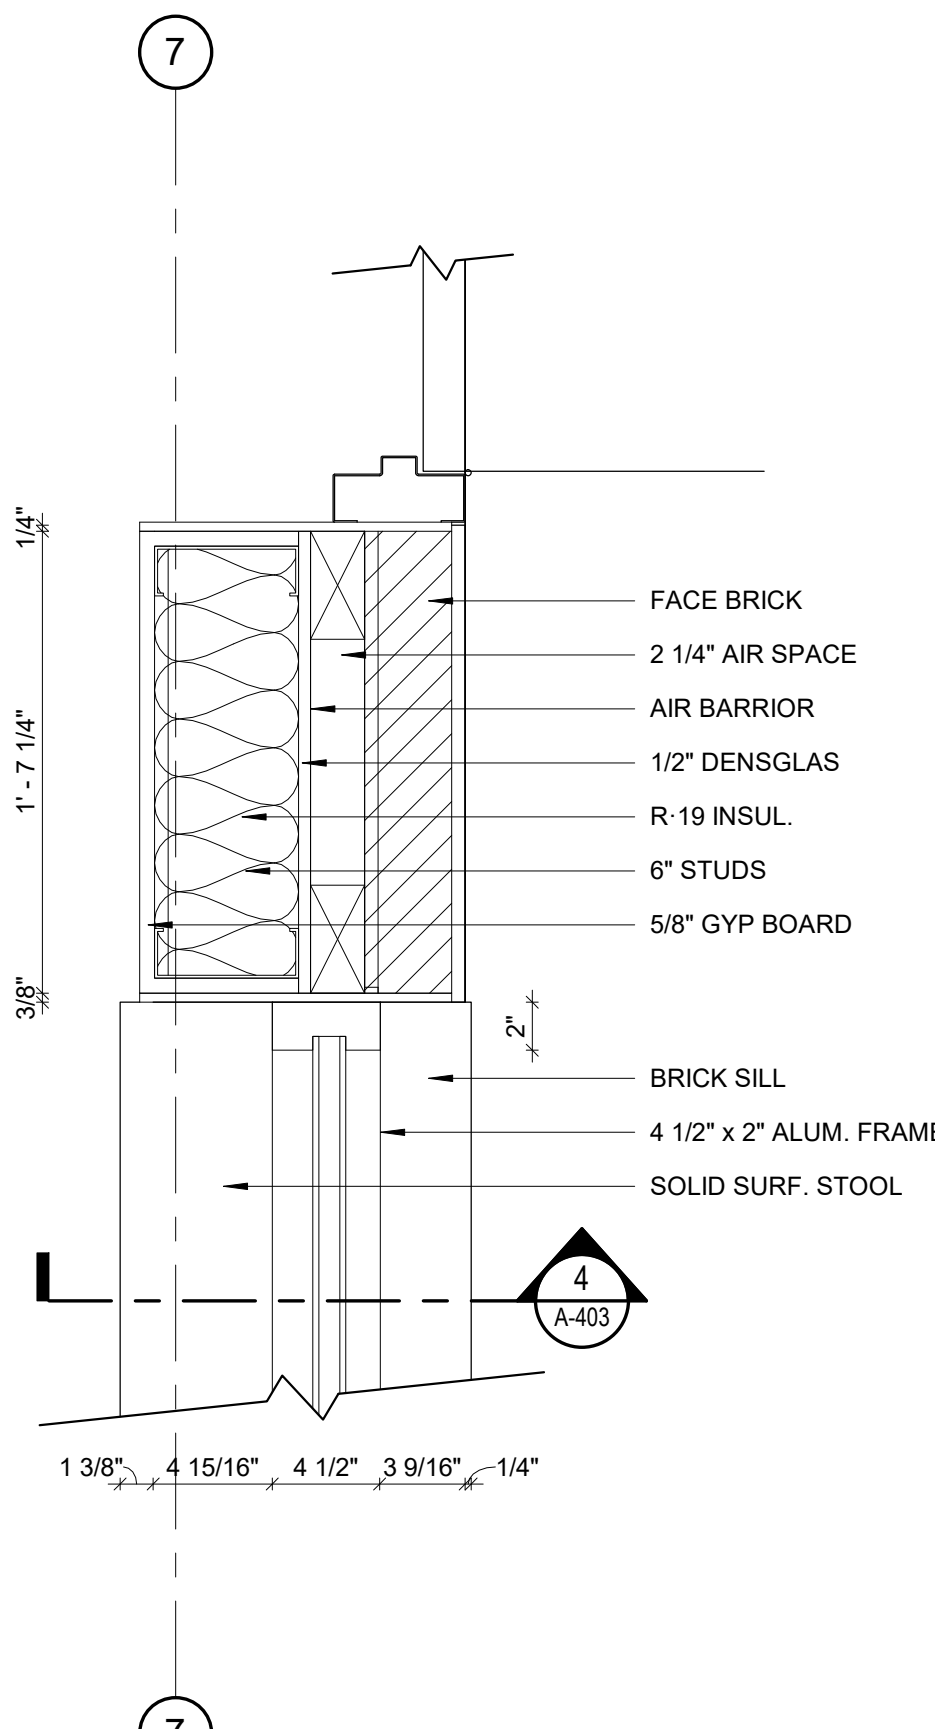


3 WALL & WINDOW DETAIL B
1 1/2" = 1'-0"

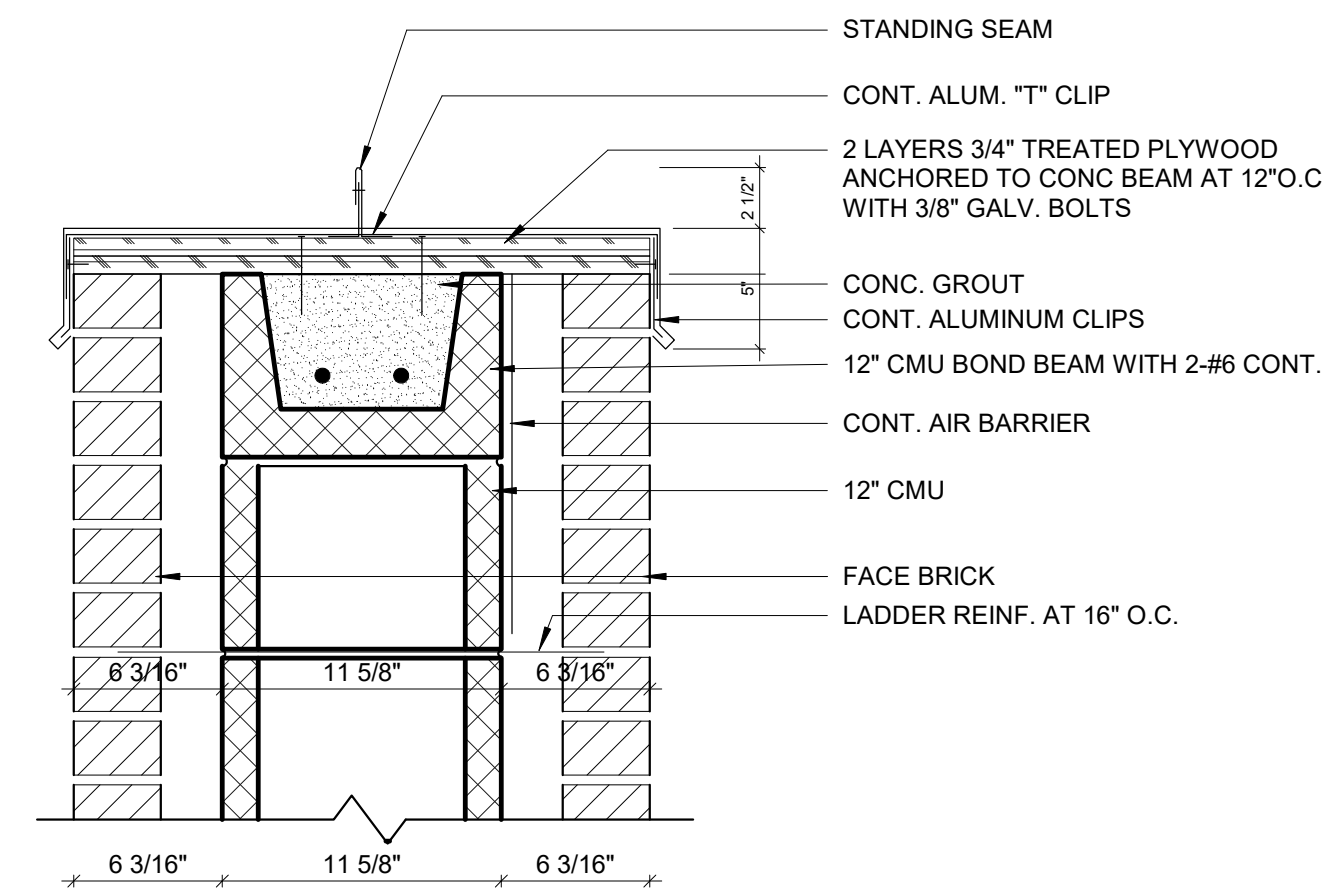


6 WALL DETAIL 6 A403
1 1/2" = 1'-0"

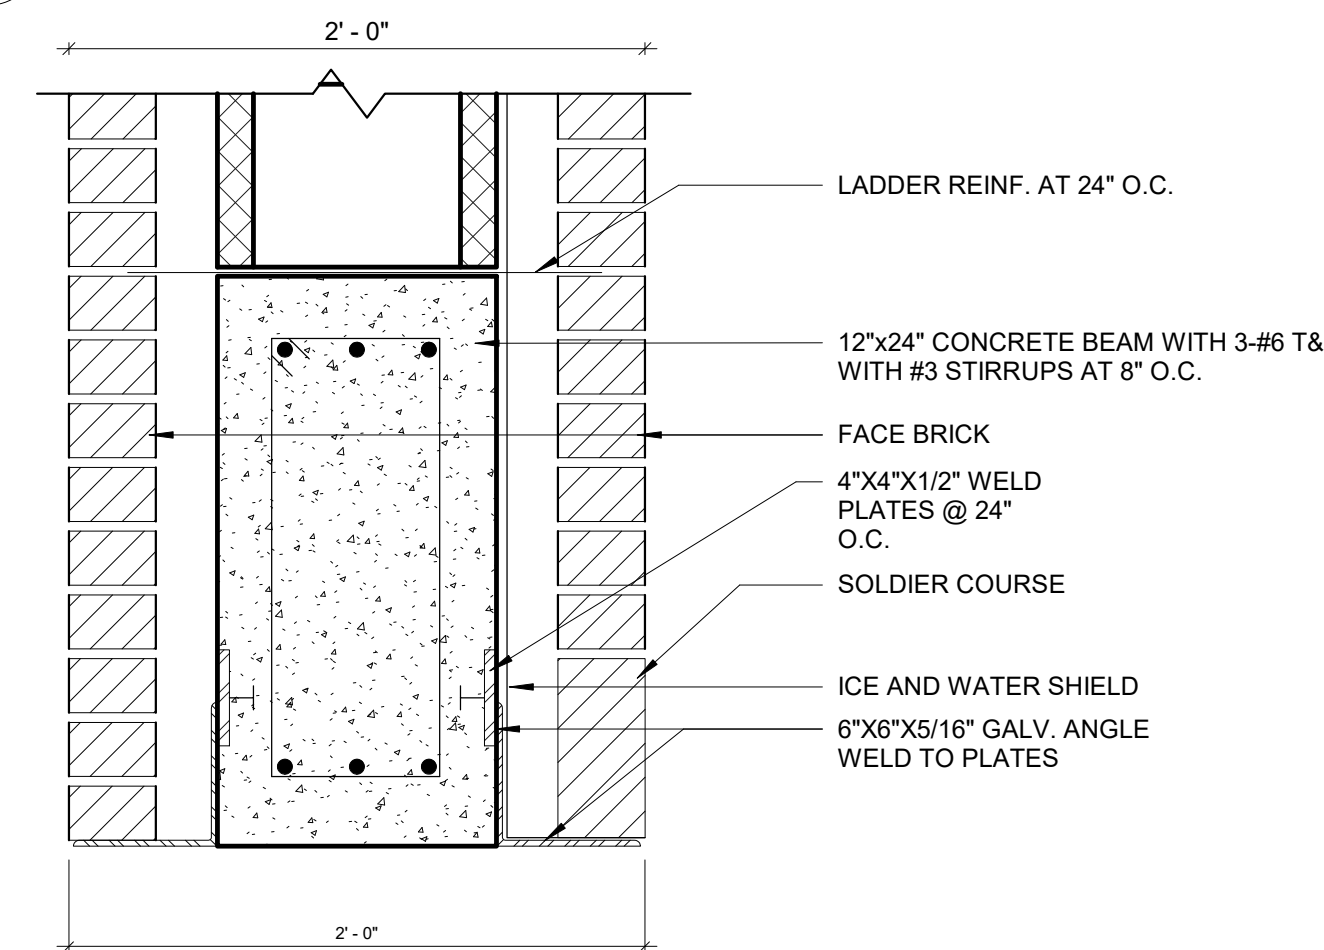


5 WALL DETAIL 5 A403
1 1/2" = 1'-0"

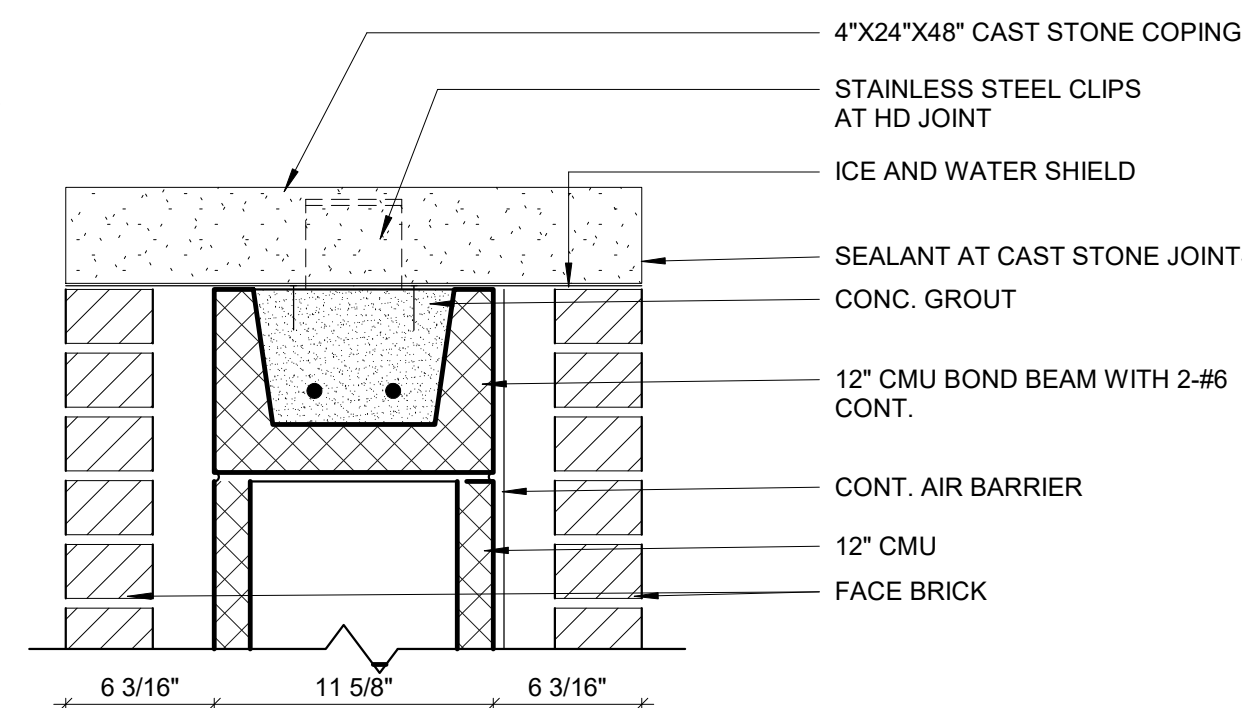


7 WALL DETAIL 7 A403
1 1/2" = 1'-0"

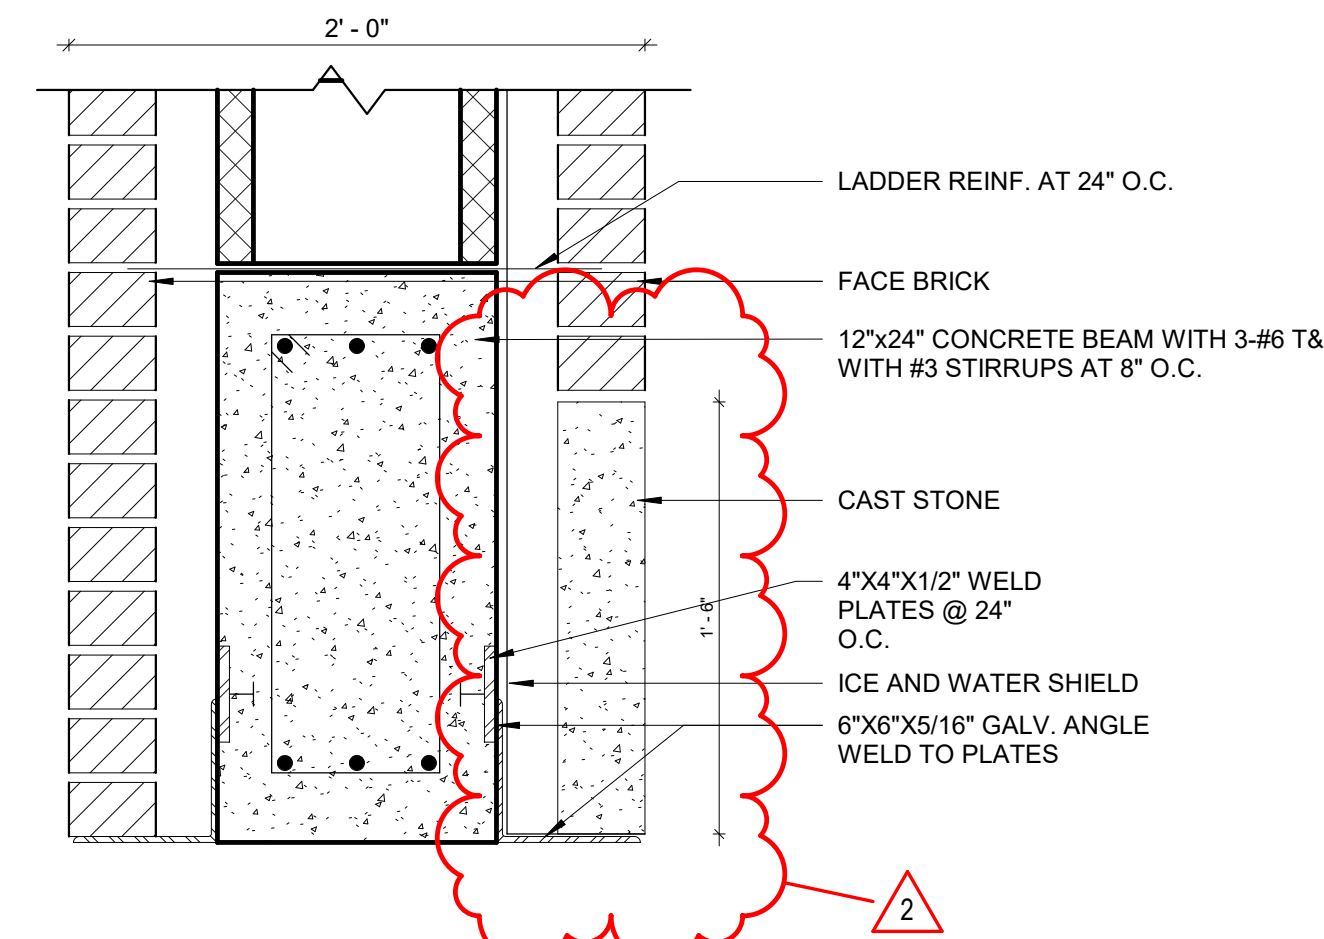


5A WALL DETAIL 5A A403
1 1/2" = 1'-0"

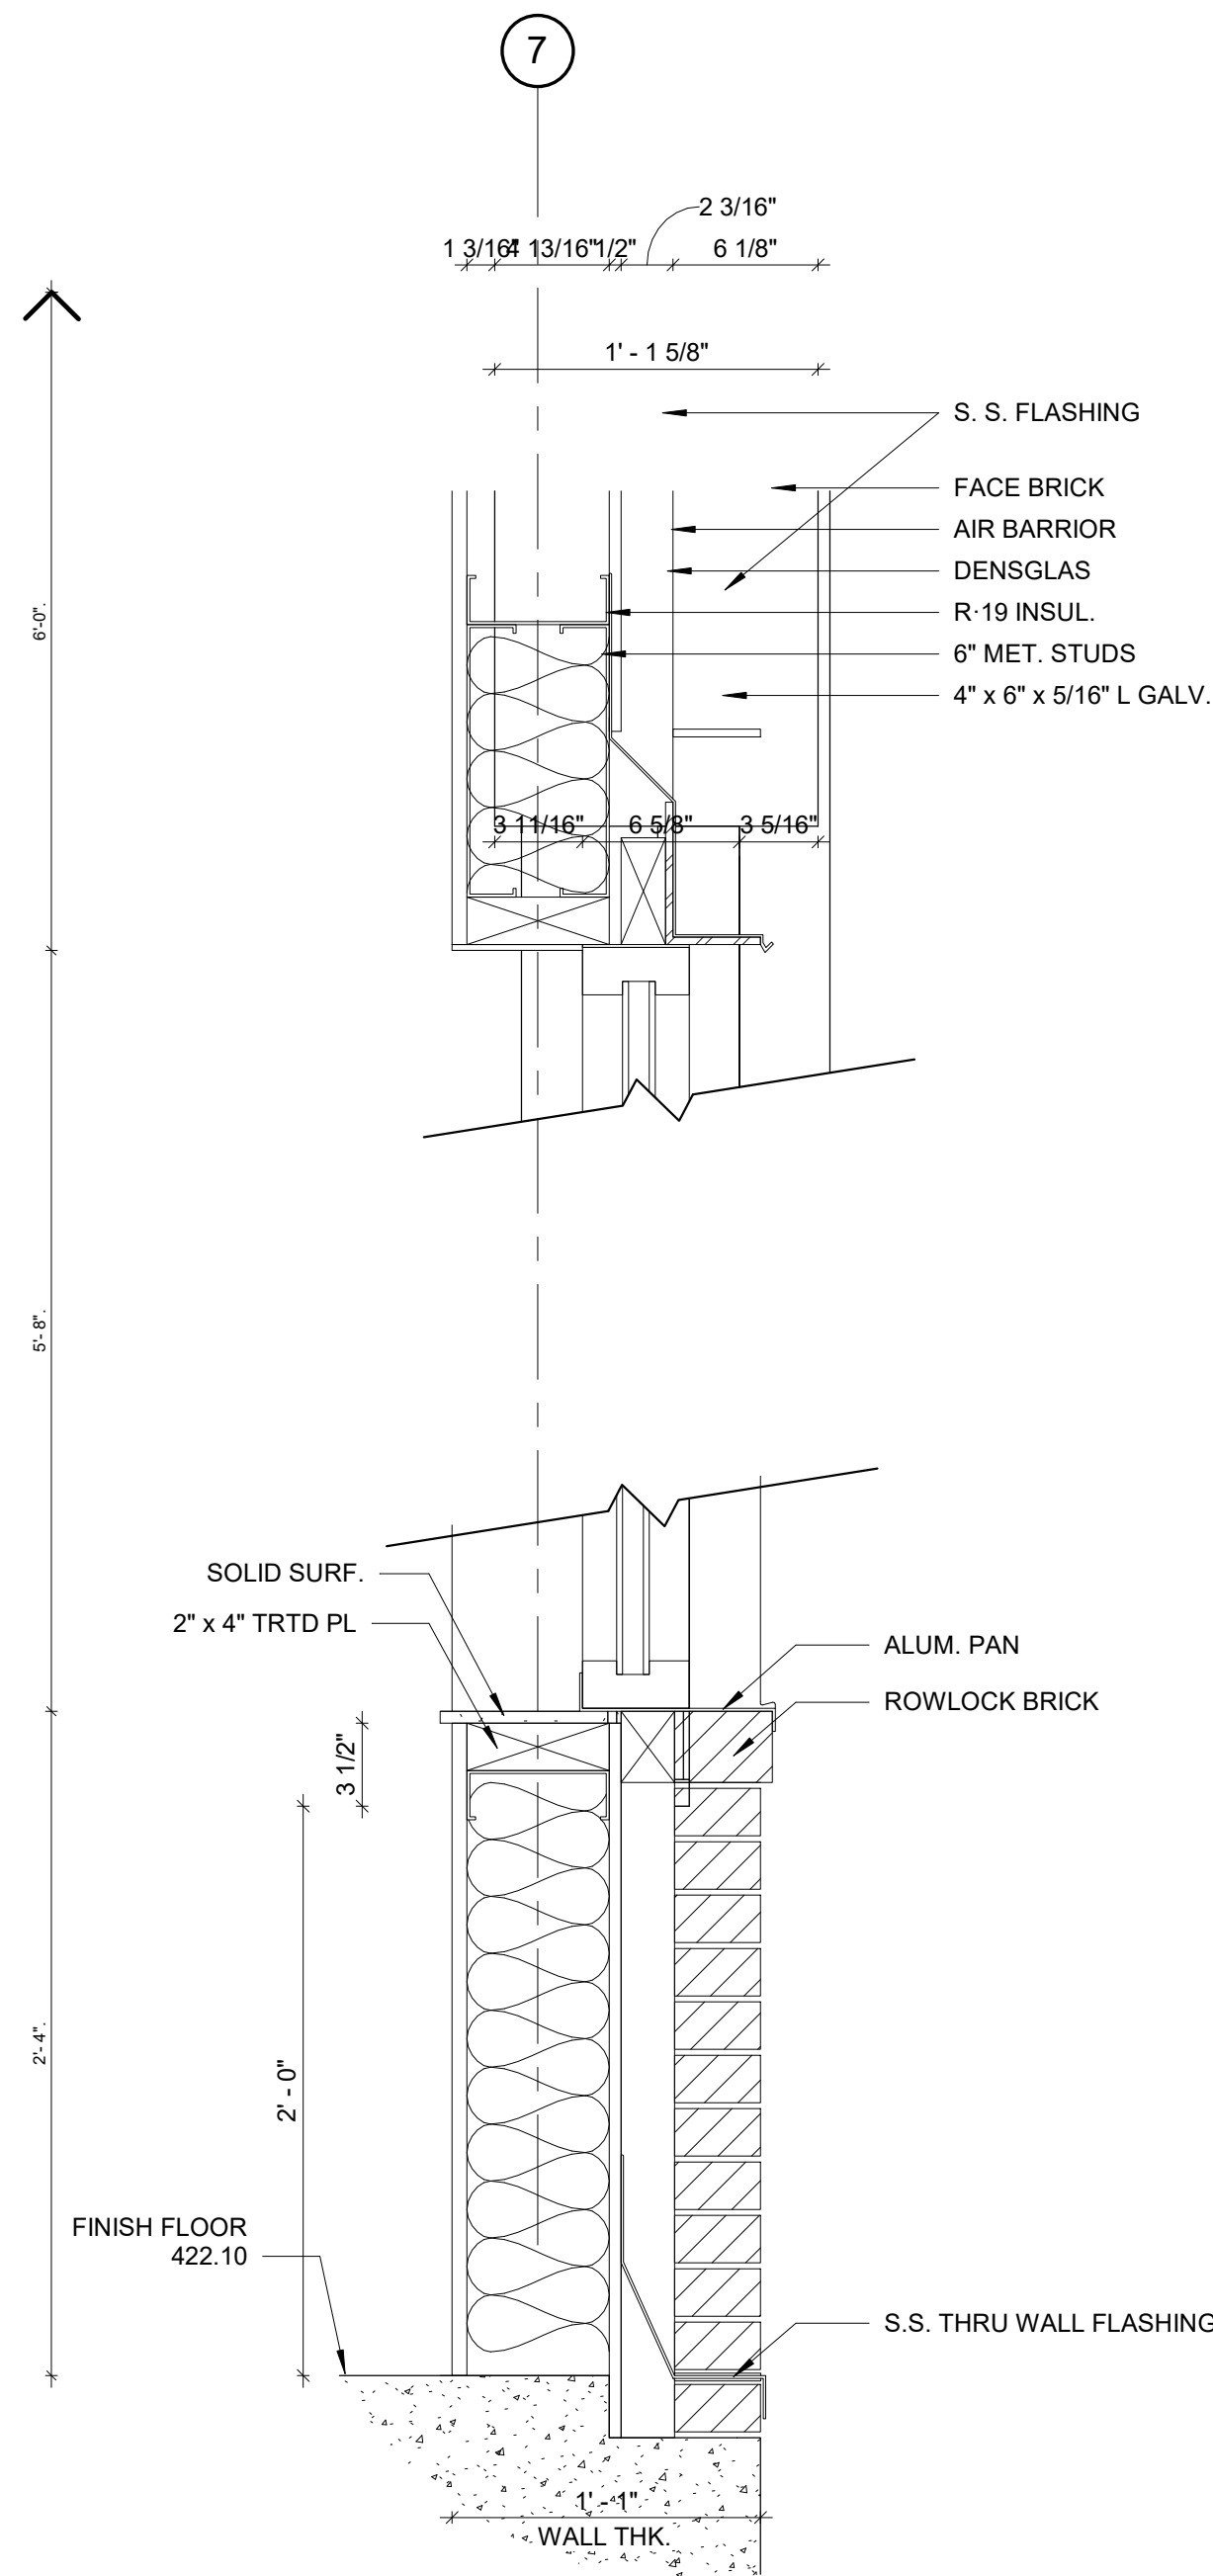


4 WALL & WINDOW DETAIL C SILL
1 1/2" = 1'-0"

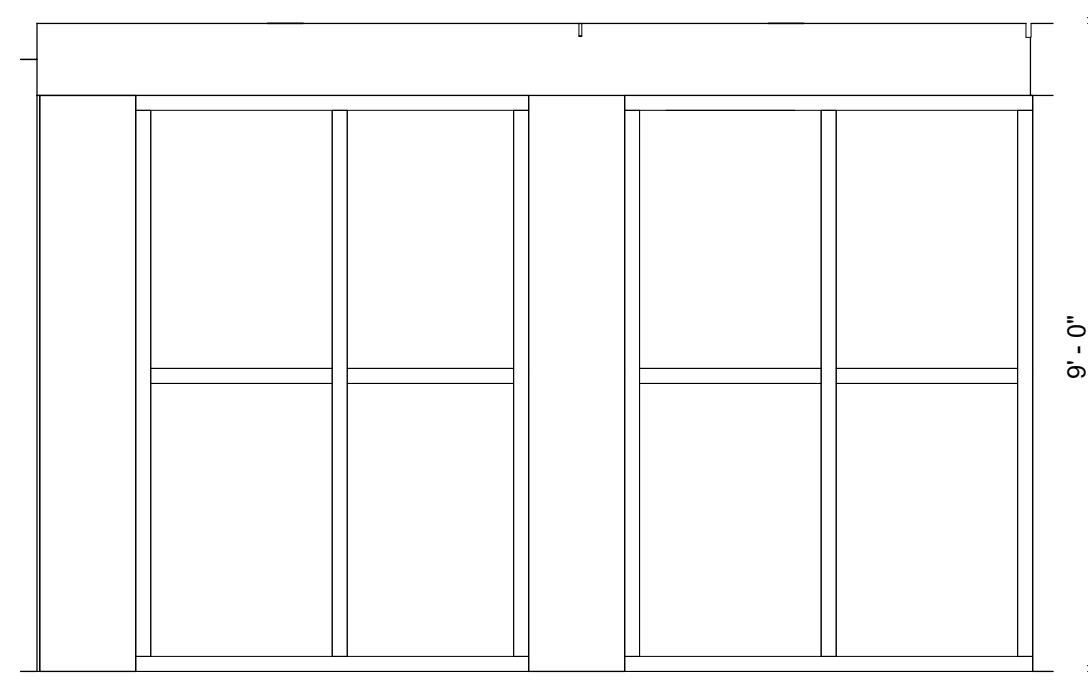


1 VEST 301 NORTH
3/8" = 1'-0"

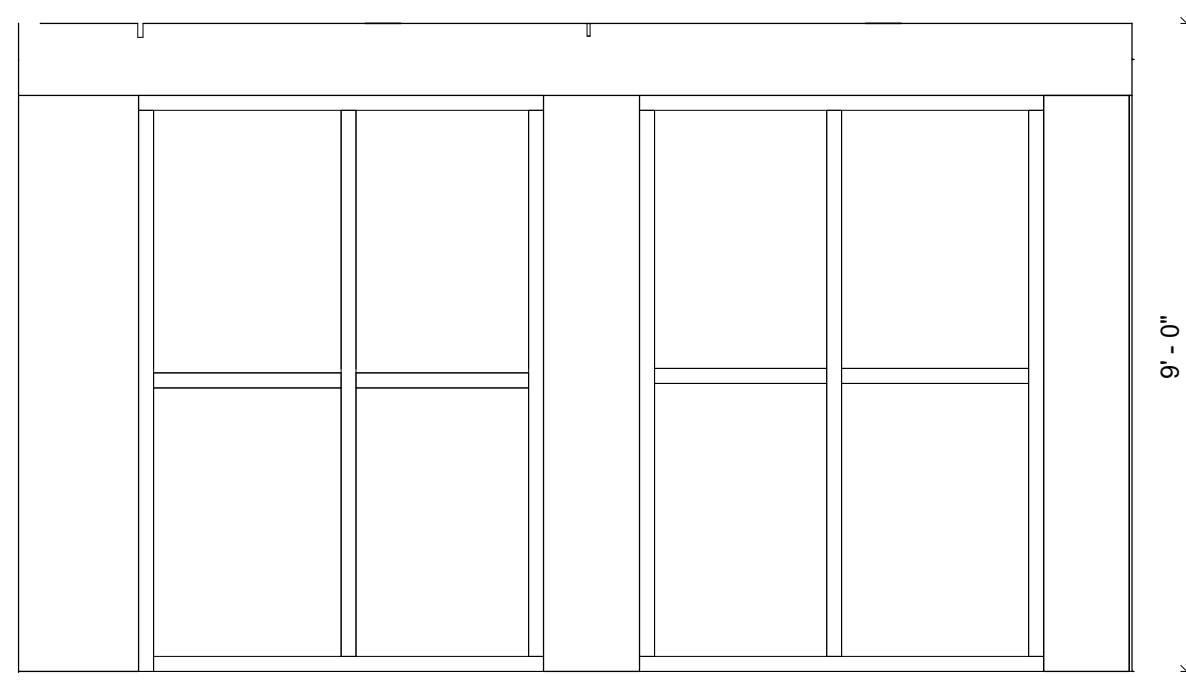


2 VEST 301 SOUTH
3/8" = 1'-0"

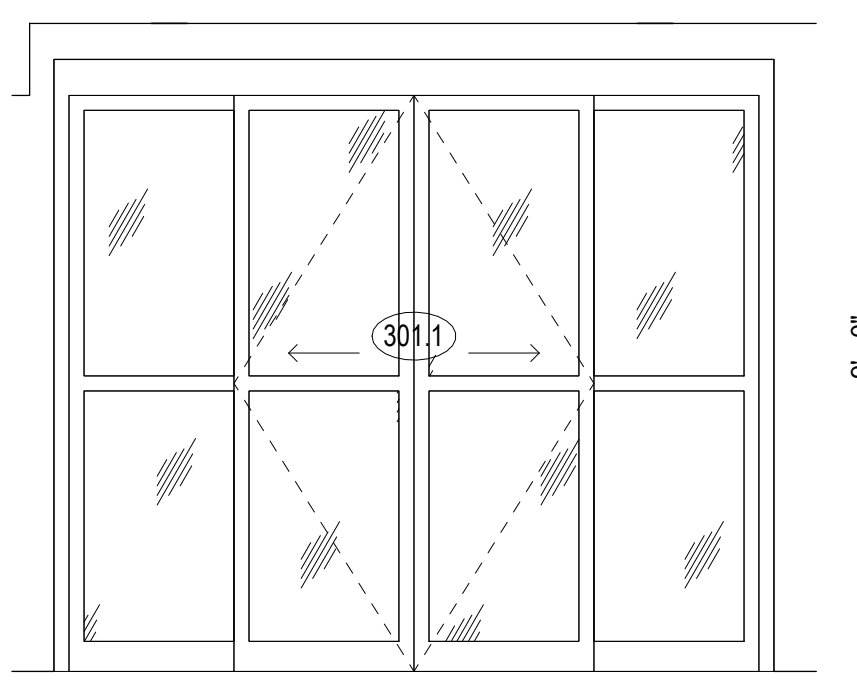


3 VEST 301 WEST
3/8" = 1'-0"

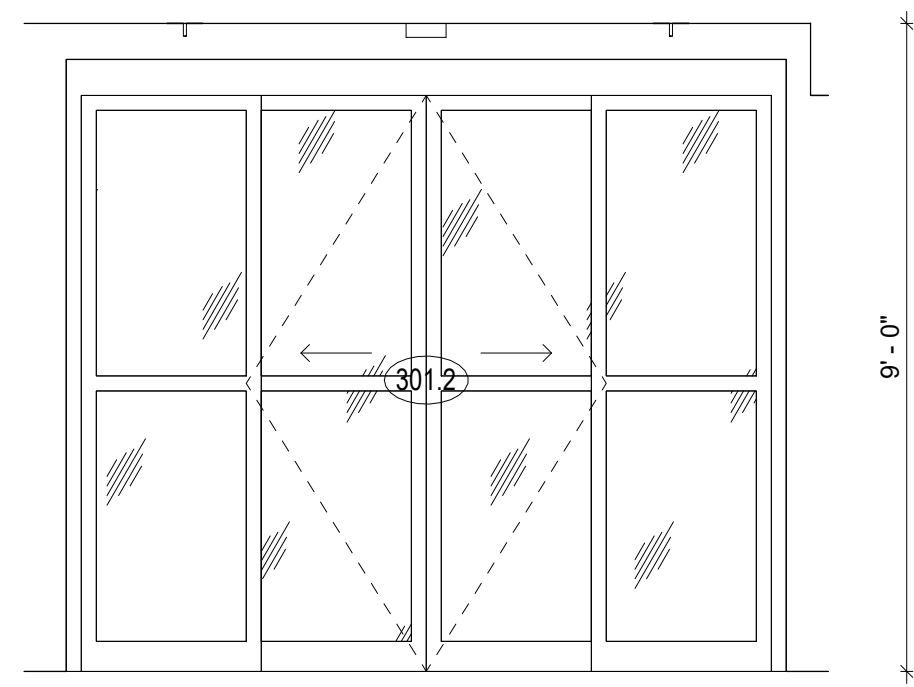


4 VEST 301 EAST
3/8" = 1'-0"

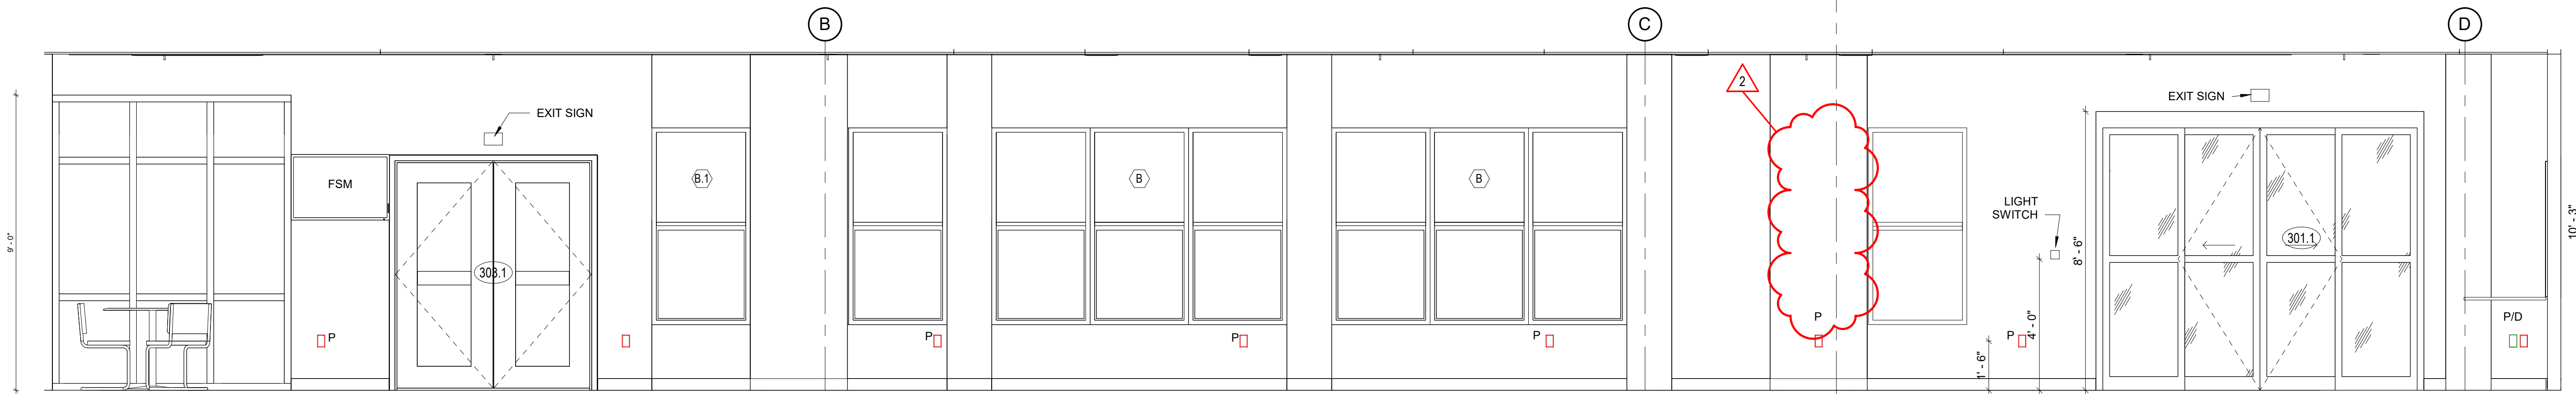


5 LOBBY 302 EAST
3/8" = 1'-0"

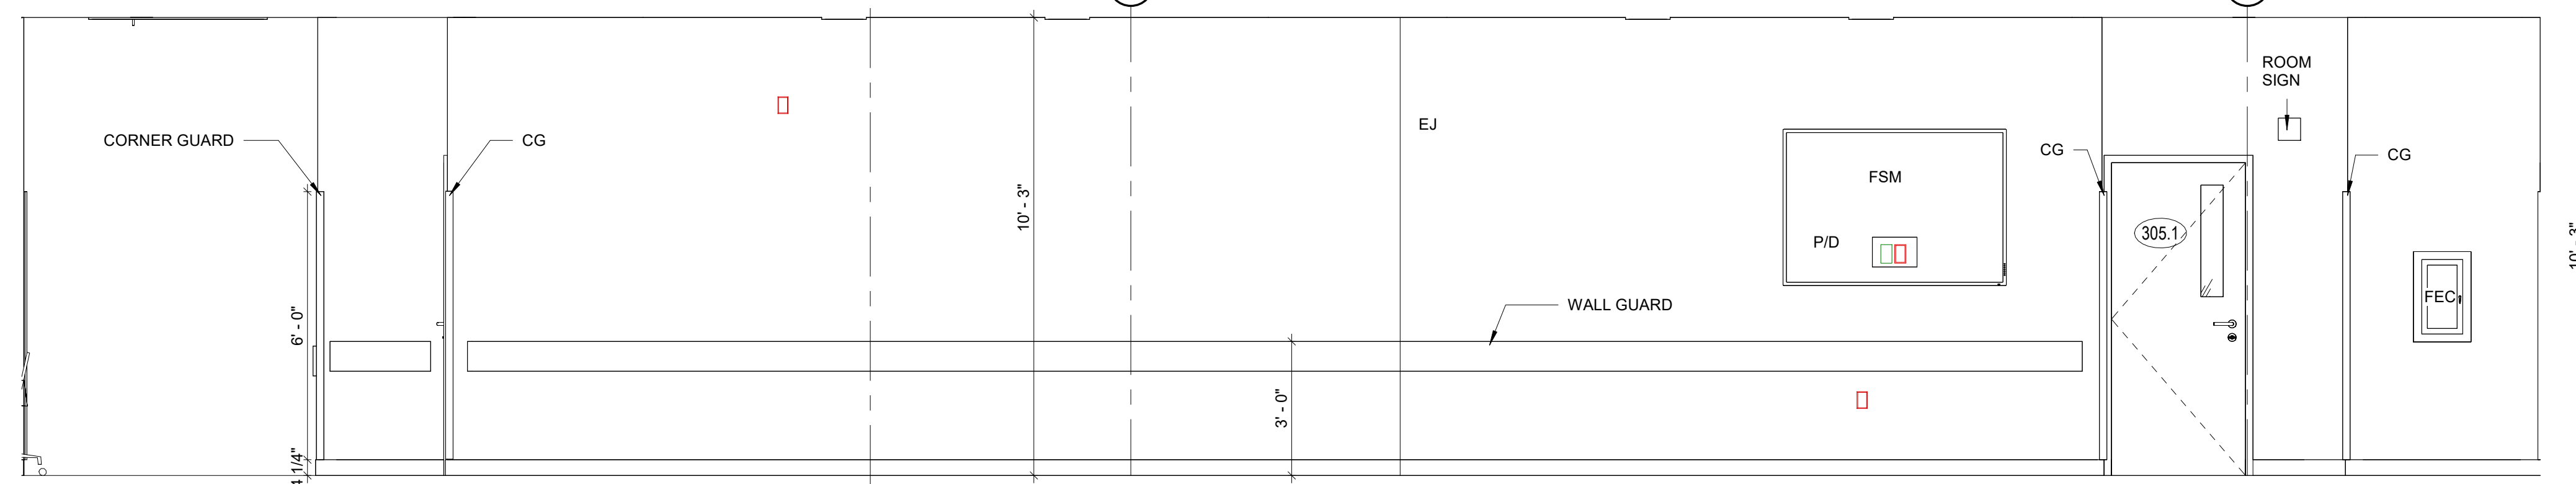


6 LOBBY 302 WEST
3/8" = 1'-0"

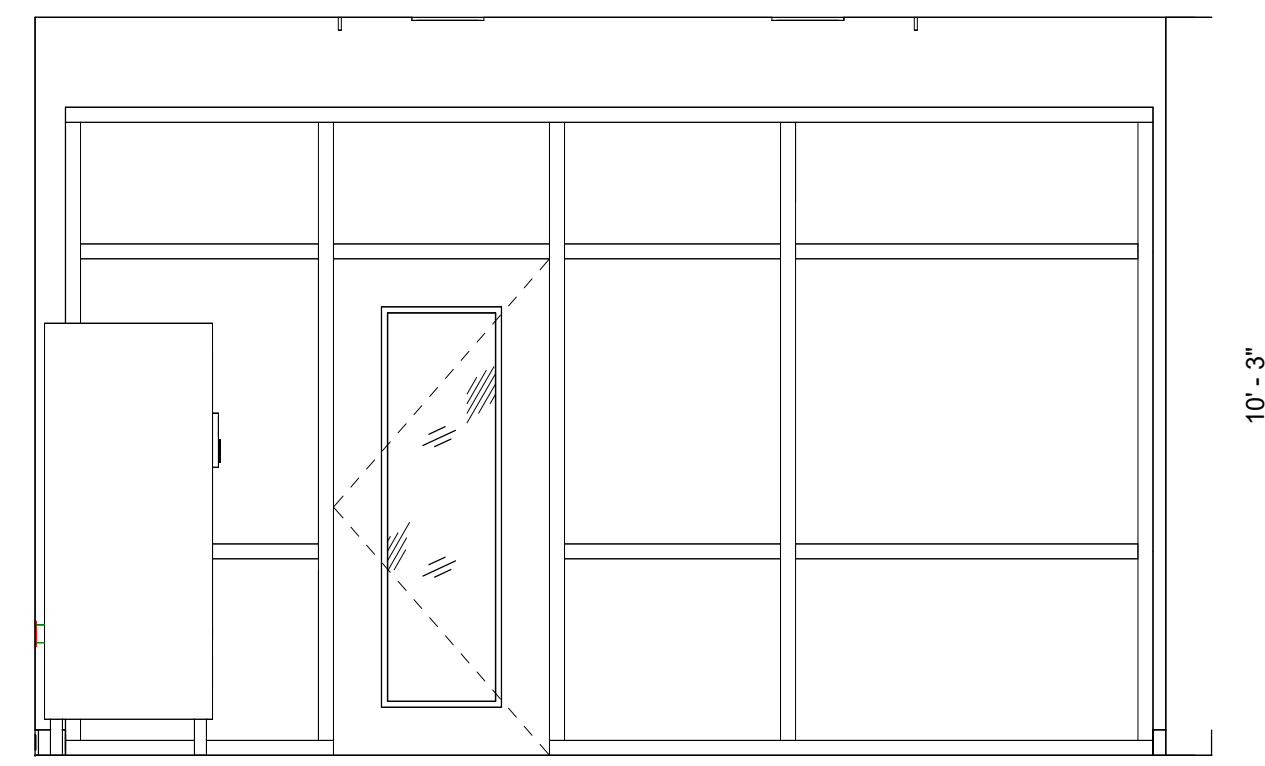


7 VENDING 303 NORTH
3/8" = 1'-0"

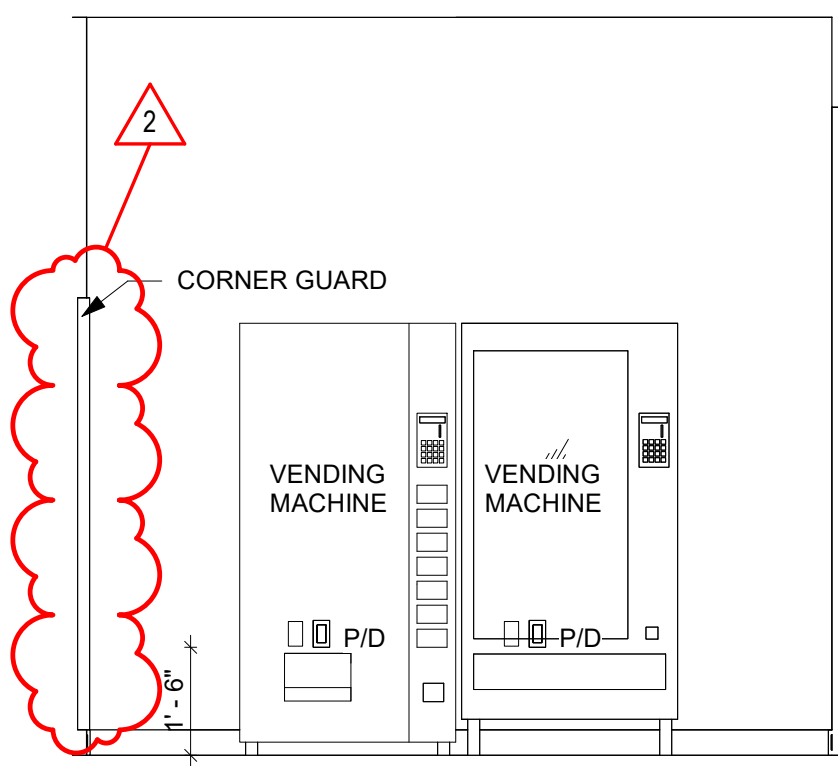


8 VENDING 303 WEST
3/8" = 1'-0"

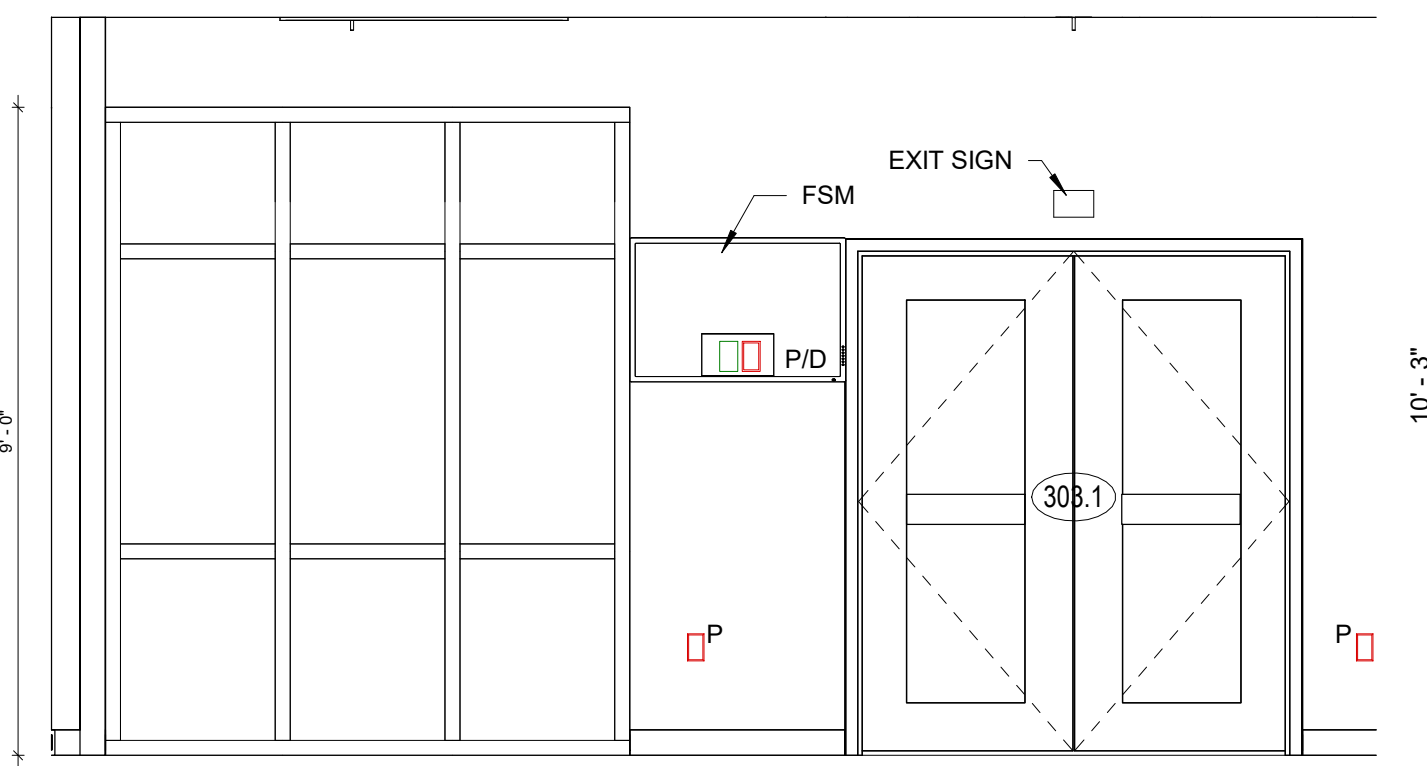

9 VENDING 303 EAST
3/8" = 1'-0"

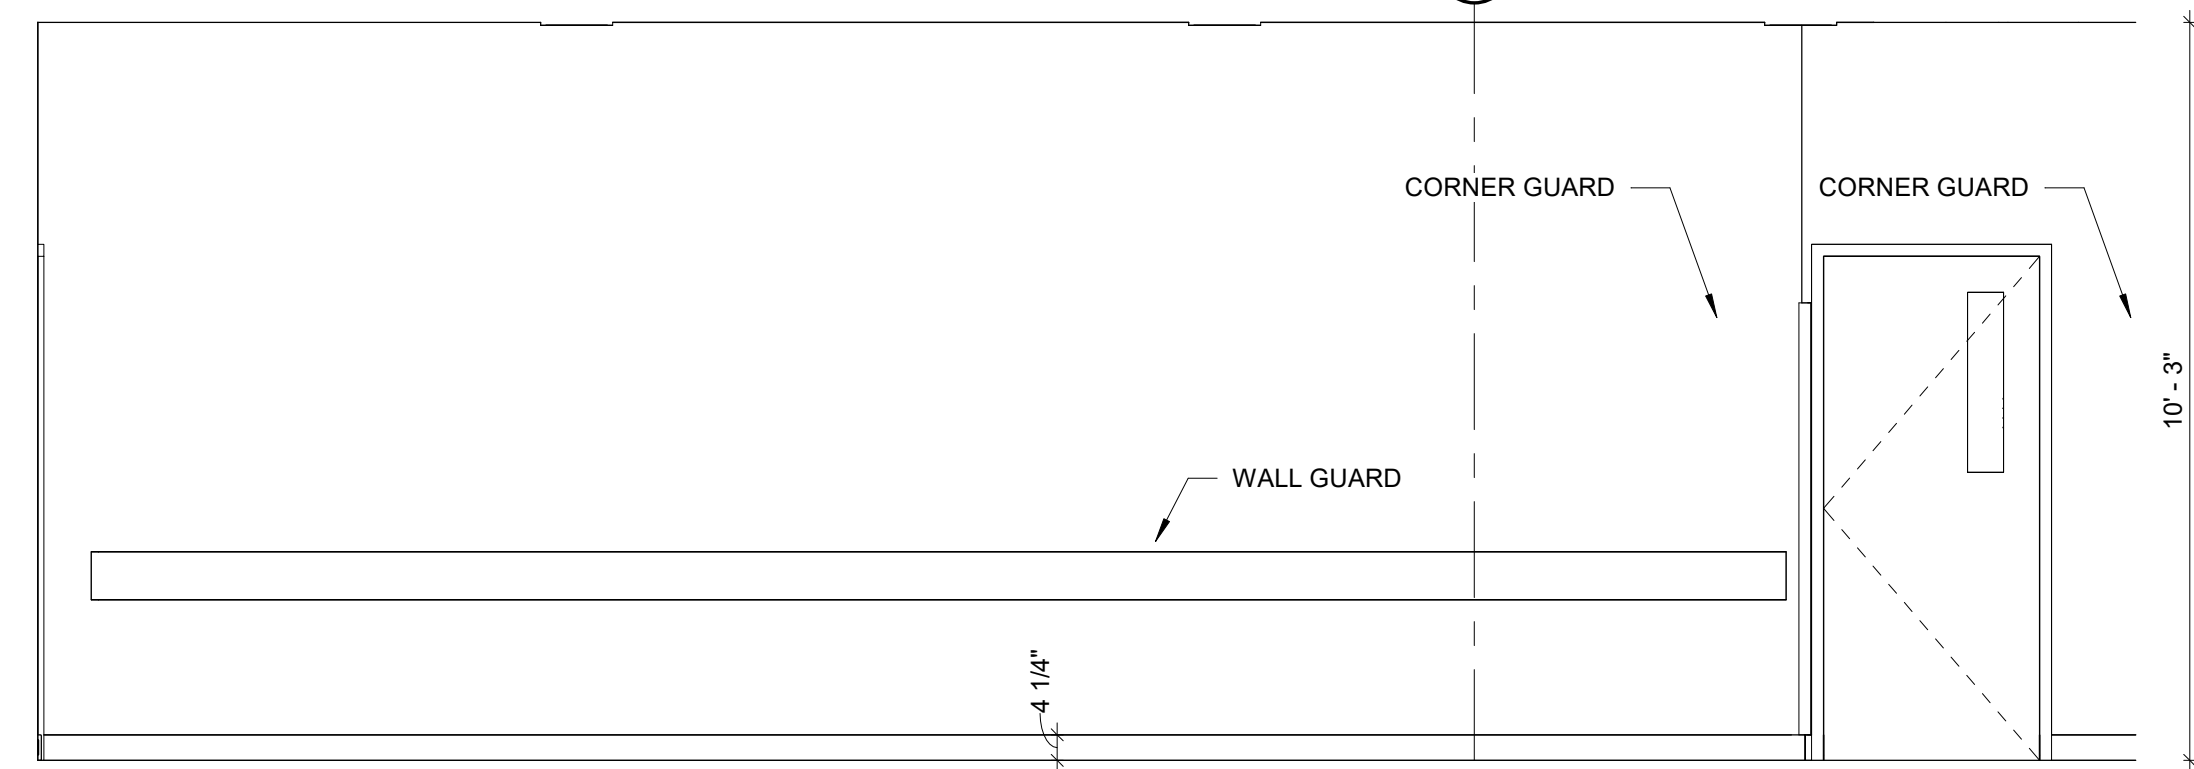

10 CORRIDOR 304 NORTH
3/8" = 1'-0"

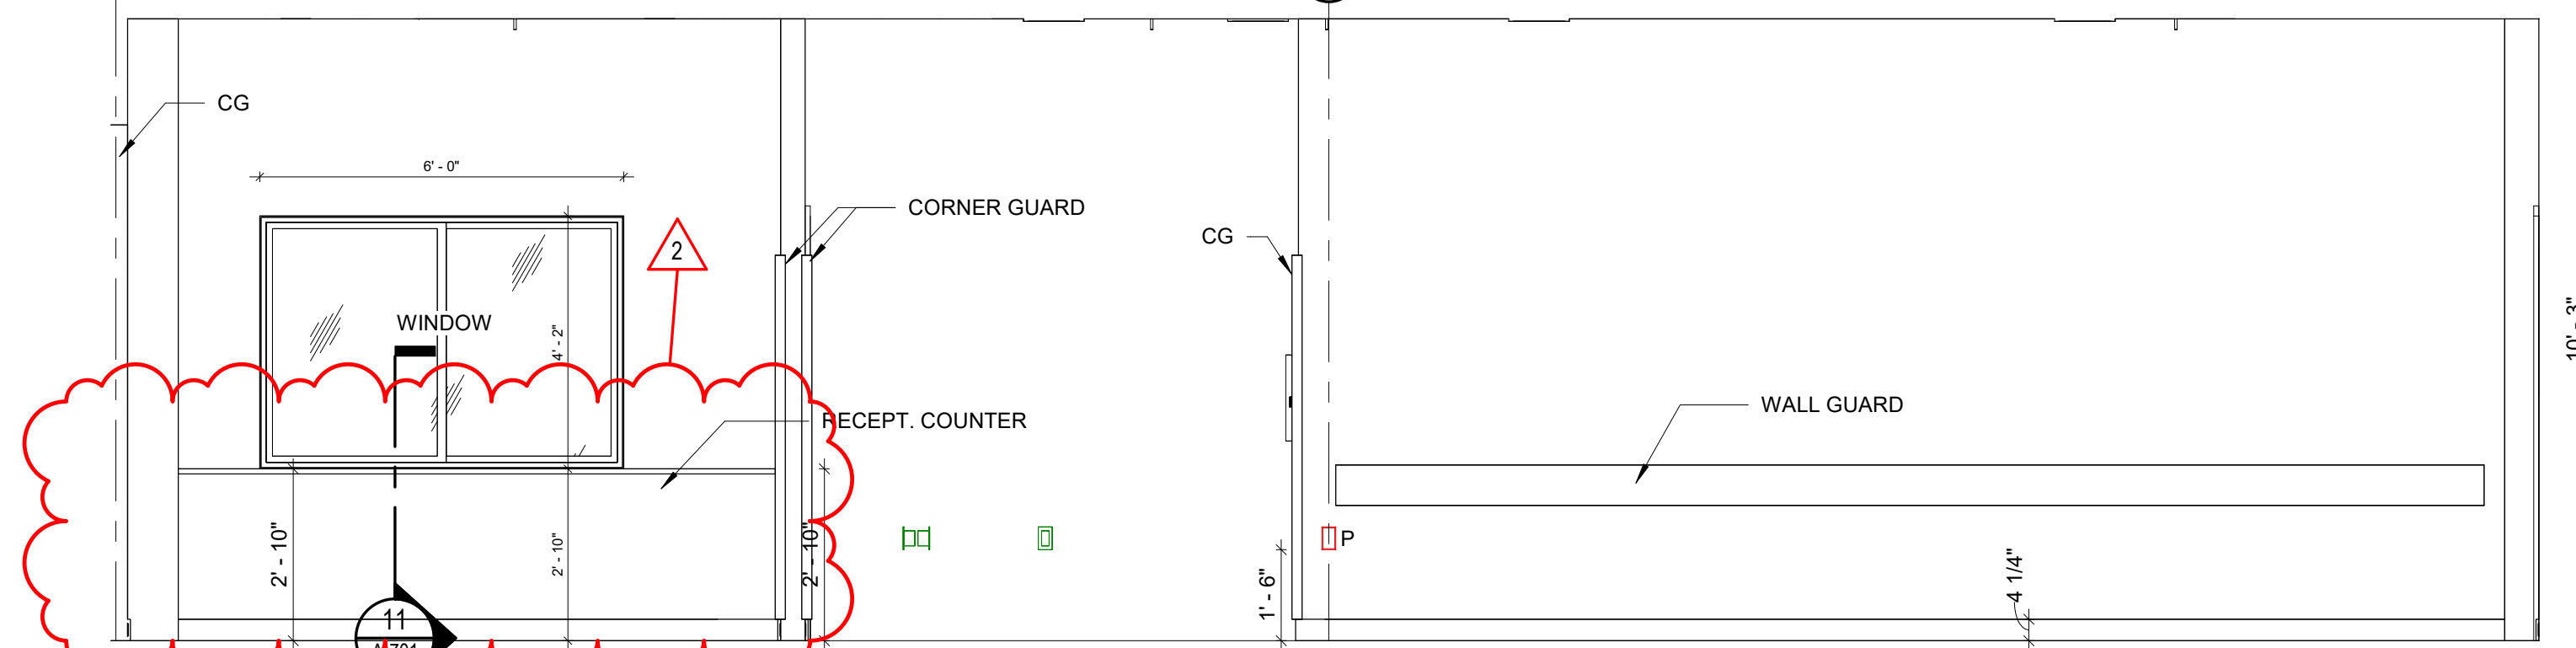

11 CORRIDOR 304 SOUTH
3/8" = 1'-0"



FoilWatt
Architects & Planners, PLLC
SUITE 200
150 NORTH STATE STREET
MEMPHIS, TN 38103
TELEPHONE (901) 552-3071
FAX (901) 552-3071
WWW.FOILWATT.COM

THE W NURSING SCHOOL
AT NESHOBIA GENERAL HOSPITAL

Philadelphia, MS 38350


CONSTRUCTION DOCUMENTS

project no.
1661 - 23
date
04 JUNE 2026
revised
2 6-9-2026


drawn by
HJ

INTERIOR
ELEVATIONS


sheet no.
A-501
of

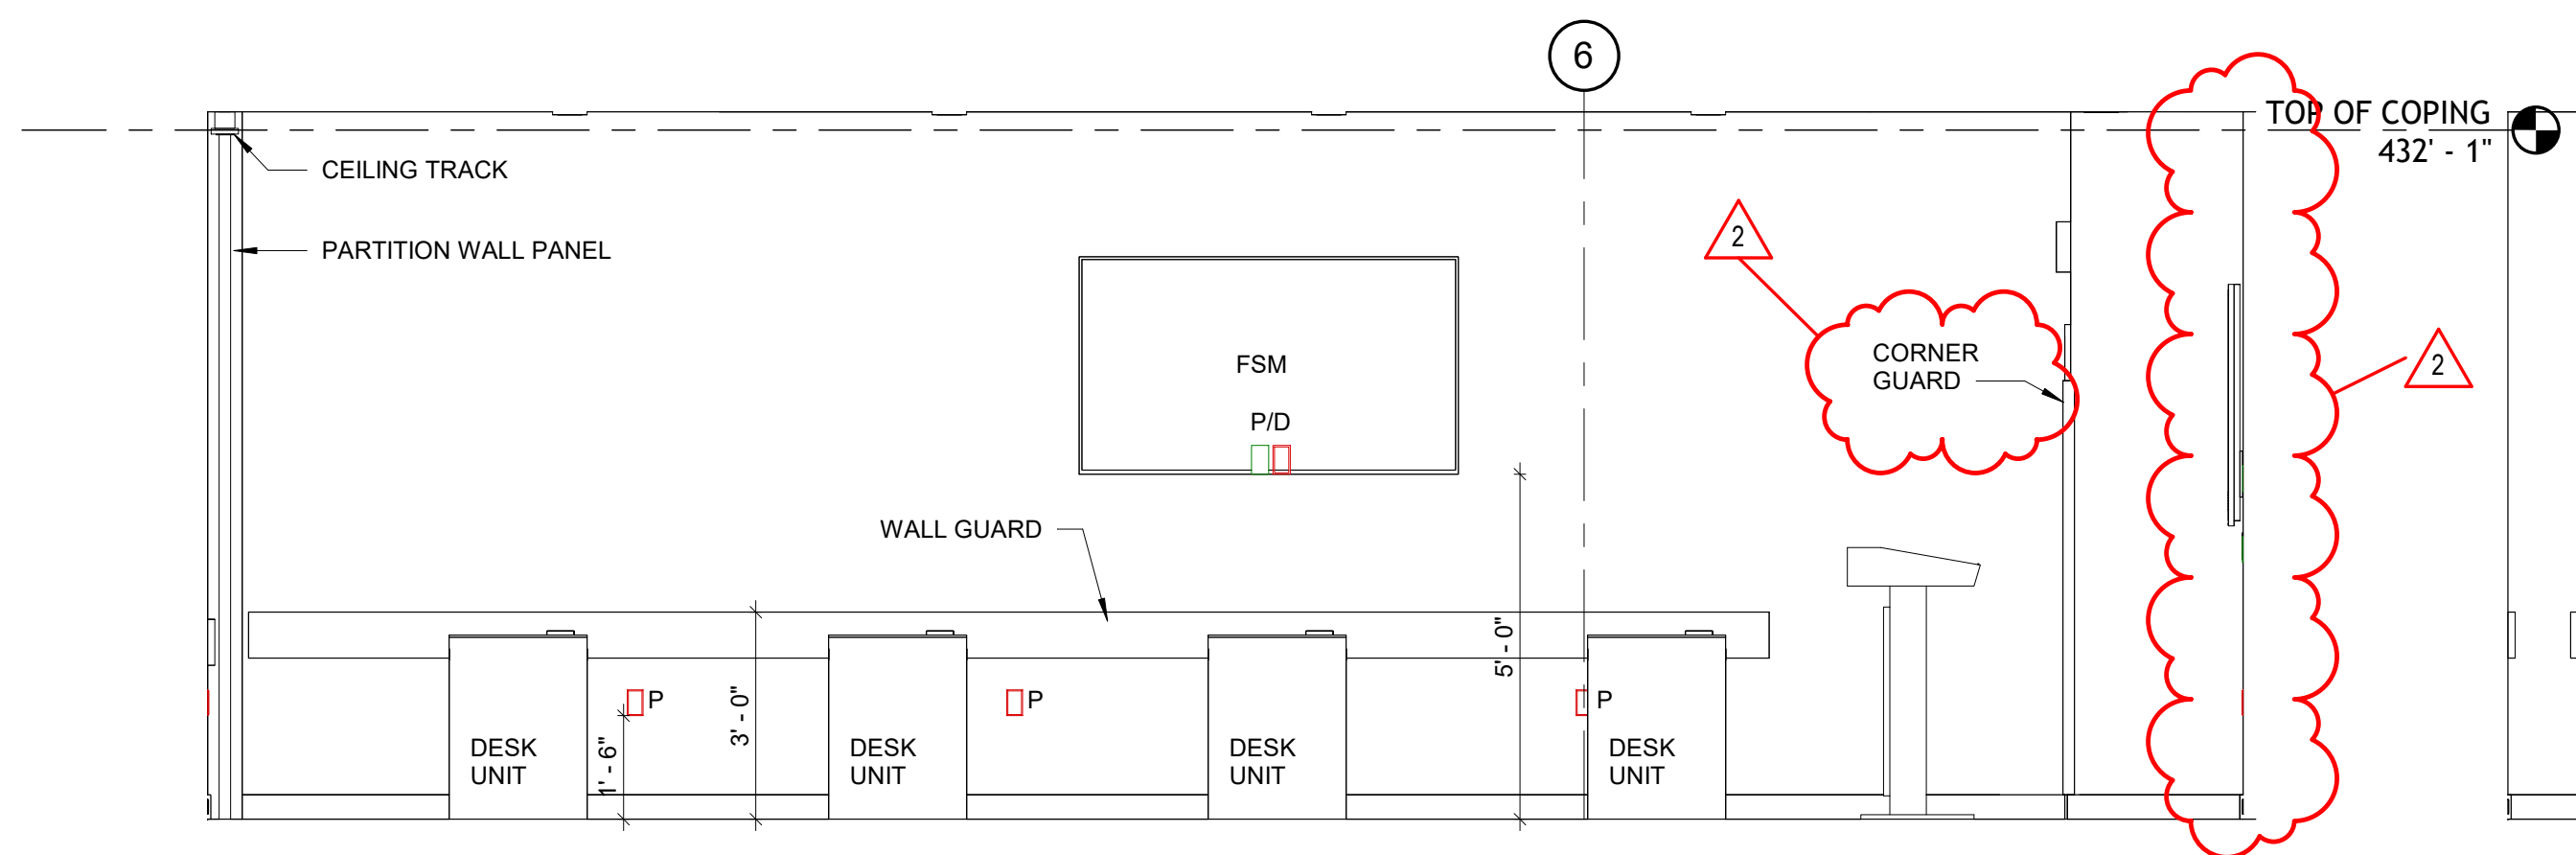


1 CLASSROOM 305 NORTH
3/8" = 1'-0"

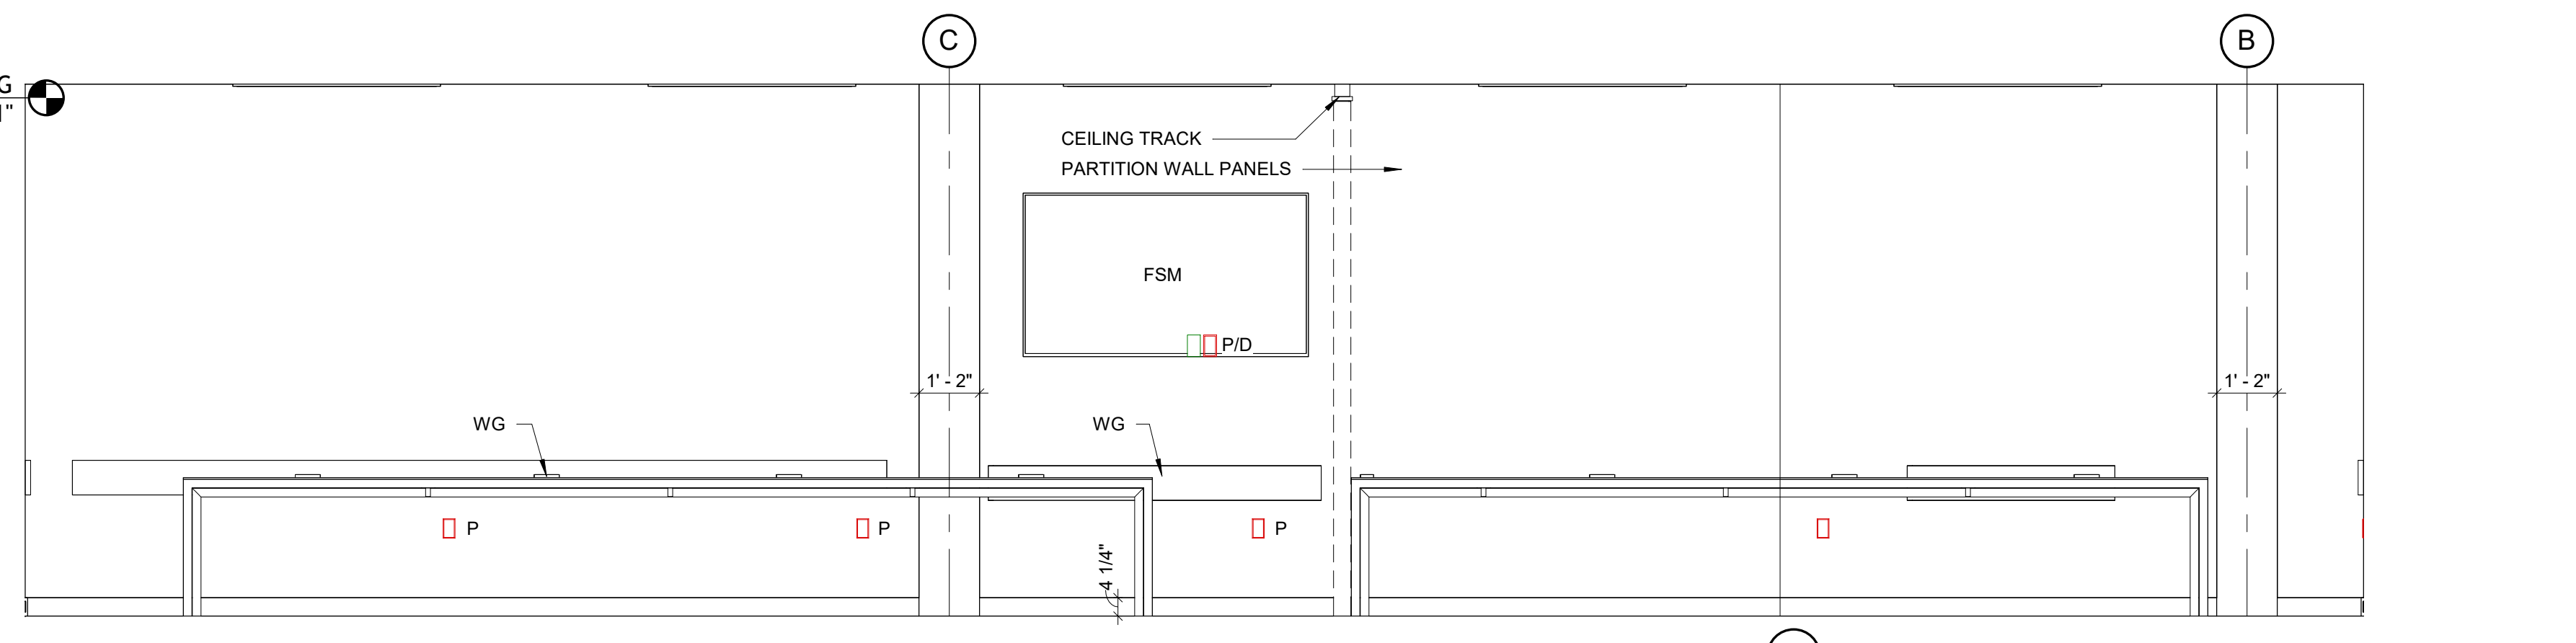


2 CLASSROOM 305 WEST
3/8" = 1'-0"

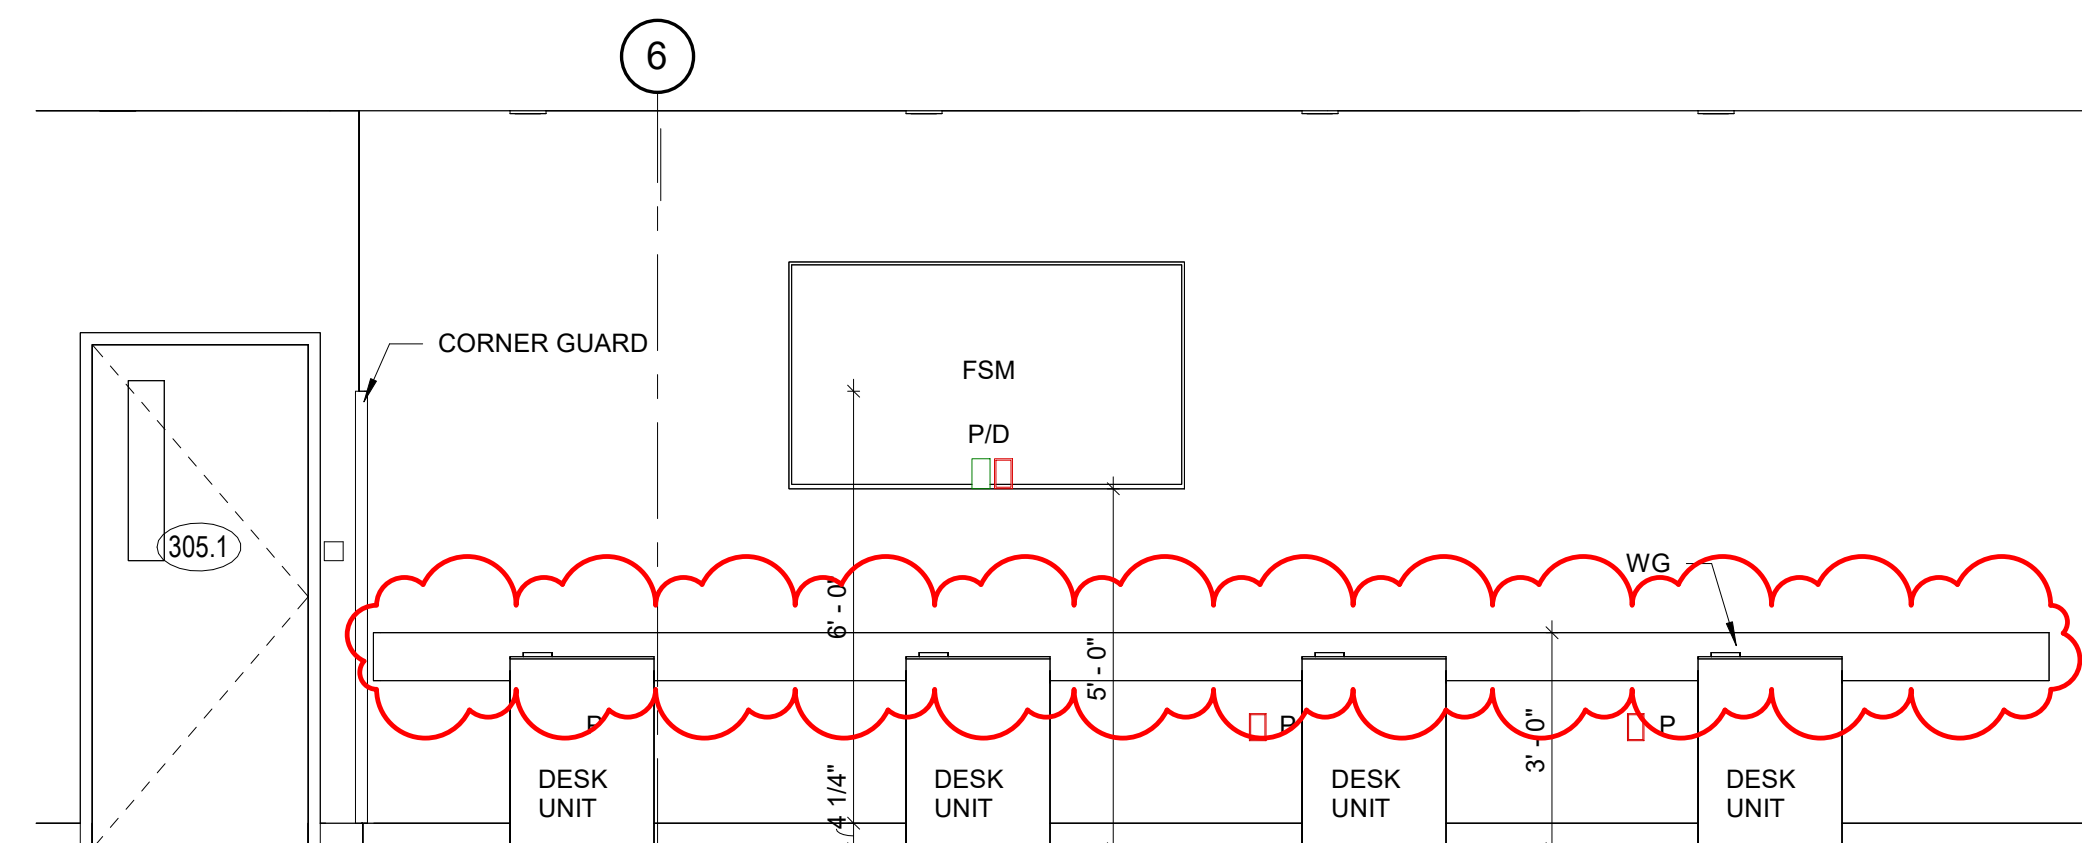


3 CLASSROOM 305 SOUTH
3/8" = 1'-0"

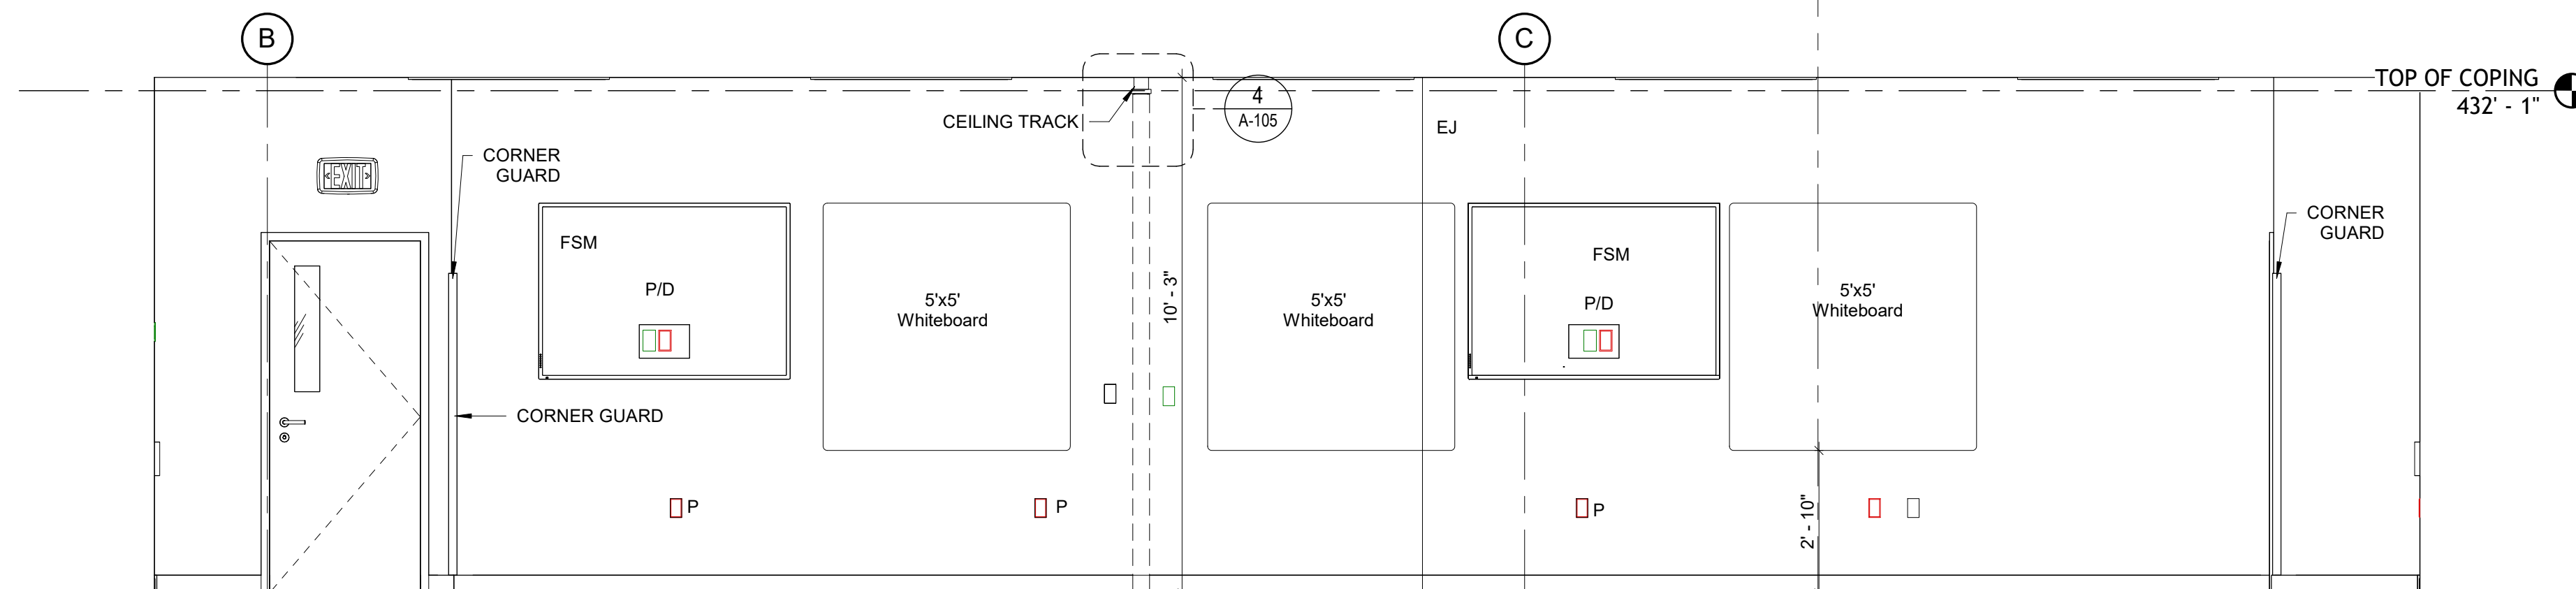


4 CLASSROOM 305 EAST
3/8" = 1'-0"

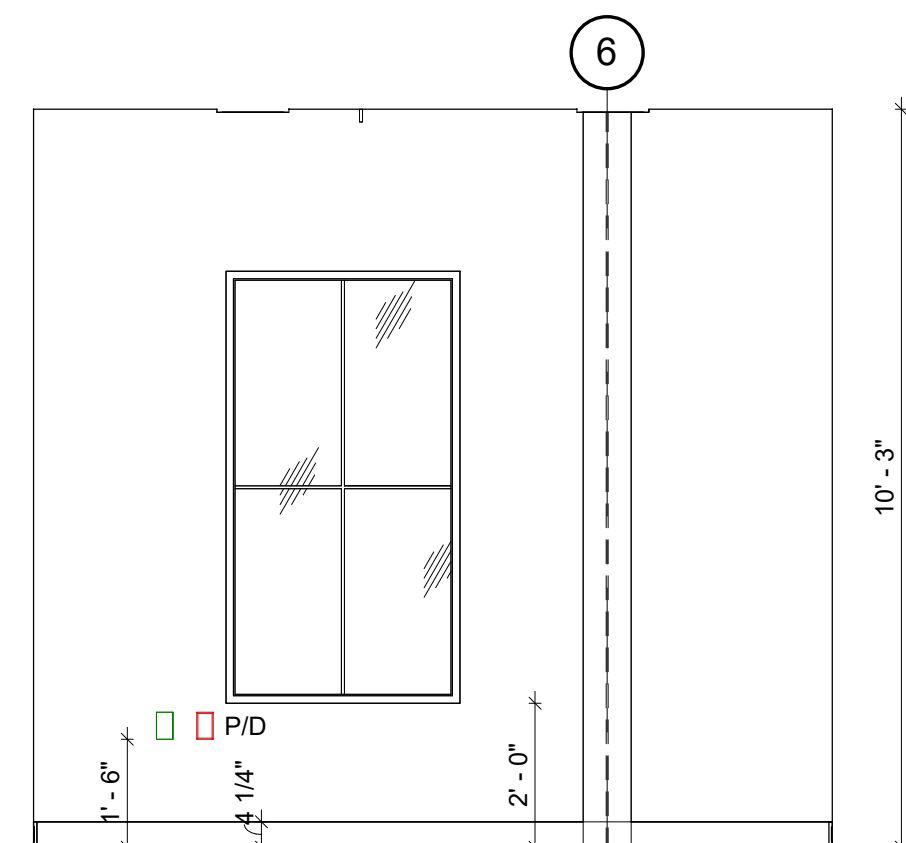


5 OFFICE 307 NORTH (OFFICE 313/315/317 SIMILAR)
3/8" = 1'-0"

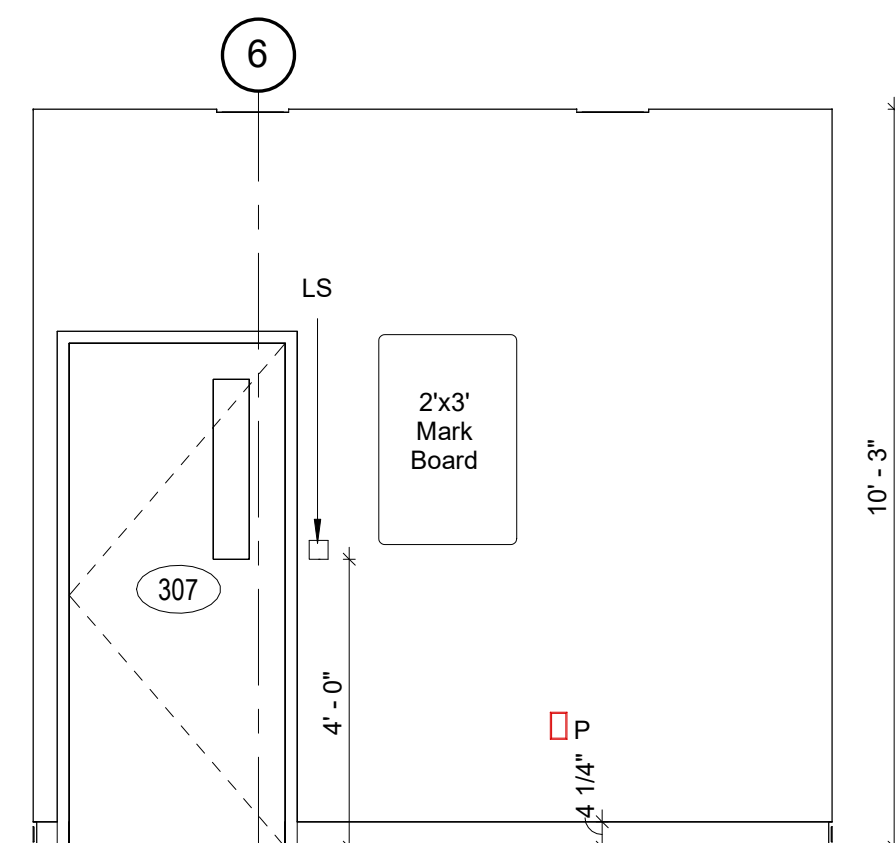


6 OFFICE 307 SOUTH
3/8" = 1'-0"

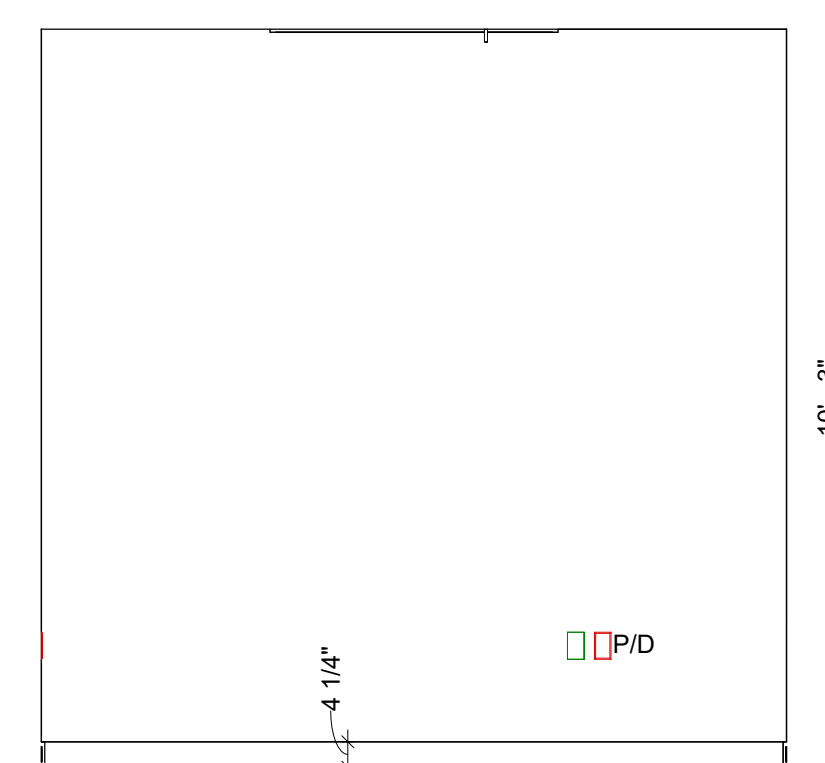


7 OFFICE 307 WEST
3/8" = 1'-0"

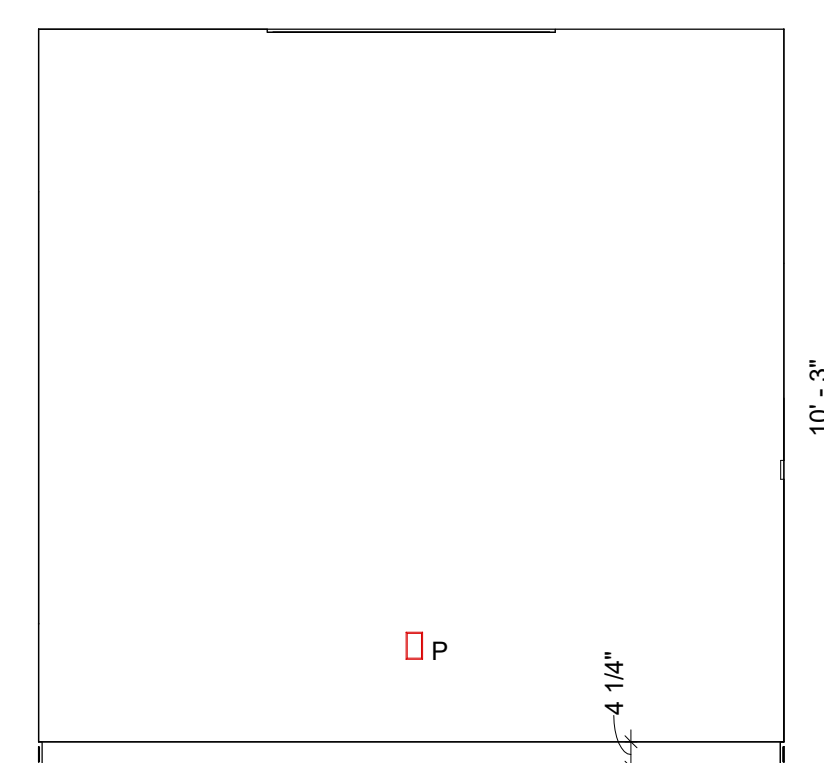


8 OFFICE 307 EAST
3/8" = 1'-0"

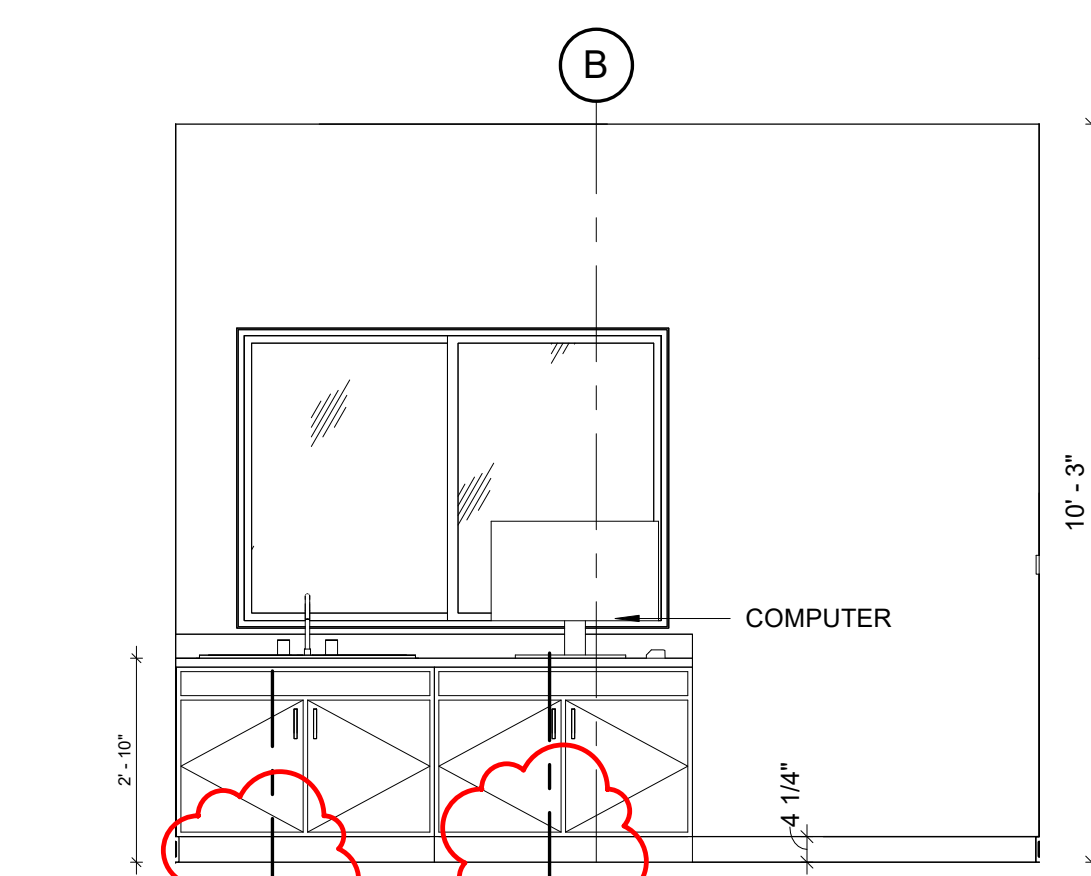


9 PT. RM 319 EAST (PT. RM. 310 SIMILAR)
3/8" = 1'-0"

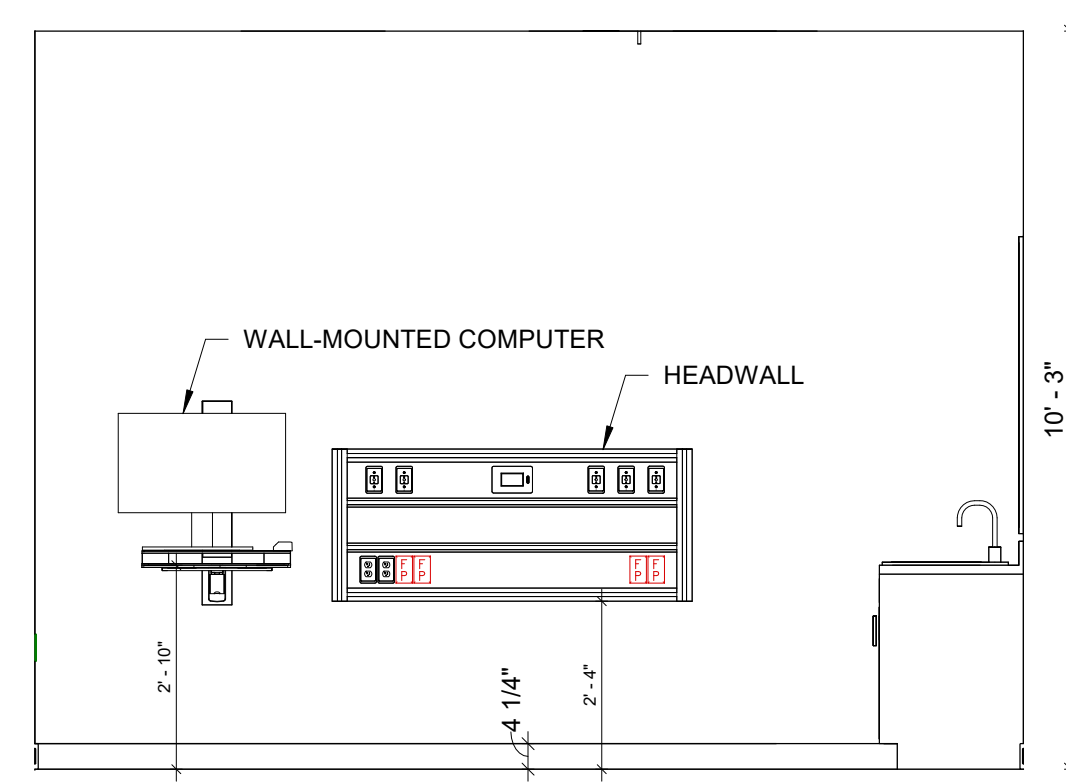


10 PT. RM 319 SOUTH
3/8" = 1'-0"

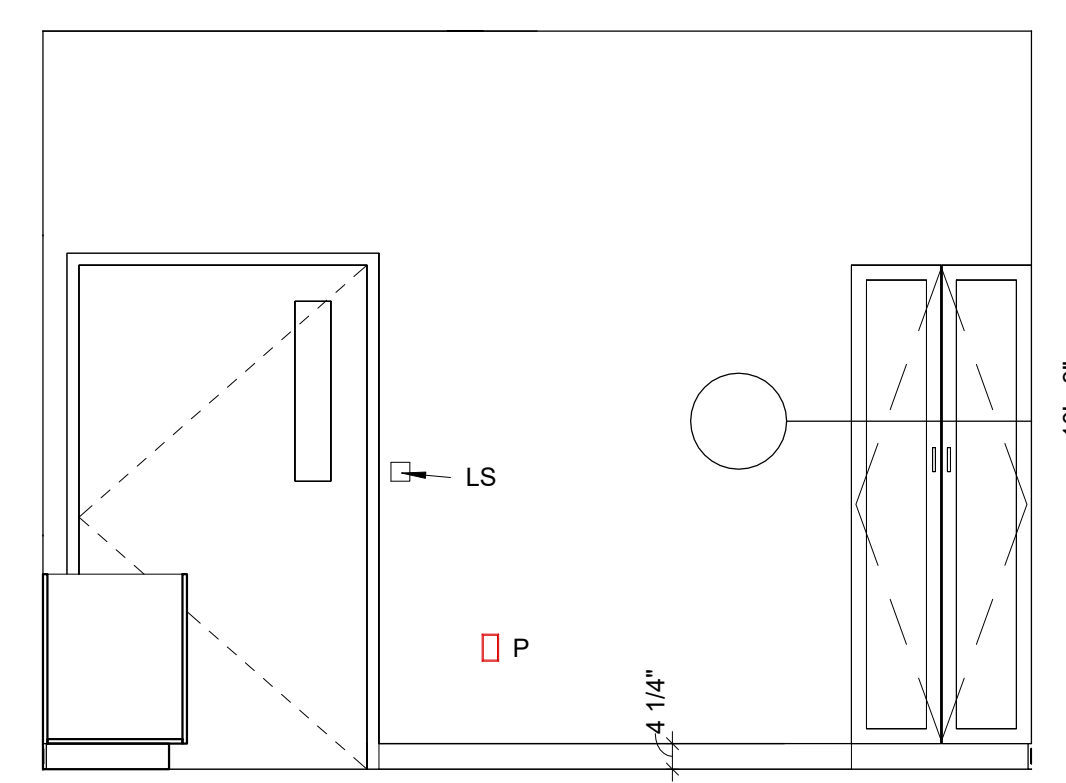


11 IPT. RM. 319 NORTH
3/8" = 1'-0"

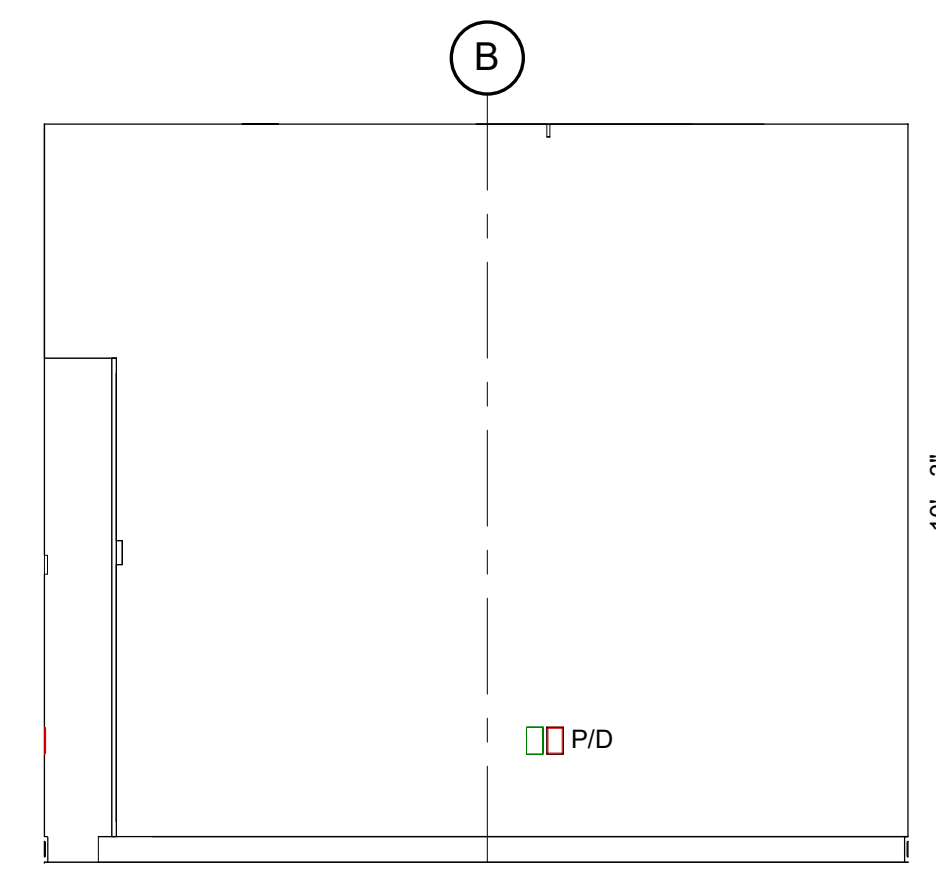


12 PT. RM. 319 WEST
3/8" = 1'-0"

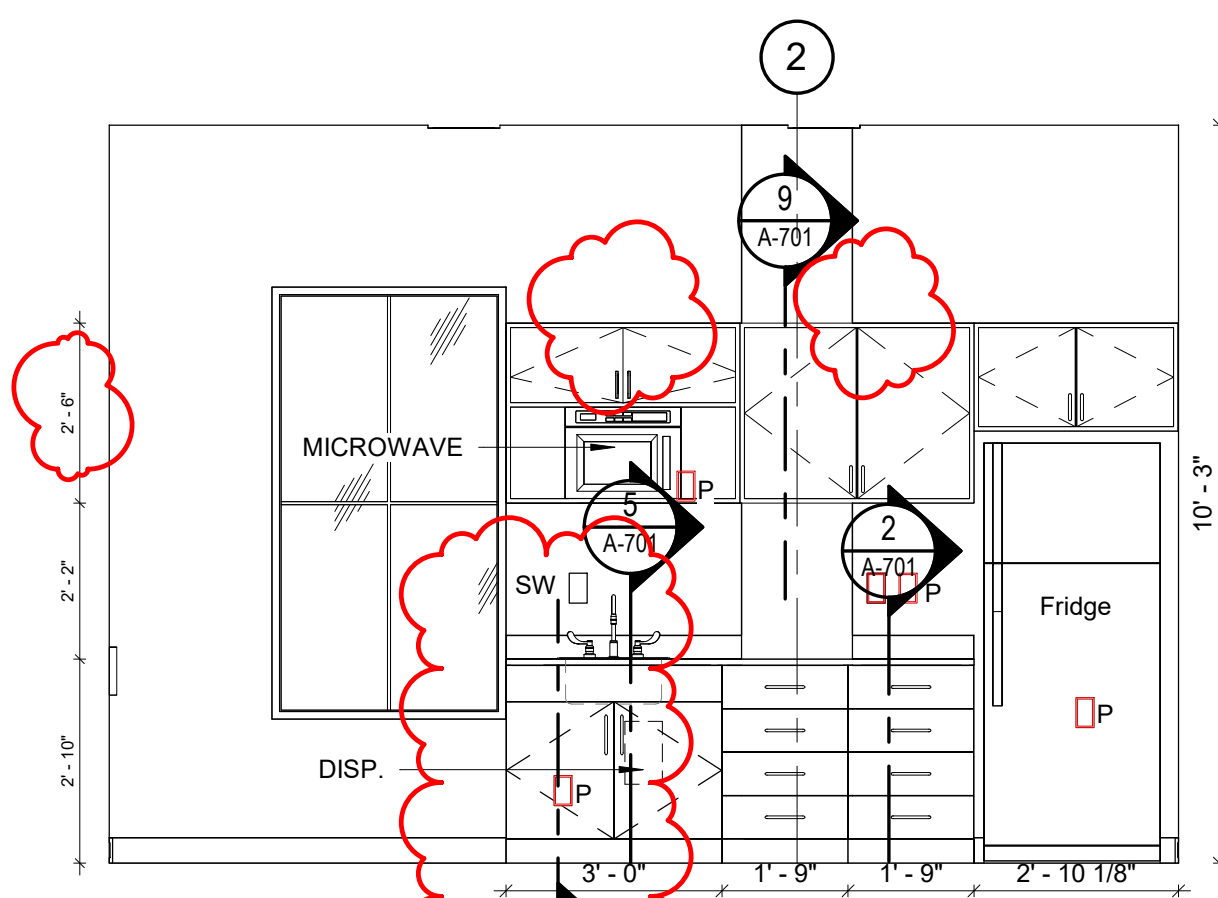


13 OFF&BRK 319 NORTH
3/8" = 1'-0"

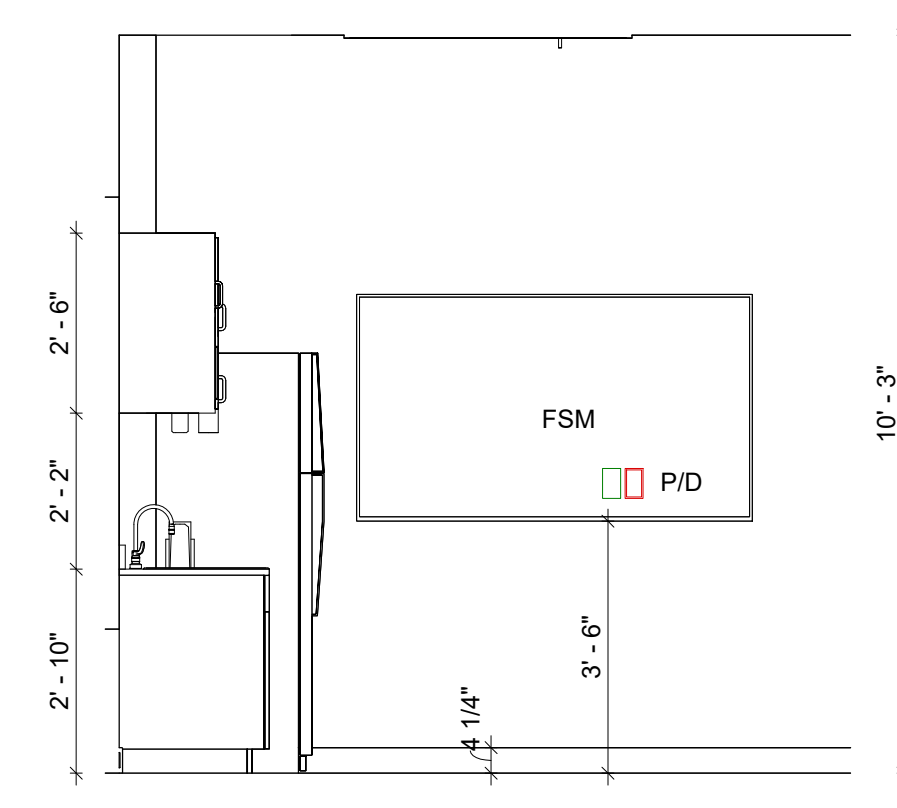

14 OFF&BRK 319 EAST
3/8" = 1'-0"

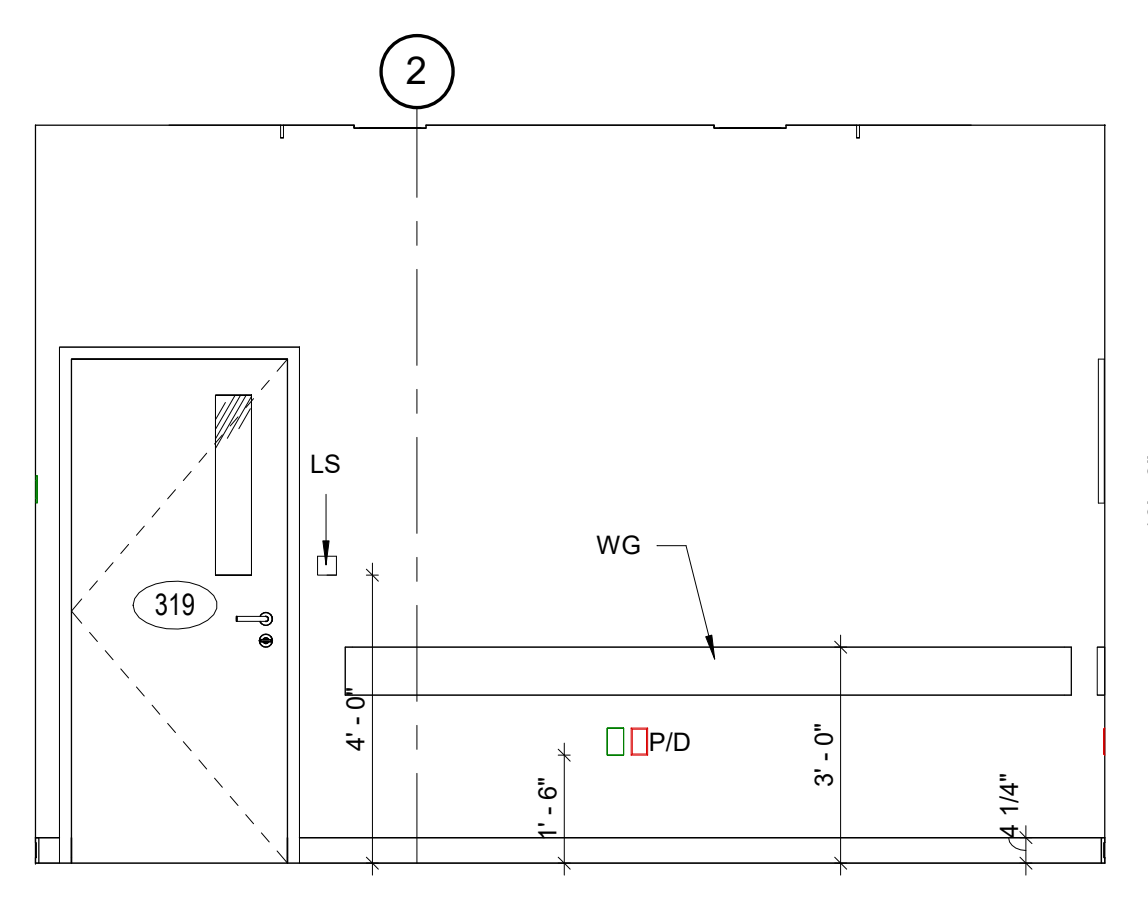

15 OFF&BRK 319 SOUTH
3/8" = 1'-0"

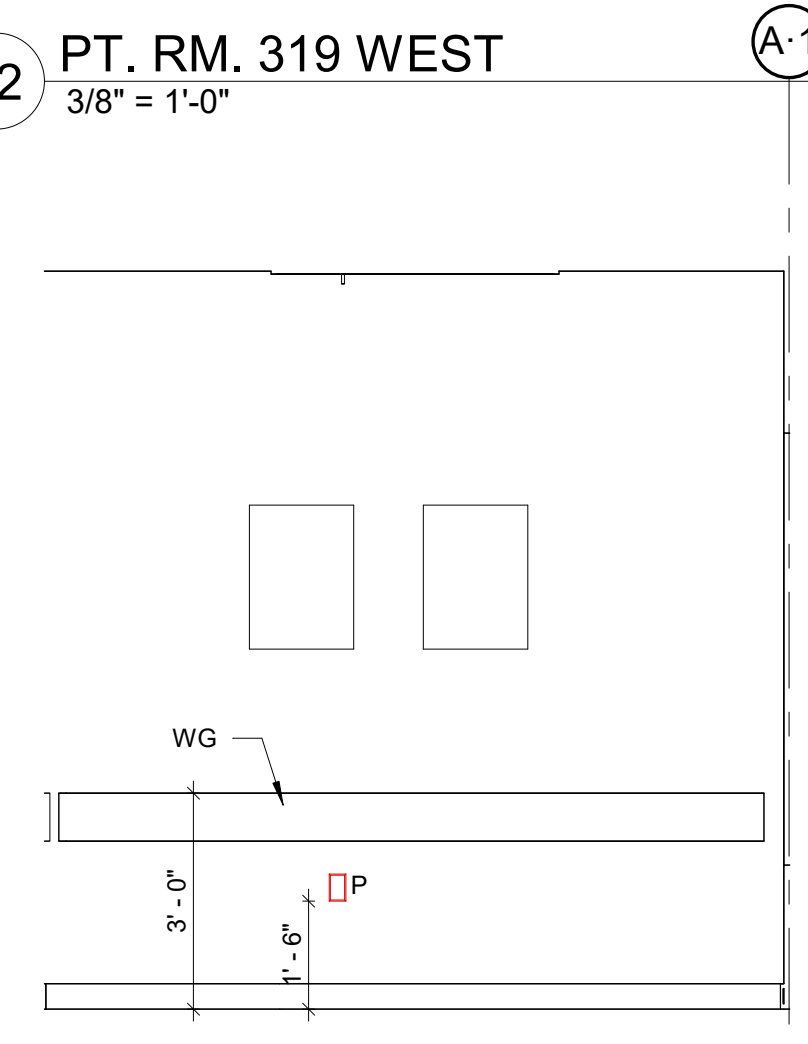

16 OFF&BRK 319 WEST
3/8" = 1'-0"



FoilWatt
Architects & Planners, PLLC
SUITE 200
150 NORTH STATE STREET
MEMPHIS, TN 38103
TELEPHONE (901) 552-3071
FAX (901) 552-3071
WWW.FOILWATT.COM

THE W NURSING SCHOOL
AT NESHOBIA GENERAL HOSPITAL

Philadelphia, MS 38350


CONSTRUCTION DOCUMENTS

project no.
1661 - 23
date
04 JUNE 2026
revised
2 6-9-2026


drawn by
Author

INTERIOR
ELEVATIONS


sheet no.
A-502
of

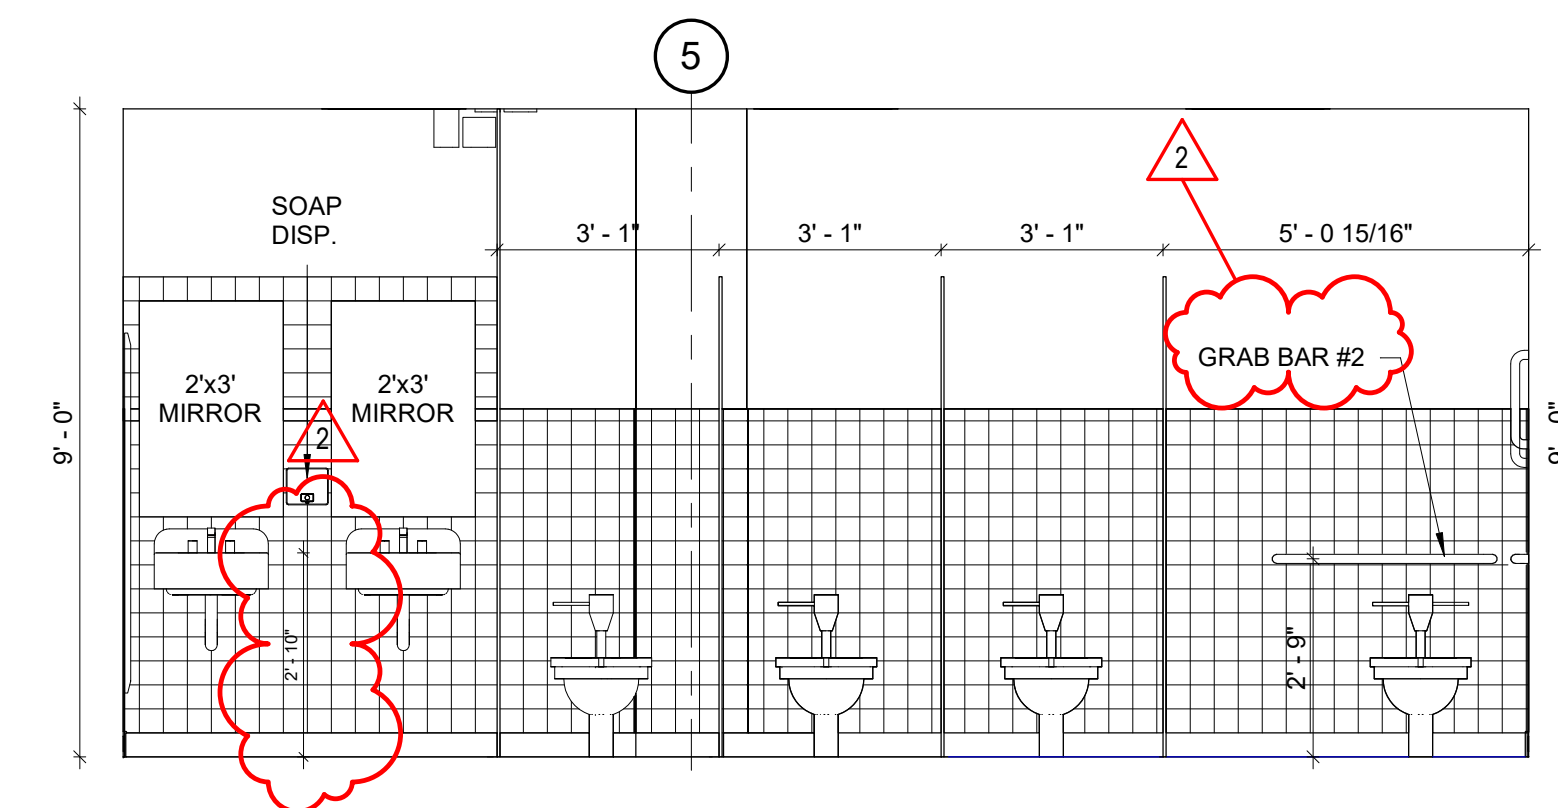


1 WOMEN 309 NORTH
3/8" = 1'-0"

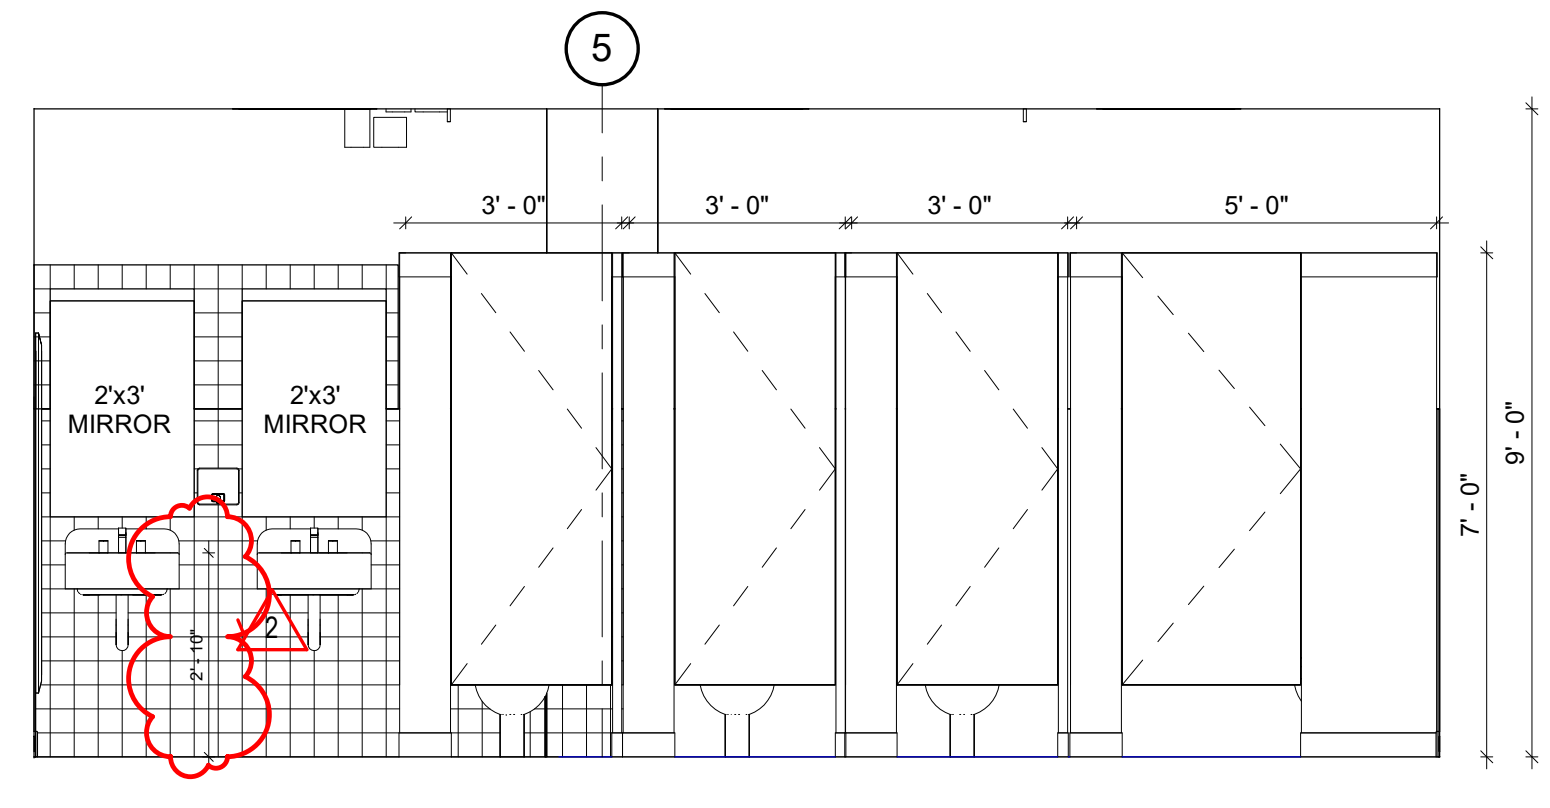


2 WOMEN 309 NORTH A
3/8" = 1'-0"

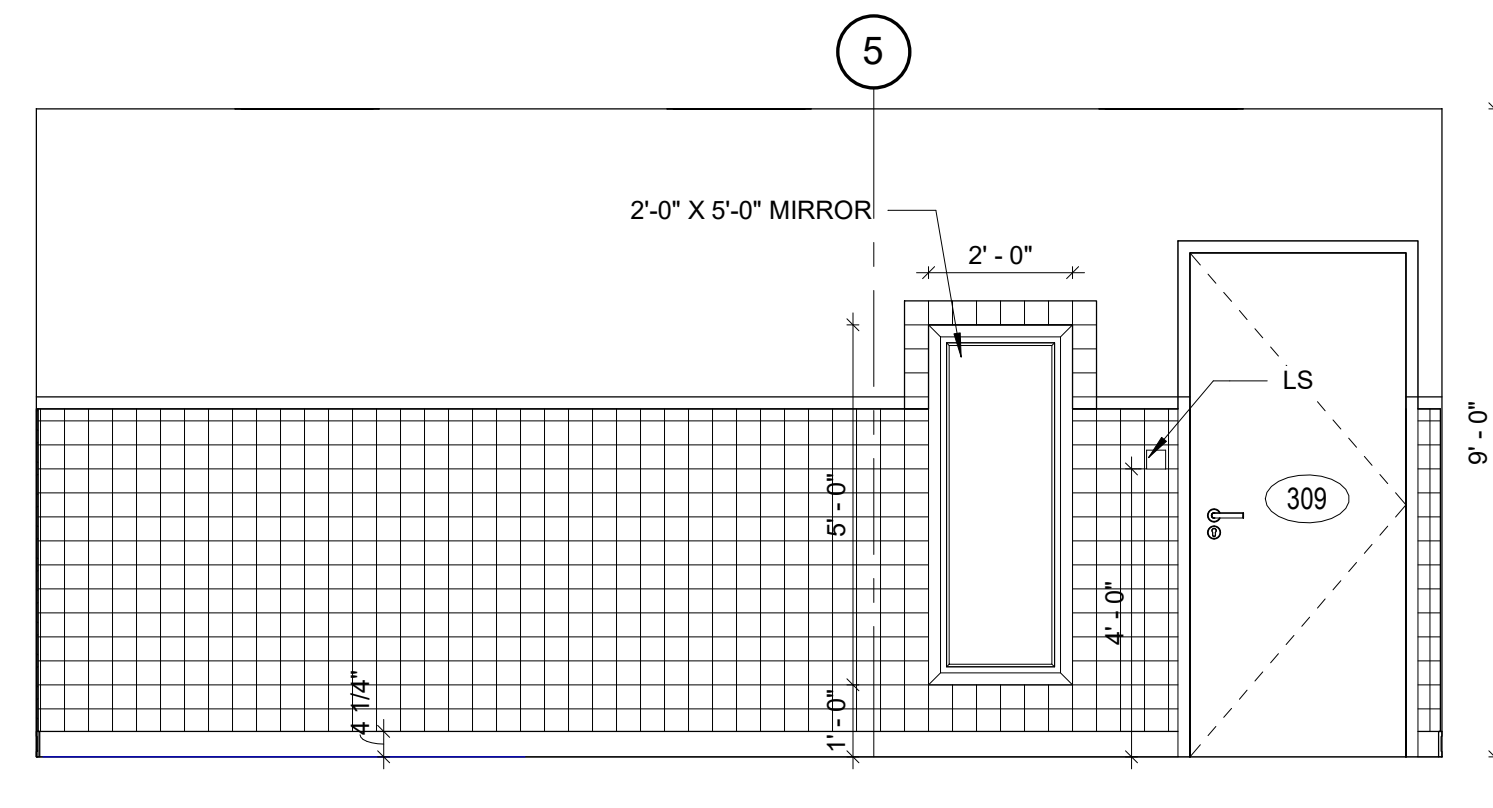


3 WOMEN 309 SOUTH
3/8" = 1'-0"

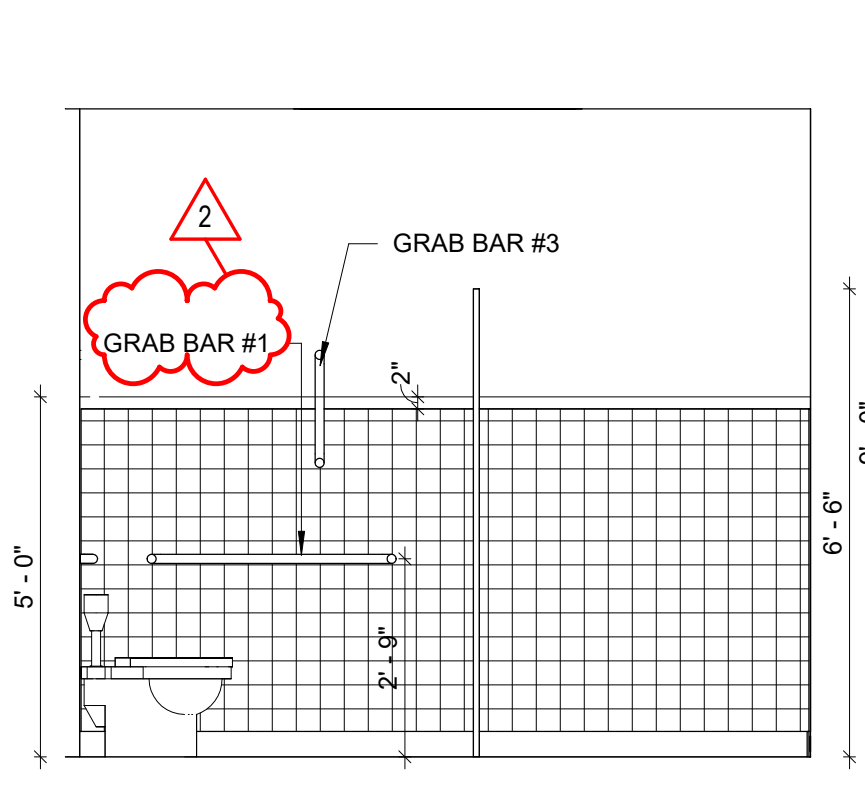


4 WOMEN 309 EAST
3/8" = 1'-0"

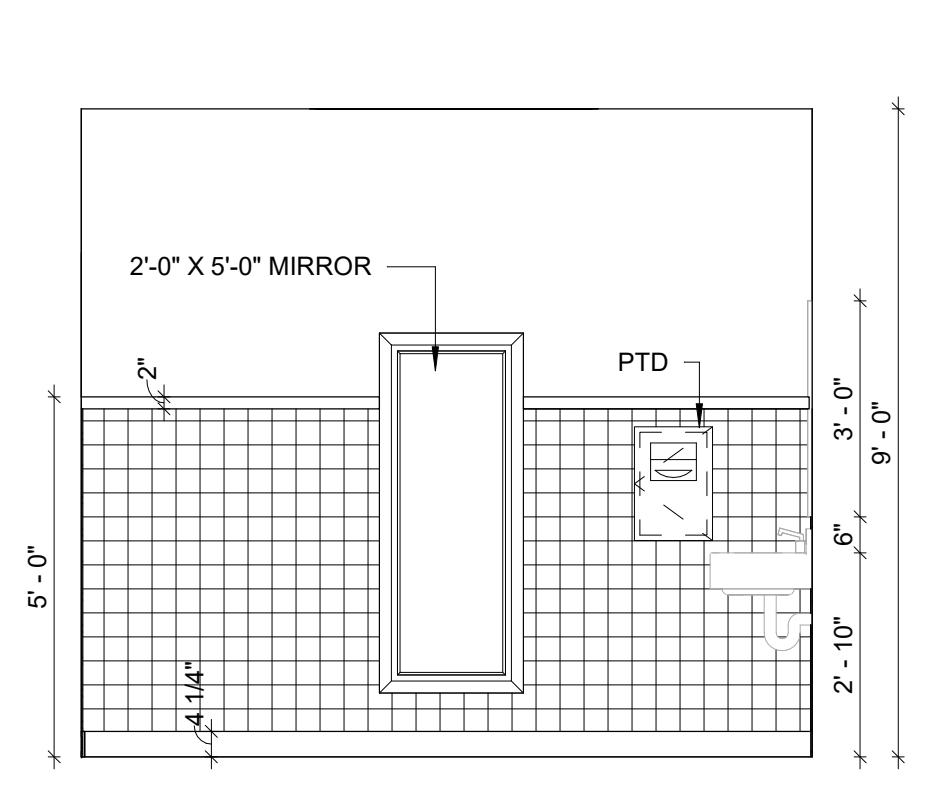


5 WOMEN 309 WEST
3/8" = 1'-0"

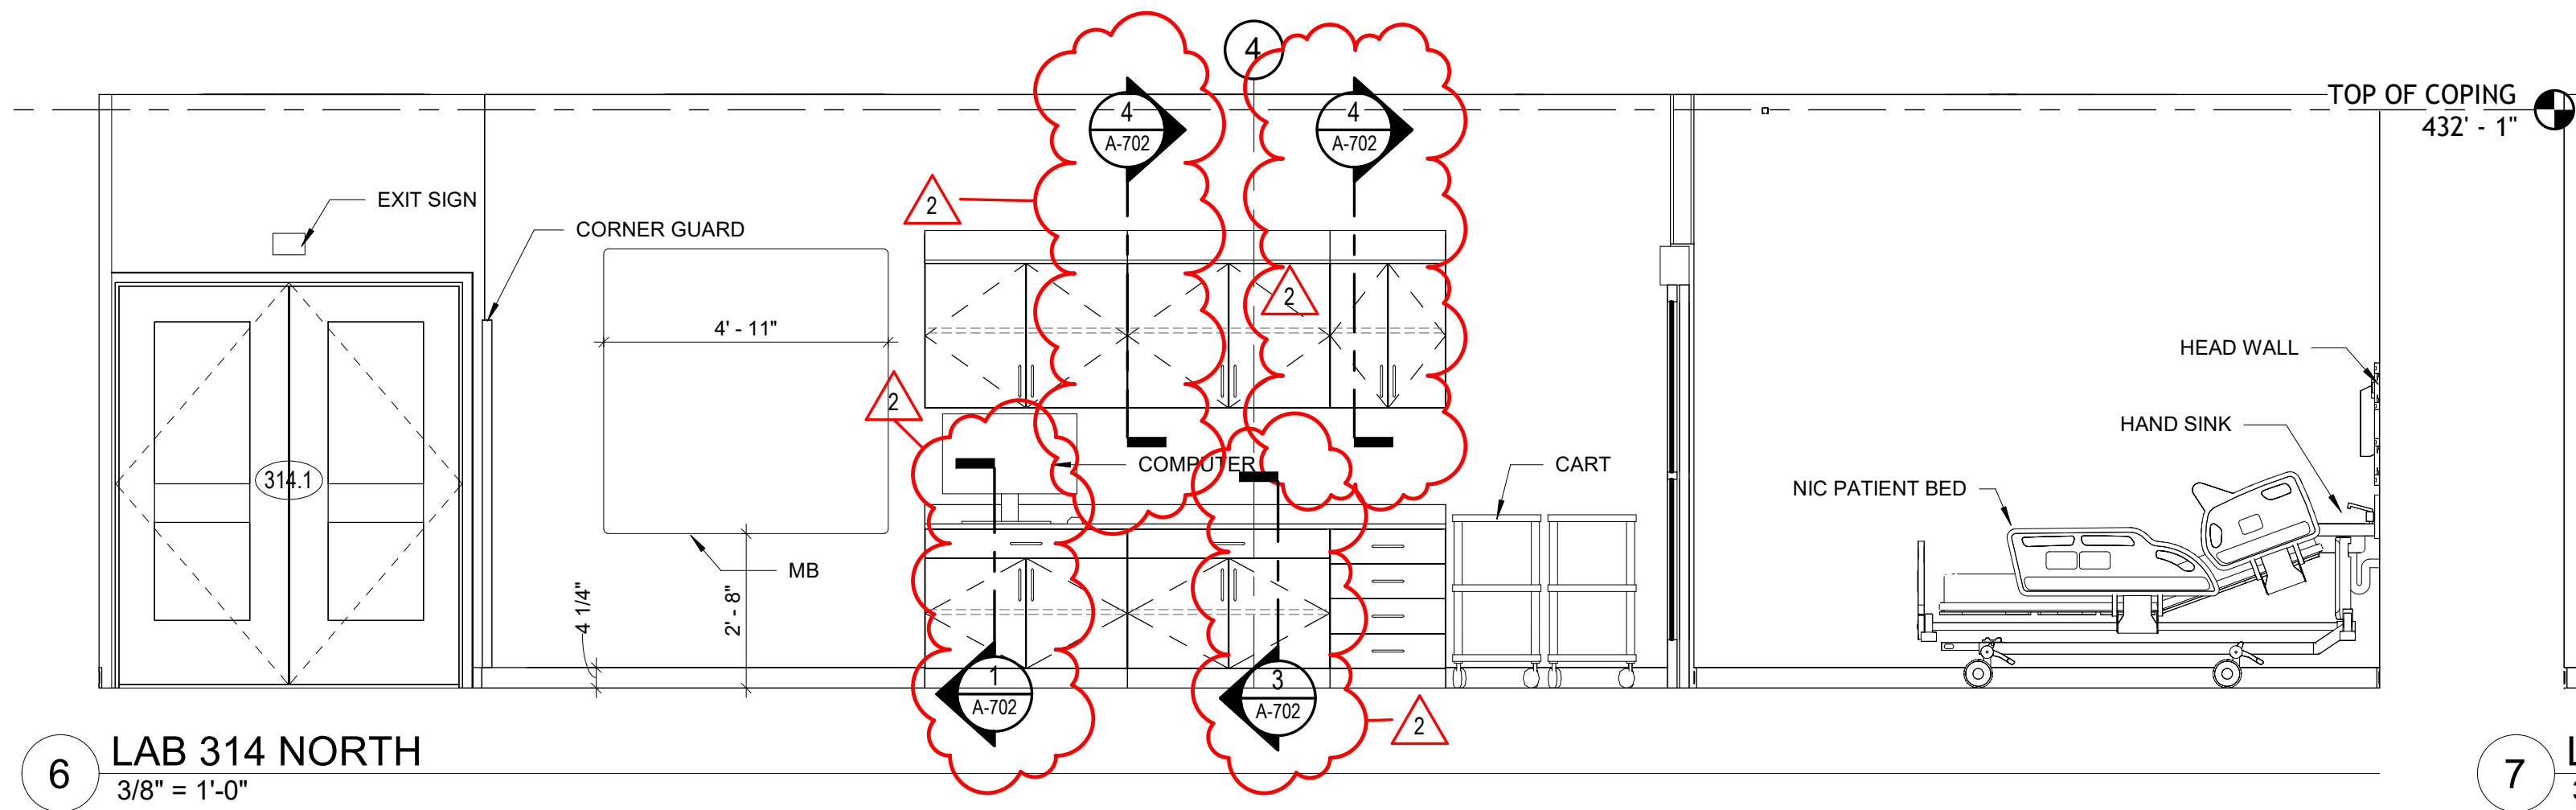


6 LAB 314 NORTH
3/8" = 1'-0"

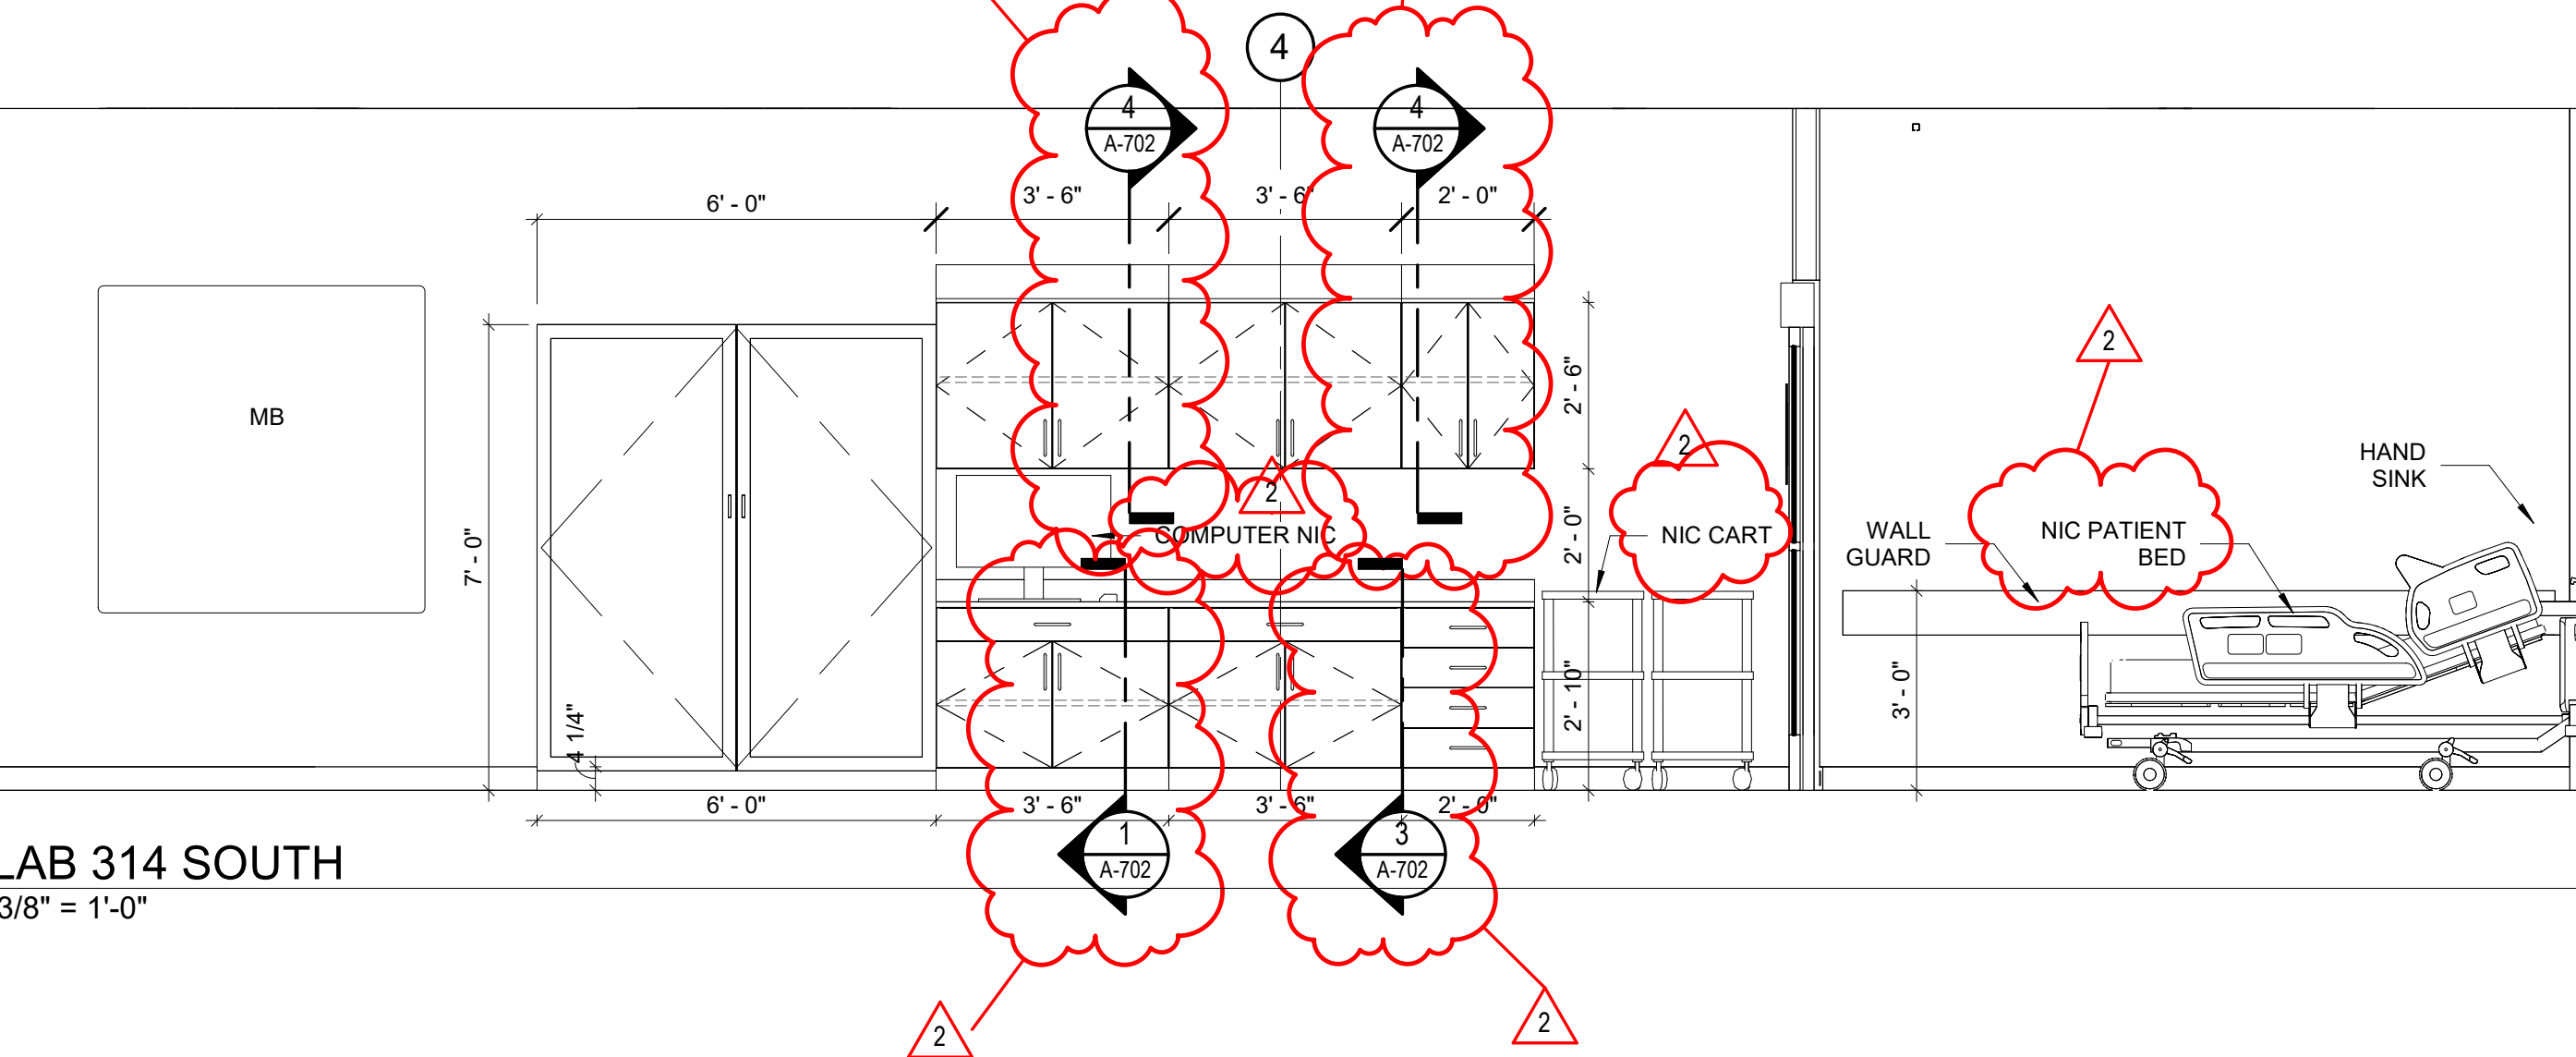

7 LAB 314 SOUTH
3/8" = 1'-0"

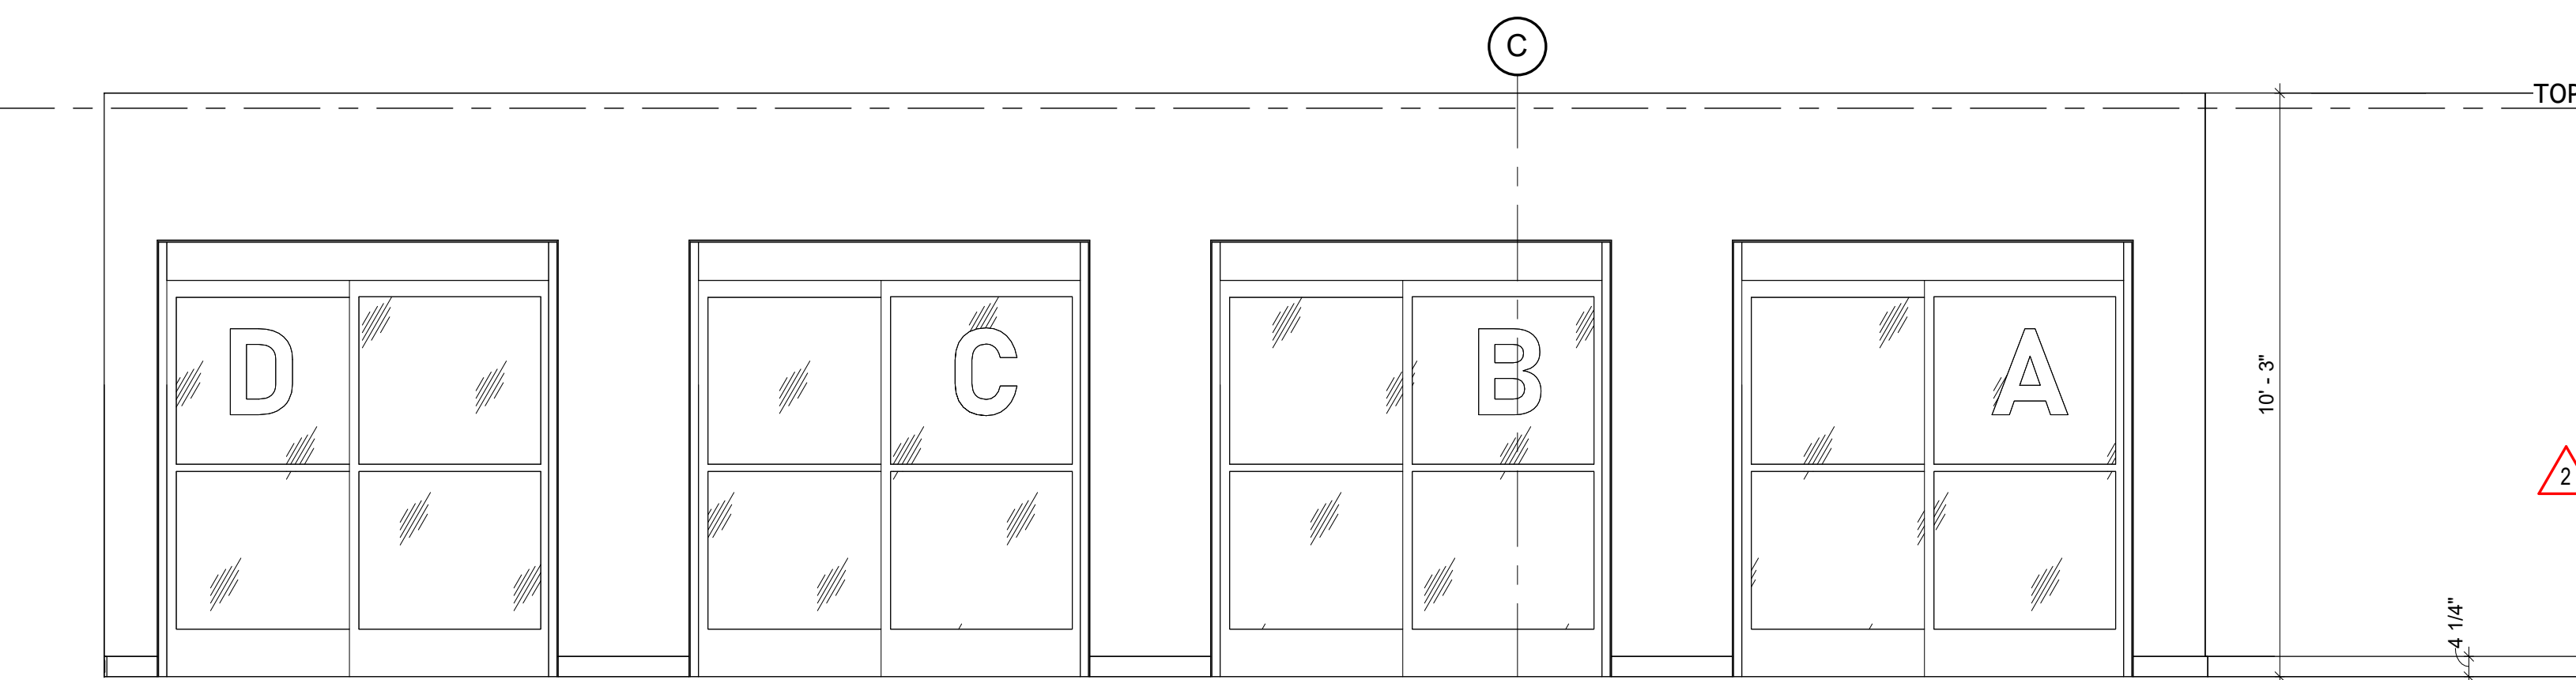


8 LAB 314 WEST A
3/8" = 1'-0"

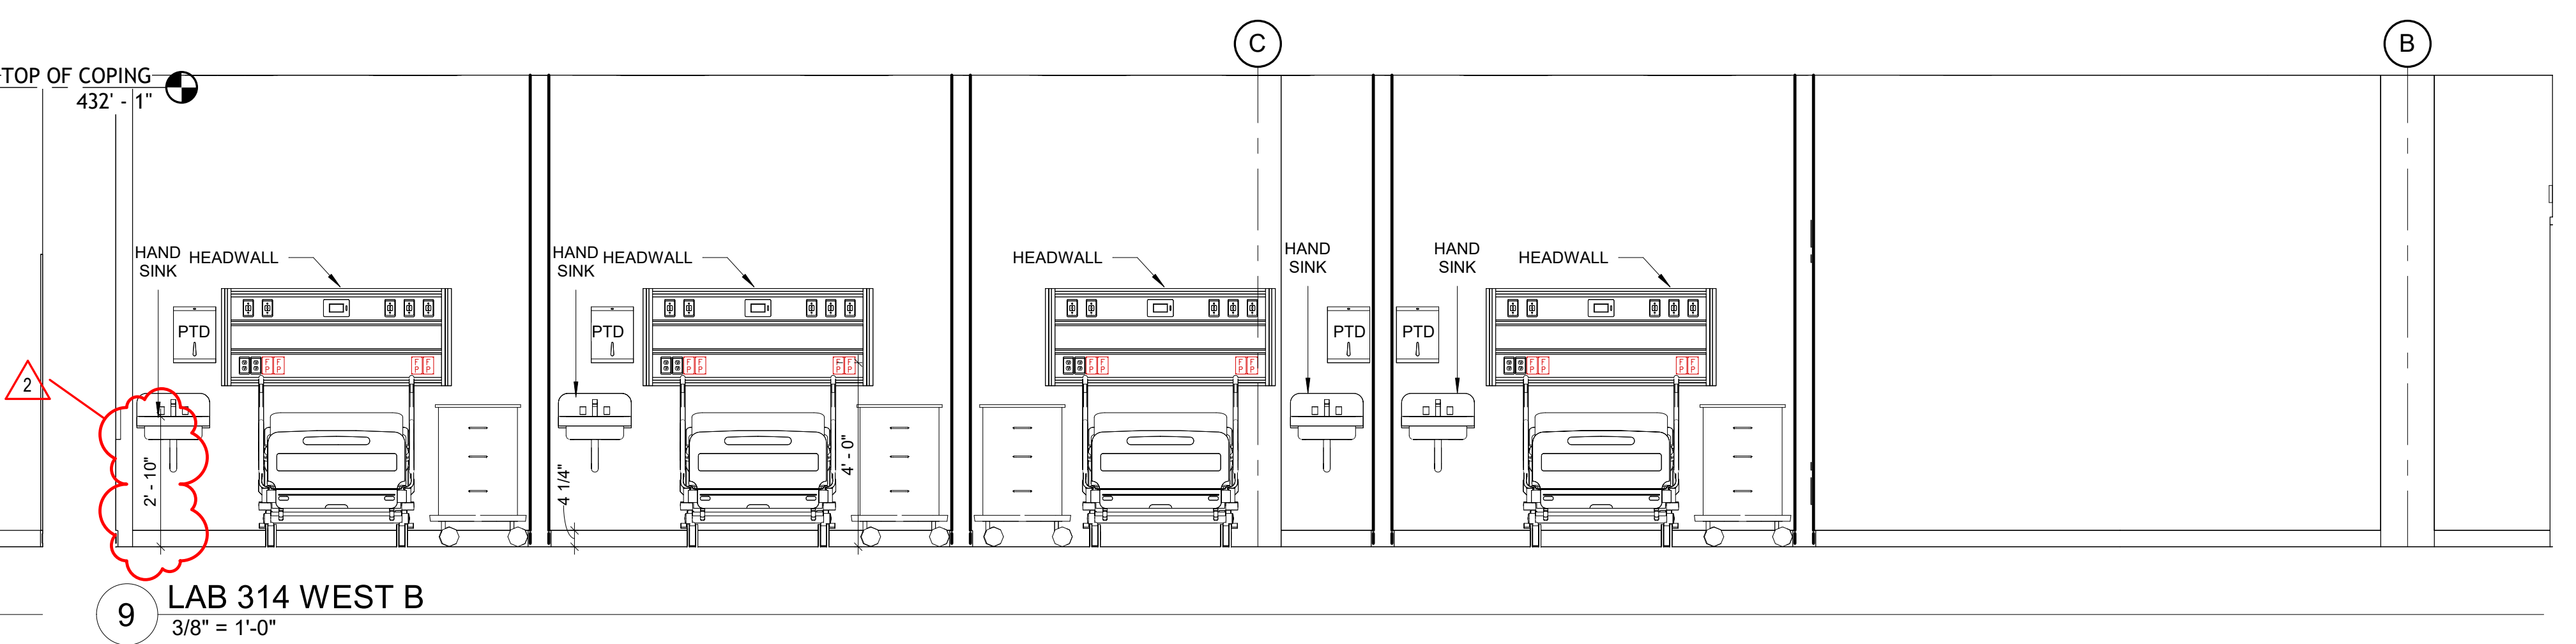


9 LAB 314 WEST B
3/8" = 1'-0"




10 LAB 314 EAST A
3/8" = 1'-0"

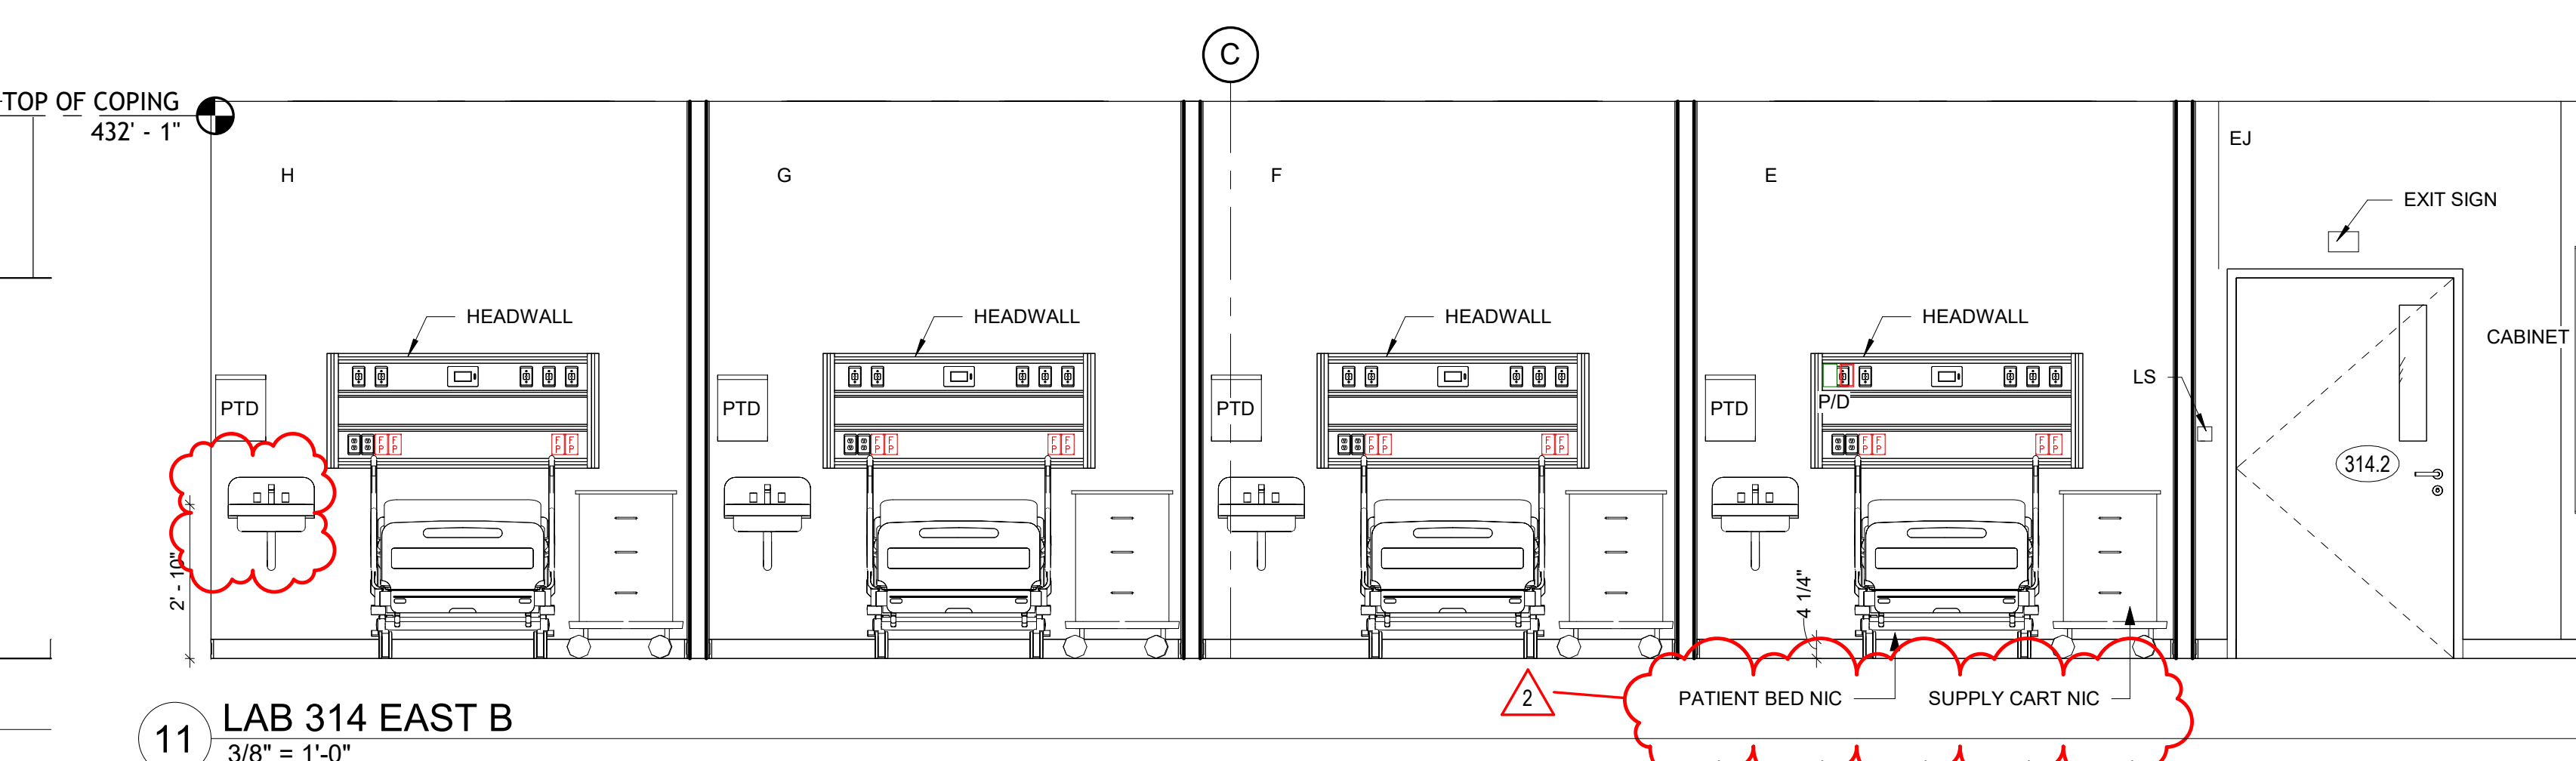


11 LAB 314 EAST B
3/8" = 1'-0"

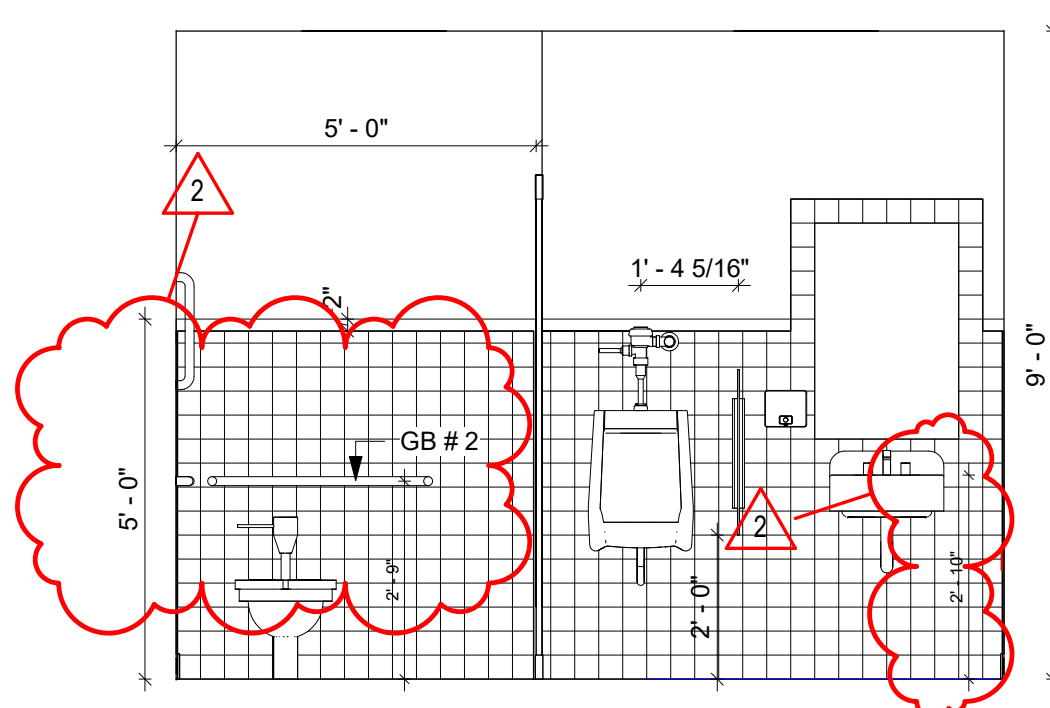


12 MEN 311 NORTH
3/8" = 1'-0"

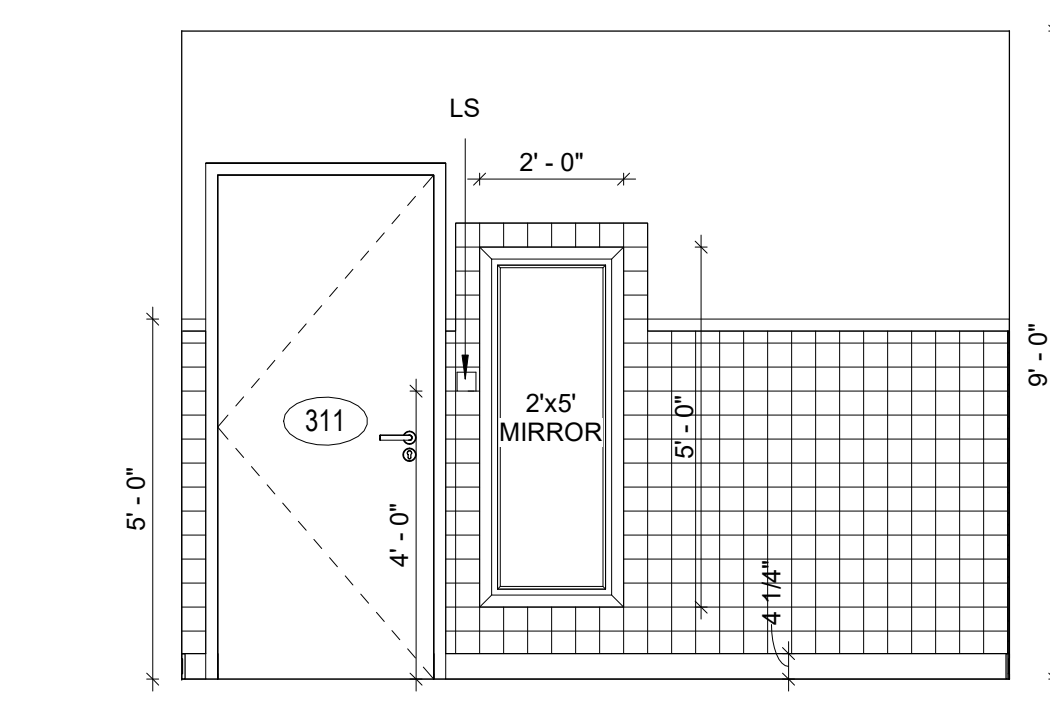

13 MEN 311 SOUTH
3/8" = 1'-0"

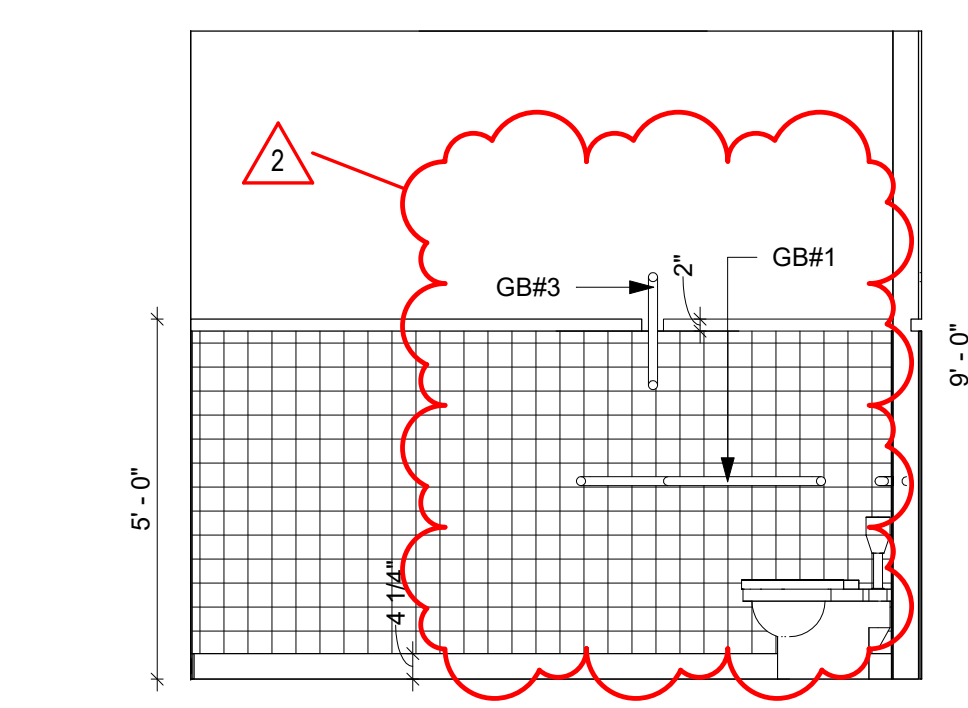

14 MEN 311 WEST
3/8" = 1'-0"

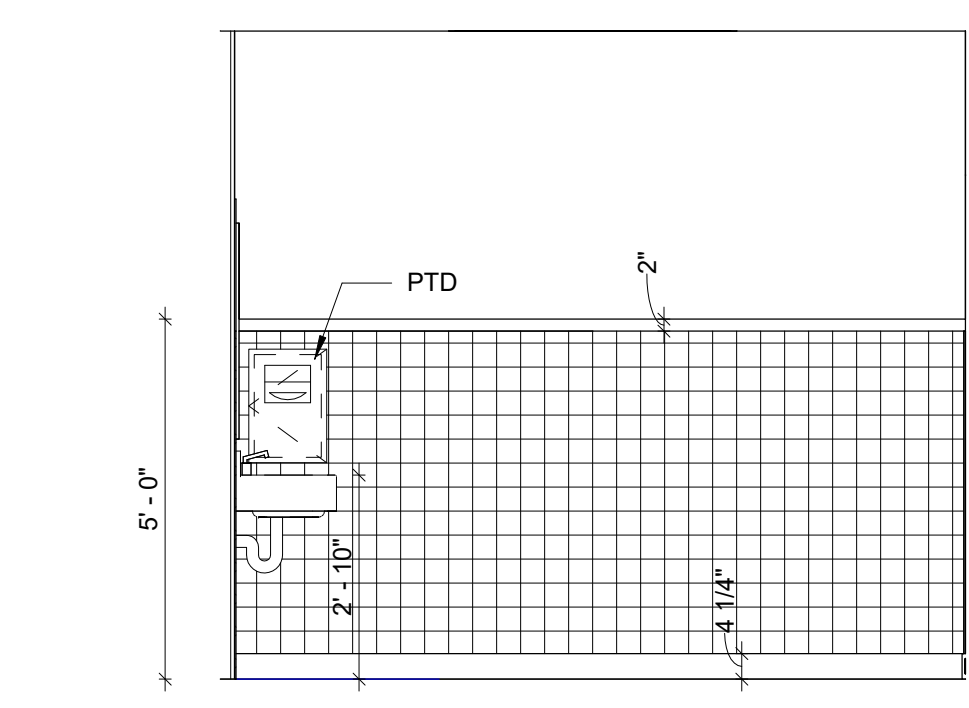

15 MEN 311 EAST
3/8" = 1'-0"



FoilWatt
Architects & Planners, PLLC
SUITE 200
1500 NORTH STATE STREET
MEMPHIS, TN 38103
TELEPHONE (901) 555-3071
FAX (901) 555-3071
WWW.FOILWATT.COM

THE W NURSING SCHOOL
AT NESHOBIA GENERAL HOSPITAL
Philadelphia, MS 38350


project no.
1661 - 23
date
04 JUNE 2026
drawn by
6-9-2026

author


**INTERIOR
ELEVATIONS**

sheet no.
A-503
of


CONSTRUCTION DOCUMENTS

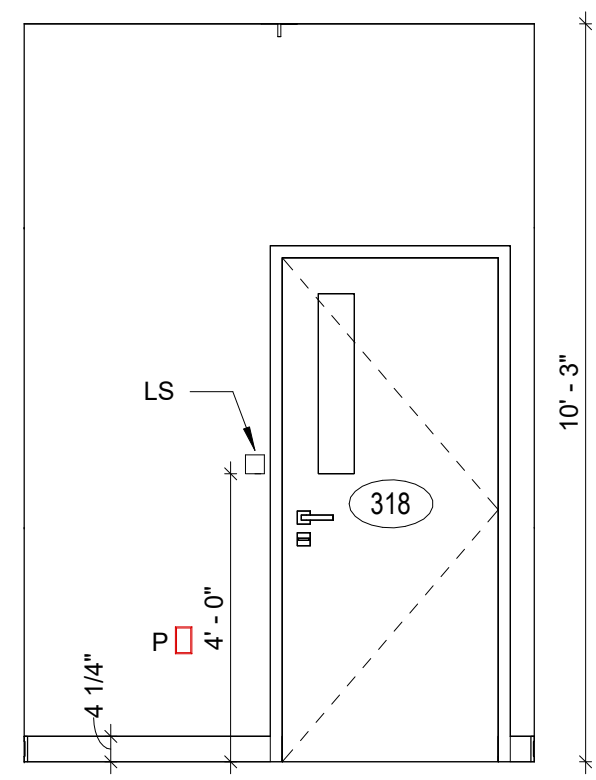


1 OBS. RM. 318 NORTH (RM.310 SIMILAR)
3/8" = 1'-0"

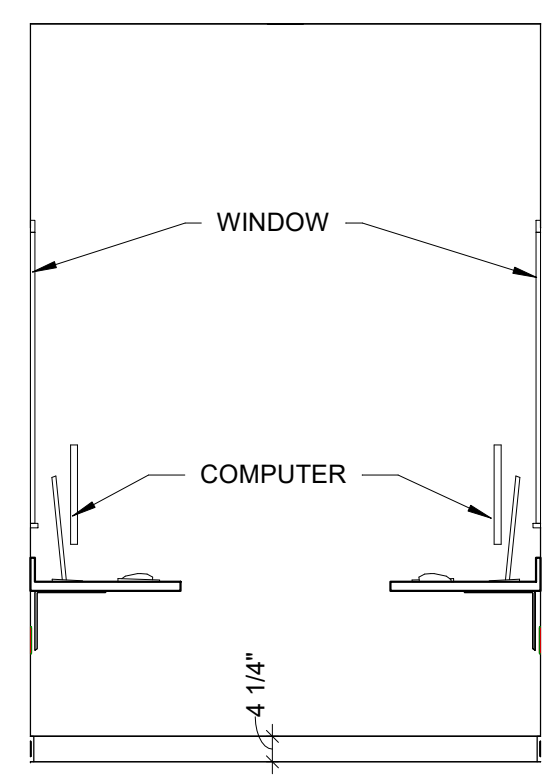


2 OBS. RM. 318 SOUTH
3/8" = 1'-0"

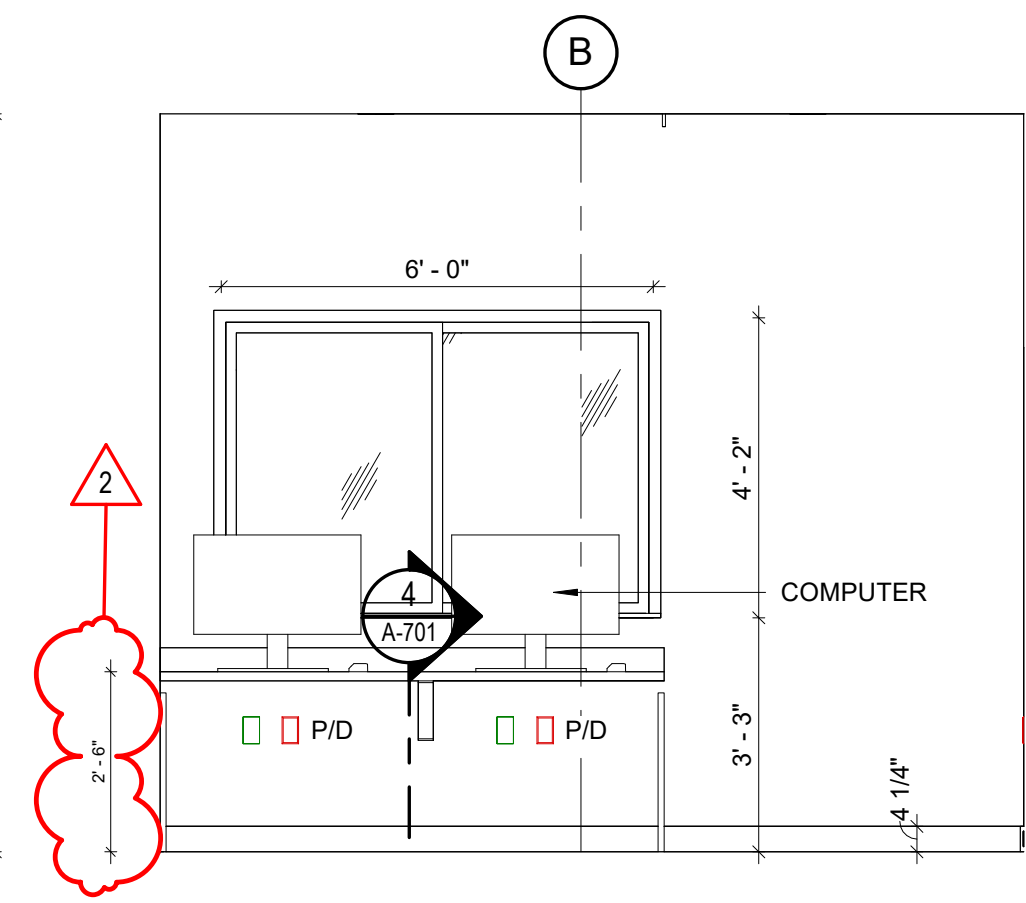


3 OBS. RM. 318 WEST
3/8" = 1'-0"

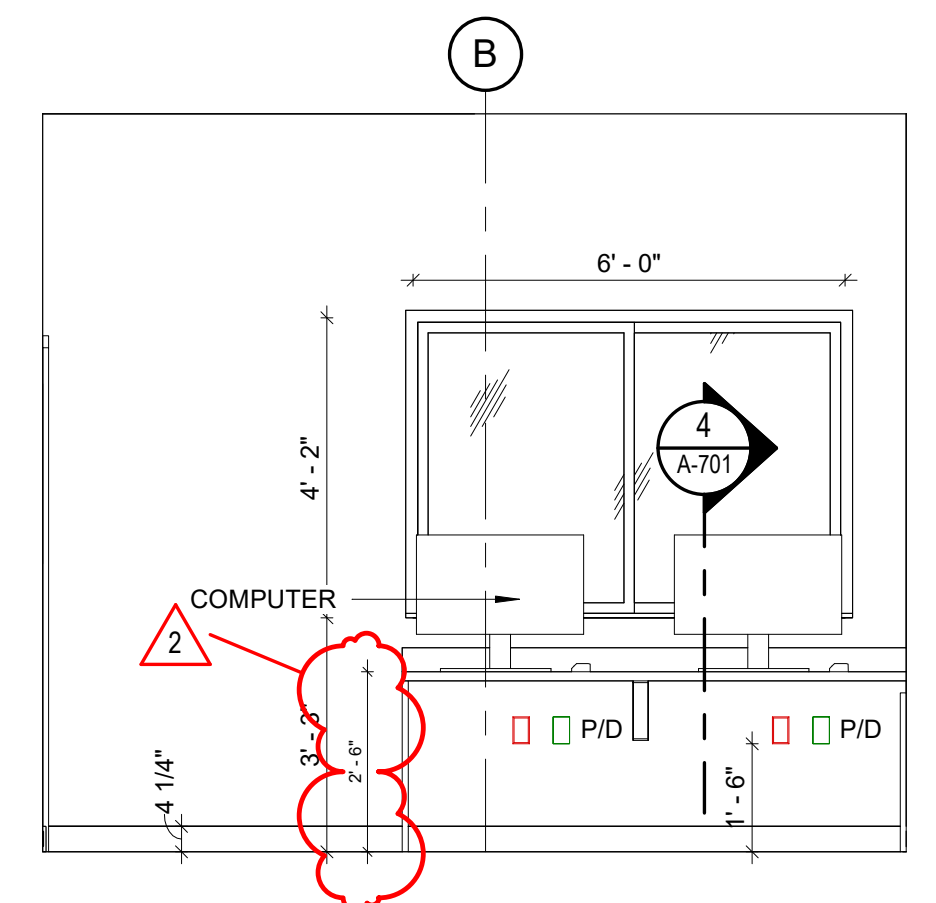


4 OBS. RM. 318 EAST
3/8" = 1'-0"

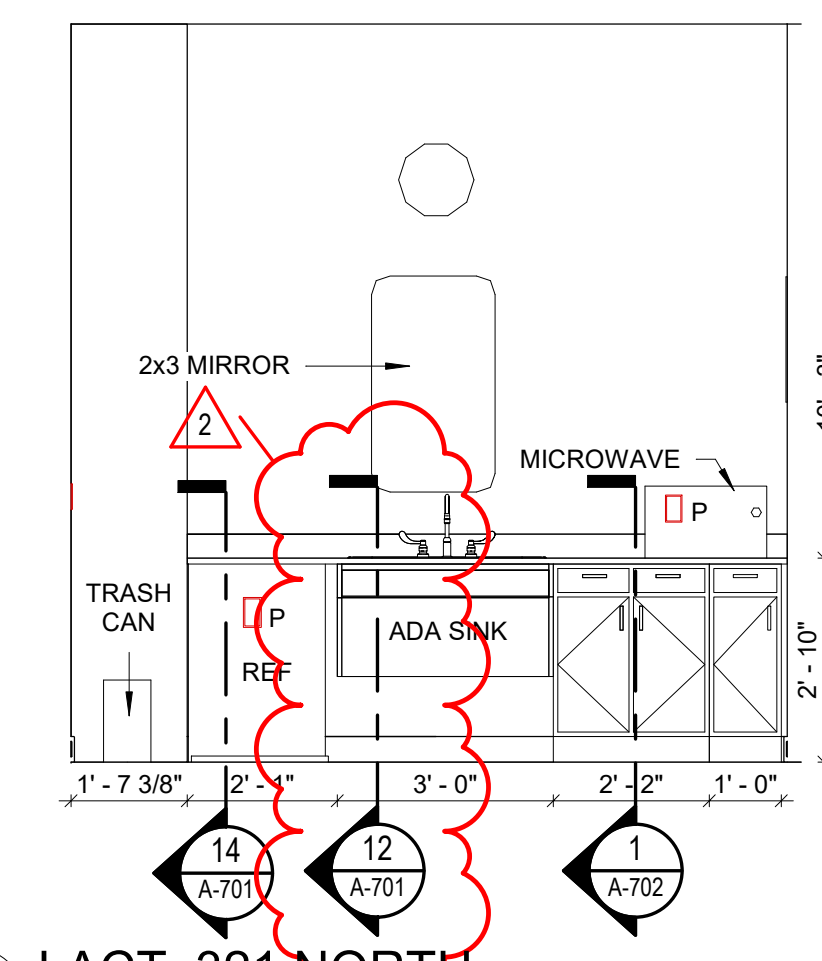


5 LACT. 321 NORTH
3/8" = 1'-0"

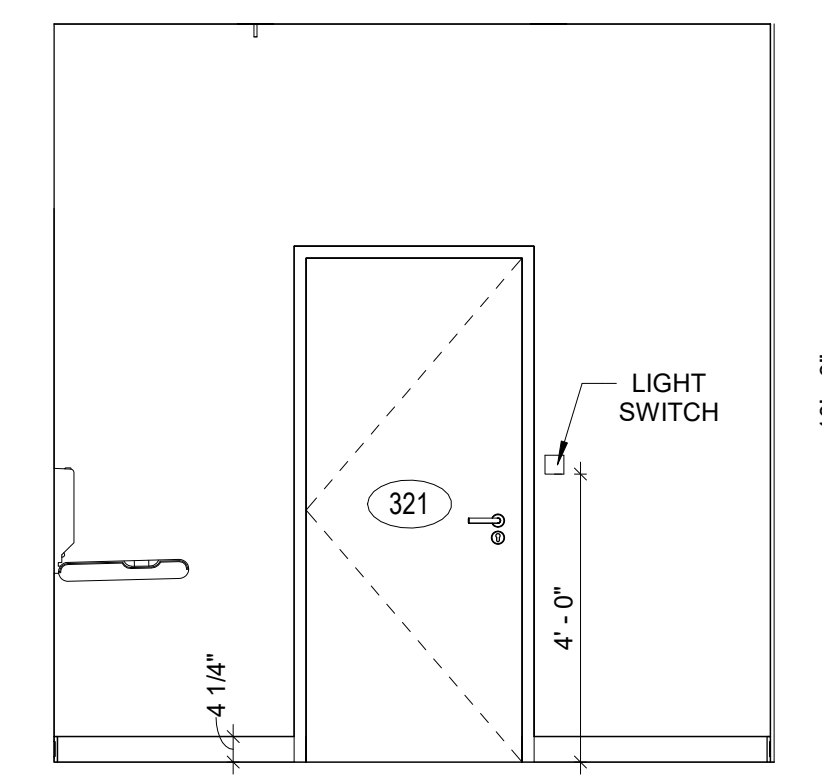


6 LACT. 321 SOUTH
3/8" = 1'-0"

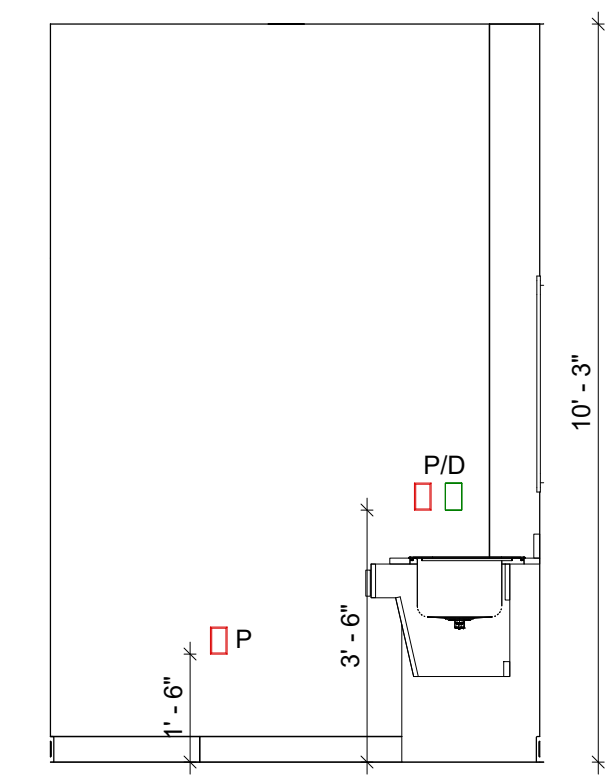


7 LACT. 321 WEST
3/8" = 1'-0"

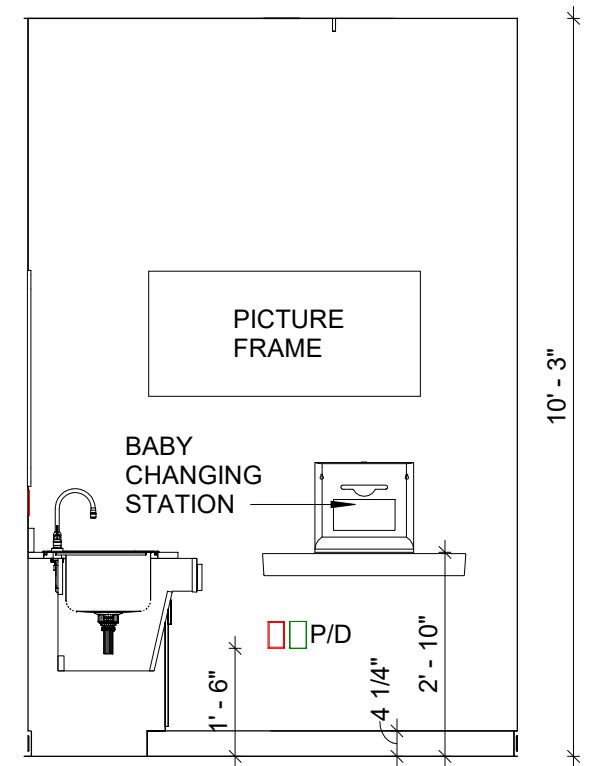


8 LACT. 321 EAST
3/8" = 1'-0"

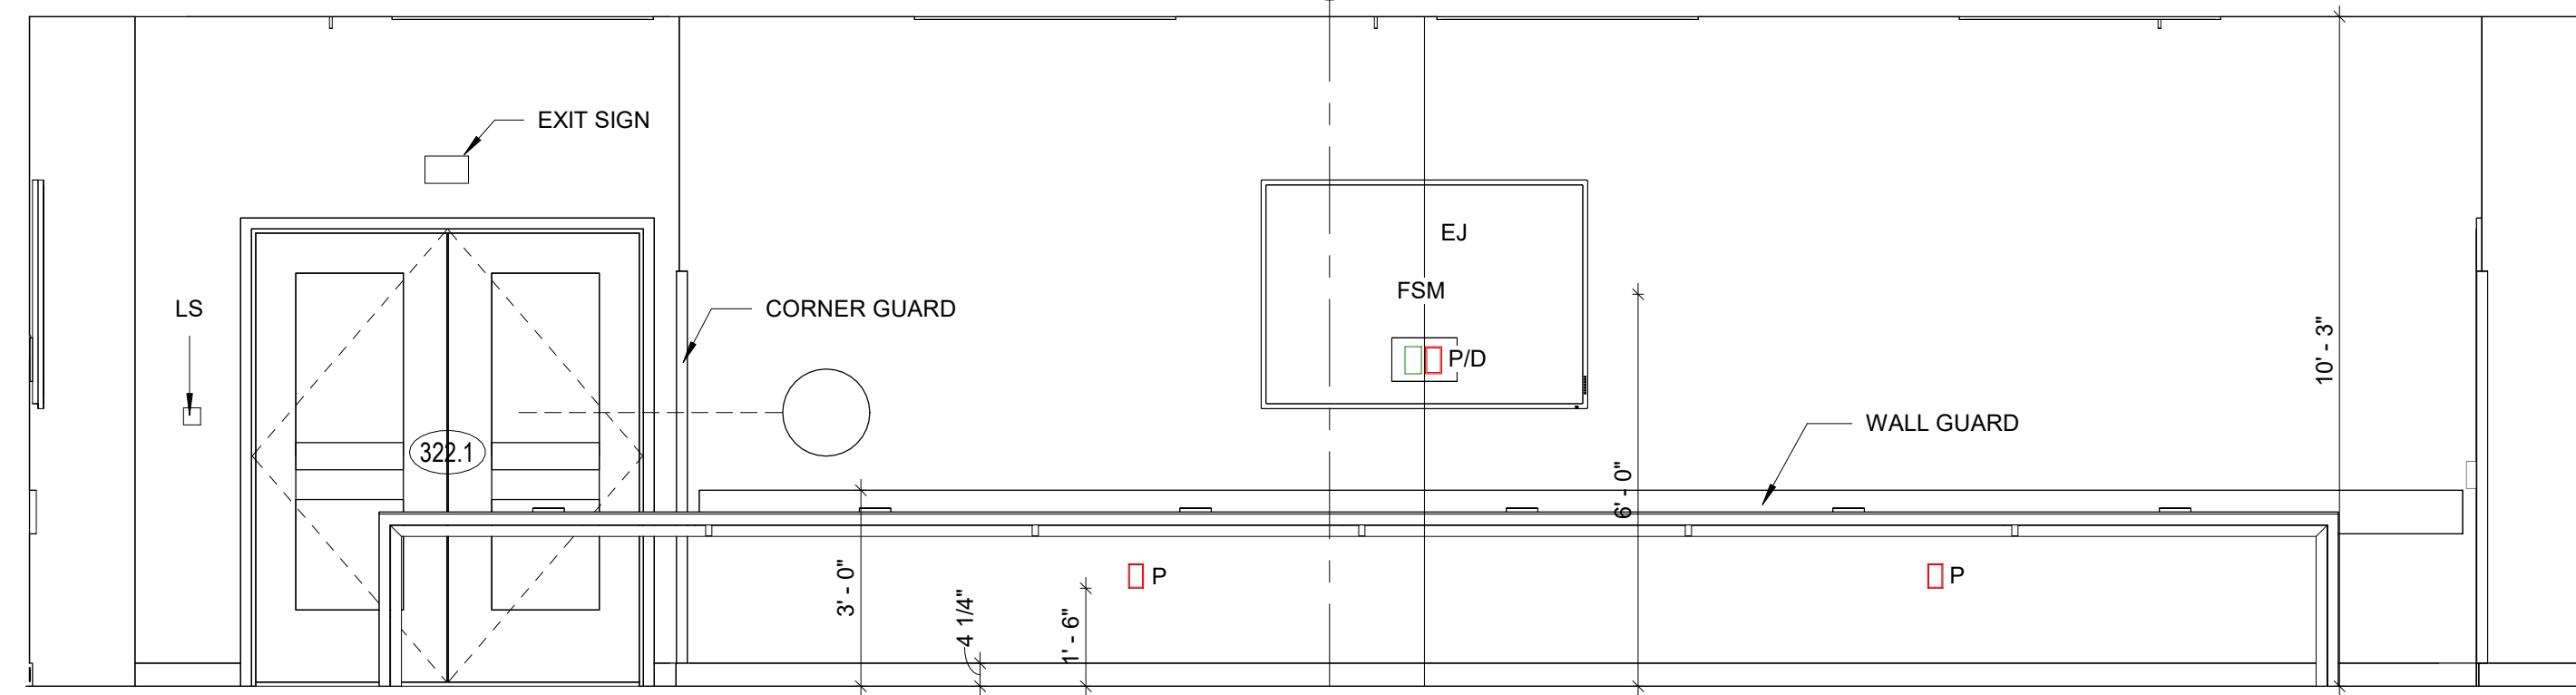


9 CLASSROOM 322 NORTH
3/8" = 1'-0"

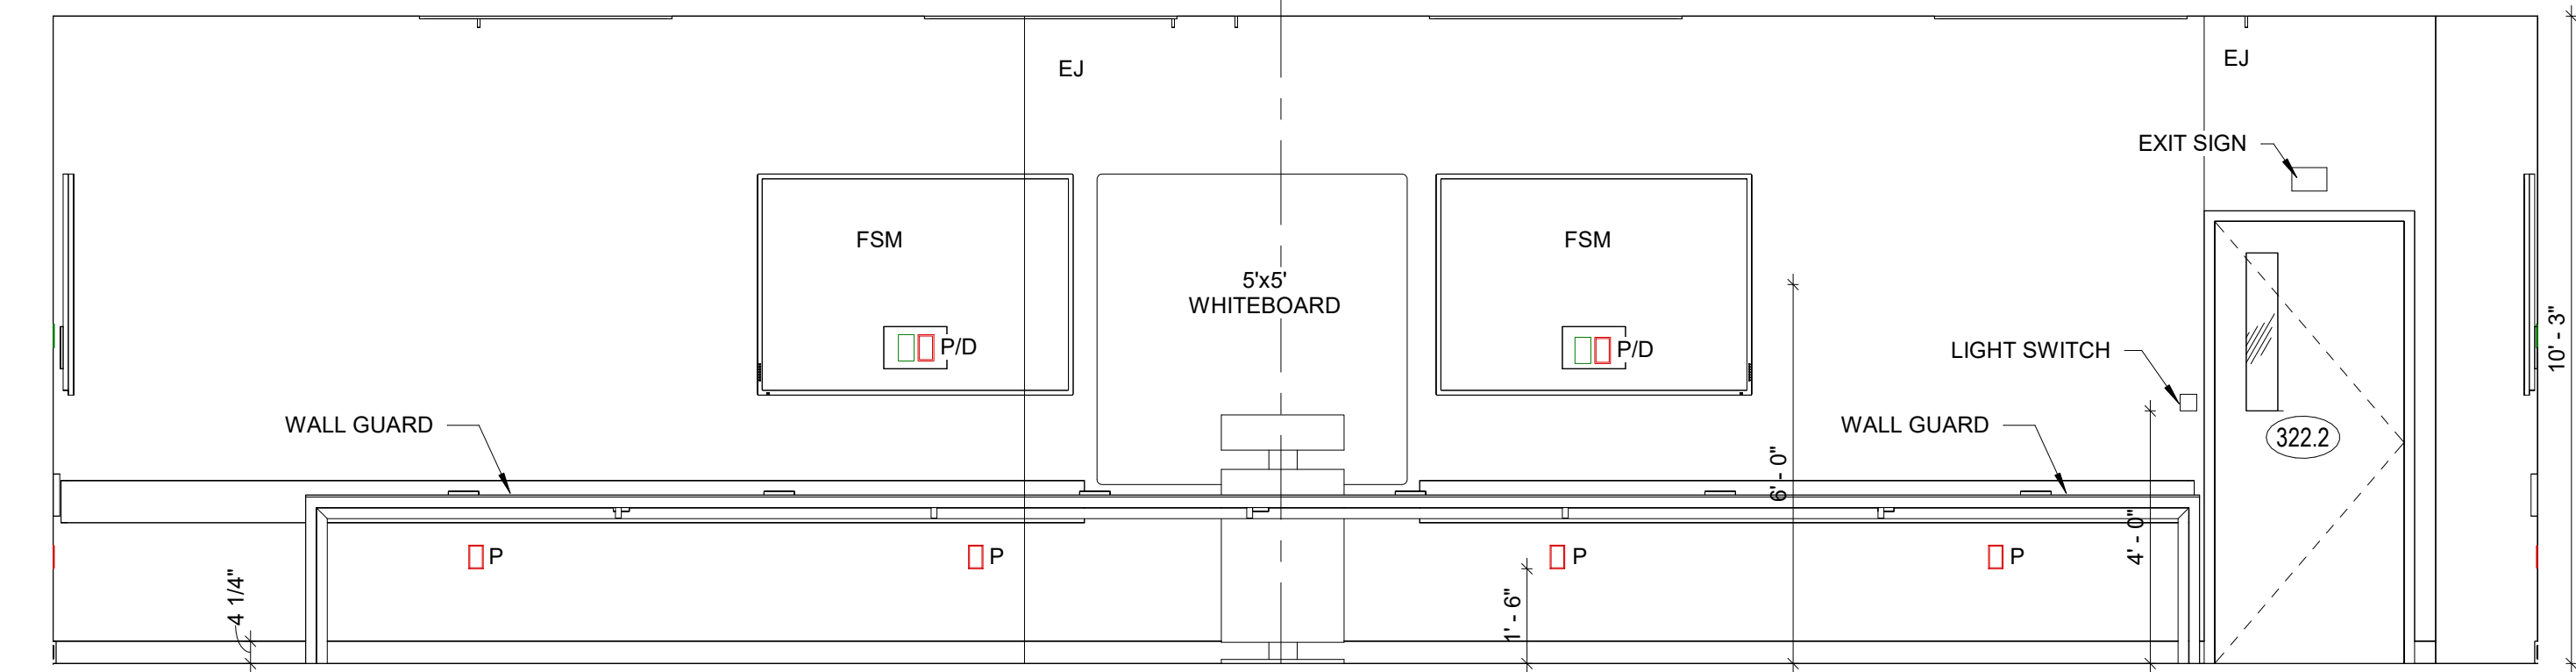


10 CLASSROOM 322 SOUTH
3/8" = 1'-0"

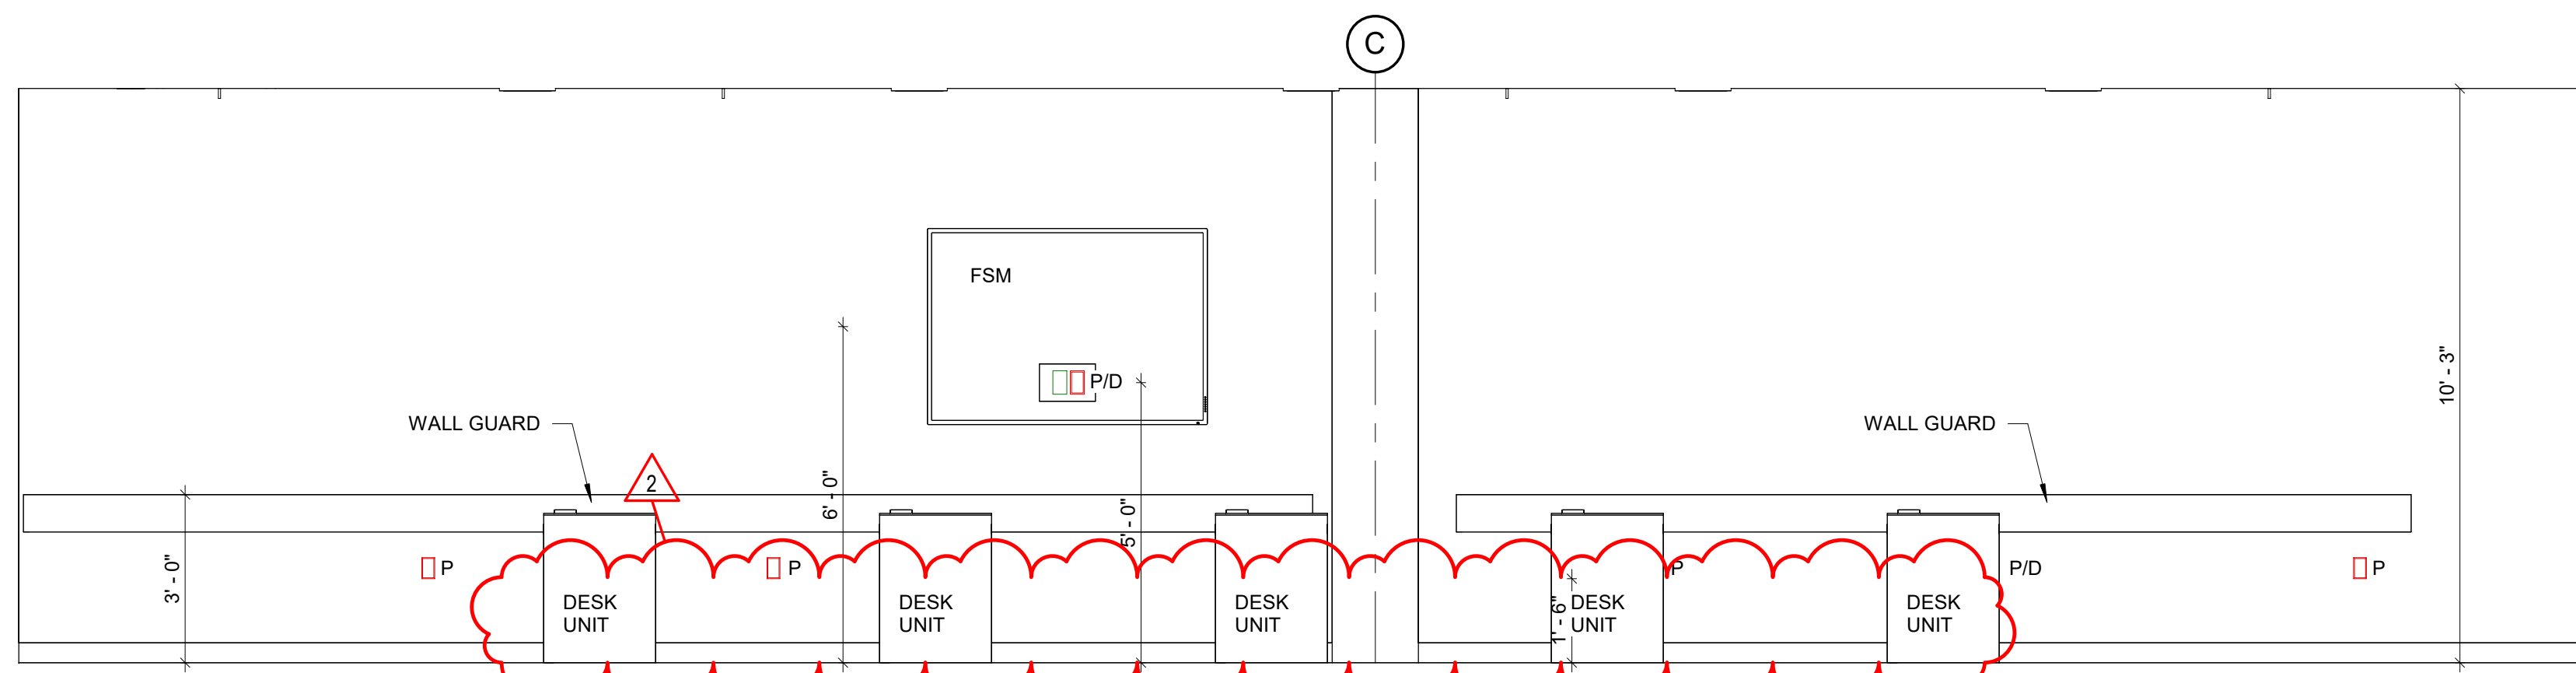


11 CLASSROOM 322 WEST
3/8" = 1'-0"

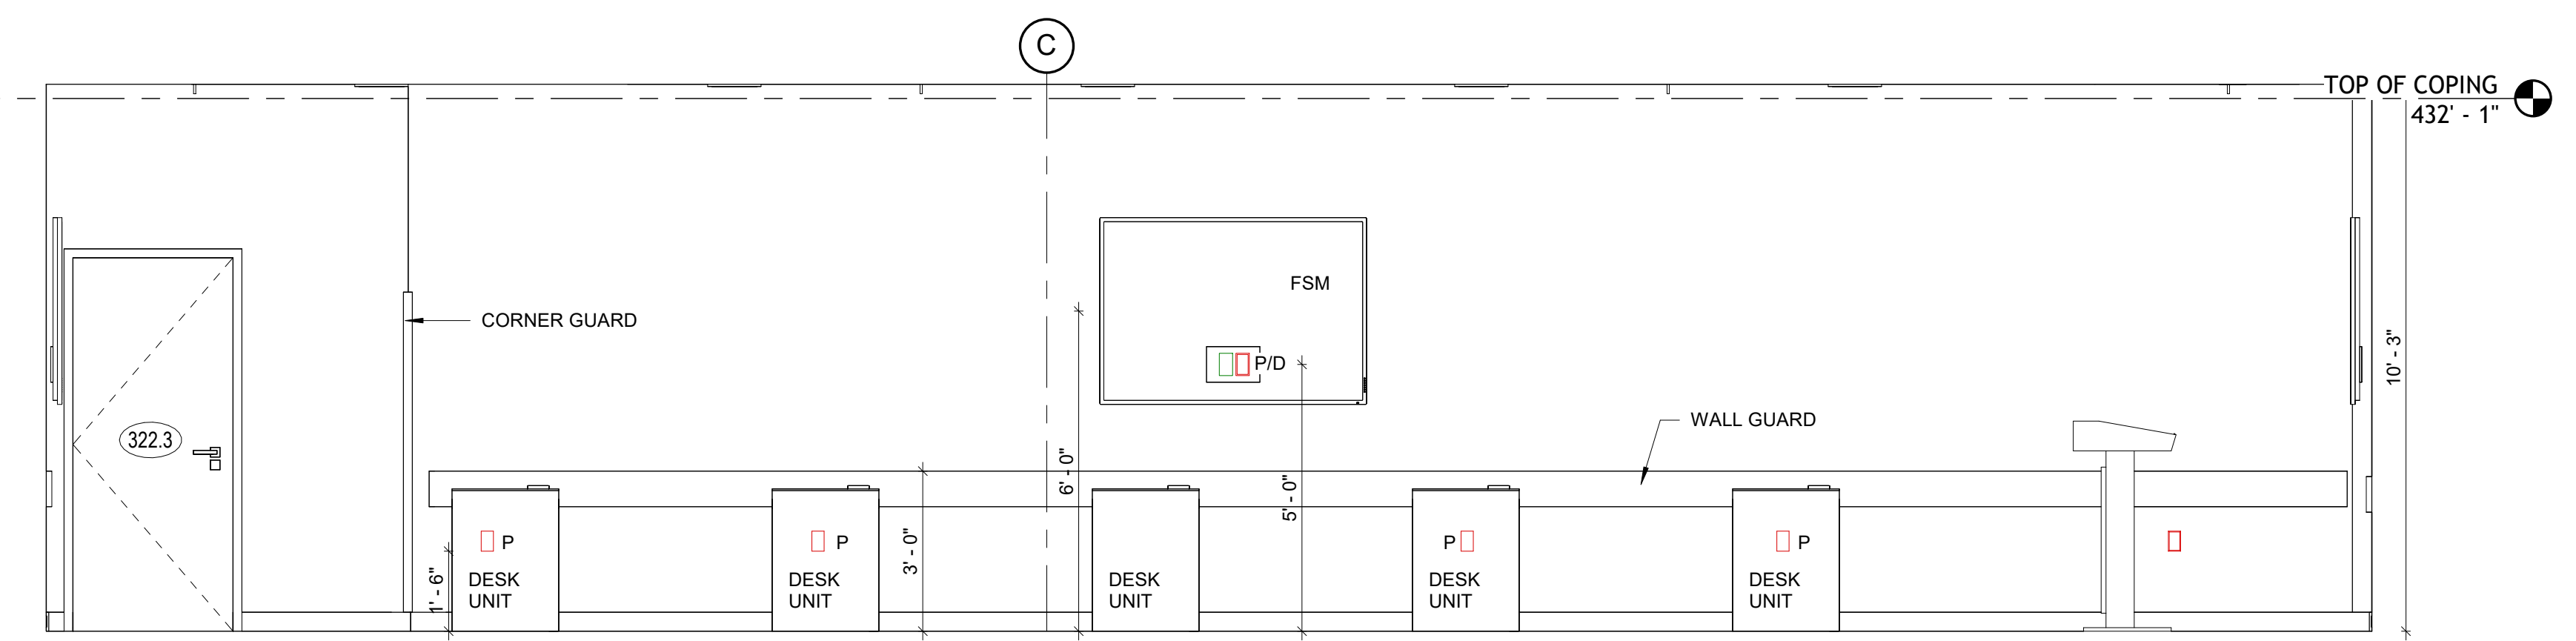


12 CLASSROOM 322 EAST
3/8" = 1'-0"

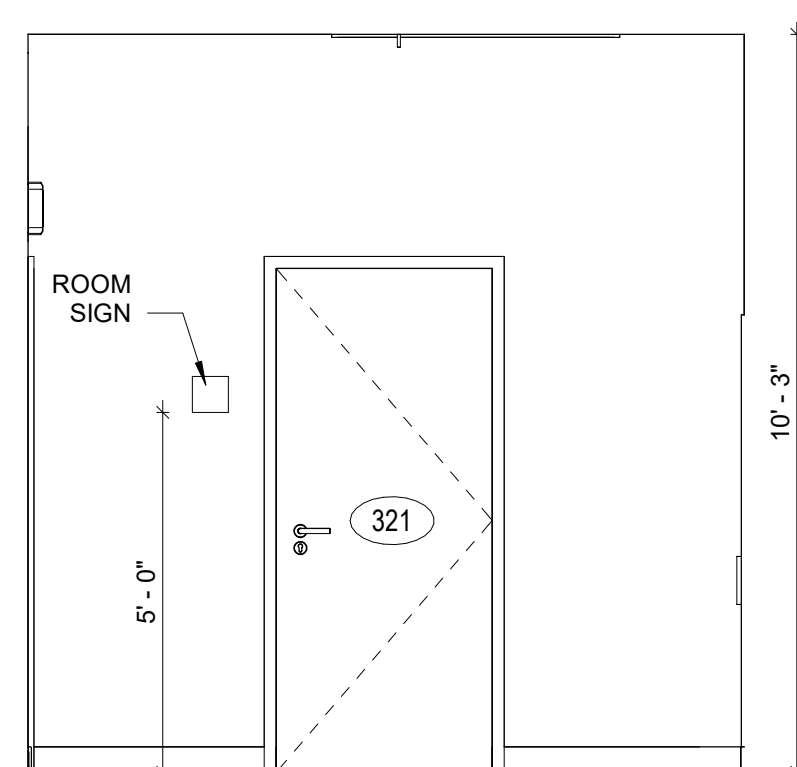


13 CORRIDOR 324 NORTH
3/8" = 1'-0"

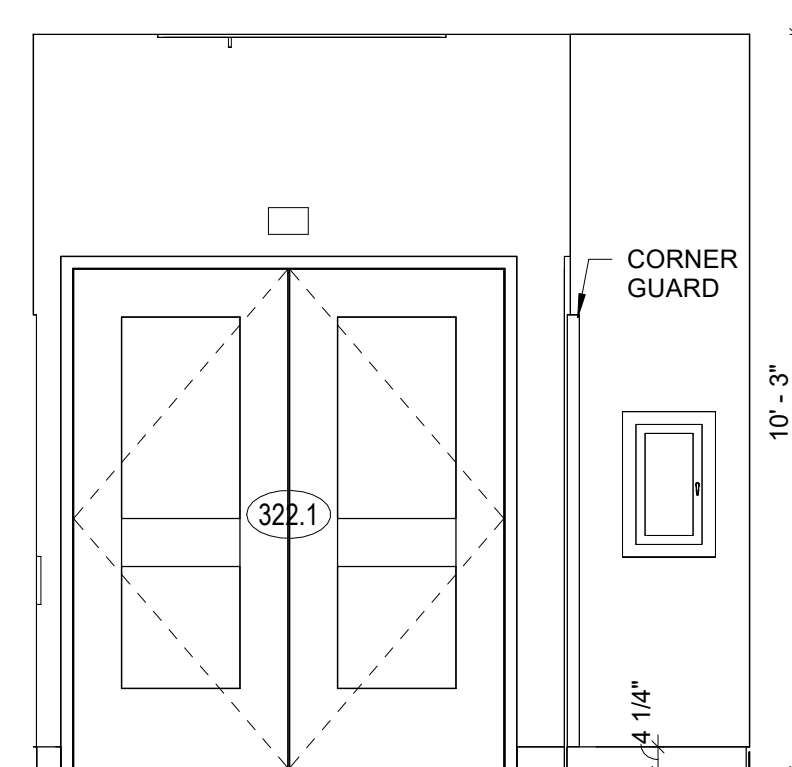


14 CORRIDOR 324 SOUTH
3/8" = 1'-0"

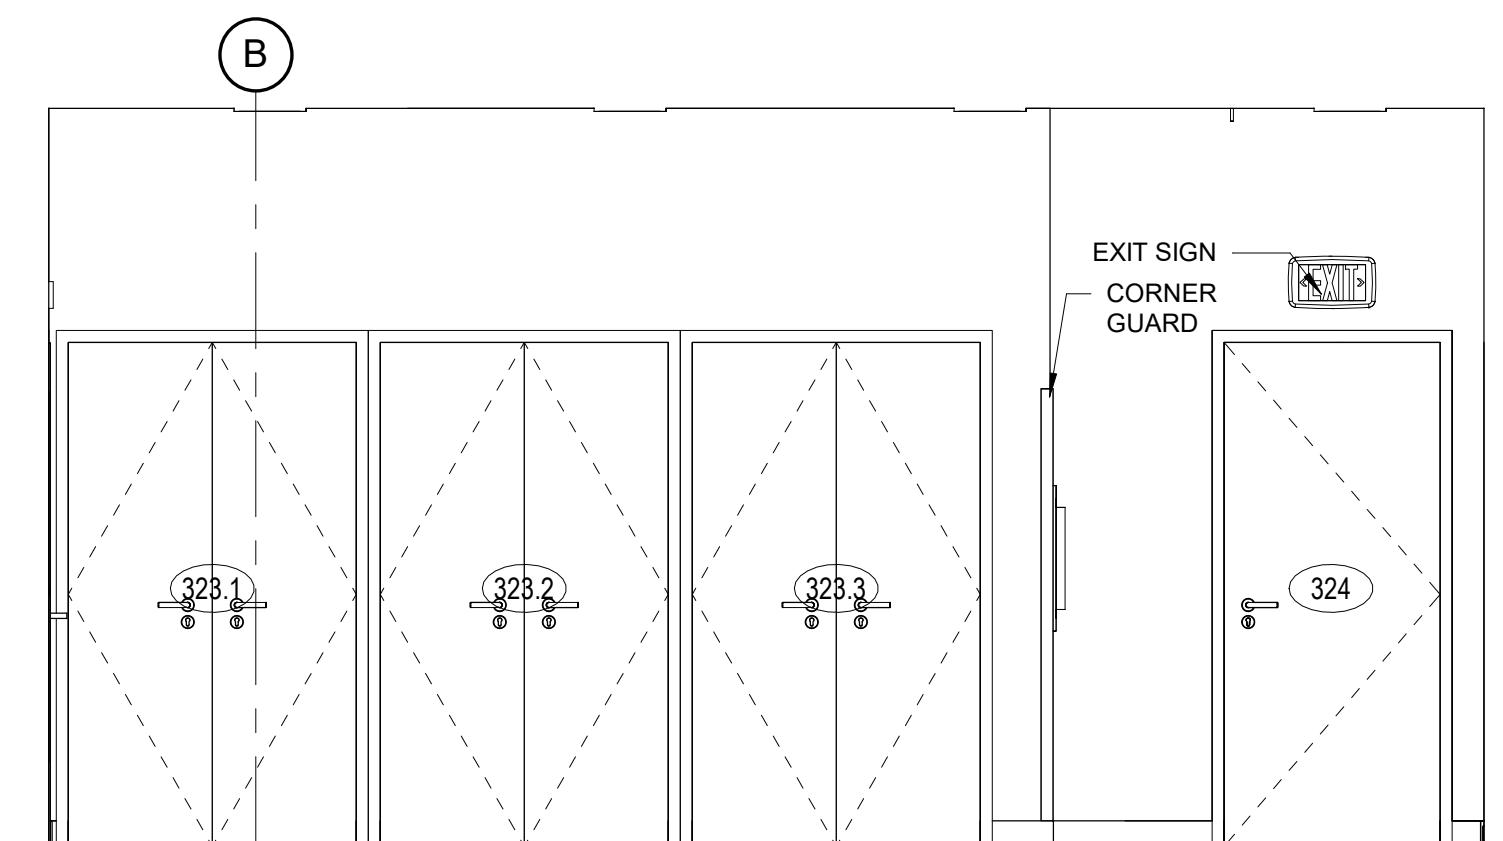


15 CORRIDOR 324 WEST
3/8" = 1'-0"

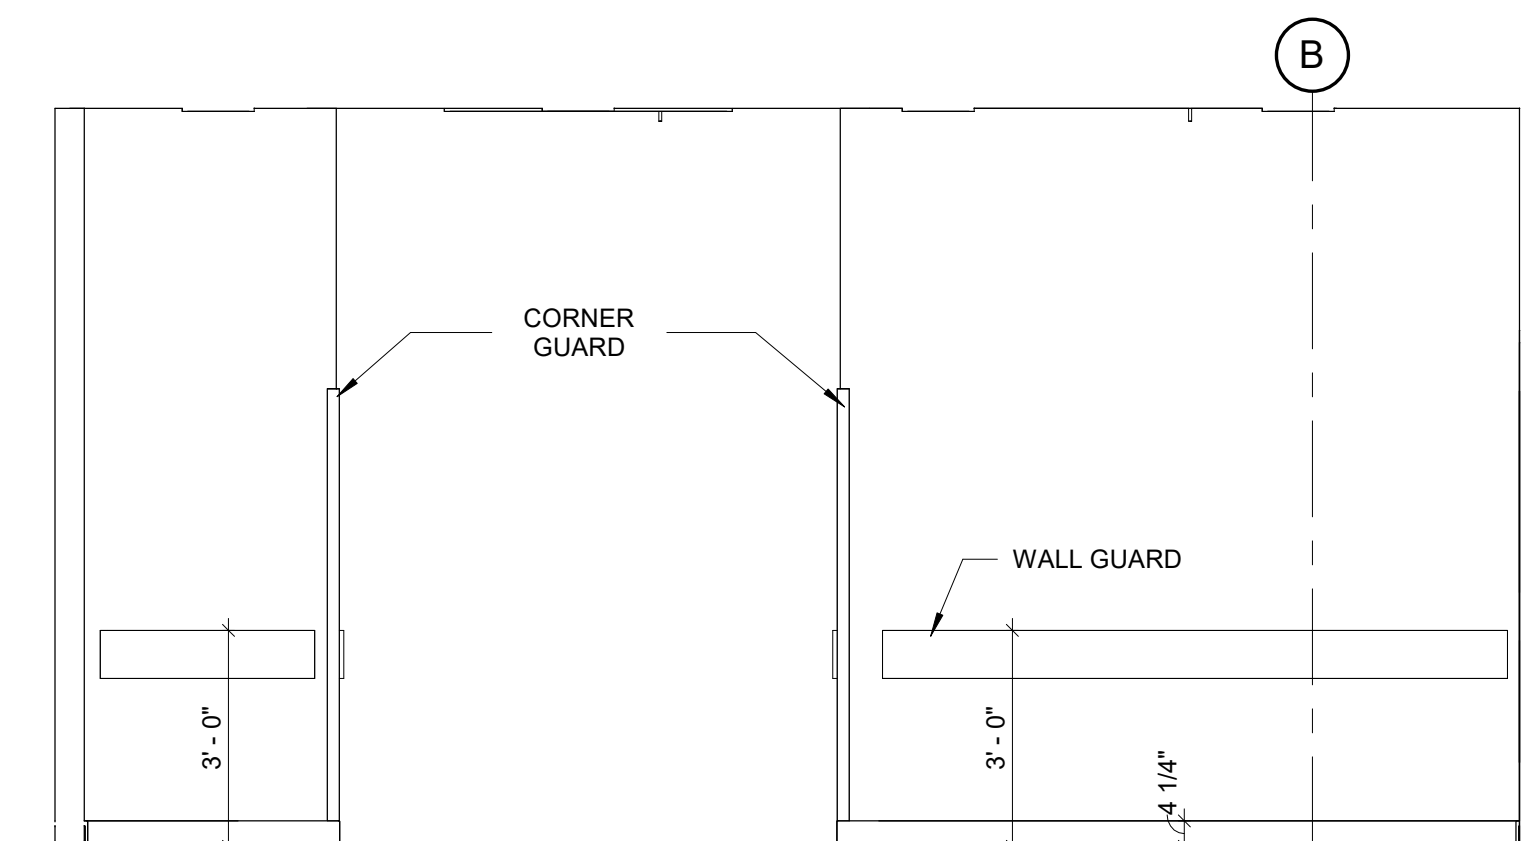


16 CORRIDOR 324 EAST
3/8" = 1'-0"

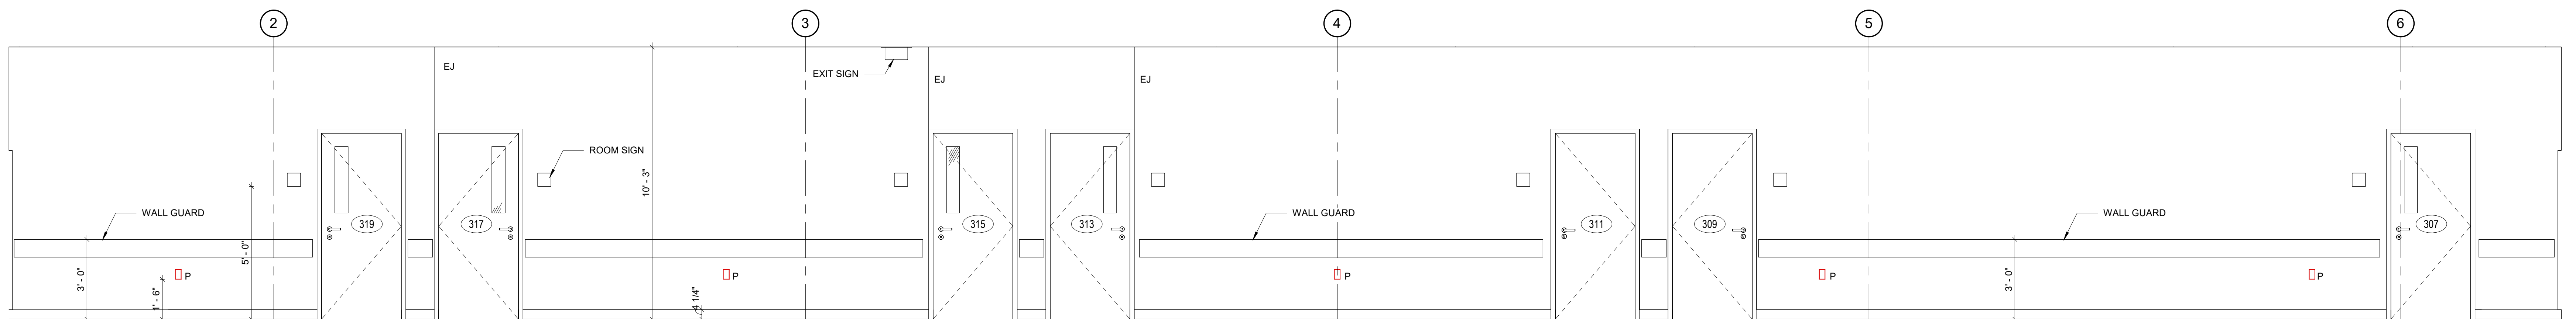


17 CORRIDOR 325 NORTH
3/8" = 1'-0"

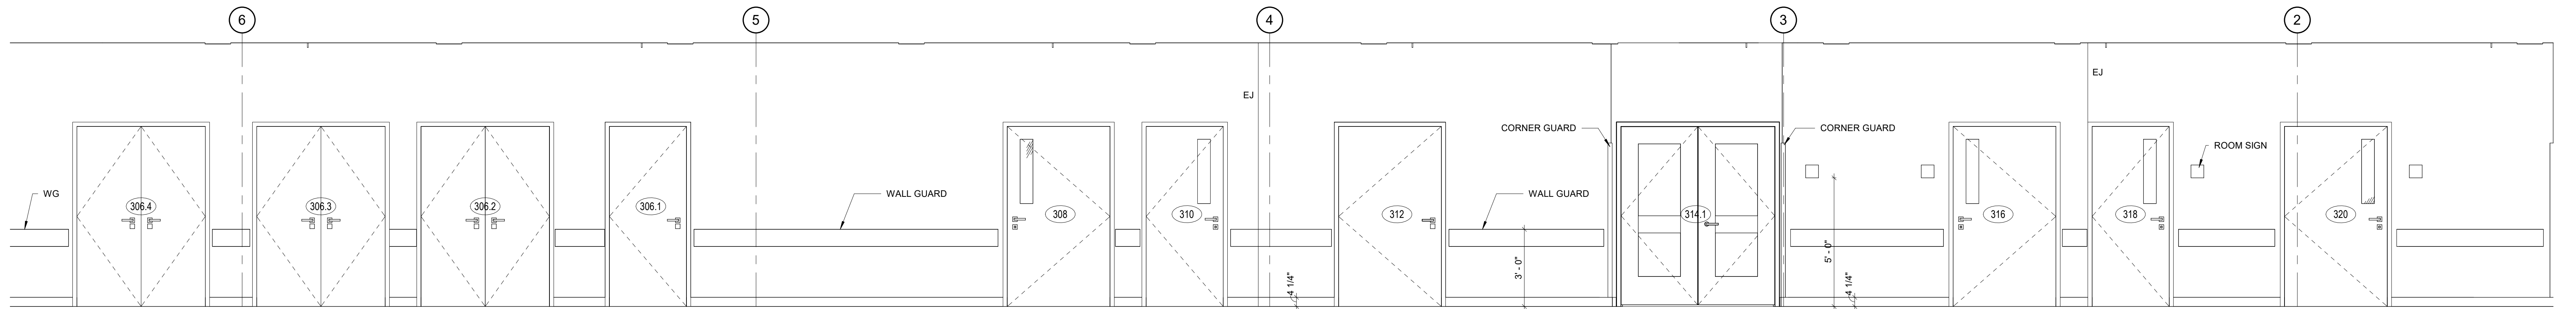


1 CORRIDOR 325 SOUTH
3/8" = 1'-0"

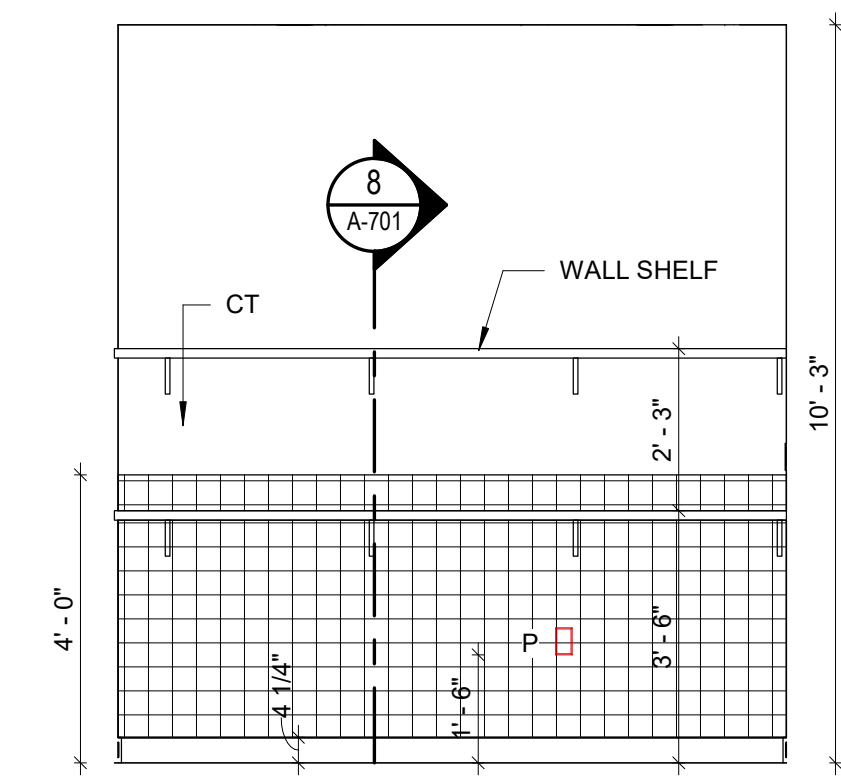


2 CUST 326 NORTH
3/8" = 1'-0"

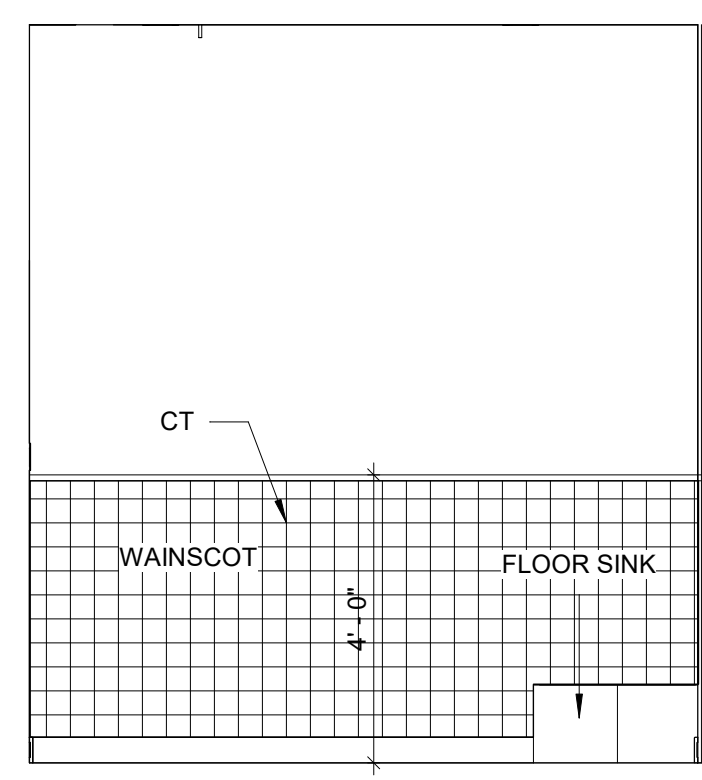


3 CUST 326 SOUTH
3/8" = 1'-0"

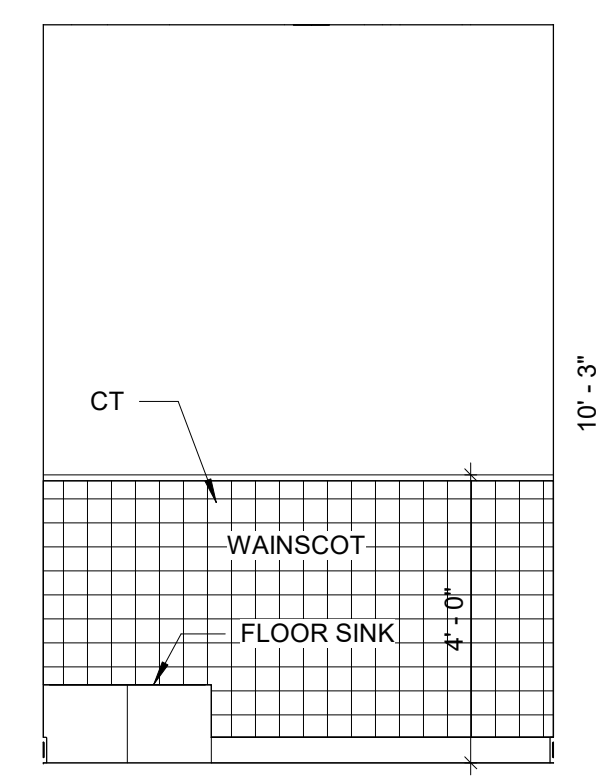


4 CUST 326 WEST
3/8" = 1'-0"

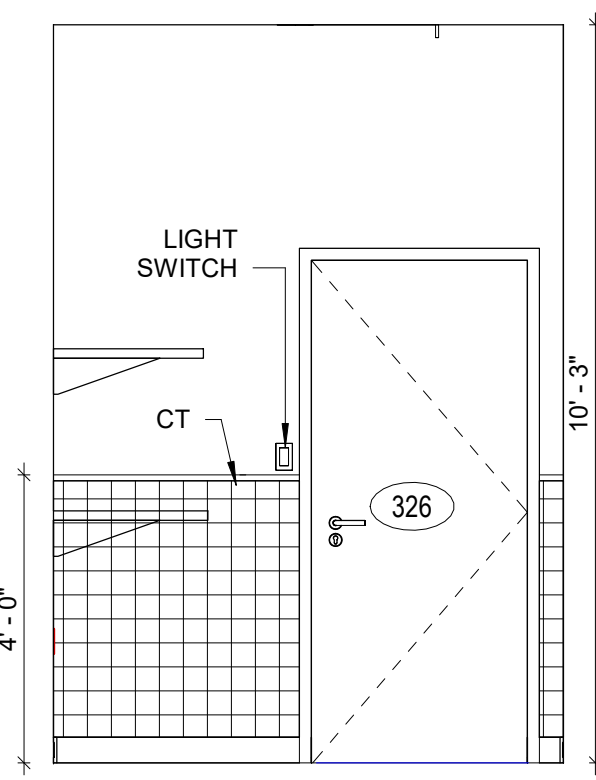


5 CUST 326 EAST
3/8" = 1'-0"

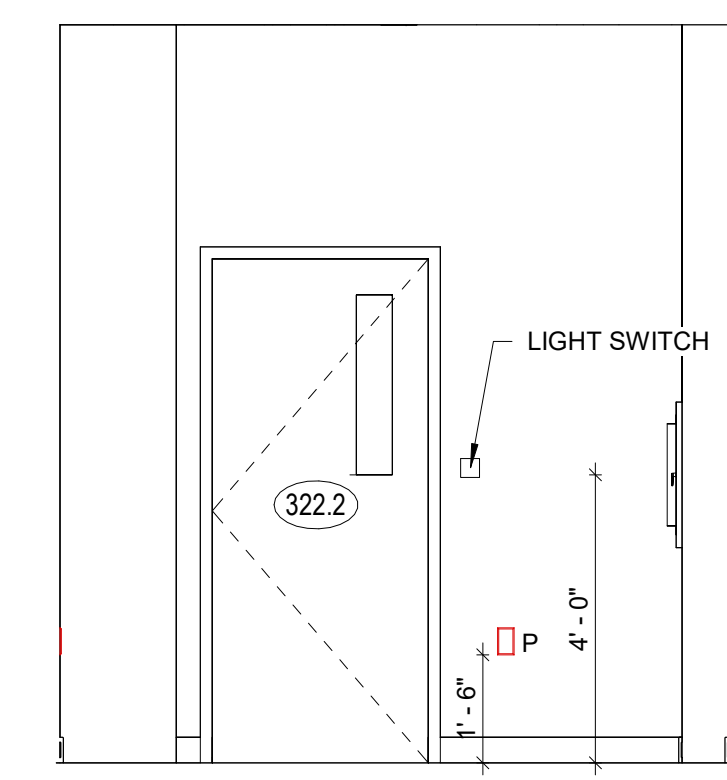


6 VEST 327 NORTH
3/8" = 1'-0"

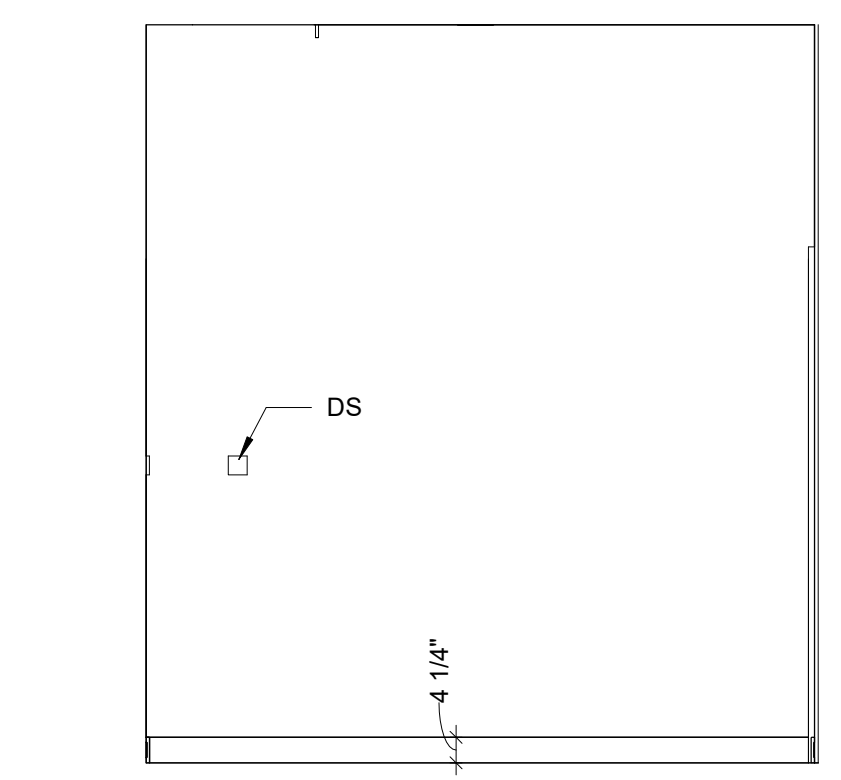


7 VEST 327 SOUTH
3/8" = 1'-0"

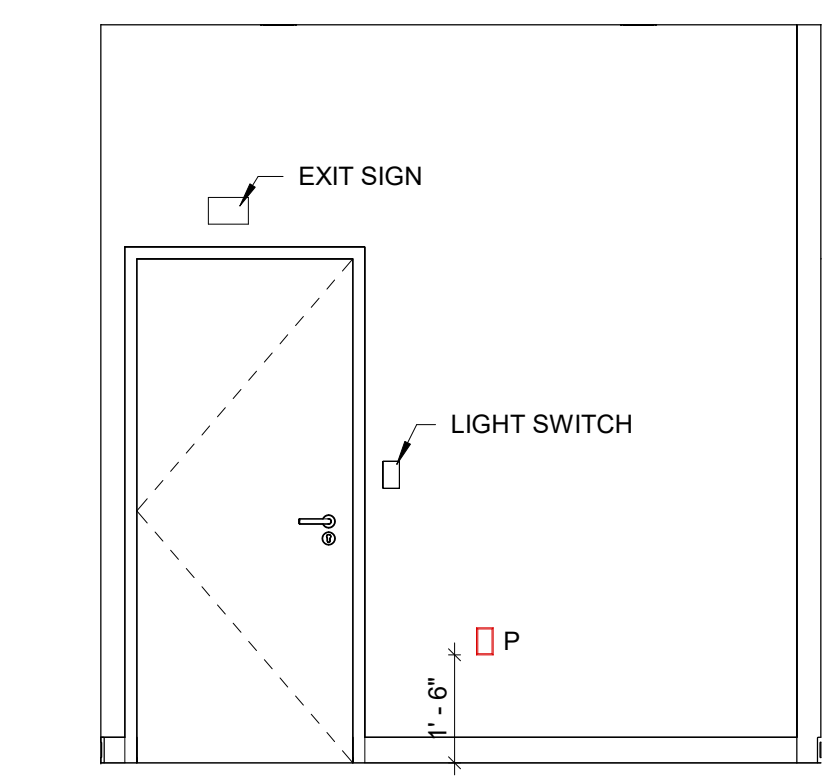


8 VEST 327 WEST
3/8" = 1'-0"

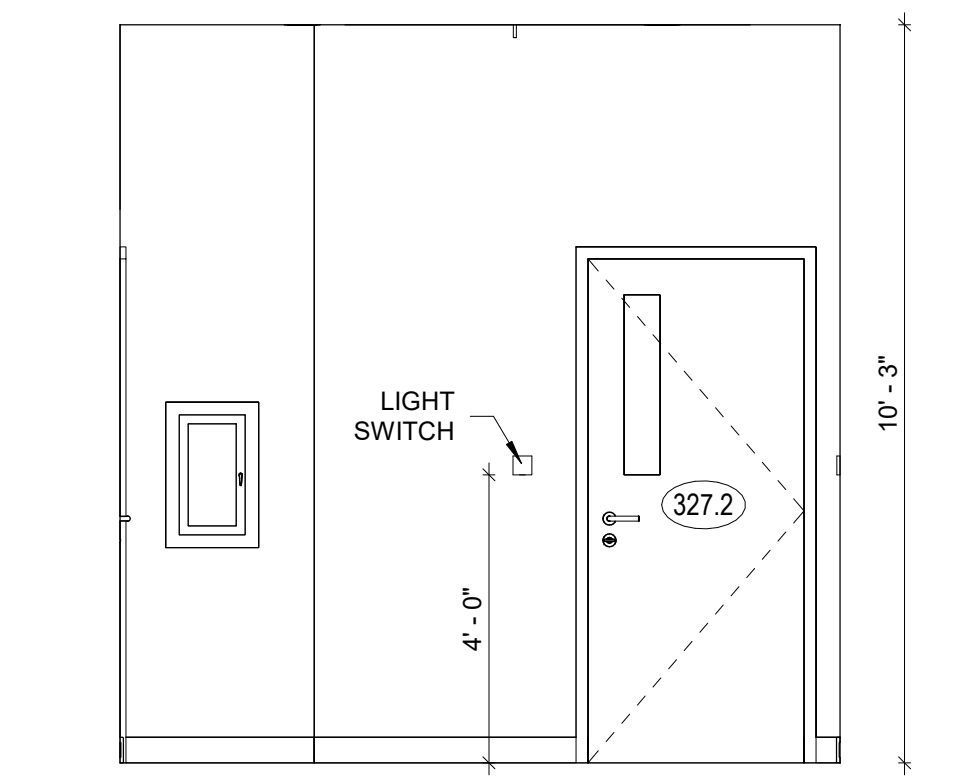


9 VEST 327 EAST
3/8" = 1'-0"

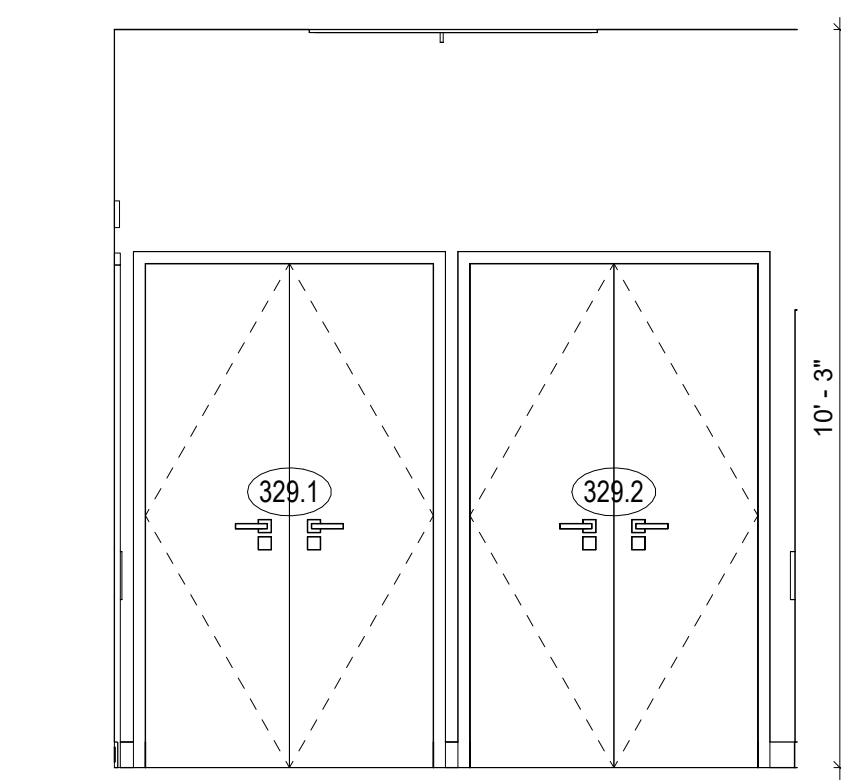


10 CORRIDOR 330 NORTH
3/8" = 1'-0"

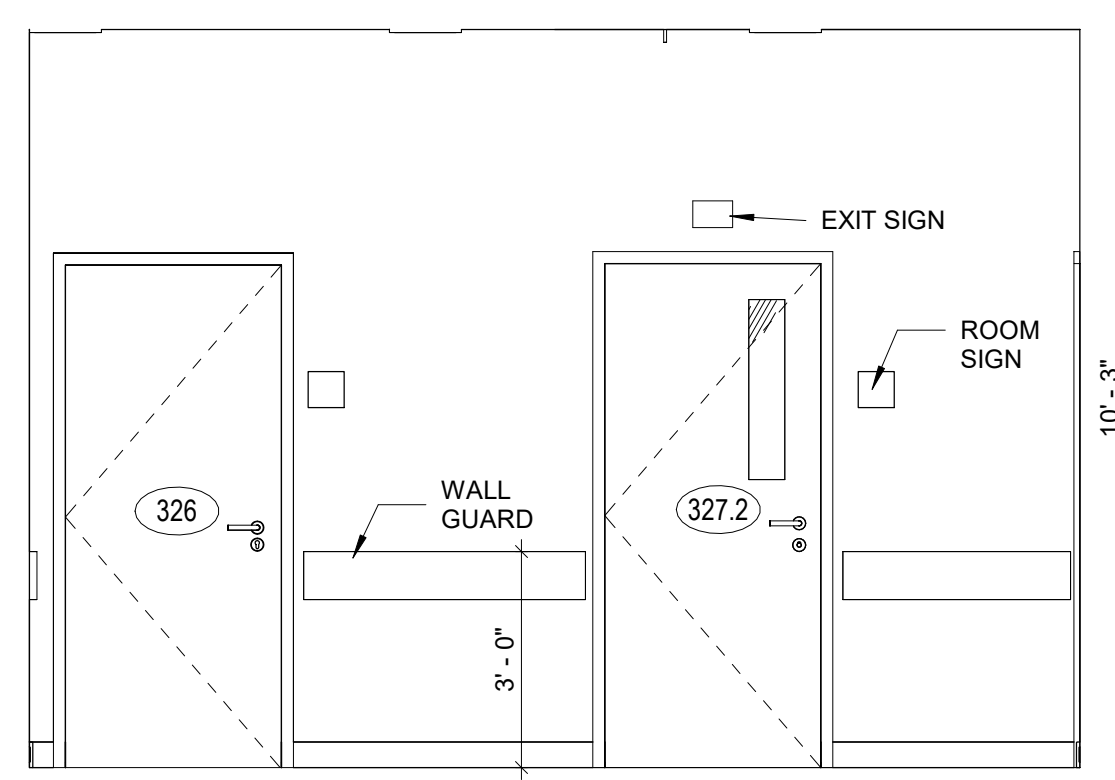


11 CORRIDOR 330 WEST
3/8" = 1'-0"

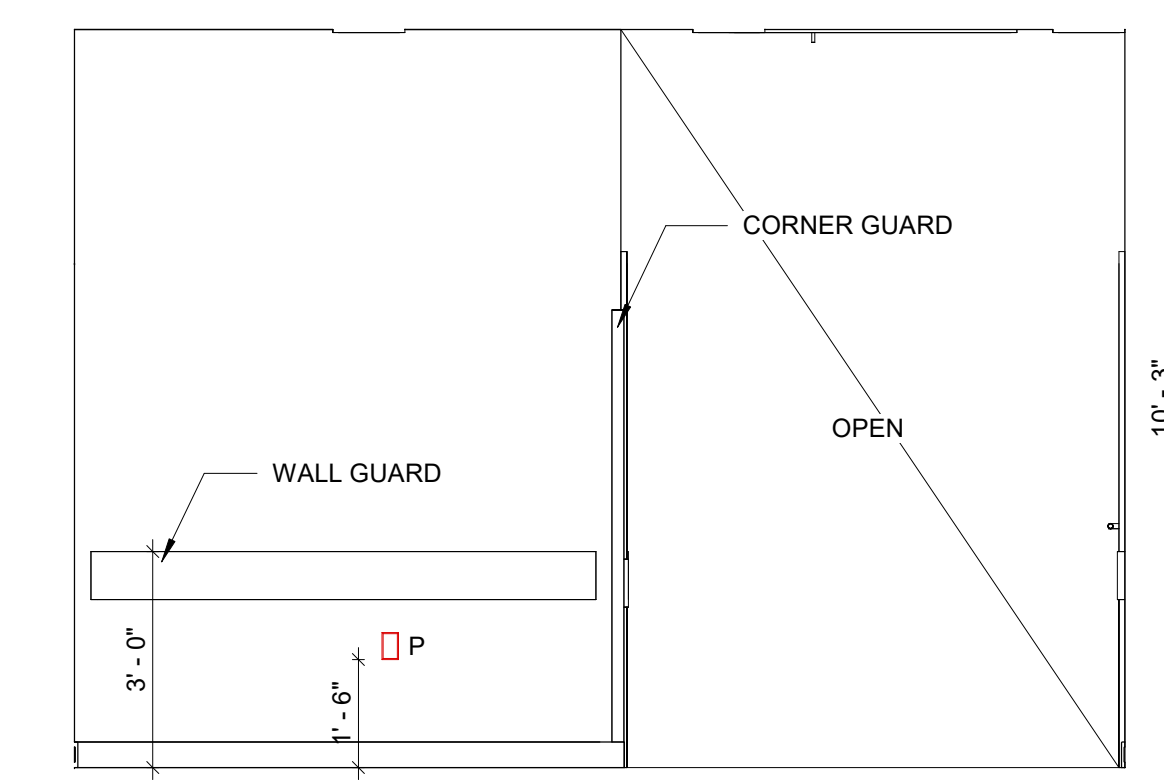


12 CORRIDOR 330 EAST
3/8" = 1'-0"

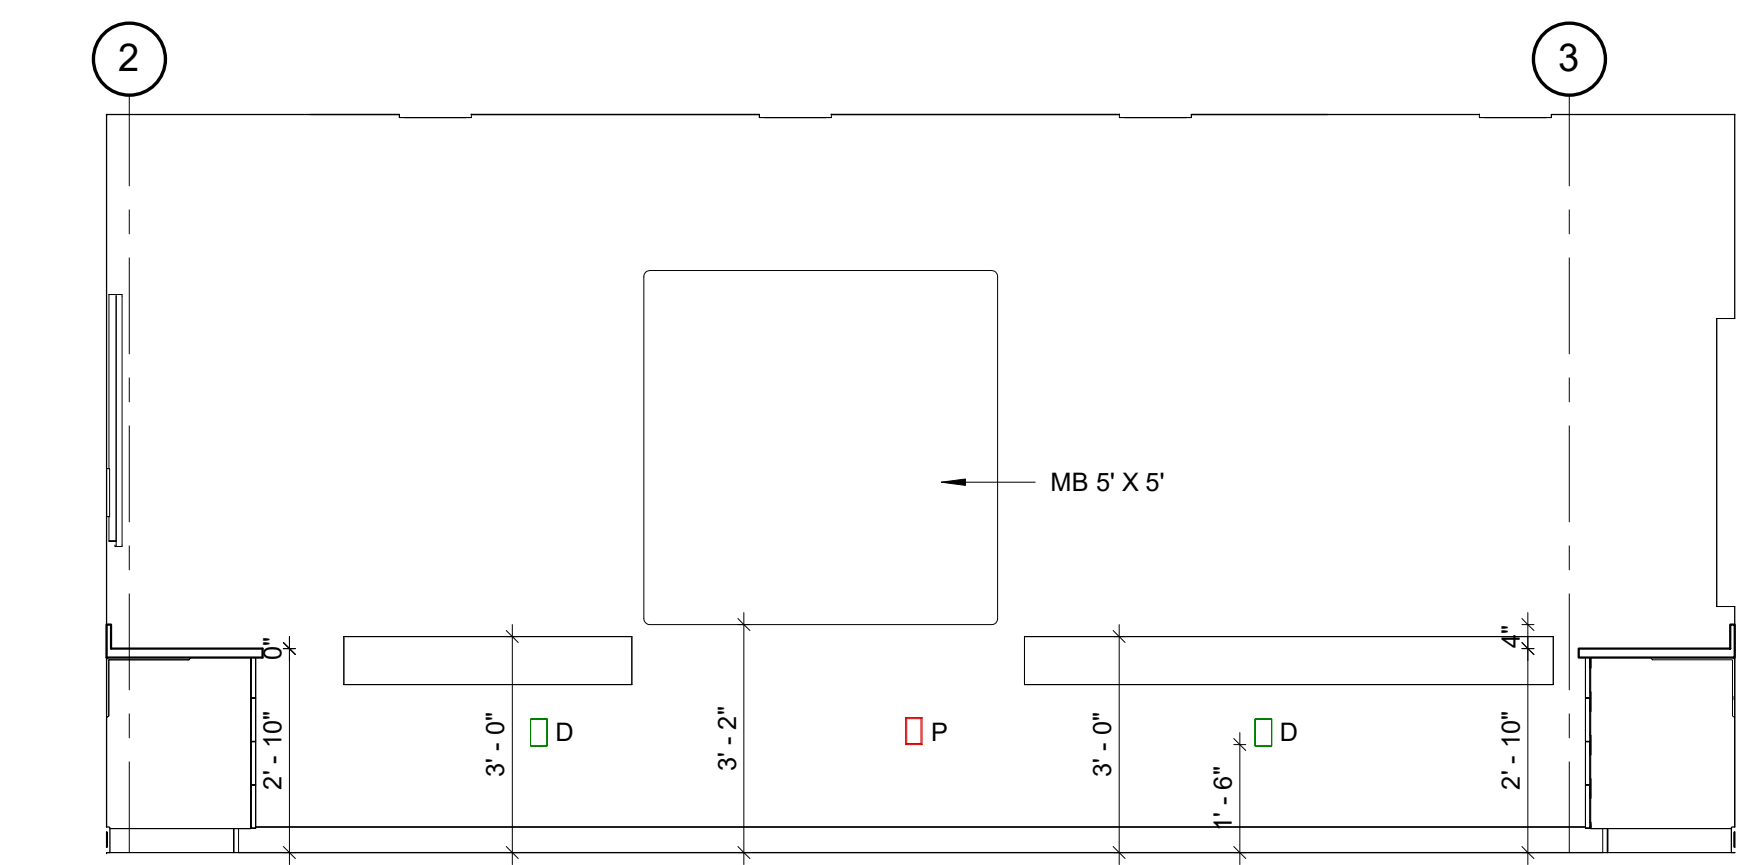


13 CONF. ROOM 331 NORTH
3/8" = 1'-0"

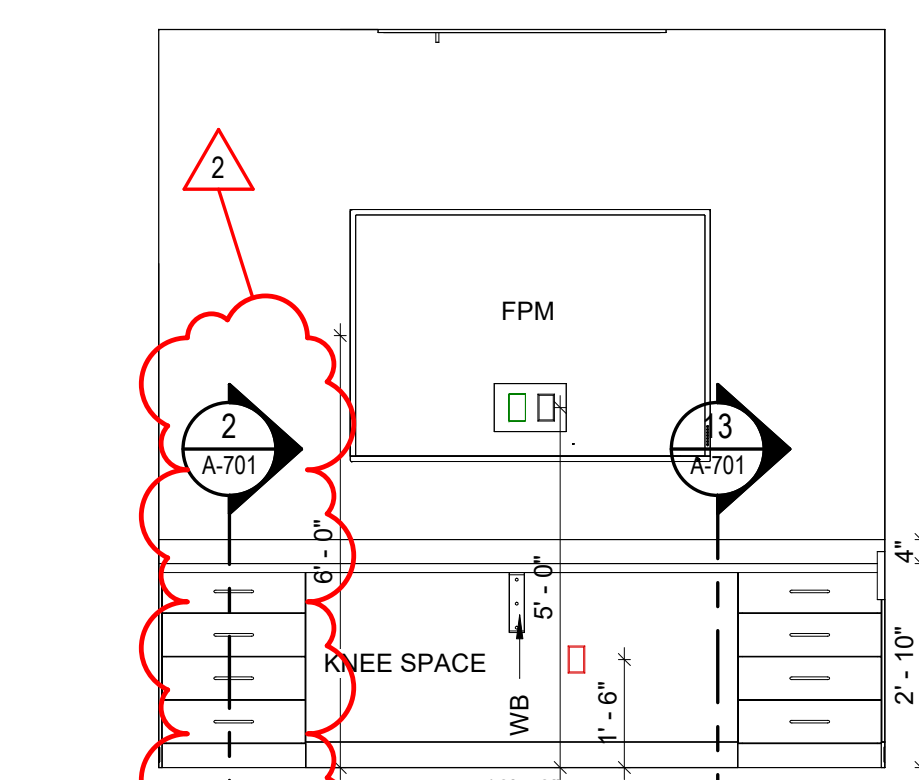


14 INT ELEV CONF ROOM WEST
3/8" = 1'-0"

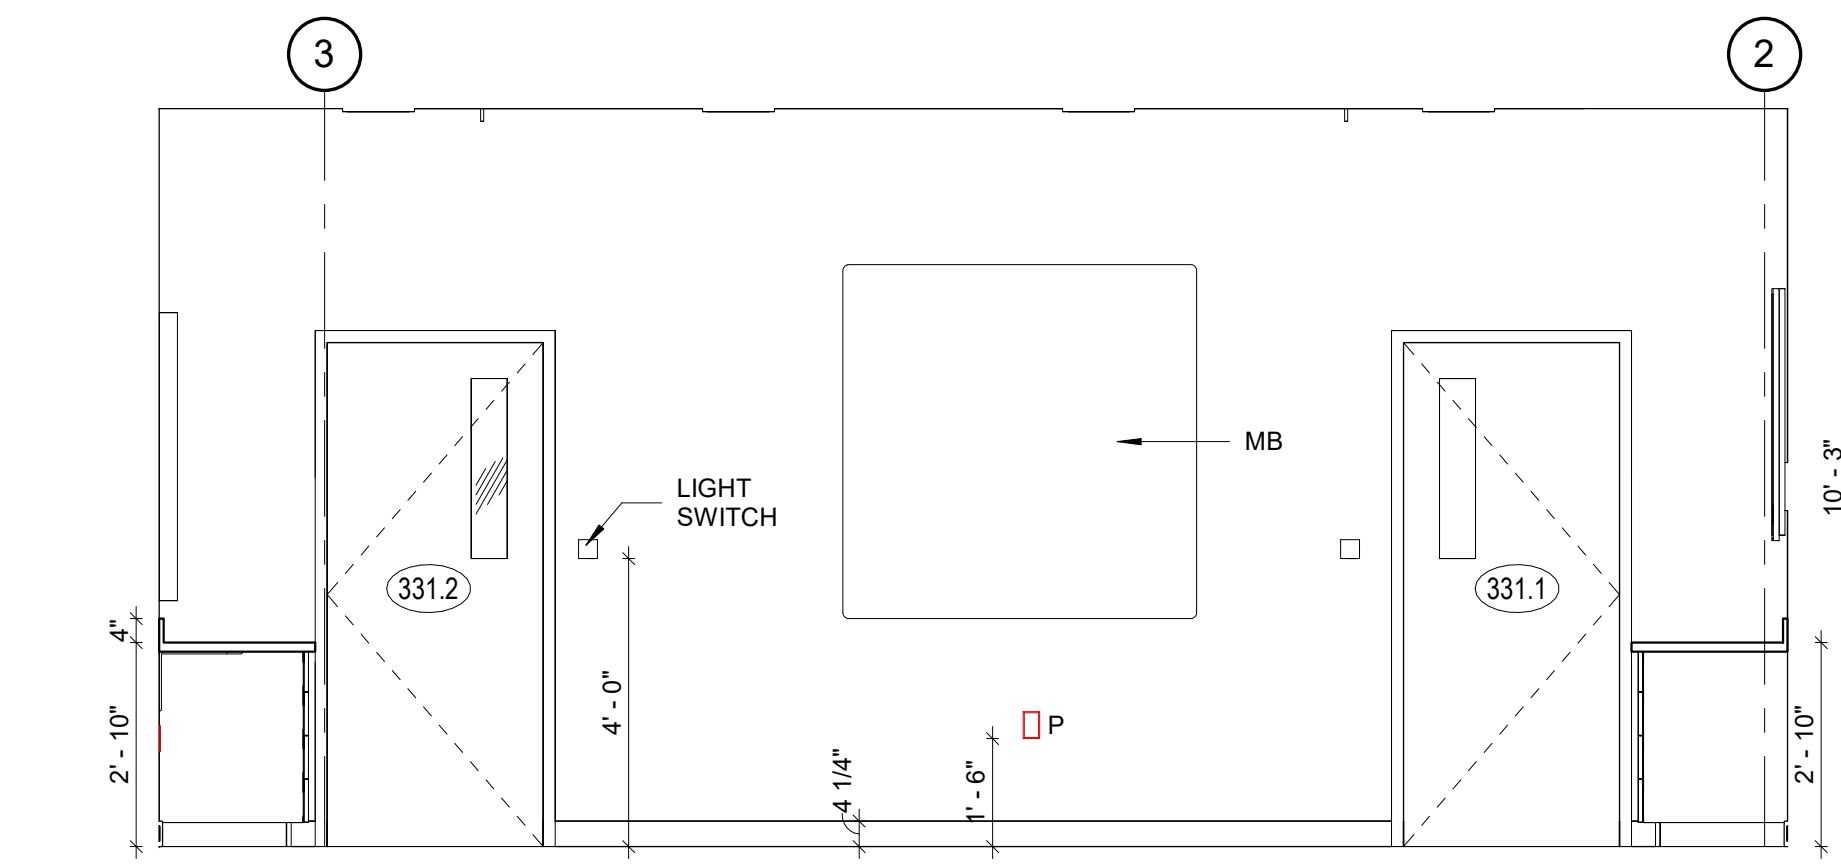


15 CONF. ROOM 331 SOUTH
3/8" = 1'-0"

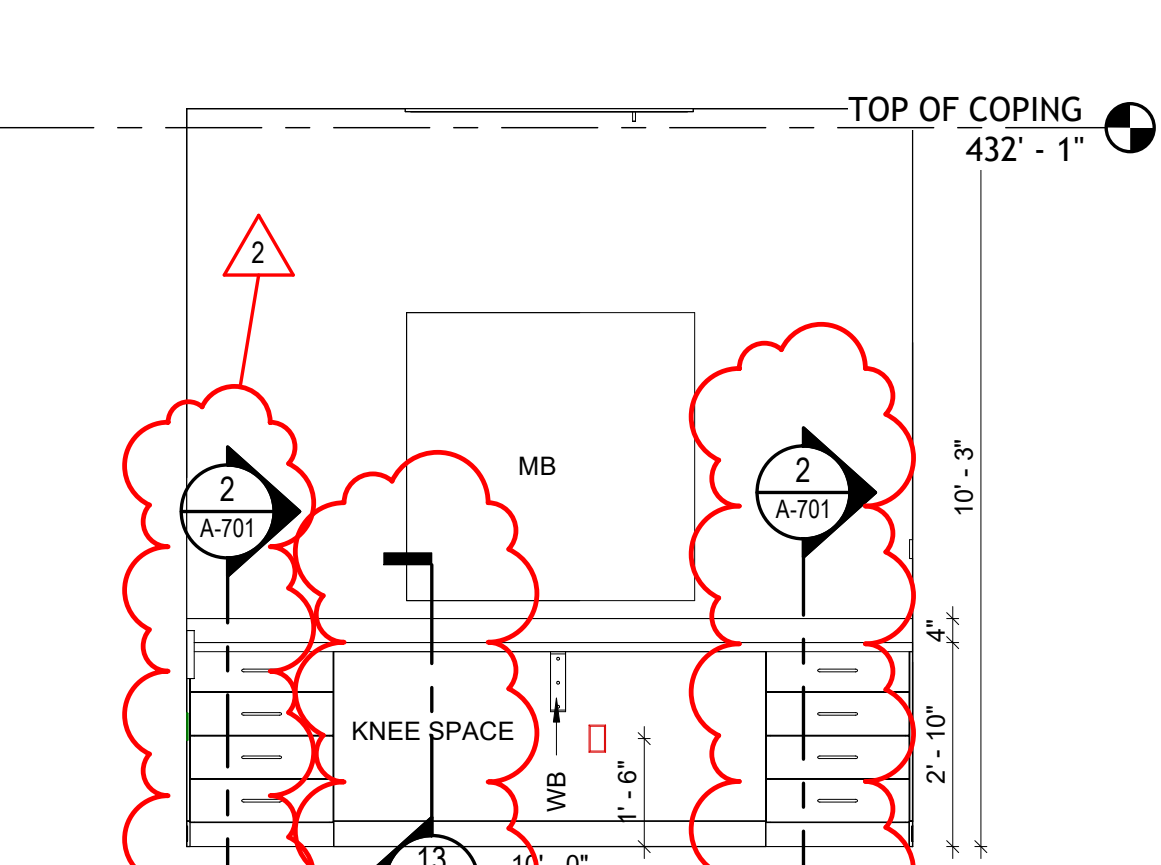


16 CONF. ROOM 331 EAST
3/8" = 1'-0"

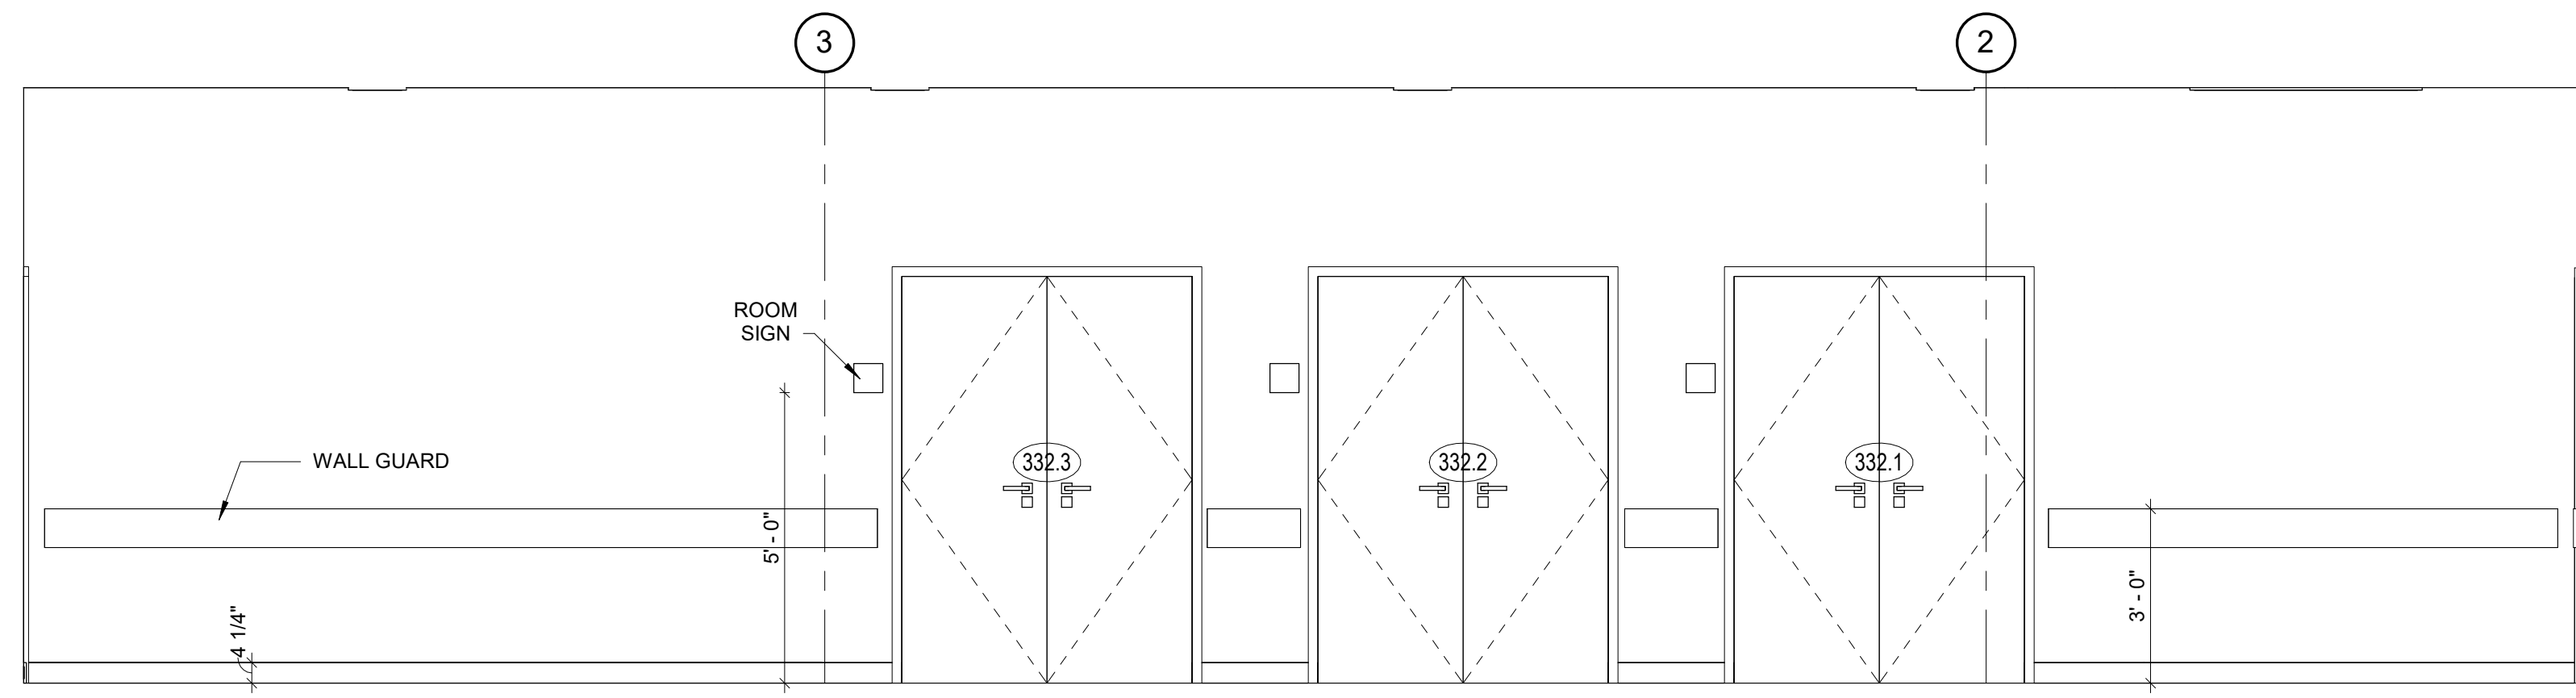


17 CORRIDOR 332 SOUTH
3/8" = 1'-0"

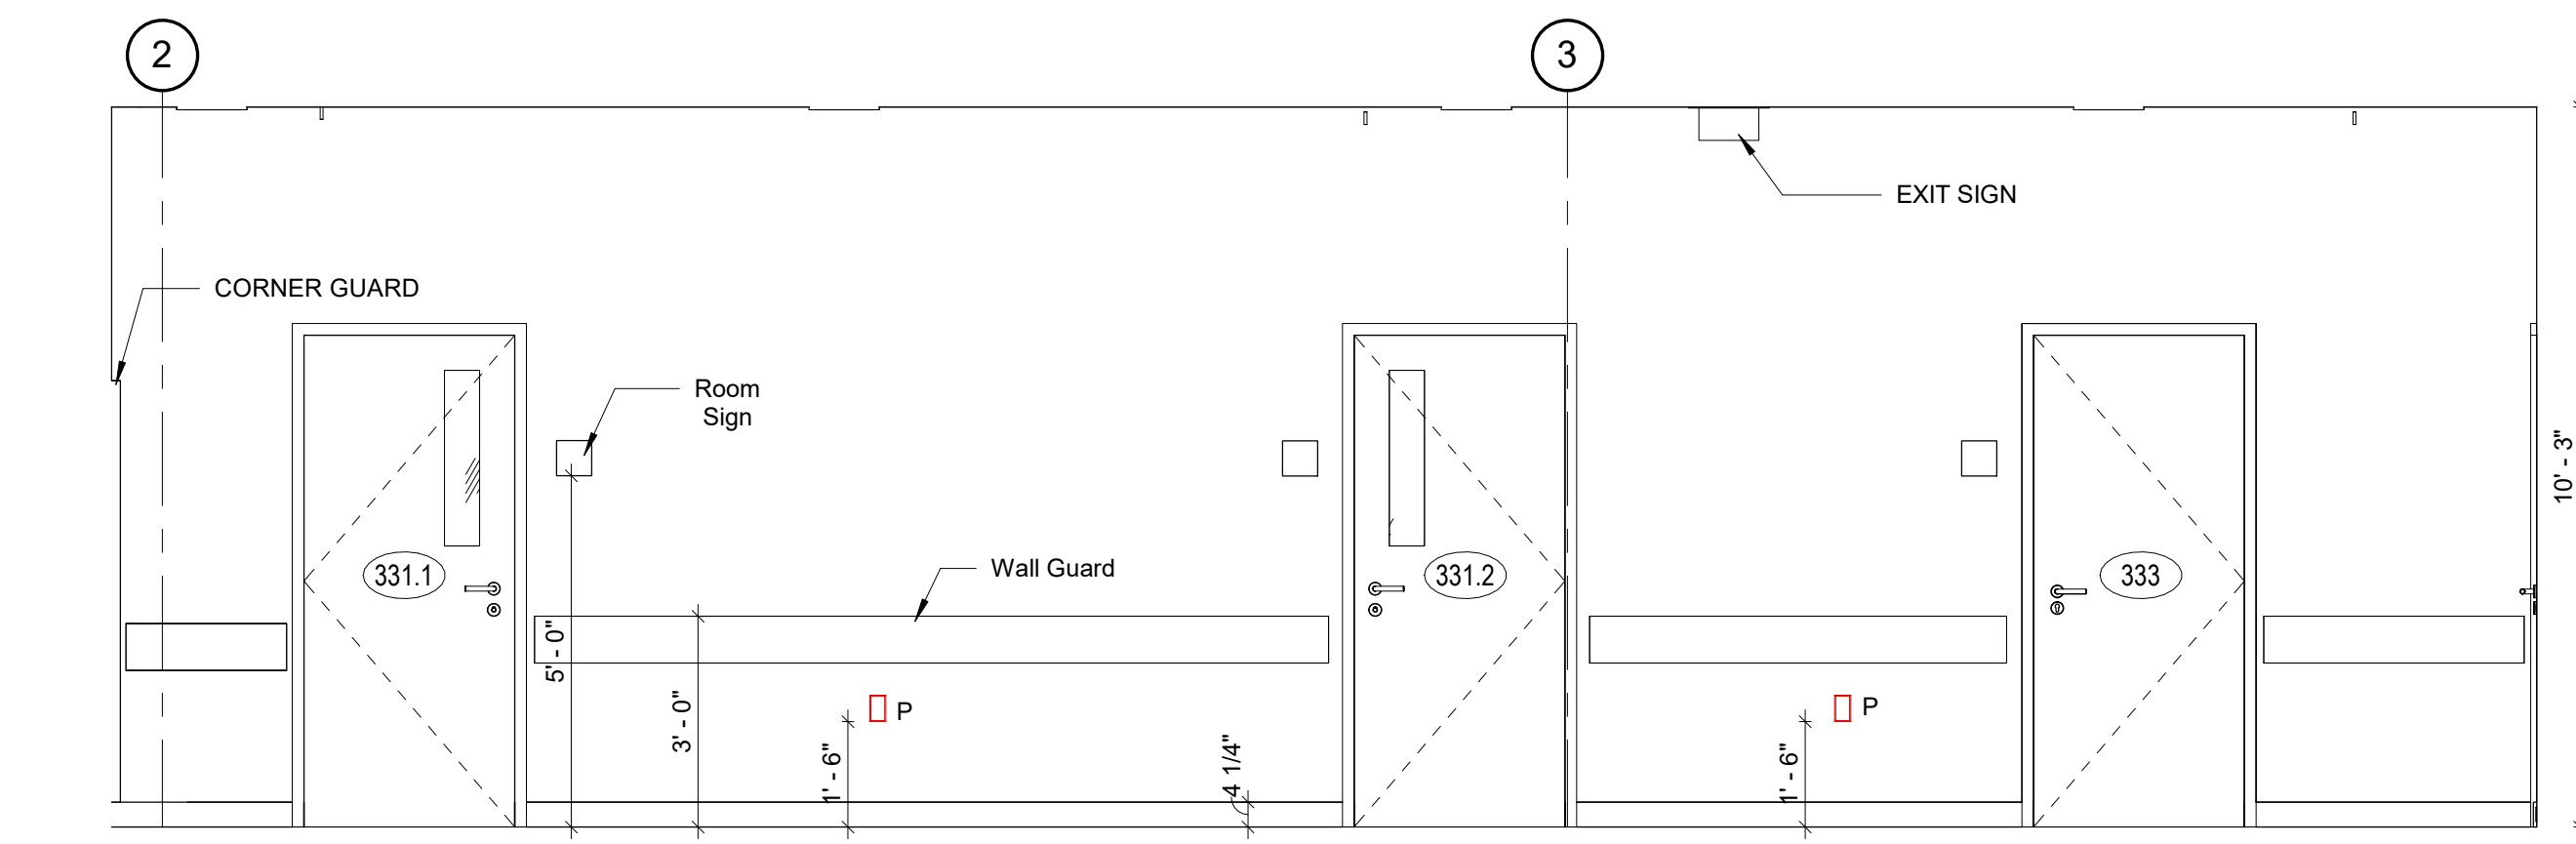


18 CORRIDOR 332 NORTH
3/8" = 1'-0"

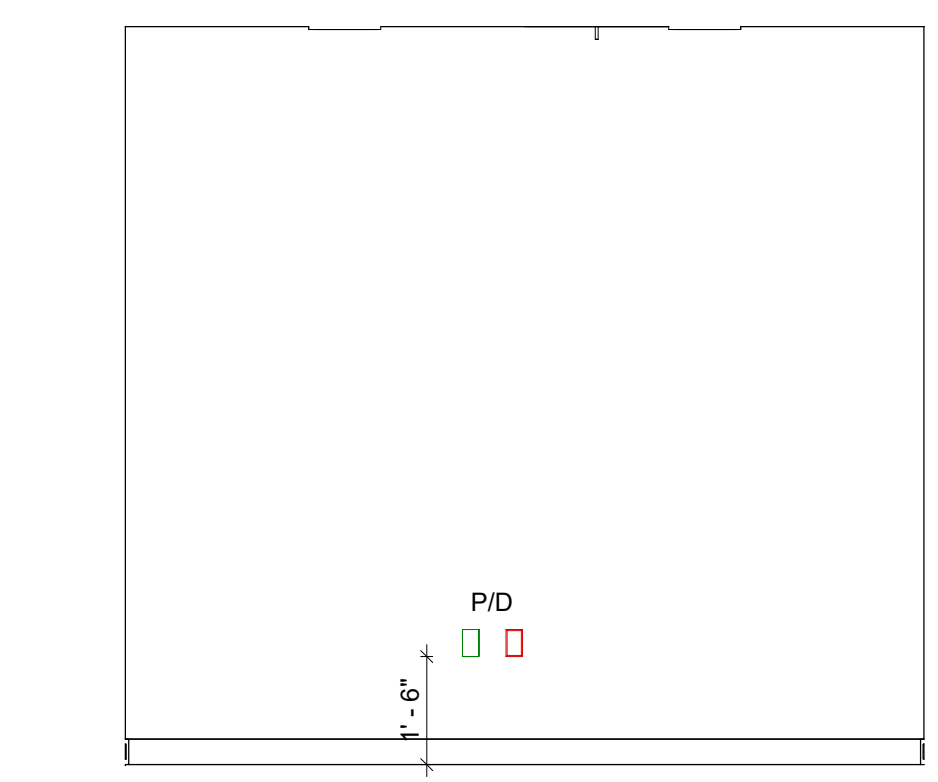


19 IT 333 NORTH
3/8" = 1'-0"

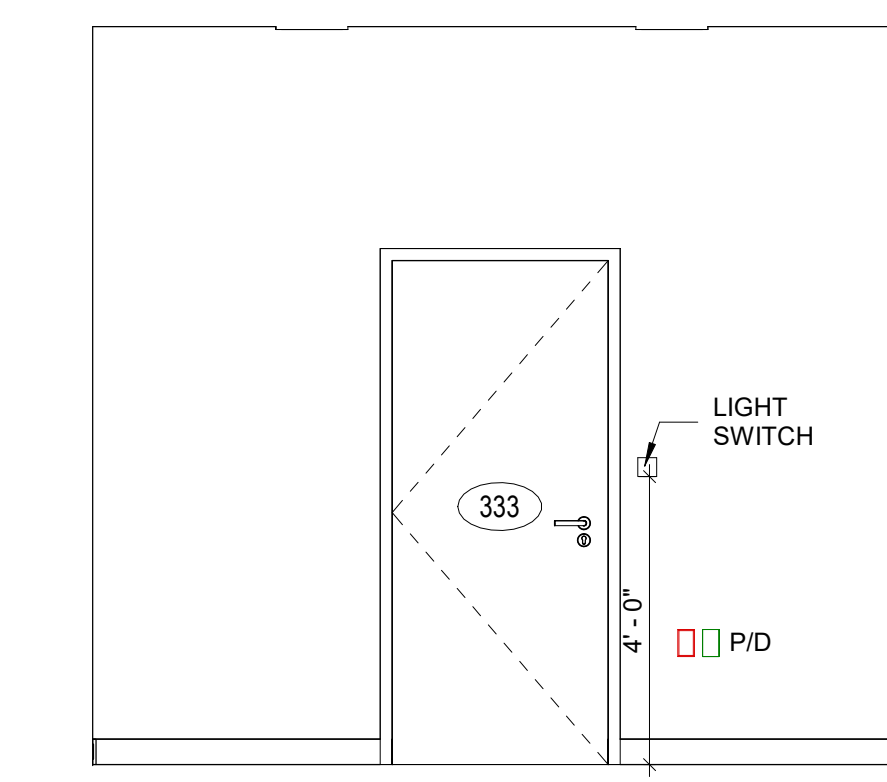


20 IT 333 SOUTH
3/8" = 1'-0"

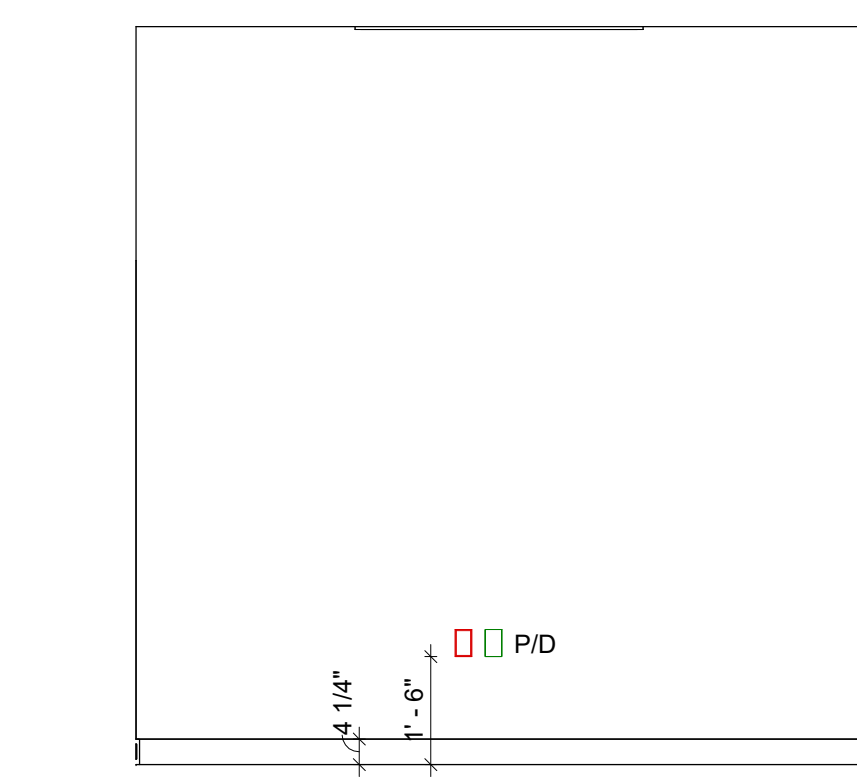


21 IT 333 WEST
3/8" = 1'-0"

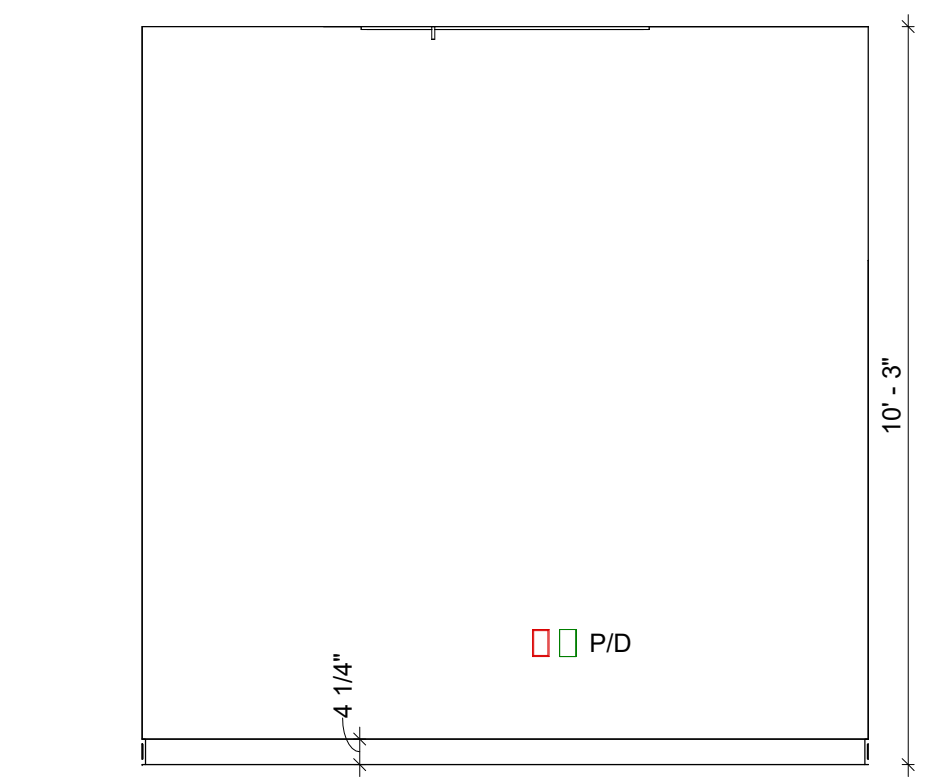


22 IT 333 EAST
3/8" = 1'-0"

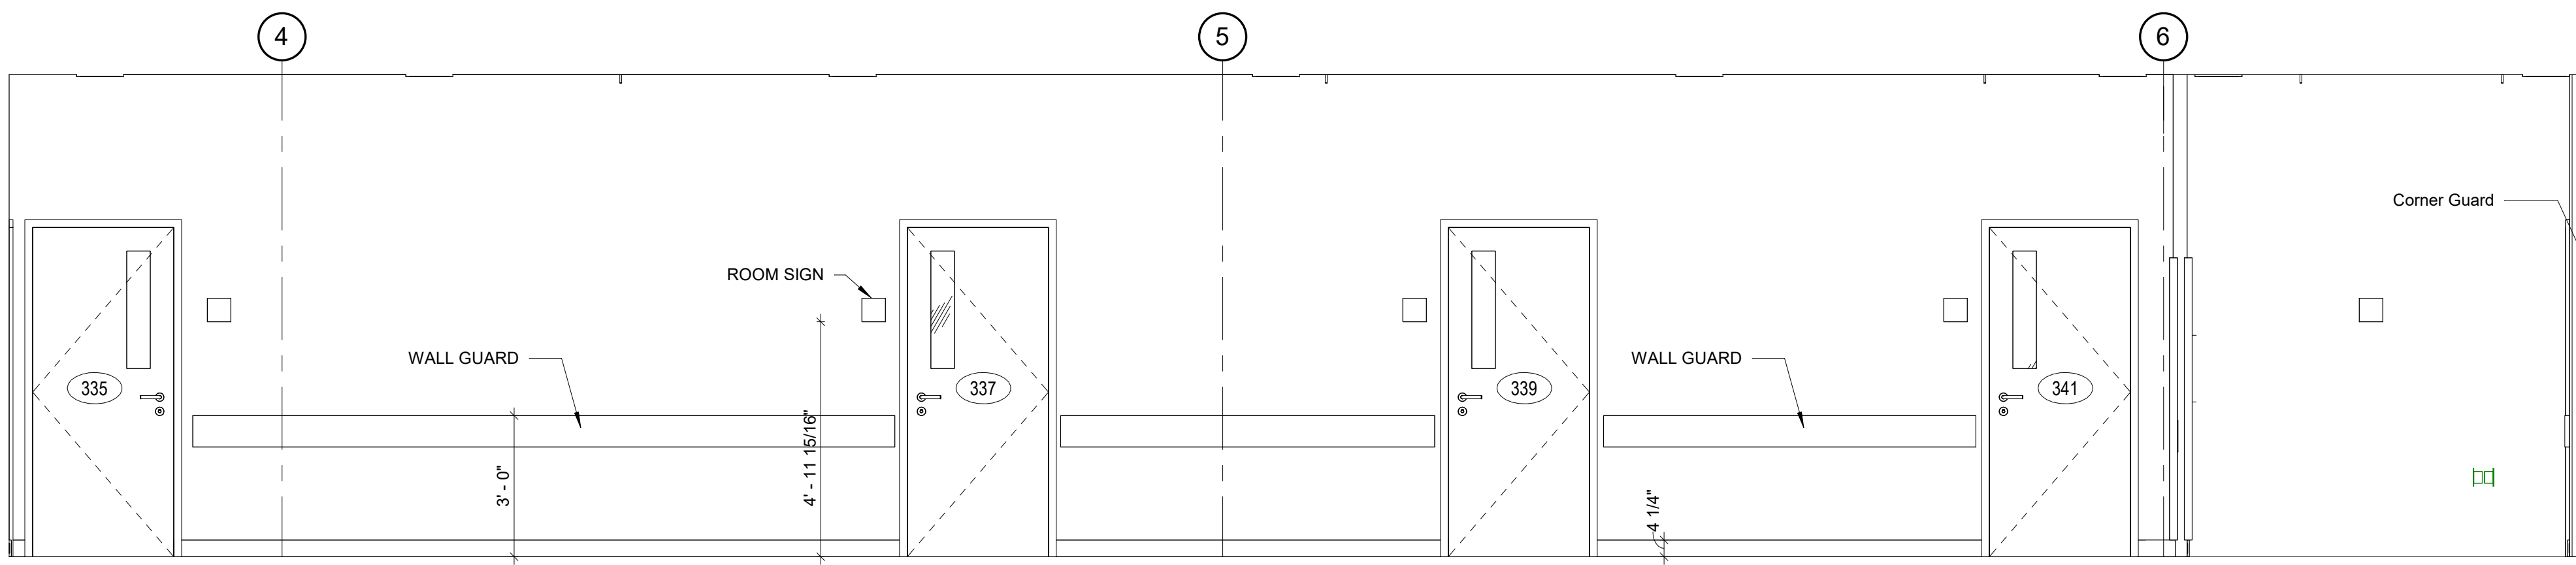


1 CORRIDOR 334 NORTH
3/8" = 1'-0"

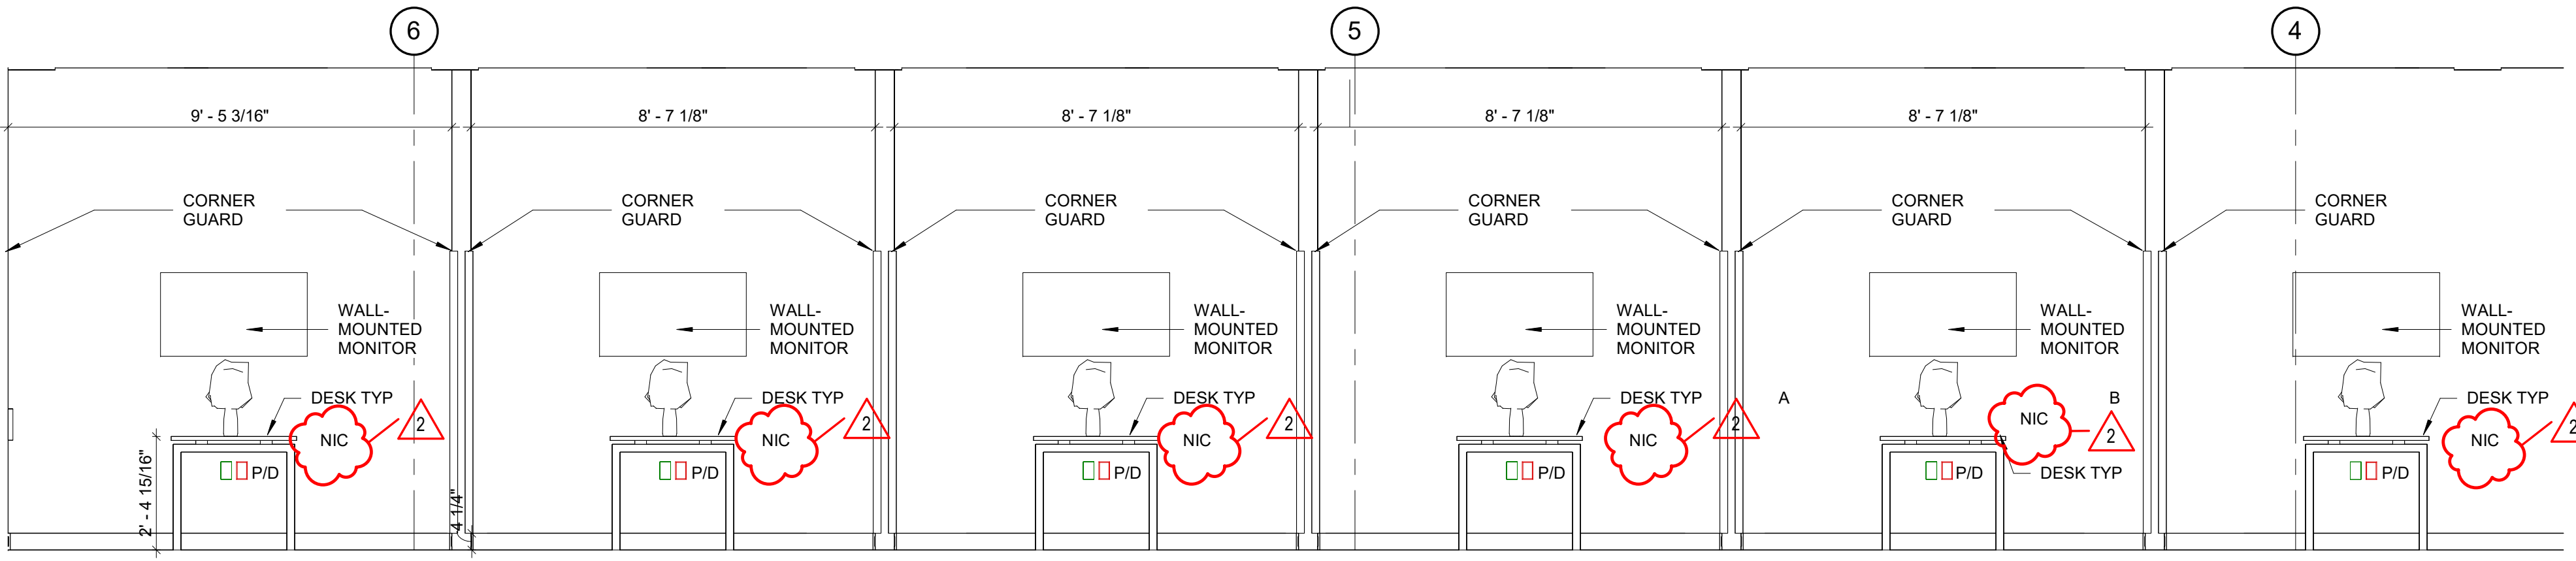

2 CORRIDOR 334 SOUTH
3/8" = 1'-0"

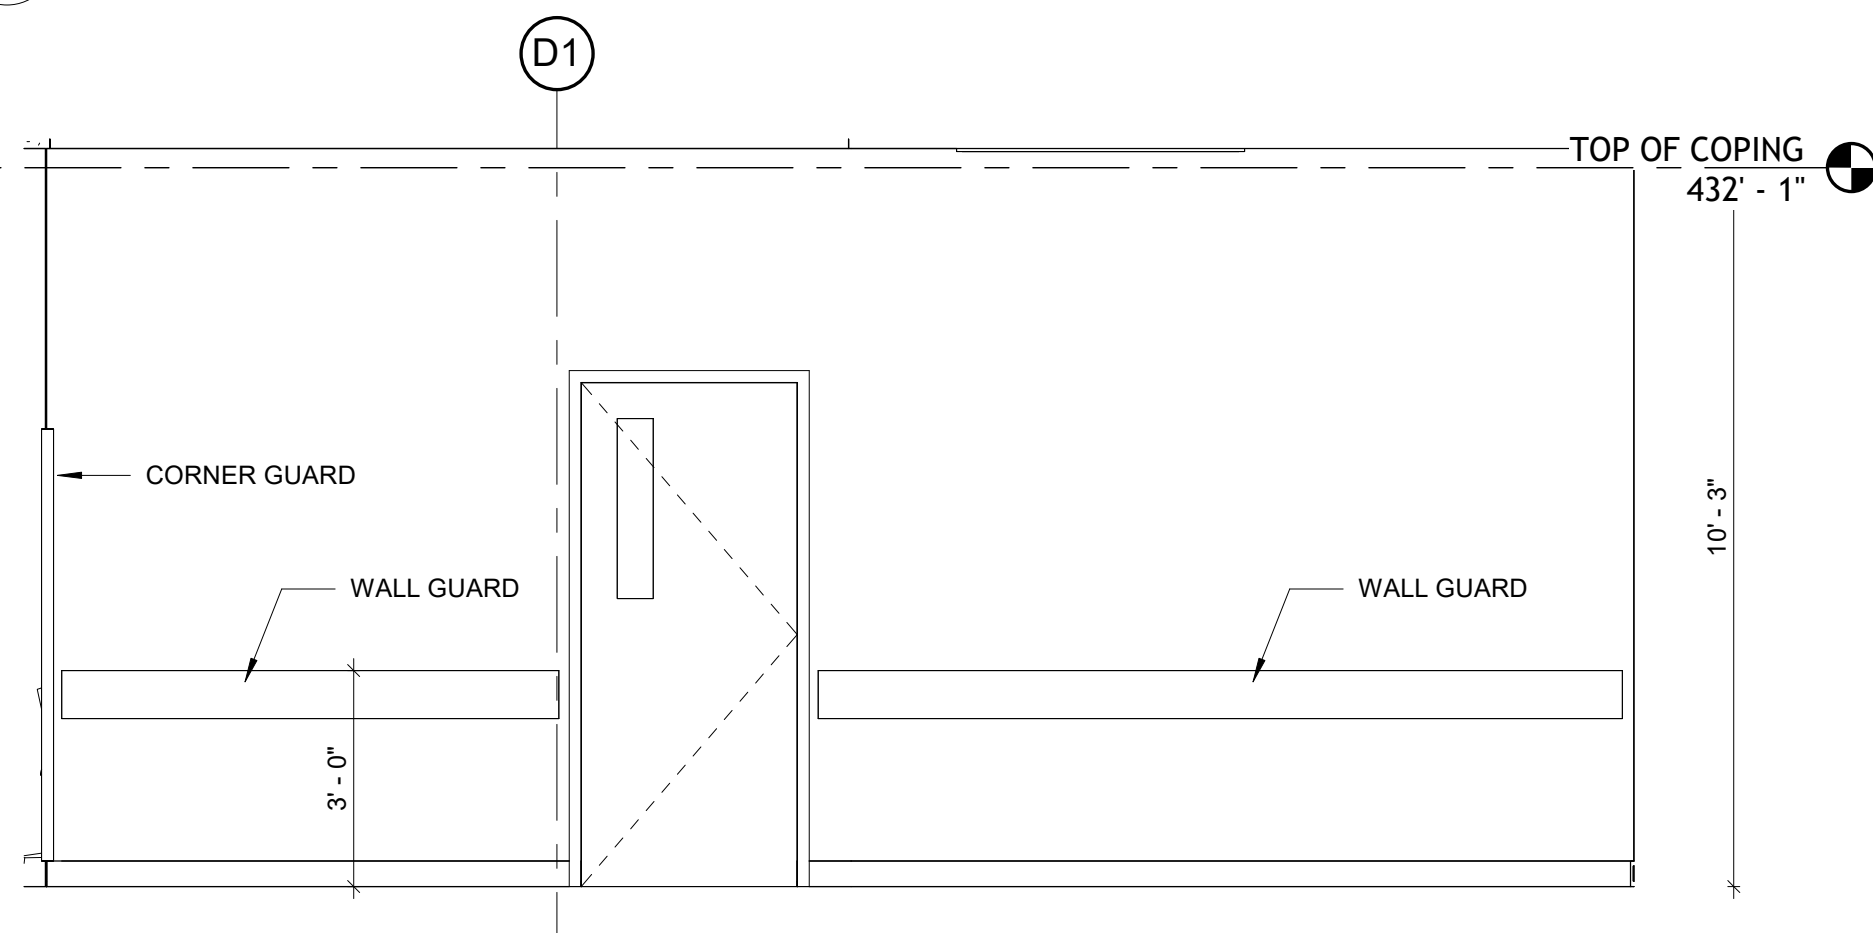


11 ALCOVE 340 - EAST
3/8" = 1'-0"

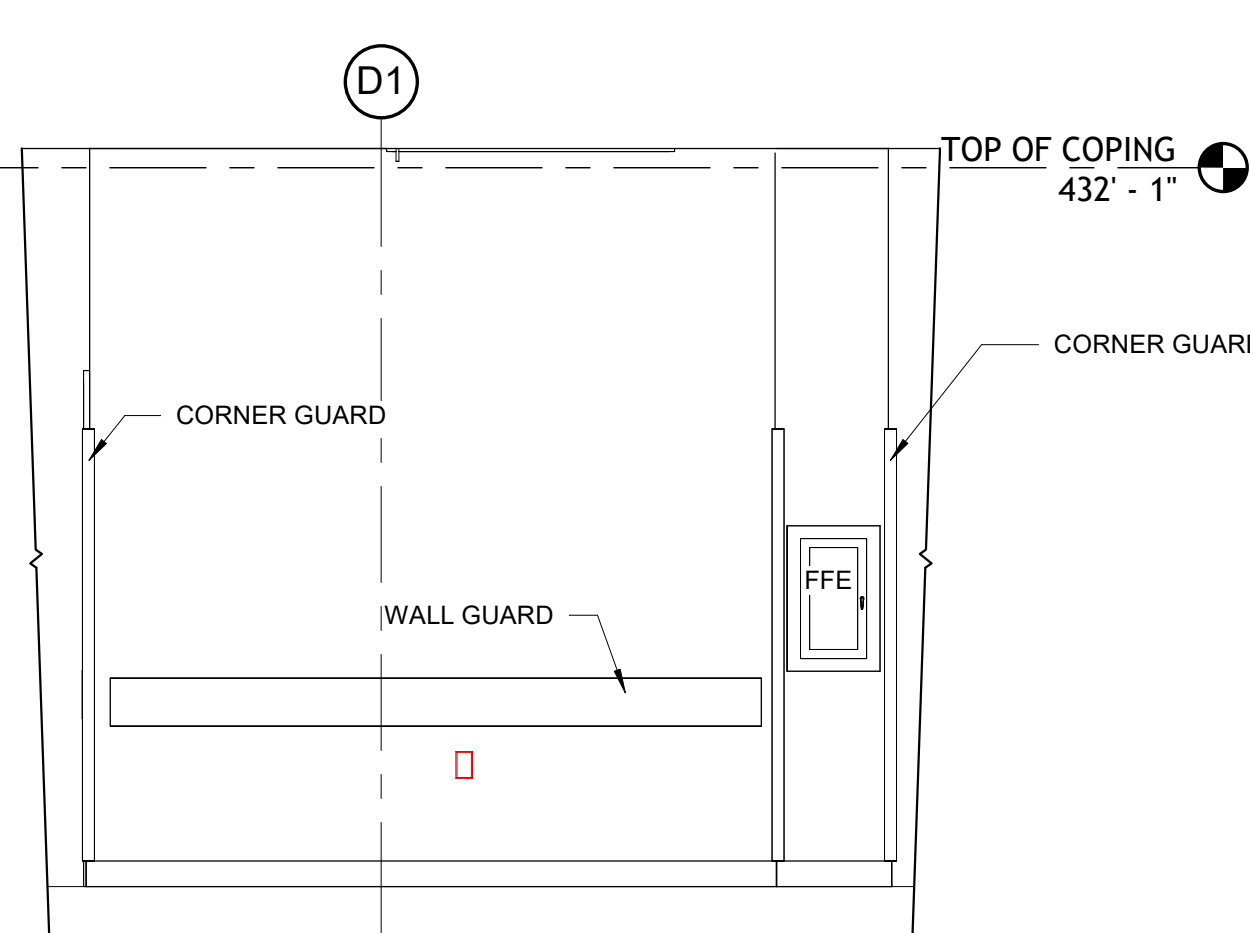


12 ALCOVE 340 - WEST
3/8" = 1'-0"




3 OFFICE 337 NORTH (OFFICE 333/335/339 SIMILAR)
3/8" = 1'-0"

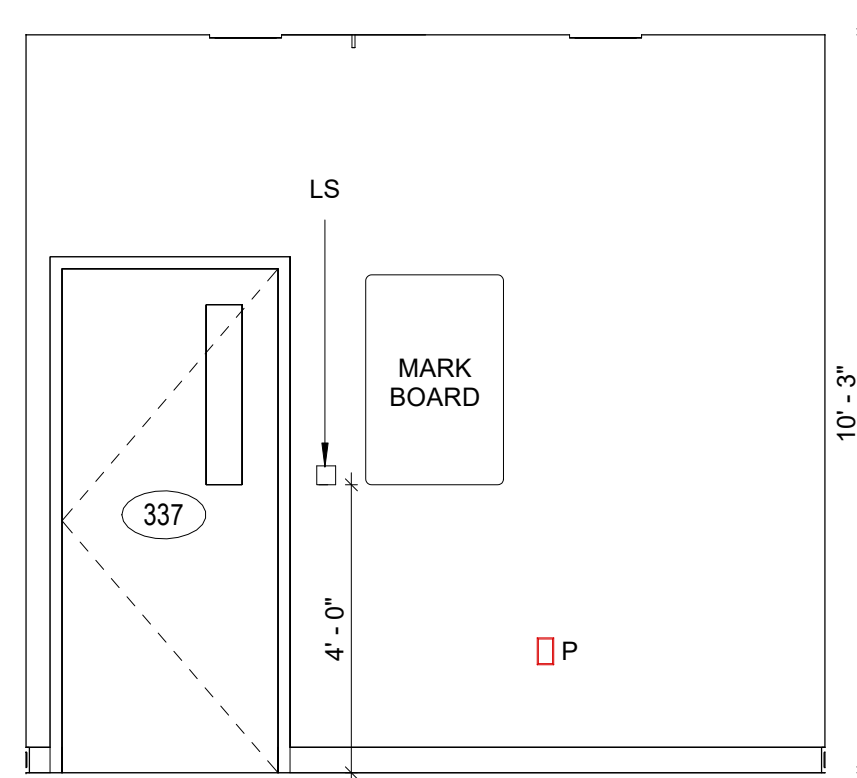


4 OFFICE 337 SOUTH
3/8" = 1'-0"

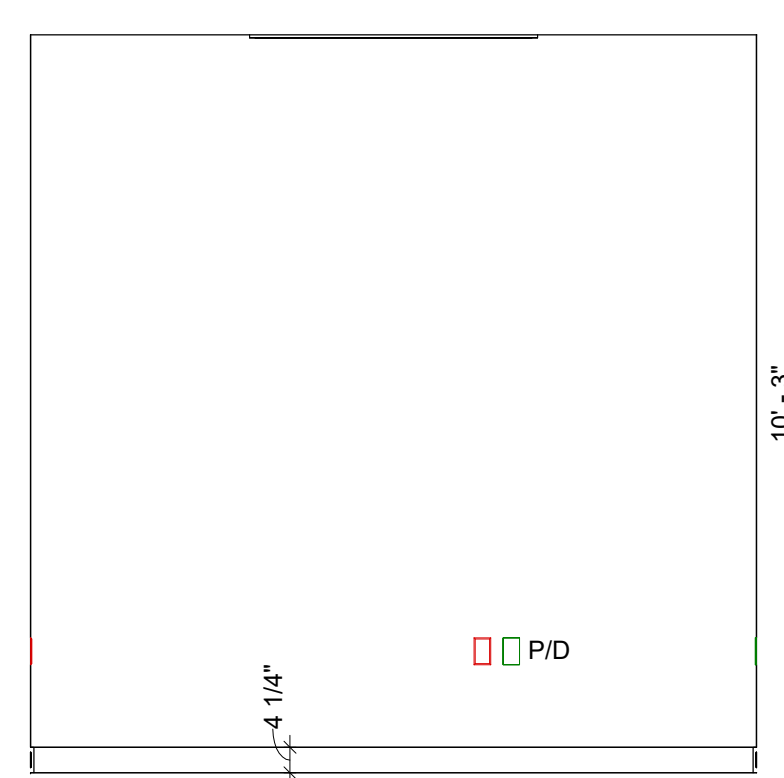


5 OFFICE 337 WEST
3/8" = 1'-0"

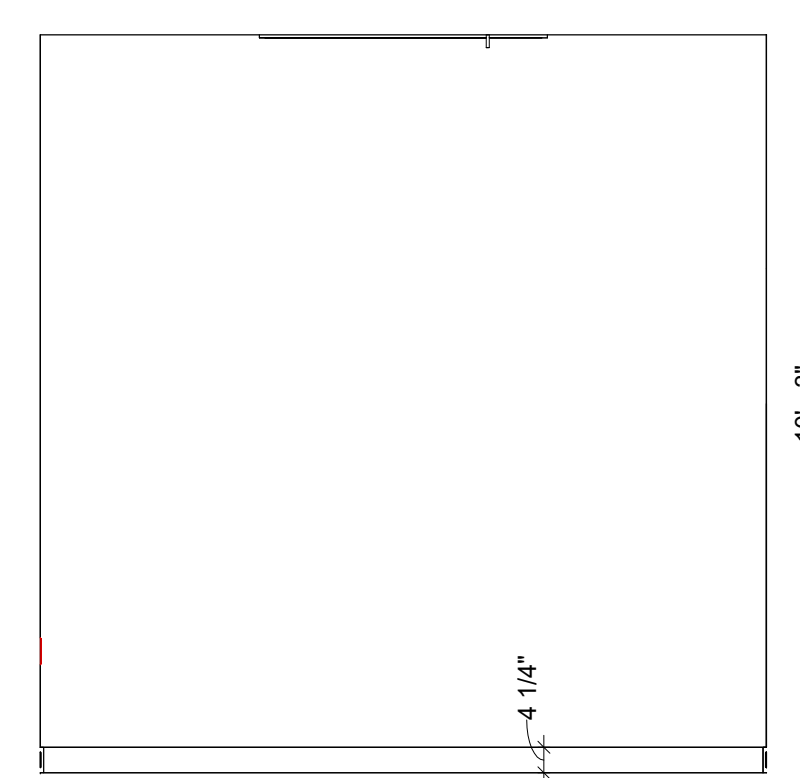


6 OFFICE 337 EAST
3/8" = 1'-0"

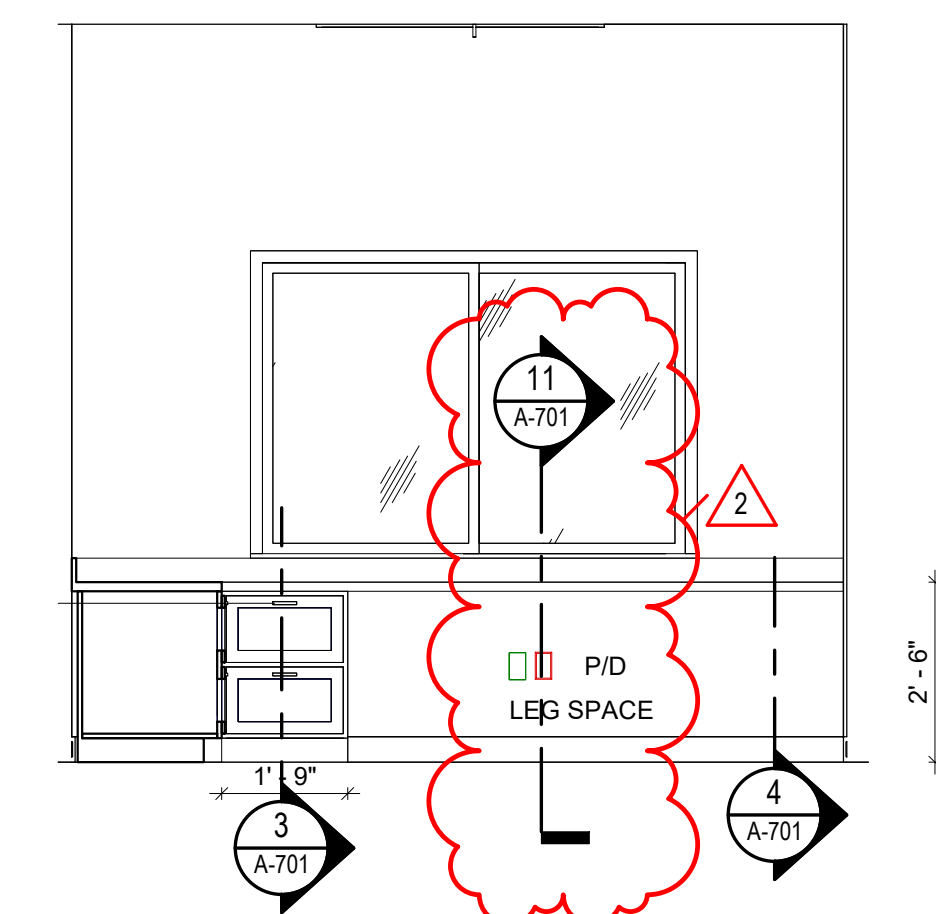


7 RECEPT 343 NORTH
3/8" = 1'-0"

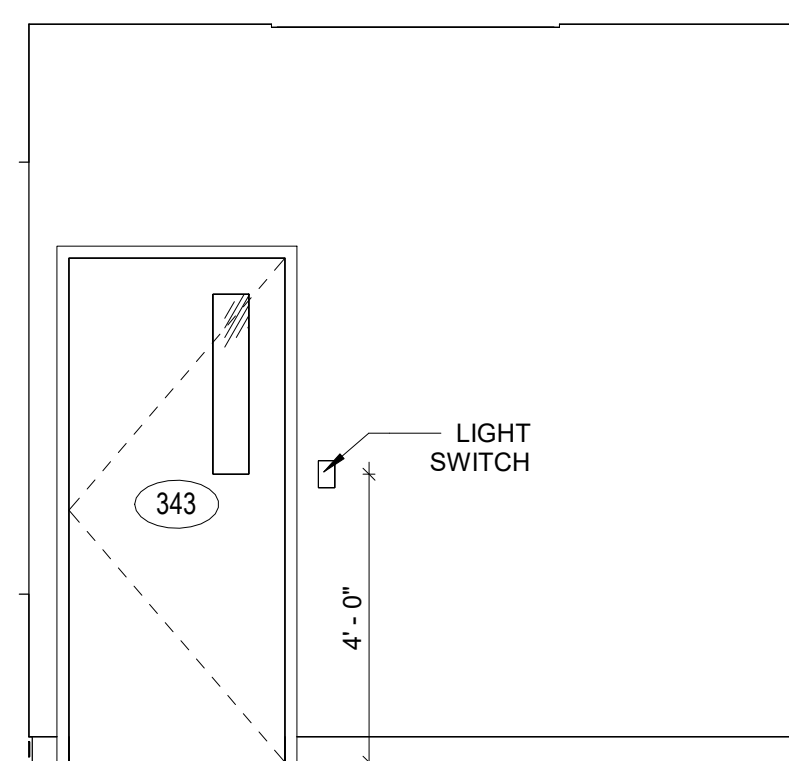


8 RECEPT 343 SOUTH
3/8" = 1'-0"

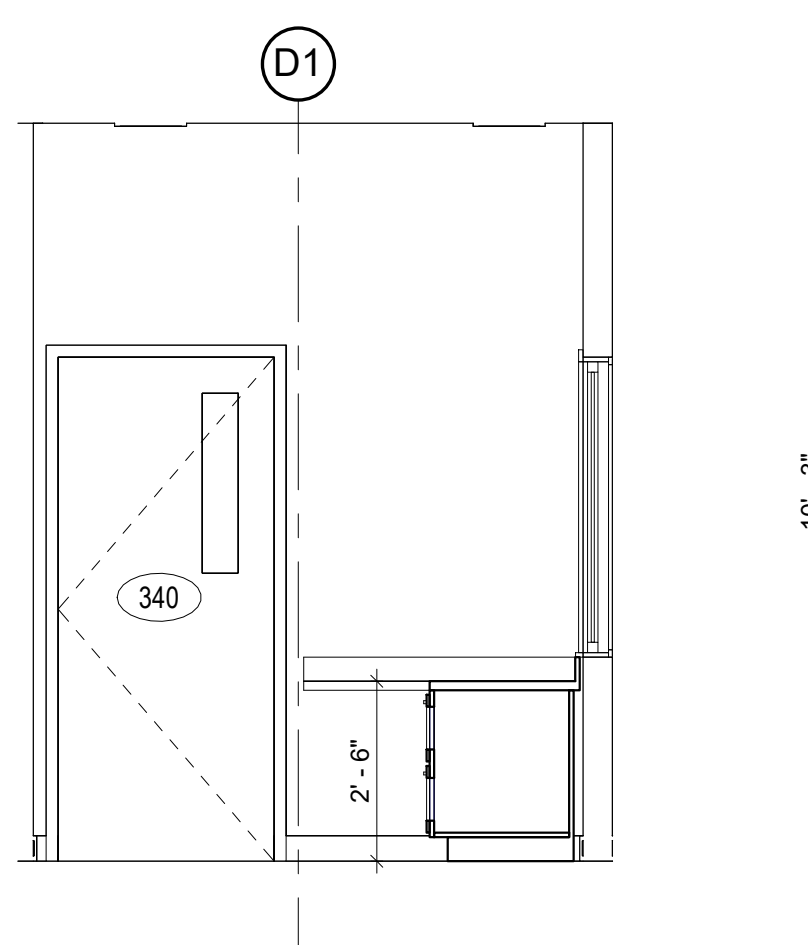


9 RECEPT 343 WEST
3/8" = 1'-0"

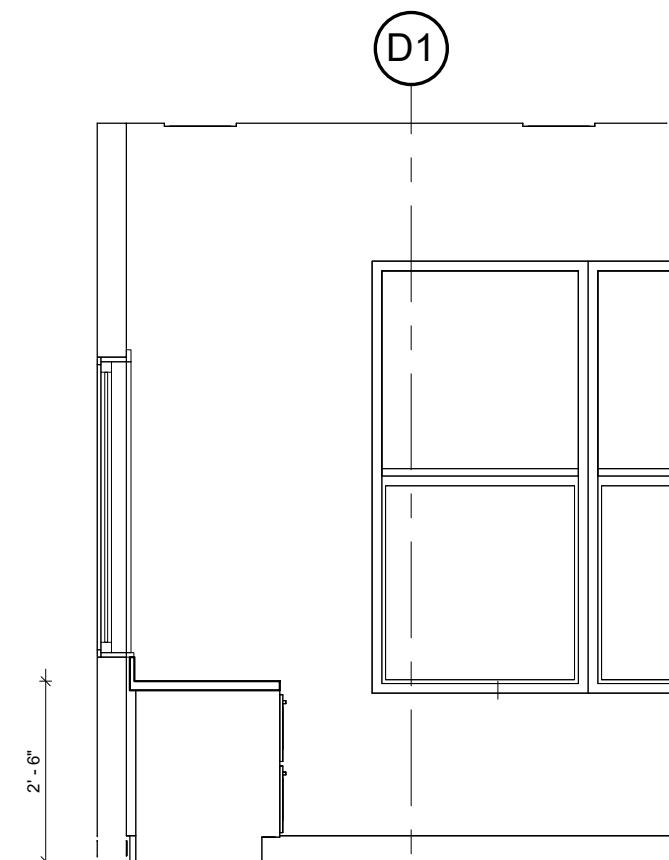


10 RECEPT 343 EAST
3/8" = 1'-0"

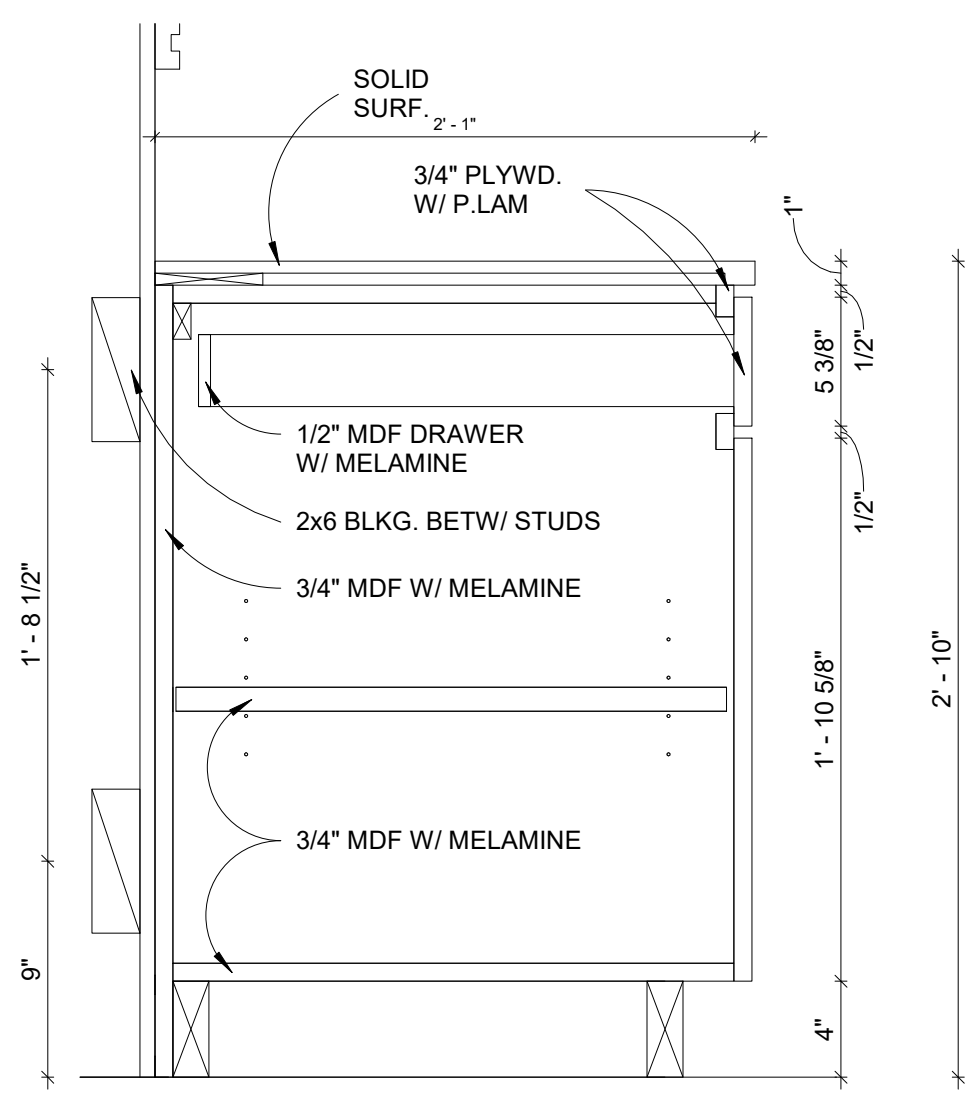


1 34" DRAWER & DOOR BASE
1 1/2" = 1'-0"

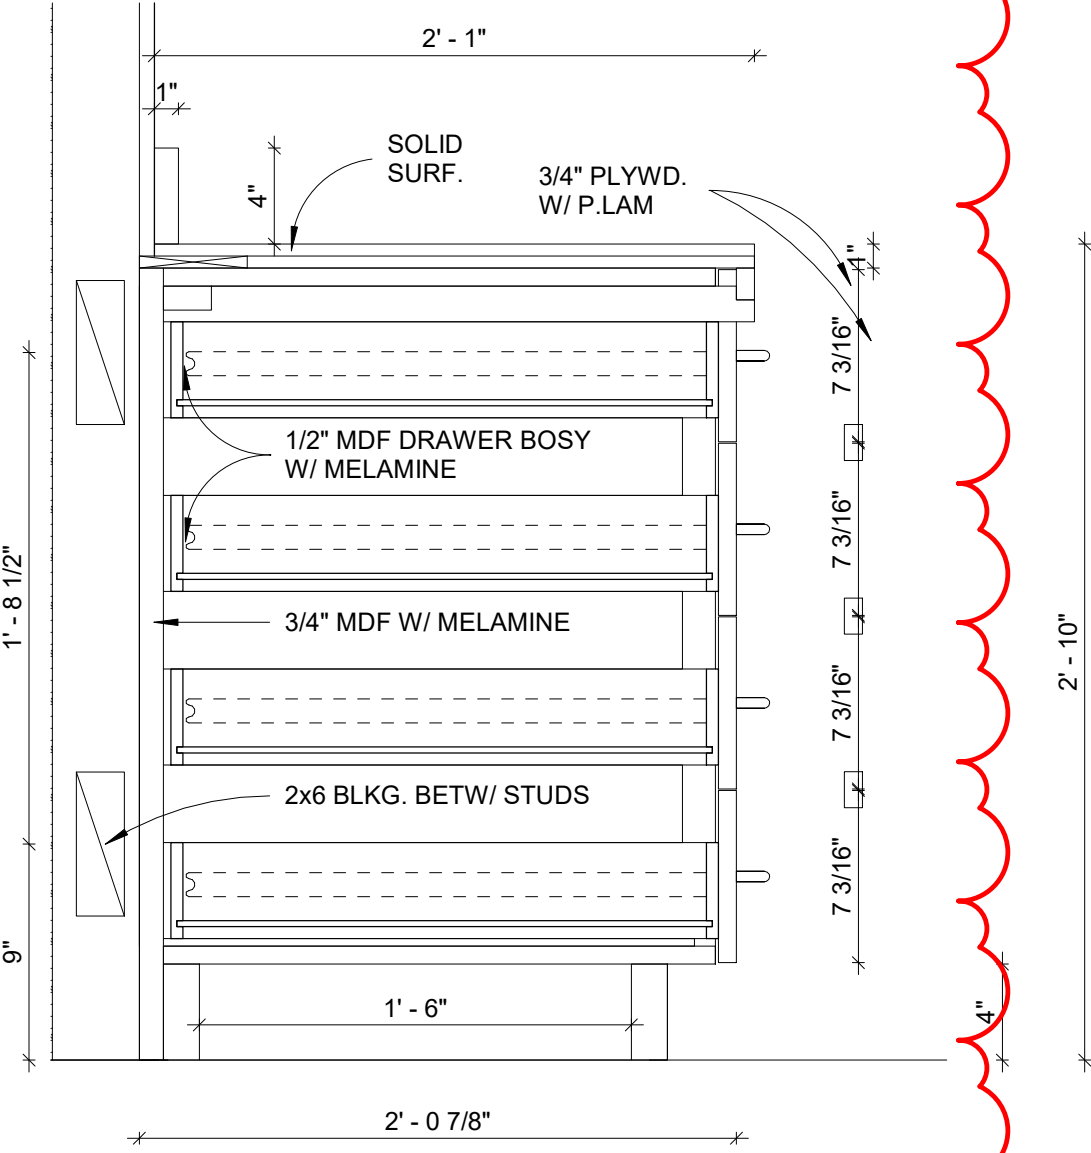


2 34" DRAWER B
1 1/2" = 1'-0"

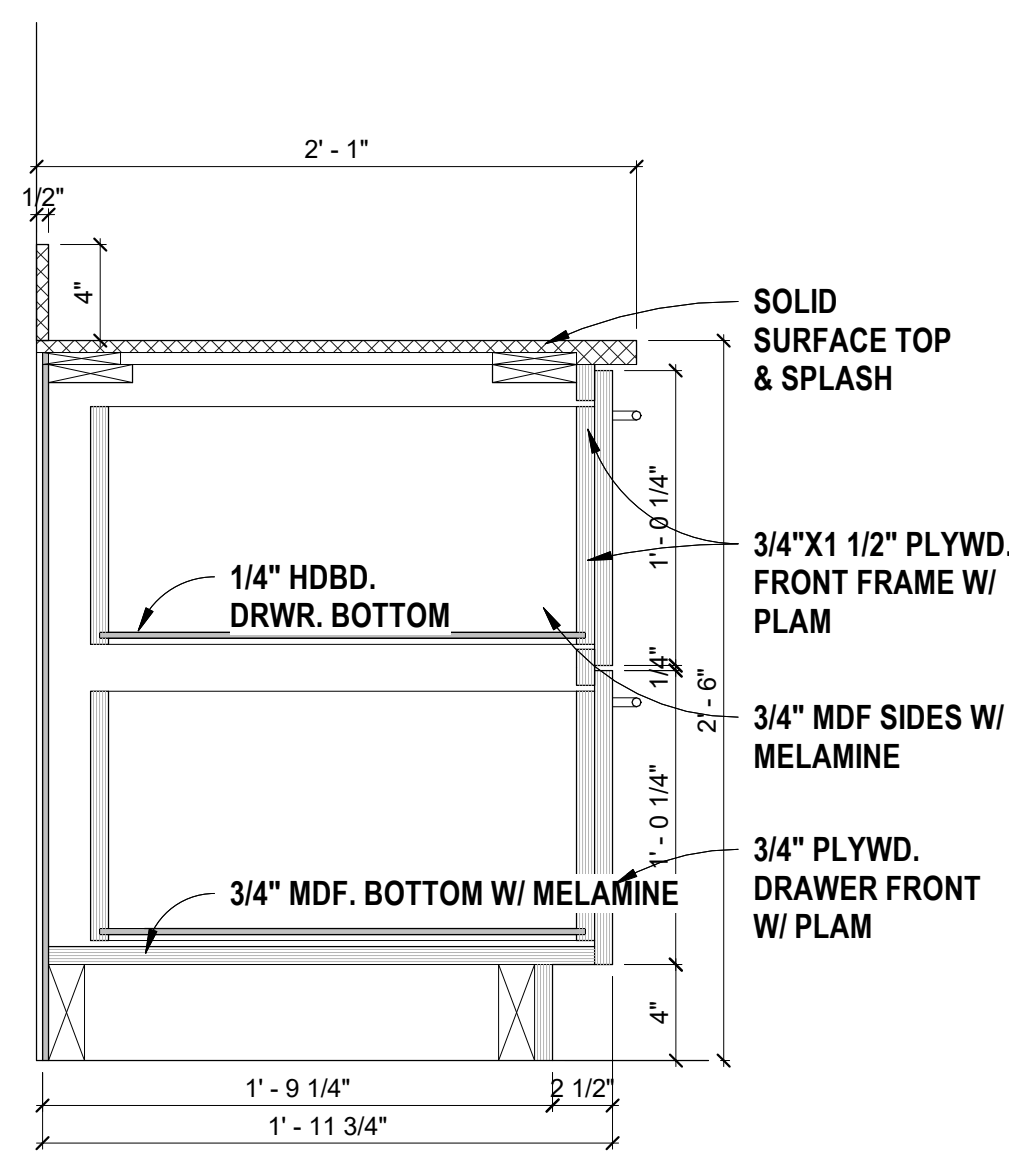


3 30" WOOD 2-DRAWER BASE
1 1/2" = 1'-0"

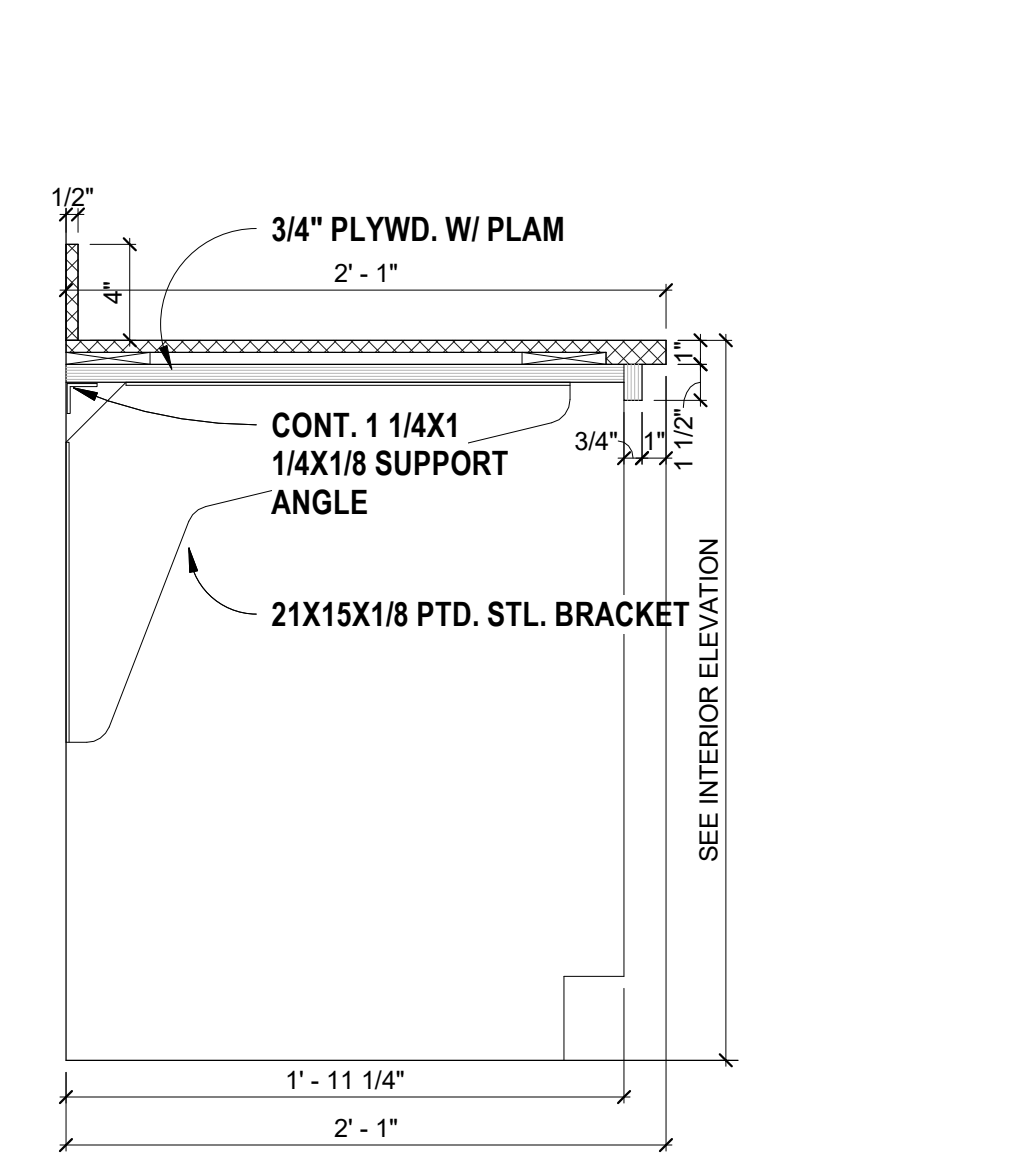


4 30" COUNTER W/ KNEESPACE
1 1/2" = 1'-0"

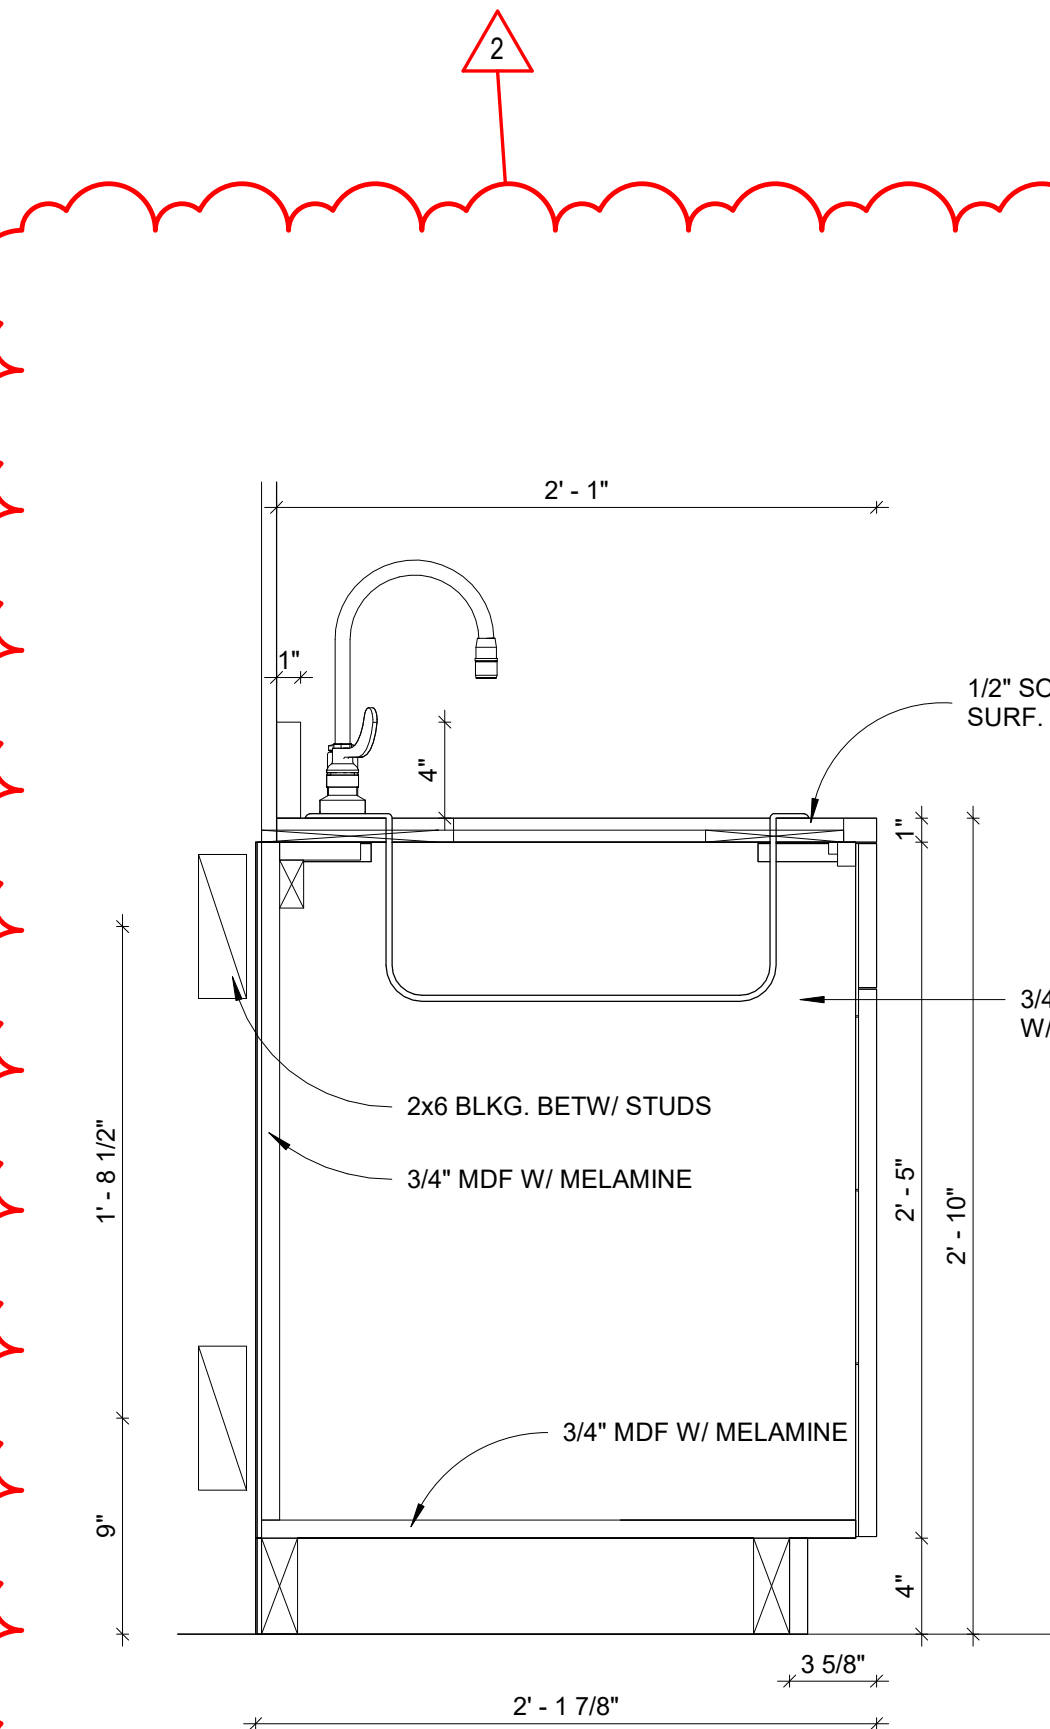


5 34" SINK BASE CAB
1 1/2" = 1'-0"

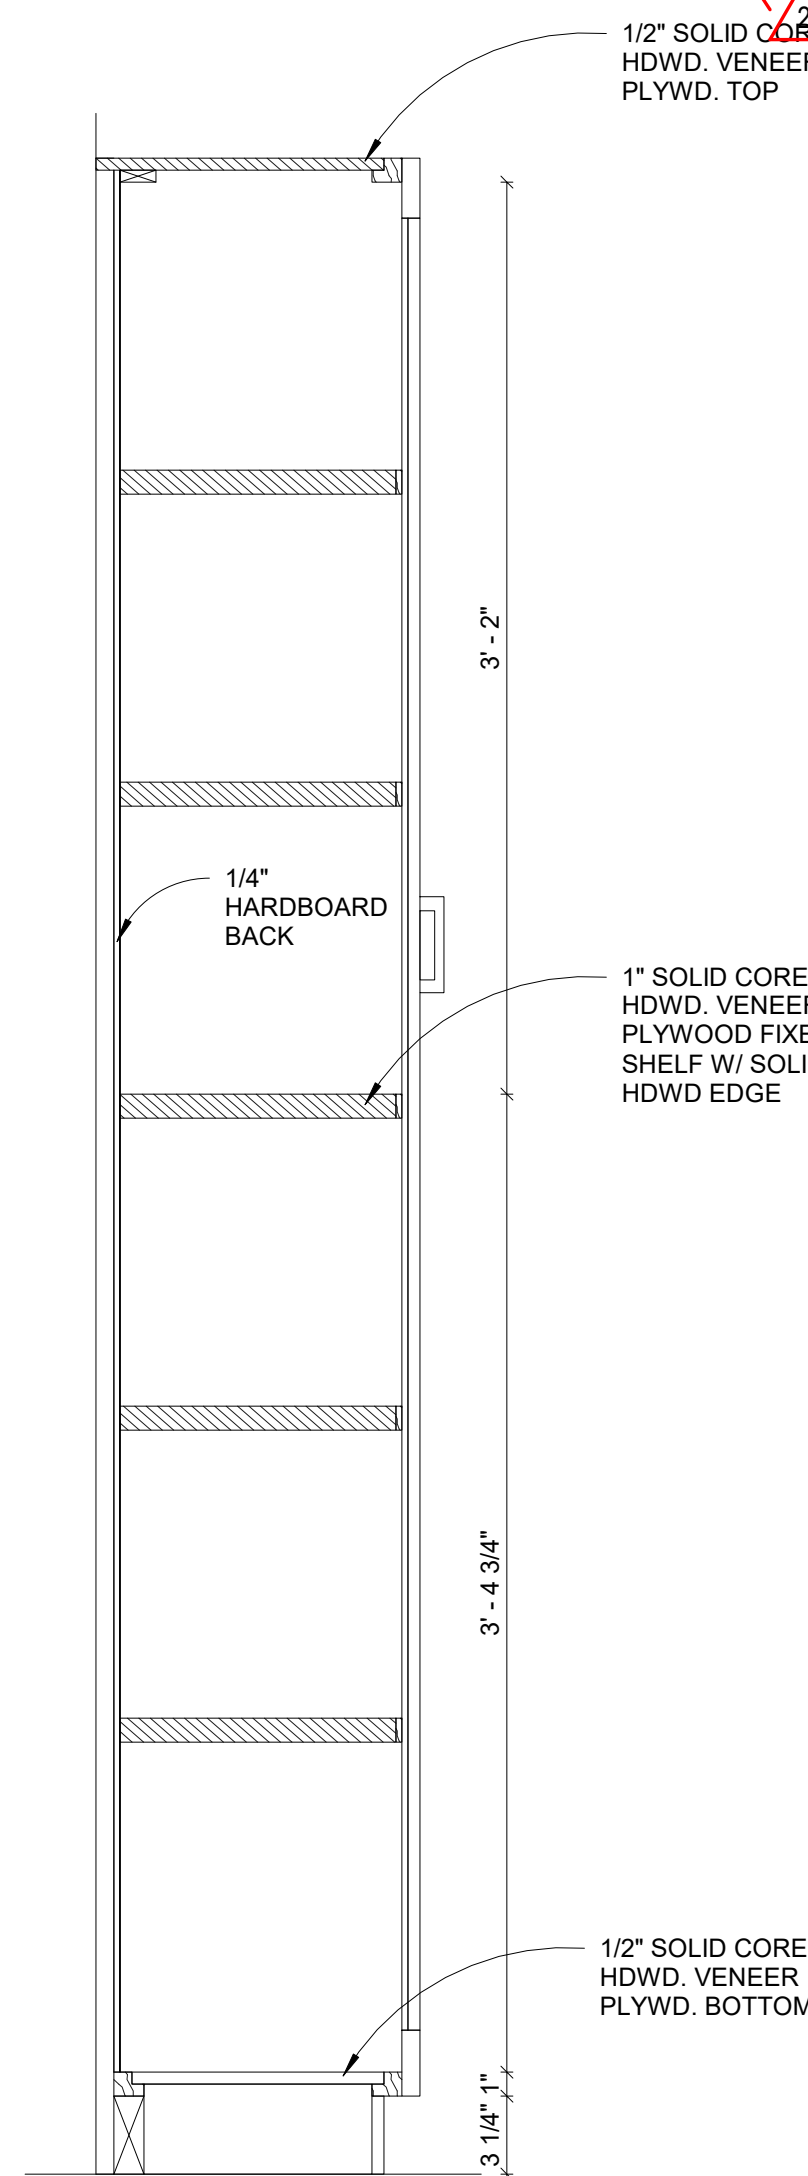


6 84" SHELVING UNIT 12" DEEP
1 1/2" = 1'-0"

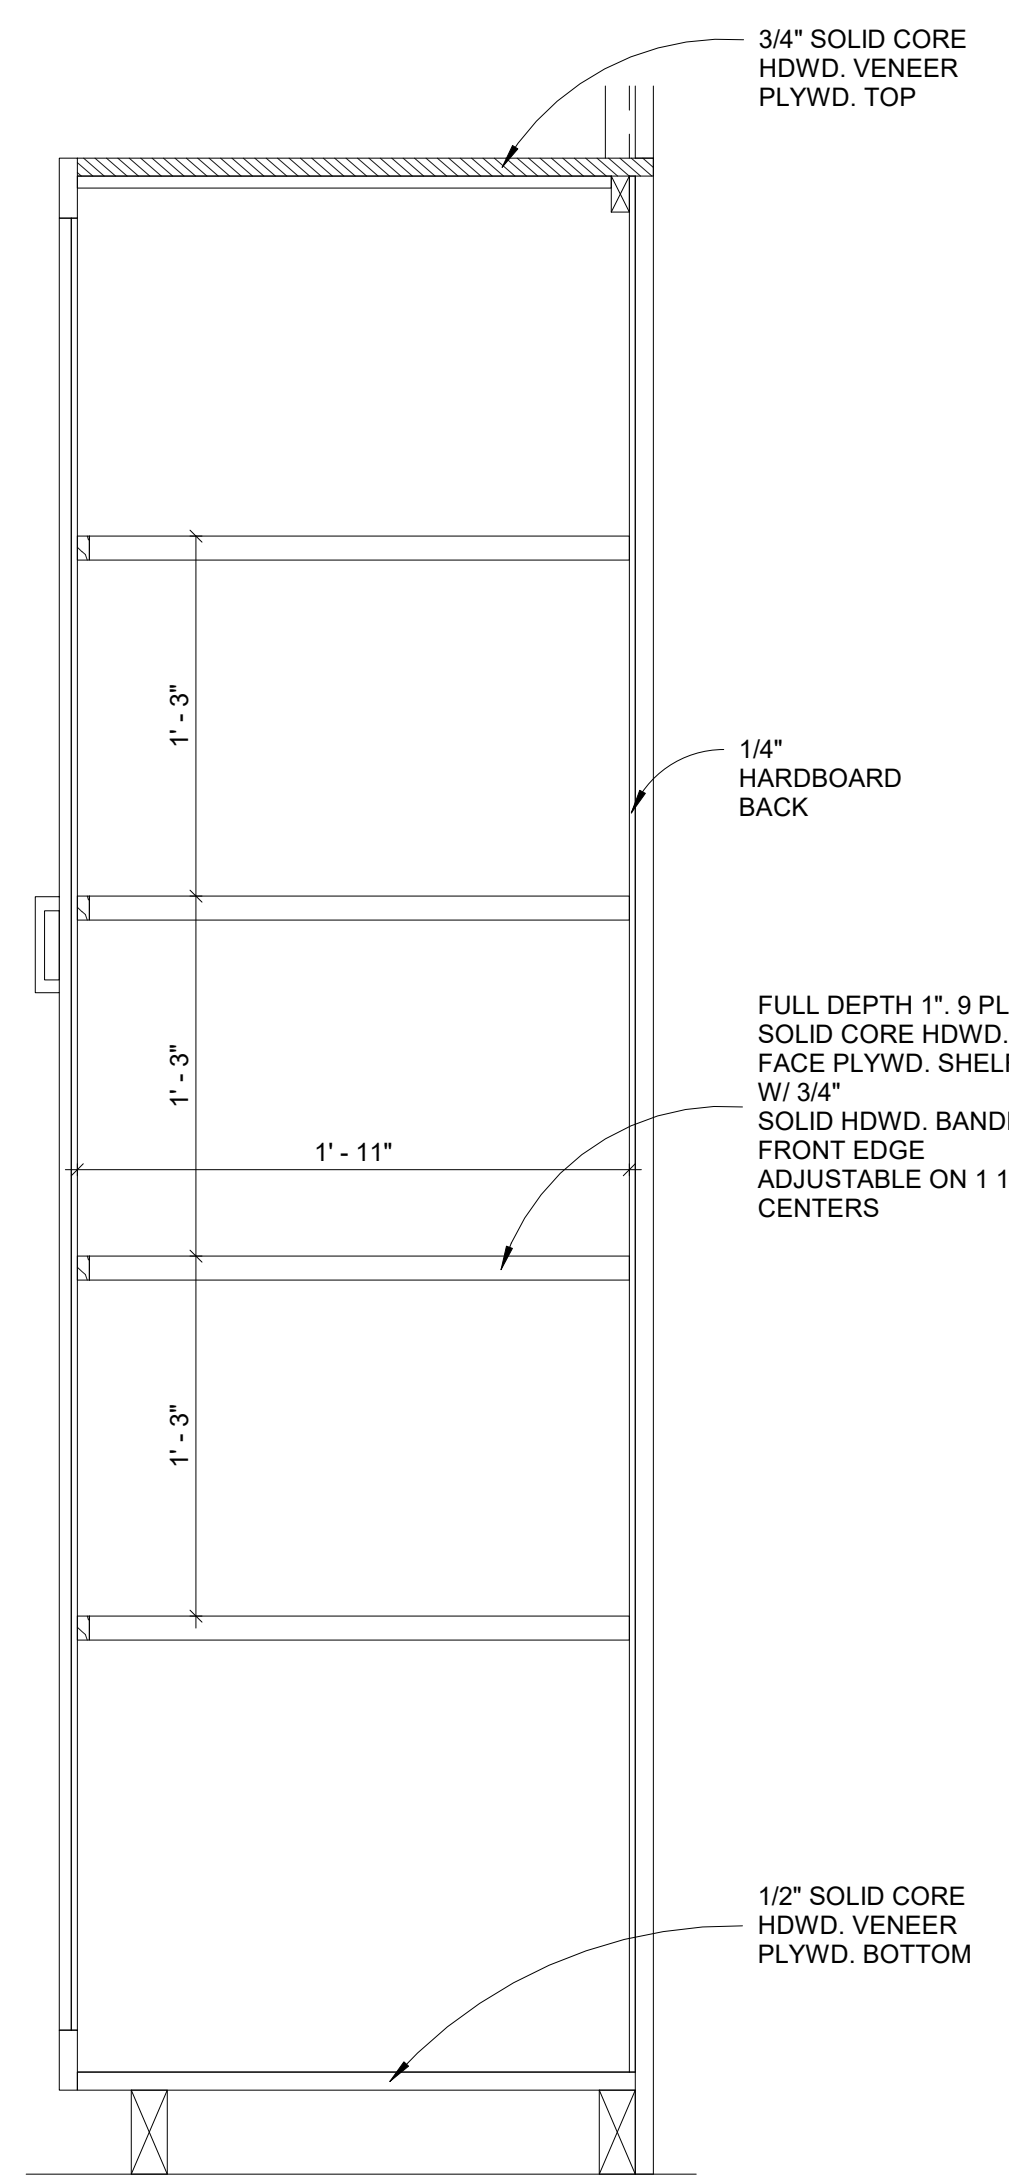


7 84" SHELVING UNIT 24" DEEP
1 1/2" = 1'-0"

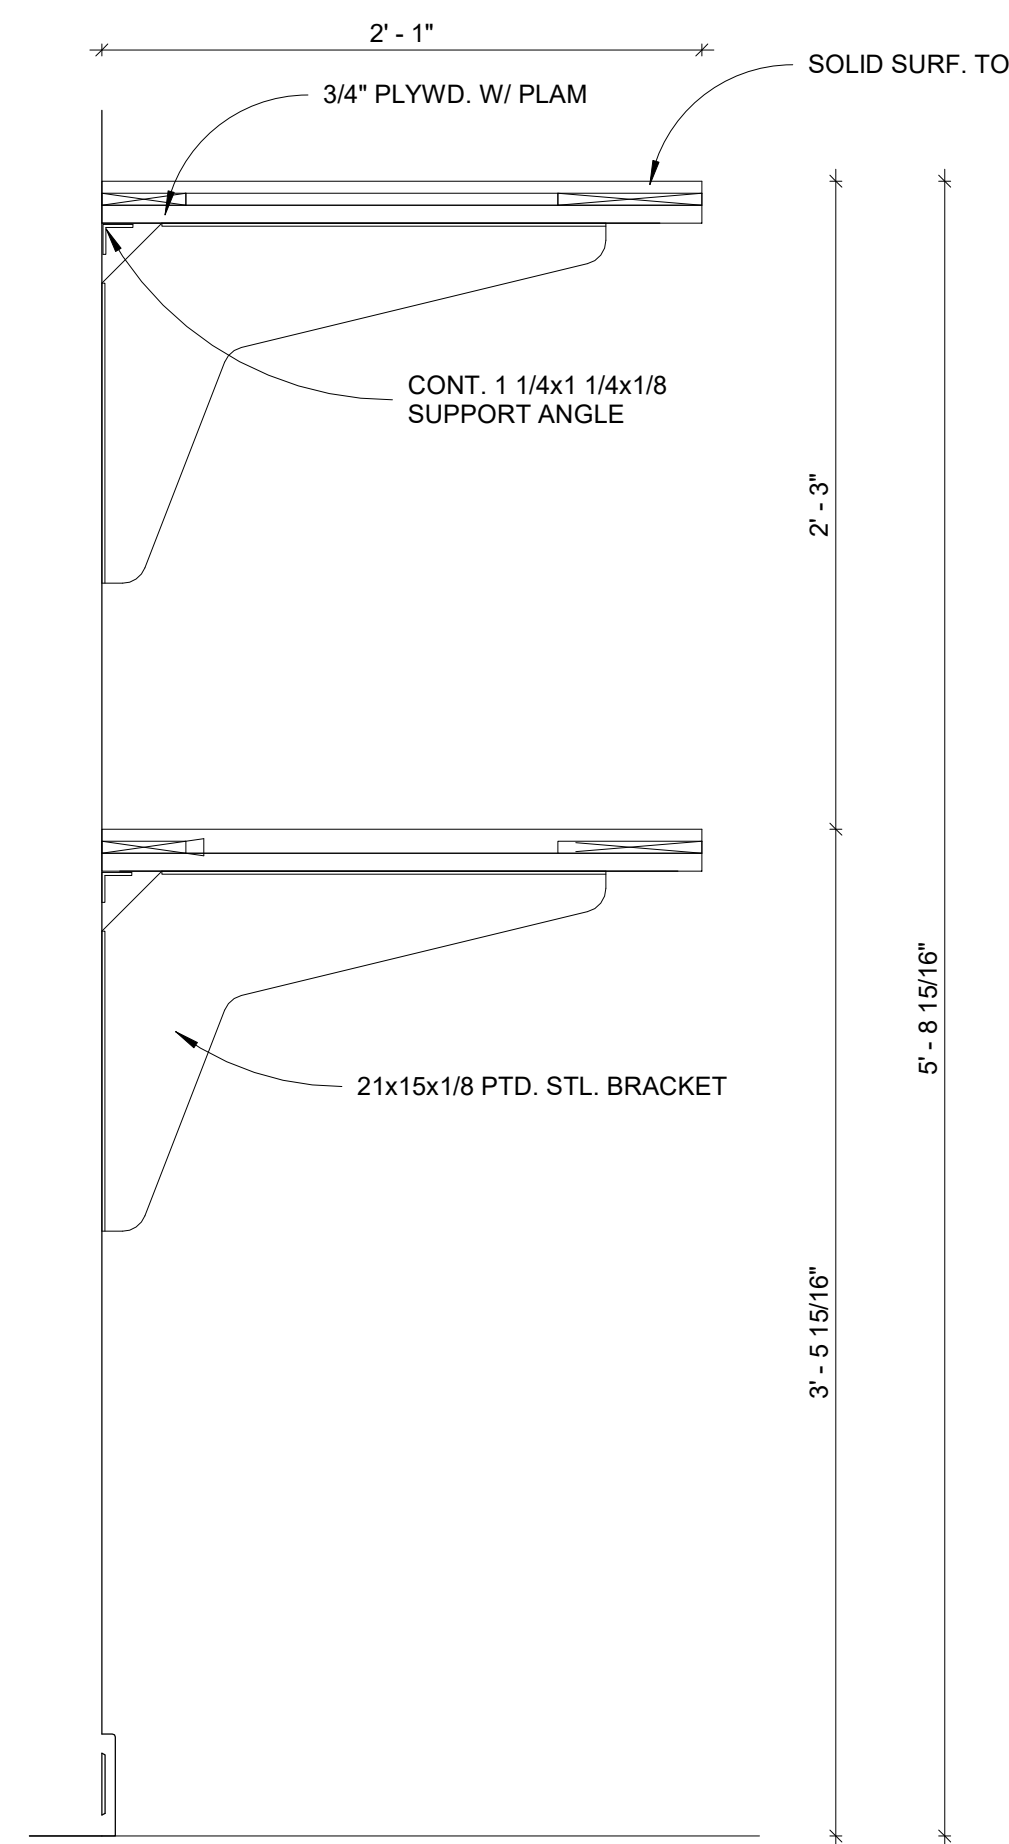


8 69" WALL SHELF
1 1/2" = 1'-0"

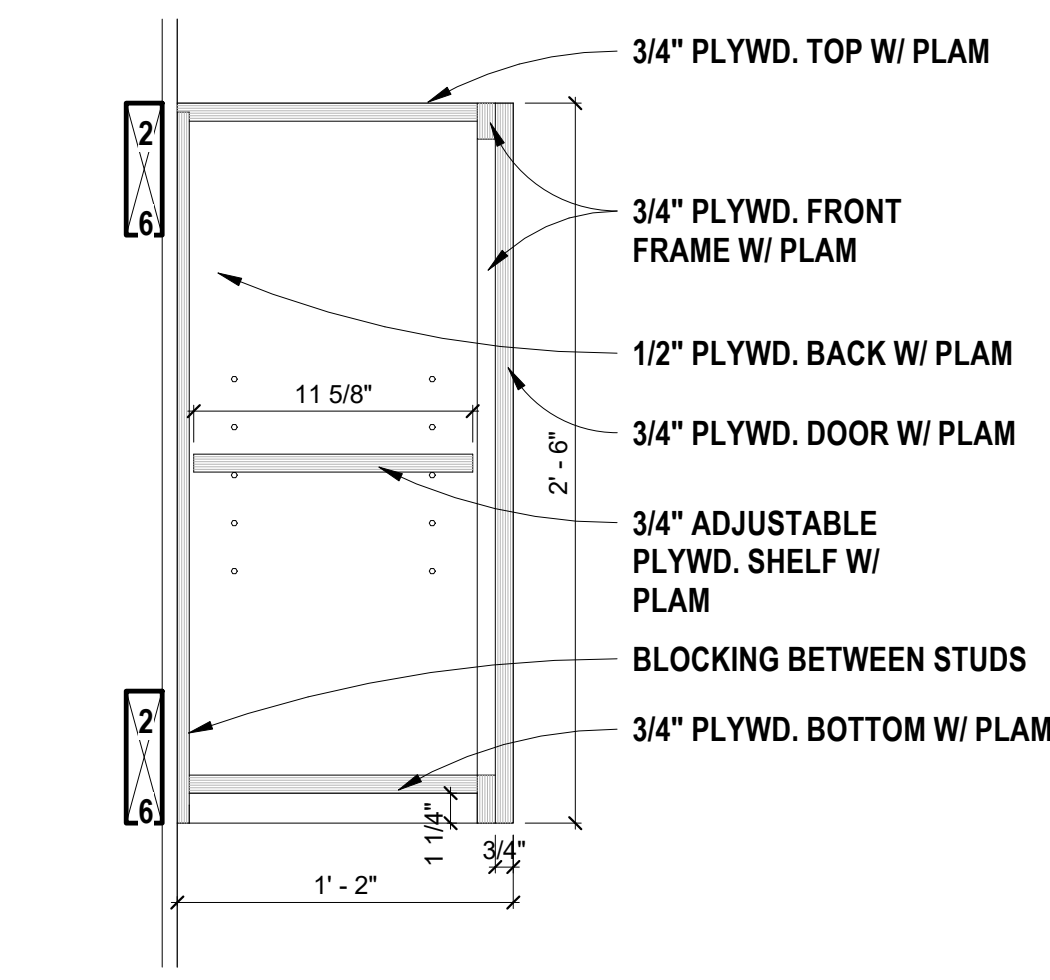


9 30" WOOD WALL CABINET
1 1/2" = 1'-0"

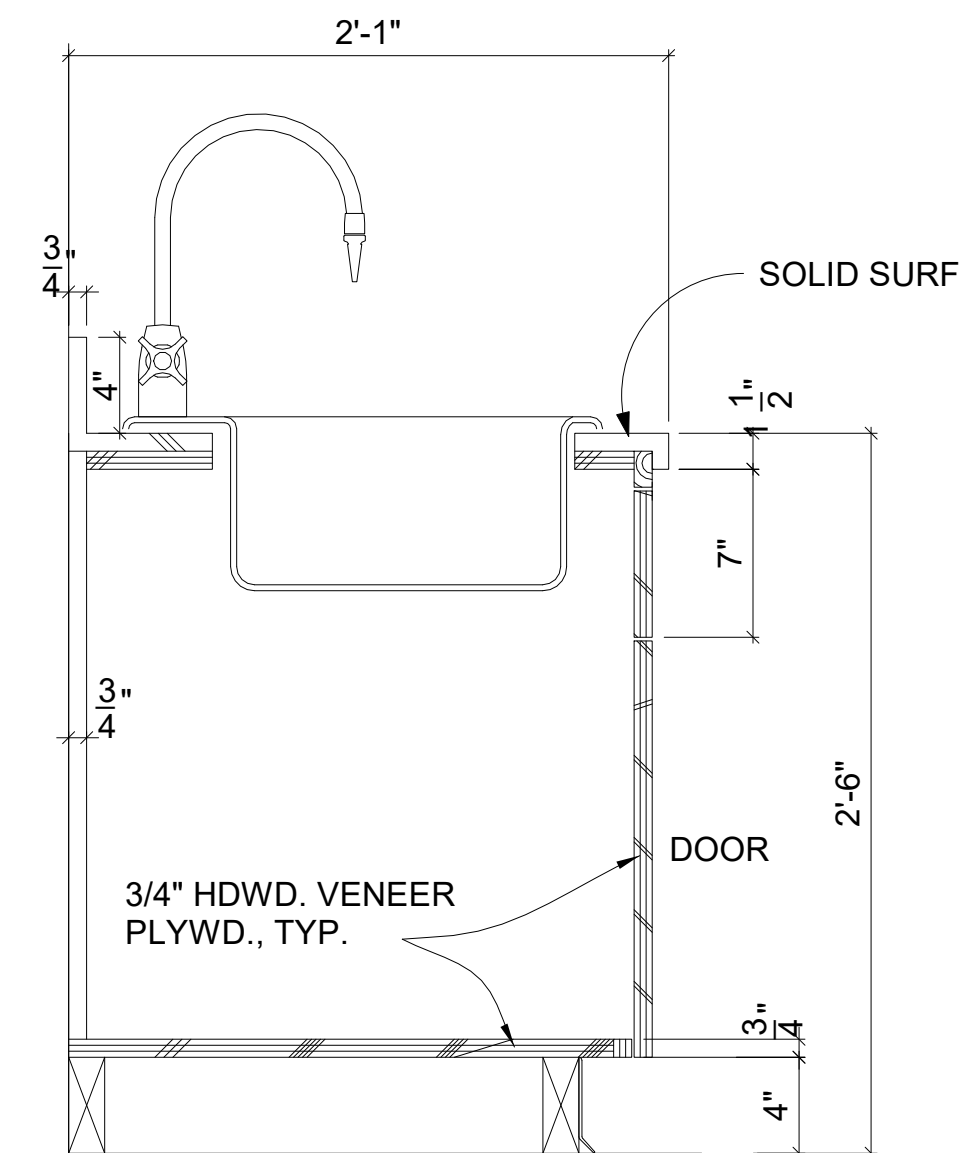


10 30" SINK (EXAM RMS) BASE CAB
1 1/2" = 1'-0"

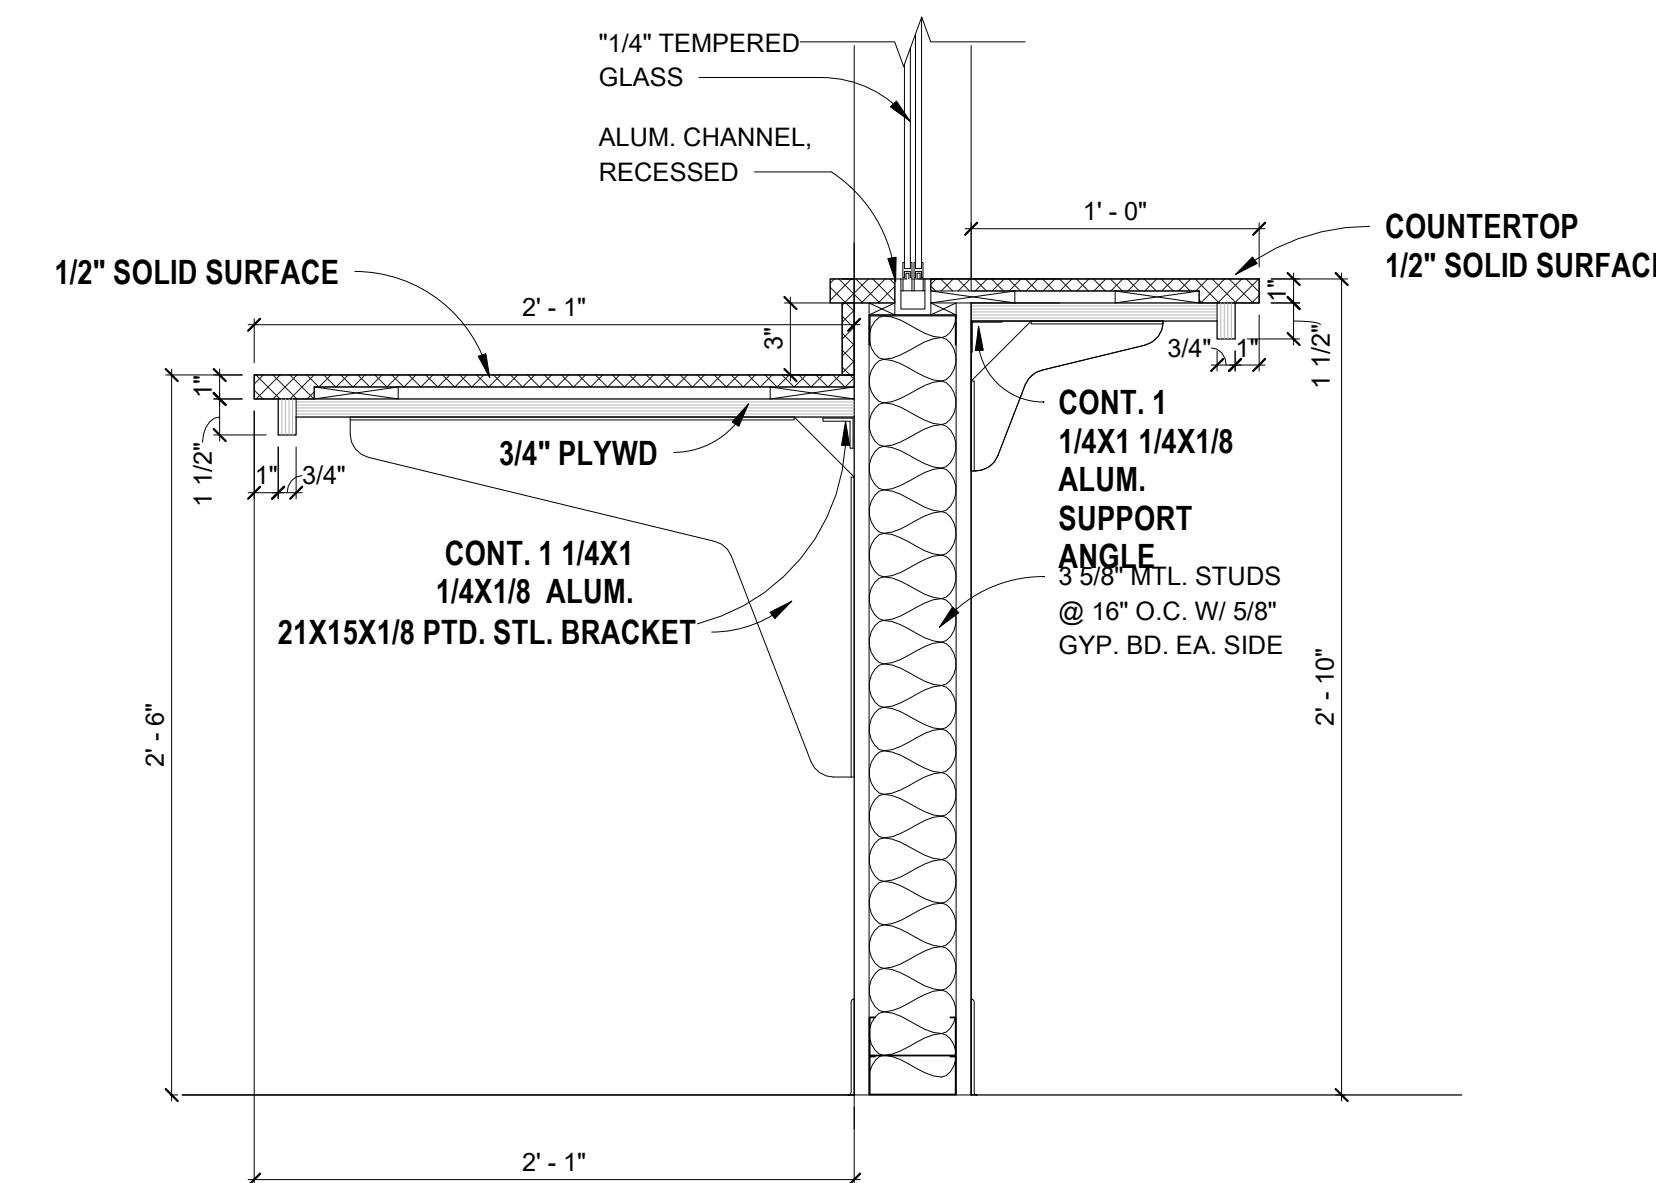


11 34" H RECEPTION COUNTER
1 1/2" = 1'-0"

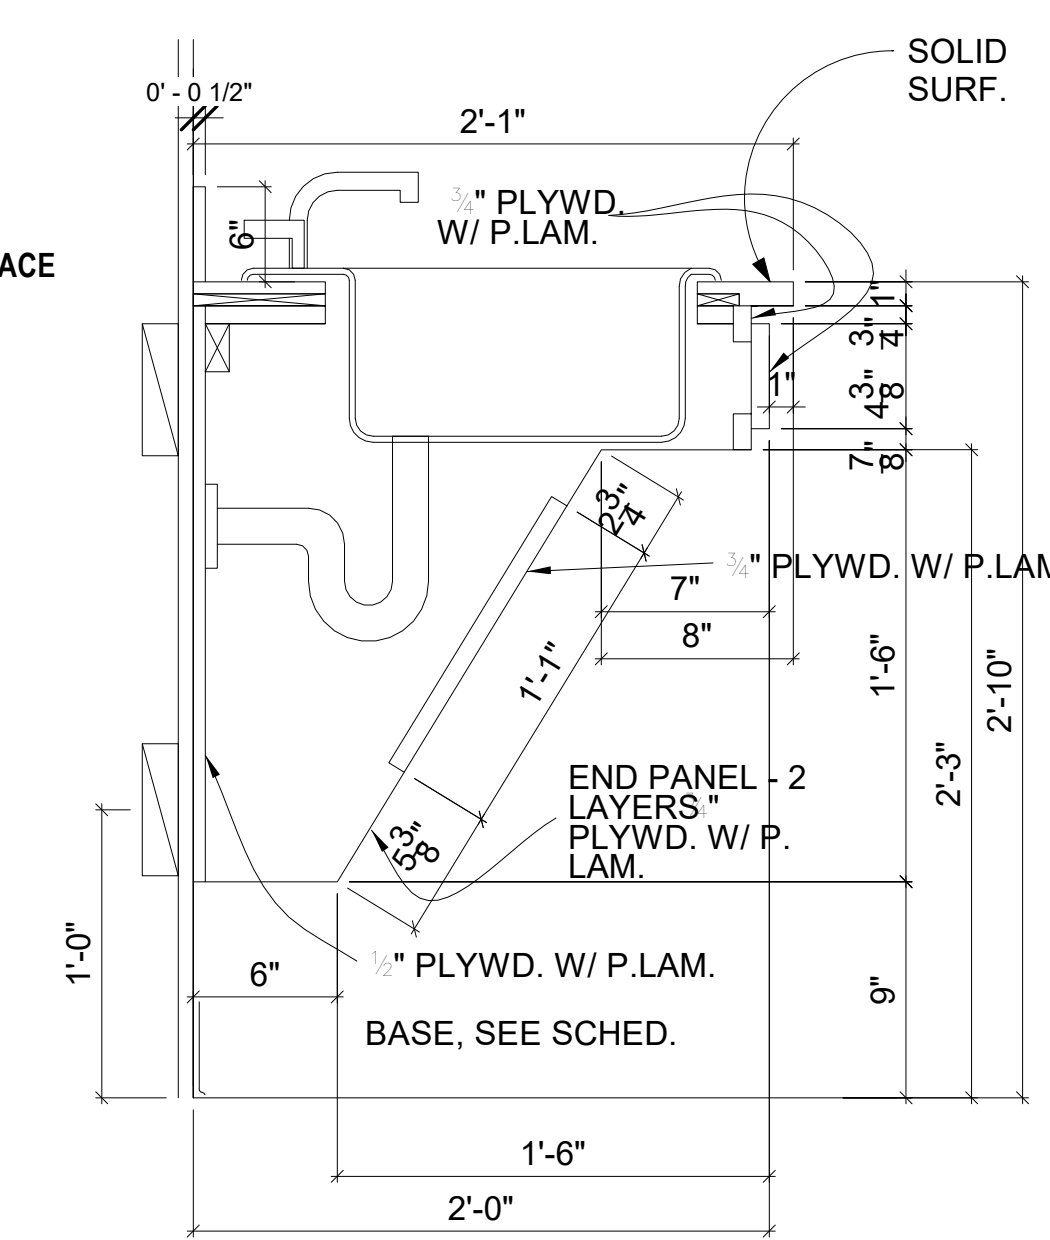

12 34" H ADA SINK BASE
1 1/2" = 1'-0"

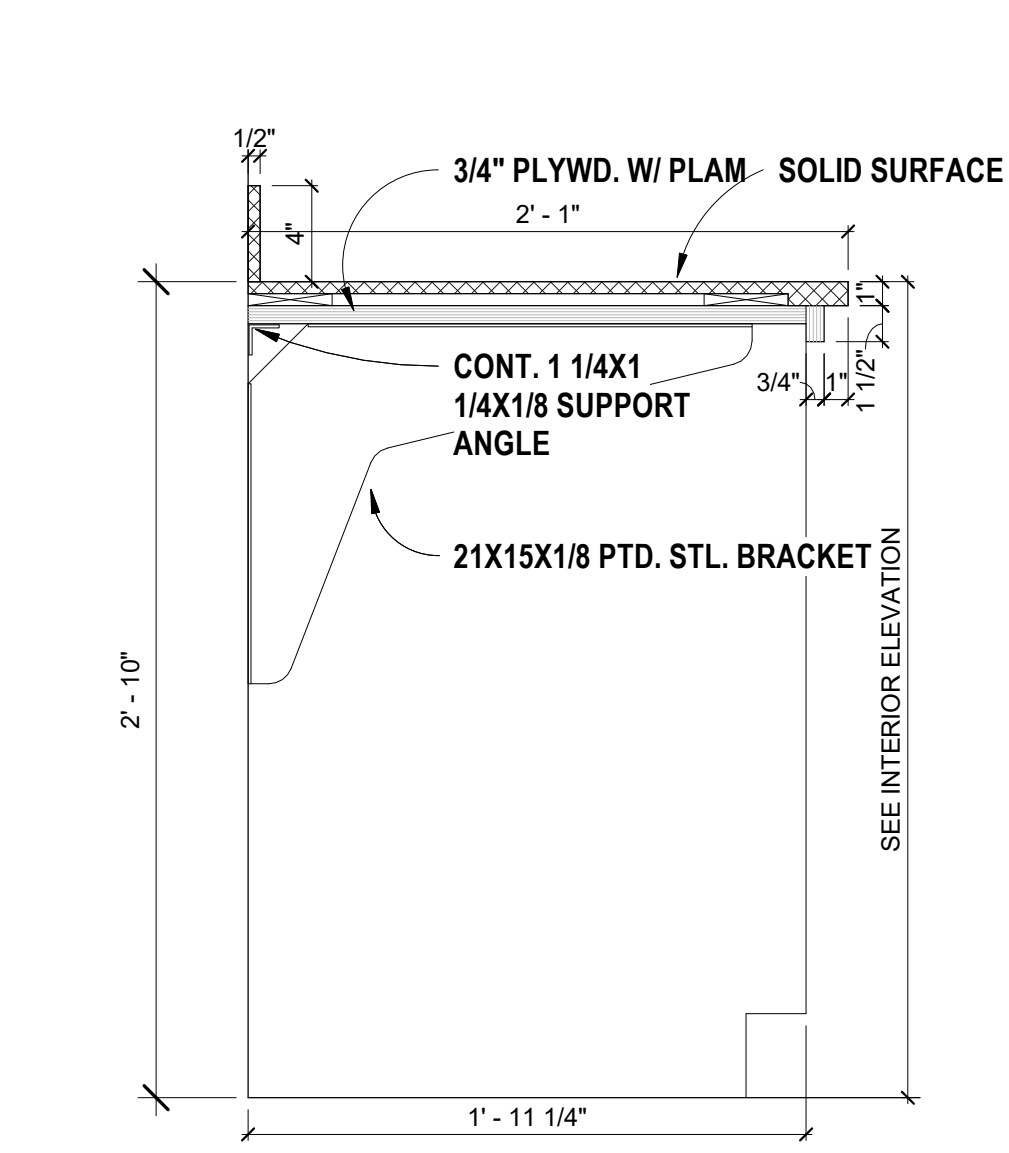

13 34" H ADA COUNTER W/ KNEESPACE
1 1/2" = 1'-0"

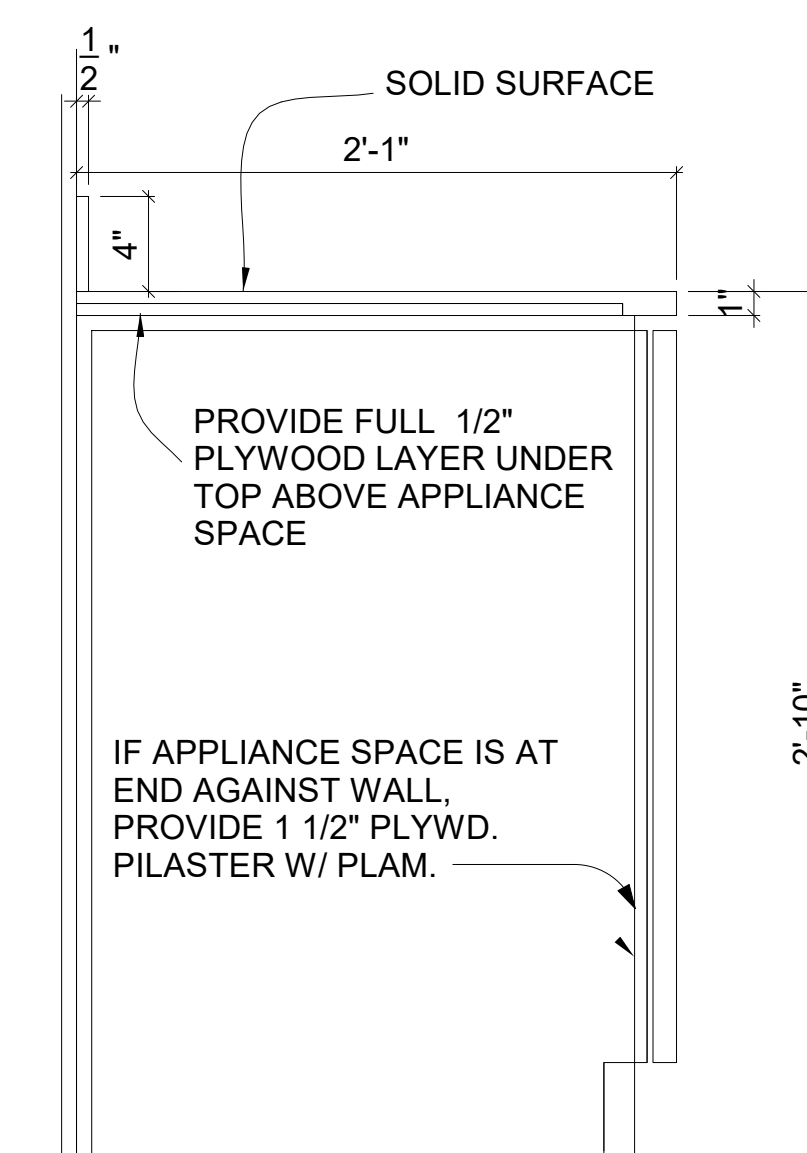

14 34" H APPLIANCE SPACER
1 1/2" = 1'-0"



F. W. WATT
Architect & Planner, PLLC
150 NORTH STATE STREET
SUITE 200
MEMPHIS, TN 38103
TELEPHONE (901) 525-3071
FAX (901) 525-3071
WWW.FWATT.COM

THE W NURSING SCHOOL
AT NESHOBIA GENERAL HOSPITAL

Philadelphia, MS 38350

project no.
1661 - 23
date
04 JUNE 2026
revised
2 6-9-2026

drawn by
DLC

MILLWORK /
CASEWORK
DETAILS

sheet no.
A-701
of

CONSTRUCTION DOCUMENTS