




05 February 2021

Addition and Renovations to Richland Senior Center | City of Richland
WBA Project No. 1219

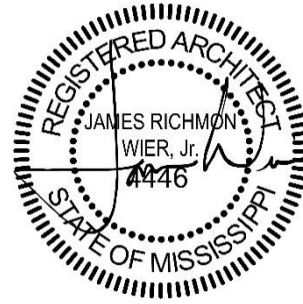

ADDENDUM NO. 01

NOTICE TO ALL DOCUMENT HOLDERS:

The following additions, deletions, changes and clarifications to the drawings and specifications are to be included as part of the Contract Documents.

SPECIFICATIONS

ITEM NO. 01

SECTION 00.2113

REMOVE Site Assessment item **1.B.** -

The bidder is required to contact Owner at the following address and phone number in order to arrange a date and time to visit the project site: 371 Scarborough Street, Richland, MS 39218.

REPLACE with **revised Site Assessment item 1.B.** -

The bidder is required to contact Owner at the following address and phone number in order to arrange a date and time to visit the project site: 371 Scarborough Street, Richland, MS 39218; phone: 601-420-3401.

ITEM NO. 02

SECTION 01.2300

REMOVE item **4.A.1.** -

4. SCHEDULE OF ALTERNATES

A. Alternate No. [] - []:

1. Alternate Item: Section [] and Drawing number [] including [].

REPLACE with **revised item 4.A.1.** -

4. SCHEDULE OF ALTERNATES

A. Alternate No. 1 - Renovate Existing Building and Entrance

1. Alternate Item: Renovate existing building and entrance. Work will include but is not limited to new flooring, new paint, and new ceiling. See sheets D101, A100, A101, A102, A201, A501, and others in contract documents.

ITEM NO. 03

SECTION 06.1500

DELETE this section in its entirety.

DRAWINGS

ITEM NO. 04

SHEET C-1 ADDENDUM

ADD enclosed sheet in its entirety to the drawing set. **CLARIFIES** connection of city service to building.
REMOVES portion of concrete patio along building.


Encl: Drawings (24x36):
C-1 ADDENDUM

cc: All Document Holders
File 1219.C2





A circular professional seal for R. A. Scott, a Registered Professional Engineer in the State of Mississippi. The seal features the text "R. A. SCOTT" at the top, "REGISTERED PROFESSIONAL ENGINEER" in the middle, and "STATE OF MISSISSIPPI" at the bottom. The license number "# 9118" is centered at the bottom.

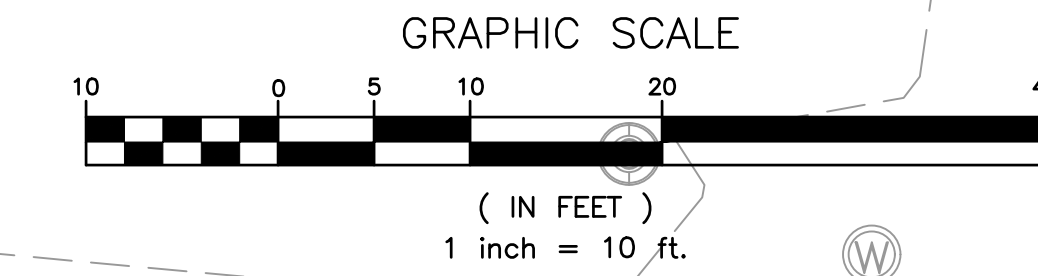

GENERAL CONSTRUCTION NOTES:

1. SCARBOROUGH STREET SHALL BE BORED USING CONTRACTOR'S METHOD OF CHOICE.
2. WATER & SEWER LINE SHALL HAVE MINIMUM 3' OF COVER EVERYWHERE WITH THE EXCEPTION OF THE LOCATION WHERE THE TWO LINES CROSS.
3. WATER SHALL BE LAYED ABOVE SEWER LINE.

PROPOSED BUILDING ADDITION
FINISHED FLOOR ELEVATION: 282.12

- SEE MECHANICAL DRAWINGS
FOR CONTINUATION

PORTION OF SLAB TO BE
EXCLUDED FROM CONSTRUCTION

0 JANUARY 2021

CONSTRUCTION
DOCUMENTS
WBA # 1219

REVISIONS	
NO.	DESCRIPTION
1	ADDENDUM #1

C-1

ADDENDUM