ADDENDUM NO. 3

THIS ADDENDUM FORMS A PART OF THE CONTRACT DOCUMENTS AND HEREBY MODIFIES THE ORIGINAL CONSTRUCTION DOCUMENTS DATED MARCH 18, 2021 RESPECTIVELY.

NAME OF COMPANY	
	ROBLET E.
BY	——————————————————————————————————————
	THE OF MISSISHIN

PROJECT MANUAL

- Item #1 SECTION 263615 MANUAL TRANSFER SWITCH WITH DOCKING STATION
 - <u>ADD:</u> The attached specification Section 263615 in its entirety.
- Item #2 APPENDIX (OWNER PROVIDED DOCUMENTS)

 ADD: Forensic Geotechnical Investigation report dated June 5, 2020 with Supplemental Borings report dated April 29, 2021 in its entirety.

DRAWINGS

- Item #3 CVR COVER SHEET

 REPLACE: Sheet in its entirety with Revision No. 2 dated April 30, 2021.
- Item #4 A100A SITE PLAN ALTERNATES
 ADD: Sheet in its entirety with Revision No. 2 dated April 30, 2021.
- Item #5 A101A FIRST FLOOR PLAN ALTERNATES
 ADD: Sheet in its entirety with Revision No. 2 dated April 30, 2021.
- Item #6 A102A DIMENSION FLOOR PLAN ALTERNATES

 ADD: Sheet in its entirety with Revision No. 2 dated April 30, 2021.
- Item #7 A103A MEZZANINE PLAN ALTERNATES

 ADD: Sheet in its entirety with Revision No. 2 dated April 30, 2021.
- Item #8 A104 ROOF PLAN

 REPLACE: Sheet in its entirety with Revision No. 2 dated April 30, 2021.
- Item #9 A104A ROOF PLAN ALTERNATES

 ADD: Sheet in its entirety with Revision No. 2 dated April 30, 2021.

- Item #10 A105A REFLECTED CEILING PLAN & DETAILS ALTERNATES ADD: Sheet in its entirety with Revision No. 2 dated April 30, 2021.
- Item #11 A201A EXTERIOR ELEVATIONS ALTERNATES

 ADD: Sheet in its entirety with Revision No. 2 dated April 30, 2021.
- Item #12 A611 OPENING SCHEDULE

 REPLACE: Sheet in its entirety with Revision No. 2 dated April 30, 2021.
- Item #13 A611A OPENING SCHEDULE

 ADD: Sheet in its entirety with Revision No. 2 dated April 30, 2021.
- Item #14 F101A INTERIOR FINISH PLAN ALTERNATES

 ADD: Sheet in its entirety with Revision No. 2 dated April 30, 2021.
- Item #15 S101 FOUNDATION AND FLOOR FRAMING PLAN

 REPLACE: Sheet in its entirety with Revision No. 2 dated April 30, 2021.
- Item #16 S102 LEMA ROOF. GARAGE ROOF, AND MEZZANINE FRAMING PLANS

 REPLACE: Sheet in its entirety with Revision No. 2 dated April 30, 2021.
- Item #17 S103 ROOF FRAMING PLAN
 REPLACE: Sheet in its entirety with Revision No. 2 dated April 30, 2021.
- Item #18 S104 SITE WALL PLAN

 REPLACE: Sheet in its entirety with Revision No. 2 dated April 30, 2021.
- Item #19 P101 FLOOR PLAN BELOW FLOOR PLUMBING
 REPLACE: Sheet in its entirety with Revision No. 2 dated April 30, 2021.
- Item #20 P102 FLOOR PLAN PLUMBING SANITARY
 REPLACE: Sheet in its entirety with Revision No. 2 dated April 30, 2021.
- Item #21 P103 FLOOR PLAN PLUMBING SUPPLY

 REPLACE: Sheet in its entirety with Revision No. 2 dated April 30, 2021.
- Item #22 P104A FLOOR PLAN BELOW FLOOR PLUMBING ALTERNATES ADD: Sheet in its entirety with Revision No. 2 dated April 30, 2021.
- Item #23 P105A FLOOR PLAN PLUMBING SANITARY ALTERNATES

 ADD: Sheet in its entirety with Revision No. 2 dated April 30, 2021.
- Item #24 P106A FLOOR PLAN PLUMBING SUPPLY ALTERNATES

 ADD: Sheet in its entirety with Revision No. 2 dated April 30, 2021.
- Item #25 FP101 FLOOR PLAN FIRE PROTECTION

 REPLACE: Sheet in its entirety with Revision No. 2 dated April 30, 2021.

- Item #26 FP102A FLOOR PLAN FIRE PROTECTION ALTERNATES

 ADD: Sheet in its entirety with Revision No. 2 dated April 30, 2021.
- Item #27 M001 HVAC LEGENDS, ABBREVIATIONS AND NOTES
 REPLACE: Sheet in its entirety with Revision No. 2 dated April 30, 2021.
- Item #28 M101 FIRST FLOOR HVAC PLAN PART "A"

 REPLACE: Sheet in its entirety with Revision No. 2 dated April 30, 2021.
- Item #29 M105 MEZZANINE HVAC FLOOR PLAN

 REPLACE: Sheet in its entirety with Revision No. 2 dated April 30, 2021.
- Item #30 M107 FIRST FLOOR HVAC THERMOSTAT PLAN PART "A" REPLACE: Sheet in its entirety with Revision No. 2 dated April 30, 2021.
- Item #31 M111A FIRST FLOOR HVAC PLAN PART "A" ALT 4
 ADD: Sheet in its entirety with Revision No. 2 dated April 30, 2021.
- Item #32 M112A FIRST FLOOR HVAC PLAN PART "C" ALT 4
 ADD: Sheet in its entirety with Revision No. 2 dated April 30, 2021.
- Item #33 M113A FIRST FLOOR THERMOSTAT PLAN PART "A" ALT 4

 <u>ADD:</u> Sheet in its entirety with Revision No. 2 dated April 30, 2021.
- Item #34 M114A FIRST FLOOR THERMOSTAT PLAN PART "C" ALT 4

 ADD: Sheet in its entirety with Revision No. 2 dated April 30, 2021.
- Item #35 M115A MEZZANINE HVAC FLOOR PLAN ALT 4

 ADD: Sheet in its entirety with Revision No. 2 dated April 30, 2021.
- Item #36 M116A ROOF PLAN HVAC ALT 4

 ADD: Sheet in its entirety with Revision No. 2 dated April 30, 2021.
- Item #37 M601 HVAC SCHEDULES

 REPLACE: Sheet in its entirety with Revision No. 2 dated April 30, 2021.
- Item #38 M602 HVAC SCHEDULES

 REPLACE: Sheet in its entirety with Revision No. 2 dated April 30, 2021.
- Item #39 E101A ELECTRICAL SITE PLAN LIGHTING, POWER AND COMMUNICATION SYSTEMS

 ADD: Sheet in its entirety with Revision No. 2 dated April 30, 2021.
- Item #40 E206A ELECTRICAL FLOOR PLANS ALTERNATE BID MEZZANINE LEVEL

 ADD: Sheet in its entirety with Revision No. 2 dated April 30, 2021.

- Item #41 E207A ELECTRICAL FLOOR PLAN ALTERNATE BID ADDITIONAL WORK LIGHTING SYSTEMS
 - ADD: Sheet in its entirety with Revision No. 2 dated April 30, 2021.
- Item #42 E208A ELECTRICAL FLOOR PLAN ALTERNATE BID ADDITIONAL WORK POWER SYSTEMS
 - ADD: Sheet in its entirety with Revision No. 2 dated April 30, 2021.
- Item #43 E209A ELECTRICAL FLOOR PLAN ALTERNATE BID ADDITIONAL WORK TELECOMM. & SPECIAL SYSTEMS
 - ADD: Sheet in its entirety with Revision No. 2 dated April 30, 2021.
- Item #44 E303A ELECTRICAL SCHEDULES

 ADD: Sheet in its entirety with Revision No. 2 dated April 30, 2021.

END OF ADDENDUM NO. 3

SECTION 263615 MANUAL TRANSFER SWITCH WITH DOCKING STATION

PART 1 - GENERAL

1.1 SUMMARY

A. Section Includes:

1. 3-Way Manual Transfer Switches with integral portable generator and load bank docking stations.

B. Related Sections:

- 1. Section 263213 "Diesel Emergency/Standby Engine Generators"
- 2. Section 263215 "Gaseous Emergency/Standby Engine Generators"

1.2 REFERENCE STANDARDS

- A. ICS 1 Industrial Control and Systems: General Requirements.
- B. ICS 6 Industrial Control and Systems: Enclosures.
- C. ICS 10 Industrial Control and Systems Part 1: Transfer Switch Equipment.
- D. IEEE C62.62 Standard Test Specifications for Surge-Protection Devices for Use on the Load Side of the Service Equipment in Low Voltage (1000 V and less) AC Power Circuits.
- E. NECA 1 Standard for Good Workmanship in Electrical Construction.
- F. NFPA 70 National Electrical Code (NEC).
- G. NFPA 99 Health Care Facilities.
- H. NFPA 110 Standard for Emergency and Standby Power Systems.
- I. UL 489 Molded-Case Circuit Breakers, Molded-Case Switches and Circuit Breaker Enclosures.
- J. UL 508 Standard for Industrial Control Equipment.

- K. UL 869A Standard for Reference Standard for Service Equipment.
- L. UL 1008 Transfer Switch Equipment.

1.3 DEFINITIONS

- A. ATS: Automatic Transfer Switch.
- B. EPS: Emergency Power Supply.
- C EPSS: Emergency Power Supply System.
- D. MTS: Manual Transfer Switch.

1.4 SUBMITTALS

- A. Product Data: For each type of product.
 - 1. Include construction details, material descriptions, dimensions of individual components and profiles, and finishes for transfer switches.
 - 2. Include rated capacities, operating characteristics, electrical characteristics, and accessories.

B. Shop Drawings:

- 1. Include plans, elevations, sections, details showing minimum clearances, conductor entry provisions, gutter space and installed features and devices.
- 2. Include material list for each switch specified.
- 3. Single-Line Diagram: Show internal and external connections of transfer switch, power sources, and load; and interlocking provisions when applicable.

1.5 CLOSEOUT SUBMITTALS

A. Operation and Maintenance Data: For each type of product include emergency, operation, and maintenance manuals.

1.6 WARRANTY

A. Manufacturer's Warranty: The manufacturer shall provide a standard one-year written warranty against defects in materials and workmanship for all products specified in this section. The warranty period shall begin on the Date of Final Acceptance

PART 2 - PRODUCTS

2.1 PERFORMANCE REQUIREMENTS

- A. Electrical Components, Devices and Accessories: Listed and labeled as defined in NFPA 70 (NEC), by a qualified testing agency, and marked for intended location and application.
- B. Comply with NEMA ICS 1.
- C. Comply with NFPA 110 and NFPA 99 when applicable.
- D. Comply with UL 1008 unless requirements herein specified are stricter.
- E. Indicated Current Ratings: Apply as defined in UL 1008 for continuous loading and total system transfer.
- F. Tested Fault Current Closing and Short-Circuit Ratings: Adequate for duty imposed by protective devices at installation locations in Project under the fault conditions indicated, based on testing according to UL 1008.
 - 1. The MTS shall have a fault current withstand rating as indicated on the drawings or if rating not indicated, the same rating as the KAIC rating of the normal service source panelboard in which connected.
- G. Resistance to Damage by Voltage Transients: Components shall meet or exceed voltage-surge withstand capability requirements when tested according to IEEE C62.62. Components shall meet or exceed voltage-impulse withstand test of NEMA ICS 1.
- H. Factory Wiring: Train and bundle factory wiring and label, consistent with Shop Drawings, by color-code or by numbered or lettered wire and cable with printed tape markers at terminations.
 - 1. Designated Terminals: Pressure type, suitable for types and sizes of field wiring indicated.
 - 2. Power-Terminal Arrangement and Field-Wiring Space: Suitable for top, side or bottom entrance of feeder conductors as indicated.
 - 3. Control Wiring: Equipped with lugs suitable for connection to terminal strips.
 - 4. Accessible via front access.

I. Enclosures: General-purpose NEMA 250, Type 1 or Type 3R as indicated or required for installed environment, complying with NEMA ICS 6 and UL 508.

2.2 MANUFACTURERS

- A. Basis of Design: ESL Power Systems TripleSwitch Series.
- B. Equal product by Asco, Russelectric, or equal approved by the Professional.

2.3 MANUAL TRANSFER SWITCH

- A. Electrical Configuration: Shall be 3-way consisting of two mechanically-interlocked molded-case circuit breakers for connection and control of permanent and portable engine generators and one independent molded-case circuit breaker with shunt-trip for connection of load bank equipment. Equipment using key-locks for interlocks are not acceptable.
 - 1. Input Connections for Portable Generator: Male cam-style connectors with ampere rating equal to switch rating.
 - 2. Output Connections for Load Bank: Female cam-style connectors with ampere rating equal to switch rating.
 - 3. Cam connectors must be located horizontally at the bottom of the unit>

B. Electrical Ratings:

- 1. Ampere Rating: As indicated on the Drawings. All breakers shall be 100% rated for indicated ampere rating.
- 2. Number of Poles: 3-pole with solid, fully rated neutral bus unless indicated otherwise.
- C. Switch Characteristics: Designed for continuous-duty repetitive transfer of full-rated current between active power sources.
 - 1. Conductor Connectors: Suitable for use with conductor material and sizes.
 - 2. Material: Hard-drawn copper, 98 percent conductivity.
 - 3. Main and Neutral Lugs: Mechanical type.
 - 4. Ground Lugs and Bus-Configured Terminators: Mechanical type.
 - 5. Ground bar.
 - 6. Connectors shall be marked for conductor size and type according to UL 1008.

- D. MTS Enclosure: Wall or Pad-Mounted enclosure as indicated on the Drawings, as specified herein or as required for switch rating.
 - 1. Construction: Code-gauge galvanized steel with continuous-welded seams.
 - 2. NEMA Rating: NEMA 3R unless indicated otherwise.
 - 3. Door: Interlocked, hinged, full height of enclosure.
 - 4. Portable Equipment Connections: Cam-style connectors with cable access via drawn flange cable entry openings in the bottom of the enclosure for wallmounted enclosures or hinged lower flap door for pad-mounted encosures. A hinged flap door shall be provided to cover cable entry when cables are not connected.
 - 5. Finish: Manufacturer's standard gray power-coat finish applied after fabrication.
- E. Cam-Style Connectors: Male or female as specified, UL listed, single-pole, separable type.
 - 1. Rating: 400 amperes at 600Vac.
 - 2. Wire: Provide connectors for each phase, neutral and ground.
 - 3. Number: Number of connectors per phase, neutral and ground as required to obtain indicated MTS switch rating.
 - 4. Identification: Cam-style connectors shall be color-coded.
 - Connection: Phase and neutral connectors shall be factory-wired to the appropriated molded-case circuit breaker. Ground connector shall be bonded to the MTS enclosure and ground lug provided for connection to the facility equipment ground conductor.
 - 6. Cam-style connectors shall not be accessible unless all three molded-case circuit breakers are in the OFF position and main access door is open.
- F. Power Distribution Block: Provided for all load-side field wiring and factory-wired to the molded-case circuit breakers.
- G. Circuit Breakers: UL listed, molded-case type, dead-front mounted.
 - 1. Trip Rating: As indicated for the MTS.
 - 2. Poles: 3- or 4-pole as indicated.
 - 3. Voltage Rating: As required for connected systems.
 - 4. K.A.I.C. Rating: Minimum 35 at 480Vac or as indicated.
 - 5. Configuration: One circuit breaker shall control the connection between the permanent generator and the automatic transfer switch. A second circuit breaker shall control the connection between the permanent generator and the load bank female cam-style connectors. A third circuit breaker shall control the connection between the portable generator and the automatic transfer switch.

- 6. Operating Handle: All circuit breakers shall include UL Listed door-mounted operating mechanisms, preventing the opening of the main access door unless all breakers are in the OFF position.
- 7. Interlocks: Circuit breakers controlling the two generator sources shall be mechanically interlocked to ensure only one breaker can be closed at a time.
- 8. Auxiliary Contacts: Provided on permanent generator circuit breaker and wired to terminal blocks within the enclosure in compliance with NFPA-70 (NEC).

PART 3 - EXECUTION

3.1 COORDINATION

- A. Coordinate MTS location, orientation, etc. with adjacent building elements, electrical equipment, etc. to maintain required working clearances, maintenance access and door swing to at least a 90 degree opening.
- B. Verify electrical rough-in is complete and required raceways for all power and control wiring are installed.
- C. Wall-Mounted MTS: Coordinate location, dimensions and electrical rough-in with adjacent building elements and equipment.
- D. Pad-Mounted MTS: Coordinate location, orientation, dimensions, cut-outs, and anchoring requirements for concrete equipment pad.

3.2 INSTALLATION

- A. Provide and connect Manual Transfer Switch(es) as herein specified and indicated on the Drawings.
- B. Wall-Mounted: MTS's rated 800A and smaller shall be wall-mounted unless specifically indicated otherwise on the Drawings or herein specified.
 - 1. Fasten MTS firmly to walls and structural surfaces ensuring they are permanently and mechanically anchored.
 - Anchor and fasten MTS and their supports to building structural elements by methods described in Section 260529 "Hangers and Supports for Electrical Systems."
 - 3. Install two rows minimum of steel slotted channel with a minimum of 4 attachment points for each MTS enclosure.

- 4. When not directly located on structural wall, provide support frame of steel slotted channel anchored to floor and ceiling structure.
- 5. Install such that top operating handle is a maximum of 6 foot 6 inches above the finished floor or working platform with handle in its highest position.
- 6. Install so as to maintain minimum working space clearance in all directions and dedicated electrical equipment spaces per NFPA 70 (NEC).
- 7. Flammable surfaces used for mounting MTS shall be painted with 2 coats of flame resistant paint.
- C. Outdoor Pad-Mounted: Unless indicated or detailed otherwise on the Drawings, the MTS shall be mounted on concrete equipment pad complying with Division 3 Section "Cast In-Place Concrete" and the following:
 - 1. Concrete: 3000 psi concrete, minimum.
 - 2. Equipment Pad Thickness: 6 inches thick concrete pad. Top 4 inches of pad shall be above finished grade.
 - 3. Equipment Pad Dimensions: Shall extend 36 inches beyond front and 6" on remaining sides of enclosure..
 - 4. Reinforcement: #6 reinforcement wire mesh, top and bottom.
 - 5. Finish: Broom finish with 1 inch chamfer on all exposed edges.
- D. Comply with NECA 1.
- E. Comply with NFPA 110 and NFPA 70 (NEC).

3.3 CONNECTIONS

- A. Wiring to Remote Components: Match type and number of cables and conductors to generator set(s), control and communication requirements of transfer switches as recommended by manufacturer. Increase raceway sizes at no additional cost to Owner if necessary to accommodate required wiring.
- B. Wiring within Enclosures: Bundle, lace and train conductors to terminal points with minimum excess and without exceeding manufacturer's limitation on bending radii.
- C. Ground equipment according to Section 260526 "Grounding and Bonding for Electrical Systems".
- D. Connect power wiring according to Section 260519 "Low-Voltage Electrical Power Conductors".

E. Provide and connect control and interface wiring per the manufacturer's instructions and recommendations.

3.4 FIELD QUALITY CONTROL

- A. Prior to energizing 3-way manual transfer switch, the Contractor shall perform the following checks and tests as a minimum:
 - 1. Verify mounting and connections are complete and secure.
 - 2. Verify internal components and wiring are secure.
 - 3. Perform continuity check of all circuits.
 - 4. Perform 1,000 VDC megger test on feeder and load cables. Prior to testing, all auxiliary circuits must be turned OFF and all fuses, microswitches and shunt trip circuits must be disconnected. It is required to take out the rating plug of any electronic trip circuit breakers while performing a megger (insulation) test.
 - 5. Verify deadfront is secure.
 - 6. With the 3-way manual transfer switch deadfront in place and the main access door closed and properly latched, actuate all (3) Operator Mechanisms; verify:
 - a. With the breaker controlling the connection between the permanent generator and the automatic transfer switch (ATS) in the ON position, the breaker controlling the connection between permanent generator and the load bank can be turned to the ON and OFF position and the breaker controlling the connection between the portable generator and the automatic transfer switch cannot be turned ON.
 - b. With the breaker controlling the connection between the permanent generator and the automatic transfer switch (ATS) in the OFF position, the other (2) breakers controlling the connection between the permanent generator and load bank can be turned ON or OFF, and the breaker controlling the connection between the portable generator and the automatic transfer switch can be turned ON and OFF.
 - c. With the breaker controlling the connection between the portable generator and the automatic transfer switch (ATS) in the ON position, the breaker controlling the connection between the permanent generator and the automatic transfer switch (ATS) cannot be turned ON and the breaker controlling the connection between the permanent generator and load bank can be turned ON and OFF.
 - 7. Confirm operation of the 3-way manual transfer switch ground receptacle by attaching a plug to the 3-way manual transfer switch ground receptacle and then verify that the plug is grounded to the facility ground.

- 8. Once normal power has been applied, confirm operation of 3-way manual transfer switch by following directions on main access door.
- B. Infrared Scanning: After Substantial Completion, but not more than 60 days after Final Acceptance, perform an infrared scan of each switch. Remove all access panels so joints and connections are accessible to portable scanner.
 - Instrument: Use an infrared scanning device designed to measure temperature or to detect significant deviations from normal values. Provide calibration record for device.
 - 2. Record of Infrared Scanning: Prepare a certified report that identifies switches checked and that describes scanning results. Include notation of deficiencies detected, remedial action taken, and observations after remedial action

END OF SECTION



P.O. Box 2523 Starkville, MS 39760 Phone: 662.324.2205

Fax: 662.324.2092

JUNE 5, 2020

LPK ARCHITECTS ATTN: BOB LUKE P.O. BOX 630 MERIDIAN, MS 39302

EMAIL: bluke@lpkarchitects.com

snixon@lpkarchitects.com

RE: FORENSIC GEOTECHNICAL INVESTIGATION

FORMER LABCORP BUILDING MERIDIAN, MISSISSIPPI

Dear Mr. Luke:

Pritchard Engineering, Inc. appreciates the opportunity to participate as geotechnical consultant for the project captioned above. At your request, Pritchard Engineering, Inc. performed two (2) soil borings and subsequent laboratory analysis in an effort to determine the subsurface conditions present along the front of the structure referenced above. Presented herewith are the following:

- > A summary of the field exploration and laboratory methods employed
- Logs of two (2) borings including results of laboratory analysis'.
- Commentary and recommendations regarding the probable cause(s) of structure demise and potential mitigation options.

PROMPT / SITE CHARACTERISTICS

This investigation is prompted by signatures of foundation and structure distress along the front entry and authorized verbally by Mr. Bob Luke, architect and consultant.

The subject structure is a former grocery re-purposed by LabCorp which is currently abandoned. It is located at the intersection of Donald Avenue and E Street in Meridian, Mississippi; just northwest of the prior Village Fair Mall. Handheld GPS coordinates obtained by the driller in proximity of boring (1) are N 32° 21′ 21.1″ and W 88° 41′ 51.0″. Ground cover beyond the footprint of the structure consists primarily of paved parking areas and access drives. The surrounding topography is relatively flat and surface drainage appears poor.

FIELD INVESTIGATION

Two (2) borings were performed at locations and to depths selected by Pritchard Engineering. Appendix (C) provides a schematic depicting the approximate boring locations.

Drilling was accomplished by the dry auger method utilizing continuous flight auger advanced by a tractor mounted Giddings Model TS-35 hydraulic boring rig and were terminated at a depth of fifteen (15) feet below the existing site elevation. Shelby tubes were advanced (See ASTM D-1587) at selected depths to provide "undisturbed" specimens for visual classification and determination of shear strength and compressibility parameters by testing in unconfined compression and one-dimensional consolidation. Standard penetration tests (See ASTM D-1586) were also conducted at locations and intervals specified by the geotechnical engineer. The standard penetration resistance (N) value is the number of blows required to drive a standard 18-inch split-barrel sampler the final 12 inches utilizing a 140-pound hammer and a freefall height of 30 inches. Standard penetration values provide an indication of soil consistency and can be utilized in formulating design recommendations through empirical relations including but not limited to bearing capacity and potential settlement under loading conditions. "N" values are depicted by depth and location on the boring logs.

Representative specimens of the various soils encountered were retrieved at changes in strata and at intervals not exceeding 2 feet in depth. Samples retrieved during the field investigation were immediately placed in sealed containers to preserve their physical characteristics for transportation and future analysis in the laboratory.

The depth at which free water was first detected during drilling is indicated on the boring logs. Prior to closure, the depth to ground water and/or borehole caving was determined. This information is also recorded on the boring logs and was obtained after an elapsed period of approximately 1 to 2 hours.

LABORATORY ANALYSIS

Procedures employed in performing laboratory analysis were accomplished in general accordance with applicable American Society for Testing and Materials (ASTM) standard specifications for quality assurance. Tests were conducted on representative samples of the various soils encountered as designated by the Engineer. A list of the tests performed including a summary of the results obtained is presented as follows:

(Soil Classification) - ASTM D-2487

All soil samples were classified both visually and in accordance with criteria stipulated by the Unified Soil Classification System. (See boring logs.) Under the Unified Soil Classification System, coarse-grained soils (gravels and sands) are classified based upon grain-size. Fine-grained materials (silts and clays) are classified on the basis of plasticity (PI) as related to the Casagrande "A" line. For your convenience, a description of the symbols employed by the Unified Soil Classification and their meaning is presented as Appendix (A). Where appropriate, dual symbols are employed to signify borderline soils:

(Water Content) - ASTM D-2216

In-situ (or field) moisture contents were determined by placing extracted samples in sealed containers immediately upon removal from the drill cavity. Highly saturated soils were encountered near the surface in Boring (1). Otherwise, information generated from the analysis performed indicates in-situ moisture

contents were within the anticipated range for the soil types encountered and climatic season. Moisture content data is presented on the boring logs as W (%).

(Liquid and Plastic Limits) - ASTM 4318

Liquid and plastic limits, commonly referred to as Atterberg Limits, were performed on representative samples of the cohesive soils encountered. The plastic limit (PL) is the moisture content representing the lower boundary range of plastic behavior of a soil. The liquid limit (LL) is the moisture content representing the upper range of plastic behavior, above which a soil will essentially have the shear strength of a fluid. Both values are expressed as percent (%) moisture. The plasticity index (PI) is the numerical difference between the liquid limit and plastic limit and is utilized in soil classification and empirical relations developed regarding volume change, strength, and permeability. Data generated from this investigation indicates the plasticity index (PI) of the clays identified within the upper soil horizon ranges from 9 to 23. Based on this information these soils are considered to have a low shrink-swell potential which should not be adversely impacting the building.

(Shear Strength)

Shear strength tests were performed on undisturbed and remolded specimens of the various soils encountered. Methods employed in assessing shear strength were designated by the geotechnical engineer and are briefly summarized as follows:

(Pocket Penetrometer)

Selected cohesive soil specimens were tested utilizing a pocket penetrometer. This procedure allows for a quick approximation of the unconfined compressive strength of a soil through correlation of penetration of a calibrated plunger. Results are indicated as tons per square foot (tsf) by sample depth on the boring logs and represent the average of a minimum of four (4) readings per specimen.

(Unconfined Compression Test) – ASTM 2166

The unconfined compression test provides a relatively quick and economical approximation of the unconsolidated and undrained shear strength of a cohesive soil. Testing involves subjecting an "undisturbed" cylindrical sample of the soil (usually extracted from a Shelby tube) to a uniformly increasing load under controlled stress or controlled strain conditions until failure is reached through shear or excessive strain. The cohesive shear strength (c) is equivalent to one-half of the maximum normal stress realized during the test effort. Test results indicate strengths range from approximately 0.8 to 4.6 kips per square foot (ksf) and are presented as unconfined compressive strength on the boring logs and as Appendix (B).

SOIL PROFILE

The generalized soil profile presented is based upon engineering interpretation of the boring logs and related laboratory analysis as presented in Appendix (B).

Nominal thickness of the asphalt pavement at the drilling locations was 8". We would note that an additional layer of asphalt underlain by a granular subbase was encountered at a depth of approximately 3 feet in boring (1) which may suggest a former parking area was overlain by new construction. Beneath these materials interbedded low to medium plasticity sandy and/or silty clays

conforming to Unified Classification CL were identified. Consistency of these soils as estimated by the driller and verified by standard penetration resistance "N" values of zero (0) to 8 ranges from very soft to medium stiff and would generally be considered as very soft to soft.

The soils described are superimposed on loose fine silty clayey sand (Unified Classification SM-SC) initially intercepted at a depth of approximately 13 feet in boring (1) which extended to the limits of exploration.

Highly saturated soils were noted at shallow depth in boring (1) with free water encountered at a depth of approximately 12 feet in boring (2). Caving of the drill cavity at 3.5' prohibited a subsequent groundwater observation at boring (1). Depth to groundwater as observed and recorded approximately 2 hours after removal of the drill tool say 9 feet in boring (2). The reader is advised the field investigation was accomplished within a period of above average precipitation. Migration of groundwater is common within the lean clays and permeable sands and the phreatic surface is anticipated to fluctuate with the climatic season. Also, localized abnormalities in groundwater levels may result from random fill or subterranean utility installations.

COMMENTARY / RECOMMENDATIONS

Based upon the information generated the probable causes of structure demise and distress realized to date include;

- > A foundation system which is inadequate for the very low bearing capacity of the underlying soils, and
- Immediate distortion and subsequent consolidation of the very soft to soft clays upon loading.

At this juncture we advise installation of a minimum of two (2) shallow test pits to reveal the structure foundation(s); the geometry and composition of which to be evaluated by the geotechnical engineer. if the foundation is of sufficient integrity the system may be retro-fitted with A.B. Chance type helical piers. For estimating purposes, we would project single or double helical units bearing a minimum of twenty (20) feet beneath the existing site elevation(s) within the lower sand stratum. We advise pier installations be accomplished by a certified installer exhibiting a minimum of five (5) years of experience. Pier spacings and allowable capacities should be developed or verified based upon results of a test installation monitored by the geotechnical engineer.

Feel free to contact us should you have any questions regarding the information provided or if we may be of additional service.

Respectfully,

Clyde L. Pritchard, P.E.


Pritchard Engineering, Inc.

APPENDIX (A)

UNIFIED SOIL CLASSIFICATION SYSTEM

Appendix (A)

	Major Di	visions	Group Symbol	Typical Names	Classification fo	or Coarse-Gained Soils		
ial is larger	alf of er than	Clean gravels (little or no fines)	GW	Well-graded gravels, gravel-sand mixtures, little or no fines		D ₆₀ / D ₁₀ > 4 ₃₀ / D ₁₀ x D ₆₀ < 3		
	than h is large ve size)	Cle gravels or no	GP	Poorly-graded gravels, gravel-sand mixtures, little or no fines	Not meeting all grad	ation requirements for GW		
or mater	Gravels (more than half of oarse fraction is larger than No. 4 sieve size)	s with es ciable nt of es)	GM	Silty gravels, gravel-sand-silt mixtures	Atterburg limits below A line or I _p < 4	Above A line with 4 < I _p < 7		
an nair o 00 sieve)	Gravels (more than half of coarse fraction is larger than No. 4 sieve size)	Gravels with fines (appreciable amount of fines)	GC	Clayey gravels, gravel-sand-clay mixtures	Atterberg limits below A line or I _p > 7	are borderline cases requiri use of dual symbols		
Coarse-Grained Soils (more than half of material is larger than No. 200 sieve)	coarse No. 4	Clean sands (little or no fines)	sw	Well-graded sands, gravelly sands, little or no fines		D ₆₀ / D ₁₀ > 6 ₃₀ / D ₁₀ x D ₆₀ < 3		
	half of er than ize)	Clean (little fin	SP	Poorly-graded sands, gravelly sands, little or no fines	Not meeting all gradation requirements for			
	ands (more than half of coars fraction is smaller than No. 4 sieve size)	th fines ciable of fines)	SM	Silty sands, sand-silt mixtures	Atterburg limits below A line or I _p < 4	Limits plotting in hatched zone with 4 < I _p < 7 are		
	Sands (more than half of coarse fraction is smaller than No. 4 sieve size)	Sands with fines (appreciable amount of fines)	sc	Clayey sands, sand-clay mixtures	Atterberg limits below A line or I _p > 7	borderline cases requiring u of dual symbols		
2		ays < 50)	ML	Inorganic silts and very fine sands, rock flour, silty or clayey fine sands, or clayey silts with slight plasticity	11.410	- Alexander		
rine-grained sons (more than hall of material is smaller than No. 200 sieve)		Silts and clays (liquid limit < 50)	CL	Inorganic clays of low to medium plasticity, gravelly clays, sandy clays, silty clays, lean clays	grain-size curve.	ges of sand and gravel from		
. 200 s		s pil)	OL	Organic silts and organic silty clays of low plasticity	 Depending on percentages of fines (fraction smalle than 200 sieve size), coarse-grained soils are classified as follows: Less than 5% - GW, GP, SW, SP 			
ed sons (more than han or smaller than No. 200 sieve)	H.	Silts and clays (liquid limit > 50)	МН	Inorganic silts, micaceous or diatomaceous fine sandy or silty soils, elastic soils				
aller t	8	Silts and clays iquid limit > 50	СН	Inorganic clays of high plasticity, fat clays	More than 12% - GM, G 5% to 12% - Borderline	cases requiring dual symbols		
Sm		Silts (liqui	ОН	Organic clays of medium to high plasticity, organic silts				
0 2 1	Highly	organic soils	Pt	Peat and other highly organic soils	Soil Consistency			

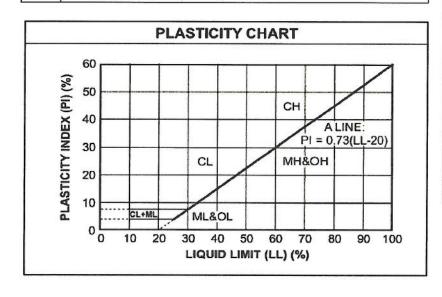

Highly organic soils

- grain-size curve.
- 2. Depending on percentages of fines (fraction smaller than 200 sieve size), coarse-grained soils are classified

Soil Co	nsistency	
C	lays	
Blows per foot (N)	Consistency	
0-2	Very Soft	
2-4	Soft	
4-8	Medium Stiff	
8-15	Stiff	
15-30	Very Stiff	
Over 30	Hard	
Sa	inds	
Blows per foot (N)	Density	
0-4	Very Loose	
4-10	Loose	
10-30	Medium Dense	
30-50	Dense	
Over 50	Very Dense	



APPENDIX (B) BORING LOGS



DRY AUGER..... ASTM D-1452

SHELBY TUBE.....ASTM D-1582

PENETRATION TEST.....ASTM D-1586

X

PROJECT NO. 6129A G-48
LAUDERDALE COUNTY GOVERNMENT
CENTER - LABCORE BLDG
MERIDIAN, MISSISSIPPI

BORING NO. ELEVATION DRILLED DRILLER

05/13/20 SM

1

DEPTH (FT)	SAMP (FT)	SR	VISUAL CLASSIFICATION / REMARKS	CONSIST.	SPT (N)	W %	LL	PI	-200 %	UNIFIED CLASS	q _u (tsf)
			8" Asphalt								
2			Red fine silty <u>SAND</u>	M. Dense		10				SM-SC	
			*Asphalt layer @ 3'								
4	2-3.5	X	Red sandy <u>CLAY</u>	M. Stiff	5	19	23	9		CL	2.3
6	5-6.5	X	Gray sandy silty <u>CLAY</u>	V. Soft	0	22	26	11		CL	0.4
8			(saturated)	V. Soft		20				CL	
10				V. Soft		28				CL	
12	10-11.5	X	Reddish brown & gray sandy silty CLAY	Soft	4	25	41	23		CL	0.8
13 14			Brown fine silty clayey <u>SAND</u>	Loose		29				SM-SC	
15			BORING TERMINATED	Loose		29				SWI-SC	
16											
18											
20											
22											
24											
26											
28											
30											
SAMPL	E RETR	IEV	AL (SR)	WATER O	BSER	VAT	ION ((S)			

NONE ENCOUNTERED

BOREHOLE CAVED AT

FT. AFTER

X

3.5

HRS.

FT.



PROJECT NO. 6129A G-48
LAUDERDALE COUNTY GOVERNMENT
CENTER - LABCORE BLDG

MERIDIAN, MISSISSIPPI

BORING NO. ELEVATION DRILLED DRILLER


05/13/20 SM

2

DEPTH SAMP VISUAL CLASSIFICATION / REMARKS CONSIST. -200 UNIFIED (FT) (FT) (N) CLASS (tsf) 8" Asphalt Dark gray (black) silty CLAY 2 M. Stiff 19 CL 2-3.5 X Mottled red, yellow, & light gray sandy silty M. Stiff 7 22 36 16 CL 2.1 **CLAY** 5-6.5 X 6 M. Stiff 25 39 17 CL 2.0 8 M. Stiff 27 CL 10 10-11.5 X Soft 4 25 35 16 CL 1.3 12 *Hit water @ 12' Soft 27 CL14 Gray & brown sandy silty CLAY Soft 27 CL 15 BORING TERMINATED 16 18 20 22 24 26 28 30

SAMPLE RETRIEVAL (SR)	WATER OBSERVATION (S)		
DRY AUGERASTM D-1452	NONE ENCOUNTERED		
SHELBY TUBEASTM D-1582	9 FT. AFTER	2	HRS.
X PENETRATION TESTASTM D-1586	BOREHOLE CAVED AT	11	FT.

APPENDIX (C) SITE SCHEMATIC / BORING PLAN

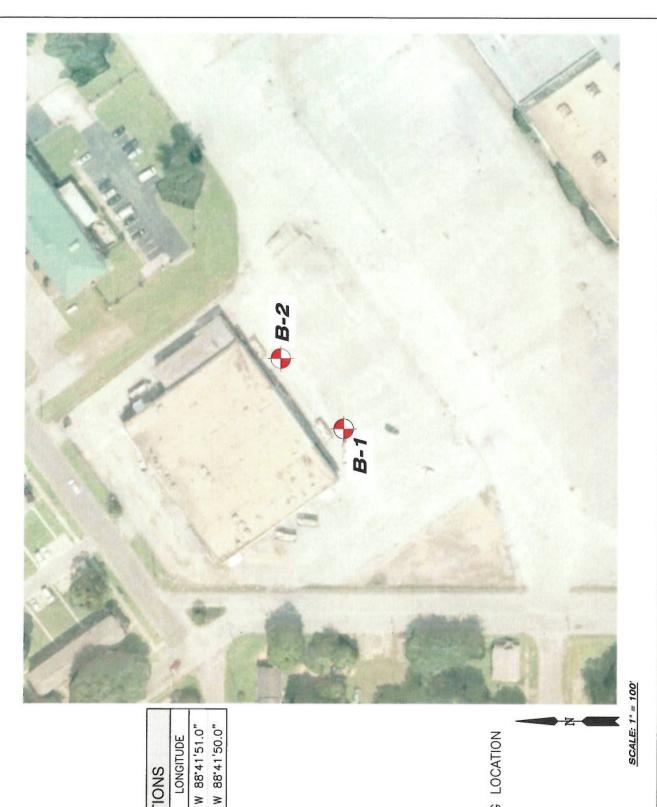

BORING LOCATIONS

N 32'21'21.1" N 32'21'21.8"

B-2 B-1

LATITUDE

BORING

LEGEND B-1

SOIL BORING LOCATION



LAUDERDALE COUNTY
GOVERNMENT CENTER - LABCORP BUILDING

PRITCHARD ENGINEERING

MERIDIAN, MISSISSIPPI

LPK ARCHITECTS MERIDIAN, MISSISSIPPI CLIENT:

100 MILEY DR. CHECKED BY: CLP
STARKVILLE, MS DATE: 8/5/2020
39760 SCALE: 1" = 100'
662,324,2205 PROJ. #: 6129
DWG #: 6129 - BP



P.O. Box 2523 Starkville, MS 39760 Phone: 662.324.2205

Fax: 662.324.2092

APRIL 29, 2021

LPK ARCHITECTS MR. BENJI ARMSTRONG P.O. BOX 630 MERIDIAN, MS 39302

VIA EMAIL: barmstrong@lpkarchitects.com

RE: SUPPLEMENTAL BORINGS

FORMER LABCORP BUILDING MERIDIAN, MISSISSIPPI

Dear Mr. Armstrong:

Submitted herewith are boring logs depicting the results of subsurface exploration and laboratory analysis performed on samples collected from each of two (2) supplemental borings conducted at the site captioned above. Said investigation intended to provide geotechnical parameters for canopy foundation design as outlined in our proposal of April 15, 2021. A site schematic illustrating the boring locations accompanies this document. Commentary and recommendations resulting from this effort are presented as follows.

SOIL PROFILE

Prevalent near surface soils identified at the locations investigated consist of low to medium plasticity sandy and/or silty clays. According to the criteria stipulated by the Unified Soil Classification System these soils are designated CL (lean clay) or CL-SC (borderline sand-clay). The extent to which the upper soil horizon represents relatively undisturbed geologic deposition or materials relocated or imported in prior site development is unknown. Consistency of the surficial clays as estimated by the driller and verified by standard penetration resistance "N" values of 4 to 7 ranges from **soft** to medium stiff.

Poorly graded fine silty and/or clayey sands and medium coarse sands were intercepted at depths of approximately 6.5 to 7 feet which extended to the limits of exploration. Appropriate Unified classifications for the sands are SM, SM-SC, SP, and SM-SP. Consistency of the lower sand strata as estimated by the driller and verified by standard penetration resistance "N" values of 5 to 14 ranges from **loose** to medium dense.

Free water was detected as the borings were advanced at depths of approximately 6.5 to 7 feet at the lower sand contact. Each of the boreholes caved at 6 to 8 feet with groundwater observed at 6 to 7 feet. The reader is advised the field investigation was accomplished within a period of above average rainfall and the phreatic surface observed is subject to change with climatic conditions.

FOUNDATION RECOMMENDATIONS

It is our understanding the project involves a "lean to" type annex to the parent structure for covered vehicle parking. Minimal grading is anticipated in site development. This investigation has revealed **soft** and **loose** materials within the zone of influence which pose a potential for excessive total and/or differential settlement. With respect to same we advise the following recommendations for utilization of reinforced concrete spread footings.

- Over-excavate area beneath and extending 1.5 feet beyond perimeter of future spread foundations to a depth of 4 feet beneath existing site elevation.
- Install 8 oz. non-woven geotextile on exposed subgrade in accordance with manufacturers recommendations.
- Backfill with initial 12" lift of Size No. 610 crushed limestone with minimal compactive effort.
 DO NOT VIBRATE.
- Backfill to design subgrade elevation in maximum loose lifts of 8"; each compacted to 95% of maximum dry density. DO NOT VIBRATE.
- Design shallow spread foundation for a maximum allowable soil pressure of 2400 psf.

All foundation members should be adequately reinforced to resist differential movement and as stipulated by applicable American Concrete Institute (ACI) specifications.

The allowable pressure quoted herein is intended to provide a factor of safety of 2.6 to 3.6 with respect to ultimate or bearing capacity failure of the supporting soils with a maximum anticipated settlement of 0.5 inches which is contingent upon proper placement and compaction of backfill during the grading process. Maximum anticipated differential settlement between adjacent columns is 0.25".

Feel free to contact us should you have any questions regarding the information provided or if we may be of additional service.

Respectfully,

Clyde L. Pritchard, P.E.


Pritchard Engineering, Inc.

APPENDIX (A)

UNIFIED SOIL CLASSIFICATION SYSTEM

Appendix (A)

	Major Di	visions	Group Symbol	Typical Names	Classification fo	r Coarse-Gained Soils			
Coarse-Grained Soils (more than half of material is larger than No. 200 sieve)	alf of r than	Clean gravels (little or no fines)	GW	Well-graded gravels, gravel-sand mixtures, little or no fines		$D_{60} / D_{10} > 4$ $B_{30} / D_{10} \times D_{60} < 3$			
	than hi is large ve size)	Cle gravels or no	GP	Poorly-graded gravels, gravel-sand mixtures, little or no fines		ation requirements for GW			
f mater	Gravels (more than half of oarse fraction is larger than No. 4 seve size)	s with es clable nt of	GM	Silty gravels, gravel-sand-silt mixtures	Atterburg limits below A line or I _p < 4	Above A line with 4 < Ip < 7			
an half o 10 sieve)	Gravels (more than half of coarse fraction is larger than No. 4 sieve size)	Gravels with fines (appreciable amount of	GC	Clayey gravels, gravel-sand-clay mixtures	Atterberg limits below A line or I _p > 7	are borderline cases requiring use of dual symbols			
is (more than half o than No. 200 sieve)	half of coarse ir than No. 4 ze)	Clean sands (little:or no fines)	sw	Well-graded sands, gravelly sands, little or no fines	-	$D_{60}/D_{10} > 6$ $B_{60}/D_{10} \times D_{60} < 3$			
Soils (half of er than ize)	Clean (little fin	SP	Poorly-graded sands, gravelly sands, little or no fines	Not meeting all grad	ation requirements for SW			
-Grainec	ore than halis smaller to sieve size)	h fines iable if fines)	5M.	Silty sands, sand-silt mixtures	Atterburg limits below A line or l _p < 4	Limits plotting in hatched zone with 4 < I _o < 7 are			
Coarse	Sands (more than half of coars fraction is smaller than No. 4 sleve size)	Sands with fines (appreciable amount of fines)	SC	Clayey sands, sand-clay mixtures	Atterberg limits below A line or I _p > 7	borderline cases requiring use of dual symbols			
rial is			ML	Inorganic silts and very fine sands, rock flour, silty or clayey fine sands, or clayey silts with slight plasticity					
Fine-grained soils (more than half of material is smaller than No. 200 sieve)		Silts and clays (liquid limit < 50)		Inorganic clays of low to medium plasticity, gravelly clays, sandy clays, silty clays, lean- clays	grain-size curve.	ges of sand and gravel from			
ed soils (more than half of r smaller than No. 200 sieve)		rz (ji	OL.	Organic silts and organic silty clays of low plasticity	Depending on percentages of fines (fraction sm than 200 sleve size), coarse-grained soils are class				
more ti han No		Sits and clays (liquid limit > 50)	MĤ	Inorganic silts, micaceous or diatomaceous fine sandy or silty soils, efastic soils	as follows: Less than 5% - GW, GP,	•			
soils (Sits and clays quid limit > 50	СН	Inorganic clays of high plasticity, fat clays	More than 12% - GM, GC, SM, SC 5% to 12% - Borderline cases requiring dual sy				
rained.		Silts (liquìc	ОН	Organic clays of medium to high plasticity, organic silts					
Fine-g	2	organic soils	Pt	Peat and other highly organic soils	Soil Consistency				

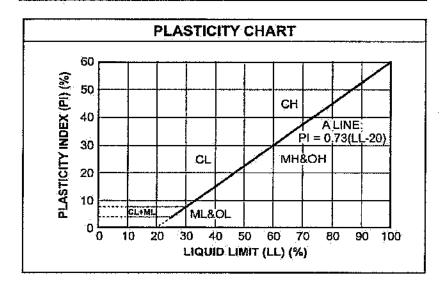

Highly organic

- 1. Determine percentages of sand and gravel from grain-size curve.
- 2. Depending on percentages of fines (fraction smaller than 200 sieve size), coarse-grained soils are classified

Soil Co	nsistency
C	lays
Blows per foot (N)	Consistency
0-2	Very Soft
2-4	Soft
4-8	Medium Stiff
8-15	Stiff
15-30	Very Stiff
Over 30	Hard
Sá	inds
Blows per foot (N)	Density
0-4	Very Loose
4-10	Loose
10-30	Medium Dense
30-50	Dense
Over 50	Very Dense



APPENDIX (B) BORING LOGS



PROJECT NO.	6129 A-48
LAUDERDA	ALE COUNTY
GOVERNM	ENT CENTER
LABCORF	BUILDING
MERIDIAN,	MISSISSIPPI

BORING NO. ELEVATION DRILLED DRILLER 3 04/20/21 SM

DEPTH (FT)	SAMP (FT)	SR	VISUAL CLASSIFICATION / REMARKS	CONSIST.	SPT (N)	W %	LL	PI	-200 %	UNIFIED CLASS	q _u (tsf)
0											
1			Dark gray sandy <u>CLAY</u> with asphalt	M. Stiff		10				CL-SC	
2			The deplace								
3	2-3.5	X	Yellow brown & gray sandy silty <u>CLAY</u>	M. Stiff	5	17	33	18		CL	2.3
4											
5	5-6.5	X		M. Stiff	7	19	25	11		CL	0.5
6 6.5			*Hit water @ 6.5'								
7	7-8.5	X	Yellow red & gray fine to medium coarse silty SAND	Loose	7	25		NP		SM	
8			Sitty <u>SAND</u>								
9				Loose		27		NP		SM	
10											
11	10-11.5	X	Light brown & gray fine to medium coarse SAND	Loose	5	26		NP		SP	
12											
13				Loose		29		NP		SP	
14											
15				Loose		26		NP		SP	
16											
17				Loose		27		NP		SP	
18											
19				Loose		27		NP		SP	
20			BORING TERMINATED		1.						
AMPI	LE RETE	RIEV	/AL (SR)	WATER OF	BSERV	ATI	ON (S	S)			1000

DRY AUGERASTM D-1452	NONE ENCOUNTERED		LA SERVICE
SHELBY TUBEASTM D-1582	6FT. AFTER	2	HRS.
PENETRATION TESTASTM D-1586	BOREHOLE CAVED AT	6	FT.




PROJECT NO.	6129 A-48
LAUDERD	ALE COUNTY
GOVERNM	ENT CENTER
LABCORI	PBUILDING
MERIDIAN	, MISSISSIPPI

BORING NO. ELEVATION DRILLED DRILLER 4 04/20/21 SM

DEPTH (FT)	SAMP (FT)	SR	VISUAL CLASSIFICATION / REMARKS	CONSIST.	SPT (N)	W %	LL	PI	-200 %	UNIFIED CLASS	q _u (tsf)
0											
1			Dark gray sandy <u>CLAY</u> with asphalt	M. Stiff		11				CL	
2											
3	2-3.5	X	Yellow brown & gray sandy silty CLAY	Soft	4	23	25	10		CL	0.9
4											
5	5-6.5	X		M. Stiff	6	27	30	14		CL	0.7
6											
7			*Hit water @ 7'	M. Stiff		26				CL	
8	7-8.5	X	Light gray fine to medium coarse clayey SAND	M. Dense	14	21				SM-SC	1.3
9			SAND								
10			Brown & gray fine to medium coarse <u>SAND</u>	Loose		32		NP		SM-SP	
11											
12				Loose		29		NP		SM-SP	
13											
14				Loose		31		NP		SM-SP	
15			BORING TERMINATED								
16											
17											
18											
19											
20											
AMPL.	E RETI	RIEV	/AL (SR)	WATER OF	SERV	ATI	ON (S	6			

THE REPORT OF THE COLO	WATER OBSERVATION (b)		
DRY AUGERASTM D-1452	NONE ENCOUNTERED		
SHELBY TUBEASTM D-1582	7 FT. AFTER	1.5	HRS.
PENETRATION TESTASTM D-1586	BOREHOLE CAVED AT	8	FT.

APPENDIX (C) SITE SCHEMATIC / BORING PLAN

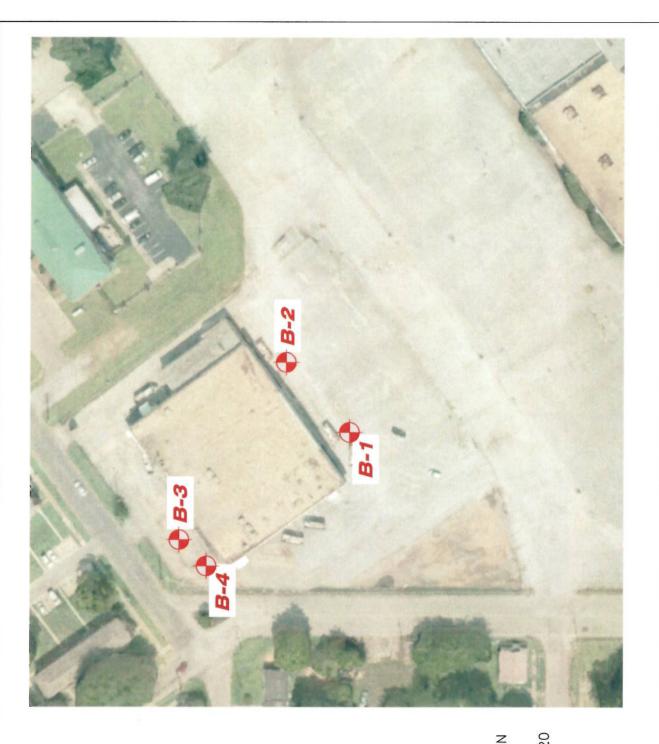



SCALE: 1' = 100'



SOIL BORING LOCATION

BORINGS (1) AND (2) 5/13/20

LPK ARCHITECTS

MERIDIAN, MISSISSIPPI

GOVERNMENT CENTER - LABCORP BUILDING LAUDERDALE COUNTY

PRITCHARD

100 MILEY DR. CHECKED BY:
STARKVILLE, MS DATE:
39760 SCALE: 1"
662.324.2205 PROJ. #: f

MATERIALS LEGEND:

GYP. BOARD, PLASTER, OR CONCRETE IN PLAN AS NOTED

BATT INSULATION


WOOD FRAMING

LAUDERDALE COUNTY PUBLIC SAFETY BUILDING

MERIDIAN, MS 39301


CONSTRUCTION DOCUMENTS PROJECT NUMBER: 19-4894B MARCH 18, 2021

PROJECT DIRECTORY:						
ARCHITECT LPK ARCHITECTS, P.A. 821 22ND AVENUE P.O. BOX 630 MERIDIAN, MS 39301 P: 601-693-9990 F: 601-693-8640	CONSTRUCTION MANAGEMENT W.G. YATES & SONS CONSTRUCTION CO. ONE GULLY AVENUE PHILADELPHIA, MS 39350 P: 601-656-5411 F: 601-663-4140	SURVEY PRITCHARD ENGINEERING, INC. 100 MILEY ROAD STARKVILLE, MS 39759 P: 662-324-2205 F: 662-324-2092				
CIVIL / STRUCTURAL SPENCER - ENGINEERS, INC. 2508 LAKELAND DRIVE, SUITE 200 FLOWOOD, MS 39232 P: 601-982-7766 F: 601-982-7769	MECHANICAL ENGINEERING RESOURCE GROUP, INC. 350 EDGEWOOD TERRACE DRIVE JACKSON, MS 39206 P: 601-362-3552 F: 601-366-6418	ELECTRICAL SCHULTZ & WYNNE, P.A. 4523 OFFICE PARK DRIVE JACKSON, MS 39206 P: 601-982-3313 F: 601-982-7685				
LANDSCAPE CHRISTIAN PREUS LANDSCAPE ARCH 1011 DESOTO STREET OCEAN SPRINGS, MS 39564 P: 855-539-5086	ITECTURE					

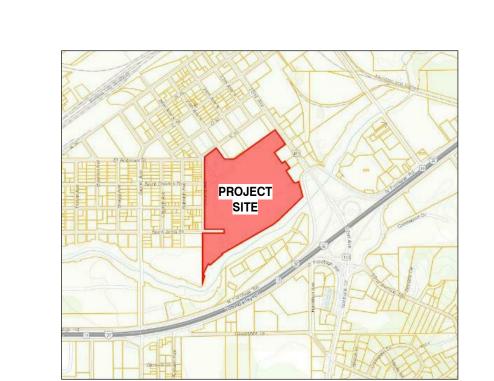

muniment and the second

F: 228-539-7990

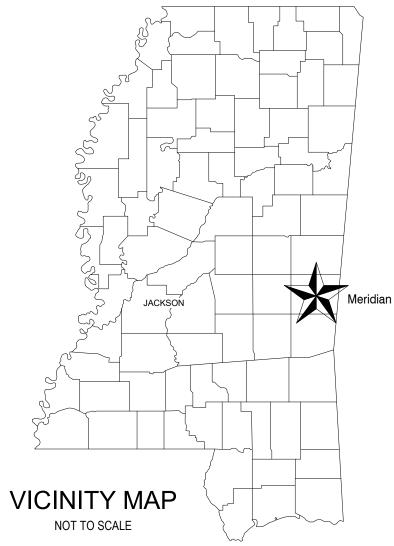

ARCHITECTURAL ABBREVIATIONS:

ACT ADD'M AFF	ACOUSTICAL CEILING TILE ADDENDUM ABOVE FINISHED FLOOR	LBS LAM	POUNDS LAMINATE OR LAMINATED
ALUM ANOD ARCH	ALUMINUM ANODIZED ARCHITECTURAL	MAX MECH MIN MO	MAXIMUM MECHANICAL MINIMUM
BD BLKG	BOARD BLOCKING	MTD	MASONRY OPENING MOUNTED
BLDG CER	BUILDING CERAMIC	NIC NO NOM	NOT IN CONTRACT NUMBER NOMINAL
CMU COL CONC	CONCRETE MASONRY UNIT COLUMN CONCRETE	OC OD	ON CENTER OUTSIDE DIAMETER
CJ CONST	CONTROL JOINT CONSTRUCTION	Р	PLASTIC
CONT	CONTINUOUS DETAIL	PARA PART PL	PARAGRAPH PARTITION PLATE OR PLATED
DWGS EA	DRAWINGS EACH	PLYWD PSF PSI	PLYWOOD POUNDS PER SQUARE FOOT POUNDS PER SQUARE INCH
EJ ELEC ELEV	EXPANSION JOINT ELECTRICAL ELEVATION	PTD PTDD	PAINTED PAPER TOWEL DISPENSER AND/OR DISPOSAL
EQ EW	EQUAL EACH WAY	PVC	POLYCINYL CHLORIDE
EWC EXIST EXP	ELECTRIC WATER COOLER EXISTING EXPANSION	R RAG RB	RADIUS RETURN AIR GRILLE RUBBER BASE
EXT FD	EXTERIOR FLOOR DRAIN	REF REINF REQ'D	REFRIGERATOR REINFORCING REQUIRED
FE FEC FIN	FIRE EXTINGUISHER FIRE EXTINGUISHER CABINET FINISHED	RT S	RUBBER THRESHOLD SILL
FL	FLOOR	SCWD SHT SIM	SOLID CORE WOOD DOOR SHEET SIMILAR
GALV GB	GALVANIZED GRAB BAR	SQFT SS	SQUARE FEET STAINLESS STEEL
GYP H	GYPSUM HEAD	STRUCT SUP SUSP	STRUCTURAL SUPPLEMENTAL SUSPENDED
HCWD HM HORIZ	HOLLOW CORE WOOD DOOR HOLLOW METAL HORIZONTAL	THKNS TPH	THICKNESS TOILET PAPER HOLDER
HT HVAC	HEIGHT HEATING, VENTILATION, AND AIR CONDITIONING	TRTD TYP	TREATED TYPICAL
INSUL INT	INSULATION INTERIOR	VCT VERT VWC	VINYL COMPOSITION TILE VERTICAL VINYL WALL COVERING
J JT	JAMB JOINT	W/ WD WT	WITH WOOD WEIGHT

ARCHITECTURAL NOTES:

- 1. CONTRACTOR SHALL VISIT THE SITE AND THOROUGHLY FAMILIARIZE HIMSELF WITH ALL EXISTING CONDITIONS, INCLUDING EXISTING UTILITY LOCATIONS, TO DETERMINE THE SCOPE AND NATURE OF THE WORK NECESSARY FOR THE COMPLETION OF THE PROJECT.
- 2. THE CONTRACTOR SHALL CAREFULLY REVIEW ALL DRAWINGS, SPECIFICATIONS AND ANY ADDENDA FOR THE PROJECT TO DETERMINE THE COMPLETE SCOPE AND NATURE OF THE WORK TO BE PERFORMED. ANY QUESTIONS OR DISCREPANCIES AS TO THE NATURE OR INTENT OF THE WORK TO BE PERFORMED SHALL BE DIRECTED TO THE ARCHITECT PRIOR TO BIDDING FOR A DETERMINATION OF WORK REQUIRED. UNLESS STATED OTHERWISE BY THE ARCHITECT. WHERE A CONFLICT OR DISCREPANCY EXISTS, THE MOST COSTLY OR MOST STRINGENT CONDITION SHALL APPLY.
- 3. CONTRACTOR SHALL COORDINATE THE WORK SCHEDULE AND INTERRUPTION OF UTILITIES FOR THE PROJECT WITH THE OWNER TO MINIMIZE DISRUPTION OF ACTIVITIES AND FUNCTIONS.
- 4. THE CONTRACTOR SHALL EXERCISE CARE AND TAKE APPROPRIATE PRECAUTIONARY MEASURES TO PREVENT ANY DAMAGE TO THE EXISTING STRUCTURES, SIDEWALKS, UTILITIES, COMMUNICATIONS, ETC., DURING THE PROJECT. THE CONTRACTOR SHALL CORRECT ALL DAMAGE CAUSED BY OR DURING THE PROJECT. CONTRACTOR SHALL BE RESPONSIBLE FOR CONTACTING ANY REQUIRED AGENCIES OR UTILITIES AND FOLLOWING APPLICABLE PROCEDURES PRIOR TO ANY EXCAVATION.
- 5. CONTRACTOR SHALL FIELD VERIFY ALL DIMENSIONS AND EXISTING CONDITIONS PRIOR TO ORDERING MATERIALS AND COMMENCING WORK. 6. THE CONTRACTOR SHALL ENSURE THAT HIS EQUIPMENT AND MATERIALS ARE STORED IN A SAFE AND SECURE MANNER IN AN AREA DESIGNATED BY THE OWNER, AND SHALL ENSURE THAT ALL WORK BE PERFORMED IN ACCORDANCE WITH SAFETY REGULATIONS AND SAFE STANDARDS OF PRACTICE FOR THE SAFETY OF THE WORKERS AND USERS OF THE BUILDING DURING THE PROJECT.
- 7. NOT EVERY CONDITION HAS BEEN DETAILED. WHERE SPECIFIC DETAILING IS NOT SHOWN, CONTACT ARCHITECT FOR INSTRUCTIONS. THEN, EXECUTE THE CONSTRUCTION IN A SOUND, WORKMANLIKE MANNER CONSISTENT WITH ACCEPTED BUILDING PRACTICES AND OTHER DETAILING SHOWN. 8. WHERE STANDARD DETAILS ARE SHOWN TO BE TYPICAL, THEY SHALL BE CONSIDERED TO BE APPLICABLE IN ALL SIMILAR CONDITIONS UNLESS
- OTHERWISE NOTED. 9. ALL WORK SHALL BE IN ACCORDANCE WITH THE REQUIREMENTS OF THE AMERICANS WITH DISABILITIES ACT AND APPLICABLE BUILDING CODES, FIRE
- 10. ALL WORK AREAS SHALL BE LEFT CLEAN & PRESENTABLE UPON COMPLETION OF THE WORK DAY. DAILY CLEANUP REQUIRED IN AREAS OF DAILY ACTIVITY. CONTRACTOR SHALL REMOVE ALL TRASH AND DEBRIS FROM THE PROJECT SITE AS NEEDED AND SHALL PERFORM FINAL CLEANUP UPON

PROJECT DATA:

NUMBER OF STORIES

HEIGHT OF BUILDING

BUILDING AREA

ALLOWED: ACTUAL:

ALLOWED:

ACTUAL:

PROJECT DESCRIPTION TH A 1,922 SF LDING. THIS WILL

RENOVATIONS AND ADDITIONS TO AN EXISTING 28,409 SF SINGLE STORY BUILDING WIT ADDITION AT THE REAR INCLUDING SITEWORK AND PARKING SURROUNDING THE BUILD BE THE NEW LAUDERDALE COUNTY PUBLIC SAFETY BUILDING.				
B4 - REGIONAL BUSINESS DISTRICT 30'-0" 10'-0" 0'-0" 50'-0" 90% (OF TOTAL SITE AREA)				
TYPE IIB, S1 - SPRINKLERED				
MIXED OCCUPANCY B (BUSINESS) / STORAGE (S-1) ACCESSORY OCCUPANCY: R-1				
250 FEET				

3-STORIES

1-STORIES

70,000 S.F.

28,409 S.F. (EXISTING)

75'-0"

ANEA	OCCOPANT LOAD					
SQ.FT.	LOAD FACTOR CALCULATED LOAD					
ACCESSOR	Y STORAGE ARE	A / MECHANICA	L ROOM			
5520 SF						33
ASSEMBLY	- CONCENTRATI	ED (CHAIRS ONL	Y / NOT FIXED)			
1701 SF	7					244
ASSEMBLY	- FIXED SEATING	3				
411 SF	0					27
ASSEMBLY	- UNCONCENTR	ATED (TABLES A	ND CHAIRS)			
1868 SF	15					129
BUSINESS	AREAS - 2018					
8299 SF	150					83
EDUCATION	AL - SHOPS / VO	CATIONAL ROO	MS			
1671 SF	50					34
INDUSTRIAI	AREAS	1				
1341 SF	100					14
LOCKER RO	OMS					
588 SF	50					13
PARKING G	ARAGES					
2288 SF	200					12
RESIDENTIA	AL					
190 SF	200					1
23877 SF	1				TOTAL OCCUPANTS:	590
REQUIRED	EXIT WIDTH / FL	.OOR:	FIRST	FLOOR	590 OCC. *.2 = 118"	
			DEGLUDED	400 004 050	(DU 1011)	00 05)
NUMBER O	F PARKING SPA	CES:	REQUIRED: PROPOSED:	102 SPACES	(BUSINESS USE / 1 PER 3	00 SF)
				6 SPACES		
			TOTAL:	145 SPACES		
			LL STRUCTURAL			
				HE APPLICABLE	BUILDING CODE	
			EAMS OOF/CEILING		0 WALLS0 ROOF COVERING	
			SHAFT ENCLOSUI	RES	N/A STAIR ENCLOSURE	=
	IT SEPARATIONS		OHAI I LIVOLOGOI	INLO	IVA OTAIR ENGLOSSIE	_
	PANCY SEPARA					
_	R SYSTEM TYPE	-	YES			
STANDPIPE SYSTEM -			YES			
FIRE/ SMOR	KE ALARM SYST	⊏IVI -	YES			

LIFE SAFETY LOAD CALCULATIONS

OCCUPANT LOAD



ARCHITECTURE • INTERIOR DESIGN PLANNING O CONSTRUCTION MANAGEMENT

	244		
	27		
	129		
	83		
	34		
	14		
	13		
	12		
PANTS:	1 590		
2 = 118"			
/ 1 PER 300) SF)		
DE ERING			
ICLOSURE			

SHEET	{INDEX OF DRAWINGS}	REVISION	REVISION
NUMBER 01 - COVER SHEE CVR	SHEET NAME T COVER SHEET	NUMBER 2	04/30/2021
02 - LIFE SAFETY LS101 03 - CIVIL	LIFE SAFETY PLAN	1	04/26/2021
C1.0 C100	EXISTING SITE SURVEY OVERALL EXISTING SITE AND DEMOLITION PLAN		
C101 C102 C103	EXISTING SITE AND DEMOLITION PLAN - PUBLIC SAFETY BUILDING EXISTING SITE AND DEMOLITION PLAN - COURTHOUSE EXISTING SITE AND DEMOLITION PLAN - ENTRY DRIVE		
C200 C201 C202	OVERALL SITE PLAN SITE PLAN - PUBLIC SAFETY BUILDING SITE PLAN - COURTHOUSE	1	04/26/2021
C300 C301 C302	OVERALL GRADING AND DRAINAGE PLAN GRADING AND DRAINAGE PLAN - PUBLIC SAFETY BUILDING GRADING AND DRAINAGE PLAN - COURTHOUSE	1 1	04/26/2021 04/26/2021 04/26/2021
C303 C400	EROSION AND SEDIMENTATION CONTROL PLAN OVERALL UTILITY PLAN	1	04/26/2021
C401 C402 C500	UTILITY PLAN - PUBLIC SAFETY BUILDING UTILITY PLAN - COURTHOUSE SITE DETAILS	1	04/26/2021
C501 C502 C503	SITE DETAILS SITE DETAILS SITE DETAILS	1	04/26/2021
3.1- LANDSCAPE I-100	IRRIGATION PLAN FOR LAUDERDALE PUBLIC SAFETY BUILDING	1	04/26/2021
I-101 L-100 L-101	IRRIGATION DETAILS FOR LAUDERDALE PUBLIC SAFETY BUILDING LANDSCAPE PLAN FOR LAUDERDALE PUBLIC SAFETY BUILDING LANDSCAPE DETAILS FOR LAUDERDALE PUBLIC SAFETY BUILDING	1 1 1	04/26/2021 04/26/2021 04/26/2021
04 - ARCHITECTUR A000 A001	GENERAL NOTES AND ACCESSIBILITY DETAILS UL DESCRIPTIONS		
A002 A003	UL DESCRIPTIONS WALL TYPES	2	04/30/2021
A100 A100A A100D	SITE PLAN SITE PLAN - ALTERNATES DEMOLITION ROOF PLAN	2	04/26/2021 04/30/2021
A101 A101A	FIRST FLOOR PLAN FIRST FLOOR PLAN - ALTERNATES	1 2	04/26/2021 04/30/2021
A102 A102A A103	DIMENSION FLOOR PLAN DIMENSION FLOOR PLAN - ALTERNATES MEZZANINE PLAN	2	04/26/2021 04/30/2021
A103A A104 A104A	MEZZANINE PLAN - ALTERNATES ROOF PLAN ROOF PLAN - ALTERNATES	2 2 2	04/30/2021 04/30/2021 04/30/2021
A105 A105A	REFLECTED CEILING PLAN & DETAILS REFLECTED CEILING PLAN & DETAILS - ALTERNATES	1 2	04/26/2021 04/30/2021
A201 A201A A202	EXTERIOR ELEVATIONS EXTERIOR ELEVATIONS - ALTERNATES 3D VIEWS	2	04/30/2021
A301 A302 A311	BUILDING SECTIONS BUILDING SECTIONS WALL SECTIONS	1	04/26/2021
A312 A401	WALL SECTIONS ENLARGED PLANS	1	04/26/2021
A402 A501 A511	ENLARGED PLANS PLAN DETAILS SECTION DETAILS	1	04/26/2021
A611 A611A	OPENING SCHEDULE OPENING SCHEDULE - ALTERNATES	2 2	04/30/2021 04/30/2021
A631 A701 A801	HJS DETAILS INTERIOR ELEVATIONS MILLWORK DETAILS	1	04/26/2021
F101 F101A 05 - STRUCTURAL	INTERIOR FINISH PLAN - ALTERNATES	2	04/26/2021 04/30/2021
S100 S101	STRUCTURAL GENERAL NOTES FOUNDATION AND FLOOR FRAMING PLAN	2	04/30/2021
S102 S103 S104	LEMA ROOF FRAMING PLAN ROOF FRAMING PLAN SITE WALL PLAN	2 2 2	04/30/2021 04/30/2021 04/30/2021
S201 S202 S301	FOUNDATION DETAILS FOUNDATION DETAILS CMU WALL AND STEEL DETAILS	1	04/26/2021
S302 S303	CMU WALL AND STEEL DETAILS CMU WALL AND STEEL DETAILS	1	04/26/2021
S304 06 - PLUMBING P001	CMU WALL AND STEEL DETAILS PLUMBING LEGEND, ABBREVIATIONS AND SYMBOLS		
P101 P102	FLOOR PLAN - BELOW FLOOR PLUMBING FLOOR PLAN - PLUMBING SANITARY	2 2	04/30/2021 04/30/2021
P103 P104A P105A	FLOOR PLAN - PLUMBING SUPPLY FLOOR PLAN - BELOW FLOOR PLUMBING - ALTERNATES FLOOR PLAN - PLUMBING SANITARY ALTERNATES	2 2 2	04/30/2021 04/30/2021 04/30/2021
P106A P301 P302	FLOOR PLAN - PLUMBING SUPPLY - ALTERNATES PLUMBING DETAILS PLUMBING RISERS	2	04/30/2021
P303 P401	PLUMBING RISERS PLUMBING SCHEDULES		
07 - FIRE PROTEC FP101 FP102A	FLOOR PLAN - FIRE PROTECTION FLOOR PLAN - FIRE PROTECTION - ALTERNATES	2 2	04/30/2021 04/30/2021
FP401 08 - MECHANICAL M001	FIRE PROTECTION DETAILS AND SCHEDULES HVAC LEGENDS, ABBREVIATIONS AND NOTES	2	04/30/2021
M100 M101	OVERALL FLOOR PLAN - HVAC FIRST FLOOR HVAC PLAN - PART 'A'	1 2	04/26/2021 04/30/2021
M102 M103 M104	FIRST FLOOR HVAC PLAN - PART 'B' FIRST FLOOR HVAC PLAN - PART 'C' FIRST FLOOR HVAC PLAN - PART 'D'	1	04/26/2021
M105 M106 M107	MEZZANINE HVAC FLOOR PLAN ROOF PLAN - HVAC FIRST FLOOR HVAC THERMOSTAT PLAN - PART 'A'	2 1 2	04/30/2021 04/26/2021 04/30/2021
M108 M109	FIRST FLOOR HVAC THERMOSTAT PLAN - PART 'B' FIRST FLOOR HVAC THERMOSTAT PLAN - PART 'C'	1	04/26/2021
M110 M111A M112A	FIRST FLOOR HVAC THERMOSTAT PLAN - PART 'D' FIRST FLOOR HVAC PLAN - PART "A" - ALT 4 FIRST FLOOR HVAC PLAN - PART "C" - ALT 4	2 2	04/30/2021 04/30/2021
M113A M114A M115A	FIRST FLOOR HVAC THERMOSTAT PLAN - PART "A" - ALT 4 FIRST FLOOR HVAC THERMOSTAT PLAN - PART "C" - ALT 4 MEZZANINE HVAC FLOOR PLAN - ALT 4	2 2 2	04/30/2021 04/30/2021
M116A M501	ROOF PLAN HVAC - ALT 4 HVAC DETAILS	2 2	04/30/2021
M601 M602 M701	HVAC SCHEDULES HVAC SCHEDULES HVAC CONTROLS	2 2	04/30/2021 04/30/2021
M702 M703 09 - ELECTRICAL	HVAC CONTROLS HVAC CONTROLS		
E001 E002	ELECTRICAL SYMBOLS LEGEND ELECTRICAL SCHEDULES AND DETAILS	1	04/26/2021 04/26/2021
E101A E101R E201R	ELECTRICAL SITE PLAN LIGHTING, POWER & COMM. SYSTEMS ELECTRICAL SITE PLAN LIGHTING, POWER AND COMMUNICATION SYSTEMS ELECTRICAL FLOOR PLAN LIGHTING SYSTEMS	2 1 1	04/30/2021 04/26/2021 04/26/2021
E202R E203R	ELECTRICAL FLOOR PLAN POWER SYSTEMS ELECTRICAL FLOOR PLAN SPECIAL SYSTEMS	1	04/26/2021 04/26/2021
E204R E205R E206A	ELECTRICAL FLOOR PLAN COMMUNICATION SYSTEMS ELECTRICAL FLOOR PLAN SAFETY AND SECURITY SYSTEMS ELECTRICAL FLOOR PLANS ALTERNATE BID MEZZANINE LEVEL	1 1 2	04/26/2021 04/26/2021 04/30/2021
E206R E207A E208A	ELECTRICAL FLOOR PLANS MEZZANINE LEVEL ELECTRICAL FLOOR PLAN ALTERNATE BID ADDITIONAL WORK LIGHTING SYSTEMS ELECTRICAL FLOOR PLAN ALTERNATE BID ADDITIONAL WORK POWER SYSTEMS	1 2 2	04/26/2021 04/30/2021 04/30/2021
E209A E301R	ELECTRICAL FLOOR PLAN ALTERNATE BID ADDITIONAL WORK TELECOMM. & SPECIAL SYSTEMS ELECTRICAL POWER RISER DIAGRAM AND DETAILS	2 1	04/30/2021 04/26/2021
E302R E303A E303R	ELECTRICAL SCHEDULES ELECTRICAL SCHEDULES ELECTRICAL SCHEDULES	1 2 1	04/26/2021 04/30/2021 04/26/2021
E401R	TELECOMMUNICATIONS WIRING DIAGRAM AND DETAILS	1	04/26/2021

SHEETS IN THE SET: 128





PROJECT ADDRESS:





ACTIVE DESIGN PHASE FOR REVIEW ONLY FOR PERMITTING ONLY SCHEMATIC DESIGN DESIGN DEVELOPMENT CONSTRUCTION BIDDING CONSTRUCTION DOCUMENTS AS-BUILT RECORD SET



REVISIONS/SUBMISSIONS				
NO.	DATE	DESCRIPTION		
1	04/26/2021	ADDENDUM #2		
2	04/30/2021	ADDENDUM #3		
	I			
SHEET	TITLE			
	COV	/ED QUEET		
	CO	/ER SHEET		

PROJECT NO.:

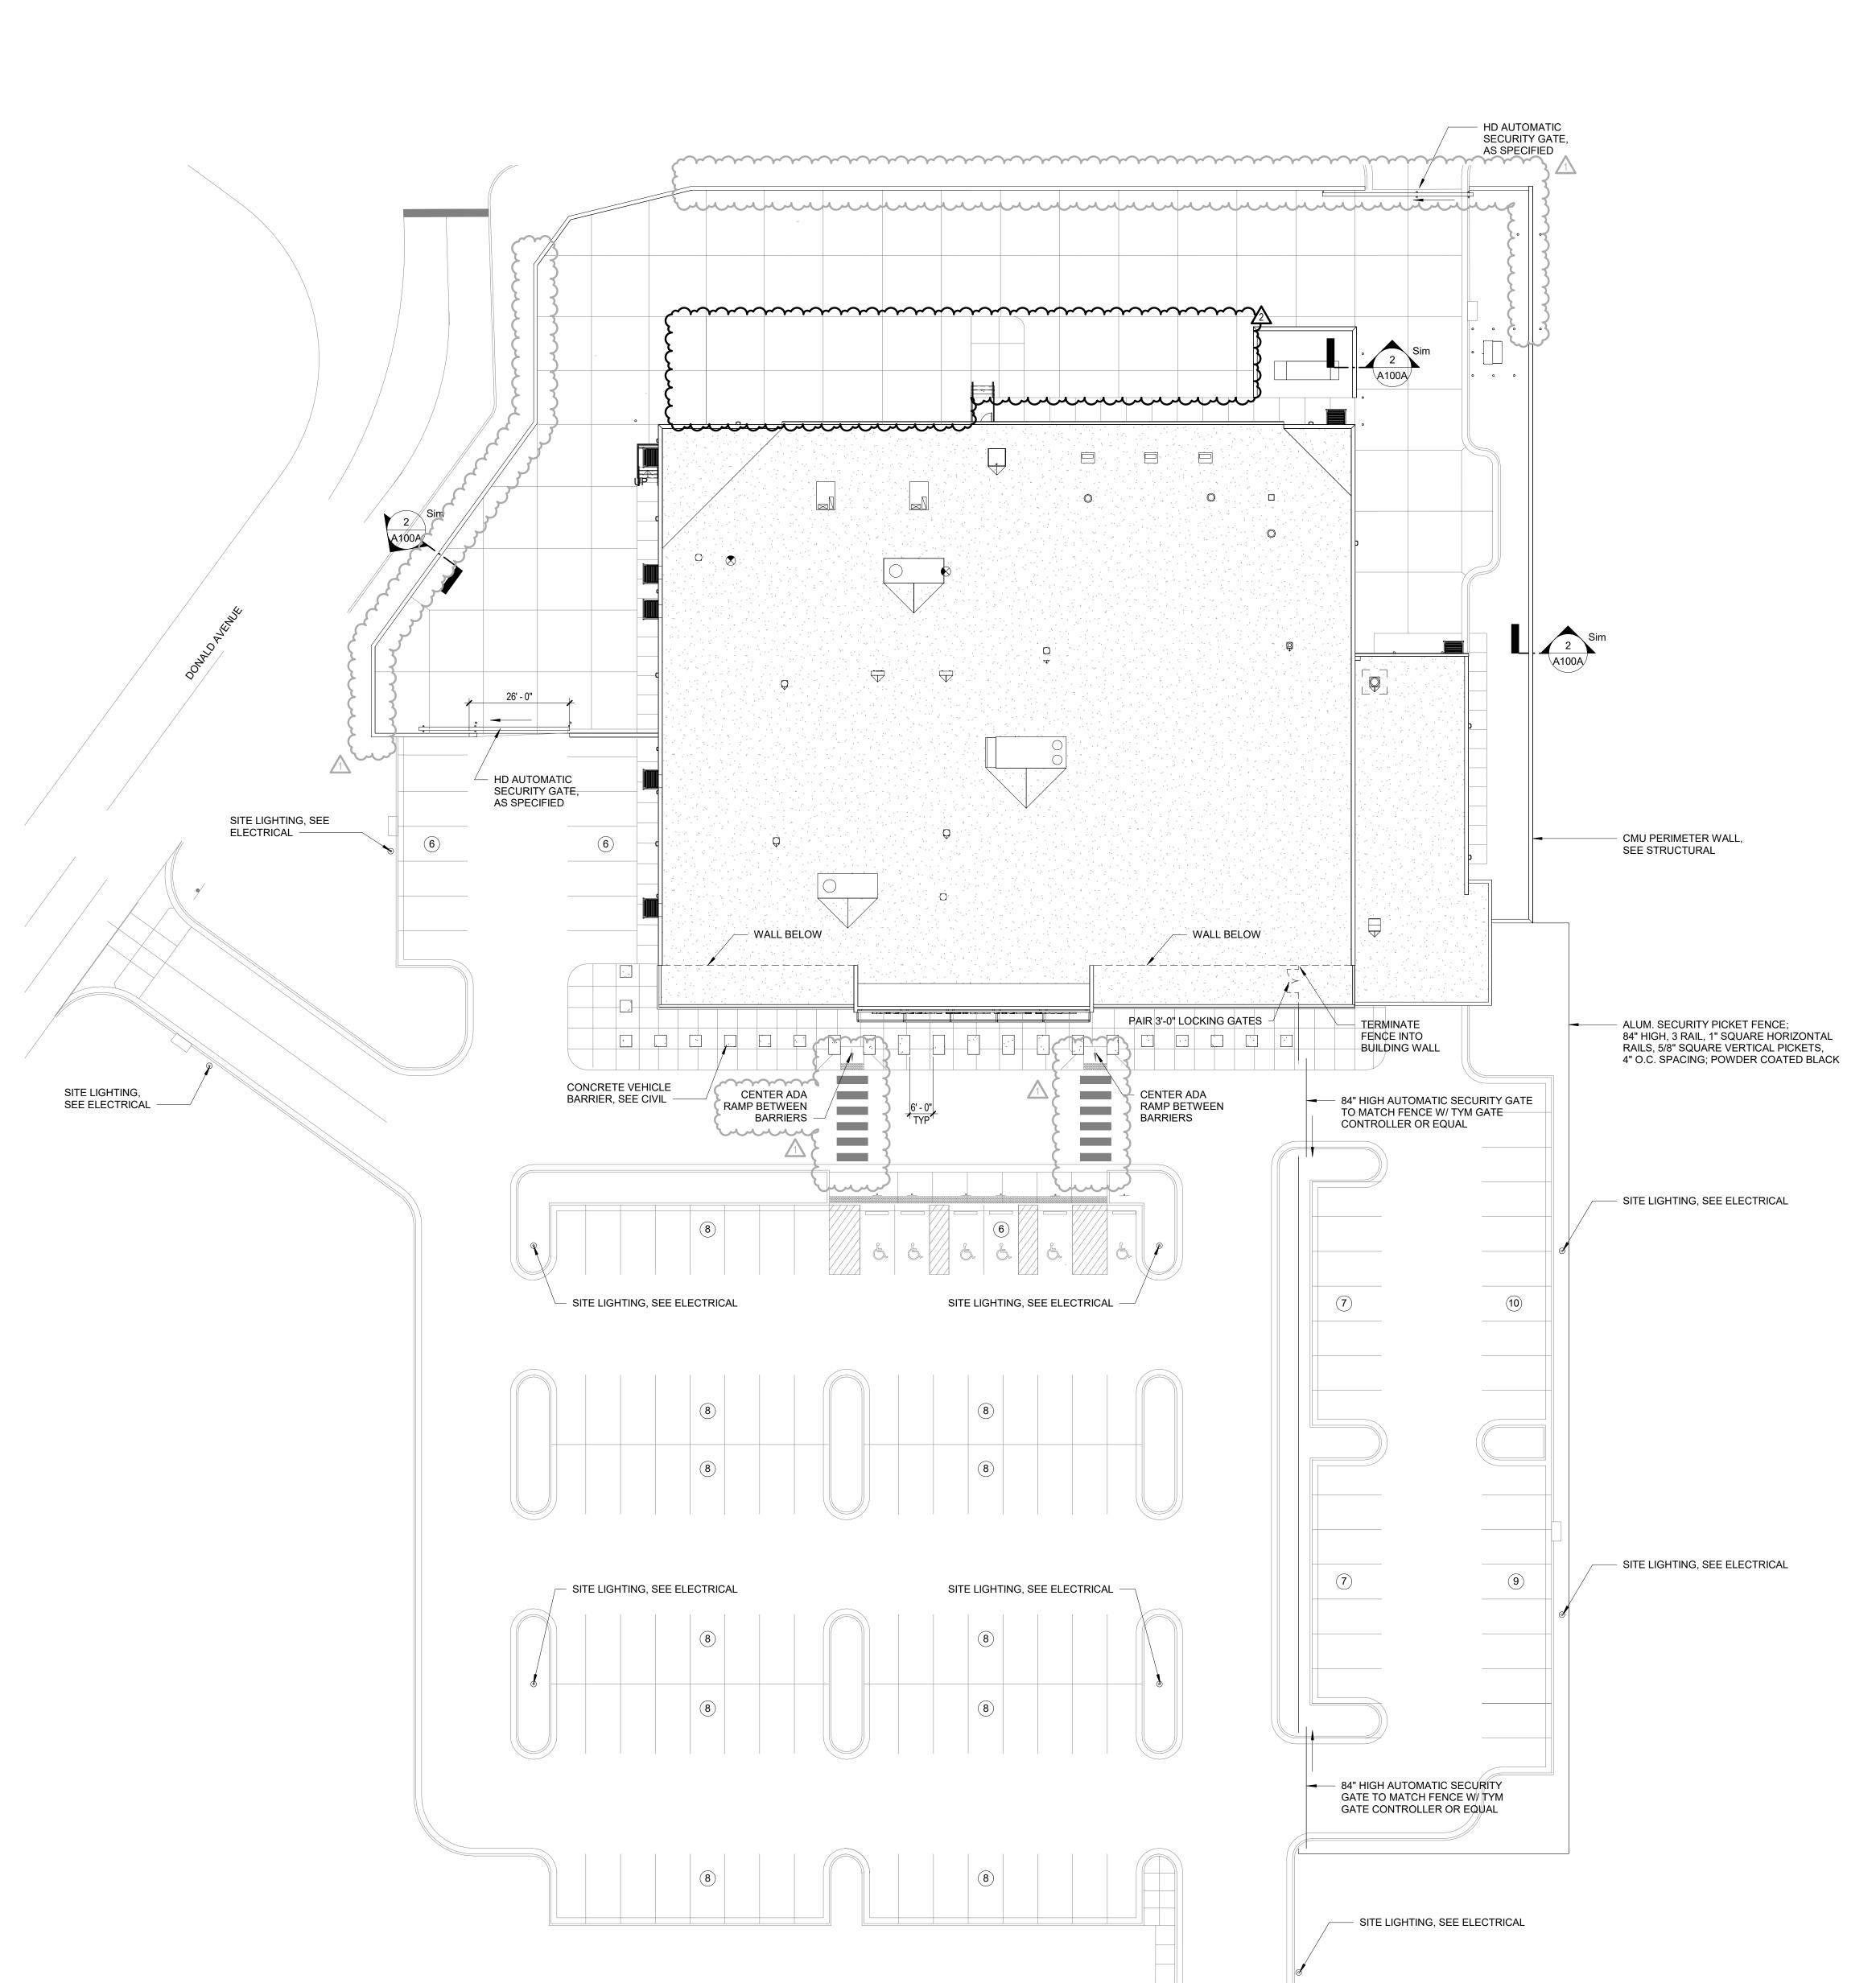

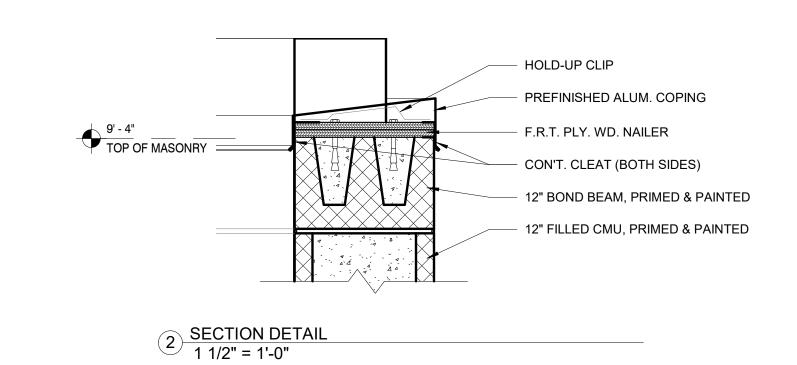



LPK ARCHITECTS, P.A.

Robert E. Luke, Architect

821 22ND AVENUE P.O. BOX 630
MERIDIAN, MISSISSIPPI 38302
P: 601.693.9990
F: 601.693.8640

ese documents are the sole property of LPK Architects P.A. and are not to reused. Any erations, revisions or reuse of these documents without the written consent of LPK Architects P.I I result in all sureties and responsibilities for the entire project becoming null and void. pyright 2021 LPK Architects, P.A.



Lauderdale County
Public Safety Building

PROJECT ADDRESS:

Village Fair Mall Site 612 22nd Avenue (Winn-Dixie / LabCorp Building)

YATES CONSTRUCTION

KEY PLAN

ACTIVE DESIGN PHASE

FOR REVIEW ONLY
FOR PERMITTING ONLY
SCHEMATIC DESIGN
DESIGN DEVELOPMENT

CONSTRUCTION BIDDING
CONSTRUCTION DOCUMENTS
AS-BUILT RECORD SET

SEAL



	REVISION	IS/SUBMISSIONS
NO.	DATE	DESCRIPTION
1	04/26/2021	ADDENDUM #2
2	04/30/2021	ADDENDUM #3

SHEET TITLE
SITE PLAN - ALTERNATES


PROJECT NO.:

SHEET ISSUED:

03/18/2021

SHEET NO.

BUILDING TRUE NORTH

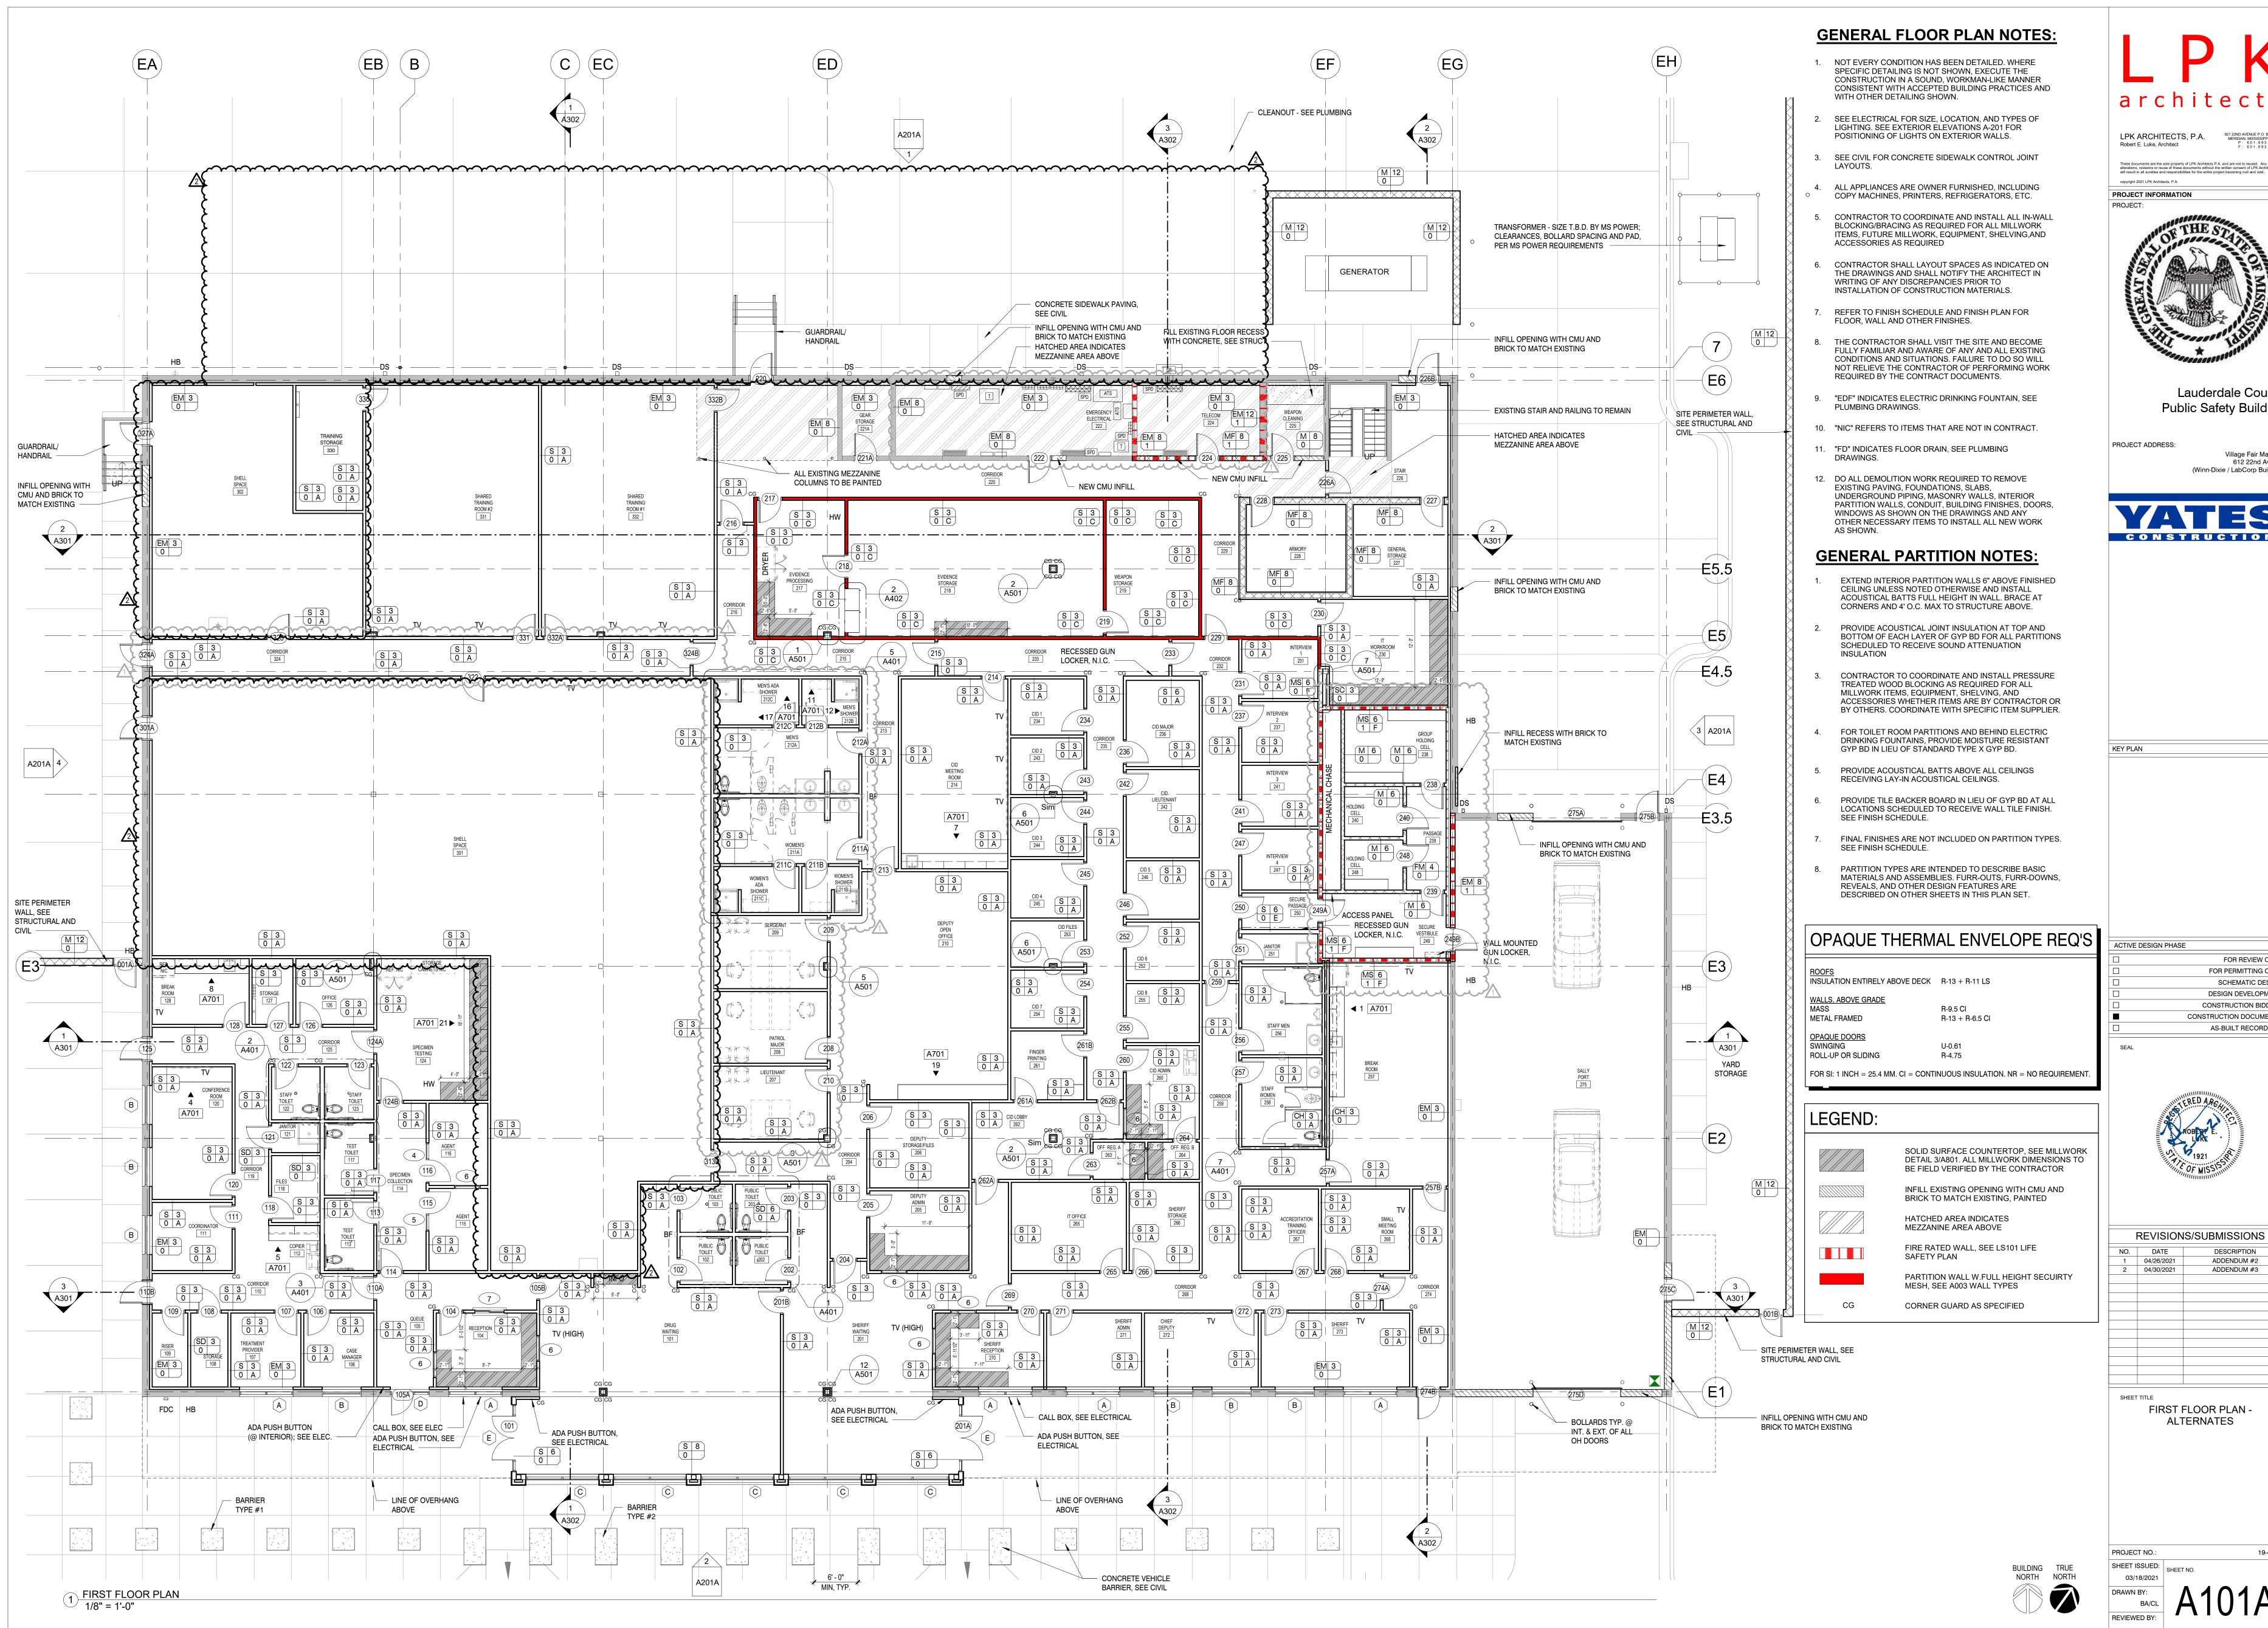

LPK ARCHITECTS, P.A.

Robert E. Luke, Architect

821 22ND AVENUE P.O. BOX 630
MERIDIAN, MISSISSIPPI 39302
P: 601.693.8940
F: 601.693.8640

These documents are the sole property of LPK Architects P.A. and are not to reused. Any alterations, revisions or reuse of these documents without the written consent of LPK Architects P.J. will result in all sureties and responsibilities for the entire project becoming null and void.



Lauderdale County Public Safety Building

Village Fair Mall Site 612 22nd Avenue (Winn-Dixie / LabCorp Building)

FOR REVIEW ONLY

FOR PERMITTING ONLY

CONSTRUCTION BIDDING

AS-BUILT RECORD SET

CONSTRUCTION DOCUMENTS

DESCRIPTION

ADDENDUM #2

ADDENDUM #3

SCHEMATIC DESIGN DESIGN DEVELOPMENT

FIRST FLOOR PLAN -ALTERNATES


PROJECT NO.:


19-4894B







REVISIONS/SUBMISSIONS							
NO.	DATE	DESCRIPTION					
1	04/26/2021	ADDENDUM #2					
2	04/30/2021	ADDENDUM #3					

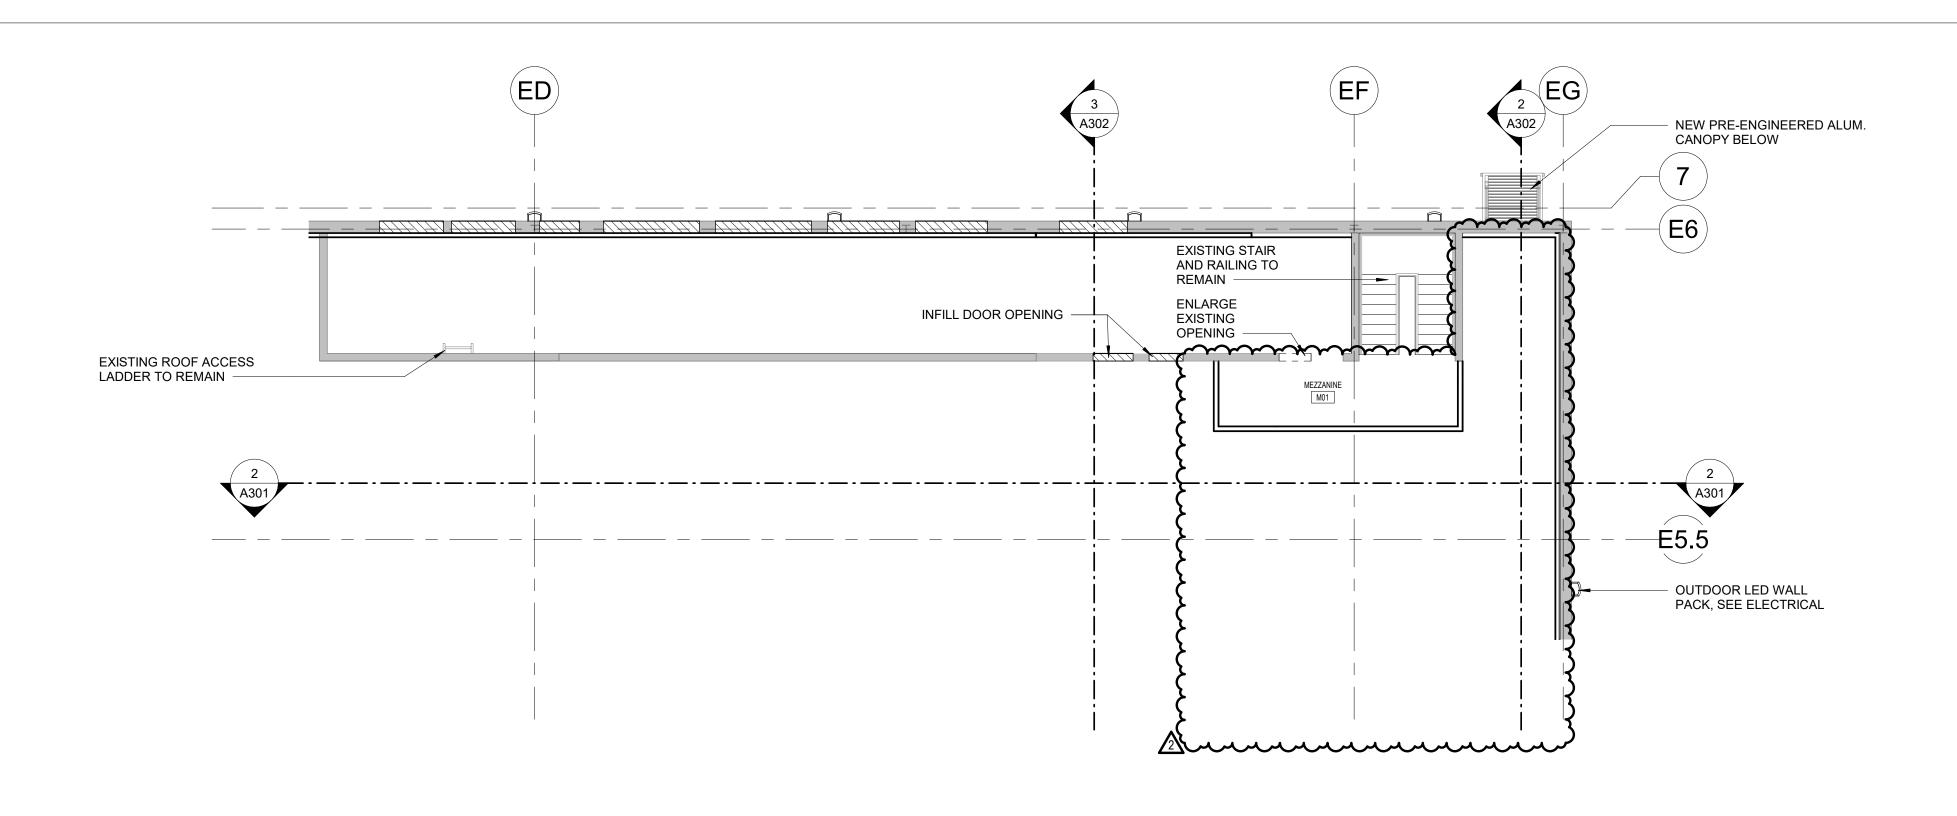

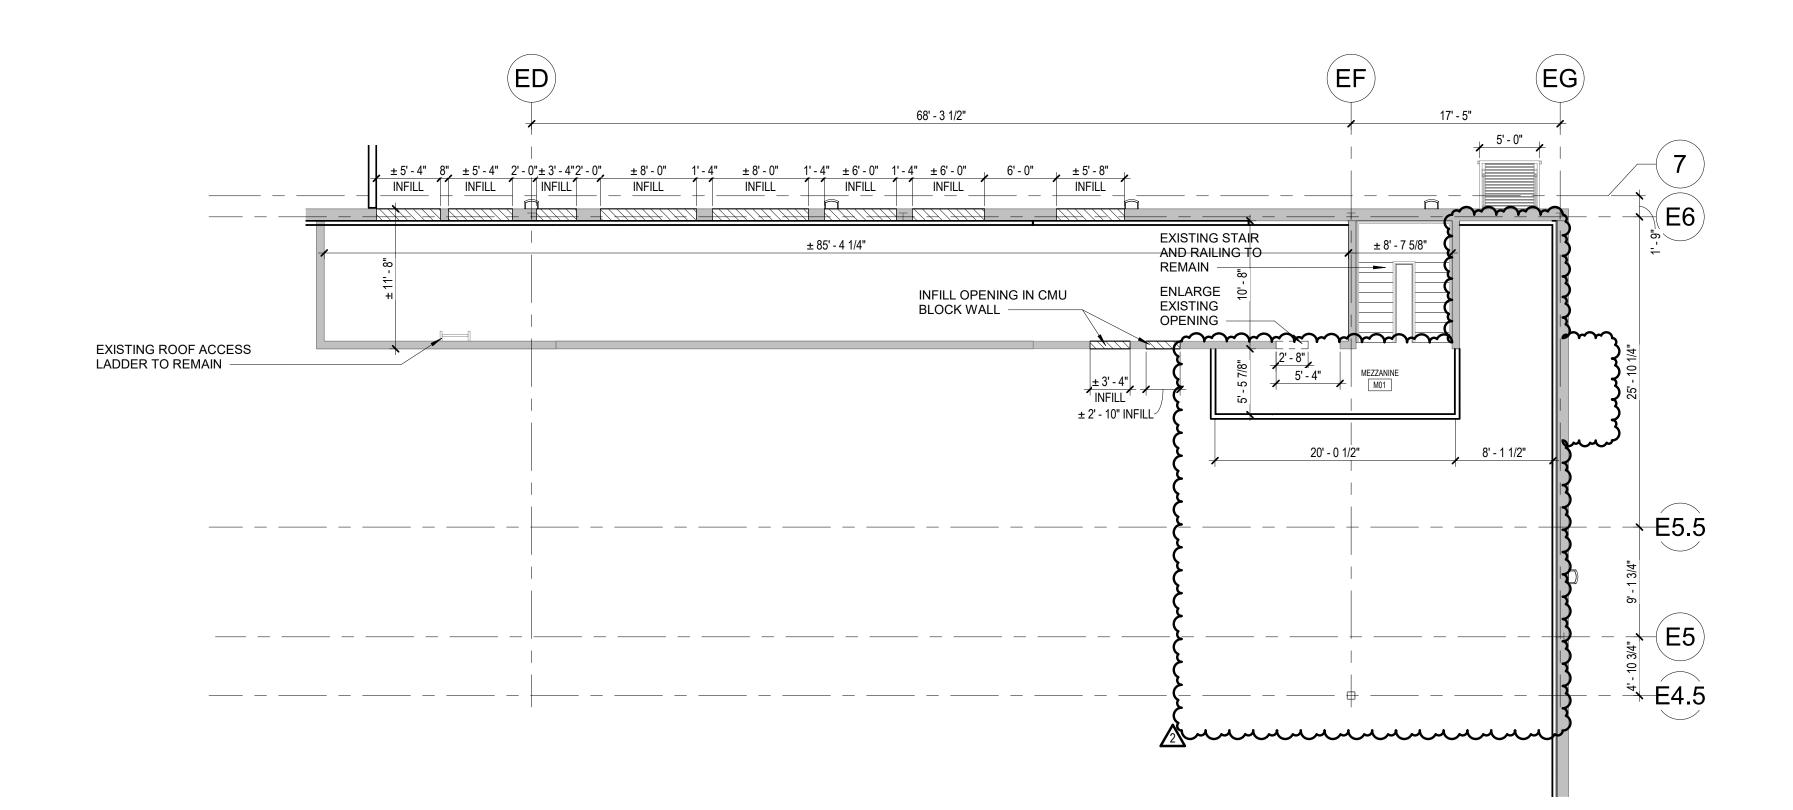

1 MEZZANINE FLOOR PLAN 1/8" = 1'-0"

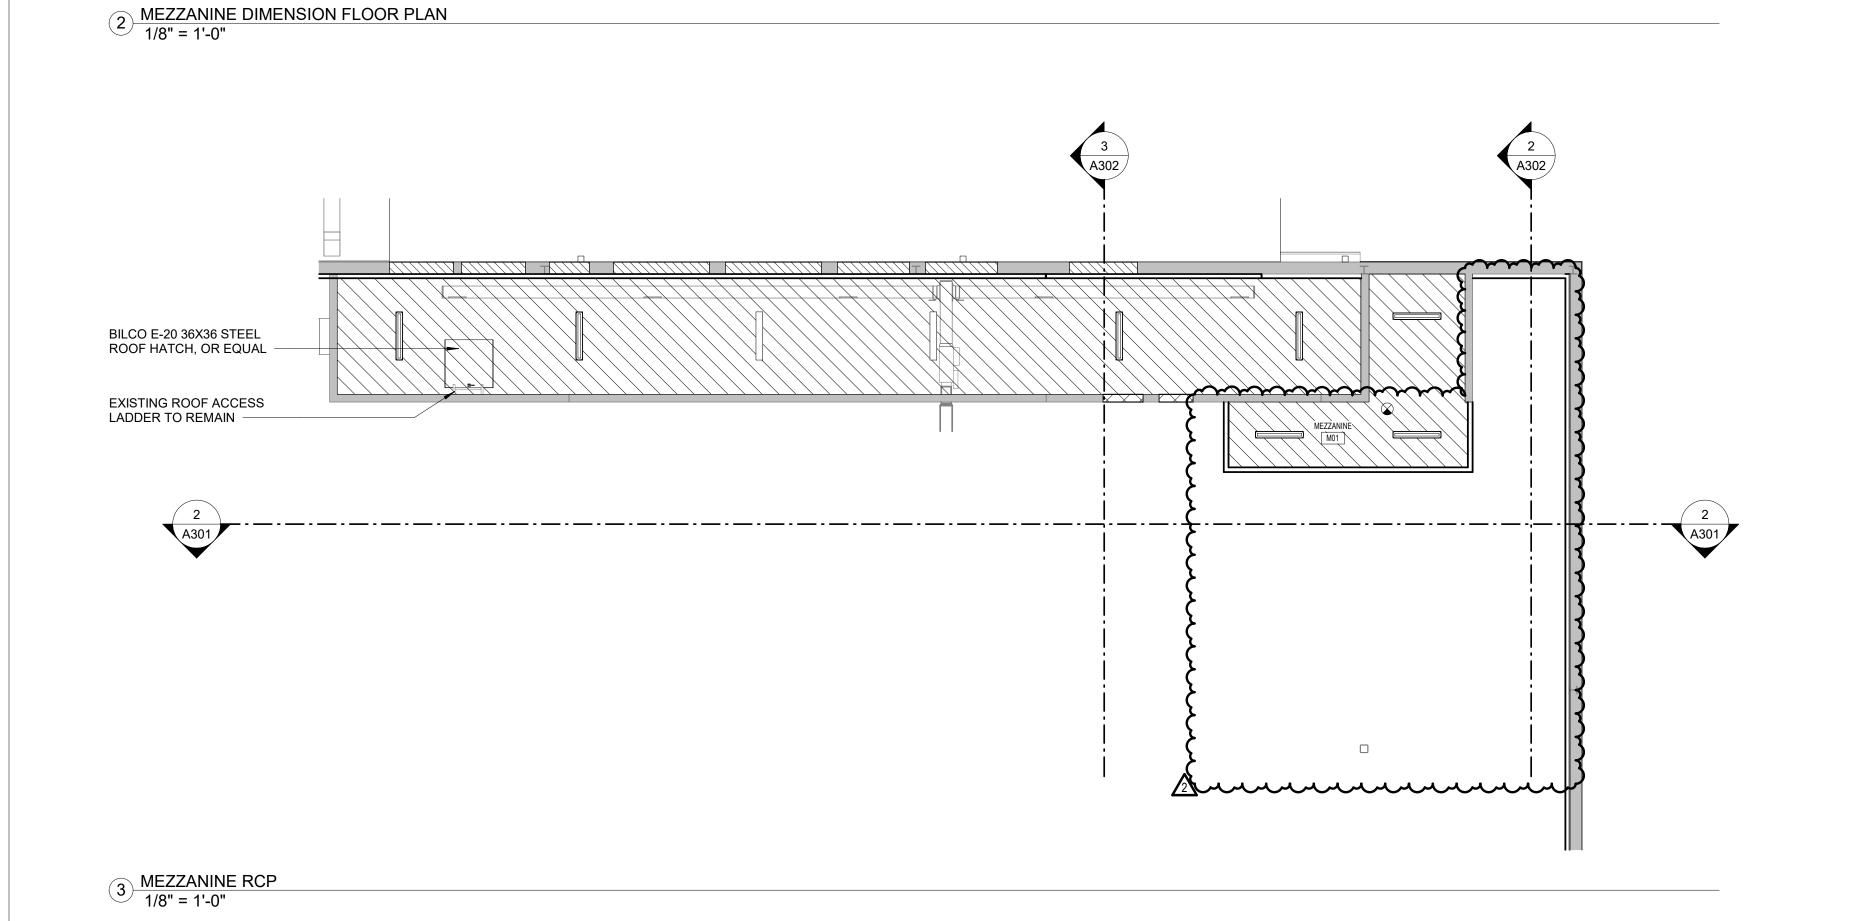

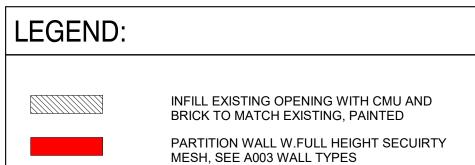

GENERAL

LAYOUTS.

 NOT EVERY Co SPECIFIC DETAIL CONSTRUCTION CONSISTENT \ WITH OTHER DETAILING SHOWN.

- SEE ELECTRICAL FOR SIZE, LOCATION, AND TYPES OF LIGHTING. SEE EXTERIOR ELEVATIONS A-201 FOR
- POSITIONING OF LIGHTS ON EXTERIOR WALLS. 3. SEE CIVIL FOR CONCRETE SIDEWALK CONTROL JOINT
- 4. ALL APPLIANCES ARE OWNER FURNISHED, INCLUDING

COPY MACHINES, PRINTERS, REFRIGERATORS, ETC.

- CONTRACTOR TO COORDINATE AND INSTALL ALL IN-WALL BLOCKING/BRACING AS REQUIRED FOR ALL MILLWORK ITEMS, FUTURE MILLWORK, EQUIPMENT, SHELVING, AND ACCESSORIES AS REQUIRED
- 6. CONTRACTOR SHALL LAYOUT SPACES AS INDICATED ON THE DRAWINGS AND SHALL NOTIFY THE ARCHITECT IN WRITING OF ANY DISCREPANCIES PRIOR TO INSTALLATION OF CONSTRUCTION MATERIALS.
- FLOOR, WALL AND OTHER FINISHES.

7. REFER TO FINISH SCHEDULE AND FINISH PLAN FOR

- 8. THE CONTRACTOR SHALL VISIT THE SITE AND BECOME FULLY FAMILIAR AND AWARE OF ANY AND ALL EXISTING CONDITIONS AND SITUATIONS. FAILURE TO DO SO WILL NOT RELIEVE THE CONTRACTOR OF PERFORMING WORK REQUIRED BY THE CONTRACT DOCUMENTS.
- 9. "EDF" INDICATES ELECTRIC DRINKING FOUNTAIN, SEE PLUMBING DRAWINGS.
- 10. "NIC" REFERS TO ITEMS THAT ARE NOT IN CONTRACT.
- 11. "FD" INDICATES FLOOR DRAIN, SEE PLUMBING DRAWINGS.
- 12. DO ALL DEMOLITION WORK REQUIRED TO REMOVE EXISTING PAVING, FOUNDATIONS, SLABS, UNDERGROUND PIPING, MASONRY WALLS, INTERIOR PARTITION WALLS, CONDUIT, BUILDING FINISHES, DOORS, WINDOWS AS SHOWN ON THE DRAWINGS AND ANY OTHER NECESSARY ITEMS TO INSTALL ALL NEW WORK AS SHOWN.

GENERAL DIMENSIONING NOTES:

- 1. ALL INTERIOR DIMENSIONS ARE TAKEN FROM FACE OF METAL STUDS UNLESS OTHERWISE NOTED.
- 2. ALL DIMENSIONS SHOWN WHICH INDICATE WINDOWS AND/OR BORROWED LITES ARE TO ROUGH OPENING OF WINDOW, UNLESS SPECIFICALLY NOTED OTHERWISE.

L FLOOR PLAN NOTES:			
CONDITION HAS BEEN DETAILED. WHERE TAILING IS NOT SHOWN, EXECUTE THE ION IN A SOUND, WORKMAN-LIKE MANNER WITH ACCEPTED BUILDING PRACTICES AND	L	P	K

LPK ARCHITECTS, P.A.

Robert E. Luke, Architect

821 22ND AVENUE P.O. BOX 630
MERIDIAN, MISSISSIPP1 38302
P: 601.693.8940
F: 601.693.8640

These documents are the sole property of LPK Architects P.A. and are not to reused. Any alterations, revisions or reuse of these documents without the written consent of LPK Architects P.F. will result in all sureties and responsibilities for the entire proiect becoming null and will copyright 2021 LPK Architects, P.A.

architects



Lauderdale County Public Safety Building

(Winn-Dixie / LabCorp Building)

PROJECT ADDRESS: Village Fair Mall Site 612 22nd Avenue



KEY PLAN

ACTIVE DESIGN PHASE

FOR REVIEW ONLY

FOR PERMITTING ONLY SCHEMATIC DESIGN

REVISIONS/SUBMISSIONS

MEZZANINE PLAN -

ALTERNATES

04/30/2021

SHEET TITLE

DESCRIPTION

ADDENDUM #3

19-4894B


DESIGN DEVELOPMENT CONSTRUCTION BIDDING CONSTRUCTION DOCUMENTS AS-BUILT RECORD SET

GENERAL CEILING PLAN NOTES:


1. CONTRACTOR TO COORDINATE WITH MECHANICAL & ELECTRICAL DRAWINGS FOR ITEMS LOCATED IN CEILINGS FOR ALL

- THE CONTRACTOR SHALL VERIFY THAT ACCESS PANELS OF APPROPRIATE SIZE & TYPE ARE INSTALLED IN GYP BD CEILINGS OR SOFFITS, AND IN OTHER NON-ACCESSIBLE TYPE CEILINGS OR SOFFITS WHERE ACCESS, SERVICE, OR ADJUSTMENT TO MECHANICAL, PLUMBING, FIRE PROTECTION, OR ELECTRICAL SYSTEMS MAY BE REQUIRED. THE CONTRACTOR SHALL TAKE SPECIAL CARE TO LOCATE ALL SYSTEM COMPONENTS, ETC. REQUIRING ACCESS ABOVE ACCESSIBLE CEILINGS. LOCATION(S) OF ALL ACCESS PANELS TO BE APPROVED BY ARCHITECT PRIOR TO
- THE CONTRACTOR SHALL ADVISE THE OWNER THAT ITEMS SHALL NOT BE PLACED OR STORED ON TOP OF SUCH SHELVING SO THAT THE CODE REQUIRED 18" VERTICAL CLEARANCE IS MAINTAINED.
- CONTRACTOR SHALL INSTALL GRID ALIGNED THROUGH DOORWAYS AND CENTERED ON CORRIDORS UNLESS NOTED OTHERWISE (UNO).
- CONTRACTOR SHALL COORDINATE CEILING HEIGHTS AND INSTALLATION OF CEILING AND ABOVE-CEILING COMPONENTS WITH ALL TRADES AND REPORT ANY CONFLICTS TO THE ARCHITECT
- 6. COORDINATE ALL CEILING COMPONENTS W/ THE ENTIRE
- 7. CONTRACTOR SHALL INSTALL SOUND ATTENUATION BLANKETS ABOVE ALL CEILINGS.
- 8. WHERE ACT UNITS LESS THAN 6" WIDE WOULD OCCUR AT EDGES OF ROOM WITH 24" X 24" PATTERN, PROVIDE 24" X 48" PANELS CUT TO EXTEND TO WALL, ELIMINATING THE TEE NEAR THE WALL.
- 9. ALL CAN LIGHTS AND SPRINKLER HEADS TO BE CENTERED WITHIN 2X2 GRID WHERE APPLICABLE.



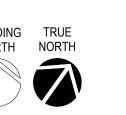

PROJECT NO.: SHEET ISSUED: SHEET NO.

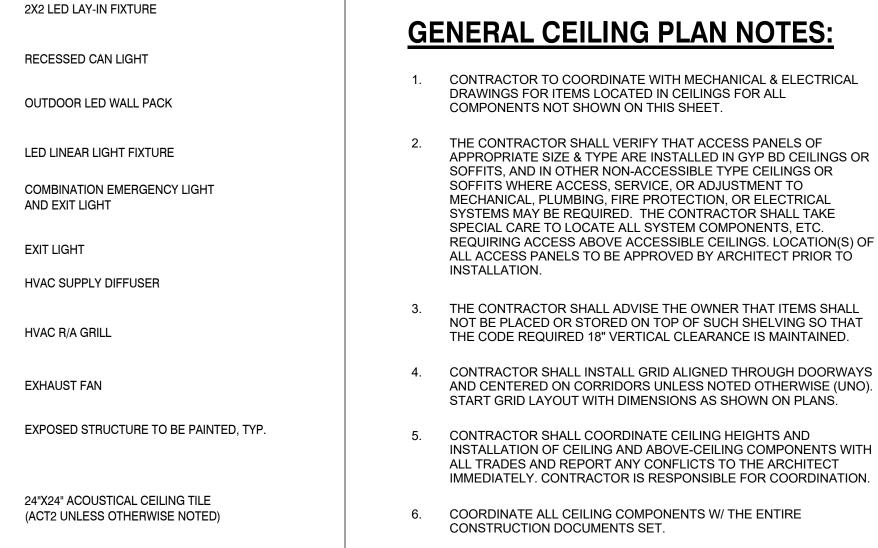


EXPOSED UNDERSIDE OF CONCRETE CAP 5/8" GYP. BD. CEILING (TO BE PAINTED P1 UNLESS NOTED OTHERWISE) PREFINISHED FLUSH SEAM ALUMINUM SOFFIT


CEILING HEIGHT UNLESS OTHERWISE NOTED

REFLECTED CEILING LEGEND


1X4 LED LAY-IN FIXTURE

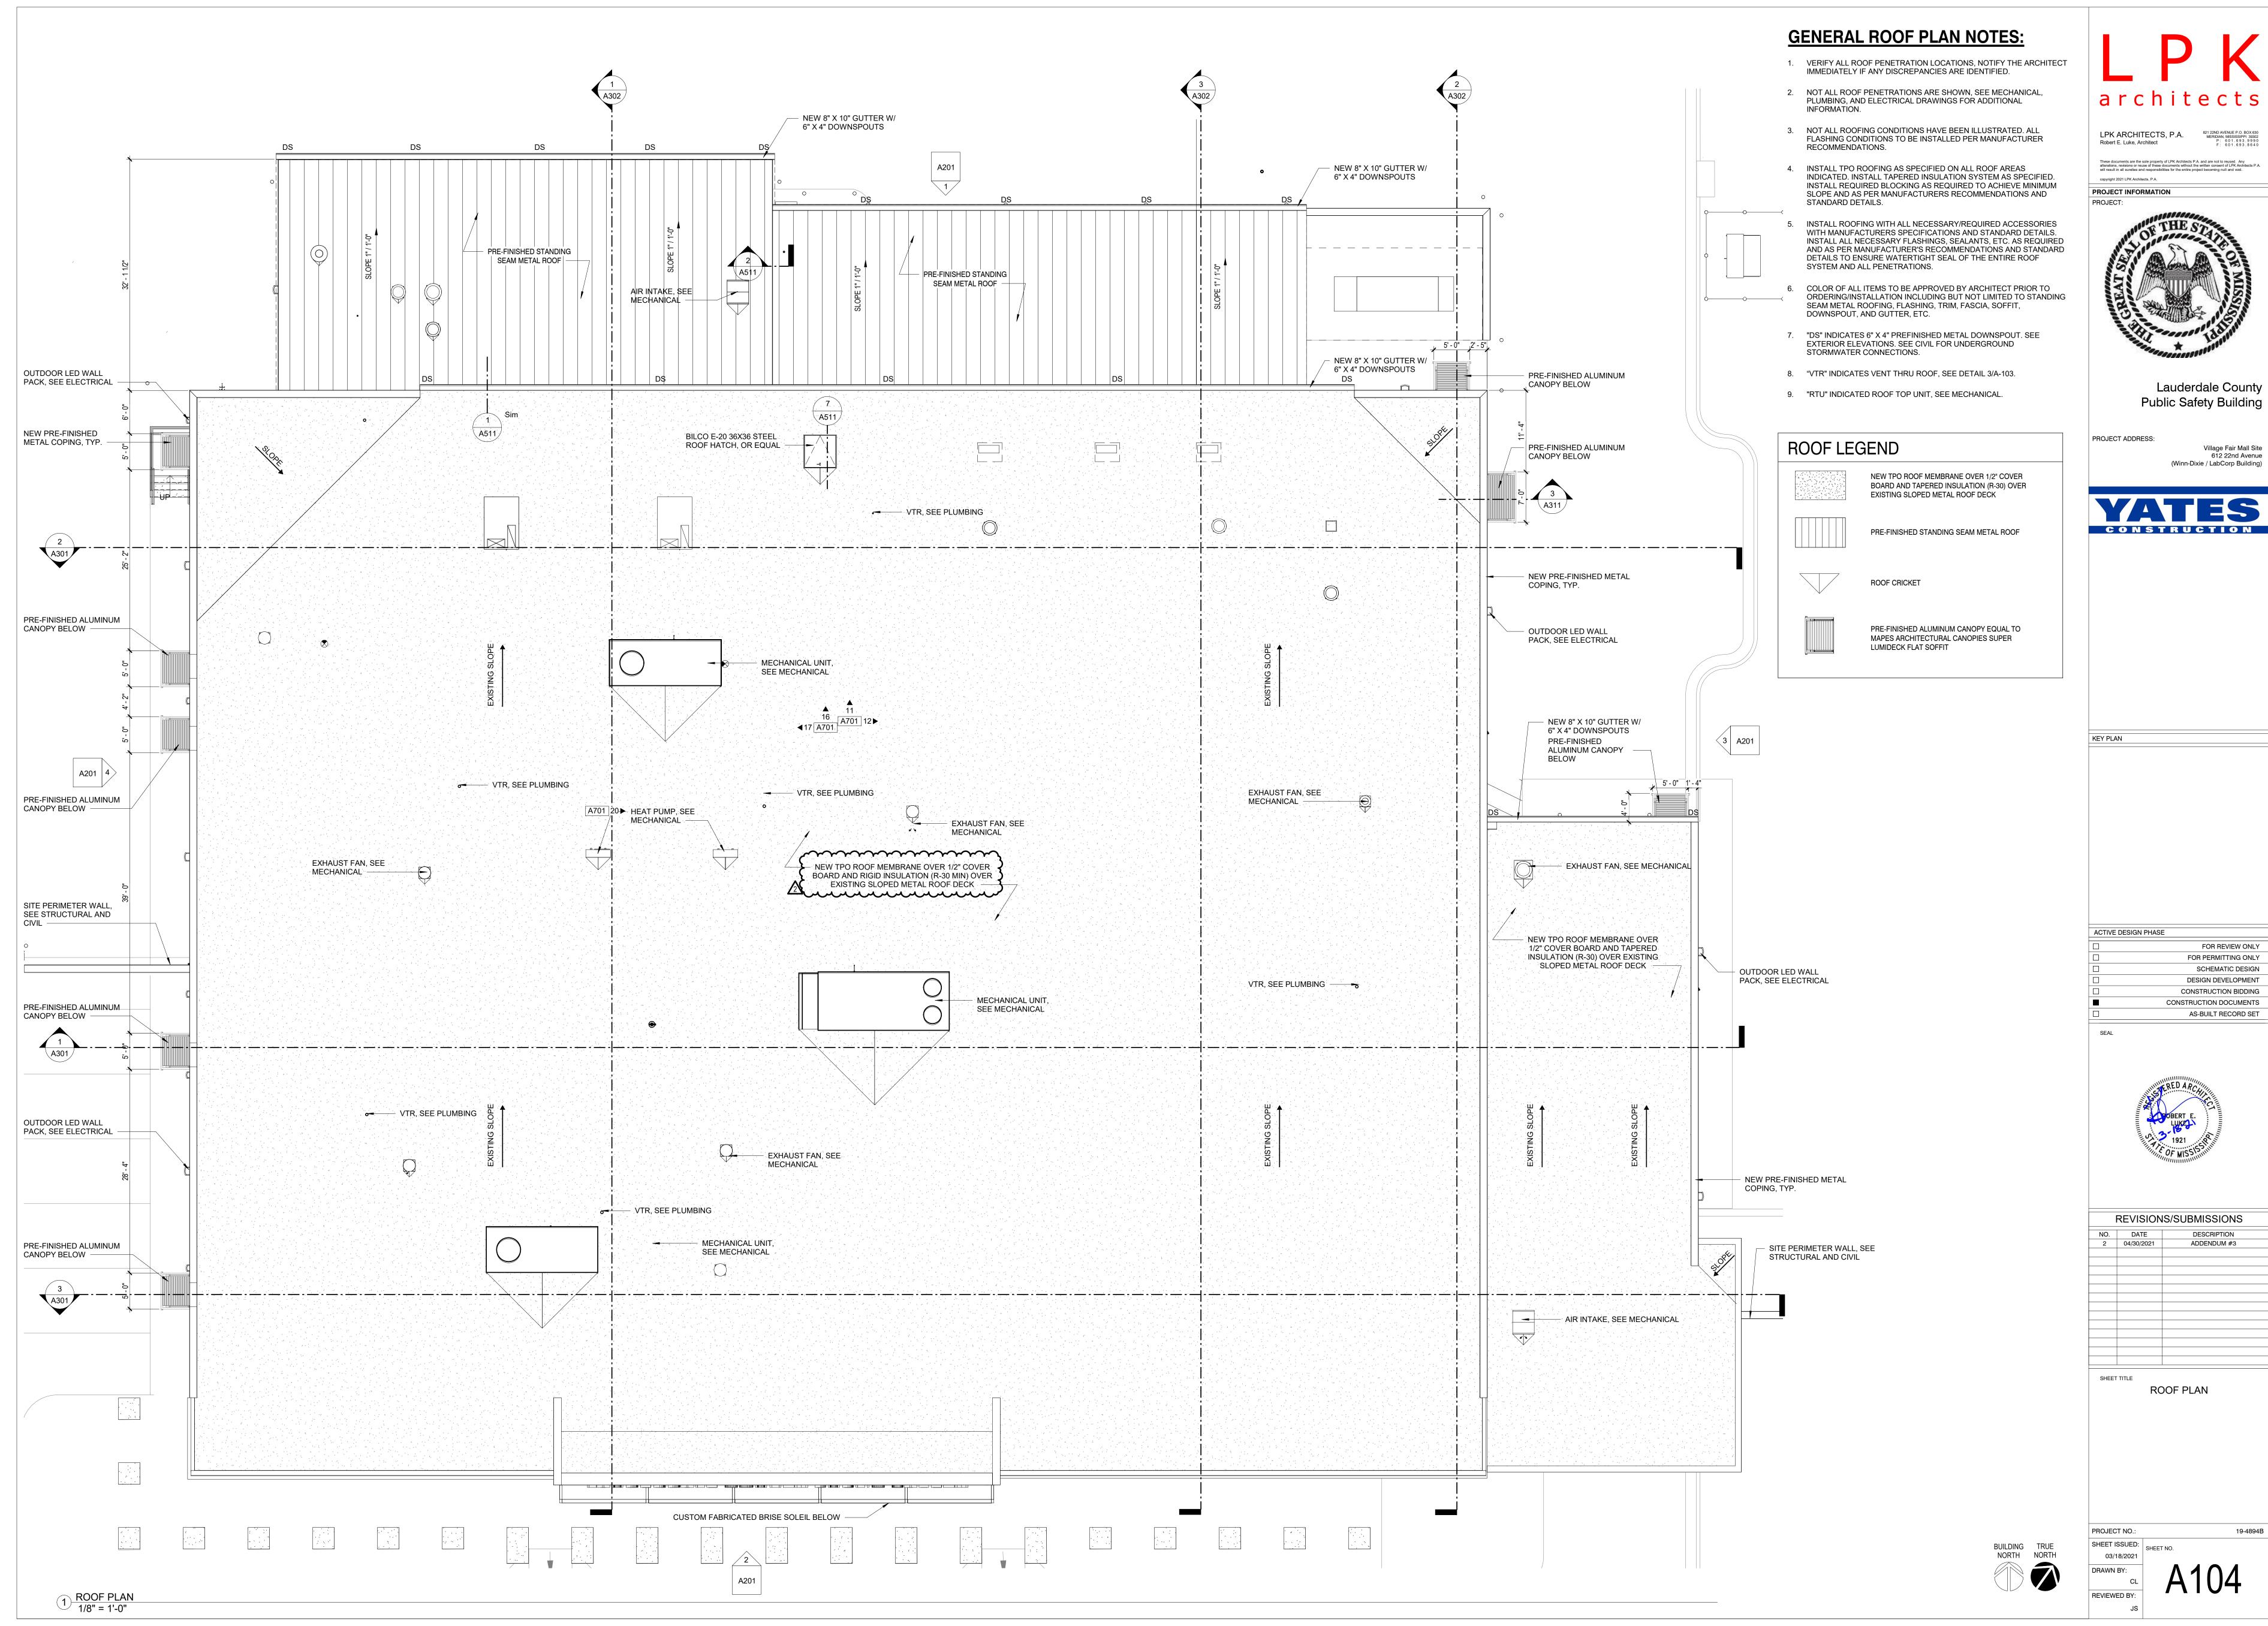

REVISIONS/SUBMISSIONS					
NO.	DATE	DESCRIPTION			
2	04/30/2021	ADDENDUM #3			
SHEET TITLE					

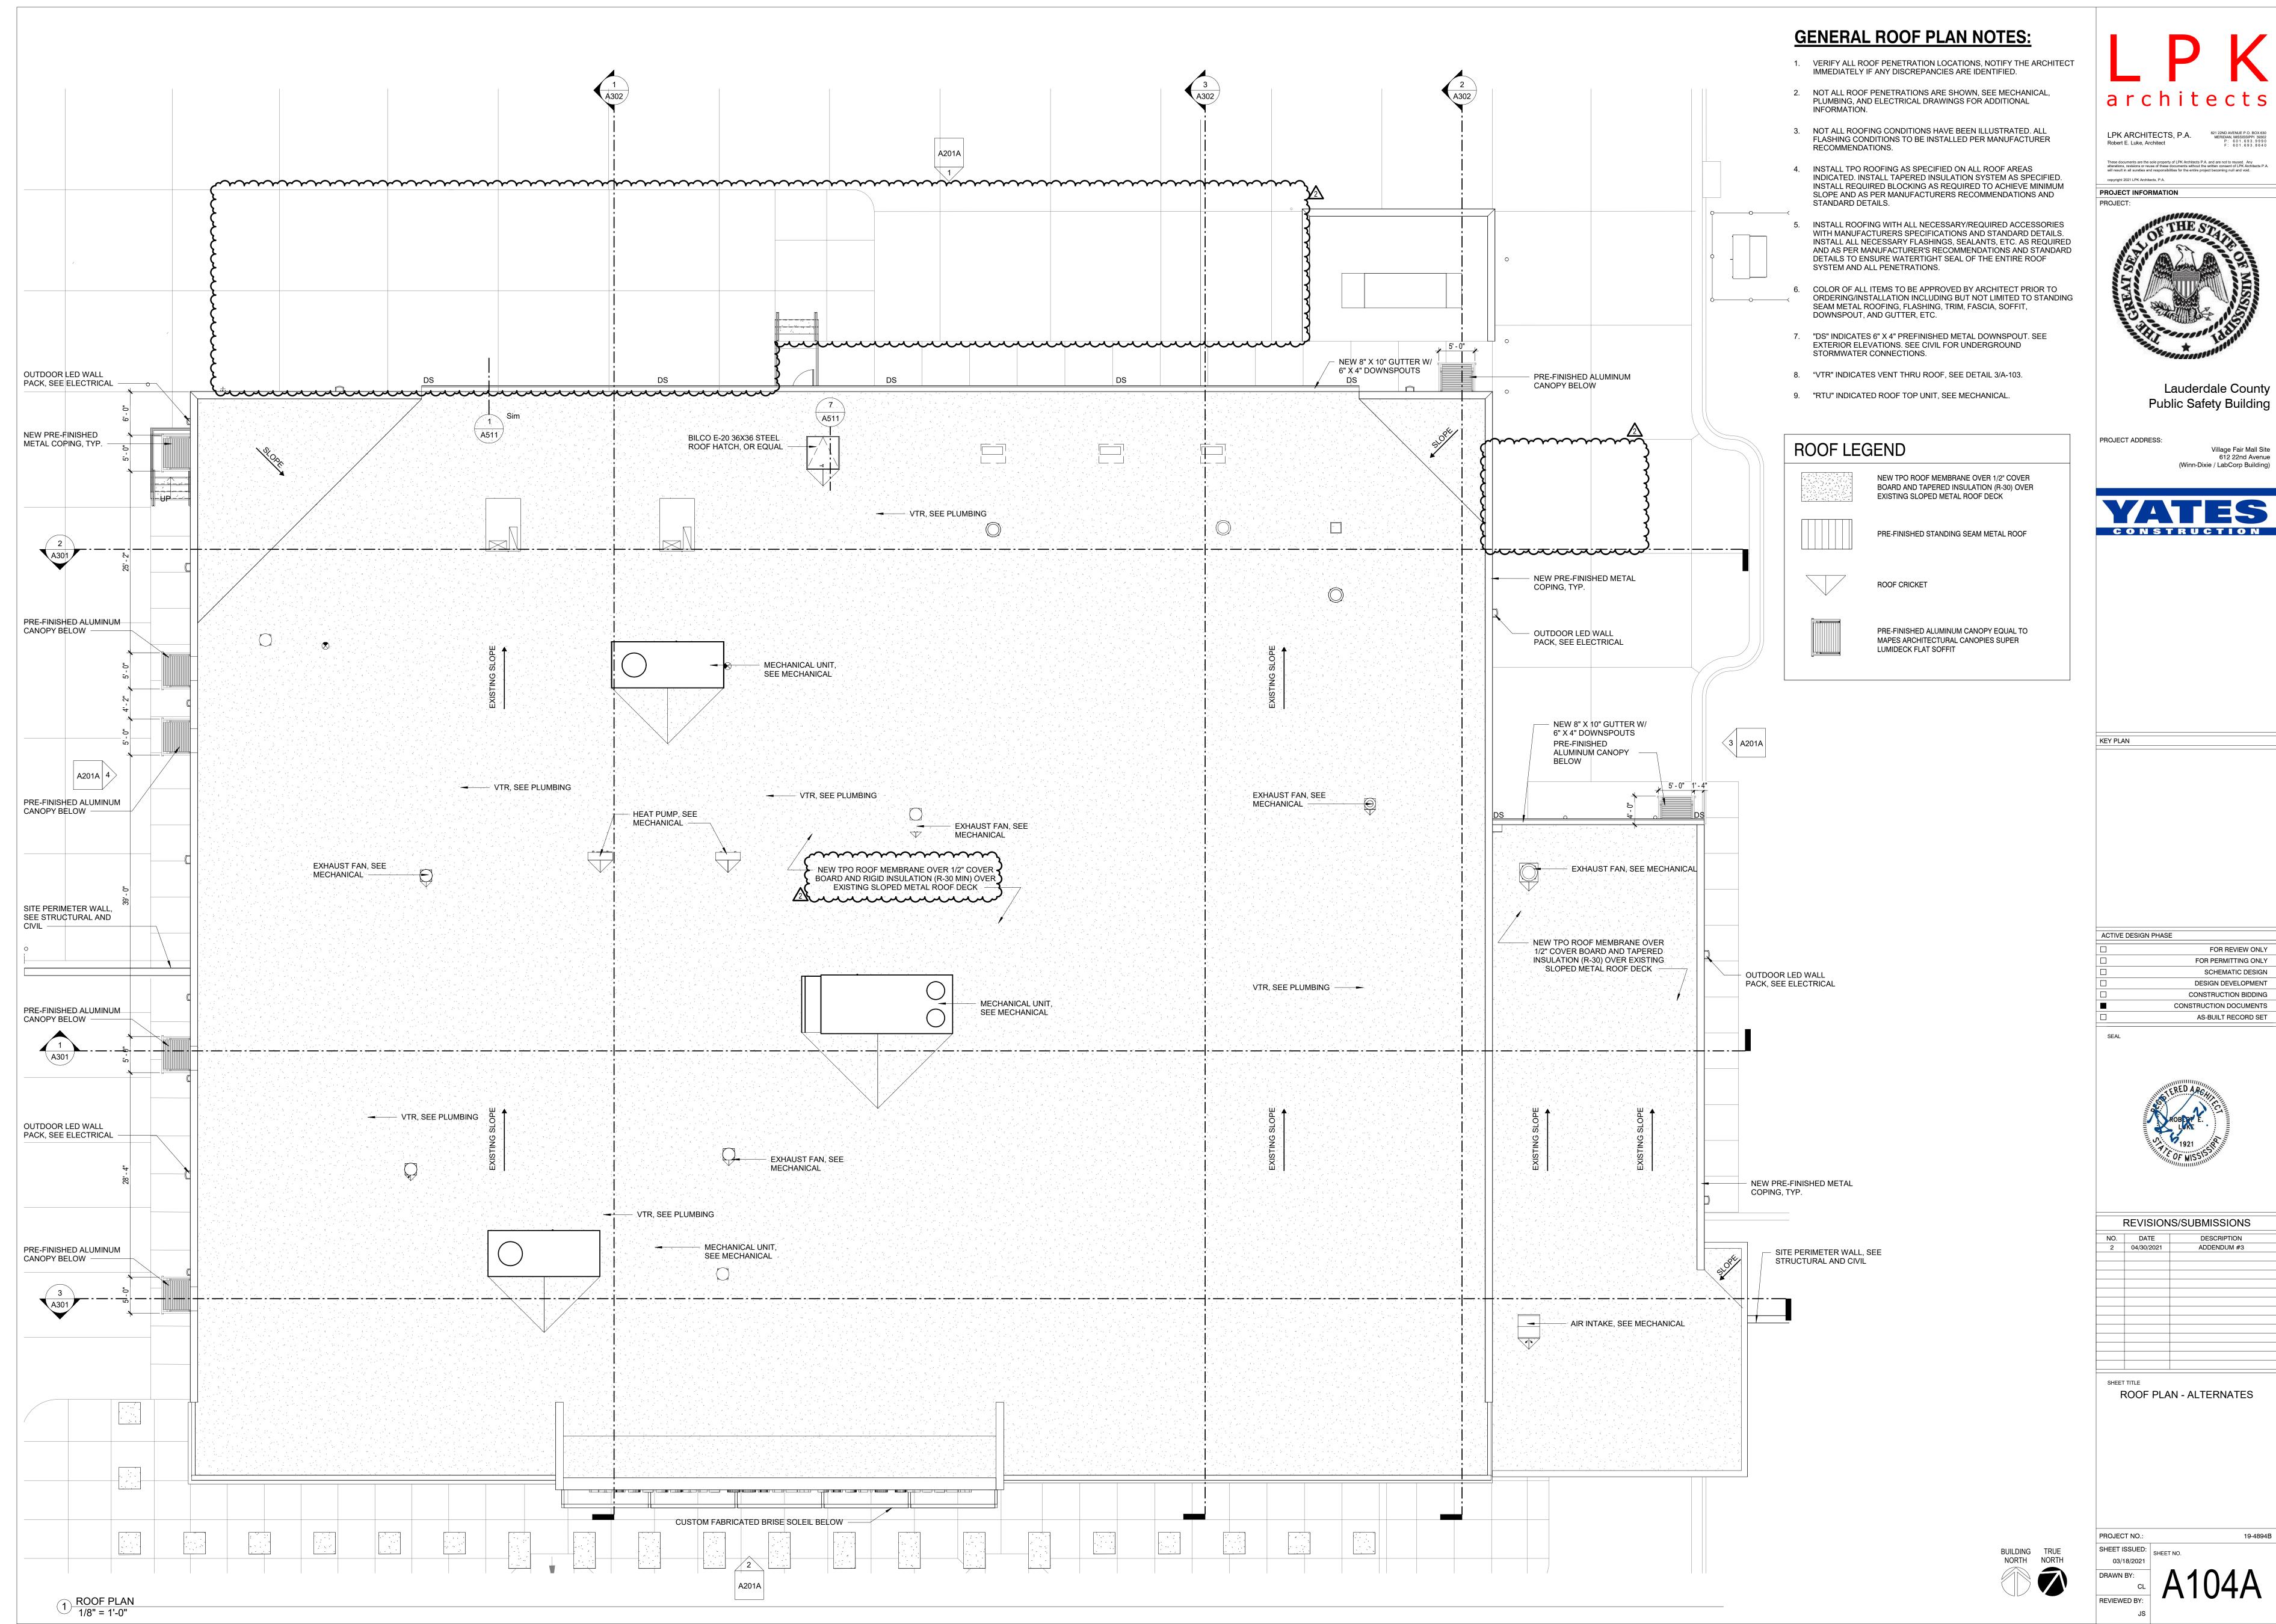

REVISIONS/SUBMISSIONS					
NO.	DATE	DESCRIPTION			
2	04/30/2021	ADDENDUM #3			

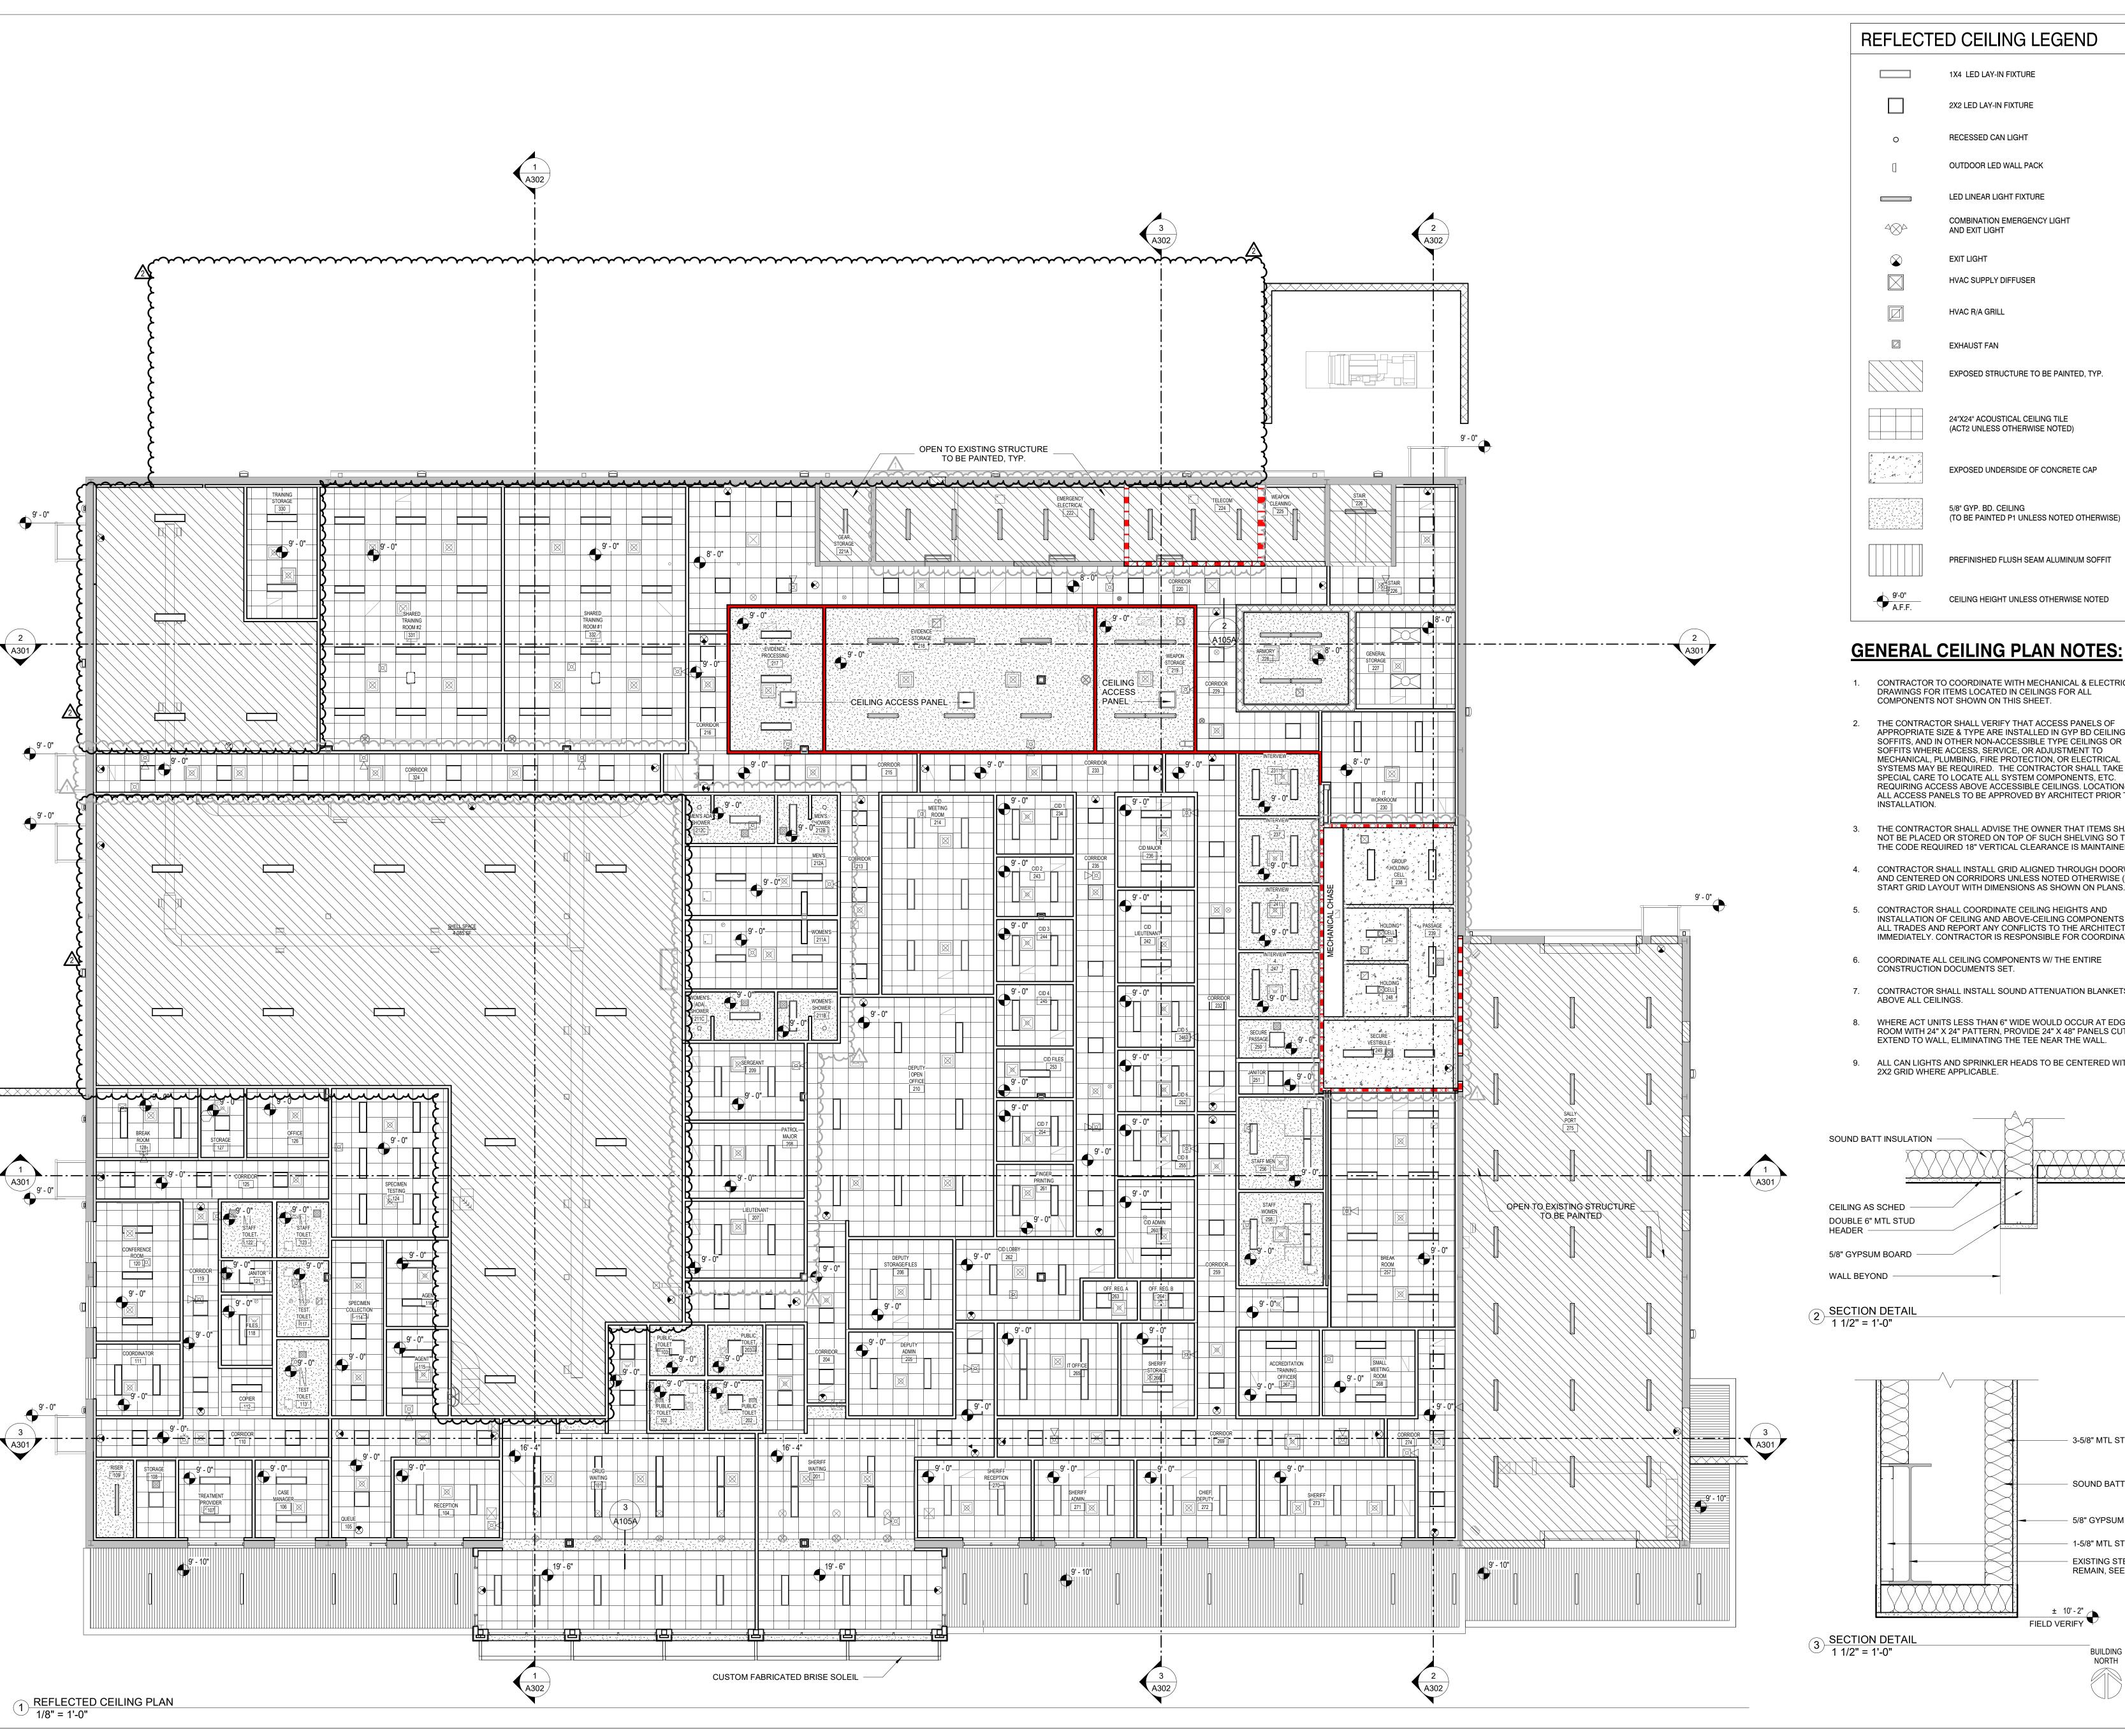



1X4 LED LAY-IN FIXTURE 2X2 LED LAY-IN FIXTURE

RECESSED CAN LIGHT

OUTDOOR LED WALL PACK

LED LINEAR LIGHT FIXTURE COMBINATION EMERGENCY LIGHT

AND EXIT LIGHT

EXIT LIGHT HVAC SUPPLY DIFFUSER

HVAC R/A GRILL

EXHAUST FAN

EXPOSED STRUCTURE TO BE PAINTED, TYP.

(TO BE PAINTED P1 UNLESS NOTED OTHERWISE)

24"X24" ACOUSTICAL CEILING TILE (ACT2 UNLESS OTHERWISE NOTED)


EXPOSED UNDERSIDE OF CONCRETE CAP


5/8" GYP. BD. CEILING

PREFINISHED FLUSH SEAM ALUMINUM SOFFIT

CEILING HEIGHT UNLESS OTHERWISE NOTED

- CONTRACTOR TO COORDINATE WITH MECHANICAL & ELECTRICAL DRAWINGS FOR ITEMS LOCATED IN CEILINGS FOR ALL COMPONENTS NOT SHOWN ON THIS SHEET.
- THE CONTRACTOR SHALL VERIFY THAT ACCESS PANELS OF APPROPRIATE SIZE & TYPE ARE INSTALLED IN GYP BD CEILINGS OR SOFFITS, AND IN OTHER NON-ACCESSIBLE TYPE CEILINGS OR SOFFITS WHERE ACCESS, SERVICE, OR ADJUSTMENT TO MECHANICAL, PLUMBING, FIRE PROTECTION, OR ELECTRICAL SYSTEMS MAY BE REQUIRED. THE CONTRACTOR SHALL TAKE SPECIAL CARE TO LOCATE ALL SYSTEM COMPONENTS, ETC. REQUIRING ACCESS ABOVE ACCESSIBLE CEILINGS. LOCATION(S) OF ALL ACCESS PANELS TO BE APPROVED BY ARCHITECT PRIOR TO INSTALLATION.
- THE CONTRACTOR SHALL ADVISE THE OWNER THAT ITEMS SHALL NOT BE PLACED OR STORED ON TOP OF SUCH SHELVING SO THAT THE CODE REQUIRED 18" VERTICAL CLEARANCE IS MAINTAINED.
- 4. CONTRACTOR SHALL INSTALL GRID ALIGNED THROUGH DOORWAYS AND CENTERED ON CORRIDORS UNLESS NOTED OTHERWISE (UNO). START GRID LAYOUT WITH DIMENSIONS AS SHOWN ON PLANS.
- 5. CONTRACTOR SHALL COORDINATE CEILING HEIGHTS AND INSTALLATION OF CEILING AND ABOVE-CEILING COMPONENTS WITH ALL TRADES AND REPORT ANY CONFLICTS TO THE ARCHITECT IMMEDIATELY. CONTRACTOR IS RESPONSIBLE FOR COORDINATION.
- 6. COORDINATE ALL CEILING COMPONENTS W/ THE ENTIRE CONSTRUCTION DOCUMENTS SET.
- 7. CONTRACTOR SHALL INSTALL SOUND ATTENUATION BLANKETS ABOVE ALL CEILINGS.
- WHERE ACT UNITS LESS THAN 6" WIDE WOULD OCCUR AT EDGES OF ROOM WITH 24" X 24" PATTERN, PROVIDE 24" X 48" PANELS CUT TO EXTEND TO WALL, ELIMINATING THE TEE NEAR THE WALL.
- 9. ALL CAN LIGHTS AND SPRINKLER HEADS TO BE CENTERED WITHIN 2X2 GRID WHERE APPLICABLE.

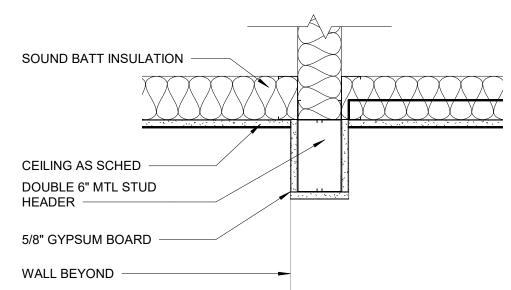

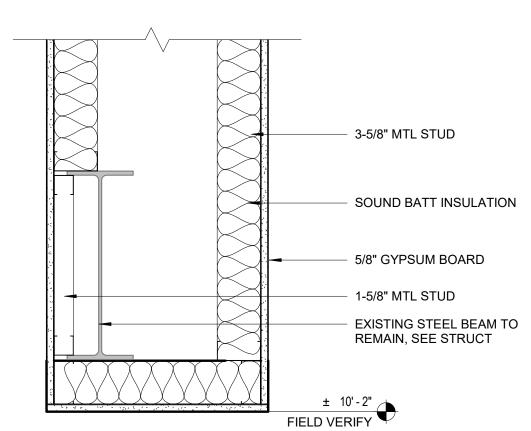

BUILDING TRUE NORTH NORTH

LPK ARCHITECTS, P.A.

Robert E. Luke, Architect

821 22ND AVENUE P.O. BOX 630
MERIDIAN, MISSISSIPPI 39302
P: 601.693.8940
F: 601.693.8640

PROJECT INFORMATION



Lauderdale County Public Safety Building

PROJECT ADDRESS: (Winn-Dixie / LabCorp Building)



ACTIVE DESIGN PHASE FOR REVIEW ONLY FOR PERMITTING ONLY

DESIGN DEVELOPMENT CONSTRUCTION BIDDING CONSTRUCTION DOCUMENTS AS-BUILT RECORD SET


SCHEMATIC DESIGN



REVISIONS/SUBMISSIONS							
NO.	DATE	DESCRIPTION					
1	04/26/2021	ADDENDUM #2					
2	04/30/2021	ADDENDUM #3					

REFLECTED CEILING PLAN & DETAILS - ALTERNATE

PROJECT NO.: 19-4894B SHEET ISSUED: SHEET NO.

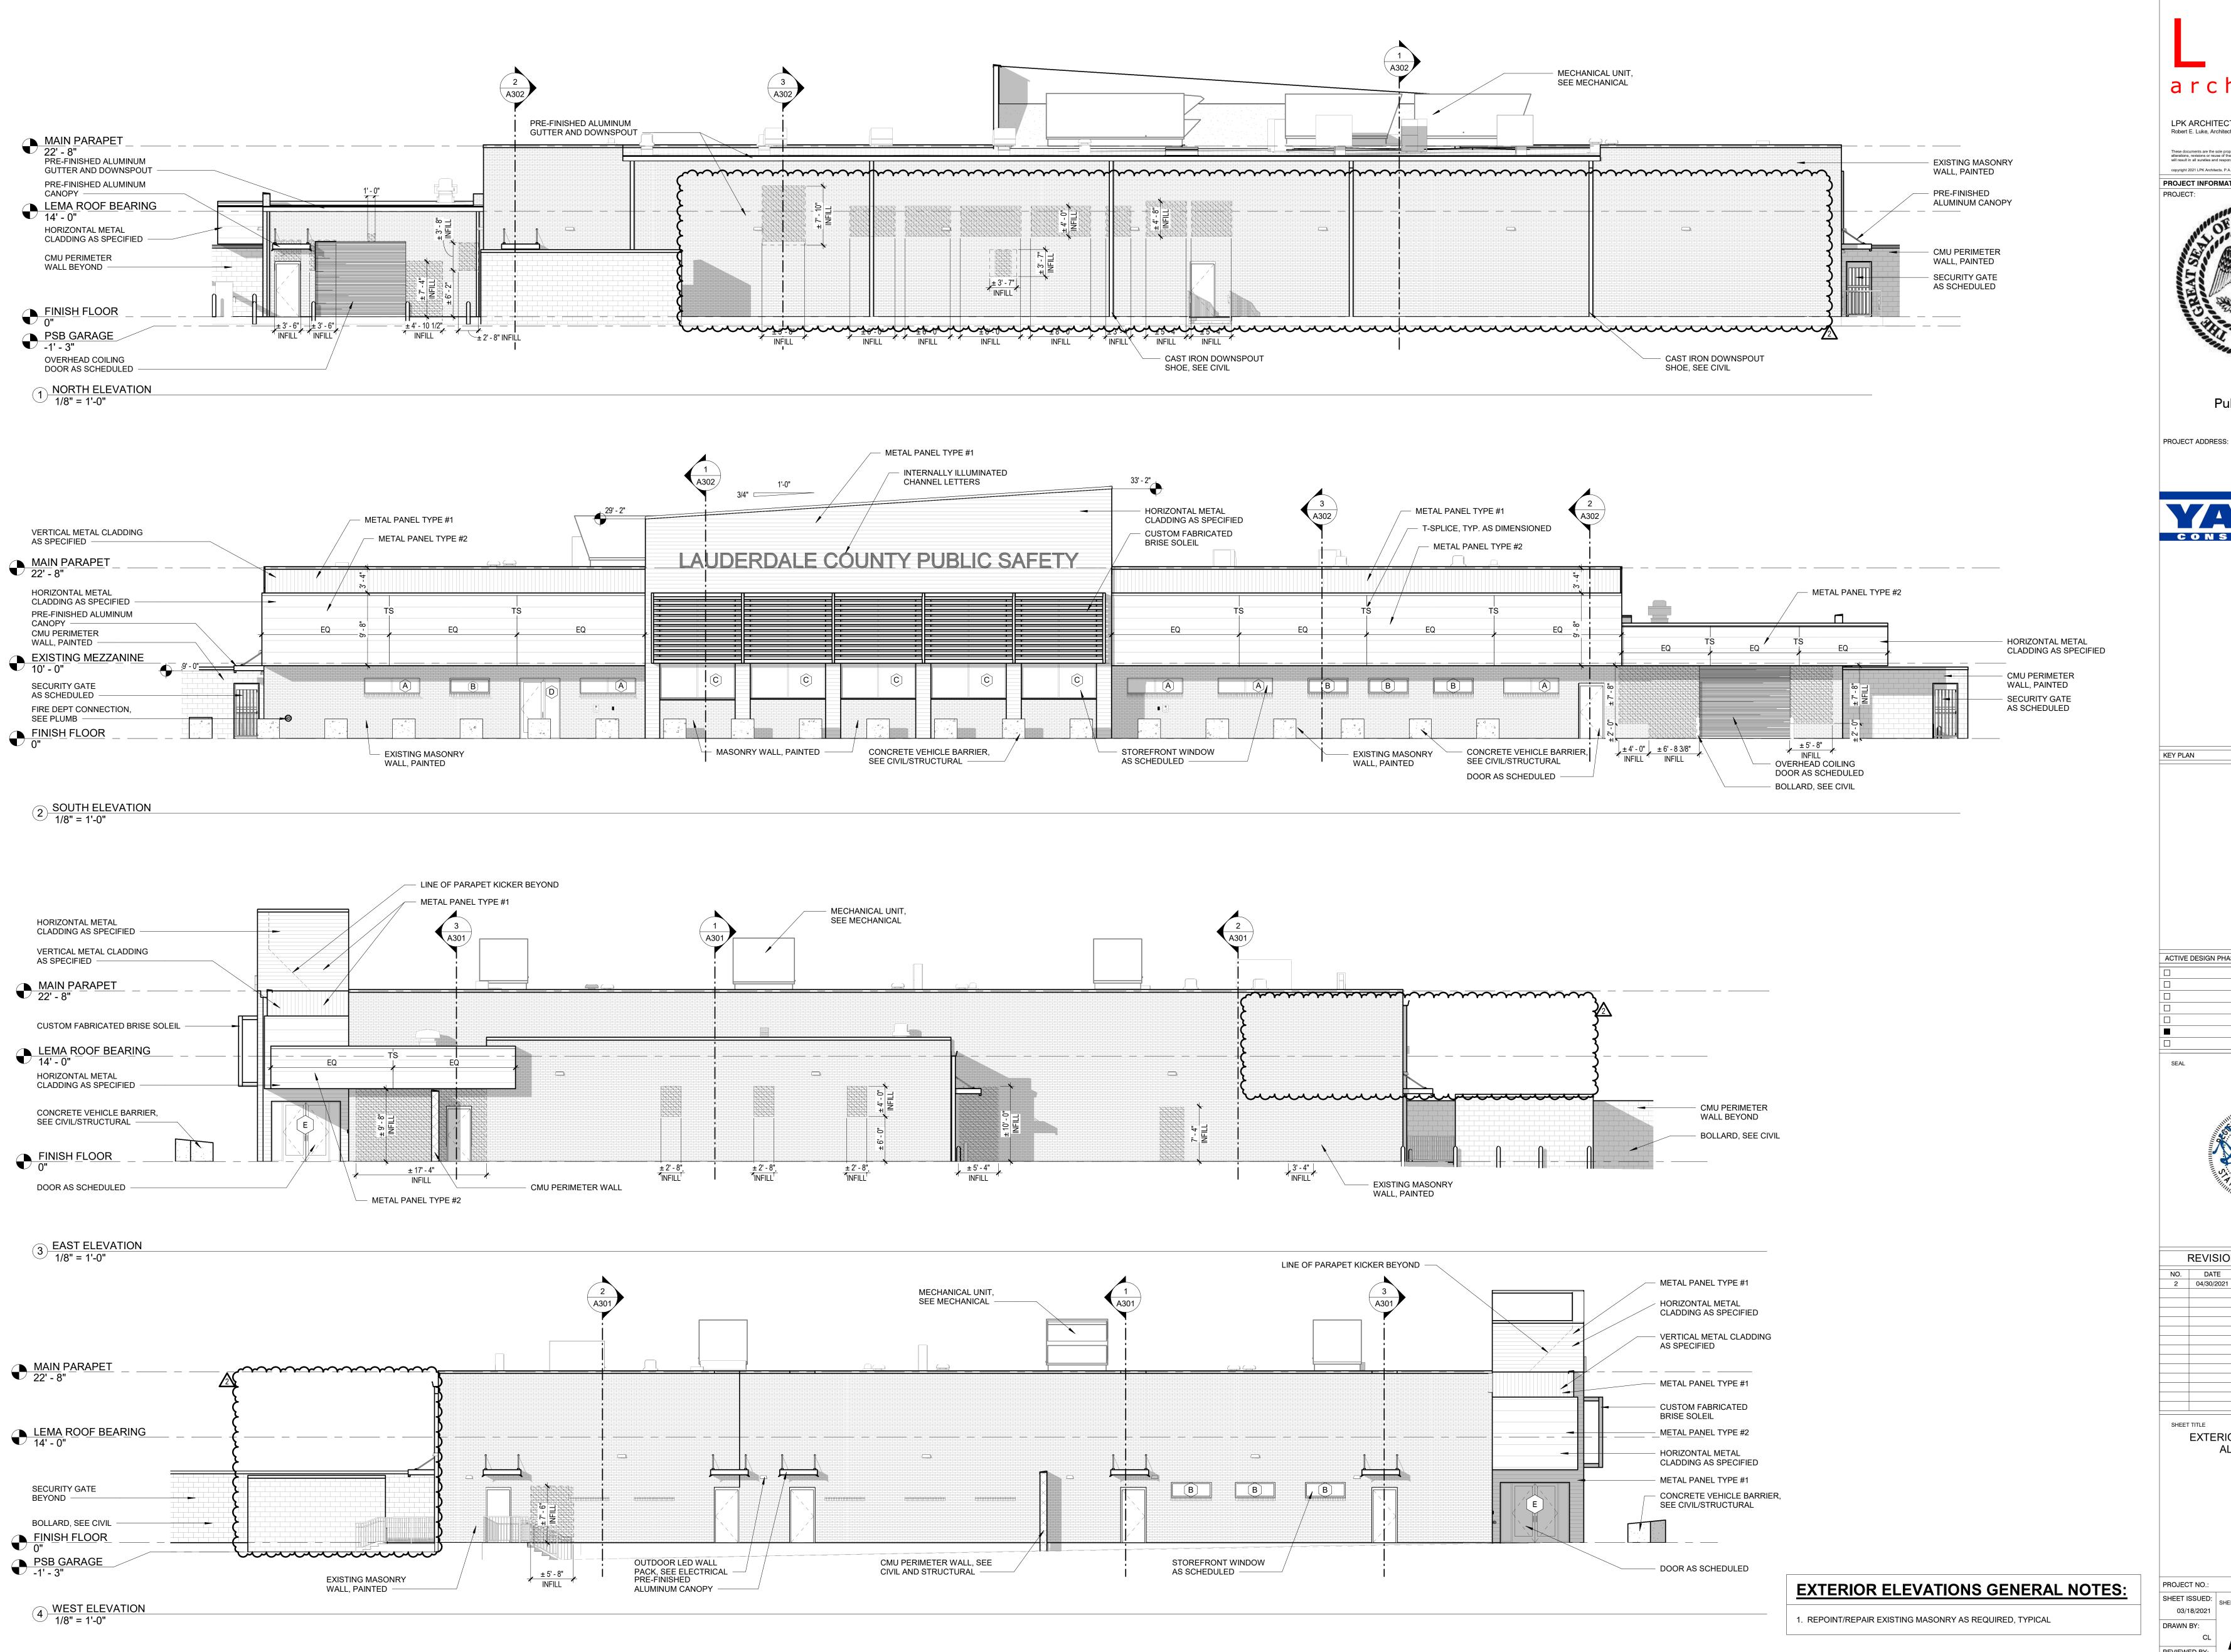

LPK ARCHITECTS, P.A.

Robert E. Luke, Architect

821 22ND AVENUE P.O. BOX 630
MERIDIAN, MISSISSIPPI 39302
P: 601.693.8940
F: 601.693.8640

copyright 2021 LPK Architects, P.A. PROJECT INFORMATION



Lauderdale County Public Safety Building

Village Fair Mall Site 612 22nd Avenue (Winn-Dixie / LabCorp Building)

ACTIVE DESIGN PHASE

FOR REVIEW ONLY FOR PERMITTING ONLY SCHEMATIC DESIGN DESIGN DEVELOPMENT CONSTRUCTION BIDDING CONSTRUCTION DOCUMENTS


AS-BUILT RECORD SET

REVISIONS/SUBMISSIONS DESCRIPTION ADDENDUM #3 04/30/2021

SHEET TITLE EXTERIOR ELEVATIONS -ALTERNATES

PROJECT NO.: SHEET ISSUED: SHEET NO. DRAWN BY:

19-4894B

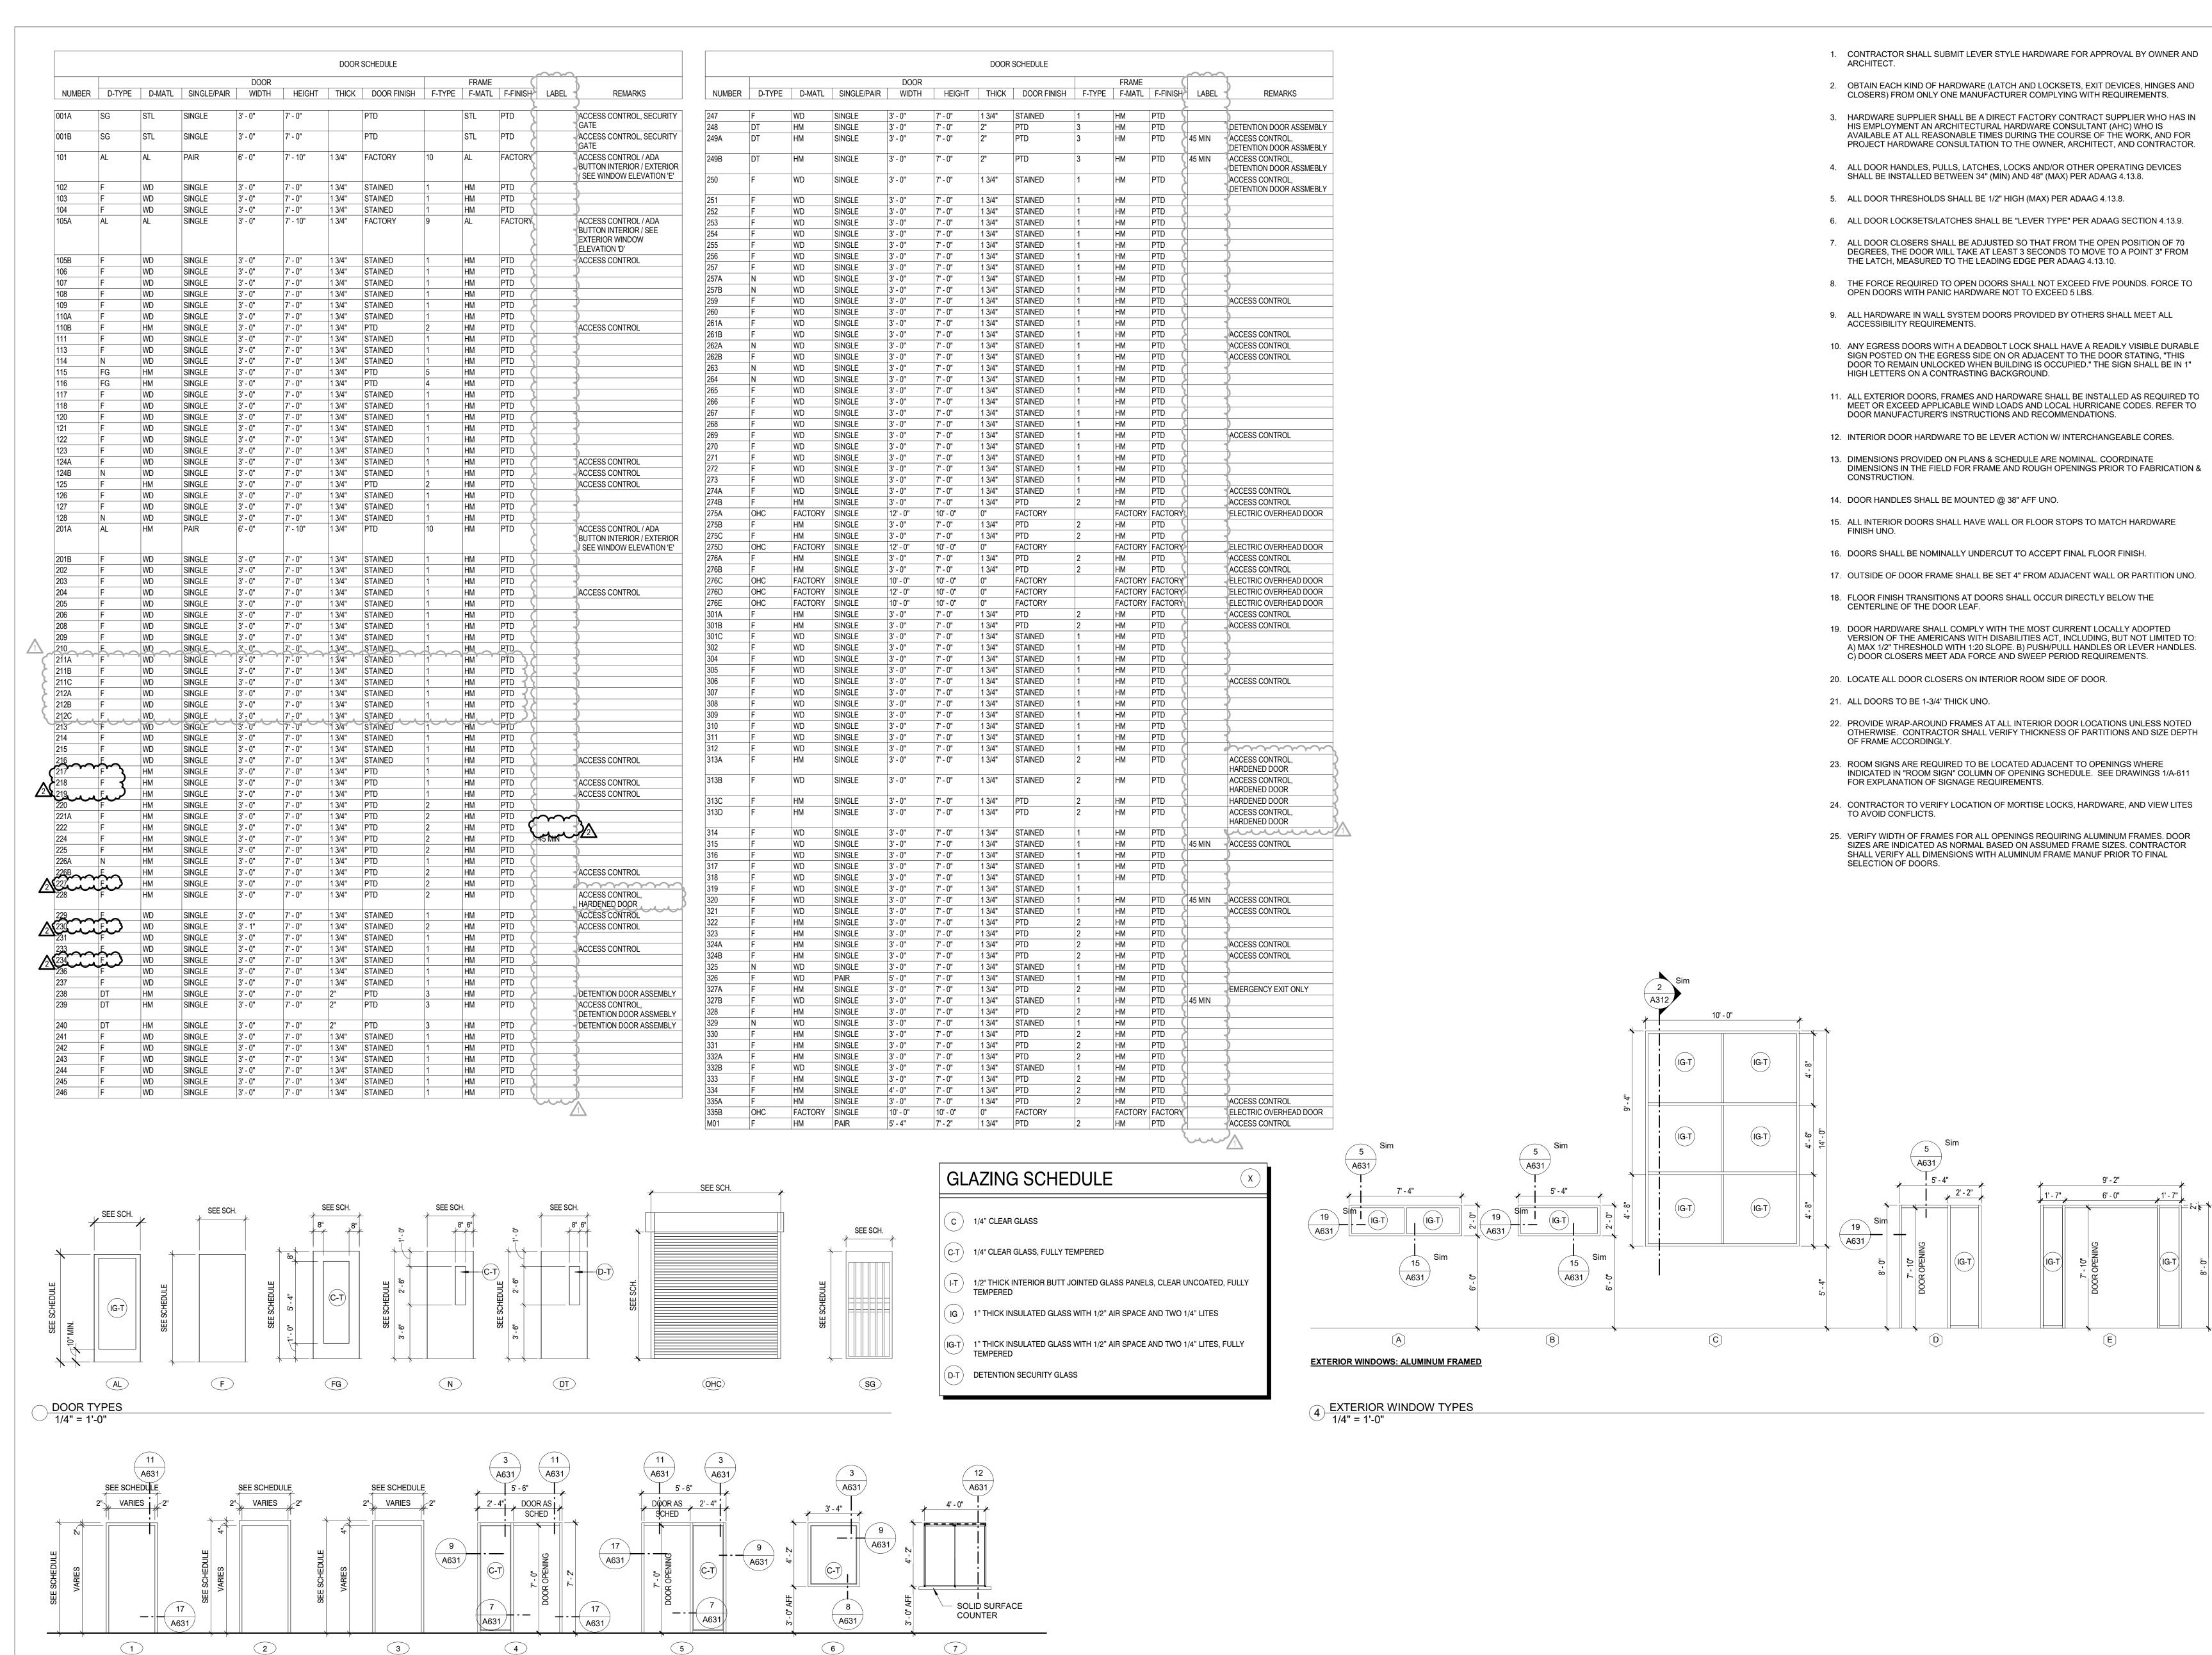

LPK ARCHITECTS, P.A.

Robert E. Luke, Architect

821 22ND AVENUE P.O. BOX 630
MERIDIAN, MISSISSIPP1 39302
P: 601.693.8940
P: 601.693.8940

PROJECT INFORMATION PROJECT:



Lauderdale County Public Safety Building

PROJECT ADDRESS:

Village Fair Mall Site 612 22nd Avenue (Winn-Dixie / LabCorp Building)

ACTIVE DESIGN PHASE

KEY PLAN

FOR REVIEW ONLY FOR PERMITTING ONLY SCHEMATIC DESIGN DESIGN DEVELOPMENT CONSTRUCTION BIDDING

CONSTRUCTION DOCUMENTS

AS-BUILT RECORD SET



REVISIONS/SUBMISSIONS							
NO.	DATE	DESCRIPTION					
1	04/26/2021	ADDENDUM #2					
2	04/30/2021	ADDENDUM #3					

SHEET TITLE OPENING SCHEDULE

PROJECT NO.: SHEET ISSUED: SHEET NO.

DRAWN BY: REVIEWED BY:

19-4894B

HOLLOW METAL

FRAME

FRAME TYPES

1/4" = 1'-0"

HOLLOW METAL

FRAME

HOLLOW METAL

FRAME

HOLLOW METAL

FRAME

HOLLOW METAL


FRAME

HOLLOW METAL


SLIDING PASS -THRU

MODEL D1040A W/ D4

HEADER AND JAMBS BY C.R. LAURENCE OR EQUAL

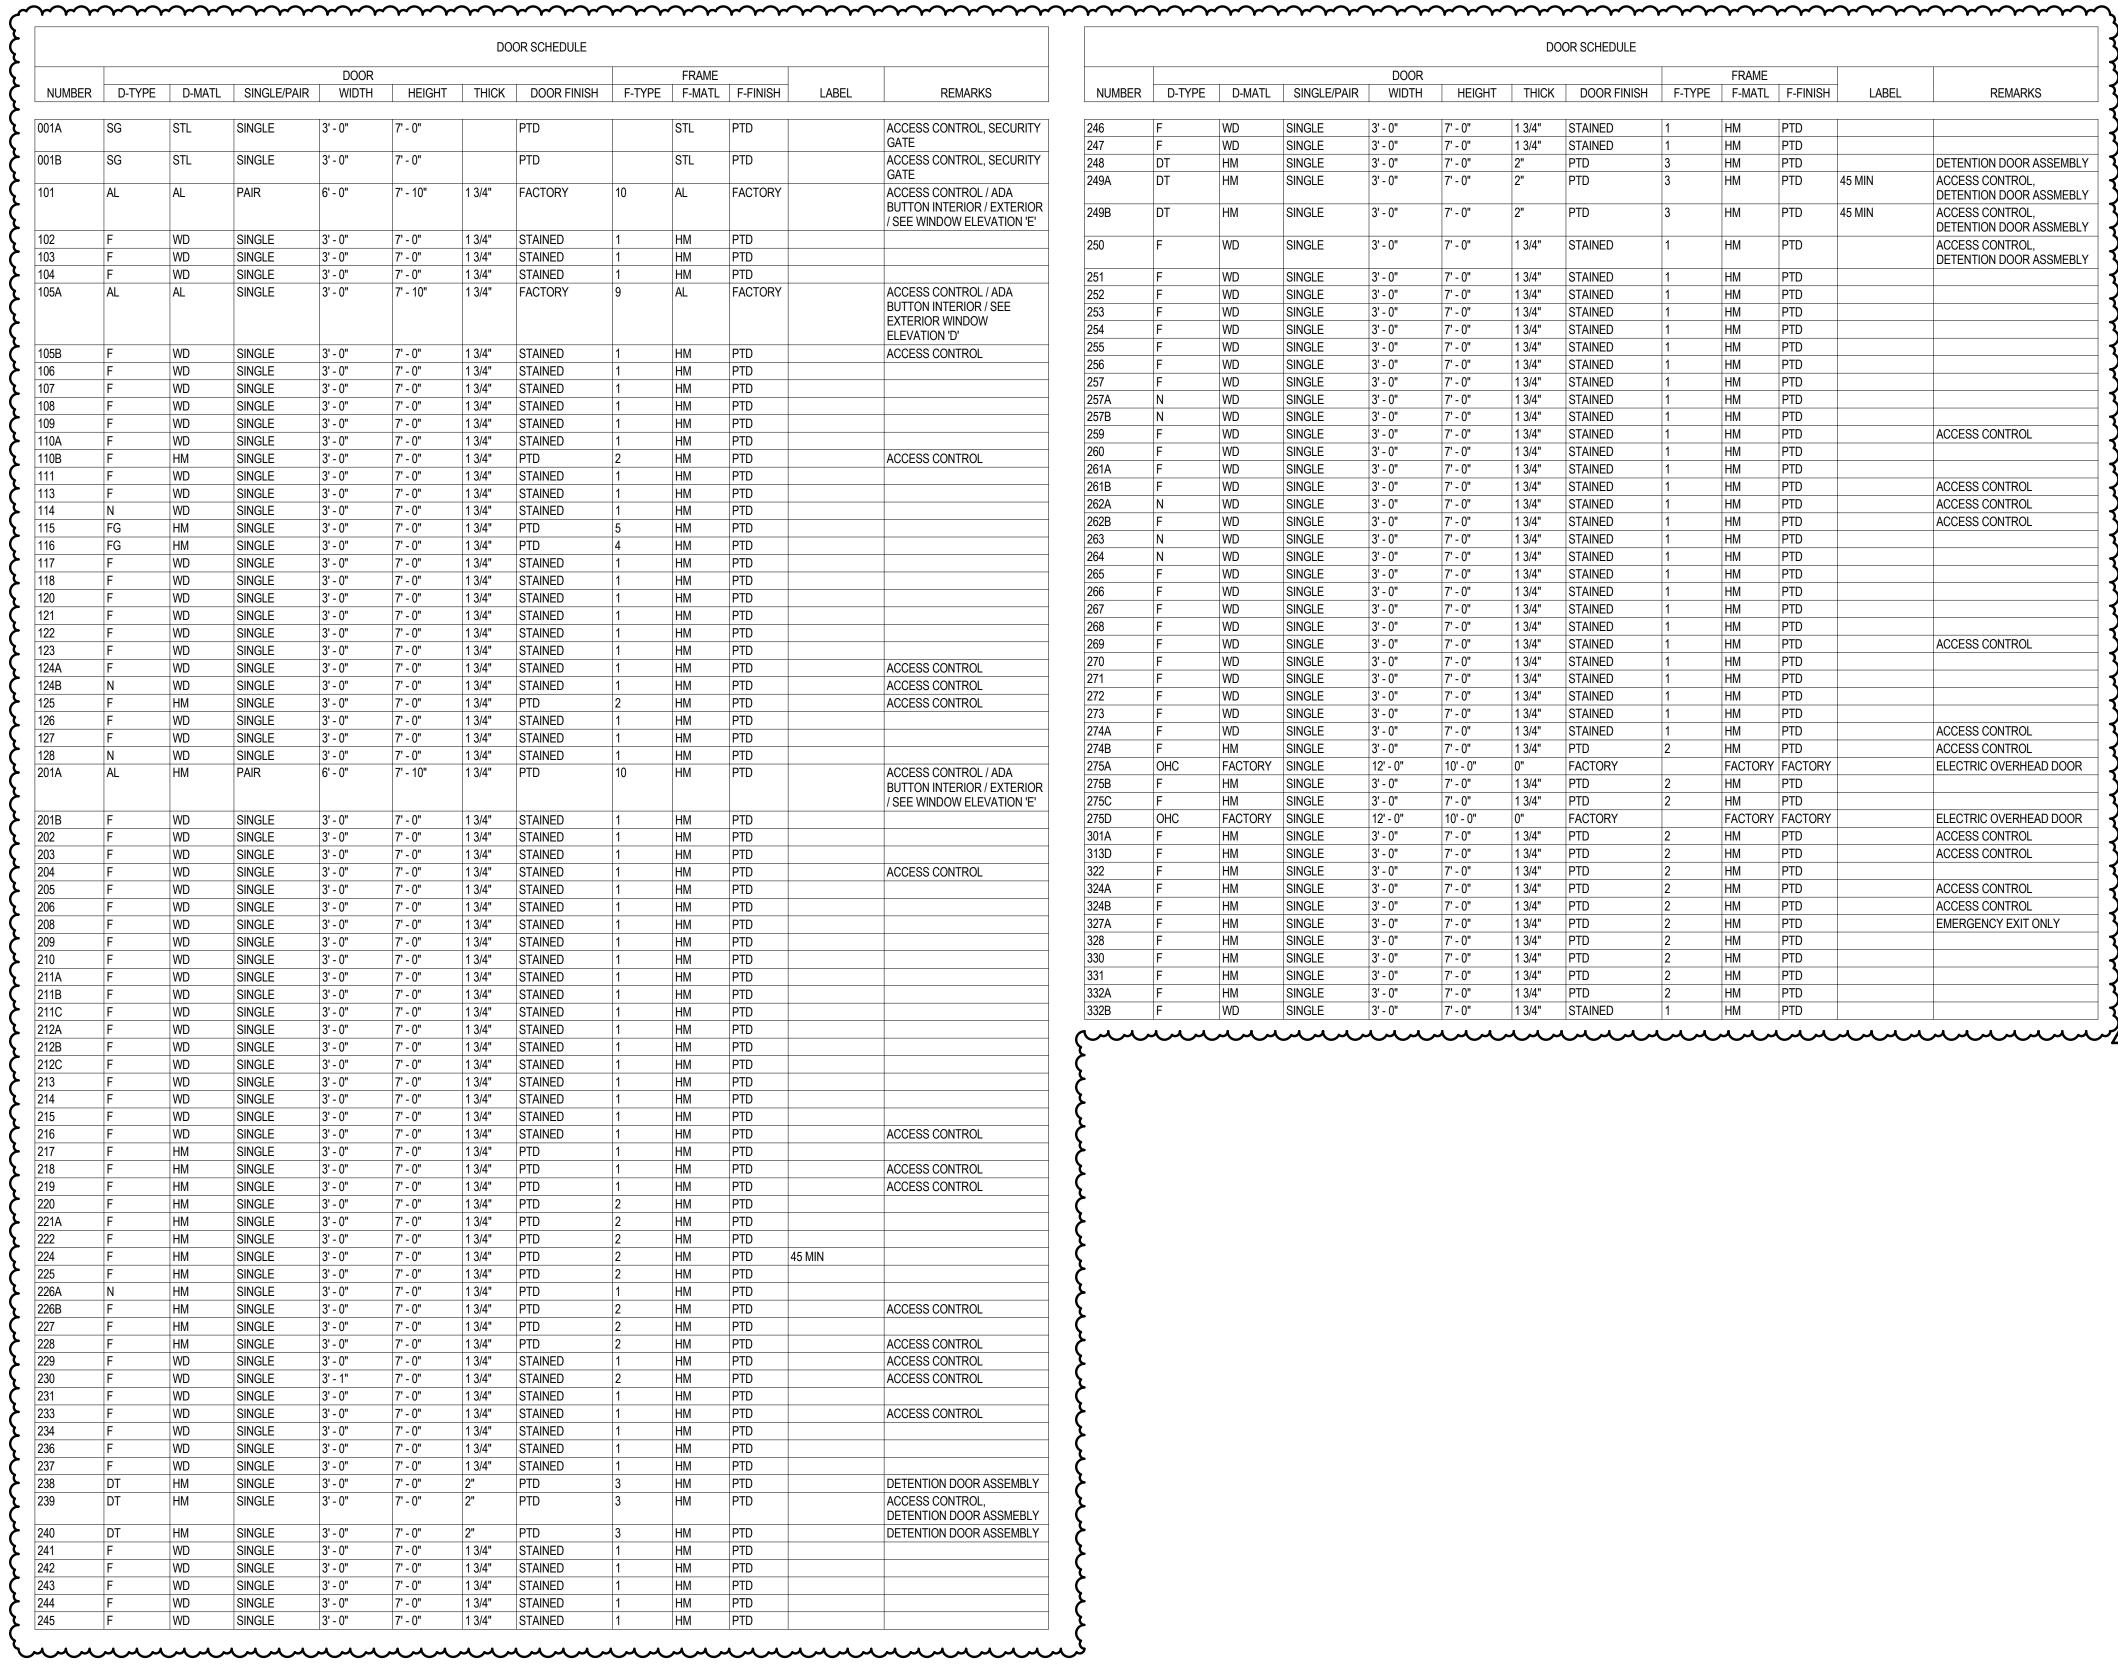

DOOR SCHEDULE					DOOR SCHEDULE							
				DOOR					FRAME			
NUMBER	D-TYPE	D-MATL	SINGLE/PAIR	WIDTH	HEIGHT	THICK	DOOR FINISH	F-TYPE	F-MATL	F-FINISH	LABEL	REMARKS
246	F	WD	SINGLE	3' - 0"	7' - 0"	1 3/4"	STAINED	1	НМ	PTD		
	F	WD		3' - 0"				1	HM			
247 248	DT	HM	SINGLE	3' - 0"	7' - 0" 7' - 0"	2"	STAINED PTD	3	HM	PTD PTD		DETENTION DOOD ACCEMBLY
	DT	HM		3' - 0"	7' - 0"	2"	PTD	3	НМ	-	45 MIN	DETENTION DOOR ASSEMBLY
249A			SINGLE							PTD		ACCESS CONTROL, DETENTION DOOR ASSMEBLY
249B	DT	HM	SINGLE	3' - 0"	7' - 0"	2"	PTD	3	HM	PTD	45 MIN	ACCESS CONTROL, DETENTION DOOR ASSMEBLY
250	F	WD	SINGLE	3' - 0"	7' - 0"	1 3/4"	STAINED	1	HM	PTD		ACCESS CONTROL, DETENTION DOOR ASSMEBLY
251	F	WD	SINGLE	3' - 0"	7' - 0"	1 3/4"	STAINED	1	НМ	PTD		
252	F	WD	SINGLE	3' - 0"	7' - 0"	1 3/4"	STAINED	1	HM	PTD		
253	F	WD	SINGLE	3' - 0"	7' - 0"	1 3/4"	STAINED	1	HM	PTD		
254	F	WD	SINGLE	3' - 0"	7' - 0"	1 3/4"	STAINED	1	НМ	PTD		
255	F	WD	SINGLE	3' - 0"	7' - 0"	1 3/4"	STAINED	1	HM	PTD		
256	F	WD	SINGLE	3' - 0"	7' - 0"	1 3/4"	STAINED	1	HM	PTD		
257	F	WD	SINGLE	3' - 0"	7' - 0"	1 3/4"	STAINED	1	HM	PTD		
257A	N	WD	SINGLE	3' - 0"	7' - 0"	1 3/4"	STAINED	1	HM	PTD		
257B	N	WD	SINGLE	3' - 0"	7' - 0"	1 3/4"	STAINED	1	HM	PTD		
259	F	WD	SINGLE	3' - 0"	7' - 0"	1 3/4"	STAINED	1	HM	PTD		ACCESS CONTROL
260	F	WD	SINGLE	3' - 0"	7' - 0"	1 3/4"	STAINED	1	HM	PTD		7.00200 0002
261A	F	WD	SINGLE	3' - 0"	7' - 0"	1 3/4"	STAINED	1	HM	PTD		
261B	F	WD	SINGLE	3' - 0"	7' - 0"	1 3/4"	STAINED	1	HM	PTD		ACCESS CONTROL
262A	N	WD	SINGLE	3' - 0"	7' - 0"	1 3/4"	STAINED	1	HM	PTD		ACCESS CONTROL
274B	ļ!	HM	SINGLE	3' - 0"	7' - 0"	1 3/4"	PTD	2	HM	PTD		ACCESS CONTROL
275A	OHC	FACTORY	SINGLE	12' - 0"	10' - 0"	0"	FACTORY			FACTORY		ELECTRIC OVERHEAD DOOR
275B	F	HM	SINGLE	3' - 0"	7' - 0"	1 3/4"	PTD	2	HM	PTD		
275C	F	HM	SINGLE	3' - 0"	7' - 0"	1 3/4"	PTD	2	HM	PTD		ELECTRIC OVERVIEWS
275D	OHC	FACTORY	SINGLE	12' - 0"	10' - 0"	0"	FACTORY			FACTORY		ELECTRIC OVERHEAD DOOR
301A	F	HM	SINGLE	3' - 0"	7' - 0"	1 3/4"	PTD	2	HM	PTD		ACCESS CONTROL
313D	F	HM	SINGLE	3' - 0"	7' - 0"	1 3/4"	PTD	2	HM	PTD		ACCESS CONTROL
322	F	HM	SINGLE	3' - 0"	7' - 0"	1 3/4"	PTD	2	HM	PTD		100700 53:: 3:
324A	F	HM	SINGLE	3' - 0"	7' - 0"	1 3/4"	PTD	2	HM	PTD		ACCESS CONTROL
324B	F	HM	SINGLE	3' - 0"	7' - 0"	1 3/4"	PTD	2	HM	PTD		ACCESS CONTROL
327A	F	HM	SINGLE	3' - 0"	7' - 0"	1 3/4"	PTD	2	HM	PTD		EMERGENCY EXIT ONLY
328	F	HM	SINGLE	3' - 0"	7' - 0"	1 3/4"	PTD	2	HM	PTD		
330	F	HM	SINGLE	3' - 0"	7' - 0"	1 3/4"	PTD	2	HM	PTD		
331	F	HM	SINGLE	3' - 0"	7' - 0"	1 3/4"	PTD	2	HM	PTD		
32A	F	HM	SINGLE	3' - 0"	7' - 0"	1 3/4"	PTD	2	HM	PTD		
332B	F	WD	SINGLE	3' - 0"	7' - 0"	1 3/4"	STAINED	1	HM	PTD		

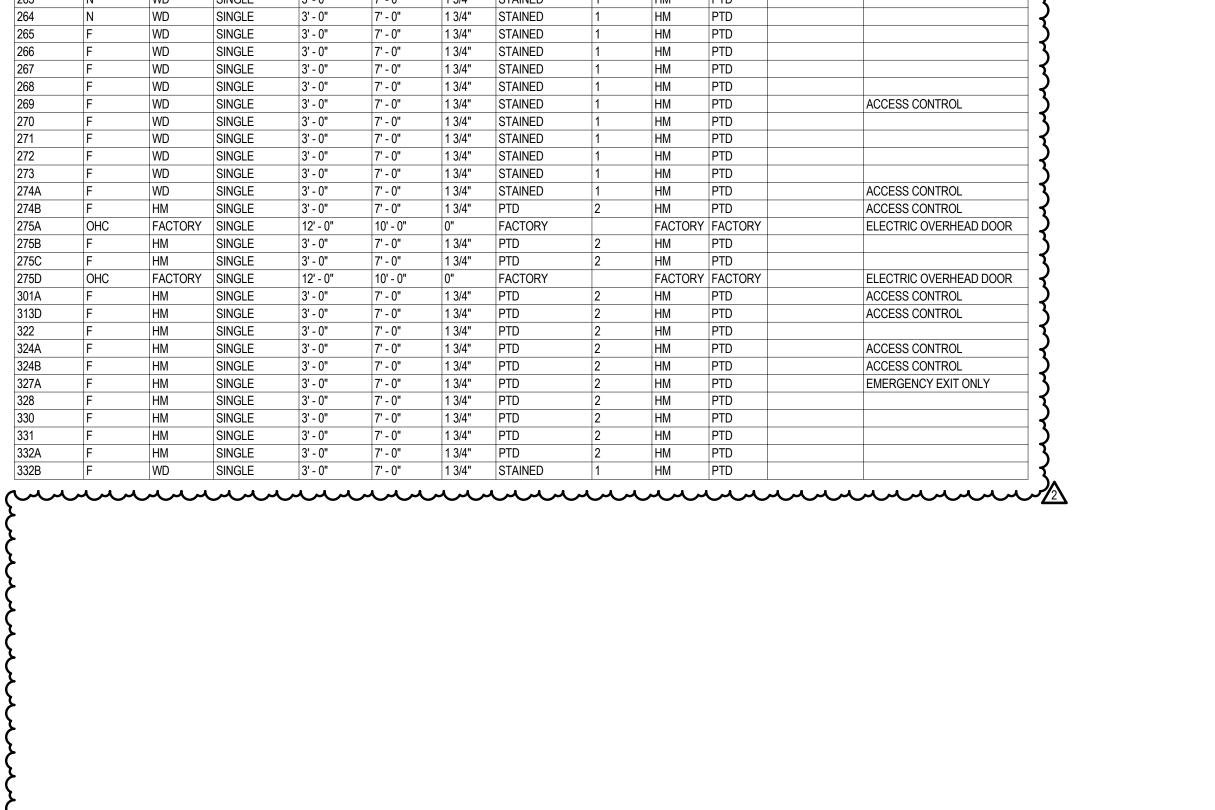

4 EXTERIOR WINDOW TYPES
1/4" = 1'-0"



SHALL BE INSTALLED BETWEEN 34" (MIN) AND 48" (MAX) PER ADAAG 4.13.8.

1. CONTRACTOR SHALL SUBMIT LEVER STYLE HARDWARE FOR APPROVAL BY OWNER AND

5. ALL DOOR THRESHOLDS SHALL BE 1/2" HIGH (MAX) PER ADAAG 4.13.8.

6. ALL DOOR LOCKSETS/LATCHES SHALL BE "LEVER TYPE" PER ADAAG SECTION 4.13.9.

7. ALL DOOR CLOSERS SHALL BE ADJUSTED SO THAT FROM THE OPEN POSITION OF 70 DEGREES, THE DOOR WILL TAKE AT LEAST 3 SECONDS TO MOVE TO A POINT 3" FROM THE LATCH, MEASURED TO THE LEADING EDGE PER ADAAG 4.13.10.

8. THE FORCE REQUIRED TO OPEN DOORS SHALL NOT EXCEED FIVE POUNDS. FORCE TO OPEN DOORS WITH PANIC HARDWARE NOT TO EXCEED 5 LBS.

9. ALL HARDWARE IN WALL SYSTEM DOORS PROVIDED BY OTHERS SHALL MEET ALL ACCESSIBILITY REQUIREMENTS.

10. ANY EGRESS DOORS WITH A DEADBOLT LOCK SHALL HAVE A READILY VISIBLE DURABLE SIGN POSTED ON THE EGRESS SIDE ON OR ADJACENT TO THE DOOR STATING, "THIS DOOR TO REMAIN UNLOCKED WHEN BUILDING IS OCCUPIED." THE SIGN SHALL BE IN 1" HIGH LETTERS ON A CONTRASTING BACKGROUND.

11. ALL EXTERIOR DOORS, FRAMES AND HARDWARE SHALL BE INSTALLED AS REQUIRED TO MEET OR EXCEED APPLICABLE WIND LOADS AND LOCAL HURRICANE CODES. REFER TO DOOR MANUFACTURER'S INSTRUCTIONS AND RECOMMENDATIONS.

12. INTERIOR DOOR HARDWARE TO BE LEVER ACTION W/ INTERCHANGEABLE CORES.

13. DIMENSIONS PROVIDED ON PLANS & SCHEDULE ARE NOMINAL. COORDINATE DIMENSIONS IN THE FIELD FOR FRAME AND ROUGH OPENINGS PRIOR TO FABRICATION & CONSTRUCTION.

14. DOOR HANDLES SHALL BE MOUNTED @ 38" AFF UNO.

15. ALL INTERIOR DOORS SHALL HAVE WALL OR FLOOR STOPS TO MATCH HARDWARE FINISH UNO.

16. DOORS SHALL BE NOMINALLY UNDERCUT TO ACCEPT FINAL FLOOR FINISH.

17. OUTSIDE OF DOOR FRAME SHALL BE SET 4" FROM ADJACENT WALL OR PARTITION UNO.

18. FLOOR FINISH TRANSITIONS AT DOORS SHALL OCCUR DIRECTLY BELOW THE CENTERLINE OF THE DOOR LEAF.

19. DOOR HARDWARE SHALL COMPLY WITH THE MOST CURRENT LOCALLY ADOPTED VERSION OF THE AMERICANS WITH DISABILITIES ACT, INCLUDING, BUT NOT LIMITED TO: A) MAX 1/2" THRESHOLD WITH 1:20 SLOPE. B) PUSH/PULL HANDLES OR LEVER HANDLES. C) DOOR CLOSERS MEET ADA FORCE AND SWEEP PERIOD REQUIREMENTS.

20. LOCATE ALL DOOR CLOSERS ON INTERIOR ROOM SIDE OF DOOR.


21. ALL DOORS TO BE 1-3/4' THICK UNO.


22. PROVIDE WRAP-AROUND FRAMES AT ALL INTERIOR DOOR LOCATIONS UNLESS NOTED OF FRAME ACCORDINGLY.

23. ROOM SIGNS ARE REQUIRED TO BE LOCATED ADJACENT TO OPENINGS WHERE INDICATED IN "ROOM SIGN" COLUMN OF OPENING SCHEDULE. SEE DRAWINGS 1/A-611 FOR EXPLANATION OF SIGNAGE REQUIREMENTS.

24. CONTRACTOR TO VERIFY LOCATION OF MORTISE LOCKS, HARDWARE, AND VIEW LITES TO AVOID CONFLICTS.

25. VERIFY WIDTH OF FRAMES FOR ALL OPENINGS REQUIRING ALUMINUM FRAMES. DOOR SIZES ARE INDICATED AS NORMAL BASED ON ASSUMED FRAME SIZES, CONTRACTOR SHALL VERIFY ALL DIMENSIONS WITH ALUMINUM FRAME MANUF PRIOR TO FINAL SELECTION OF DOORS.

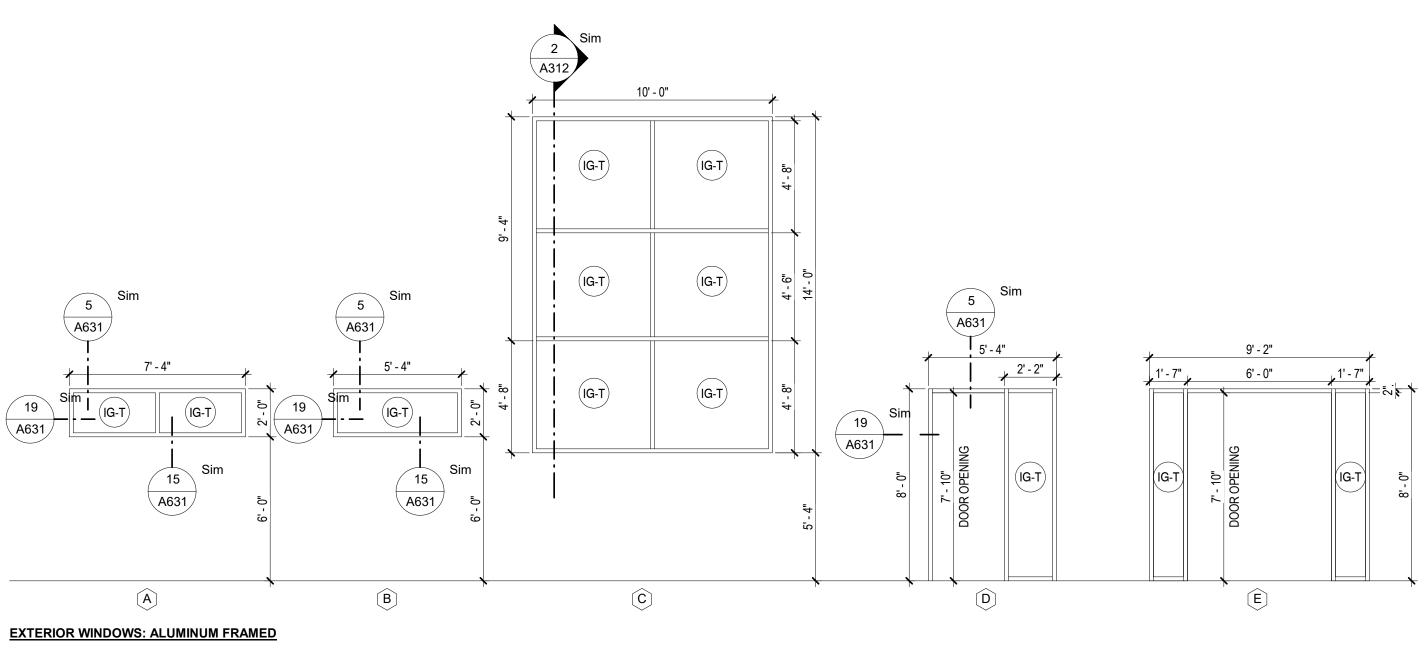

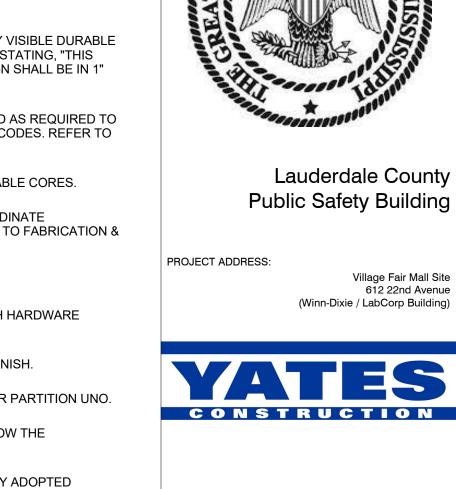

KEY PLAN

LPK ARCHITECTS, P.A.


Robert E. Luke, Architect

821 22ND AVENUE P.O. BOX 630
MERIDIAN, MISSISSIPPI 39302
P: 601.693.8940
F: 601.693.8640

These documents are the sole property of LPK Architects P.A. and are not to reused. Any alterations, revisions or reuse of these documents without the written consent of LPK Architects P.J. will result in all surprises and responsibilities for the entire project becoming null and void

PROJECT INFORMATION

PROJECT:

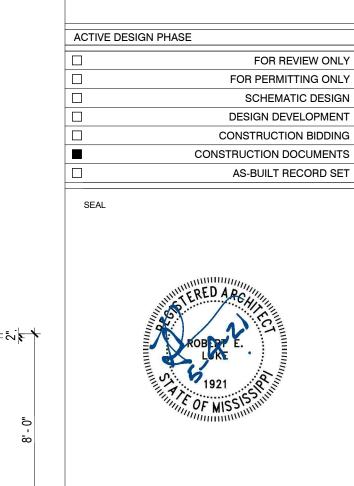


REVISIONS/SUBMISSIONS					
10.	DATE	DESCRIPTION			
2	04/30/2021	ADDENDUM #3			


SHEET TITLE OPENING SCHEDULE -ALTERNATES

PROJECT NO.:


19-4894B

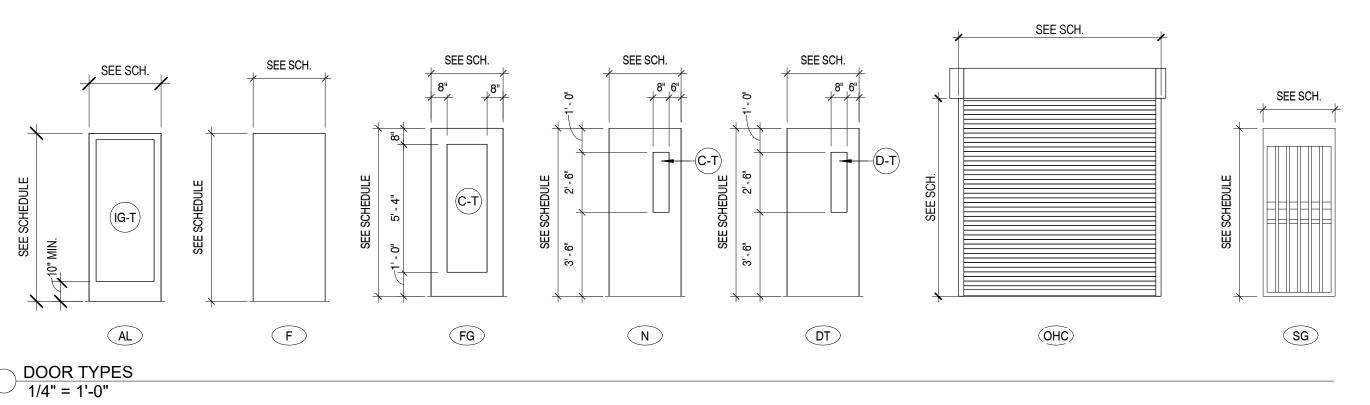



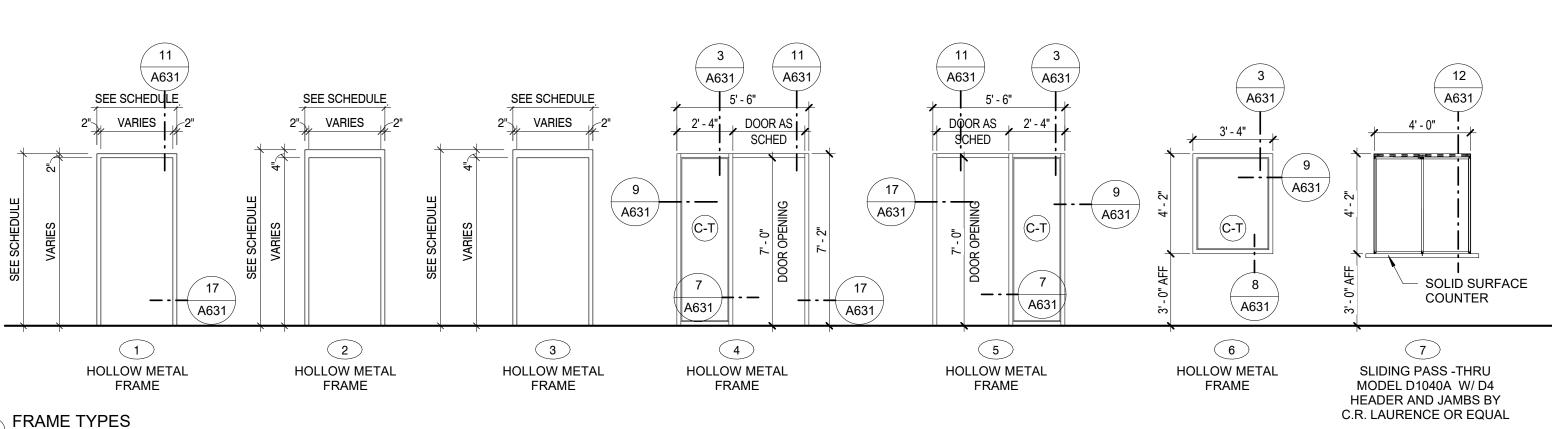

1/4" = 1'-0"

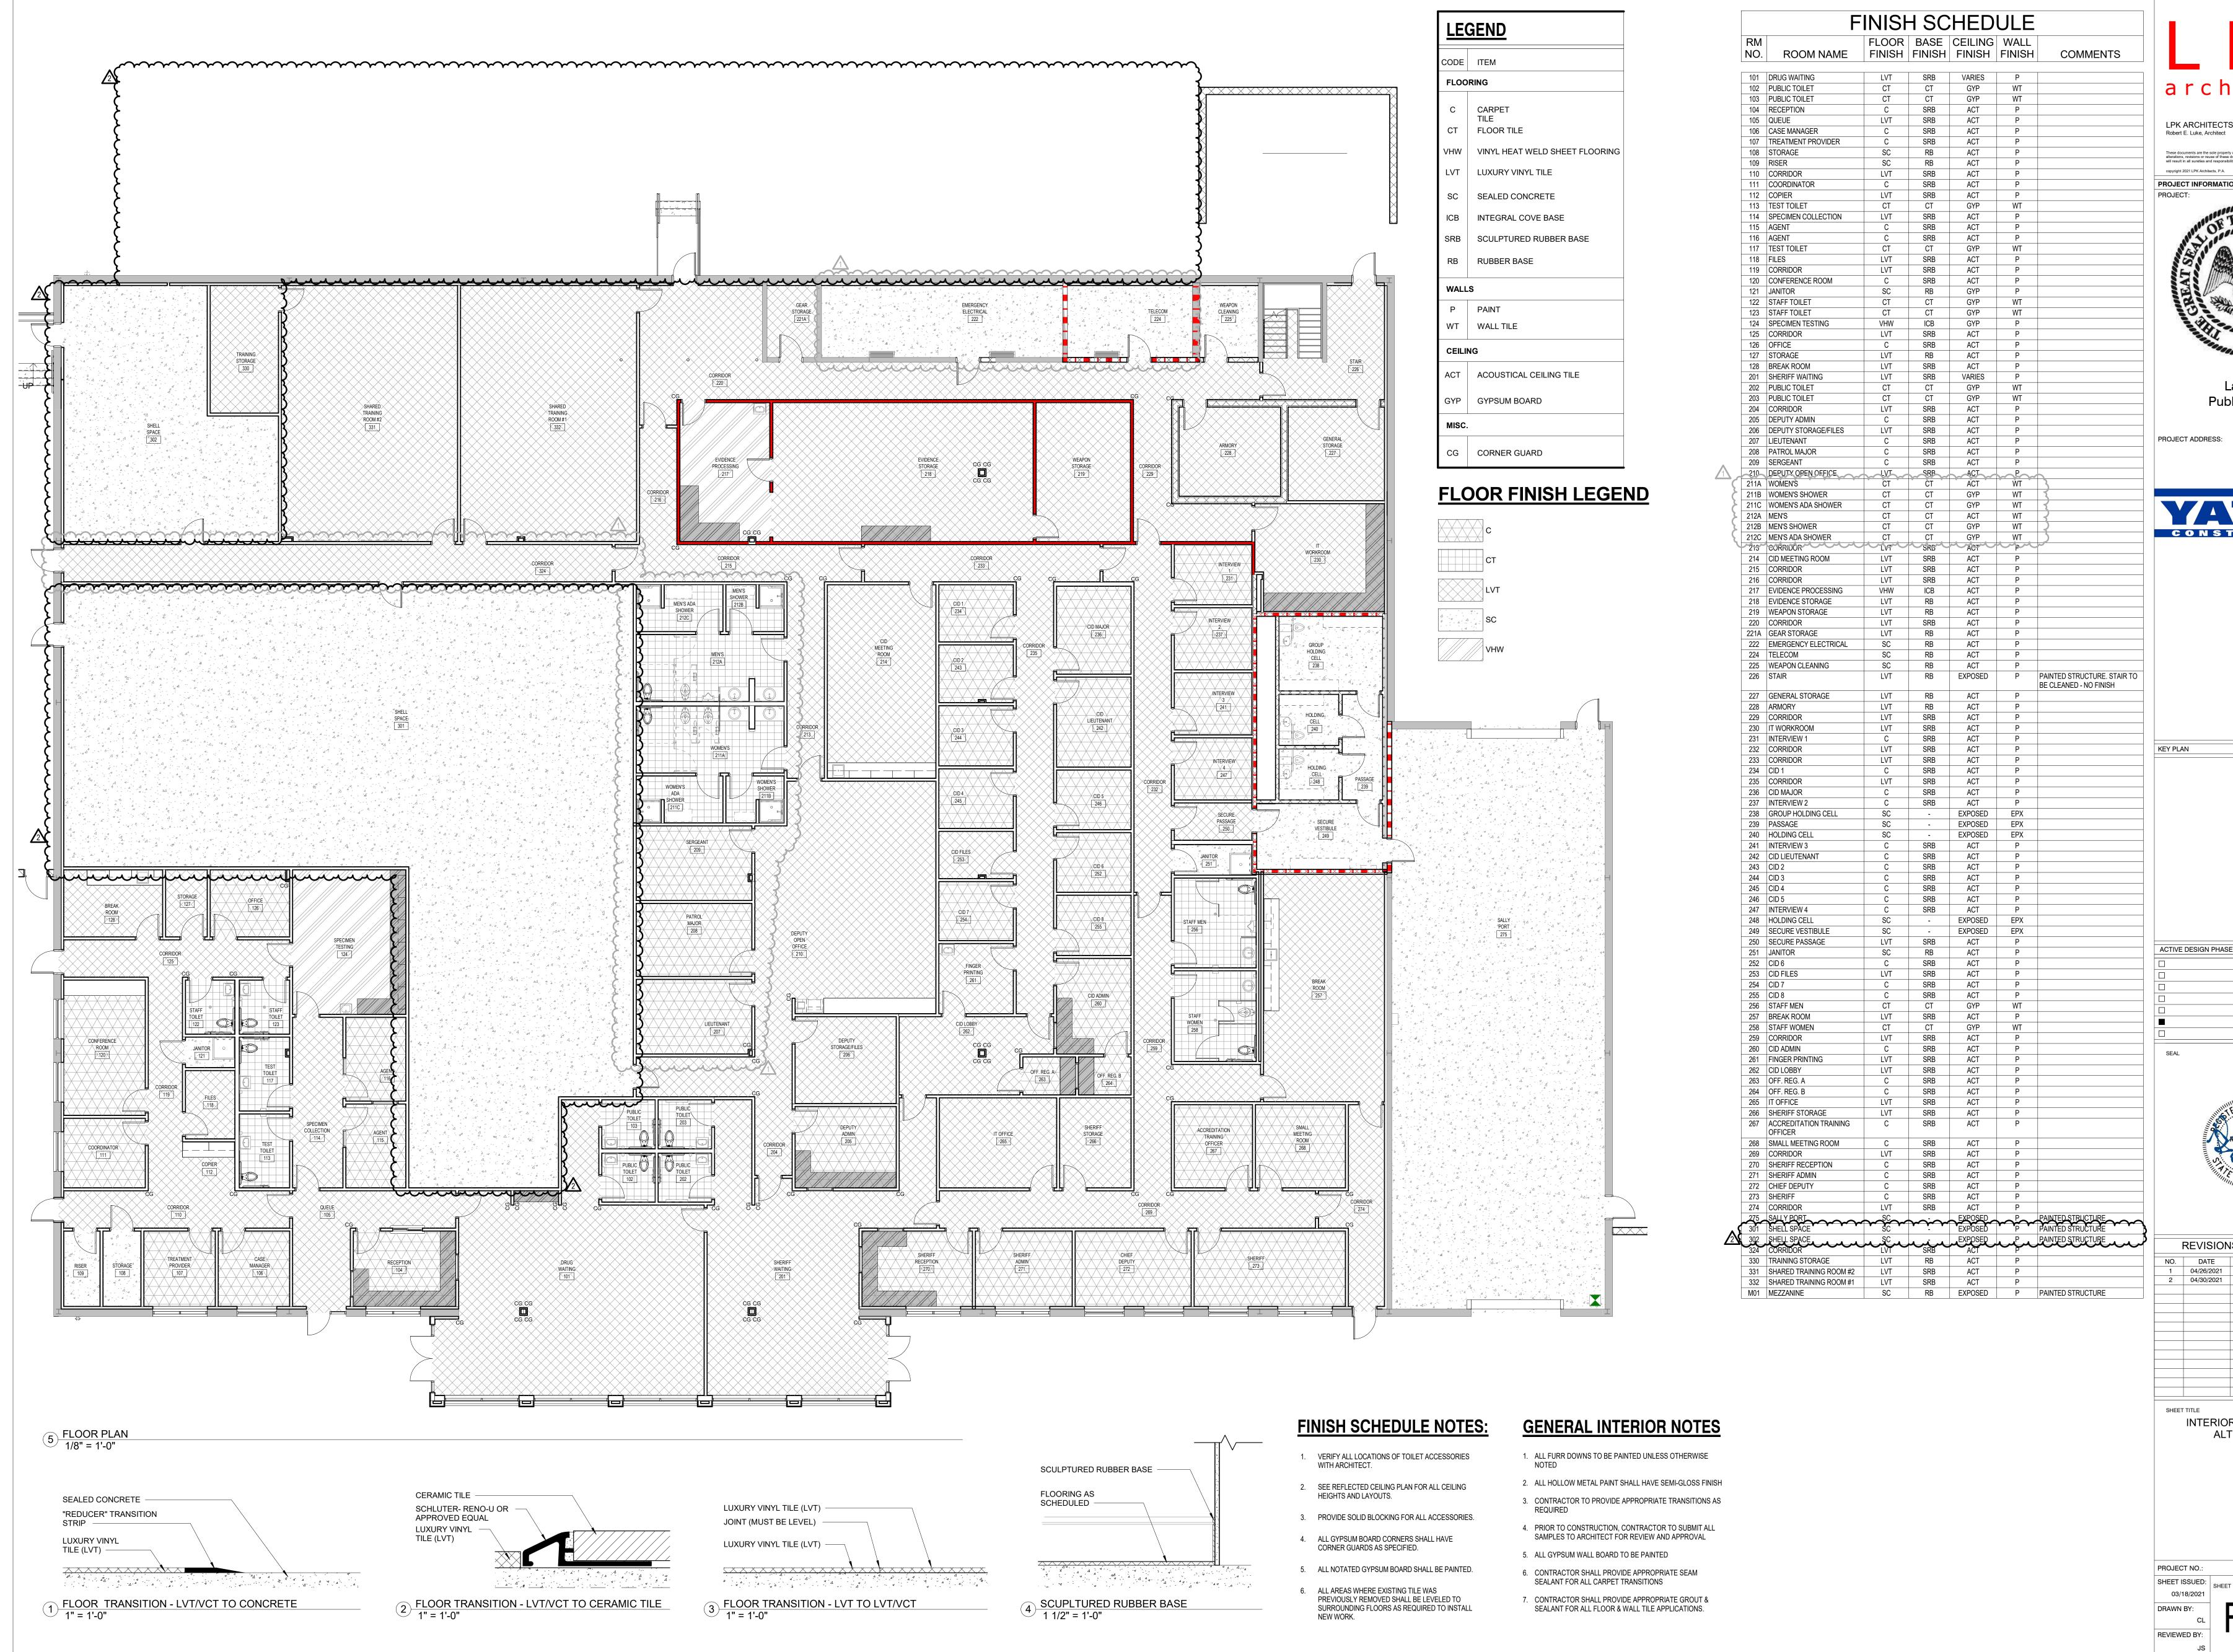

LPK ARCHITECTS, P.A.

Robert E. Luke, Architect

821 22ND AVENUE P.O. BOX 630
MERIDIAN, MISSISSIPP1 38302
P: 601.693.8940
F: 601.693.8640 PROJECT INFORMATION

Lauderdale County Public Safety Building

> Village Fair Mall Site (Winn-Dixie / LabCorp Building)

FOR REVIEW ONLY FOR PERMITTING ONLY DESIGN DEVELOPMENT CONSTRUCTION BIDDING CONSTRUCTION DOCUMENTS

AS-BUILT RECORD SET




	<u> </u>						
)	REVISIONS/SUBMISSIONS						
	NO.	DATE	DESCRIPTION				
	1	04/26/2021	ADDENDUM #2				
	2	04/30/2021	ADDENDUM #3				

INTERIOR FINISH PLAN -ALTERNATES

SHEET ISSUED: SHEET NO.

19-4894B

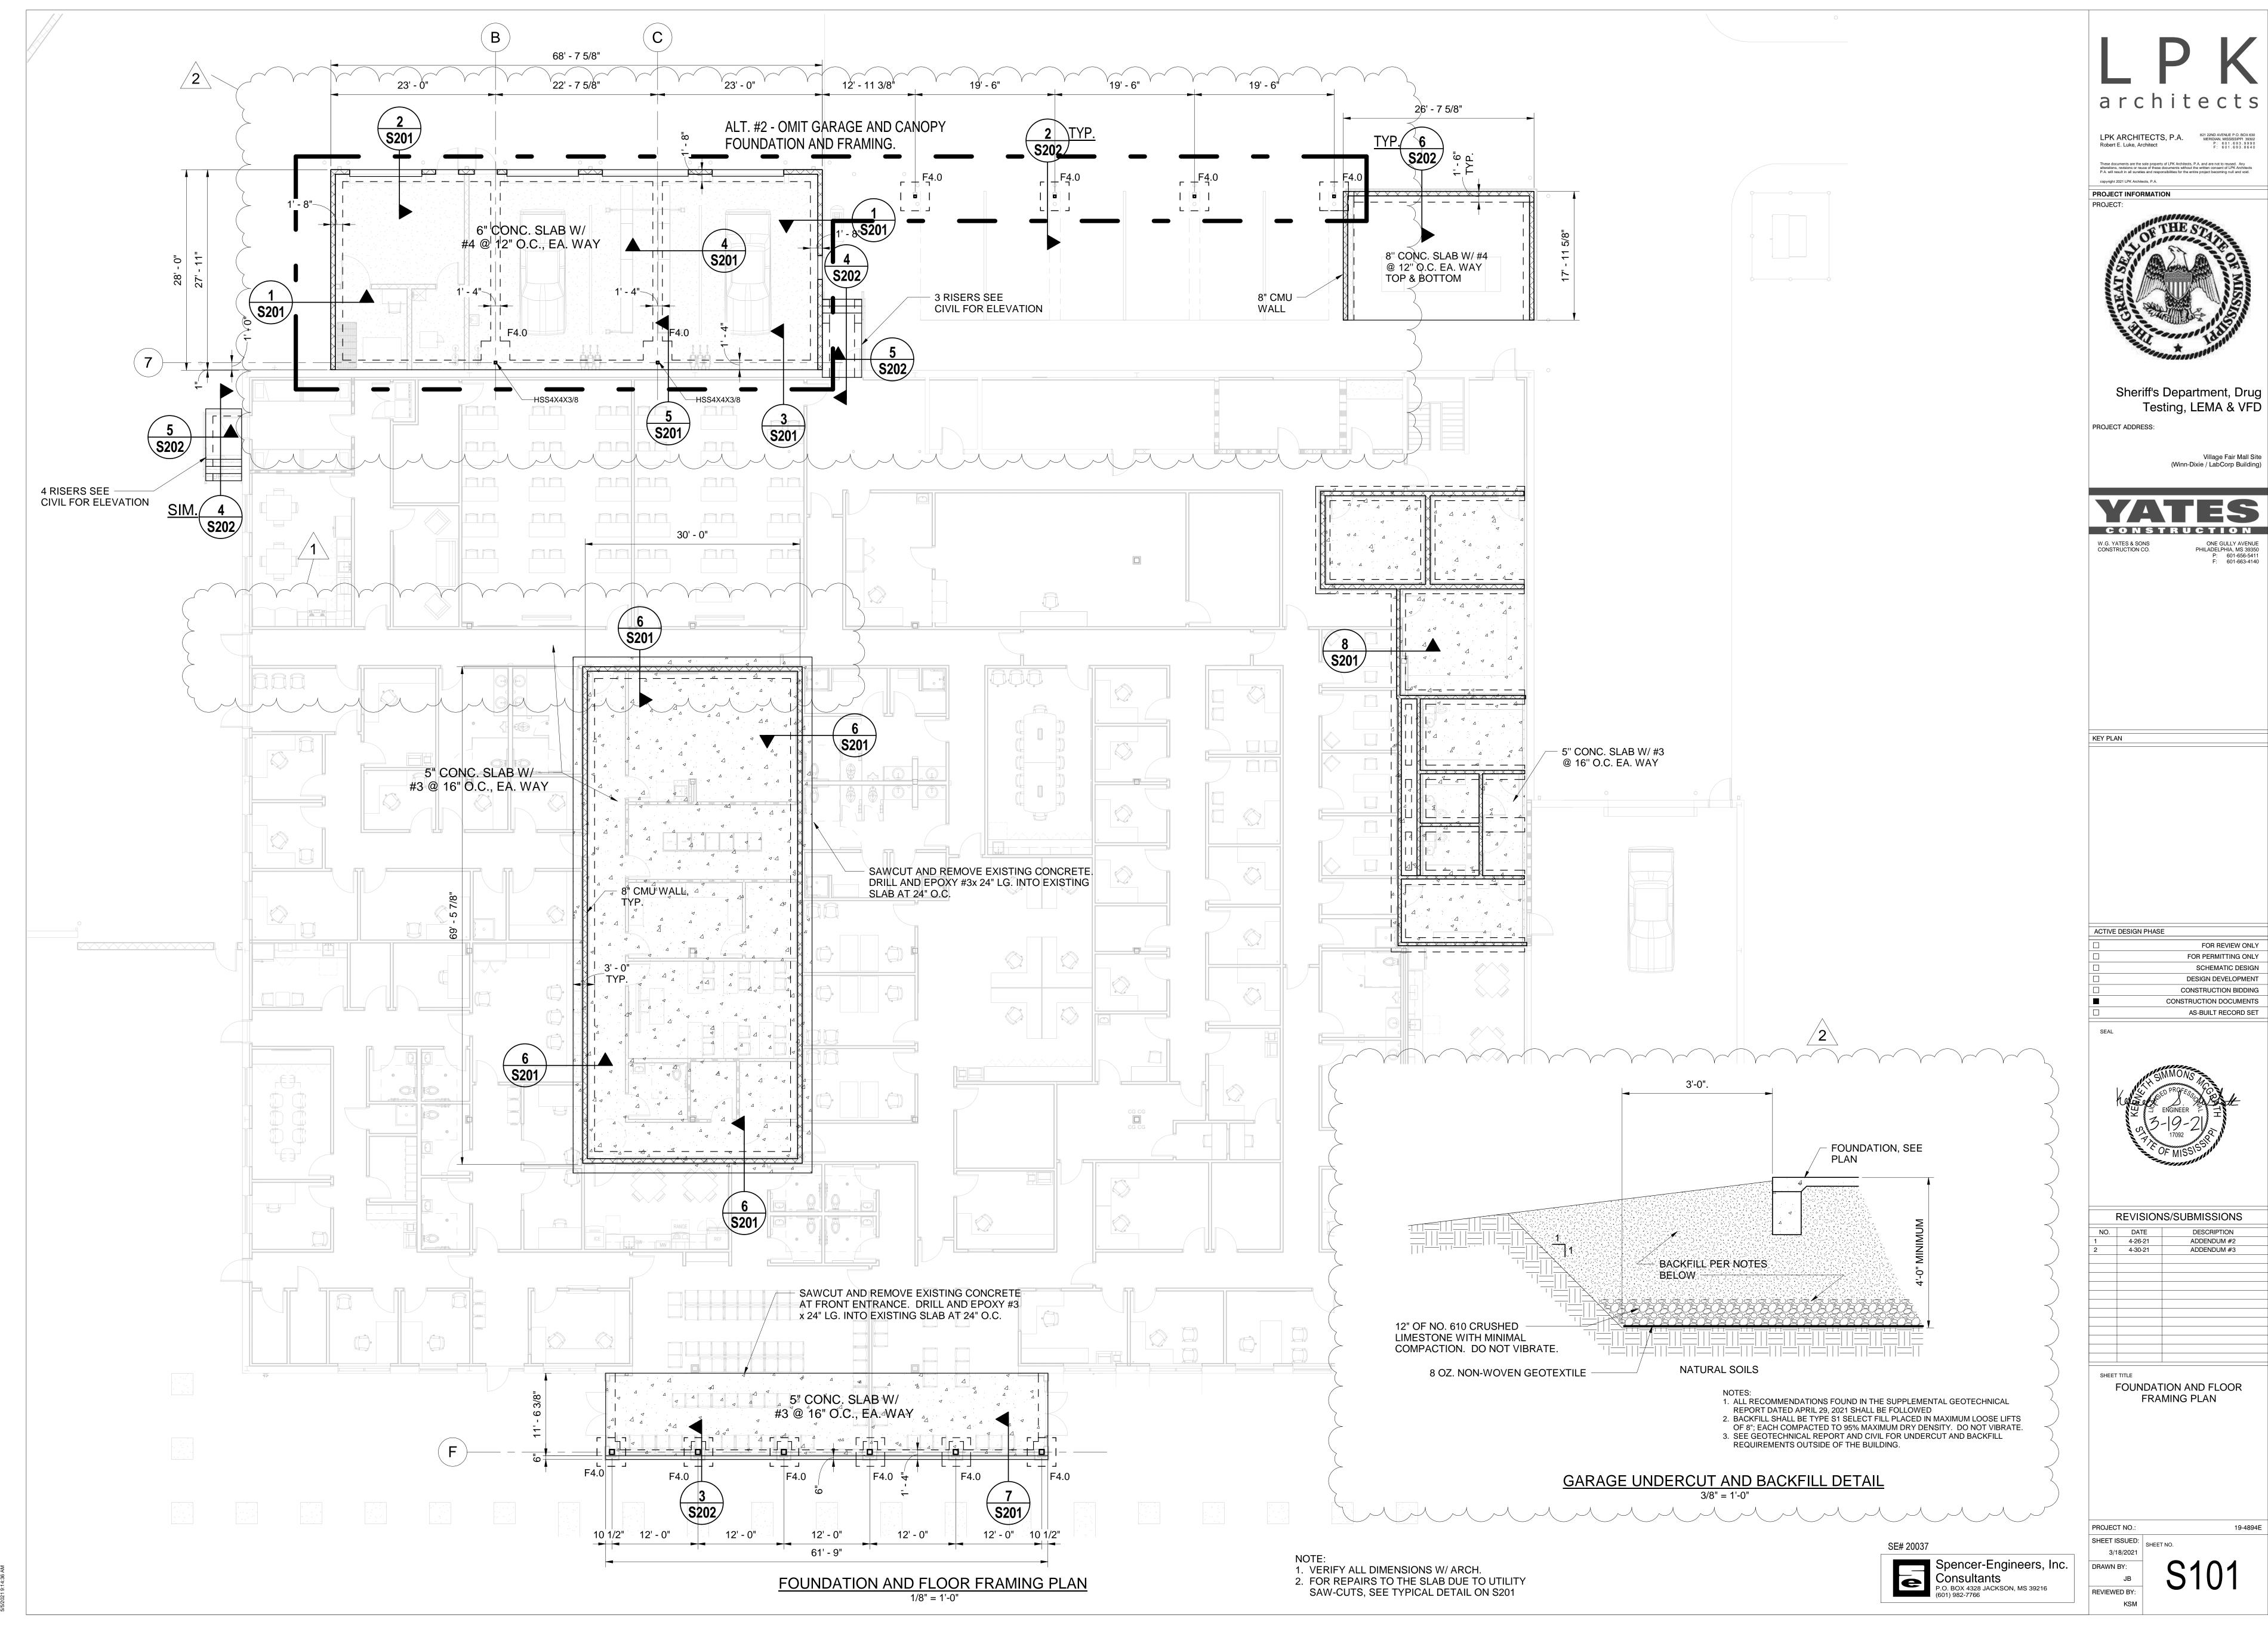




FOR REVIEW ONLY FOR PERMITTING ONLY SCHEMATIC DESIGN DESIGN DEVELOPMENT CONSTRUCTION BIDDING CONSTRUCTION DOCUMENTS

REVISIONS/SUBMISSIONS						
NO.	DATE	DESCRIPTION				
1	4-26-21	ADDENDUM #2				
2	4-30-21	ADDENDUM #3				

19-4894E

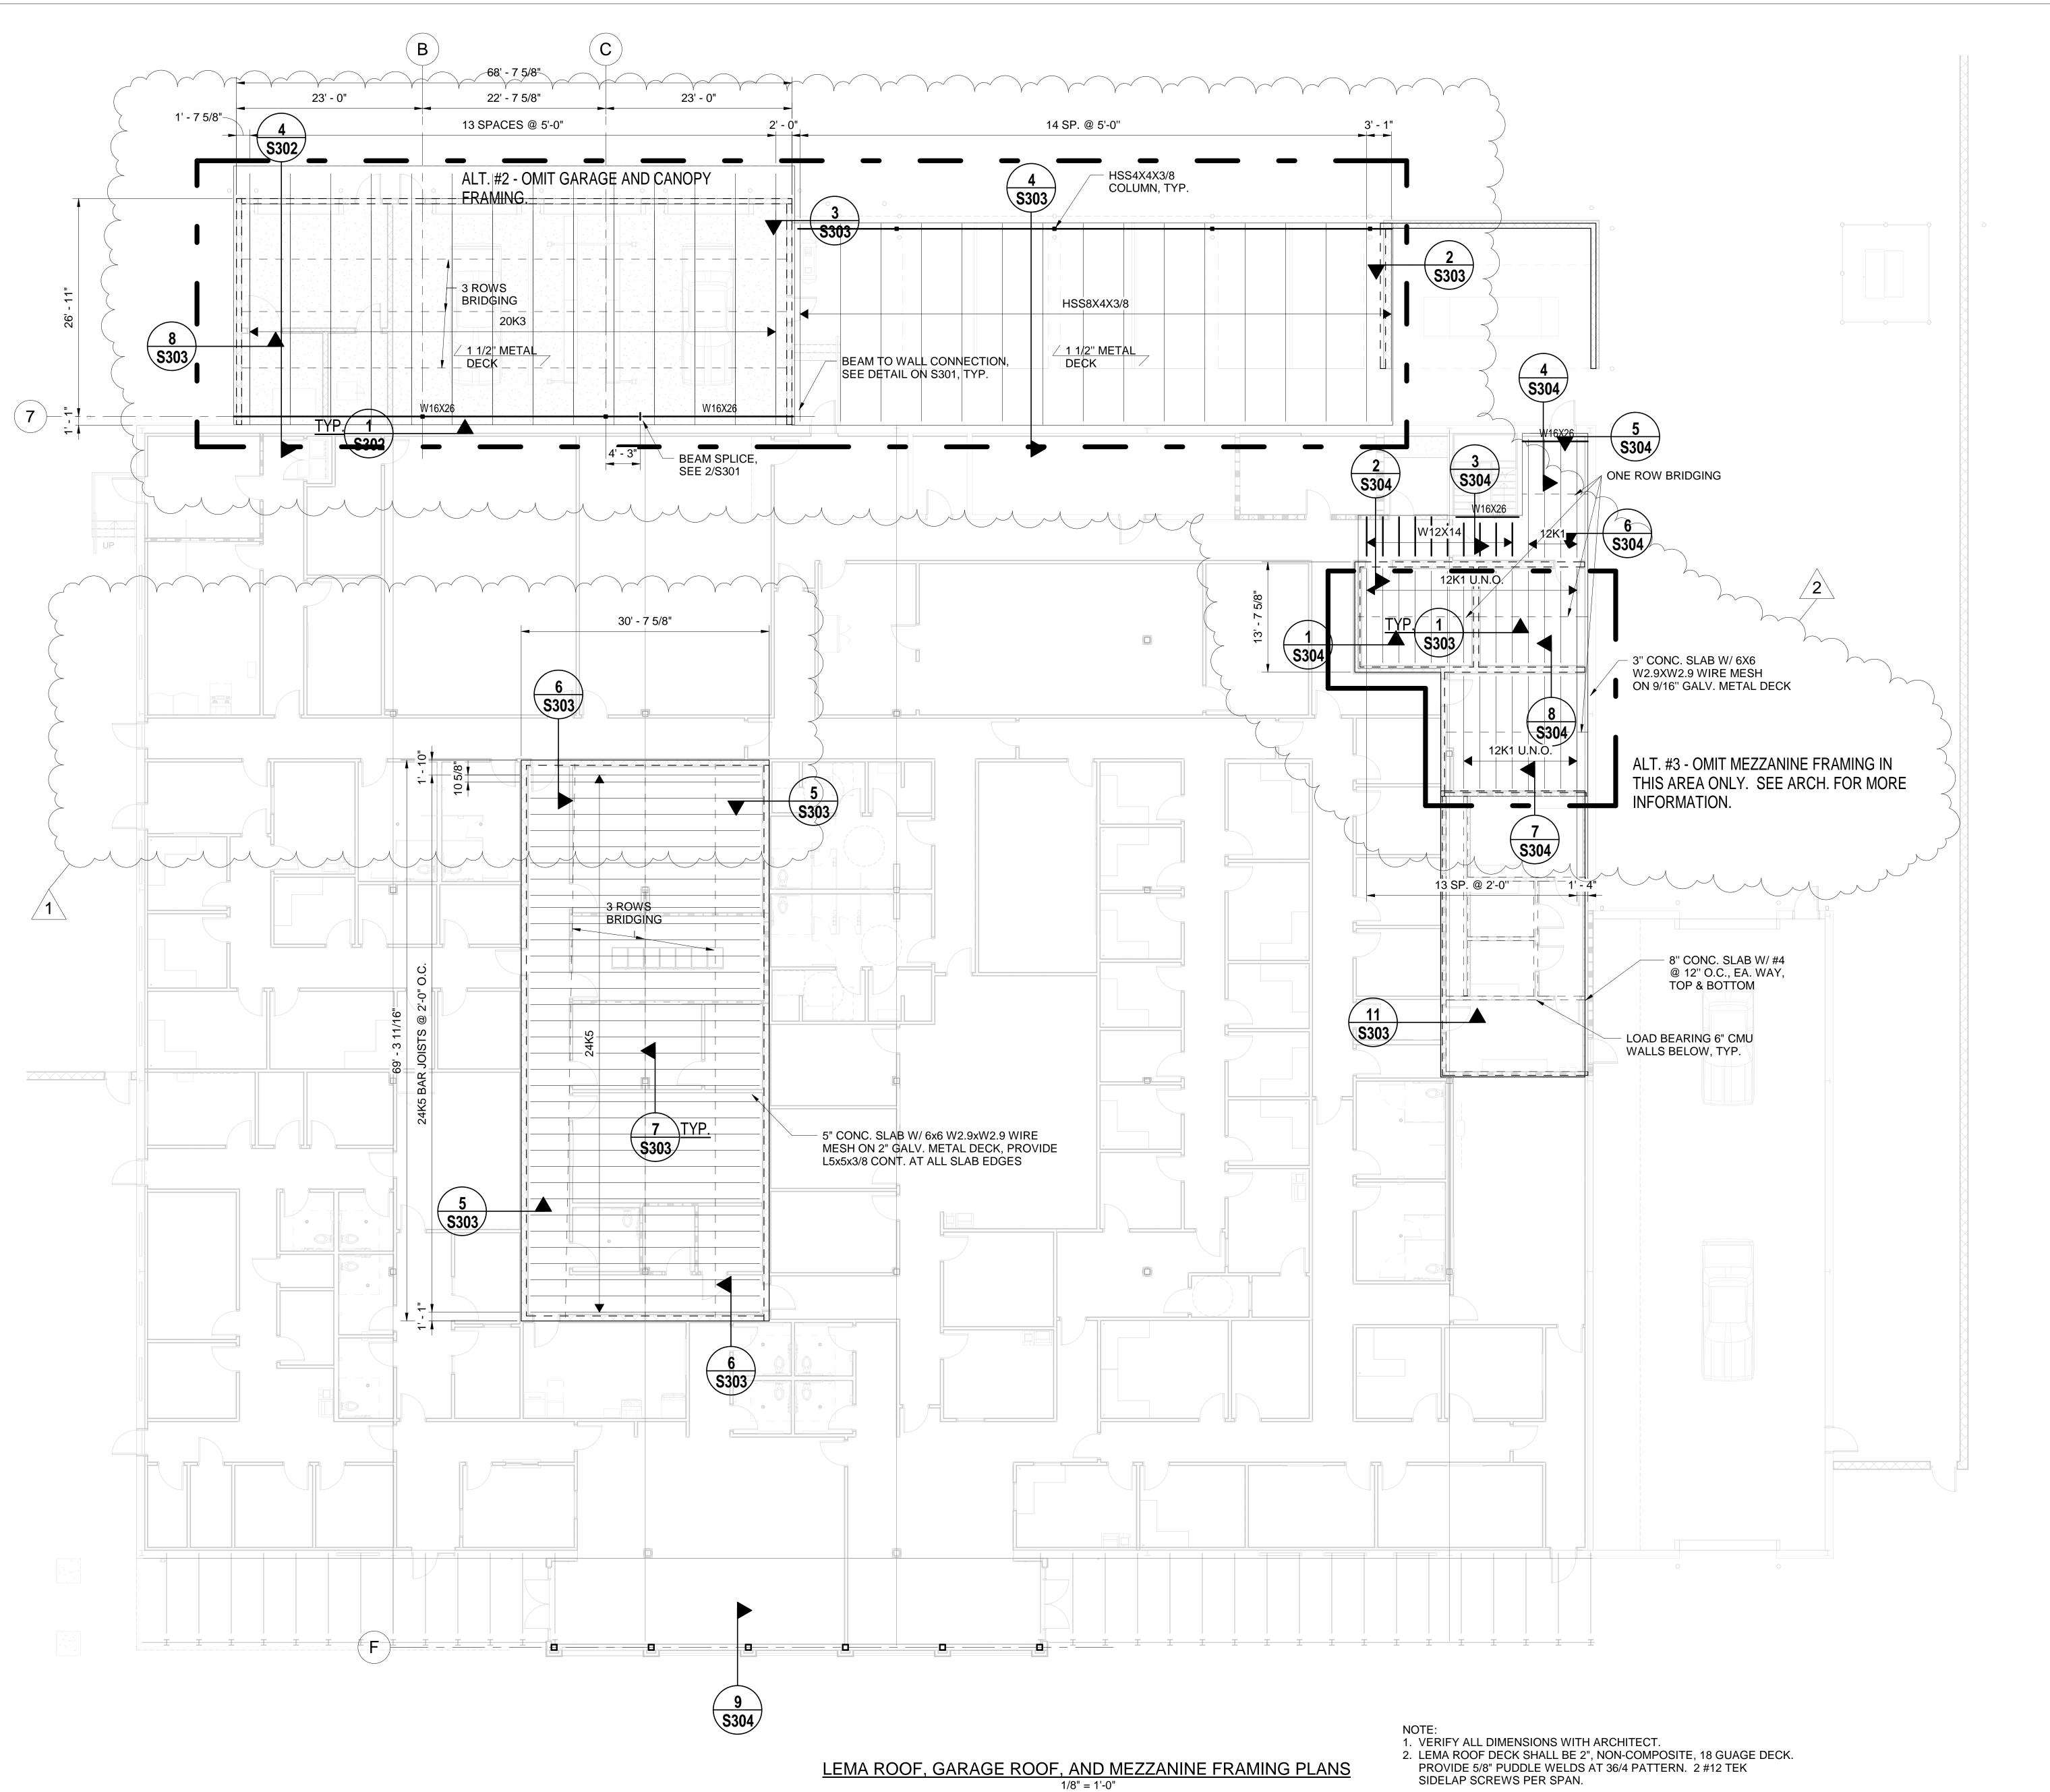

LPK ARCHITECTS, P.A.

Robert E. Luke, Architect

821 22ND AVENUE P.O. BOX 630 MERIDIAN, MISSISSIPP1 3930 P: 601.693, 9990 F: 601.693, 8640



Sheriff's Department, Drug Testing, LEMA & VFD

Village Fair Mall Site (Winn-Dixie / LabCorp Building)

ONE GULLY AVENUE PHILADELPHIA, MS 39350 P: 601-656-5411 F: 601-663-4140 W.G. YATES & SONS CONSTRUCTION CO.

ACTIVE DESIGN PHASE

FOR REVIEW ONLY FOR PERMITTING ONLY SCHEMATIC DESIGN DESIGN DEVELOPMENT CONSTRUCTION BIDDING CONSTRUCTION DOCUMENTS

AS-BUILT RECORD SET




F	REVISION	NS/SUBMISSION:
NO.	DATE	DESCRIPTION
1	4-26-21	ADDENDUM #2
2	4-30-21	ADDENDUM #3

LEMA ROOF, GARAGE ROOF, AND MEZZANINE FRAMING **PLANS**

19-4894E

PROJECT NO.: SHEET ISSUED: SHEET NO.

SIDELAP SCREWS PER SPAN.

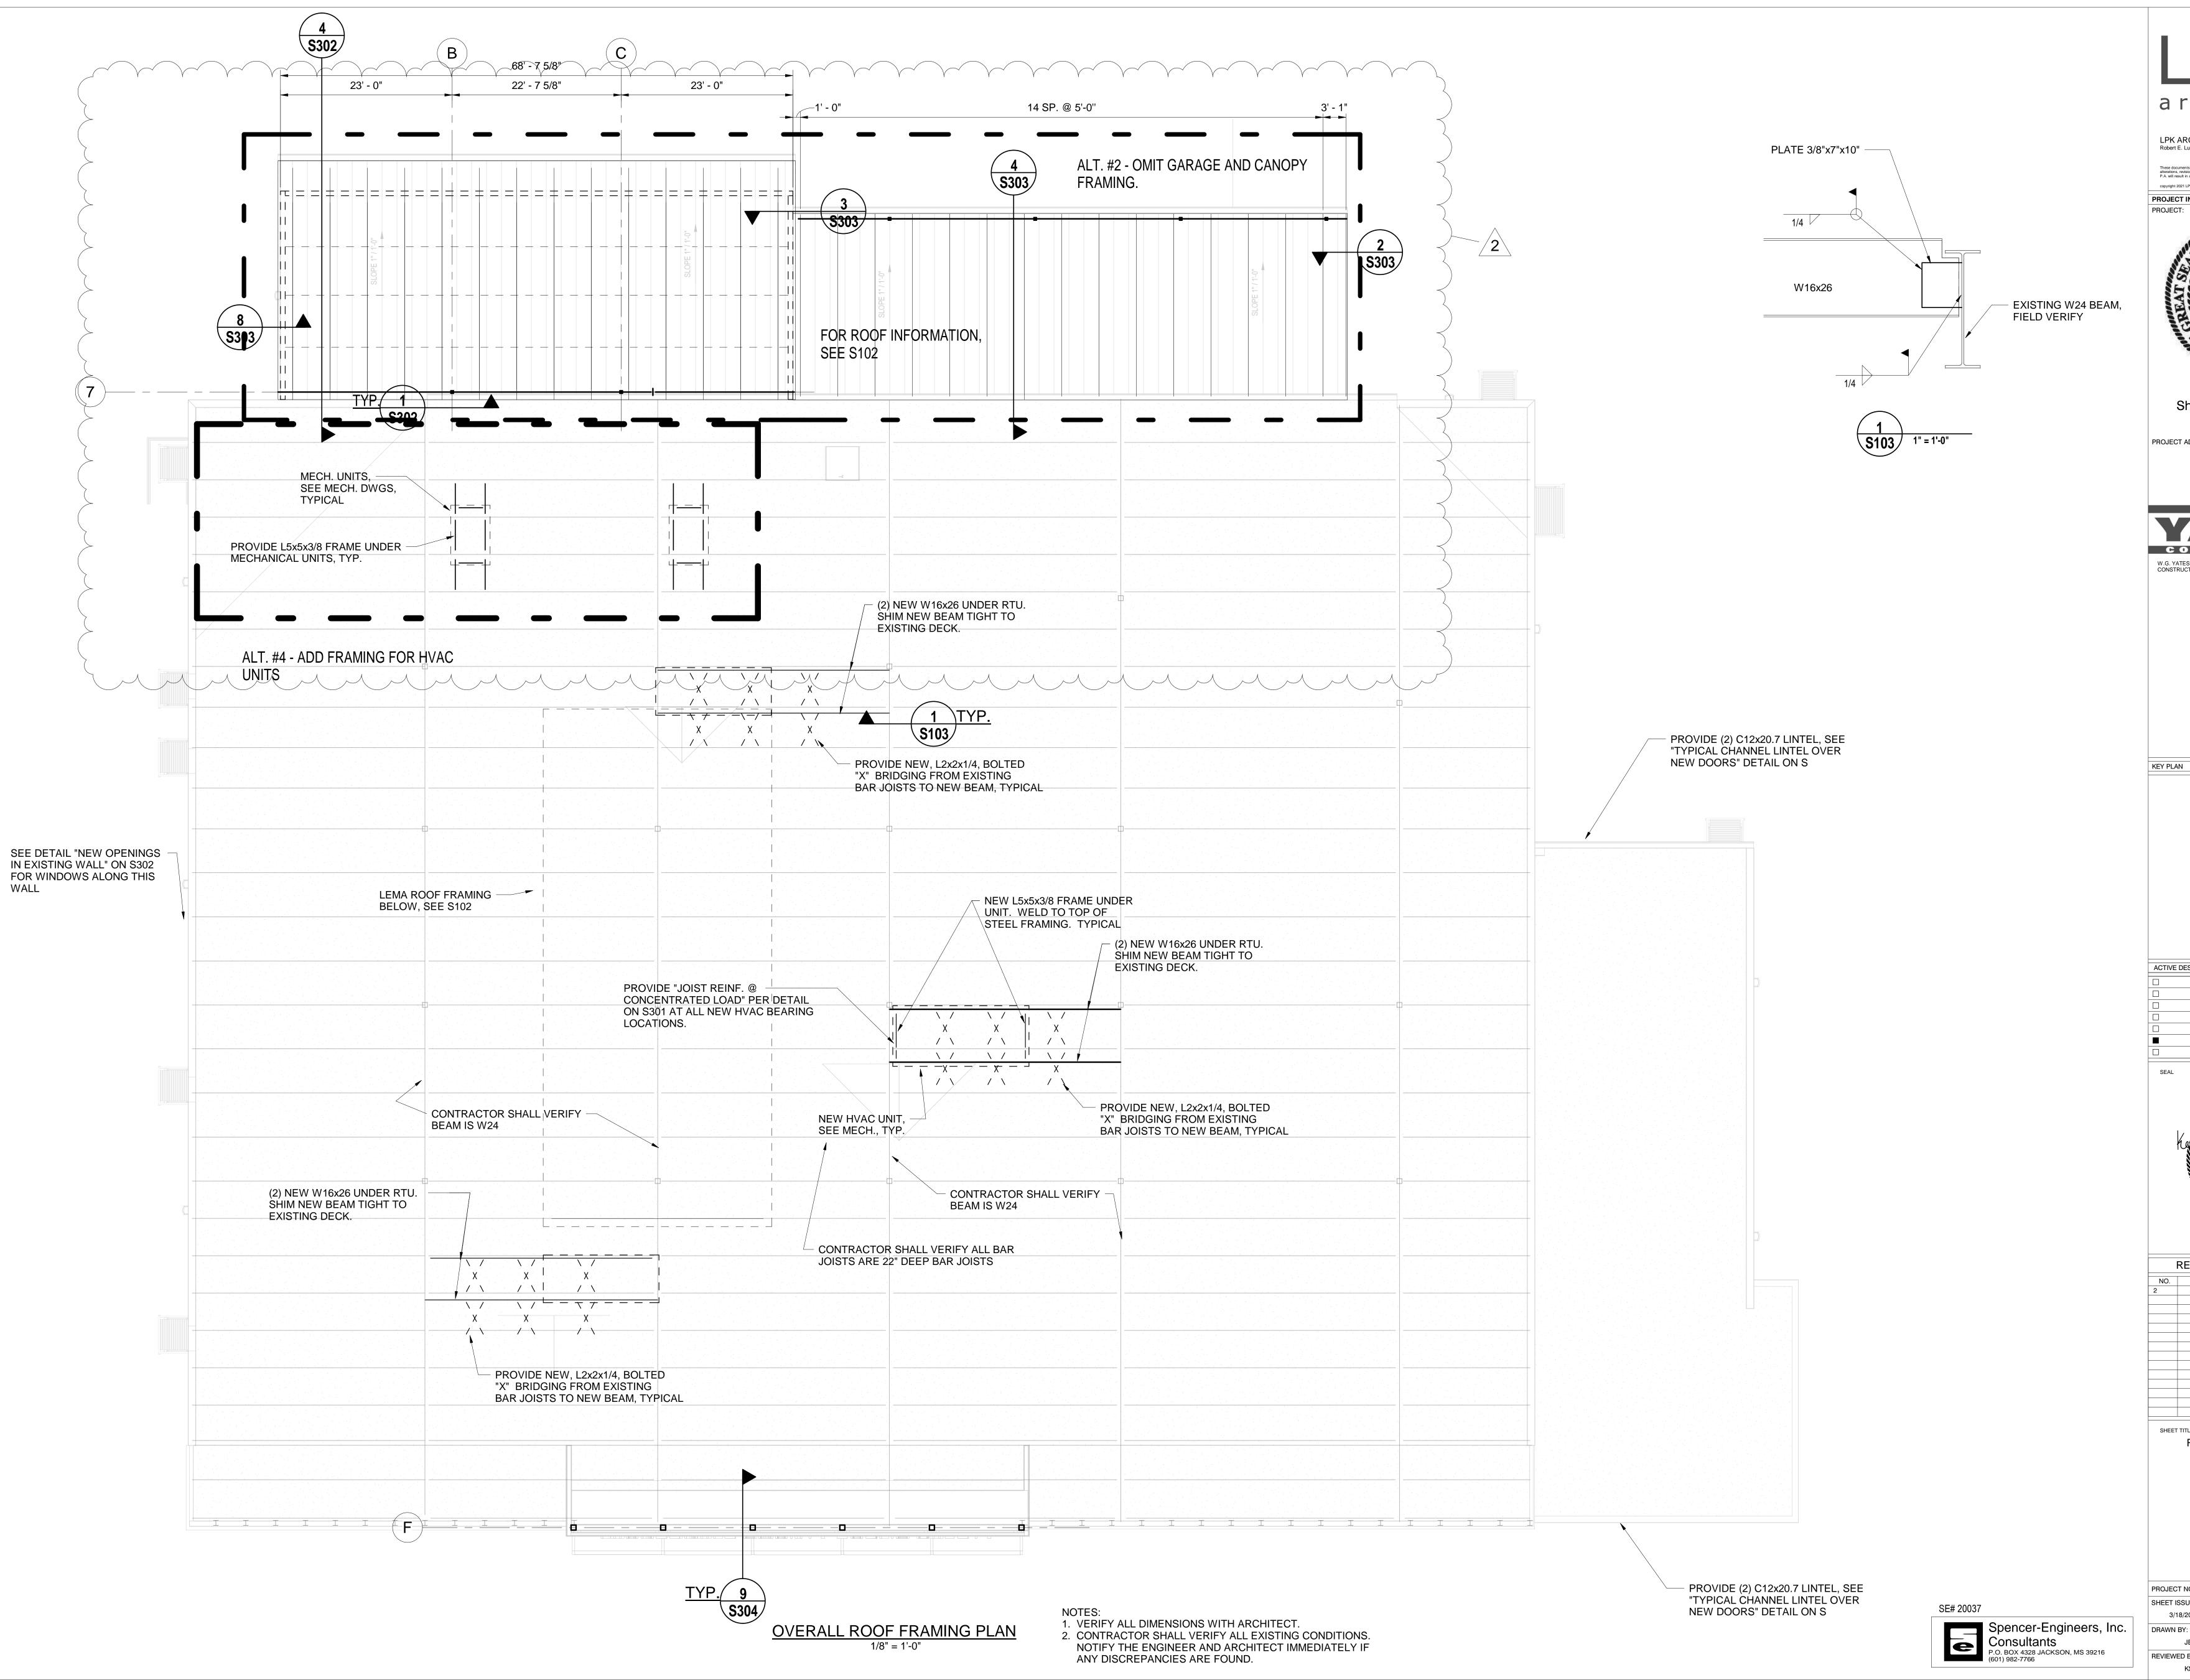

LPK ARCHITECTS, P.A.

Robert E. Luke, Architect

821 22ND AVENUE P.O. BOX 630
MERIDIAN, MISSISSIPPI 39302
P: 601.693, 8990
P: 601.693, 8640

PROJECT INFORMATION



Sheriff's Department, Drug Testing, LEMA & VFD

PROJECT ADDRESS:

Village Fair Mall Site (Winn-Dixie / LabCorp Building)

ONE GULLY AVENUE PHILADELPHIA, MS 39350 P: 601-656-5411 F: 601-663-4140 W.G. YATES & SONS CONSTRUCTION CO.

ACTIVE DESIGN PHASE

FOR REVIEW ONLY FOR PERMITTING ONLY SCHEMATIC DESIGN DESIGN DEVELOPMENT CONSTRUCTION BIDDING CONSTRUCTION DOCUMENTS

AS-BUILT RECORD SET




REVISIONS/SUBMISSIONS						
NO.	DATE	DESCRIPTION				
2	4-30-21	ADDENDUM #3				
I		I .				

SHEET TITLE ROOF FRAMING PLAN

PROJECT NO.: 19-4894E SHEET ISSUED: SHEET NO.

DRAWN BY: REVIEWED BY:

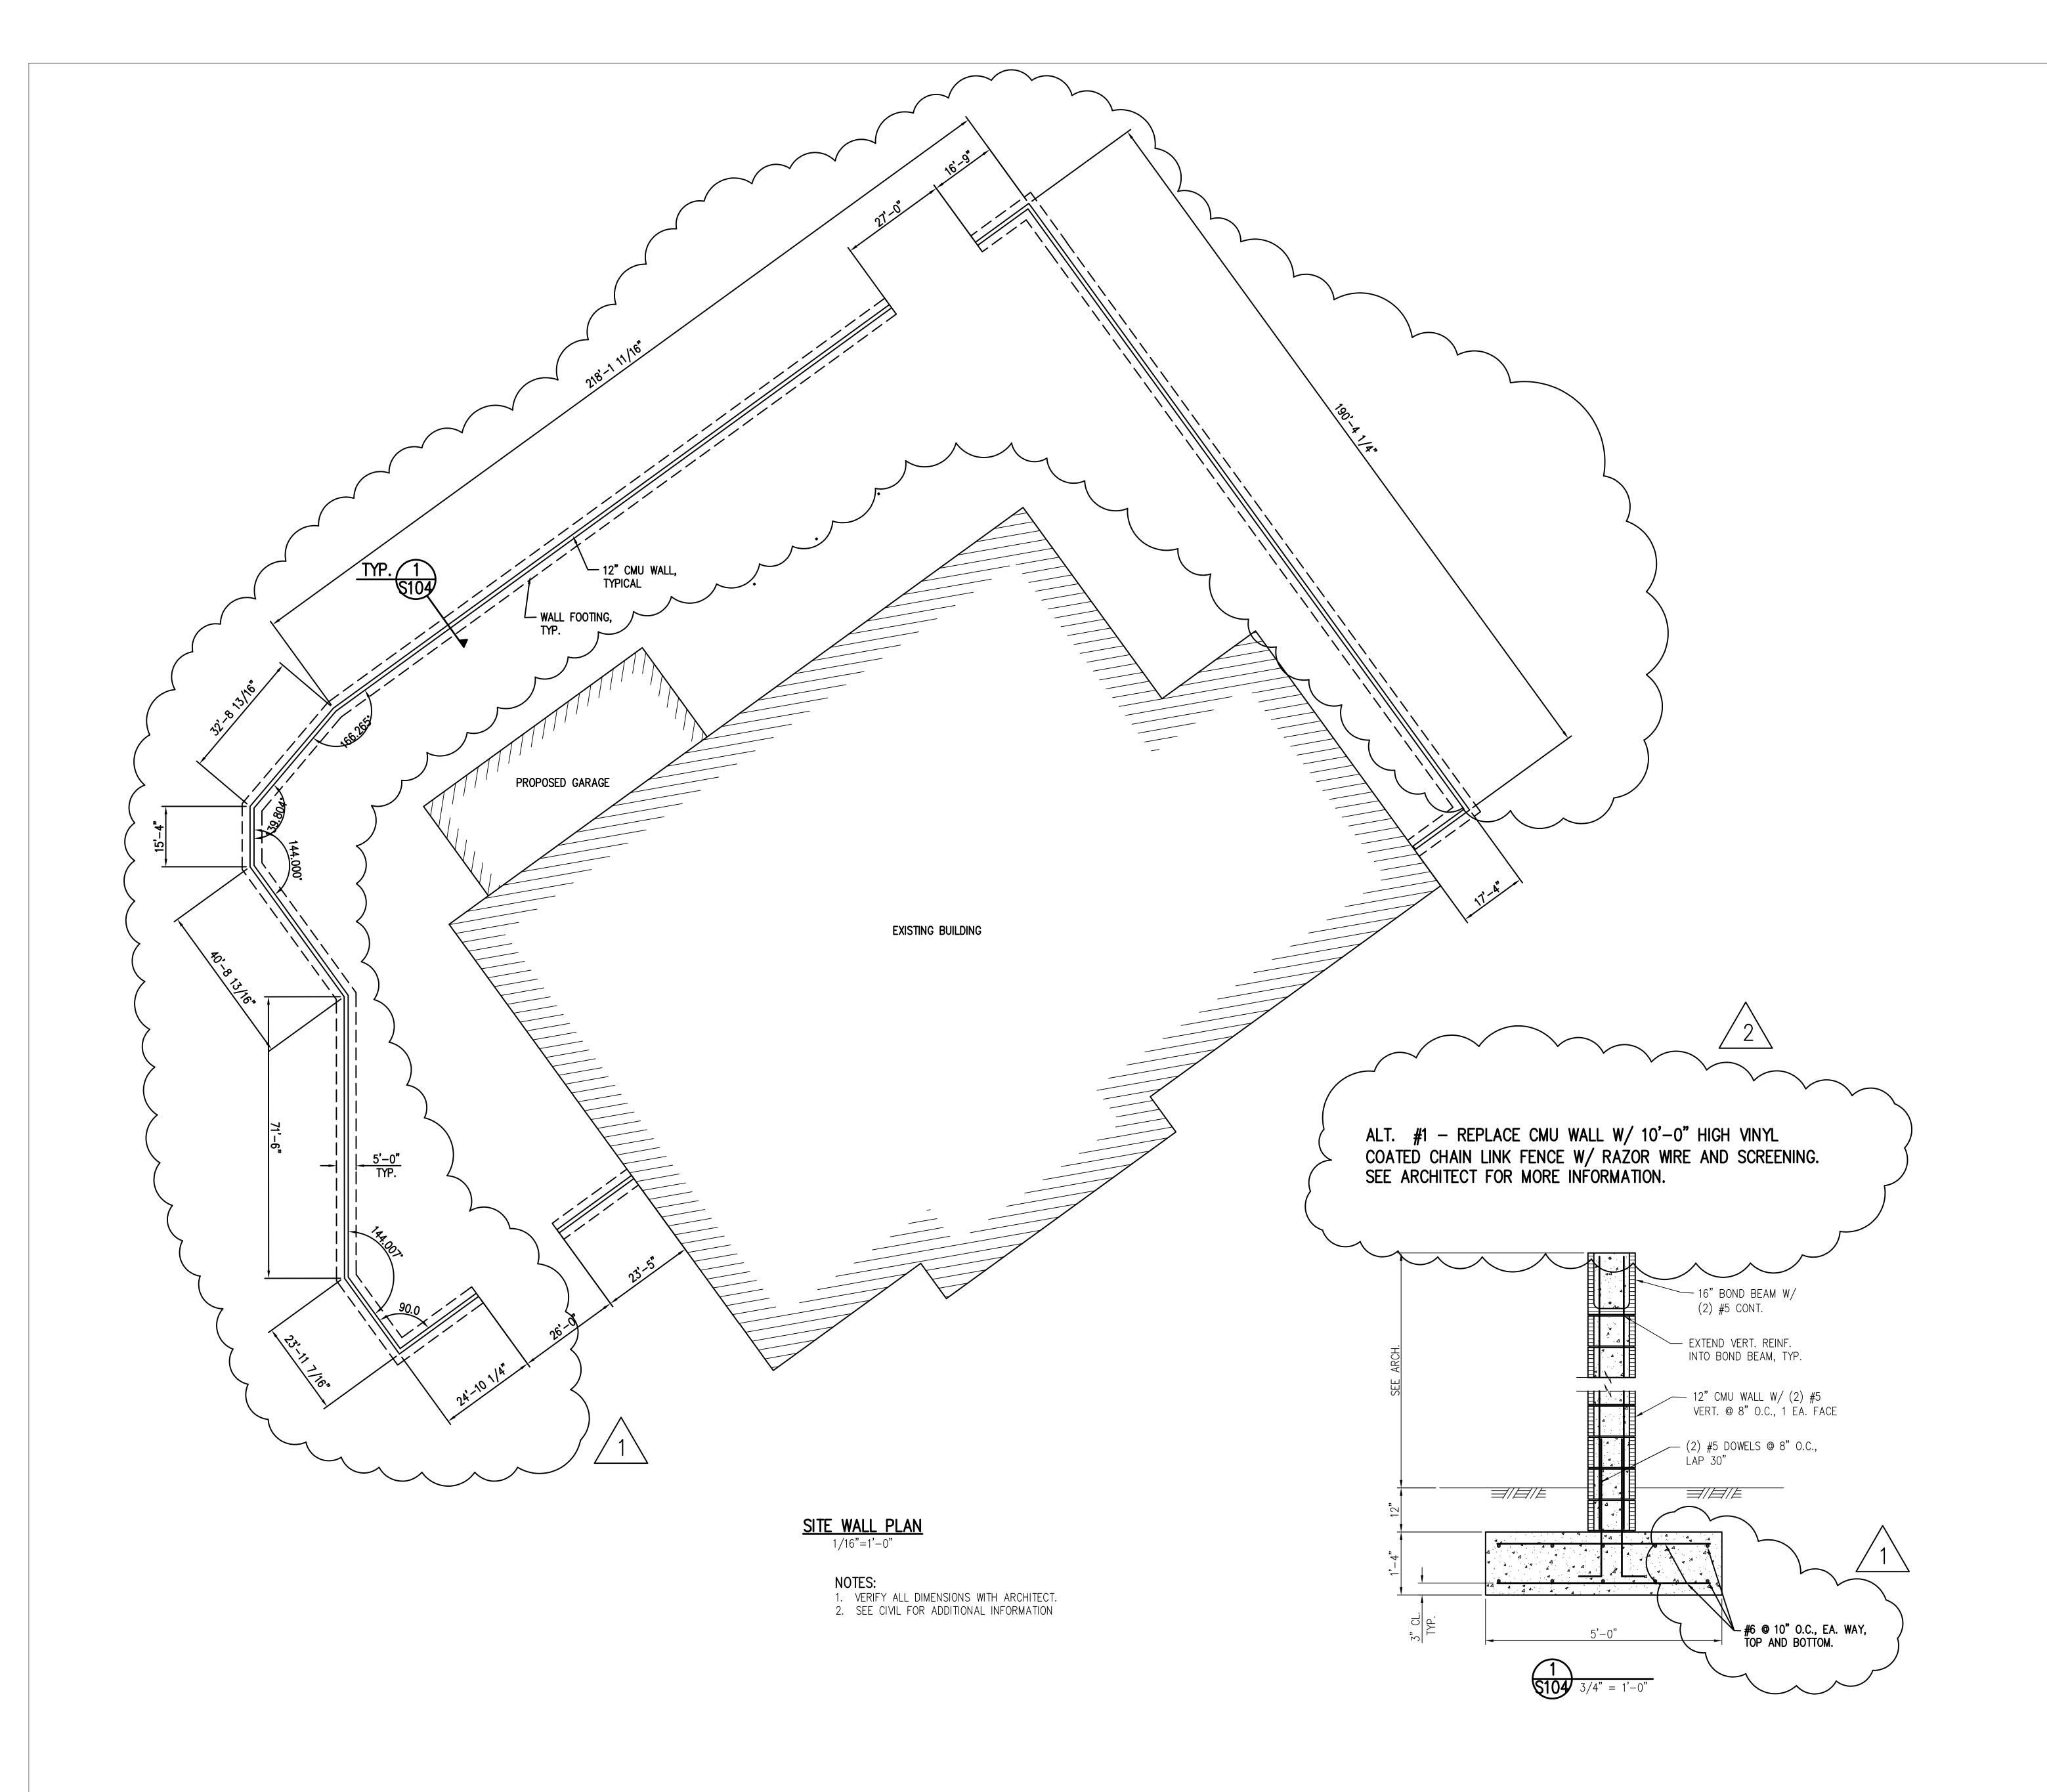



LPK ARCHITECTS, P.A.

Robert E. Luke, Architect

821 22ND AVEN
MERIDIAN, MI
P: 60
F: 60

These documents are the sole property of LPK Architects P.A. and are not to reused. Any alterations, revisions or reuse of these documents without the written consent of LPK Architects I will result in all sureties and responsibilities for the entire project becoming null and vold. copyright 2020 LPK Architects, P.A.

PROJECT INFORMATION



Sheriff's Department, Drug Testing, LEMA & VFD

PROJECT ADDRESS:

612 22ND AVENUE MERIDIAN, MS 39301

W.G. YATES & SONS
CONSTRUCTION CO.

ONE GULLY AVENUE
PHILADELPHIA, MS 39350
P: 601-656-5411
F: 601-663-4140

KEY PLAI

ACTIVE DESIGN PHASE

FOR REVIEW ONLY
FOR PERMITTING ONLY
SCHEMATIC DESIGN
DESIGN DEVELOPMENT

 □
 CONSTRUCTION BIDDING

 ■
 CONSTRUCTION DOCUMENTS

 □
 AS-BUILT RECORD SET



REVISIONS/SUBMISSIONS			
NO.	DATE	DESCRIPTION	
1	4-26-21	ADDENDUM #2	
2	4-30-21	ADDENDUM #3	

SITE WALL PLAN

PROJECT NO.:

SHEET ISSUED: SHEET NO.

SHEET ISSUED:
03/18/2021


DRAWN BY:
KSM

REVIEWED BY:

19-4894 D

SE# 20037

Spencer-Engineers, Inc.
Consultants
P.O. BOX 4328 JACKSON, MS 39216
(601) 982-7766

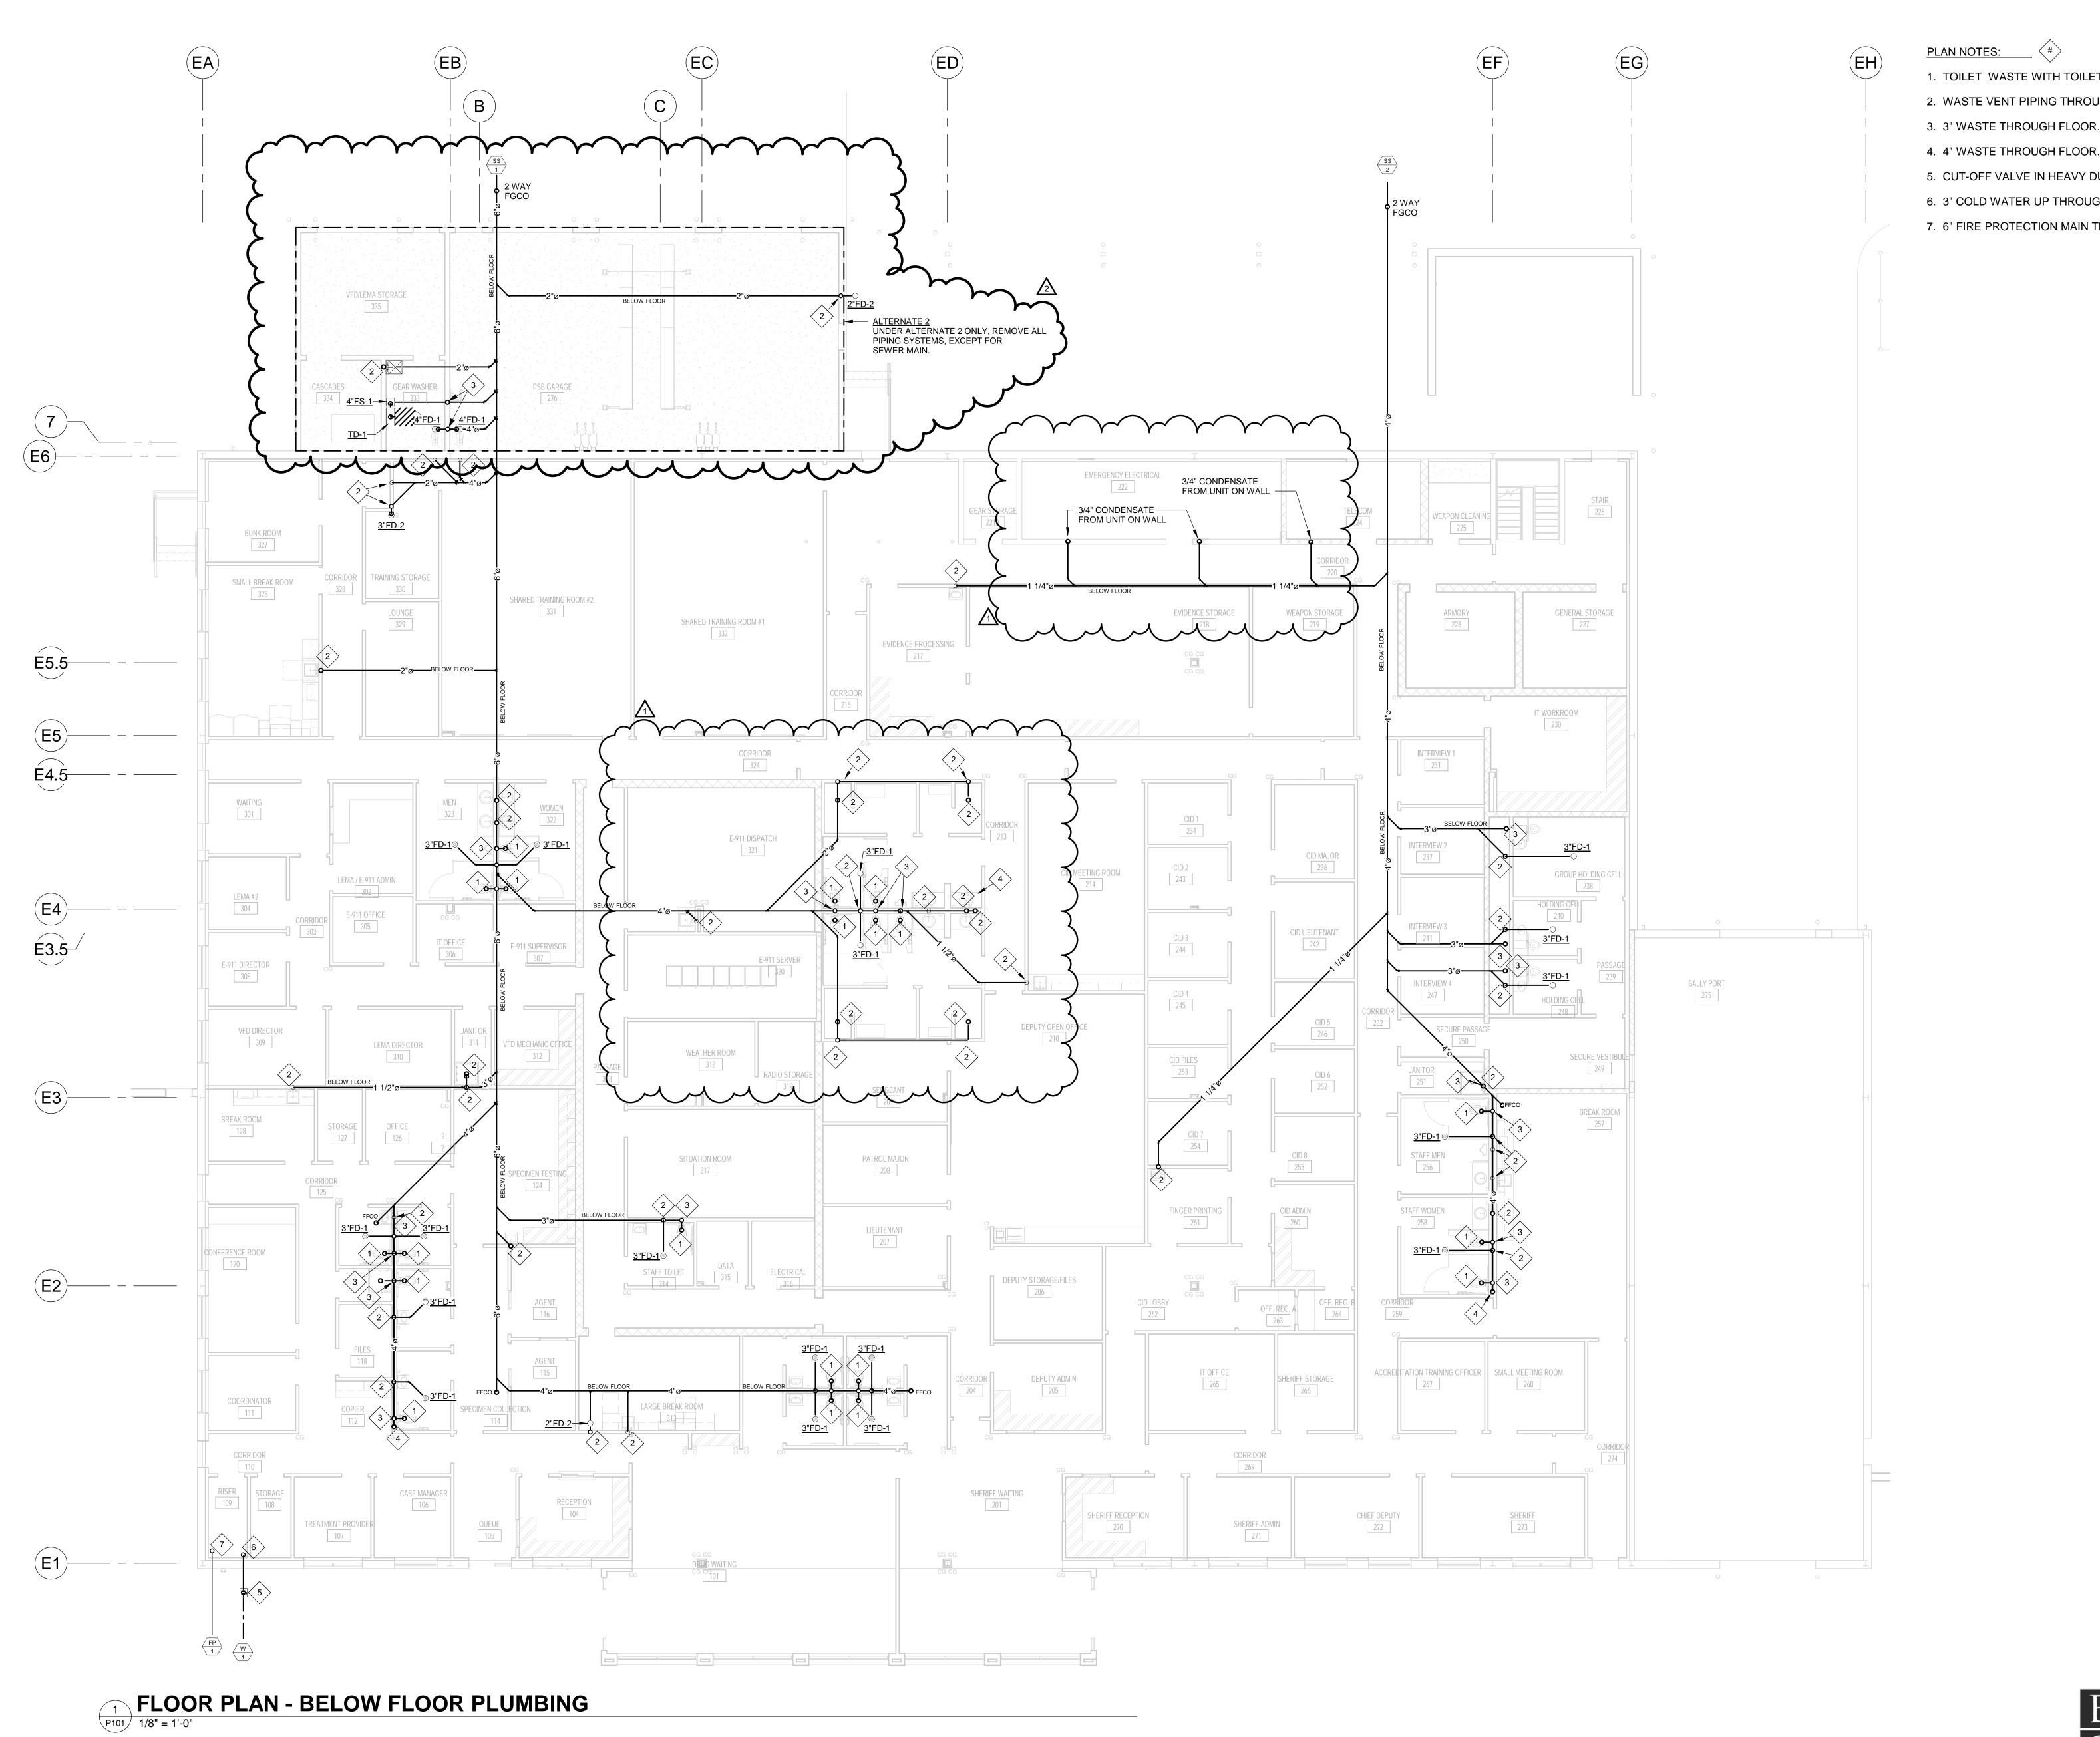

1. TOILET WASTE WITH TOILET FLANGE TROUGH FLOOR.

2. WASTE VENT PIPING THROUGH FLOOR.

4. 4" WASTE THROUGH FLOOR.

5. CUT-OFF VALVE IN HEAVY DUTY BOX WITH COVER.

6. 3" COLD WATER UP THROUGH FLOOR IN RISER ROOM.

7. 6" FIRE PROTECTION MAIN THROUGH FLOOR OF RISER ROOM.

architects

LPK ARCHITECTS, P.A.

Robert E. Luke, Architect

821 22ND AVENUE P.O. BOX 630
MERIDIAN, MISSISSIPPI 39302
P: 601.693.8940
P: 601.693.8640

PROJECT INFORMATION


Project Name

PROJECT ADDRESS:

Enter address here


ACTIVE DESIGN PHASE FOR REVIEW ONLY

FOR PERMITTING ONLY DESIGN DEVELOPMENT CONSTRUCTION BIDDING AS-BUILT RECORD SET

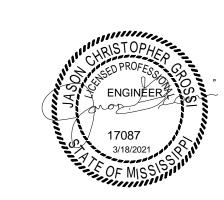

REVISIONS/SUBMISSIONS

FLOOR PLAN - BELOW FLOOR PLUMBING

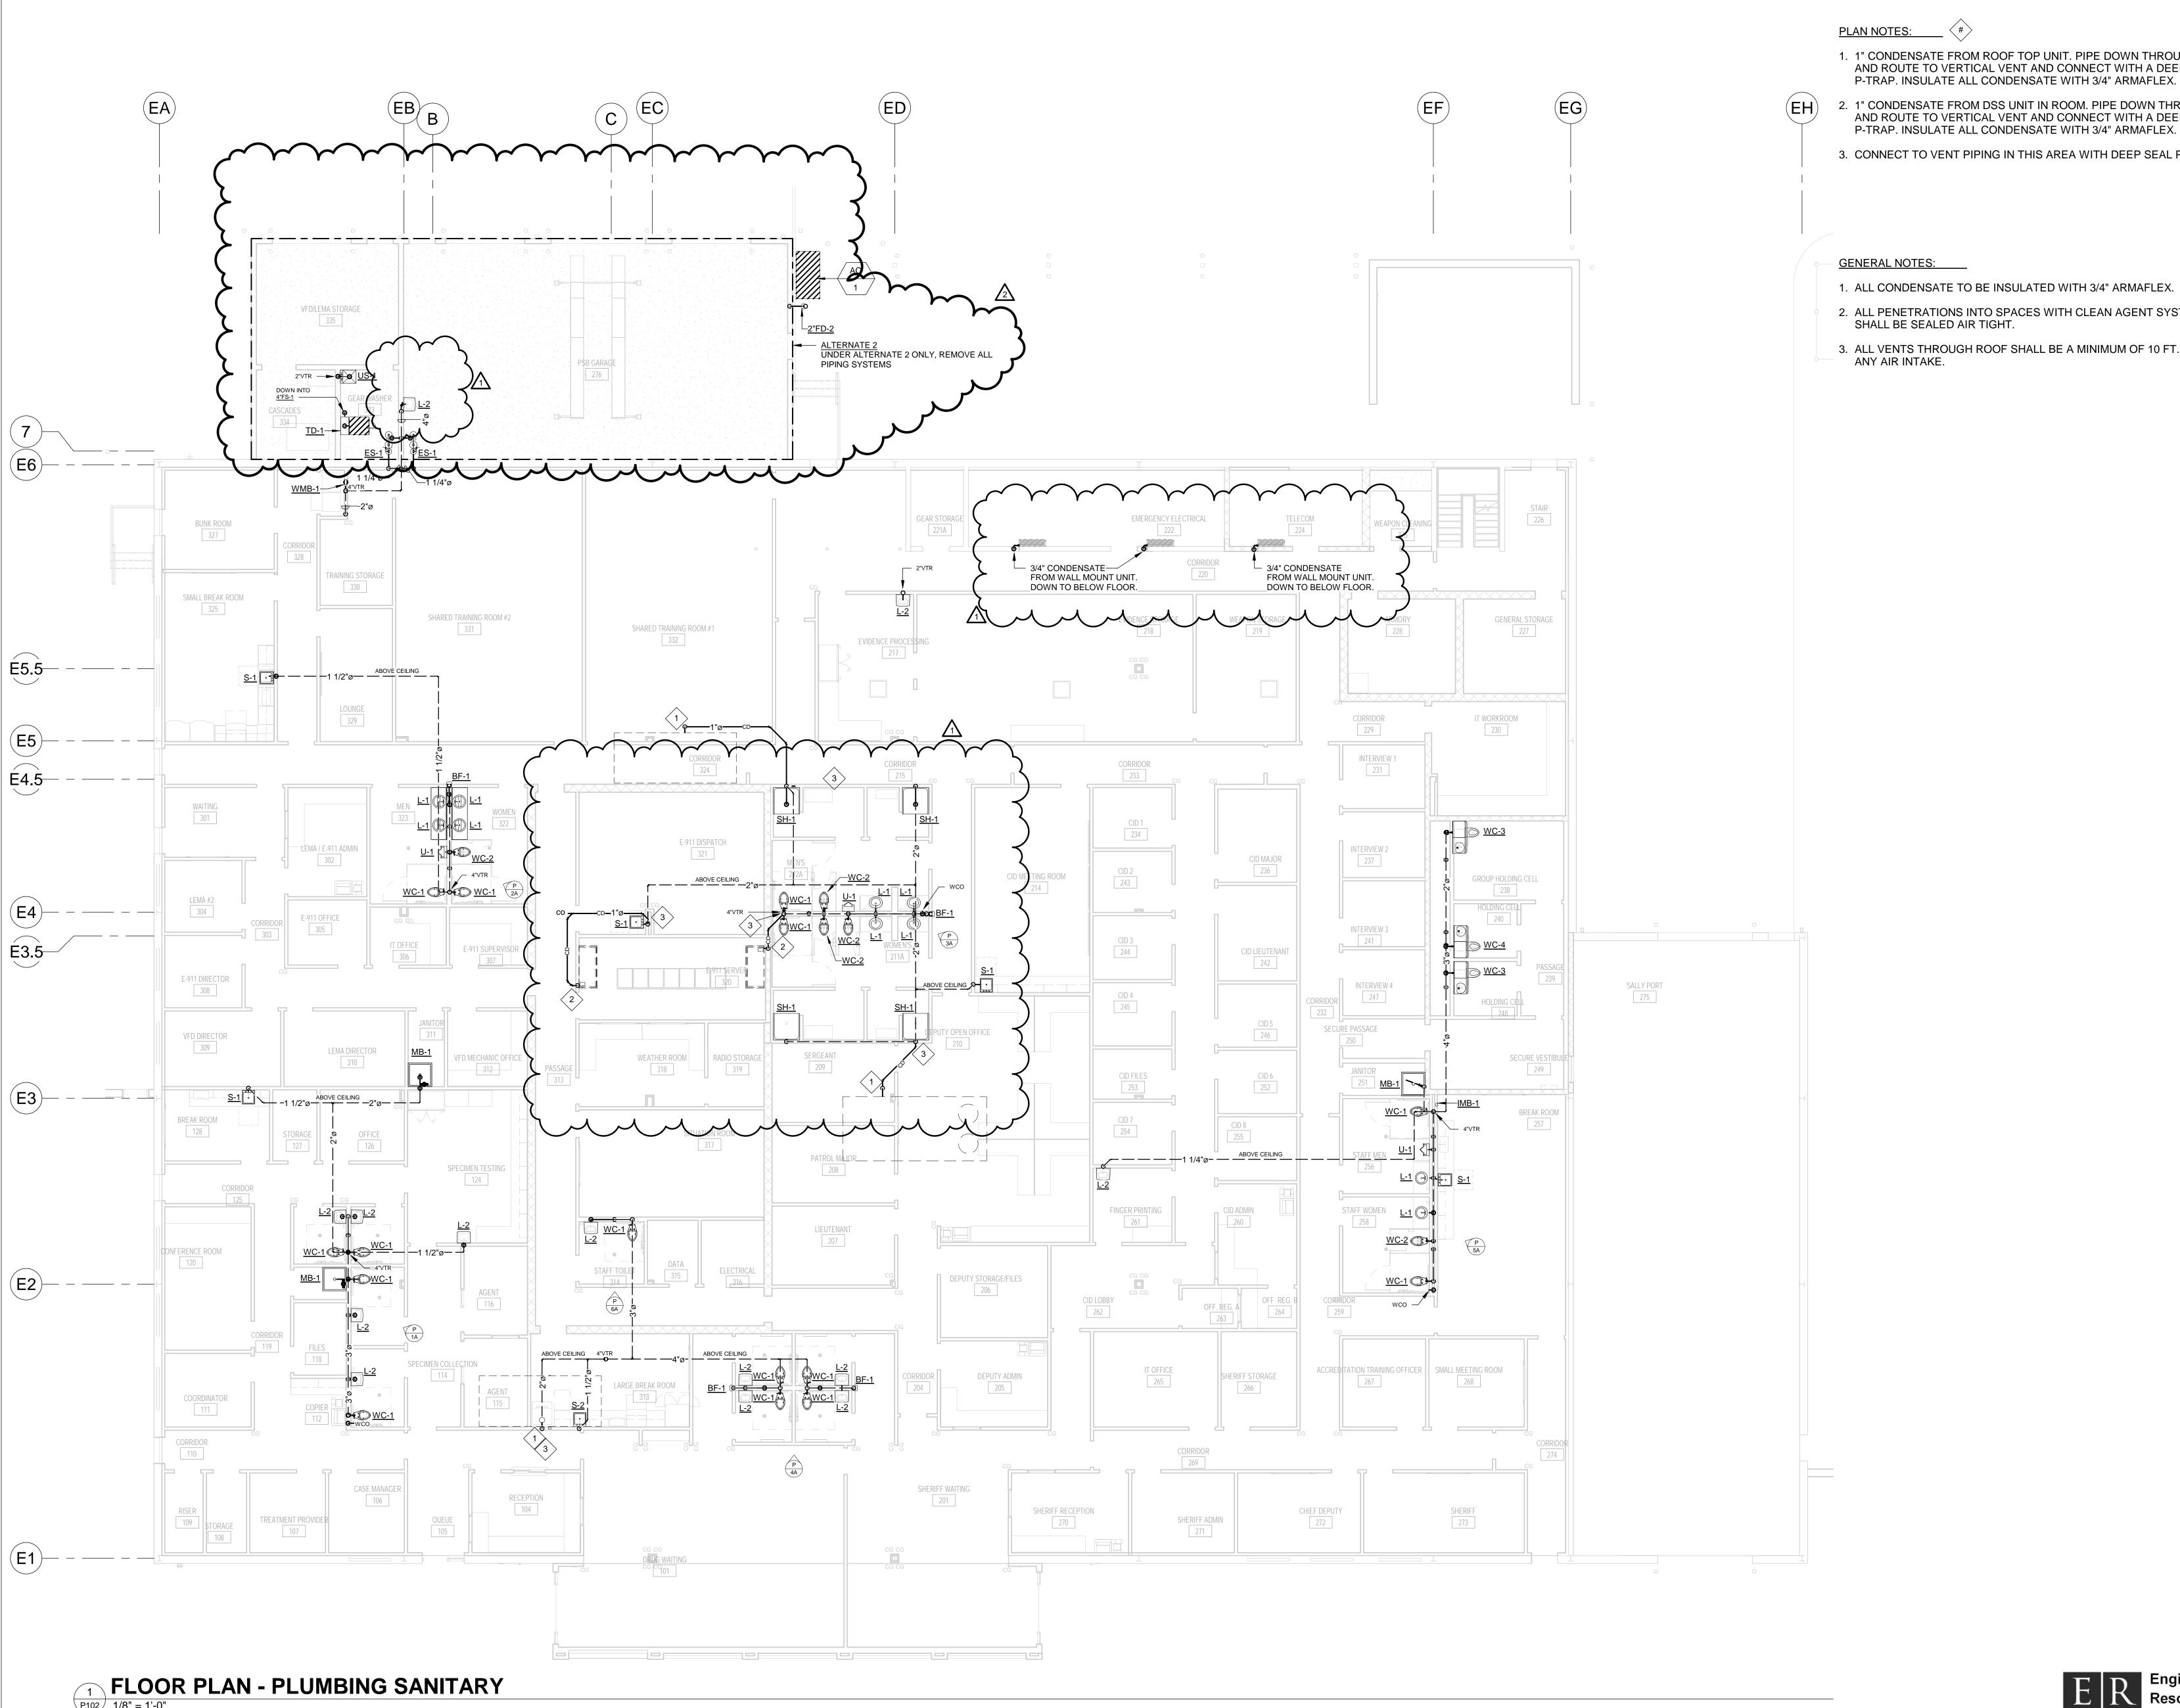

1. 1" CONDENSATE FROM ROOF TOP UNIT. PIPE DOWN THROUGH ROOF AND ROUTE TO VERTICAL VENT AND CONNECT WITH A DEEP SEAL P-TRAP. INSULATE ALL CONDENSATE WITH 3/4" ARMAFLEX.

. 1" CONDENSATE FROM DSS UNIT IN ROOM. PIPE DOWN THROUGH ROOF AND ROUTE TO VERTICAL VENT AND CONNECT WITH A DEEP SEAL

3. CONNECT TO VENT PIPING IN THIS AREA WITH DEEP SEAL P-TRAP.

GENERAL NOTES:

- 1. ALL CONDENSATE TO BE INSULATED WITH 3/4" ARMAFLEX.
- 2. ALL PENETRATIONS INTO SPACES WITH CLEAN AGENT SYSTEMS SHALL BE SEALED AIR TIGHT.
- 3. ALL VENTS THROUGH ROOF SHALL BE A MINIMUM OF 10 FT. FROM ANY AIR INTAKE.

architects

LPK ARCHITECTS, P.A.

Robert E. Luke, Architect

821 22ND AVENUE P.O. BOX 630
MERIDIAN, MISSISSIPPI 39302
P: 601.693.8940
P: 601.693.8640

PROJECT INFORMATION



Project Name

PROJECT ADDRESS:


Enter address here



ACTIVE DESIGN PHASE

FOR REVIEW ONLY FOR PERMITTING ONLY DESIGN DEVELOPMENT CONSTRUCTION BIDDING


AS-BUILT RECORD SET

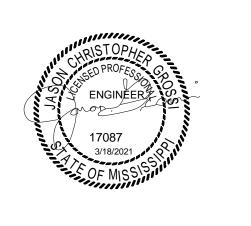

REVISIONS/SUBMISSIONS					
NO.	DATE DESCRIPTION				
1	04/26/2021	Addendum 2			
2	04/30/2021	Addendum 3			
	t				

FLOOR PLAN - PLUMBING SANITARY

350 Edgewood Terrace Drive Jackson, MS 39206 Phone: (601) 362-3552 Fax: (601) 366-6418

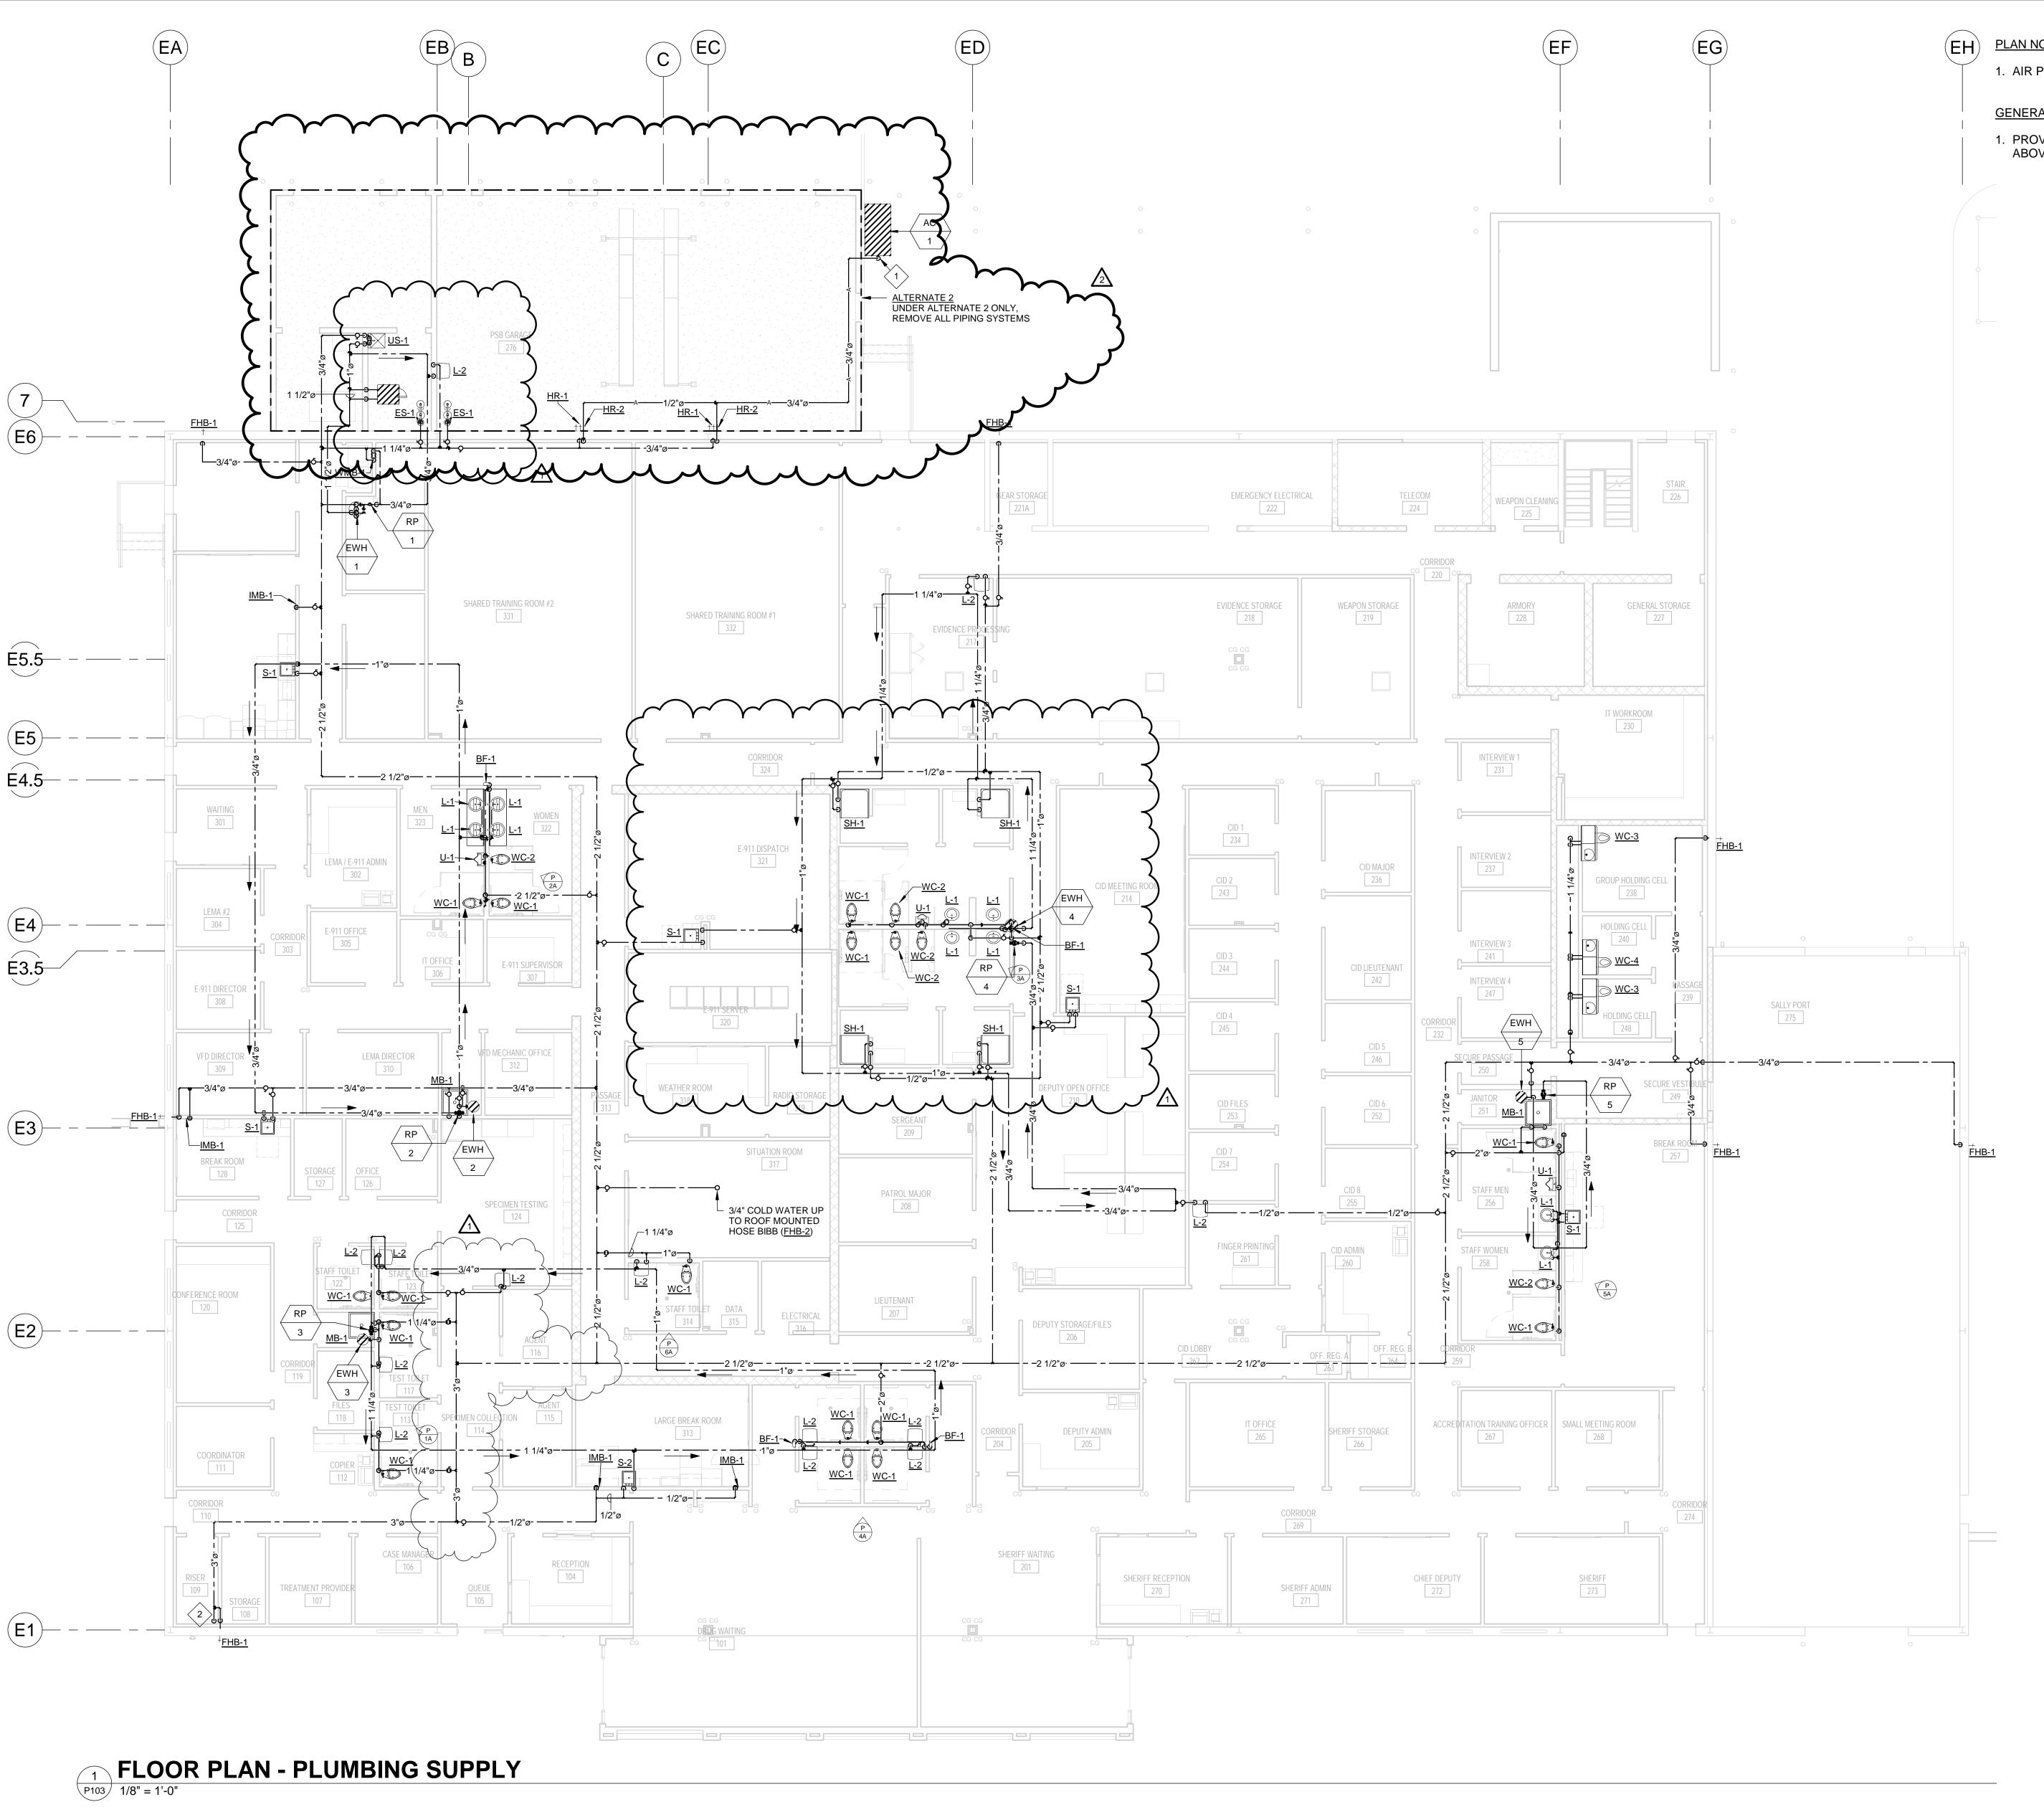

1. AIR PIPING TO RISE FROM AIR COMPRESSOR. ROUTE HIGH IN STRUCTURE

GENERAL NOTES:

PROVIDE ACCESS PANELS IN AREAS WHERE CUT-OFF VALVES OCCUR ABOVE HARD CEILINGS.

architects

LPK ARCHITECTS, P.A.

Robert E. Luke, Architect

821 22ND AVENUE P.O. BOX 630
MERIDIAN, MISSISSIPPI 39302
P: 601.693.8640
F: 601.693.8640




PROJECT ADDRESS:

Enter address here

ACTIVE DESIGN PHASE

FOR REVIEW ONLY FOR PERMITTING ONLY DESIGN DEVELOPMENT CONSTRUCTION BIDDING

AS-BUILT RECORD SET

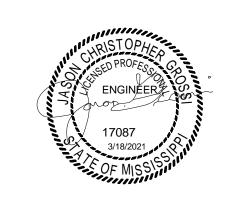


REVISIONS/SUBMISSIONS					
NO.	O. DATE DESCRIPTION				
1	04/26/2021	Addendum 2			
2	04/30/2021	Addendum 3			

FLOOR PLAN - PLUMBING SUPPLY

20.087 PROJECT NO.:

Jackson, MS 39206 Phone: (601) 362-3552 Fax: (601) 366-6418

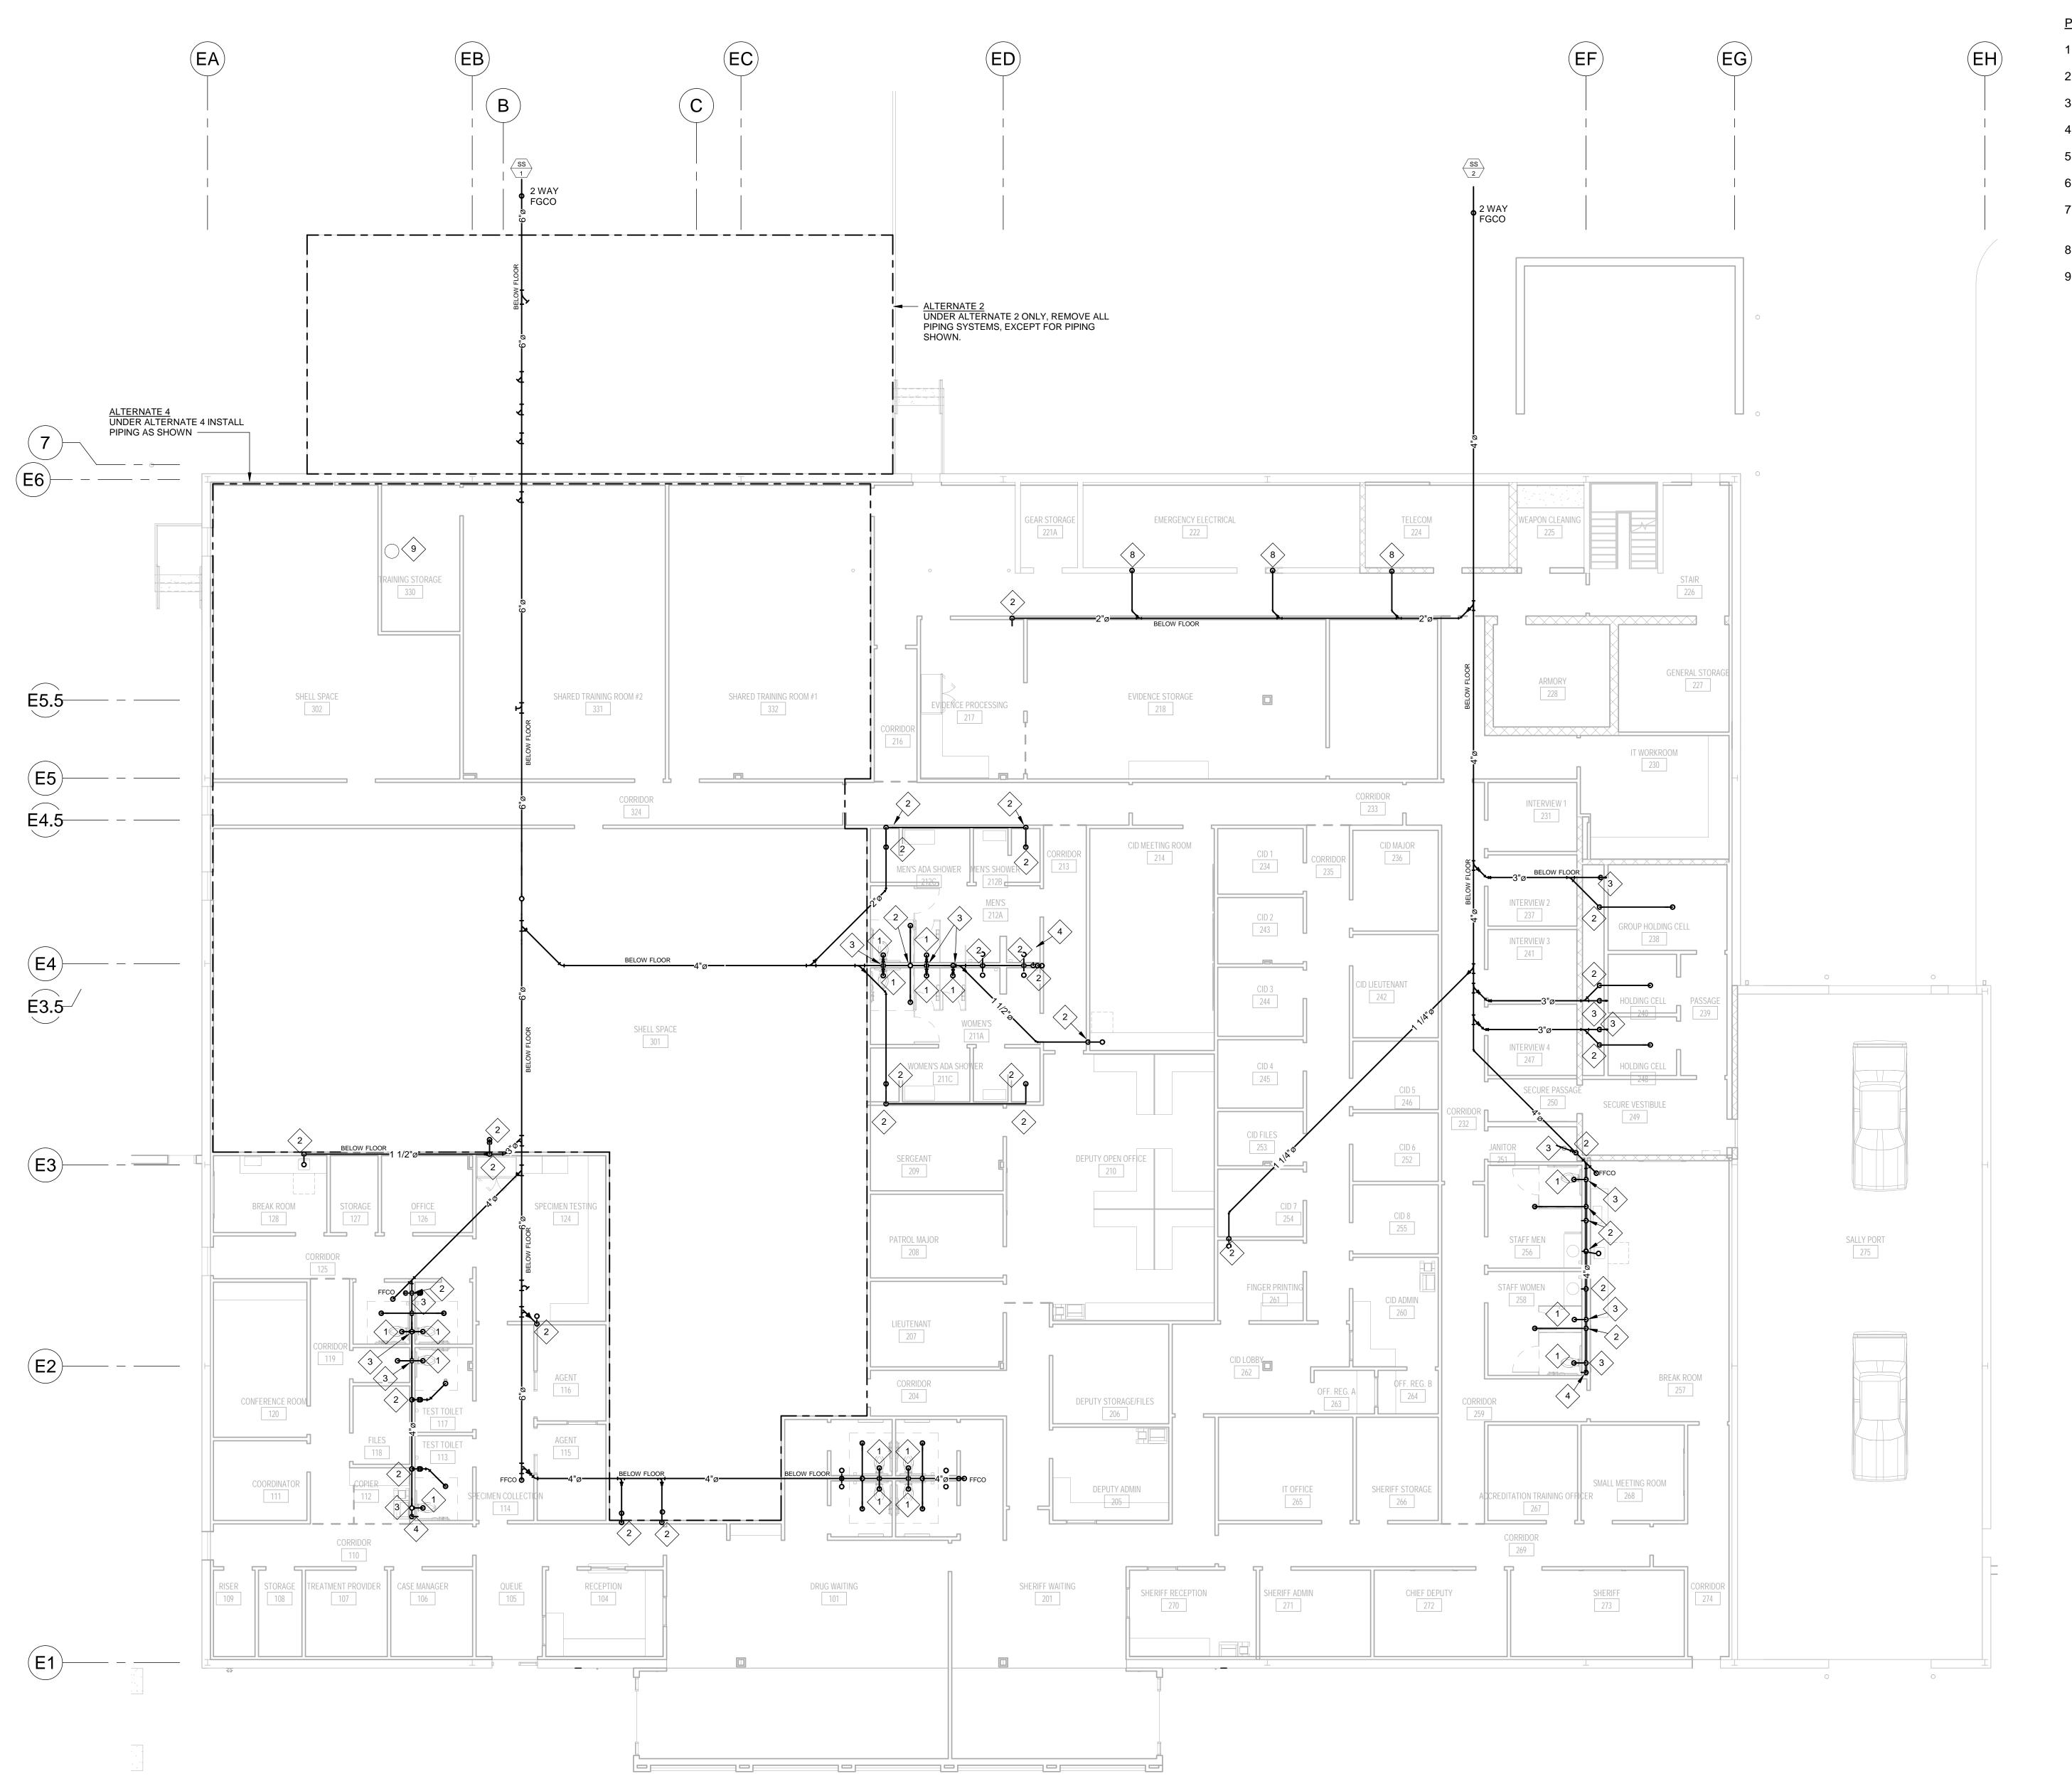

PLAN NOTES: #

- 1. TOILET WASTE WITH TOILET FLANGE TROUGH FLOOR.
- 2. WASTE VENT PIPING THROUGH FLOOR.
- 3. 3" WASTE THROUGH FLOOR.
- 4. 4" WASTE THROUGH FLOOR.
- 5. CUT-OFF VALVE IN HEAVY DUTY BOX WITH COVER.
- 6. 3" COLD WATER UP THROUGH FLOOR IN RISER ROOM.
- 7. 6" FIRE PROTECTION MAIN THROUGH FLOOR OF RISER
- 8. 1" CONDENSATE FROM AC UNIT ON WALL.
- 9. WATER HEATER AND FLOOR DRAIN TO REMAIN IF ALTERNATE 2 OR ALTERNATE 4 IS ACCEPTED. IF BOTH ALTERNATES ARE TAKEN, OMIT WATER HEATER AND FLOOR DRAIN.

architects

LPK ARCHITECTS, P.A.

Robert E. Luke, Architect

821 22ND AVENUE P.O. BOX 630
MERIDIAN, MISSISSIPPI 39302
P: 601.693.8940
F: 601.693.8940

PROJECT INFORMATION



Project Name

PROJECT ADDRESS:


Enter address here



ACTIVE DESIGN PHASE

FOR REVIEW ONLY FOR PERMITTING ONLY DESIGN DEVELOPMENT CONSTRUCTION BIDDING CONSTRUCTION DOCUMENTS

AS-BUILT RECORD SET

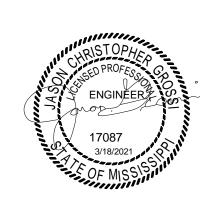


	REVISION	IS/SUBMISSIONS
NO.	DATE	DESCRIPTION
2	04/30/2021	Addendum 3

FLOOR PLAN - BELOW FLOOR PLUMBING - ALTERNATES

20.087 PROJECT NO.:

FLOOR PLAN - BELOW FLOOR PLUMBING - Alternates

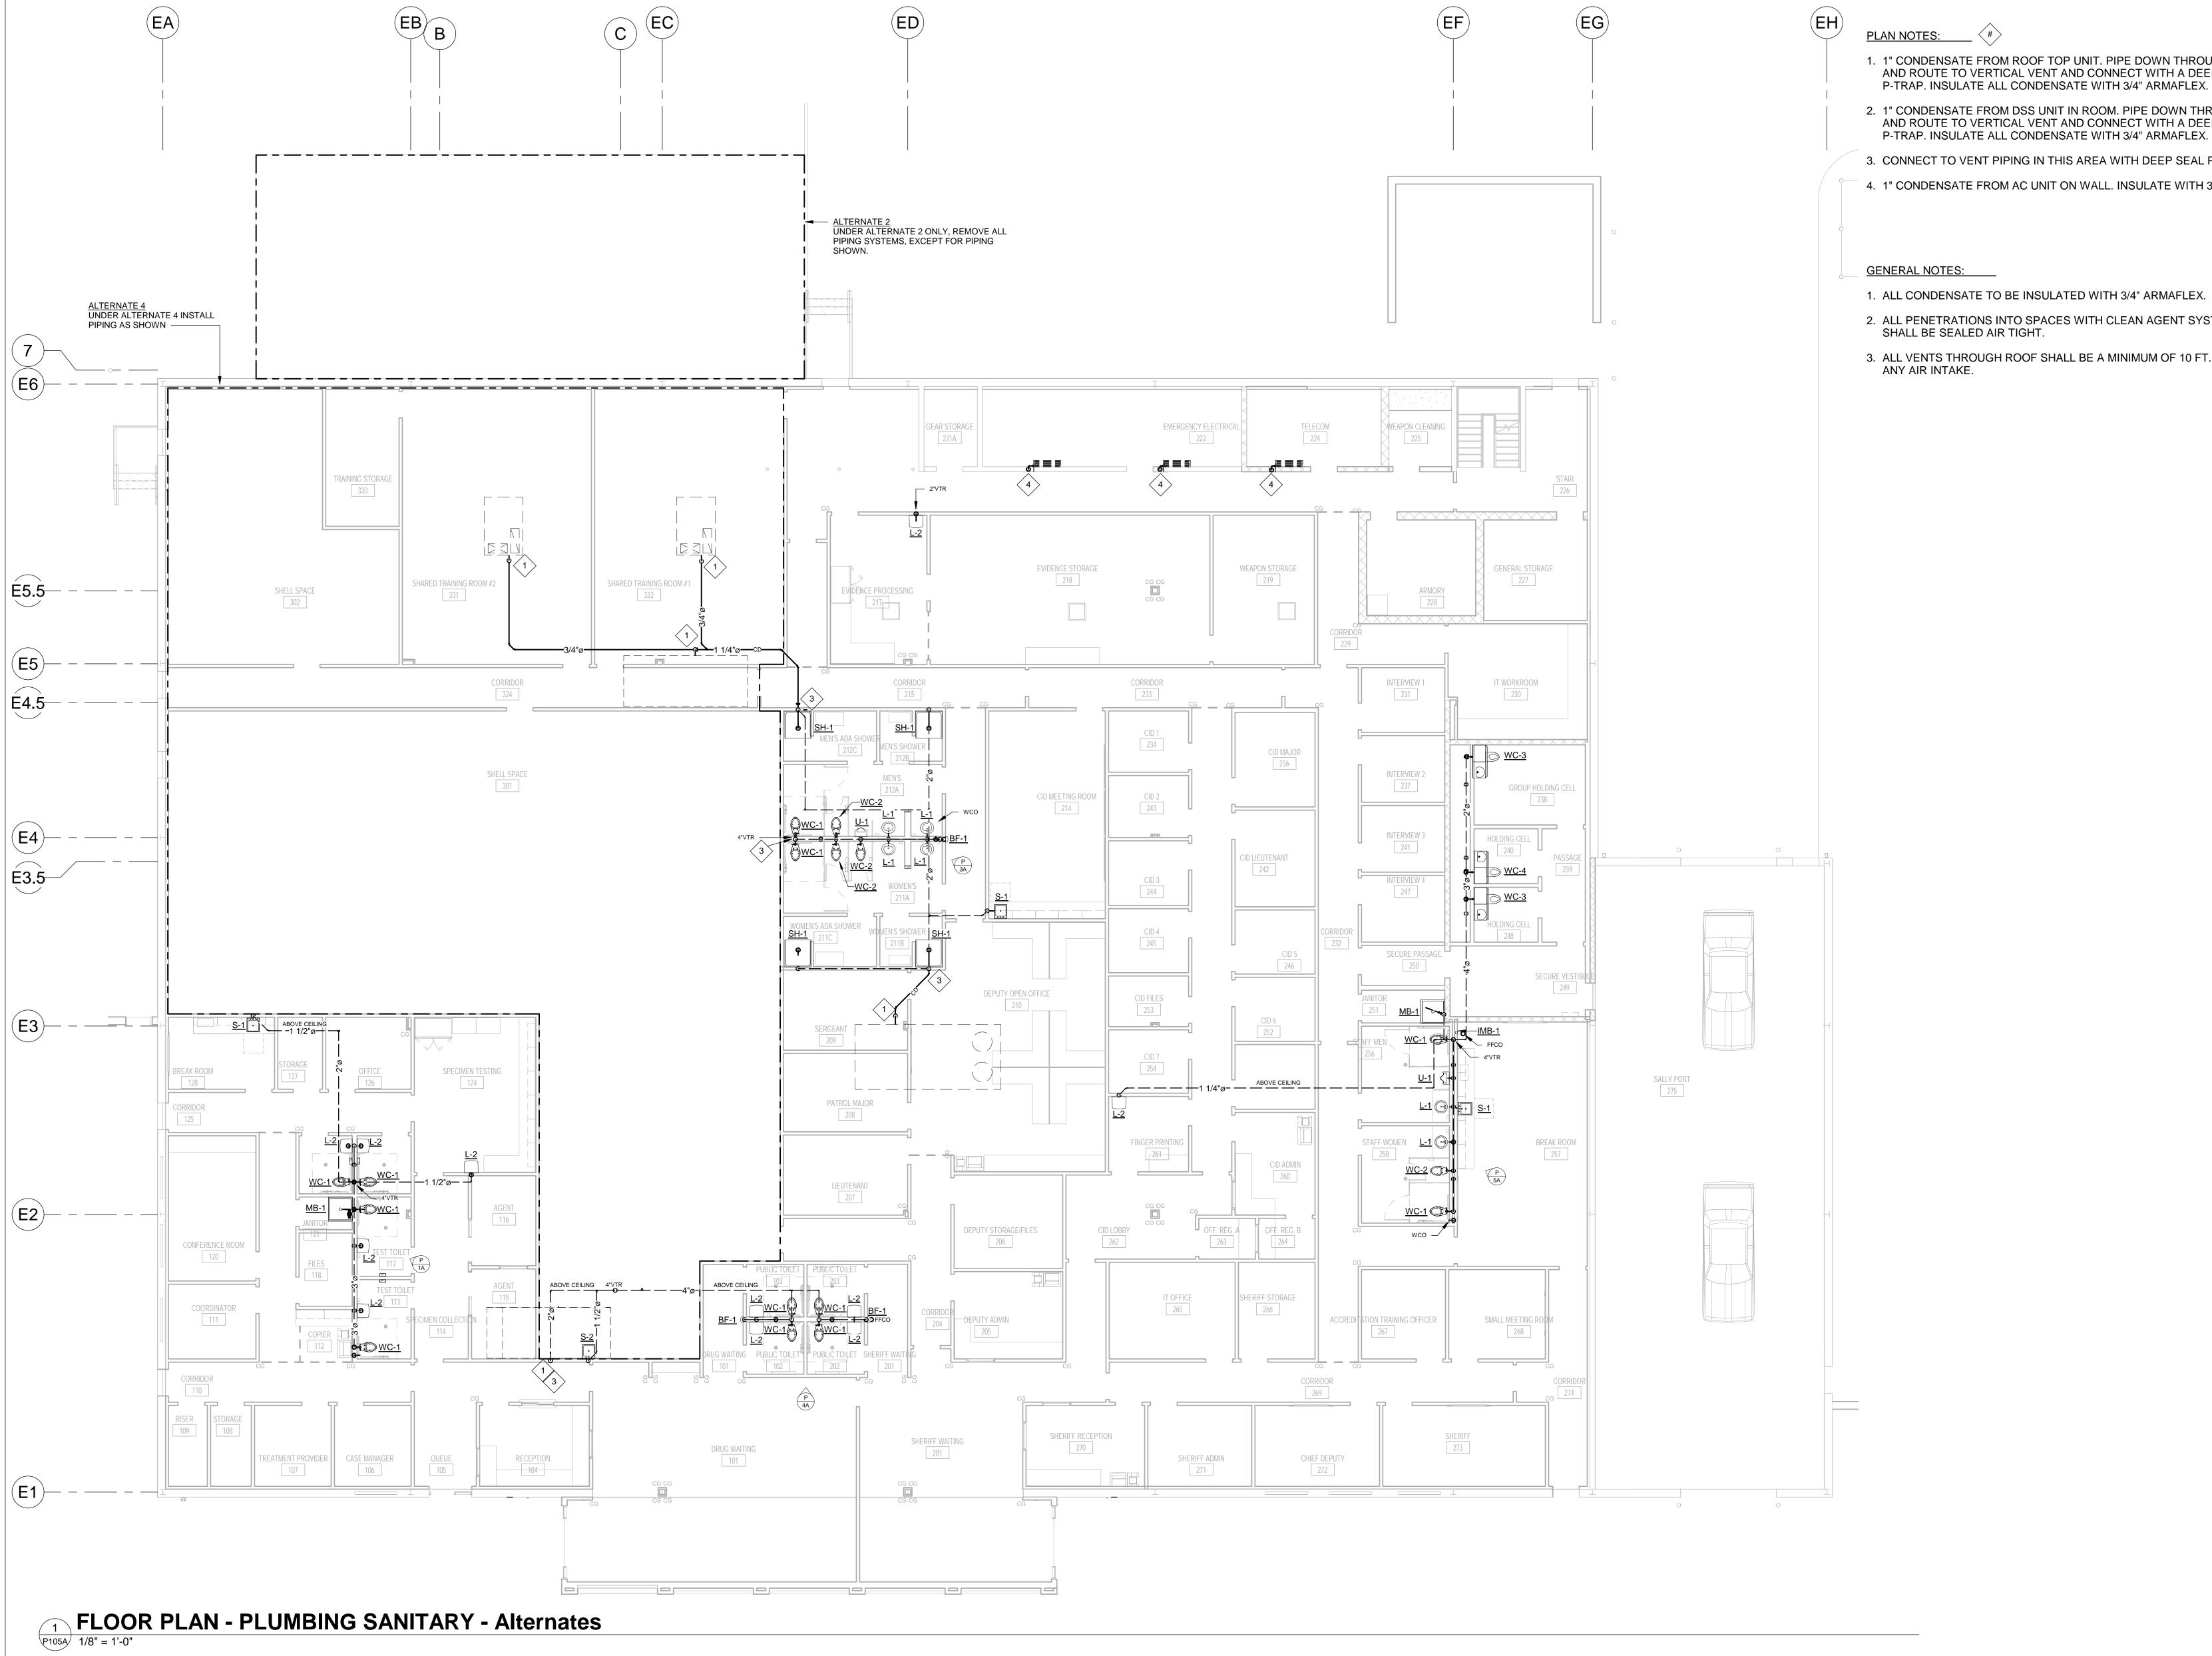

1. 1" CONDENSATE FROM ROOF TOP UNIT. PIPE DOWN THROUGH ROOF AND ROUTE TO VERTICAL VENT AND CONNECT WITH A DEEP SEAL

2. 1" CONDENSATE FROM DSS UNIT IN ROOM. PIPE DOWN THROUGH ROOF AND ROUTE TO VERTICAL VENT AND CONNECT WITH A DEEP SEAL P-TRAP. INSULATE ALL CONDENSATE WITH 3/4" ARMAFLEX.

3. CONNECT TO VENT PIPING IN THIS AREA WITH DEEP SEAL P-TRAP.

4. 1" CONDENSATE FROM AC UNIT ON WALL. INSULATE WITH 3/4" ARMAFLEX.


- 1. ALL CONDENSATE TO BE INSULATED WITH 3/4" ARMAFLEX.
- 2. ALL PENETRATIONS INTO SPACES WITH CLEAN AGENT SYSTEMS SHALL BE SEALED AIR TIGHT.
- 3. ALL VENTS THROUGH ROOF SHALL BE A MINIMUM OF 10 FT. FROM

architects

LPK ARCHITECTS, P.A.

Robert E. Luke, Architect

821 22ND AVENUE P.O. BOX 630
MERIDIAN, MISSISSIPPI 39302
P: 601.693.8640
F: 601.693.8640

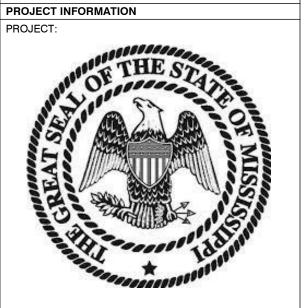

Project Name

PROJECT ADDRESS:

Enter address here

ACTIVE DESIGN PHASE


FOR REVIEW ONLY FOR PERMITTING ONLY DESIGN DEVELOPMENT CONSTRUCTION BIDDING

AS-BUILT RECORD SET



	REVISIONS/SUBMISSIONS			
NO.	DATE	DESCRIPTION		
2	04/30/2021	Addendum 3		
		1		

FLOOR PLAN - PLUMBING SANITARY - ALTERNATES

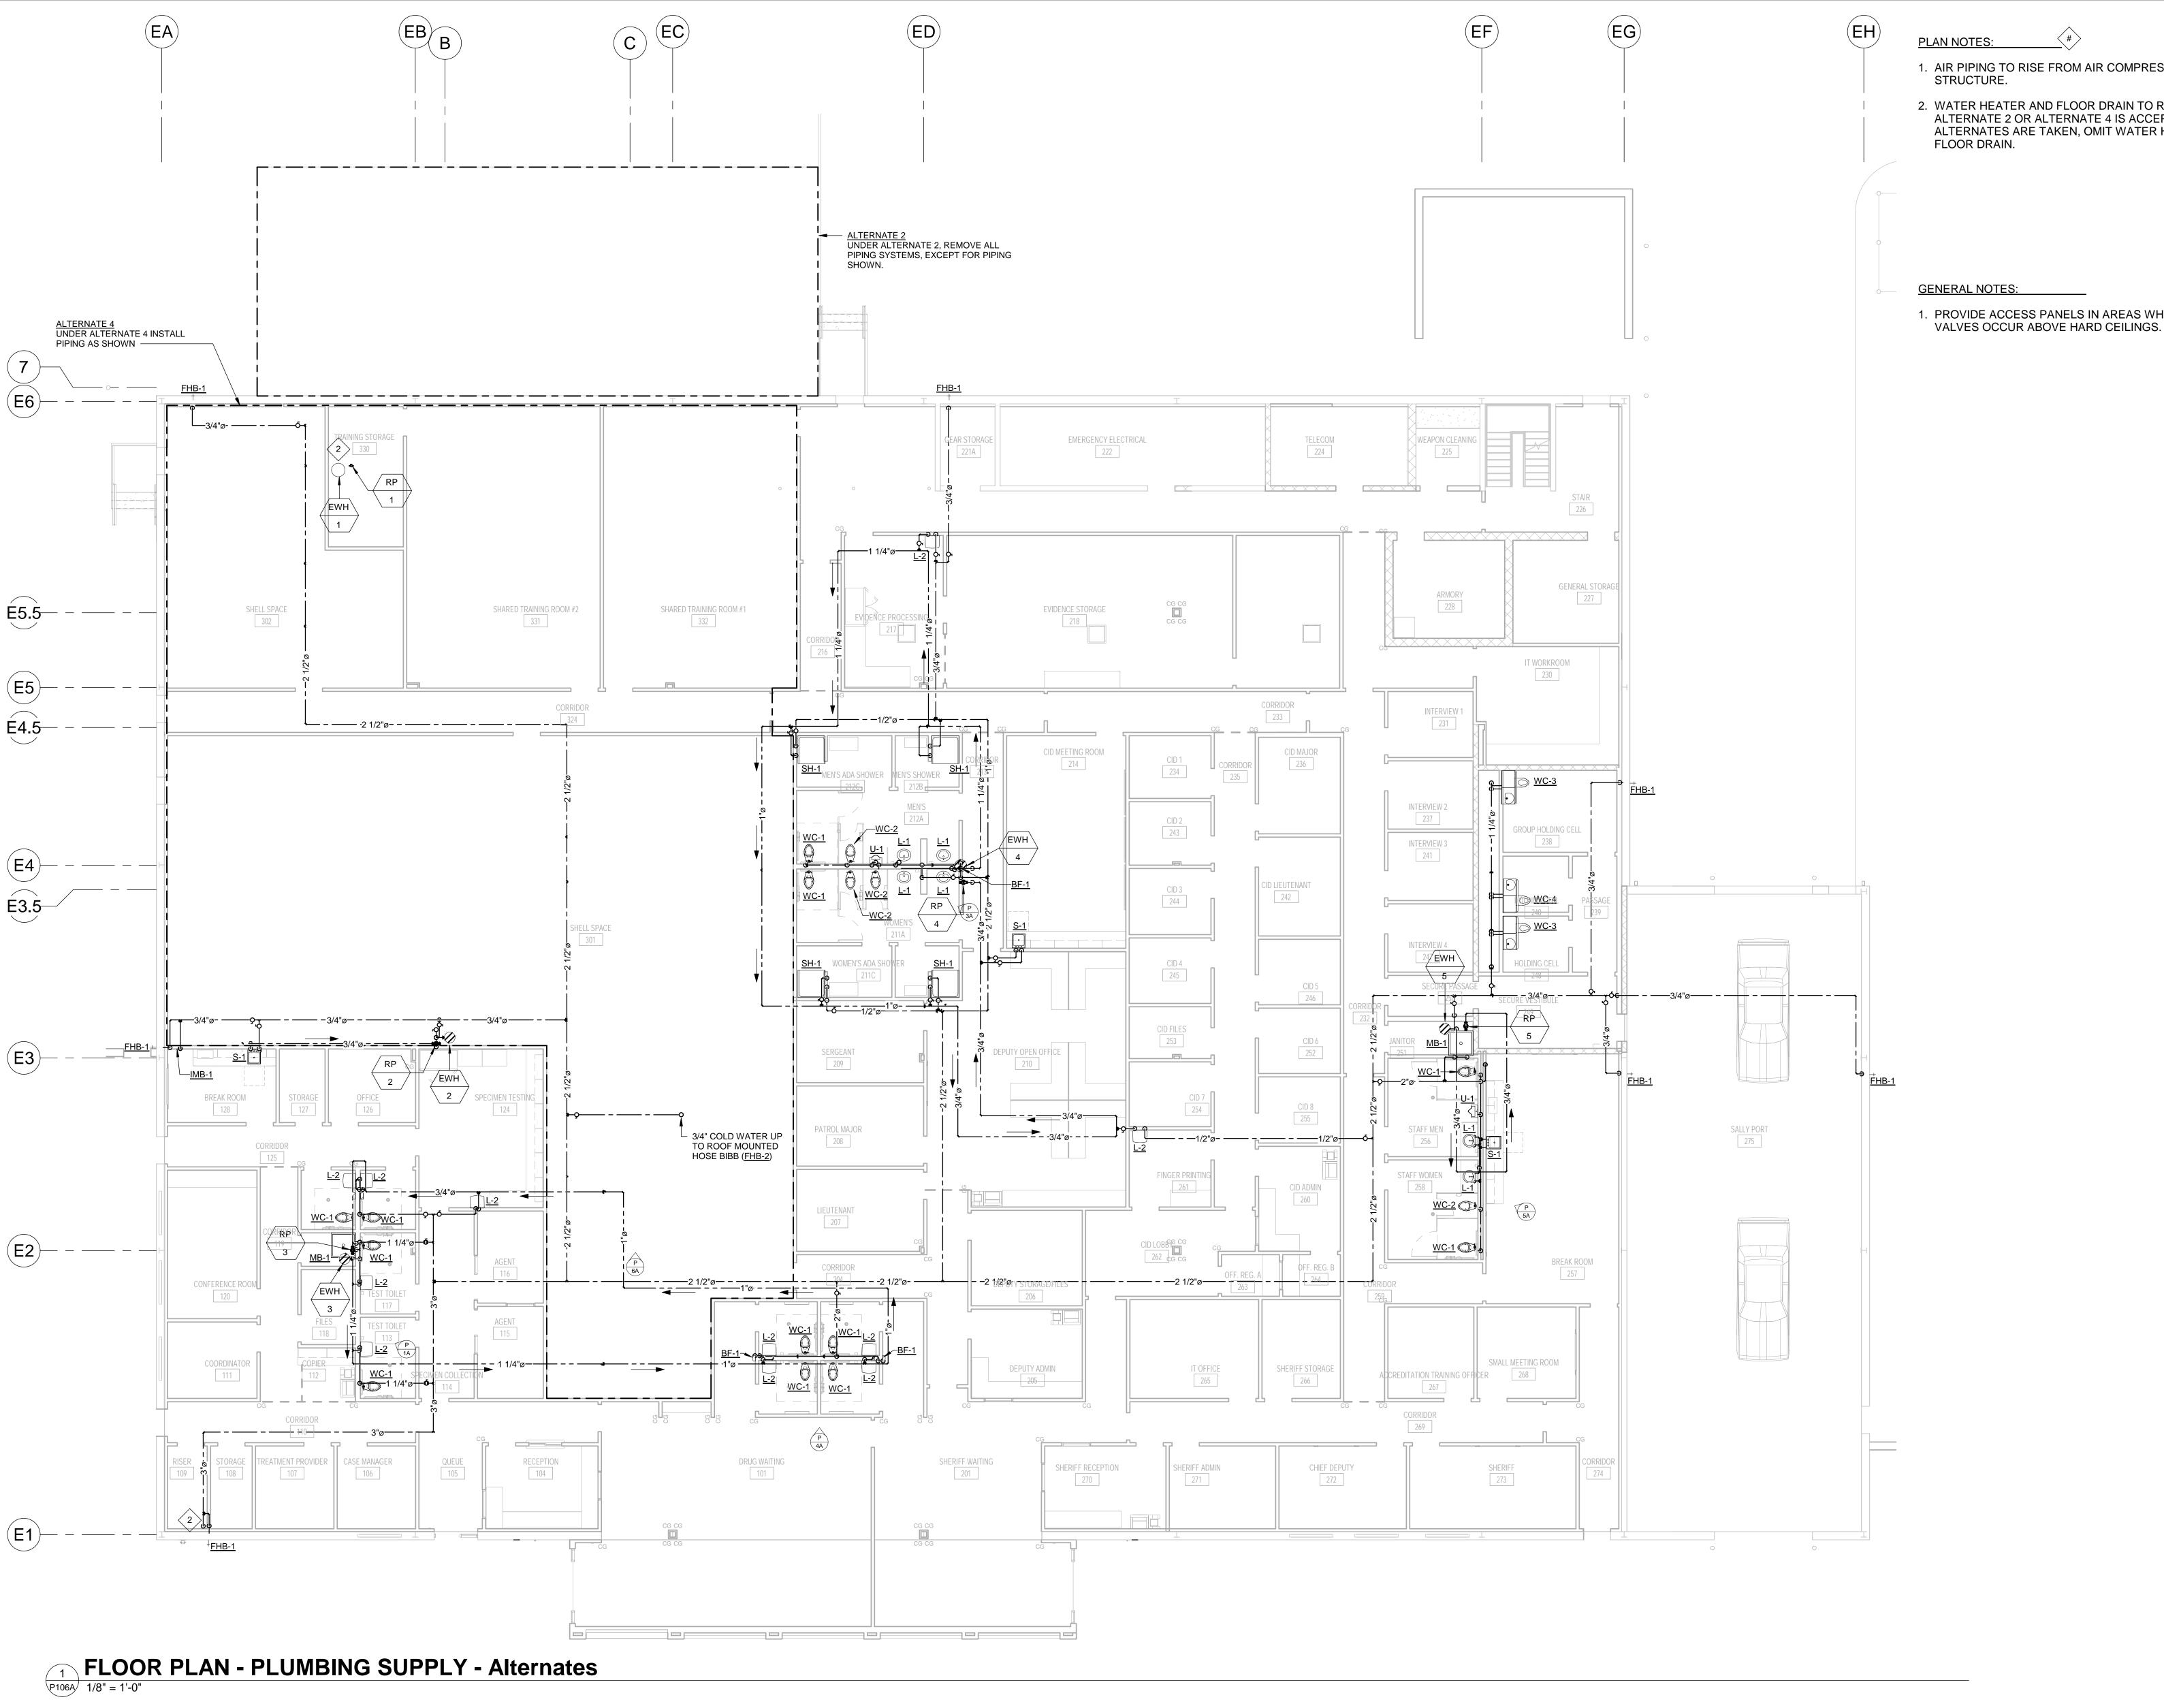

1. AIR PIPING TO RISE FROM AIR COMPRESSOR. ROUTE HIGH IN

2. WATER HEATER AND FLOOR DRAIN TO REMAIN IF ALTERNATE 2 OR ALTERNATE 4 IS ACCEPTED. IF BOTH ALTERNATES ARE TAKEN, OMIT WATER HEATER AND

1. PROVIDE ACCESS PANELS IN AREAS WHERE CUT-OFF

architects

LPK ARCHITECTS, P.A.

Robert E. Luke, Architect

821 22ND AVENUE P.O. BOX 630
MERIDIAN, MISSISSIPPI 39302
P: 601.693.8940
P: 601.693.8640

PROJECT INFORMATION



Project Name


PROJECT ADDRESS:

Enter address here

ACTIVE DESIGN PHASE

FOR REVIEW ONLY FOR PERMITTING ONLY DESIGN DEVELOPMENT CONSTRUCTION BIDDING


AS-BUILT RECORD SET

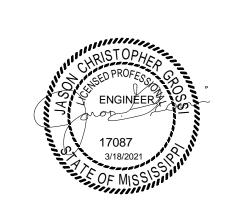

	REVISION	IS/SUBMISSIONS
NO.	DATE	DESCRIPTION
2	04/30/2021	Addendum 3
	1	

FLOOR PLAN - PLUMBING SUPPLY - ALTERNATES

Jackson, MS 39206 Phone: (601) 362-3552 Fax: (601) 366-6418

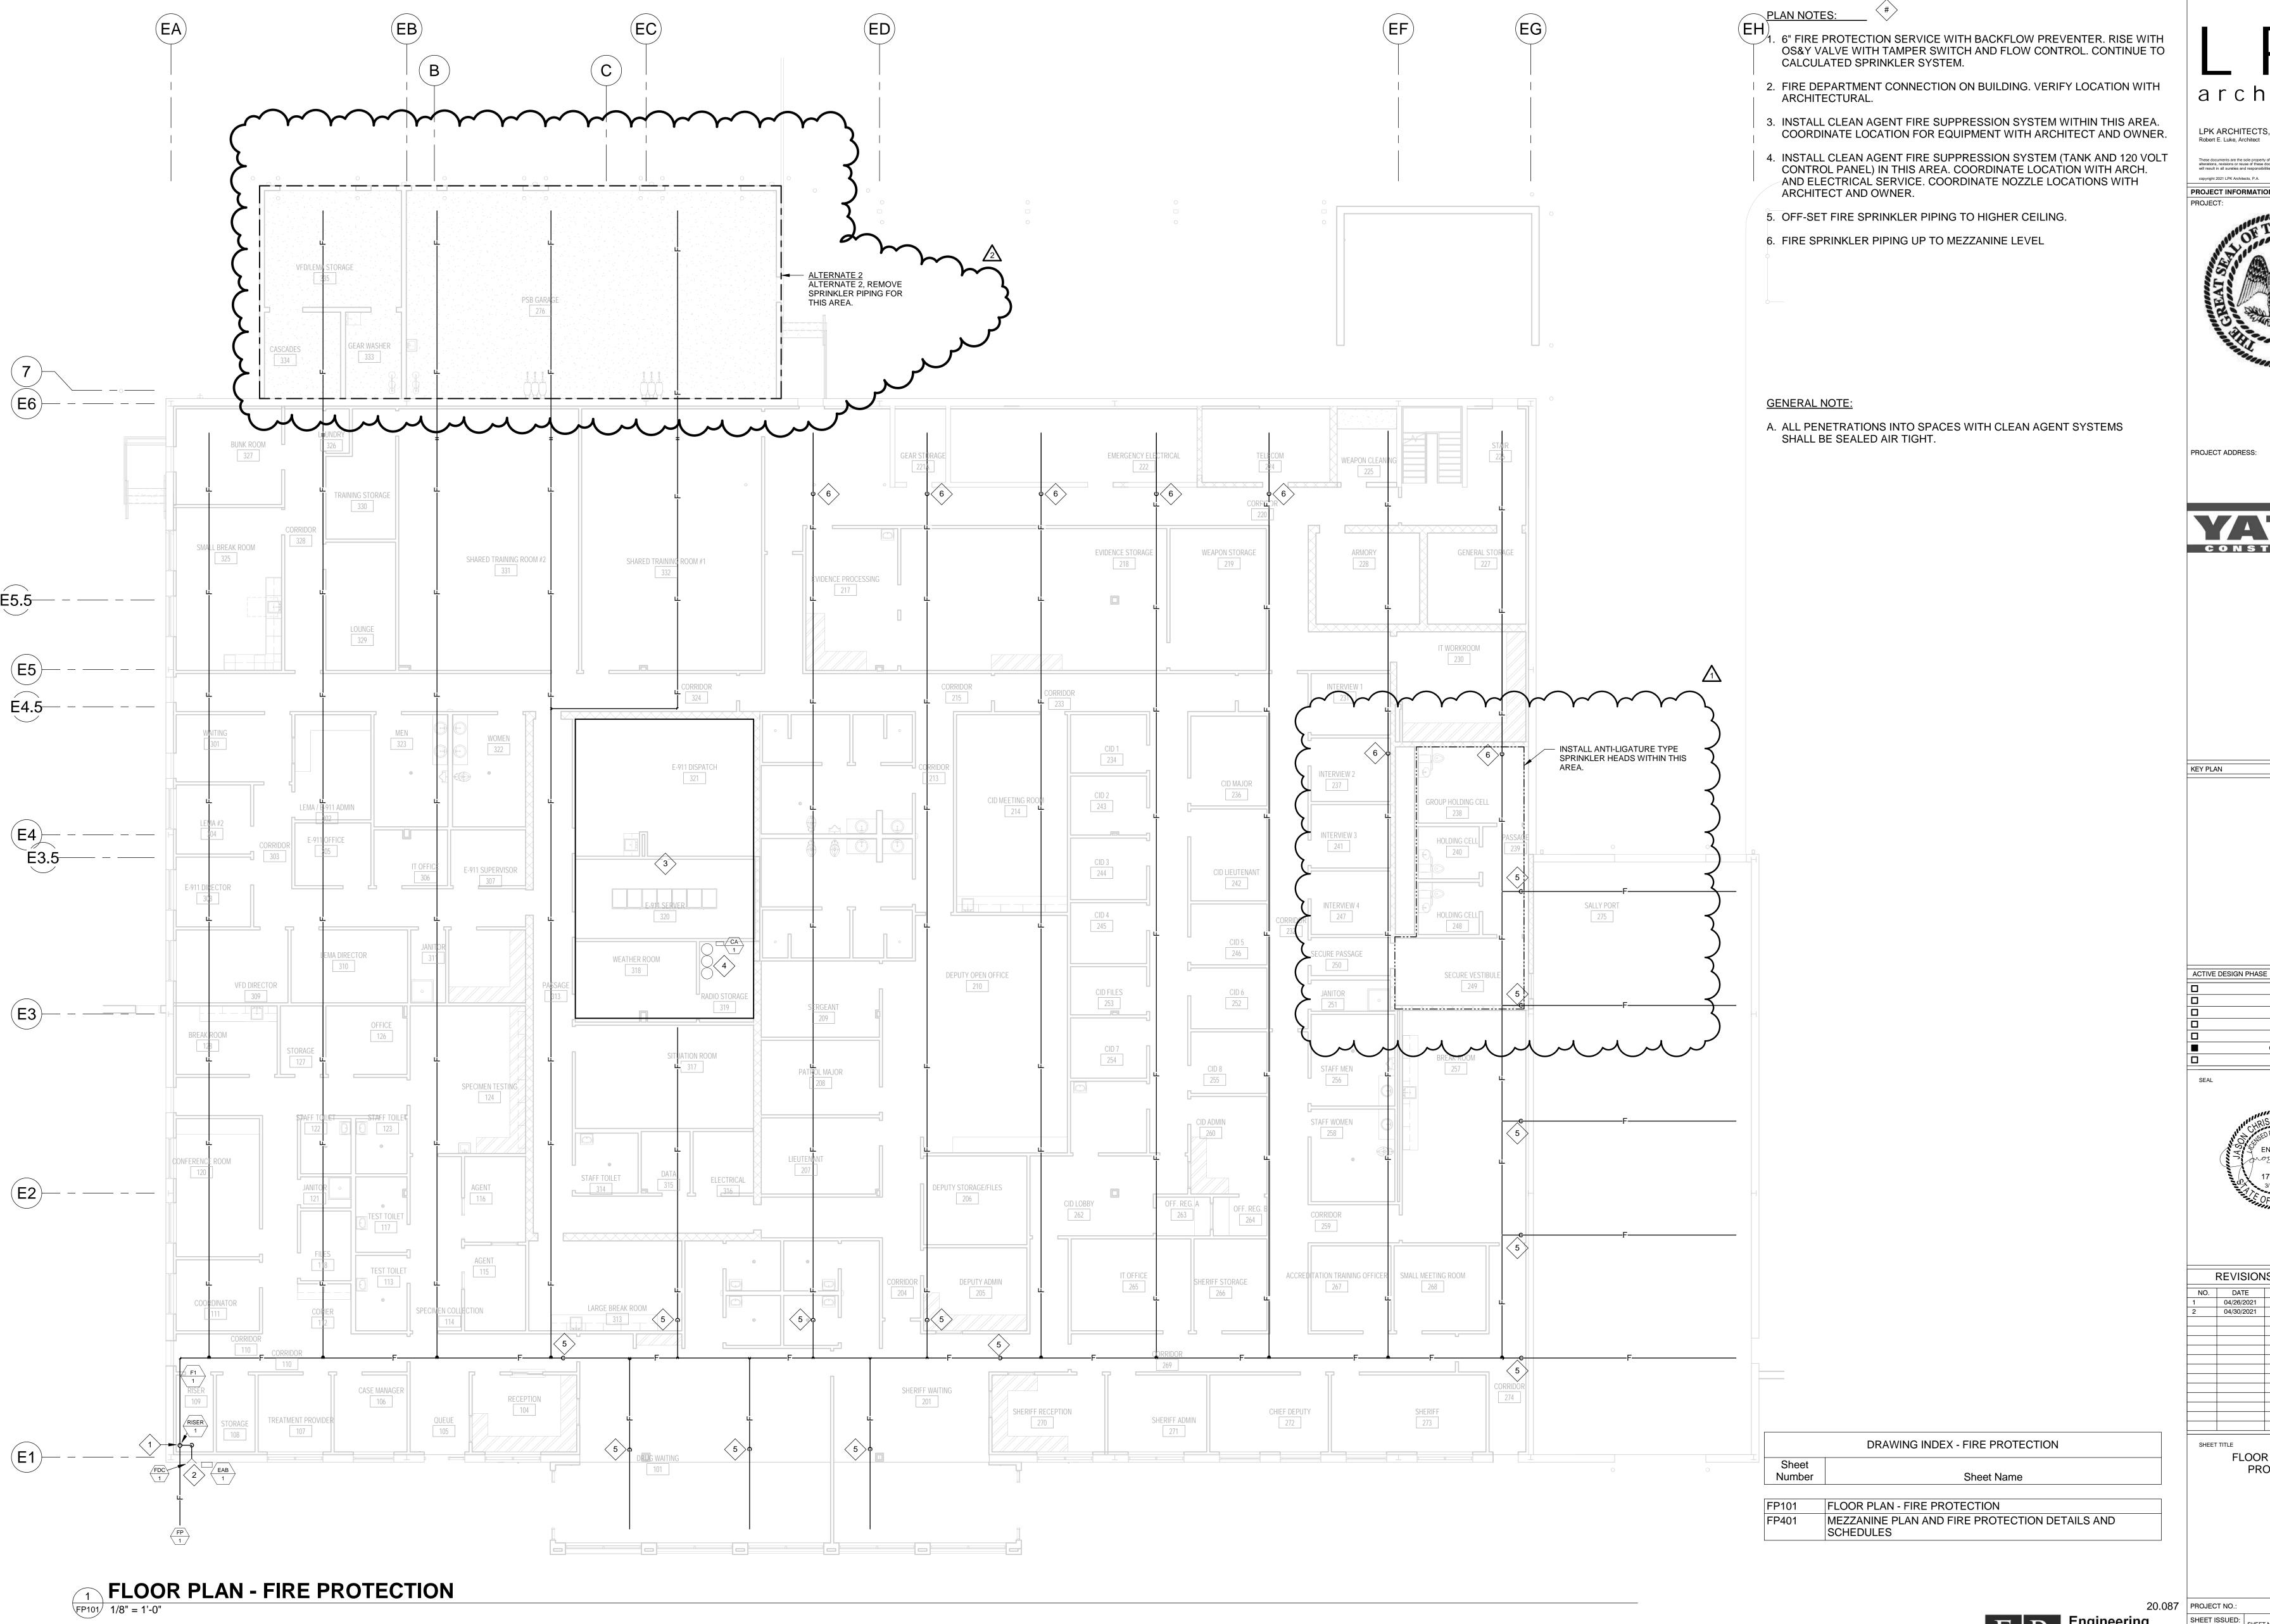

LPK ARCHITECTS, P.A.

Robert E. Luke, Architect

821 22ND AVENUE P.O. BOX 630
MERIDIAN, MISSISSIPP 33902
P: 601.693.8640
F: 601.693.8640

These documents are the sole property of LPK Architects P.A. and are not to reused. Any alterations, revisions or reuse of these documents without the written consent of LPK Architects P will result in all sureties and responsibilities for the entire project becomina null and vols.

PROJECT INFORMATION



Project Name

PROJECT ADDRESS:

Enter address here

FOR REVIEW ONLY FOR PERMITTING ONLY DESIGN DEVELOPMENT CONSTRUCTION BIDDING

CONSTRUCTION DOCUMENTS

AS-BUILT RECORD SET




REVISIONS/SUBMISSIONS					
NO.	DATE DESCRIPTION				
1	04/26/2021	Addendum 2			
2	04/30/2021	Addendum 3			

SHEET TITLE

FLOOR PLAN - FIRE PROTECTION

350 Edgewood Terrace Drive Jackson, MS 39206 Phone: (601) 362-3552 Fax: (601) 366-6418

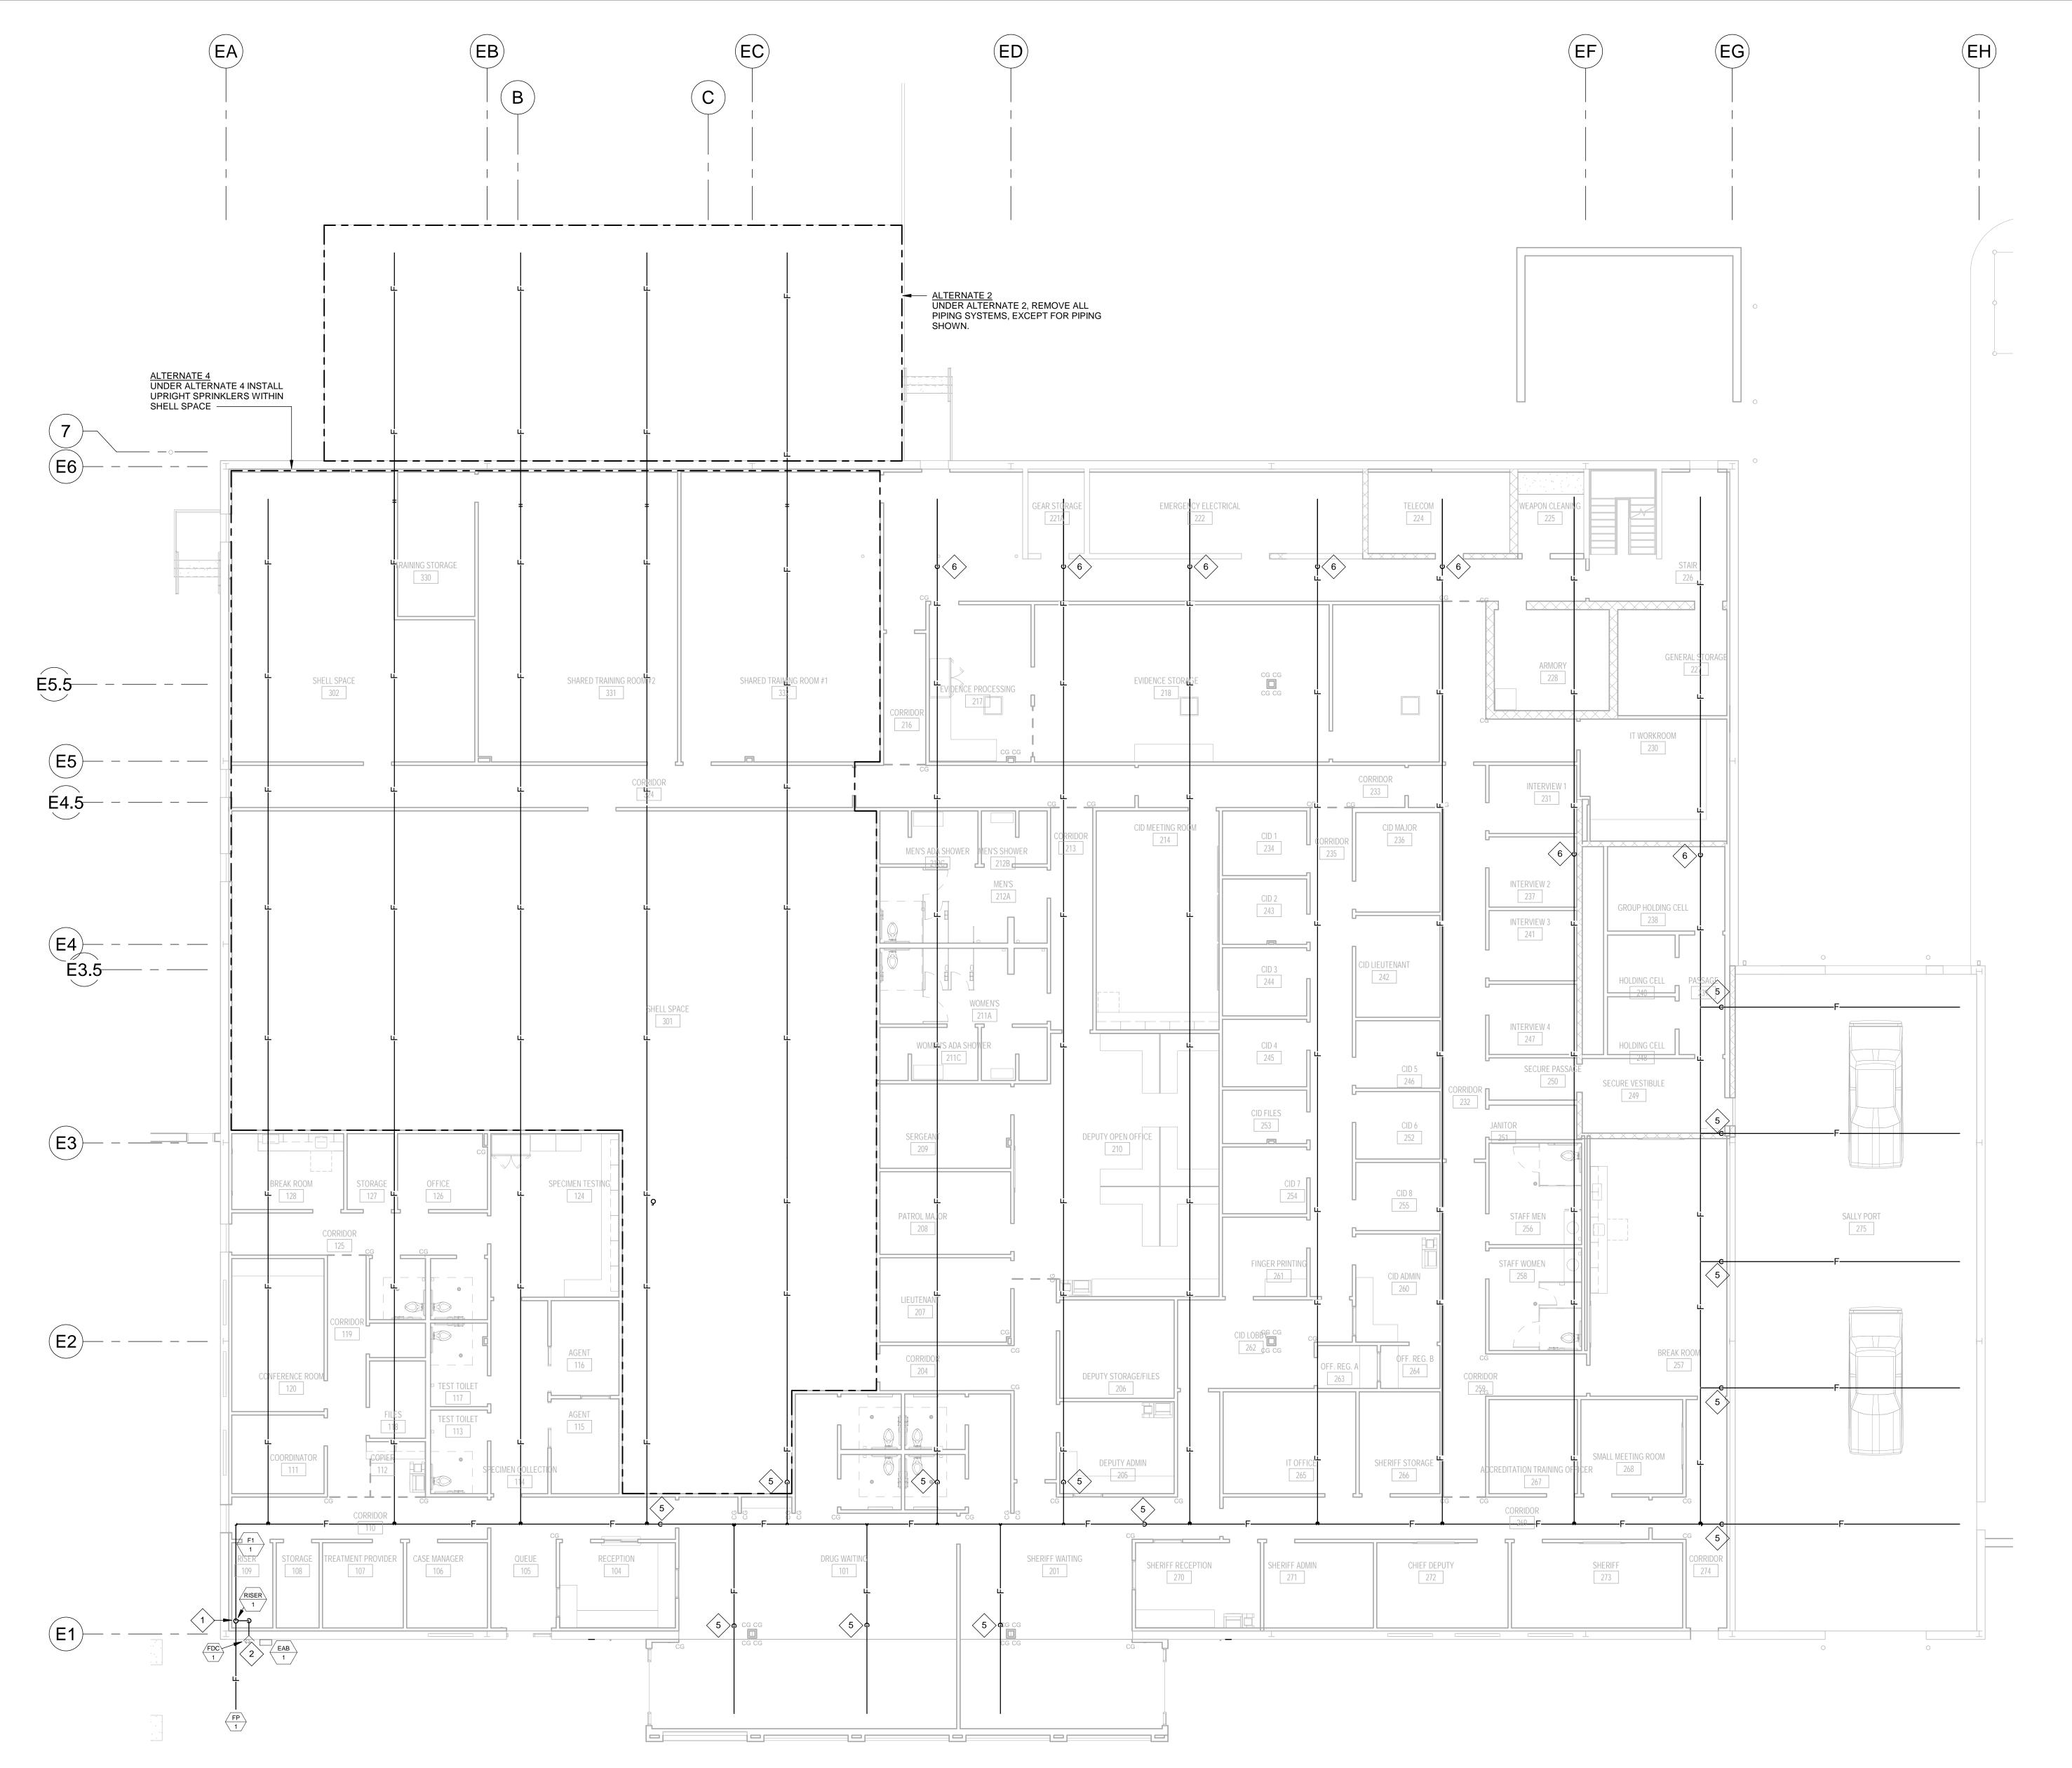

LPK ARCHITECTS, P.A.

Robert E. Luke, Architect


ROBERT E. Luke, Architect

ROBERT E. Luke, Architect

ROBERT E. Luke, Architect

ROBERT E. BO1.693.8990

P: 601.693.8640

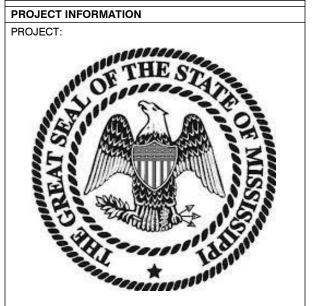

PROJECT ADDRESS:

Enter address here

ACTIVE DESIGN PHASE

FOR REVIEW ONLY FOR PERMITTING ONLY DESIGN DEVELOPMENT CONSTRUCTION BIDDING CONSTRUCTION DOCUMENTS AS-BUILT RECORD SET


REVISIONS/SUBMISSIONS

FLOOR PLAN - FIRE PROTECTION - ALTERNATES

350 Edgewood Terrace Drive Jackson, MS 39206 Phone: (601) 362-3552 Fax: (601) 366-6418

20.087 PROJECT NO.:

FLOOR PLAN - FIRE PROTECTION - Alternates

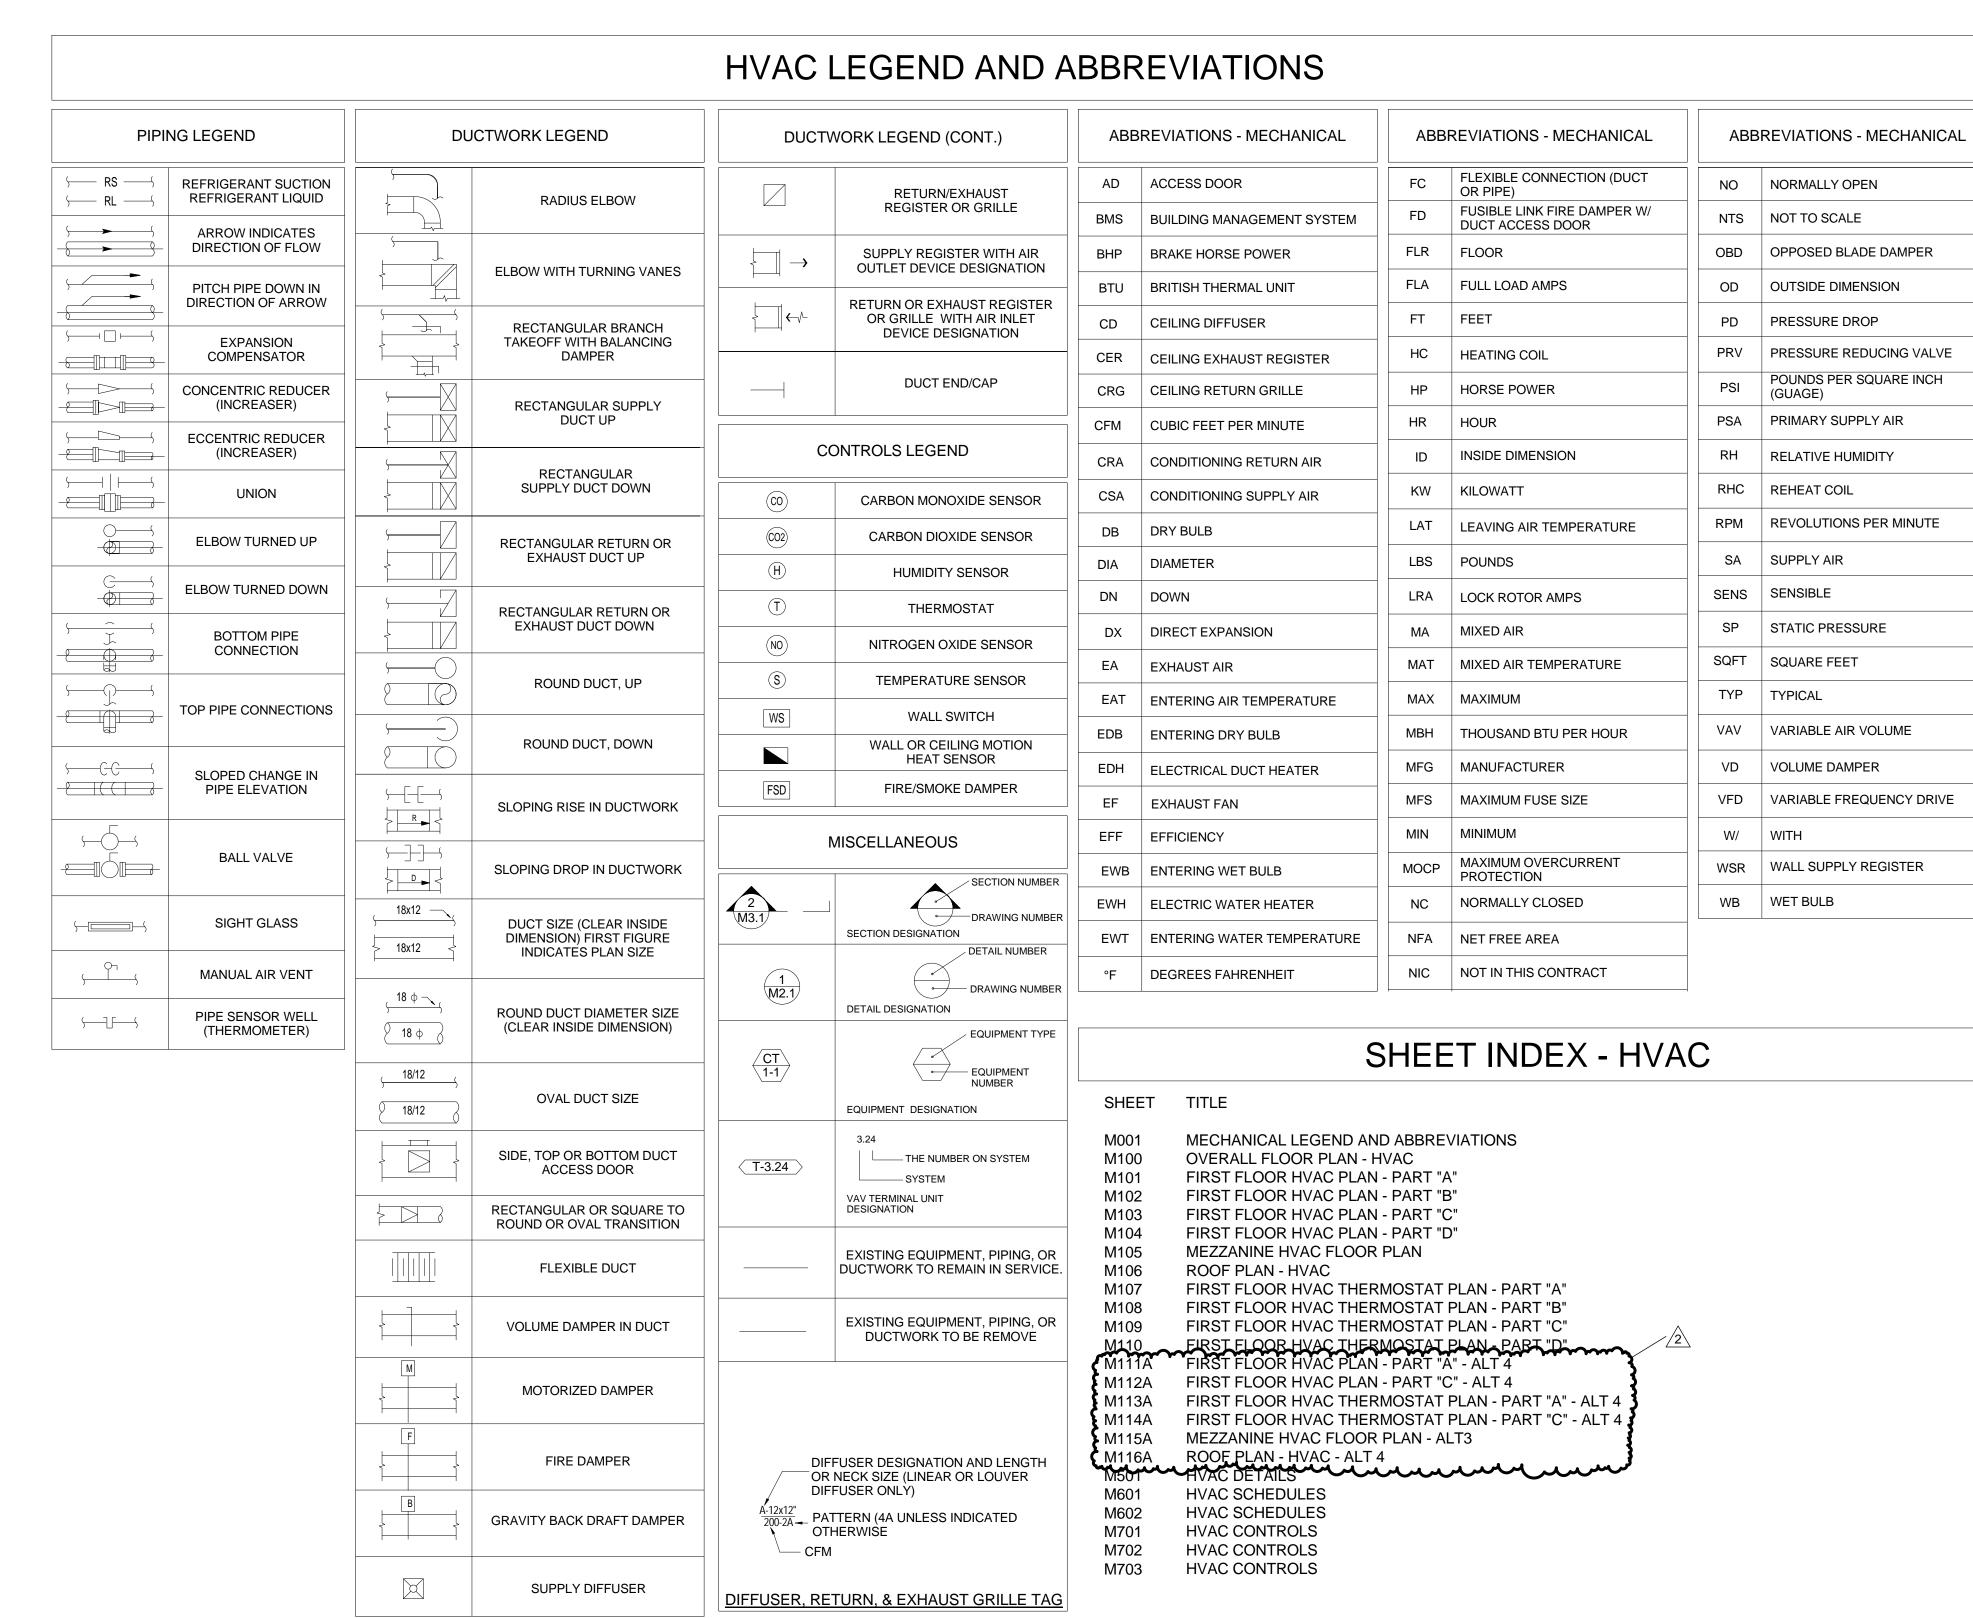

GENERAL NOTES - HVAC

- EACH CONTRACTOR, SUPPLIER AND/OR MANUFACTURER SHALL REFER TO ALL DOCUMENTS PERTAINING TO THIS PROJECT AND COORDINATE ACCORDINGLY SO AS TO ENSURE ADEQUACY OF FIT, COMPLIANCE WITH SPECIFICATIONS, PROPER ELECTRICAL SERVICE, AND AVOID CONFLICT WITH ANY OTHER BUILDING SYSTEMS. VERIFY SAME WITH SHOP DRAWINGS.
- ALL OFFSETS, TURNS, FITTINGS, TRIM, DETAIL, ETC., MAY NOT BE INDICATED, BUT SHALL BE PROVIDED AS REQUIRED. ADDITIONAL ALLOWANCES SHALL BE INCLUDED FOR SAME AT EACH PROPOSERS' DISCRETION.
- 3. OBSERVE ALL APPLICABLE CODES, RULES AND REGULATIONS (CITY, COUNTY, LOCAL, STATE, FEDERAL, MUNICIPALITY, UTILITY COMPANY, OSHA, ETC.).
- ALL SYSTEMS, EQUIPMENT, AND MATERIALS ARE TO BE INSTALLED IN A NEAT AN WORKMANLIKE MANNER. WORK NOT DONE SO SHALL BE REMOVED AND REINSTALLED SATISFACTORILY.
- WHERE MOUNTING HEIGHTS ARE NOT INDICATED OR ARE IN CONFLICT WITH ANY OTHER BUILDING SYSTEM, CONTACT THE ENGINEER BEFORE INSTALLATION. REFER ALSO TO ARCHITECTURAL WALL INTERIOR AND EXTERIOR WALL ELEVATIONS, CEILING HEIGHTS AND OTHER DETAILS OF THESE DOCUMENTS. REFERENCE SPECIFICATION SECTION "MECHANICAL GENERAL PROVISIONS" FOR COORDINATION DRAWING REQUIREMENTS.
- 6. DO NOT SCALE DRAWINGS, PRINTING DISTORTS SCALE. WORK SHALL BE LAID OUT FROM DIMENSIONED DRAWINGS, OR DIMENSIONS SUPPLIED TO THE CONTRACTOR.
- THE CONTRACTOR SHALL BE RESPONSIBLE FOR ALL CUTTING AND PATCHING REQUIRED FOR THEIR WORK, ALL CUTTING AND PATCHING SHALL MATCH ADJACENT SURFACES.
- TURNING VANES SHALL BE INSTALLED IN ALL SUPPLY, RETURN, AND EXHAUST DUCTWORK ELBOWS. TURNING VANES NOT REQUIRED FOR KITCHEN EXHAUST DUCTS.
- THESE DRAWINGS ARE ACCURATE TO THE BEST OF OUR KNOWLEDGE, HOWEVER LOCATIONS, DEPTHS, ELEVATIONS, AND SIZES WERE TAKEN FROM DIFFERENT SOURCES AND ARE SUBJECT TO DEVIATION. THE CONTRACTOR SHALL ASSUME SOME DEVIATIONS AND INCLUDE OFFSETS, ADDITIONAL PIPING, ETC. AT THE TIME OF BID.
- 10. WHERE PENETRATING ROOFING MEMBRANE OR OTHER MATERIALS USED FOR WEATHERPROOFING THE BUILDING, MAKE SUCH PENETRATIONS IN A WAY THAT WILL NOT VOID OR DIMINISH THE ROOFING WARRANTY OR INTEGRITY IN ANY WAY. COORDINATE ALL SUCH PENETRATIONS WITH THE GENERAL CONTRACTOR/ROOFER.
- 11. ADVISE THE ARCHITECT OF ANY CONFLICTS, ERRORS, OMISSIONS, ETC. AT LEAST TEN DAYS PRIOR TO BID DATE, TO ALLOW
- 12. DEVIATION FROM SPECIFICATIONS OR PLANS REQUIRES PRIOR WRITTEN APPROVAL FROM THE ARCHITECT AND MUST BE SUBMITTED IN WRITING NO LATER THAN TEN DAYS PRIOR TO THE BID DATE.
- 13. COORDINATE THE LOCATION OF DRAINS, ELECTRICAL OUTLETS, ETC. WITH ALL MECHANICAL ROOM EQUIPMENT, ETC. PRIOR TO COMMENCING INSTALLATION. WORK NOT SO COORDINATED SHALL BE REMOVED AND PROPERLY INSTALLED AT THE EXPENSE OF THE RESPONSIBLE CONTRACTOR(S).
- 14. THE PURPOSE AND INTENT OF THE DOCUMENTS PERTAINING TO THIS PROJECT IS TO PROVIDE A COMPLETE, FUNCTIONAL, AND SAFE FACILITY, ANYTHING LESS SHALL BE UNACCEPTABLE.
- 15. ALL VIBRATING, OSCILLATING, NOISE PRODUCING OR ROTATING EQUIPMENT SHALL BE ISOLATED FROM SURROUNDING SYSTEMS IN AN APPROVED MANNER. NOISY, VIBRATING, OR STRUCTURALLY DAMAGING INSTALLATIONS SHALL BE SATISFACTORILY REPLACED OR REPAIRED AT THE INSTALLING CONTRACTOR'S EXPENSE. THE FINAL DECISION ON THE SUITABILITY OF A PARTICULAR INSTALLATION SHALL BE THAT OF THE ARCHITECT.
- . INSTALL EQUIPMENT, MATERIALS, ETC. IN STRICT ACCORDANCE WITH MANUFACTURER'S RECOMMENDATIONS AND DIRECTIONS. IF IN CONFLICT WITH THE DESIGN INDICATED IN CONTRACT DOCUMENTS, ADVISE THE ARCHITECT PRIOR TO INSTALLATION FOR
- 17. ALL SUPPORTS FOR EQUIPMENT, DEVICES, OR FIXTURES SHALL BE UNIQUE FROM THE BUILDING STRUCTURE. DO NOT SUPPORT FROM OTHER TRADES, EQUIPMENT OR SUPPORTS WITHOUT WRITTEN PERMISSION FROM THE ARCHITECT AND CONSENT OF THE OTHER TRADE, IN WRITING.
- 18. DEVIATIONS IN SIZE, CAPACITIES, FIT, FINISH, ETC. FOR EQUIPMENT FROM THAT SPECIFIED SHALL BE THE RESPONSIBILITY OF THE PURCHASER OF THAT EQUIPMENT. ANY PROVISIONS REQUIRED TO ACCOMMODATE A DEVIATION, WHETHER APPROVED BY THE ARCHITECT OR NOT, SHALL BE THE RESPONSIBILITY OF THE PURCHASER.
- 19. THE GENERAL CONTRACTOR FOR THIS CONSTRUCTION IS RESPONSIBLE FOR THE COORDINATION, APPEARANCE, SCHEDULING, AND TIMELINESS OF THE WORK OF ALL TRADES, CONTRACTORS, SUPPLIERS, INSTALLERS, ETC.
- 20. VALVES, BALANCING DAMPERS OR ANY MECHANICAL/ELECTRICAL ITEM SHALL NOT BE LOCATED ABOVE A HARD CEILING. IF THIS IS NOT POSSIBLE, THEN AN APPROPRIATELY SIZED ACCESS DOOR SHALL BE PLACED UNDER THE ITEM TO ALLOW EASY MAINTENANCE AND ADJUSTMENT BY THIS CONTRACTOR.
- 21. PROVIDE FIRE DAMPERS AND APPROPRIATE DUCT ACCESS DOORS IN ALL DUCT PENETRATIONS WHERE REQUIRED BY CODE. CONTACT PROFESSIONAL SHOULD CLARIFICATION BY REQUIRED.
- 22. PROVIDE METAL SLEEVES AND FIRESTOPPING ON ALL DUCTWORK PASSING THRU RATED WALLS, PER CODE.
- 23. THE GENERAL CONTRACTOR, MECHANICAL CONTRACTOR, AND ALL OTHER CONTRACTORS SHALL ENSURE PROPER COORDINATION BETWEEN ALL TRADES SUCH THAT CONDUITS, PIPING, DUCTWORK, ETC. DO NOT BLOCK ACCESS TO VALVES, EQUIPMENT, DUCT ACCESS DOORS, ETC. ITEMS THAT HAVE BEEN INSTALLED WHERE ACCESS IS COMPROMISED SHALL BE RELOCATED AT THE CONTRACTOR'S
- 24. THE CONTRACTOR SHALL INCLUDE IN THEIR BID ALL COSTS ASSOCIATED WITH DRAINING AND FILLING PIPING SYSTEMS AS REQUIRED TO
- 25. TESTING, ADJUSTING, AND BALANCING AGENCY IS TO PROVIDE SIZING OF FAN AND MOTOR SHEAVES REQUIRED FOR PROPER BALANCE. REPLACE FAN AND MOTOR SHEAVES AND BELTS AS REQUIRED ON EQUIPMENT (AHUS, EFS, ETC.). THE MECHANICAL CONTRACTOR SHALL PURCHASE AND INSTALL ALL SHEAVES AND BELTS AS REQUIRED.
- 26. PRIOR TO ORDERING ANY MATERIALS OR ROUGH-IN OF ANY KIND, THE MECHANICAL CONTRACTOR SHALL BE RESPONSIBLE FOR FINAL COORDINATION OF ALL ELECTRICAL REQUIREMENTS (I.E., VOLTAGE, PHASE, CIRCUIT BREAKER, WIRING SIZE, ETC.) WITH THE ELECTRICAL CONTRACTOR. THERE WILL BE NO CHANGE IN THE CONTRACT AMOUNT FOR ANY DISCREPANCIES. MECHANICAL CONTRACTOR SHALL COORDINATE WITH ALL OTHER CONTRACTORS, VENDORS, AND SUPPLIERS AND SHALL INSURE COMPLETE, 100% FUNCTIONAL, TESTED, INSPECTED, AND APPROVED SYSTEMS. CLAIMS FOR ADDITIONAL COST OR CHANGE ORDERS WILL IMMEDIATELY
- 27. EQUIPMENT BRACING WILL BE INCLUDED FOR ALL OVERHEAD UTILITIES AND OTHER EQUIPMENT WEIGHING 31 POUNDS OR MORE (EXCLUDING DISTRIBUTED SYSTEMS SUCH AS PIPING, ETC.). BRACING SHALL BE ACCOMPLISHED BY EITHER RIGID OR FLEXIBLE SYSTEMS. ALL EQUIPMENT MOUNTINGS SHALL BE DESIGNED TO RESIST FORCES OF 0.5 TIMES THE EQUIPMENT WEIGHT IN ANY DIRECTION AND 1.5 TIMES THE EQUIPMENT WEIGHT IN THE DOWNWARD DIRECTION. ALL BRACING SHALL BE CONTRACTOR DESIGNED.
- 28. ALL BRANCH DUCTS TO AIR DISTRIBUTION DEVICES (SUPPLY, RETURN, EXHAUST, ETC.) SHALL INCLUDE A VOLUME DAMPER PER DRAWINGS AND SPECIFICATIONS.
- 29. DUCT SIZES INDICATED ARE ACTUAL INSIDE (NET) DIMENSIONS. ALL RECTANGULAR SUPPLY, RETURN, EXHAUST, AND OUTDOOR AIR DUCT SIZES ARE INSIDE CLEAR DIMENSIONS (INSIDE LINER, WHERE APPLICABLE).



LPK ARCHITECTS, P.A. Robert E. Luke, Architect

These documents are the sole property of LPK Architects P.A. and are not to reused. Any alterations, revisions or reuse of these documents without the written consent of LPK Architects P. will result in all sureties and responsibilities for the artist provided becoming and the provided becomes a



Lauderdale County Public Safety Building

PROJECT ADDRESS:

Village Fair Mall Site 612 22nd Avenue (Winn-Dixie / LabCorp Building)




KEY PLAN

ACTIVE DESIGN PHASE FOR REVIEW ONLY


> SCHEMATIC DESIGN DESIGN DEVELOPMENT CONSTRUCTION BIDDING CONSTRUCTION DOCUMENTS AS-BUILT RECORD SET

FOR PERMITTING ONLY

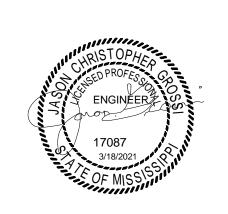

REVISIONS/SUBMISSIONS		
NO.	DATE	DESCRIPTION
2	04/30/2021	ADDENDUM #3
	1	

SHEET TITLE HVAC LEGENDS, ABBREVIATIONS AND NOTES

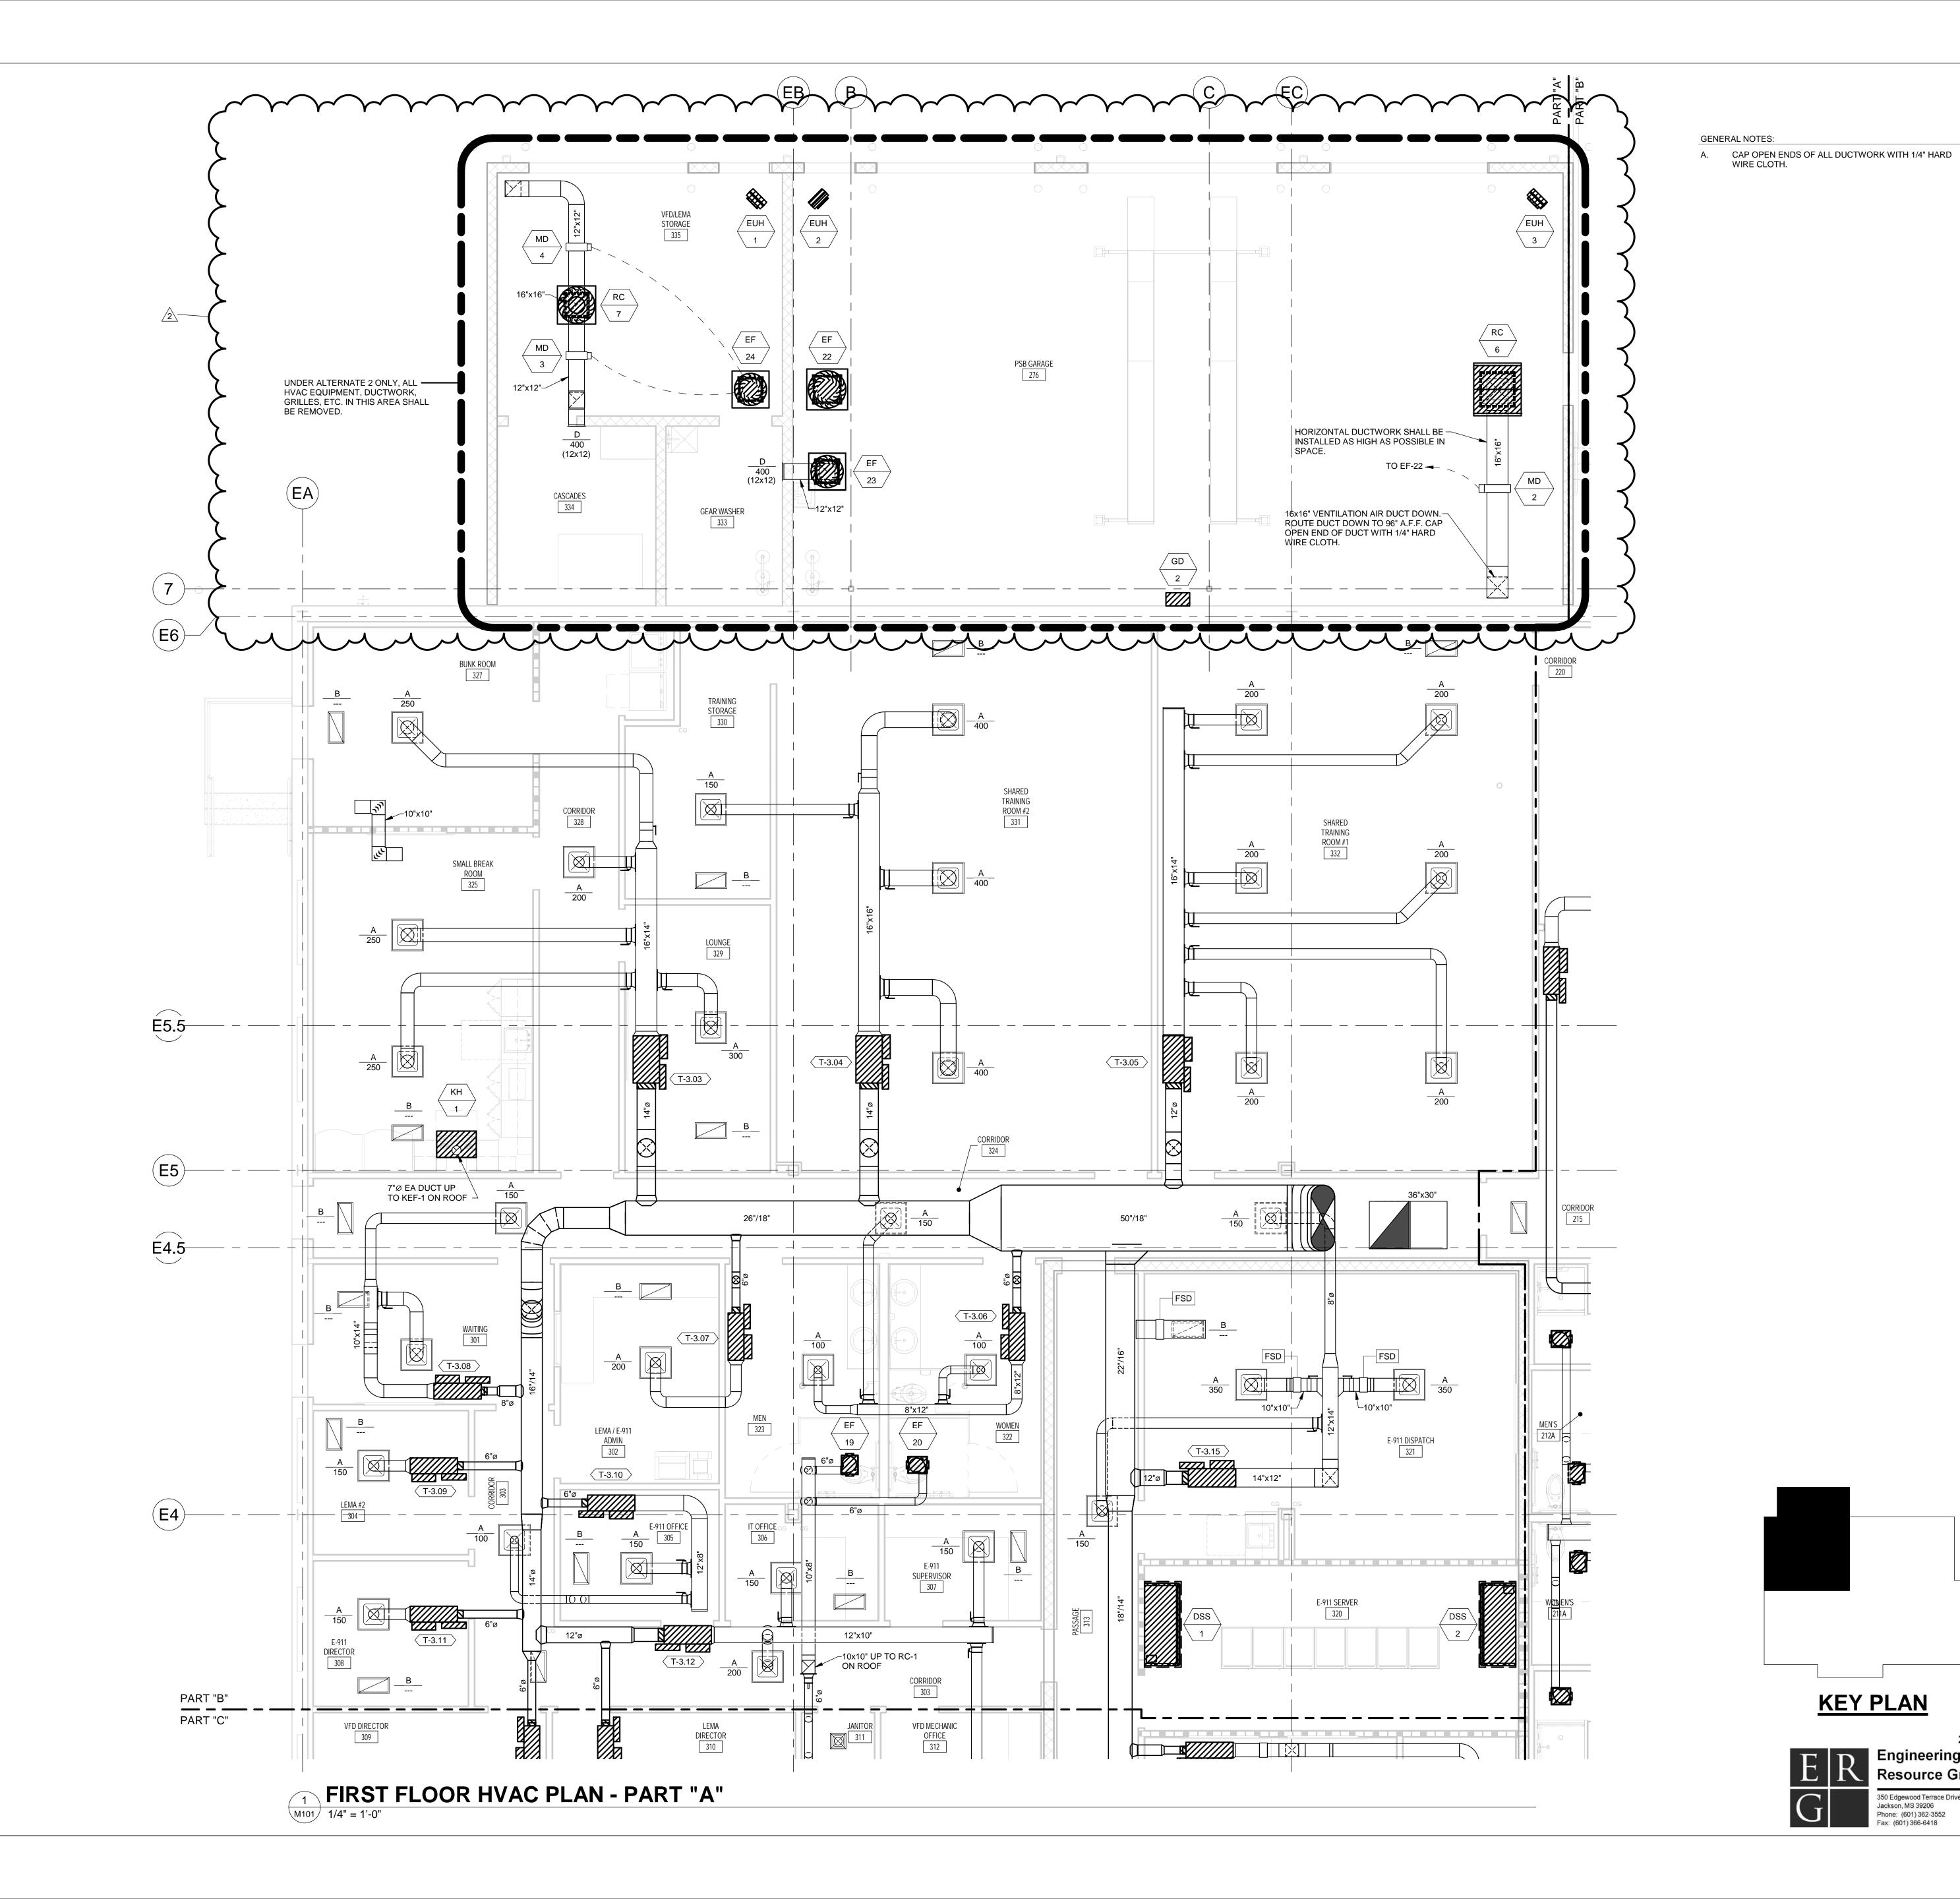

LPK ARCHITECTS, P.A.

Robert E. Luke, Architect

821 22ND AVENUE P.O. BOX 630
MERIDIAN, MISSISSIPP 33902
P: 601.693.9990
F: 601.693.8640



Lauderdale County Public Safety Building

PROJECT ADDRESS: Village Fair Mall Site 612 22nd Avenue (Winn-Dixie / LabCorp Building)

ACTIVE DESIGN PHASE FOR REVIEW ONLY FOR PERMITTING ONLY SCHEMATIC DESIGN DESIGN DEVELOPMENT

> CONSTRUCTION BIDDING CONSTRUCTION DOCUMENTS AS-BUILT RECORD SET


REVISIONS/SUBMISSIONS

FIRST FLOOR HVAC PLAN -PART "A"

KEY PLAN

20.087 PROJECT NO.: 19-4894B

350 Edgewood Terrace Drive Jackson, MS 39206 Phone: (601) 362-3552 Fax: (601) 366-6418 REVIEWED BY:

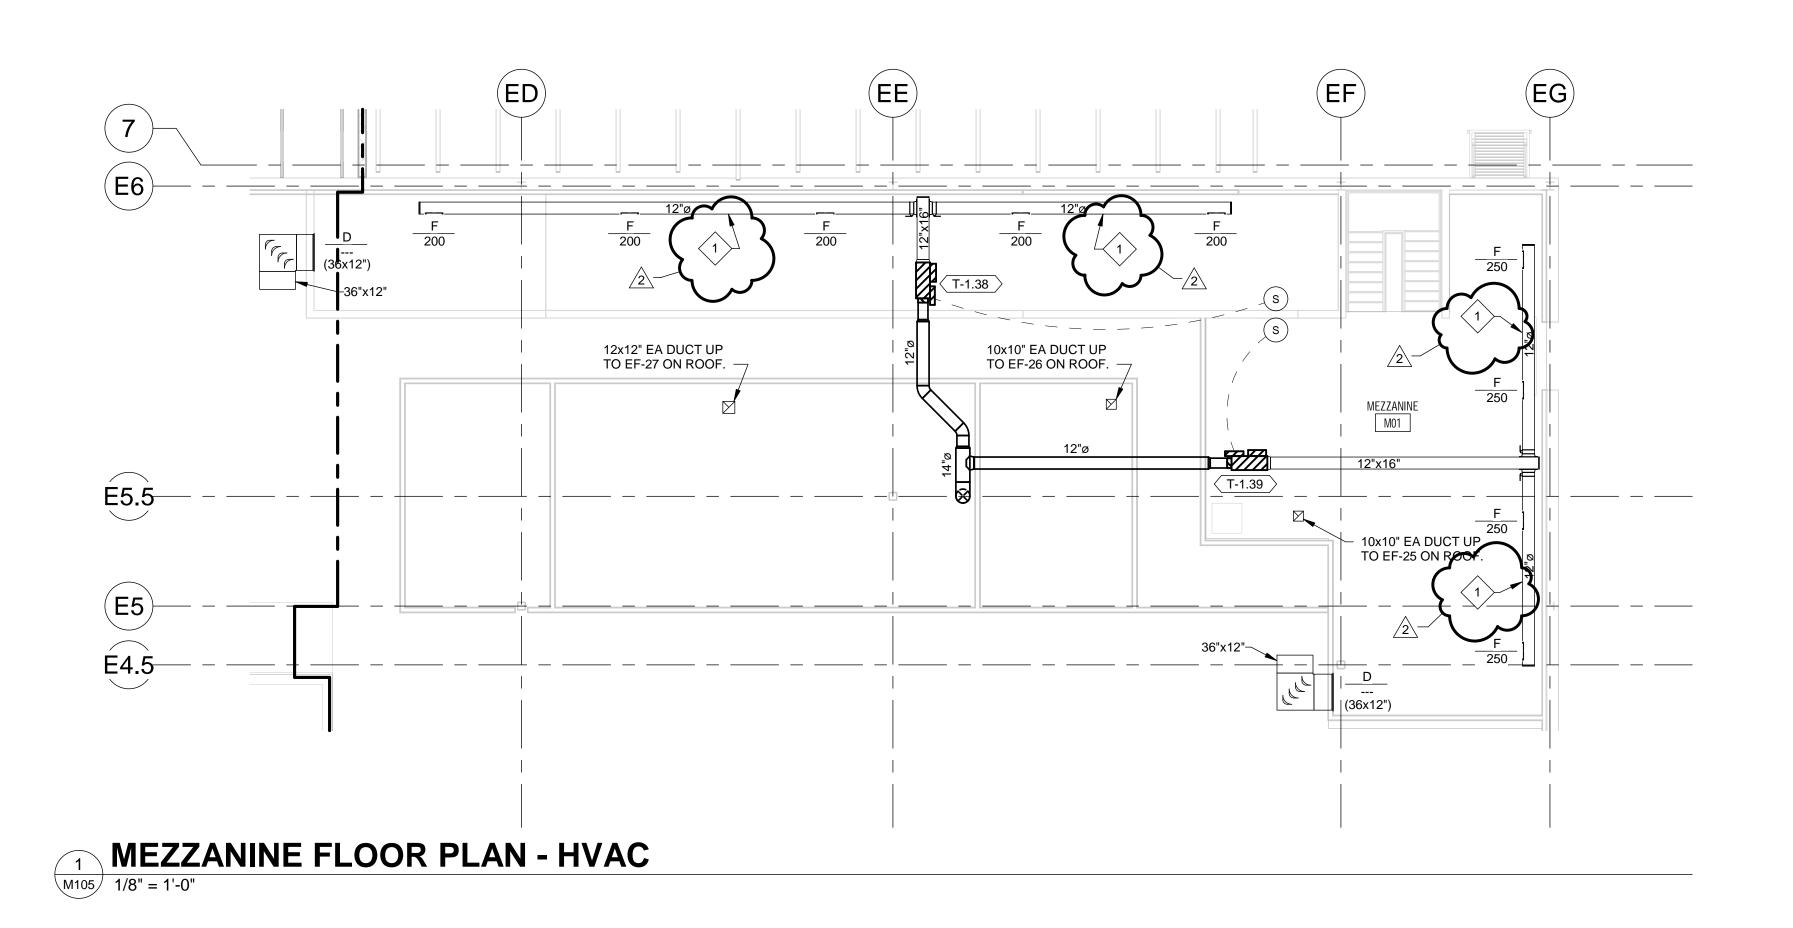

A. CAP OPEN ENDS OF ALL DUCTWORK WITH 1/4" HARD WIRE CLOTH. ROUND LOW PRESSURE DUCTWORK SHALL BE DOUBLE WALL SPIRAL.



LPK ARCHITECTS, P.A.

Robert E. Luke, Architect

821 22ND AVENUE P.O. BOX 630
MERIDIAN, MISSISSIPP 33902
P: 601.693.9990
F: 601.693.8640



Public Safety Building

PROJECT ADDRESS:

Village Fair Mall Site 612 22nd Avenue (Winn-Dixie / LabCorp Building)



ACTIVE DESIGN PHASE

FOR REVIEW ONLY FOR PERMITTING ONLY DESIGN DEVELOPMENT CONSTRUCTION BIDDING

> CONSTRUCTION DOCUMENTS AS-BUILT RECORD SET




	REVISION	IS/SUBMISSIONS
NO.	DATE	DESCRIPTION
2	04/30/2021	ADDENDUM #3
	I .	

MEZZANINE HVAC FLOOR PLAN

KEY PLAN



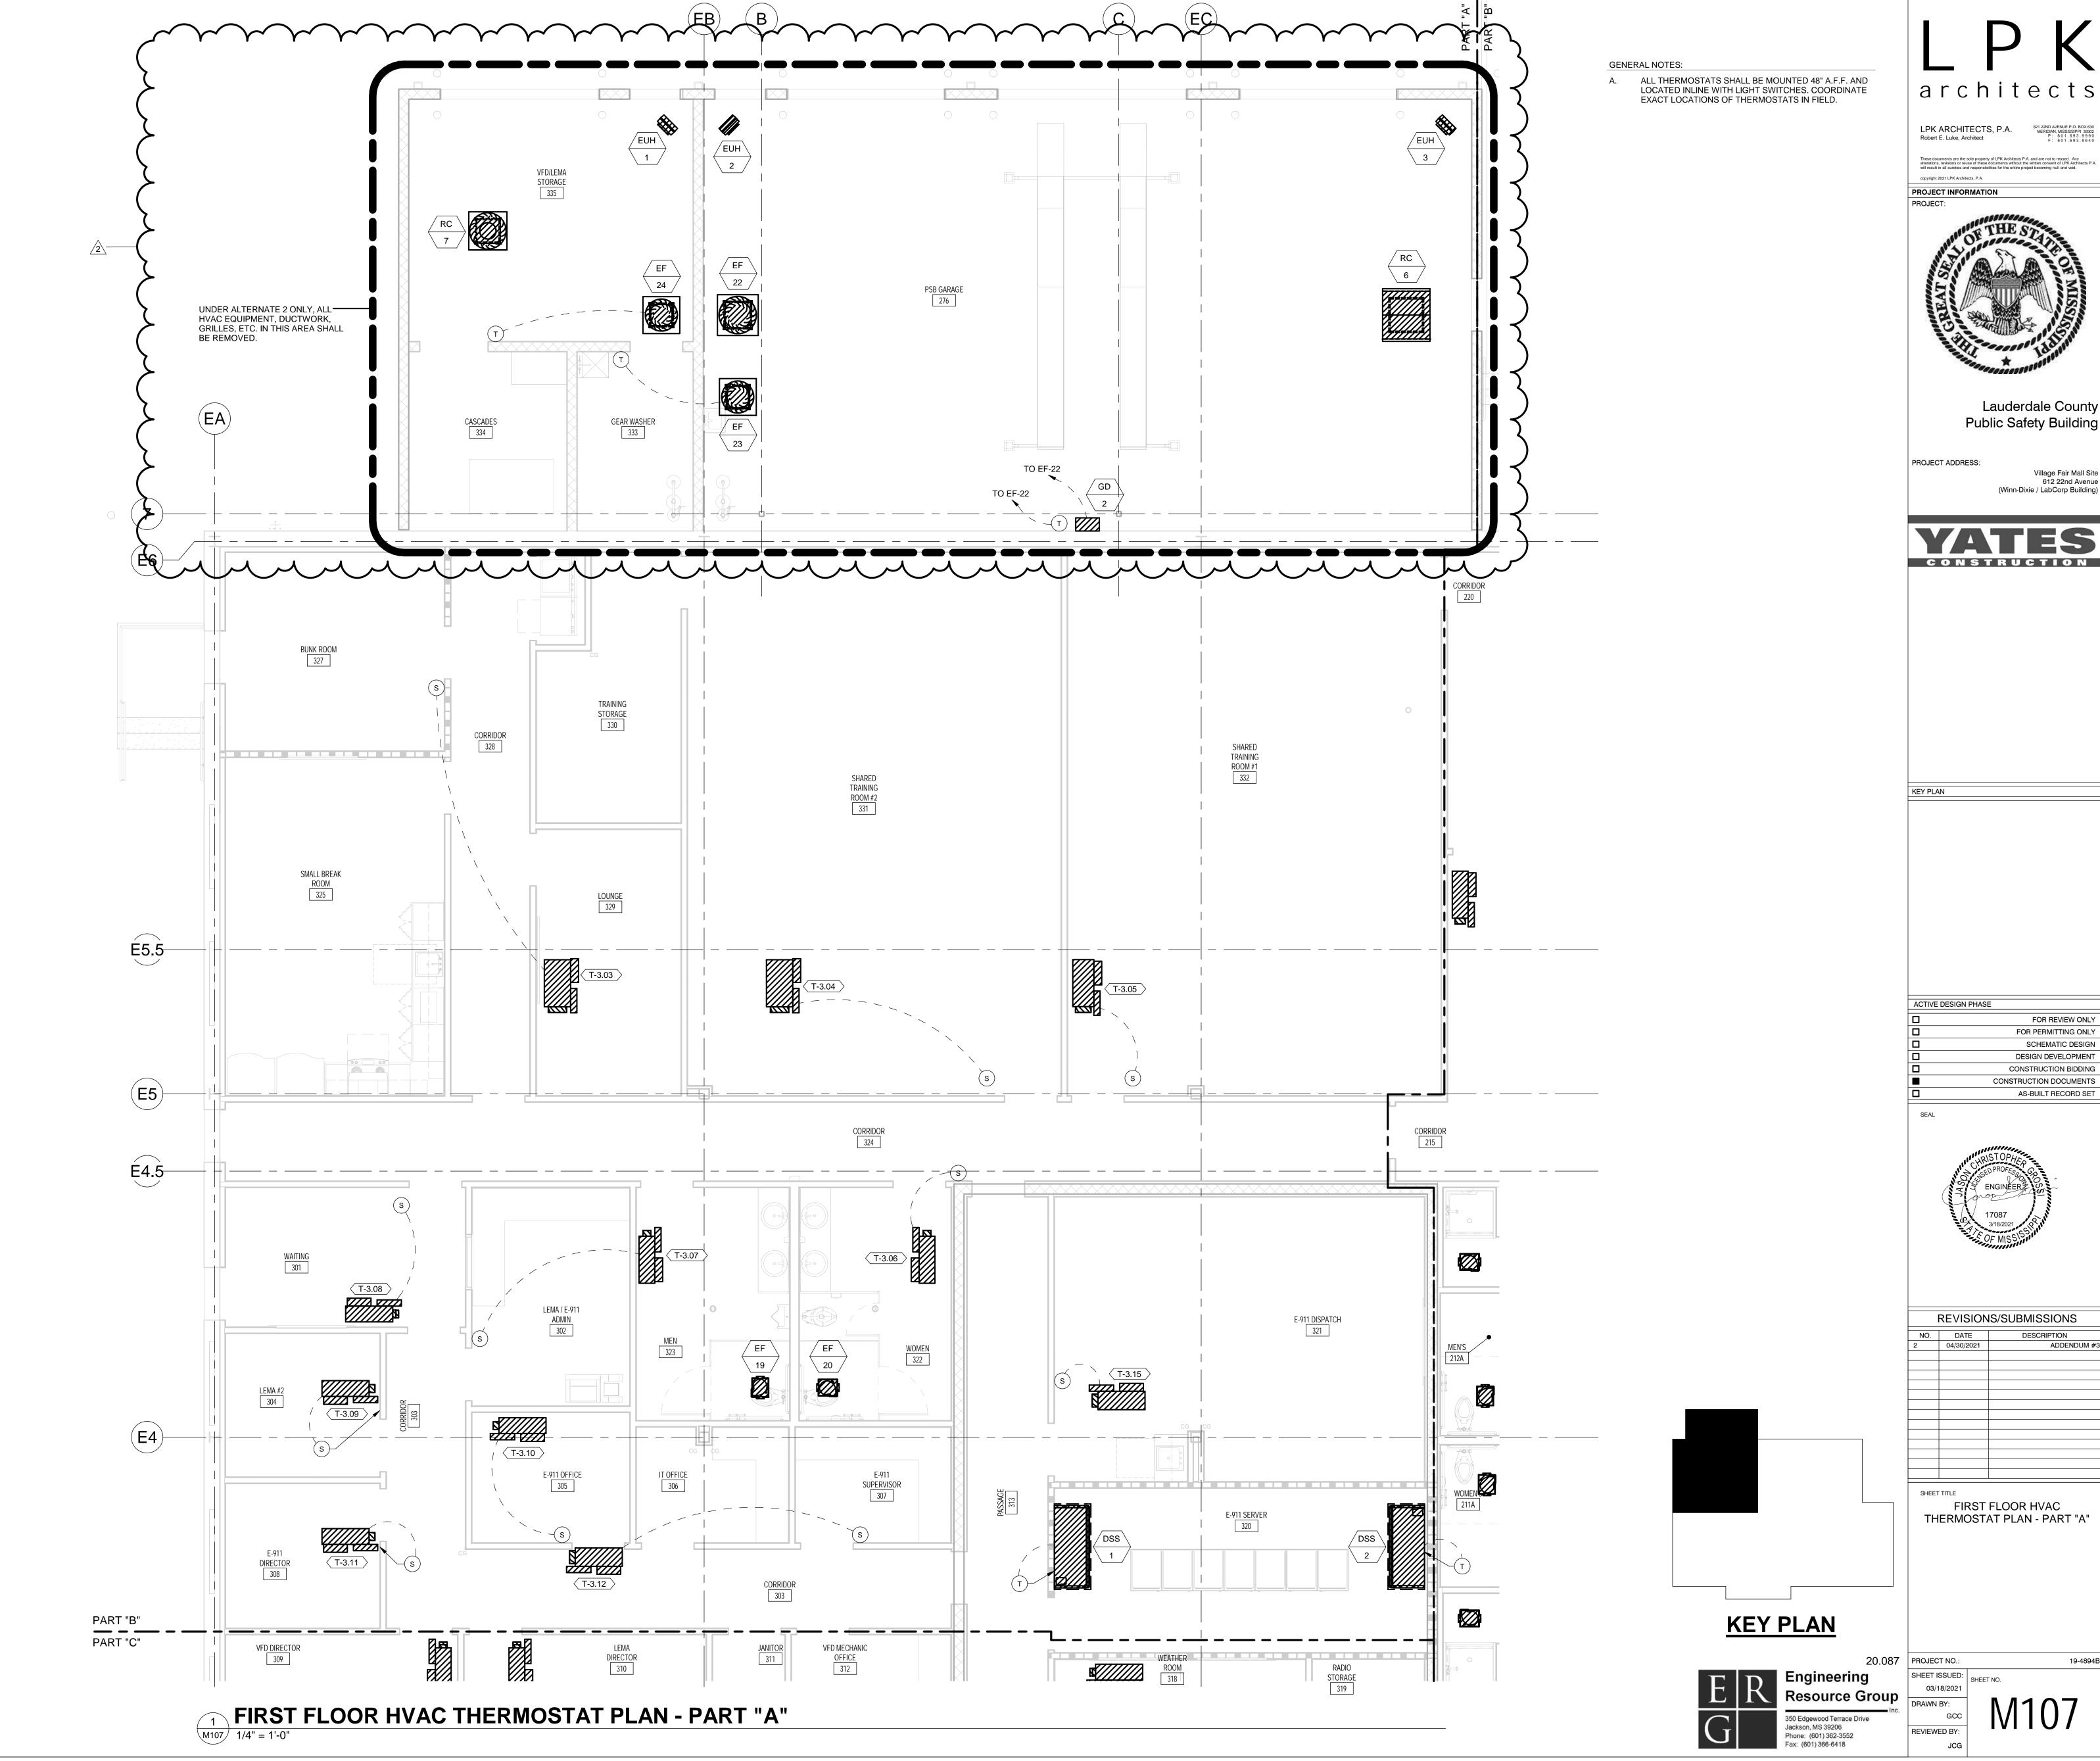




Lauderdale County

Village Fair Mall Site 612 22nd Avenue

FOR REVIEW ONLY FOR PERMITTING ONLY SCHEMATIC DESIGN DESIGN DEVELOPMENT CONSTRUCTION BIDDING


REVISIONS/SUBMISSIONS

19-4894B

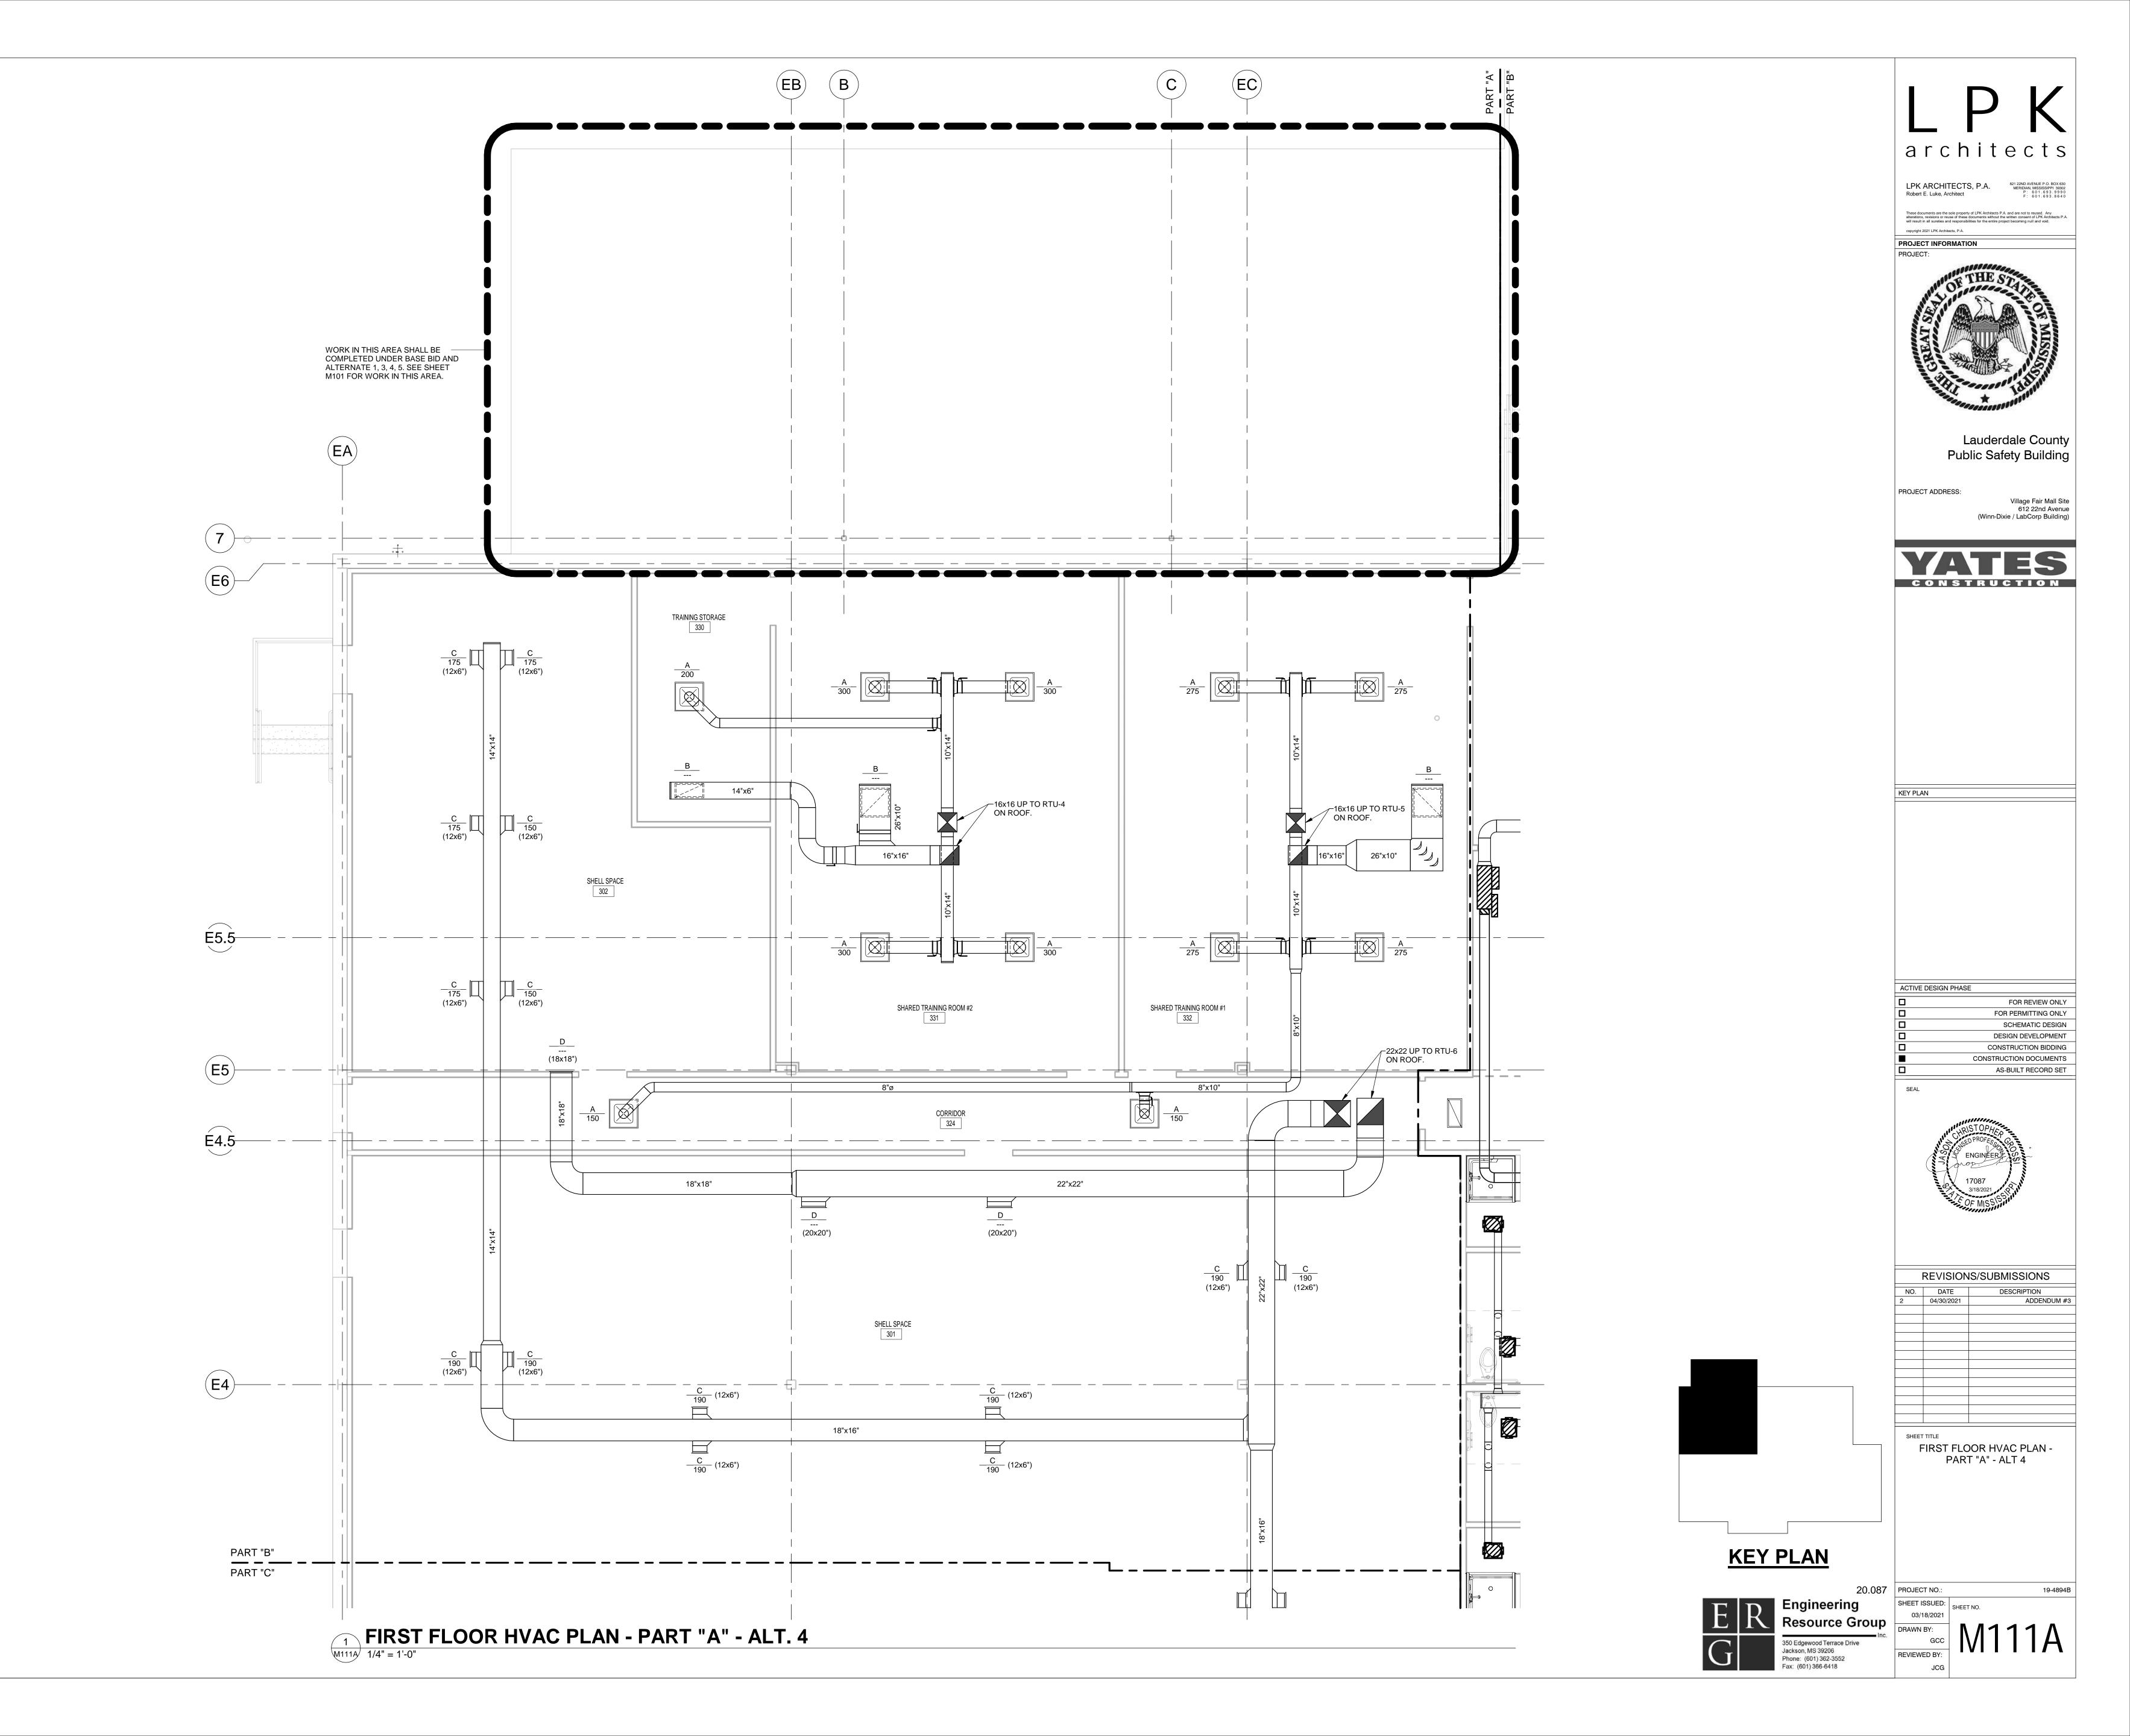

//Lauderdale County Government //20.87 - HVAC Model_R20.rvt

Complex/20.87 - HVAC Model_R

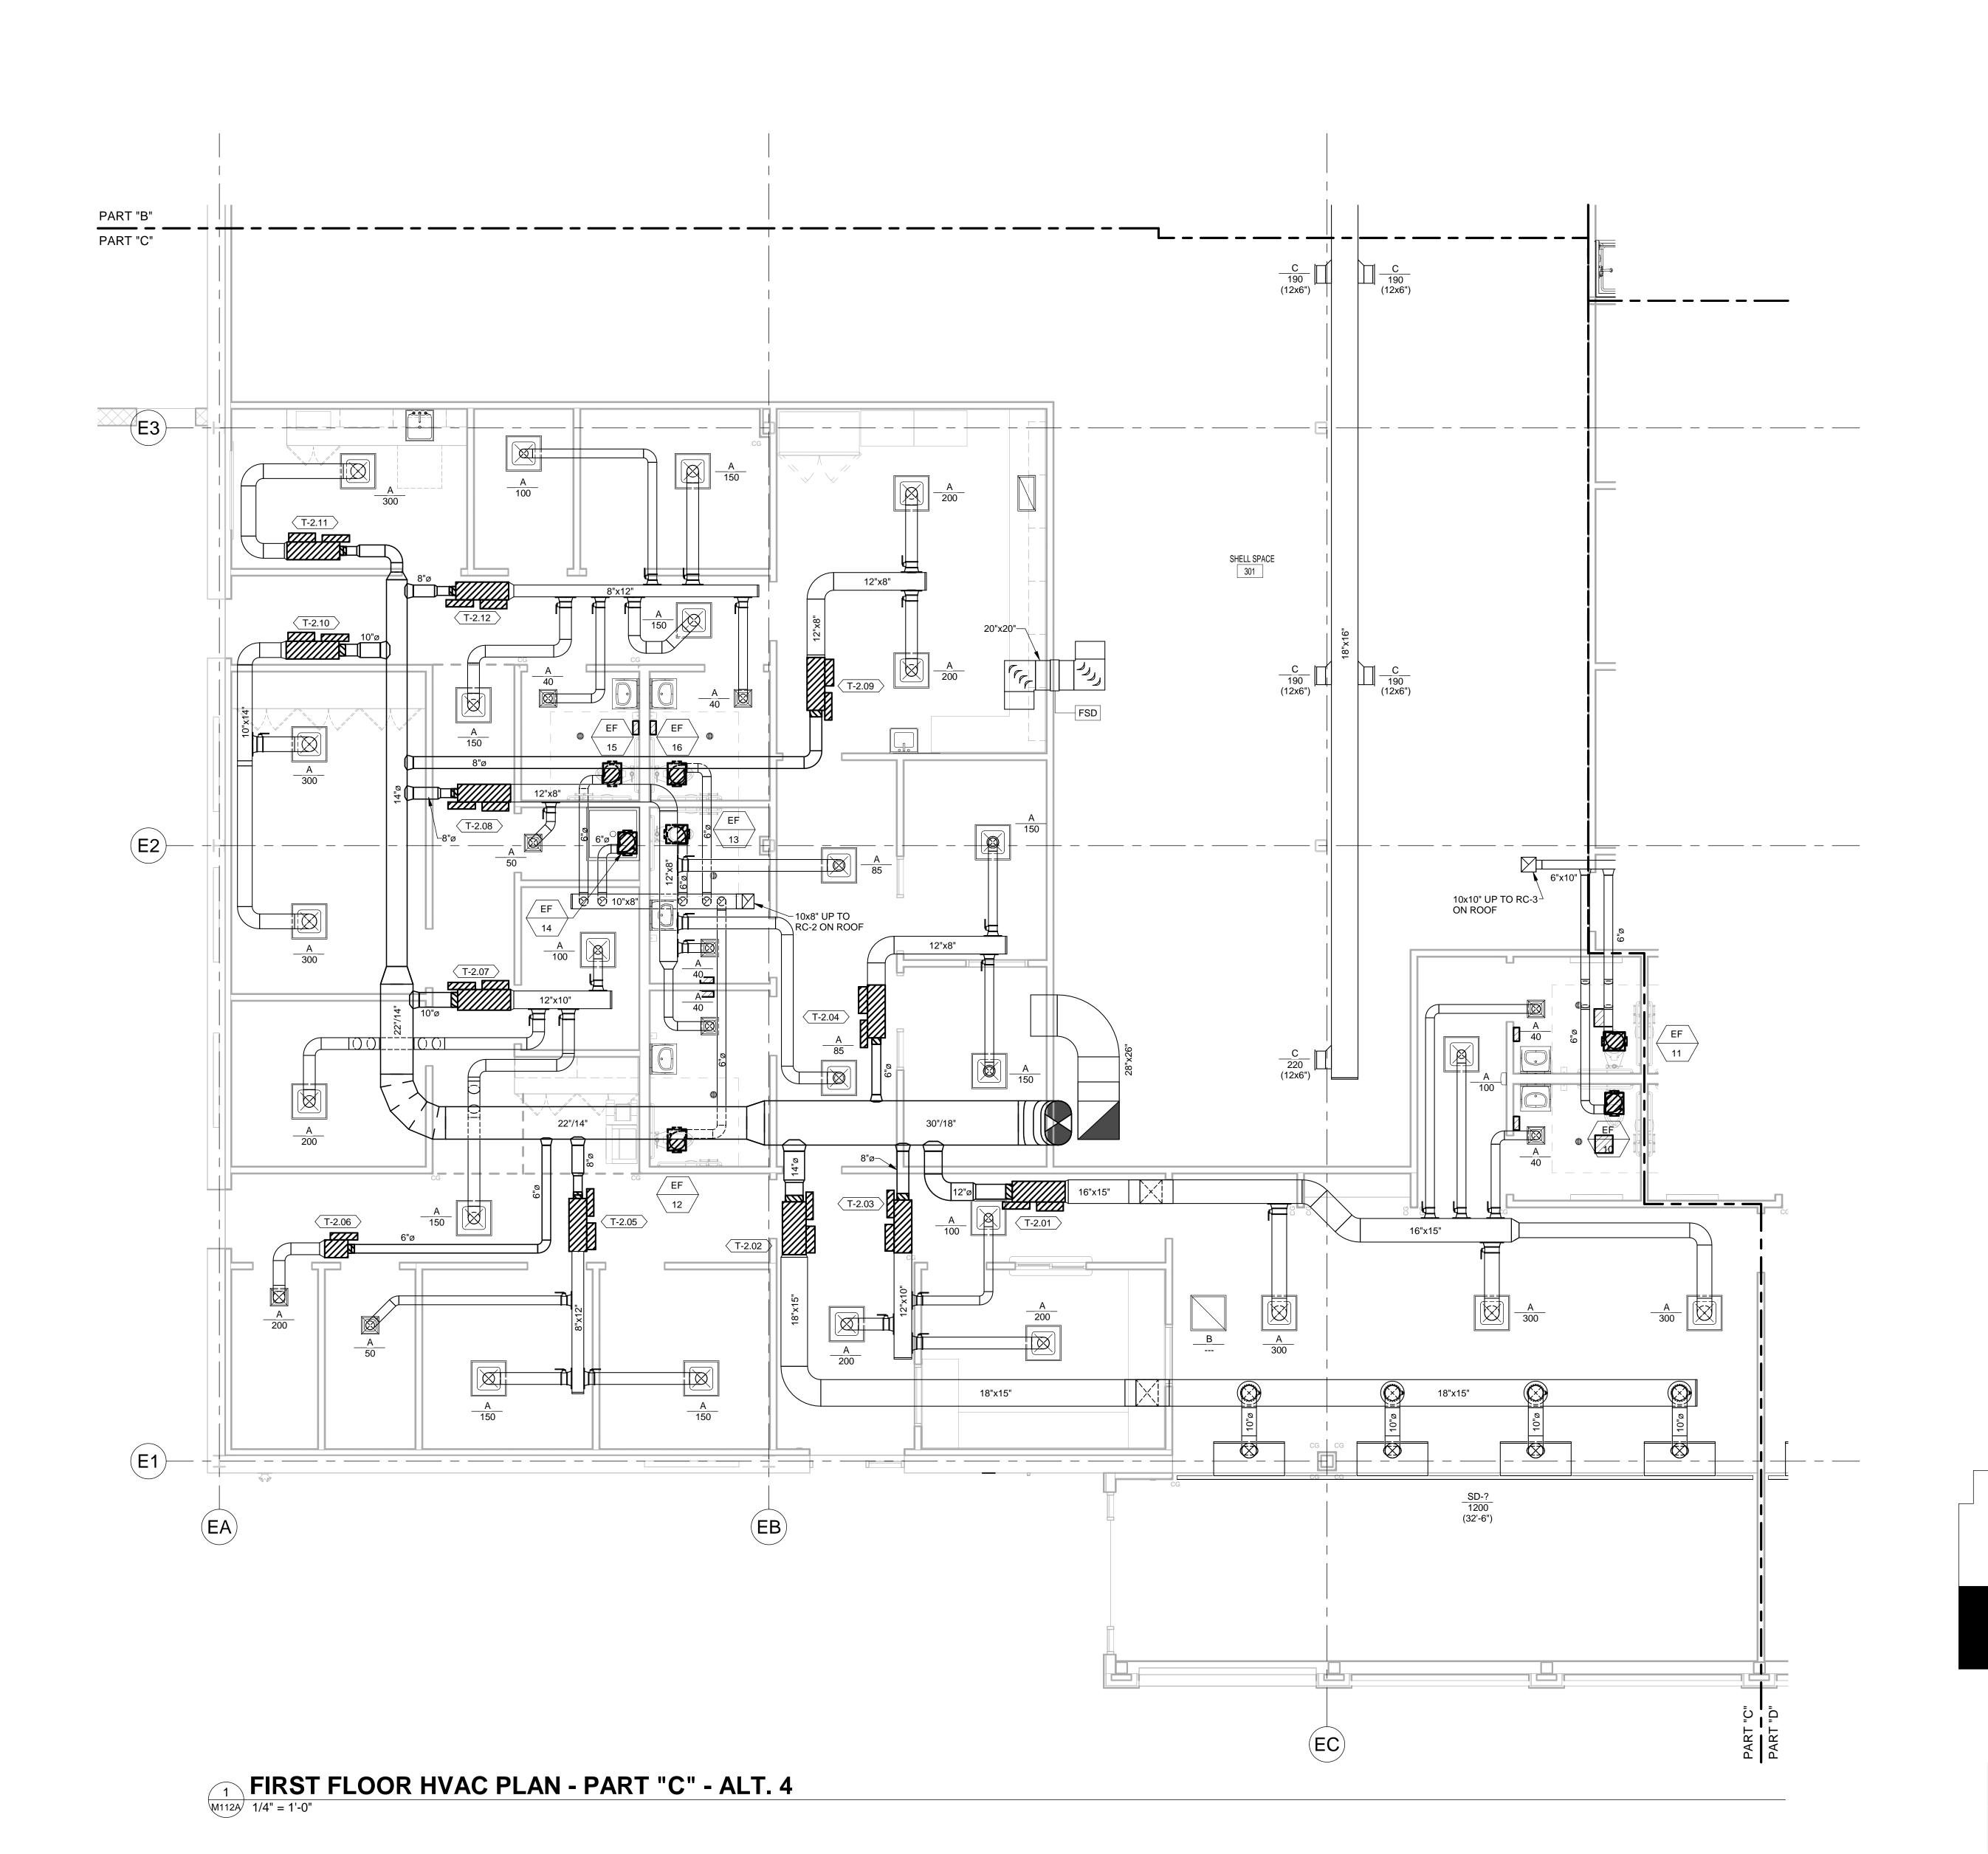




LPK ARCHITECTS, P.A.

Robert E. Luke, Architect

821 22ND AVENUE P.O. BOX 630
MERIDIAN, MISSISSIPP1 330302
P: 601 . 693 . 999 0
F: 601 . 693 . 8640

nese documents are the sole property of LPK Architects P.A. and are not to reused. Any terations, revisions or reuse of these documents without the written consent of LPK Architects P.A ill result in all surfeies and responsibilities for the entire project becoming null and void. ppyright 2021 LPK Architects, P.A.

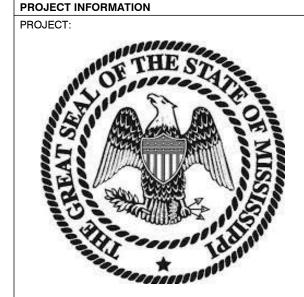

Lauderdale County Public Safety Building


PROJECT ADDRESS:

VATES

ACTIVE DESIGN PHASE

FOR REVIEW ONLY
FOR PERMITTING ONLY
SCHEMATIC DESIGN
DESIGN DEVELOPMENT
CONSTRUCTION BIDDING
CONSTRUCTION DOCUMENTS

AS-BUILT RECORD SET

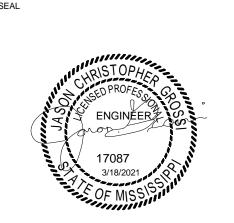

ļ			
		REVISION	IS/SUBMISSIONS
	NO.	DATE	DESCRIPTION
	2	04/30/2021	ADDENDUM #3
-			
-			
-			
-			
ŀ			
Ī			

FIRST FLOOR HVAC PLAN -PART "C" - ALT 4

KEY PLAN



20.087 PROJECT NO.:

SHEET ISSUED:
03/18/2021

DRAWN BY:
GCC


GCC

SHEET ISSUED: 03/18/2021


DRAWN BY: GCC

REVIEWED BY: 15 46

SHEET NO. 15

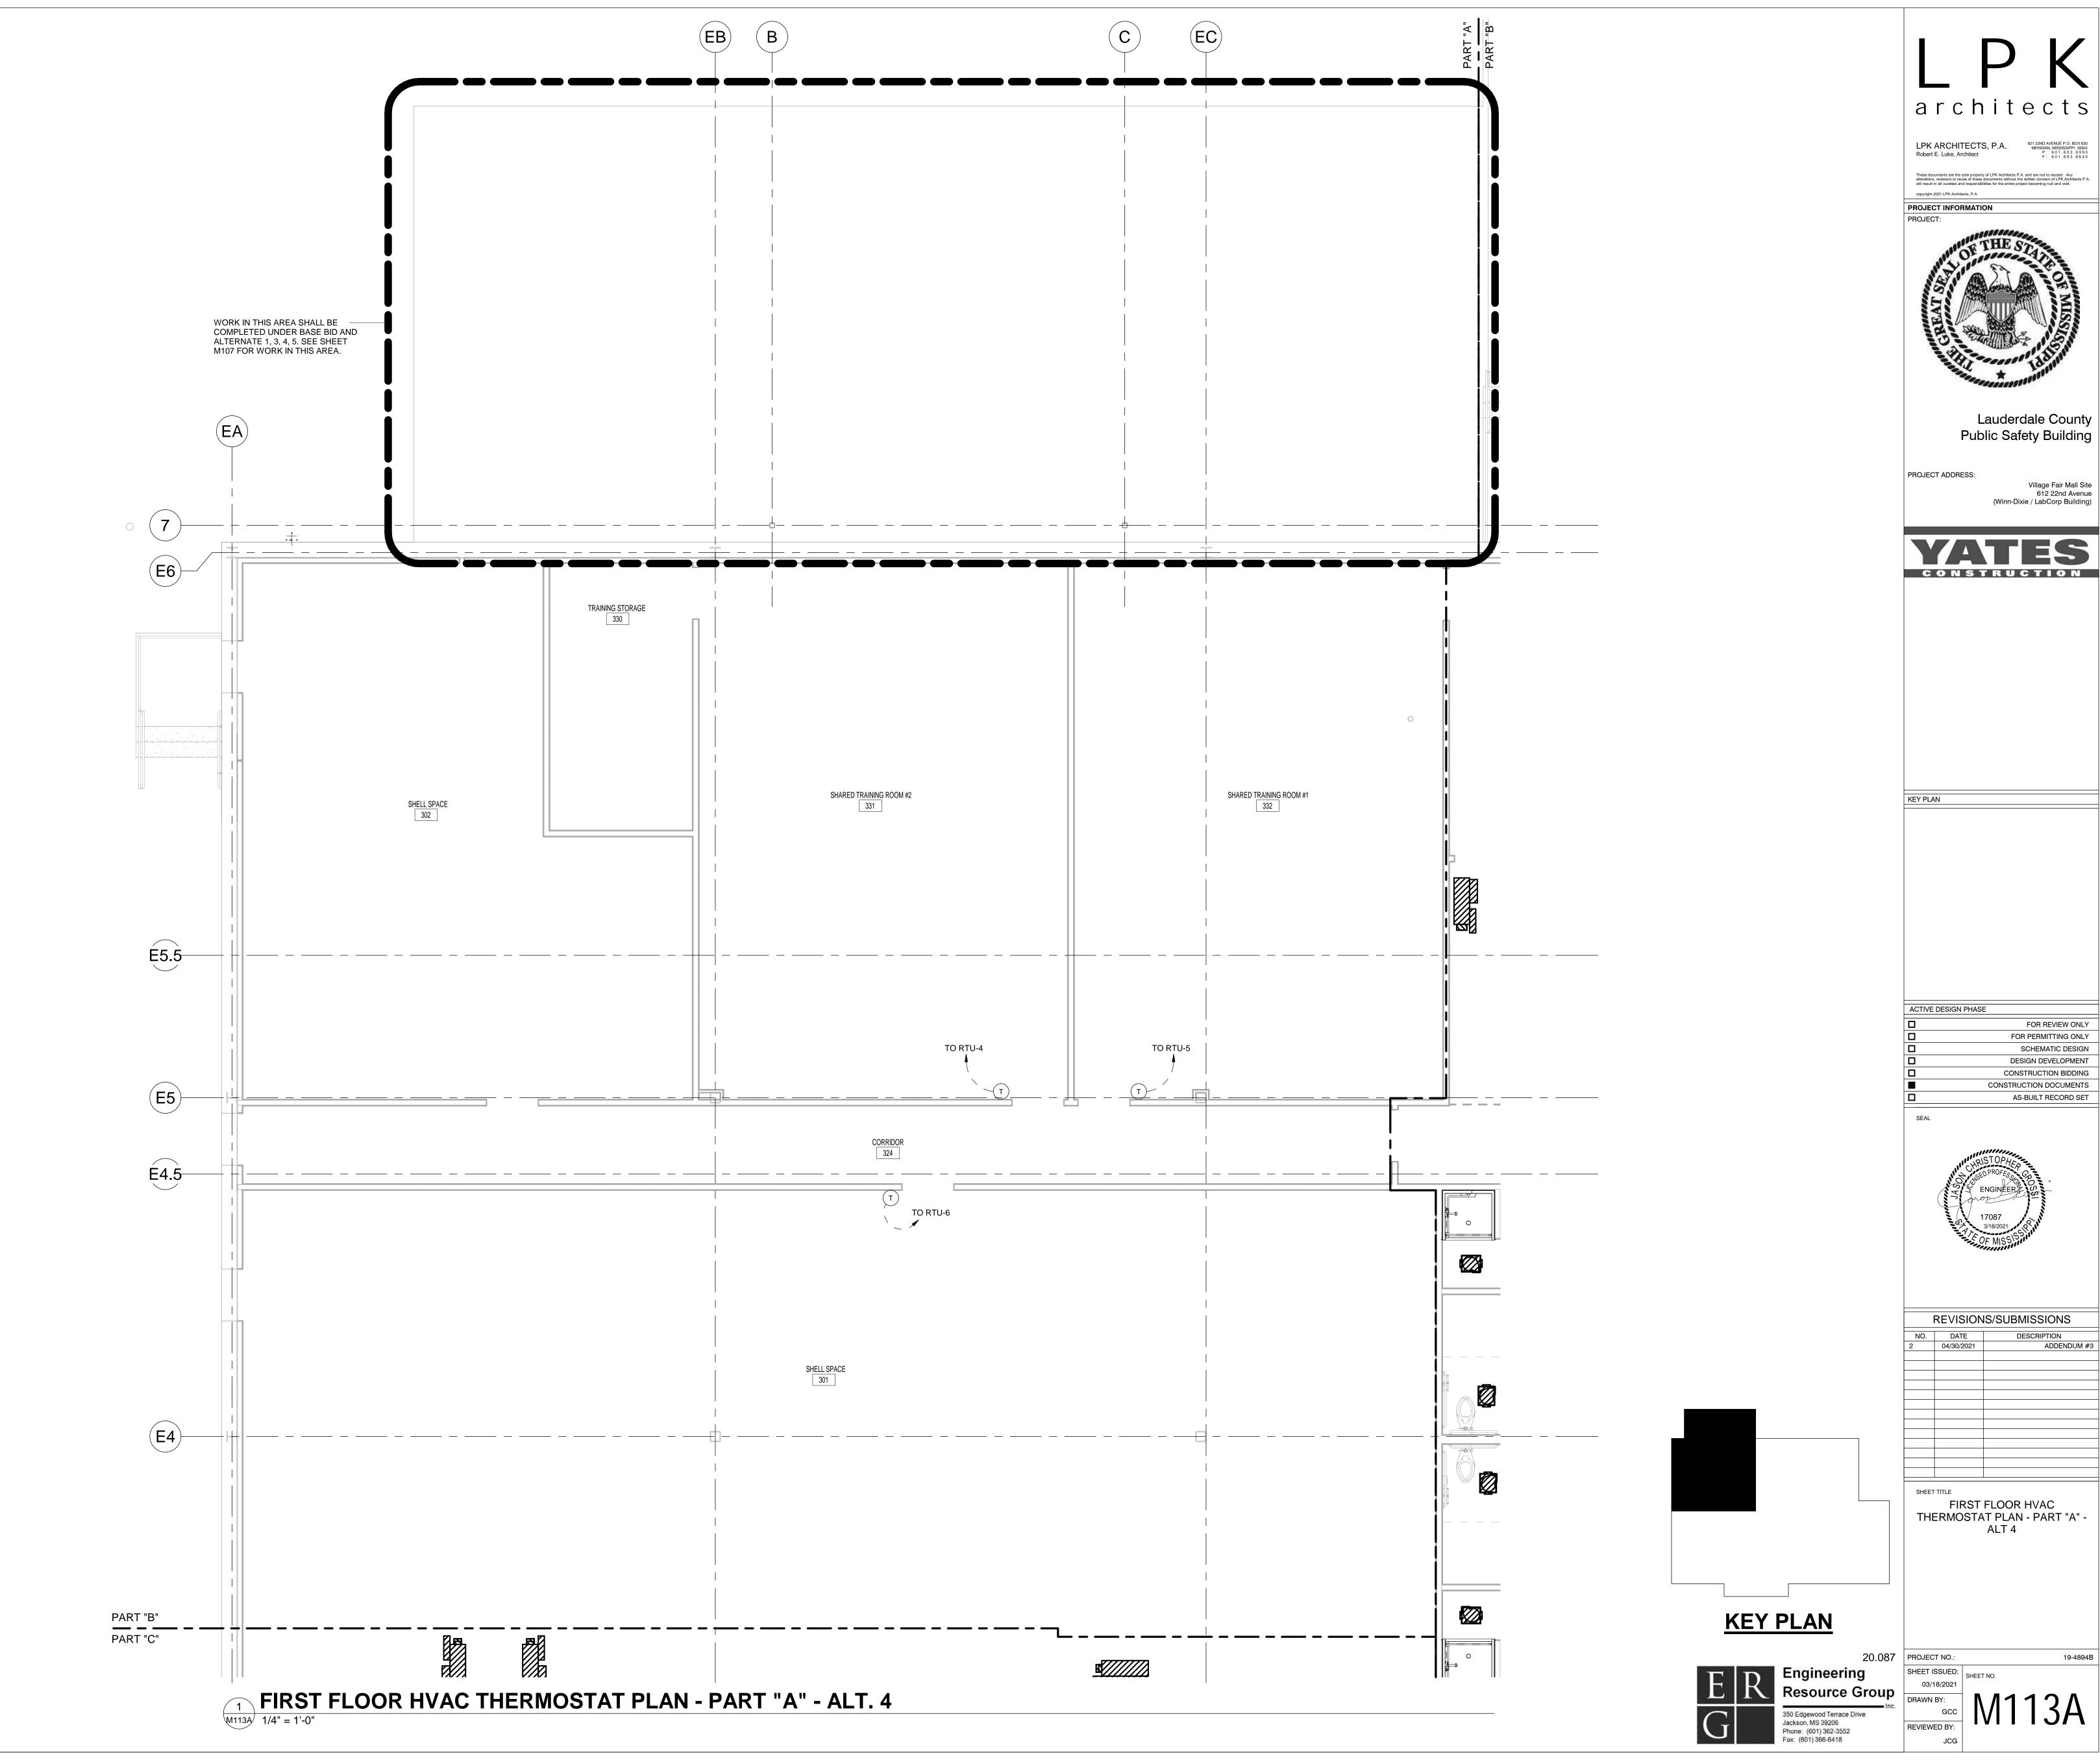



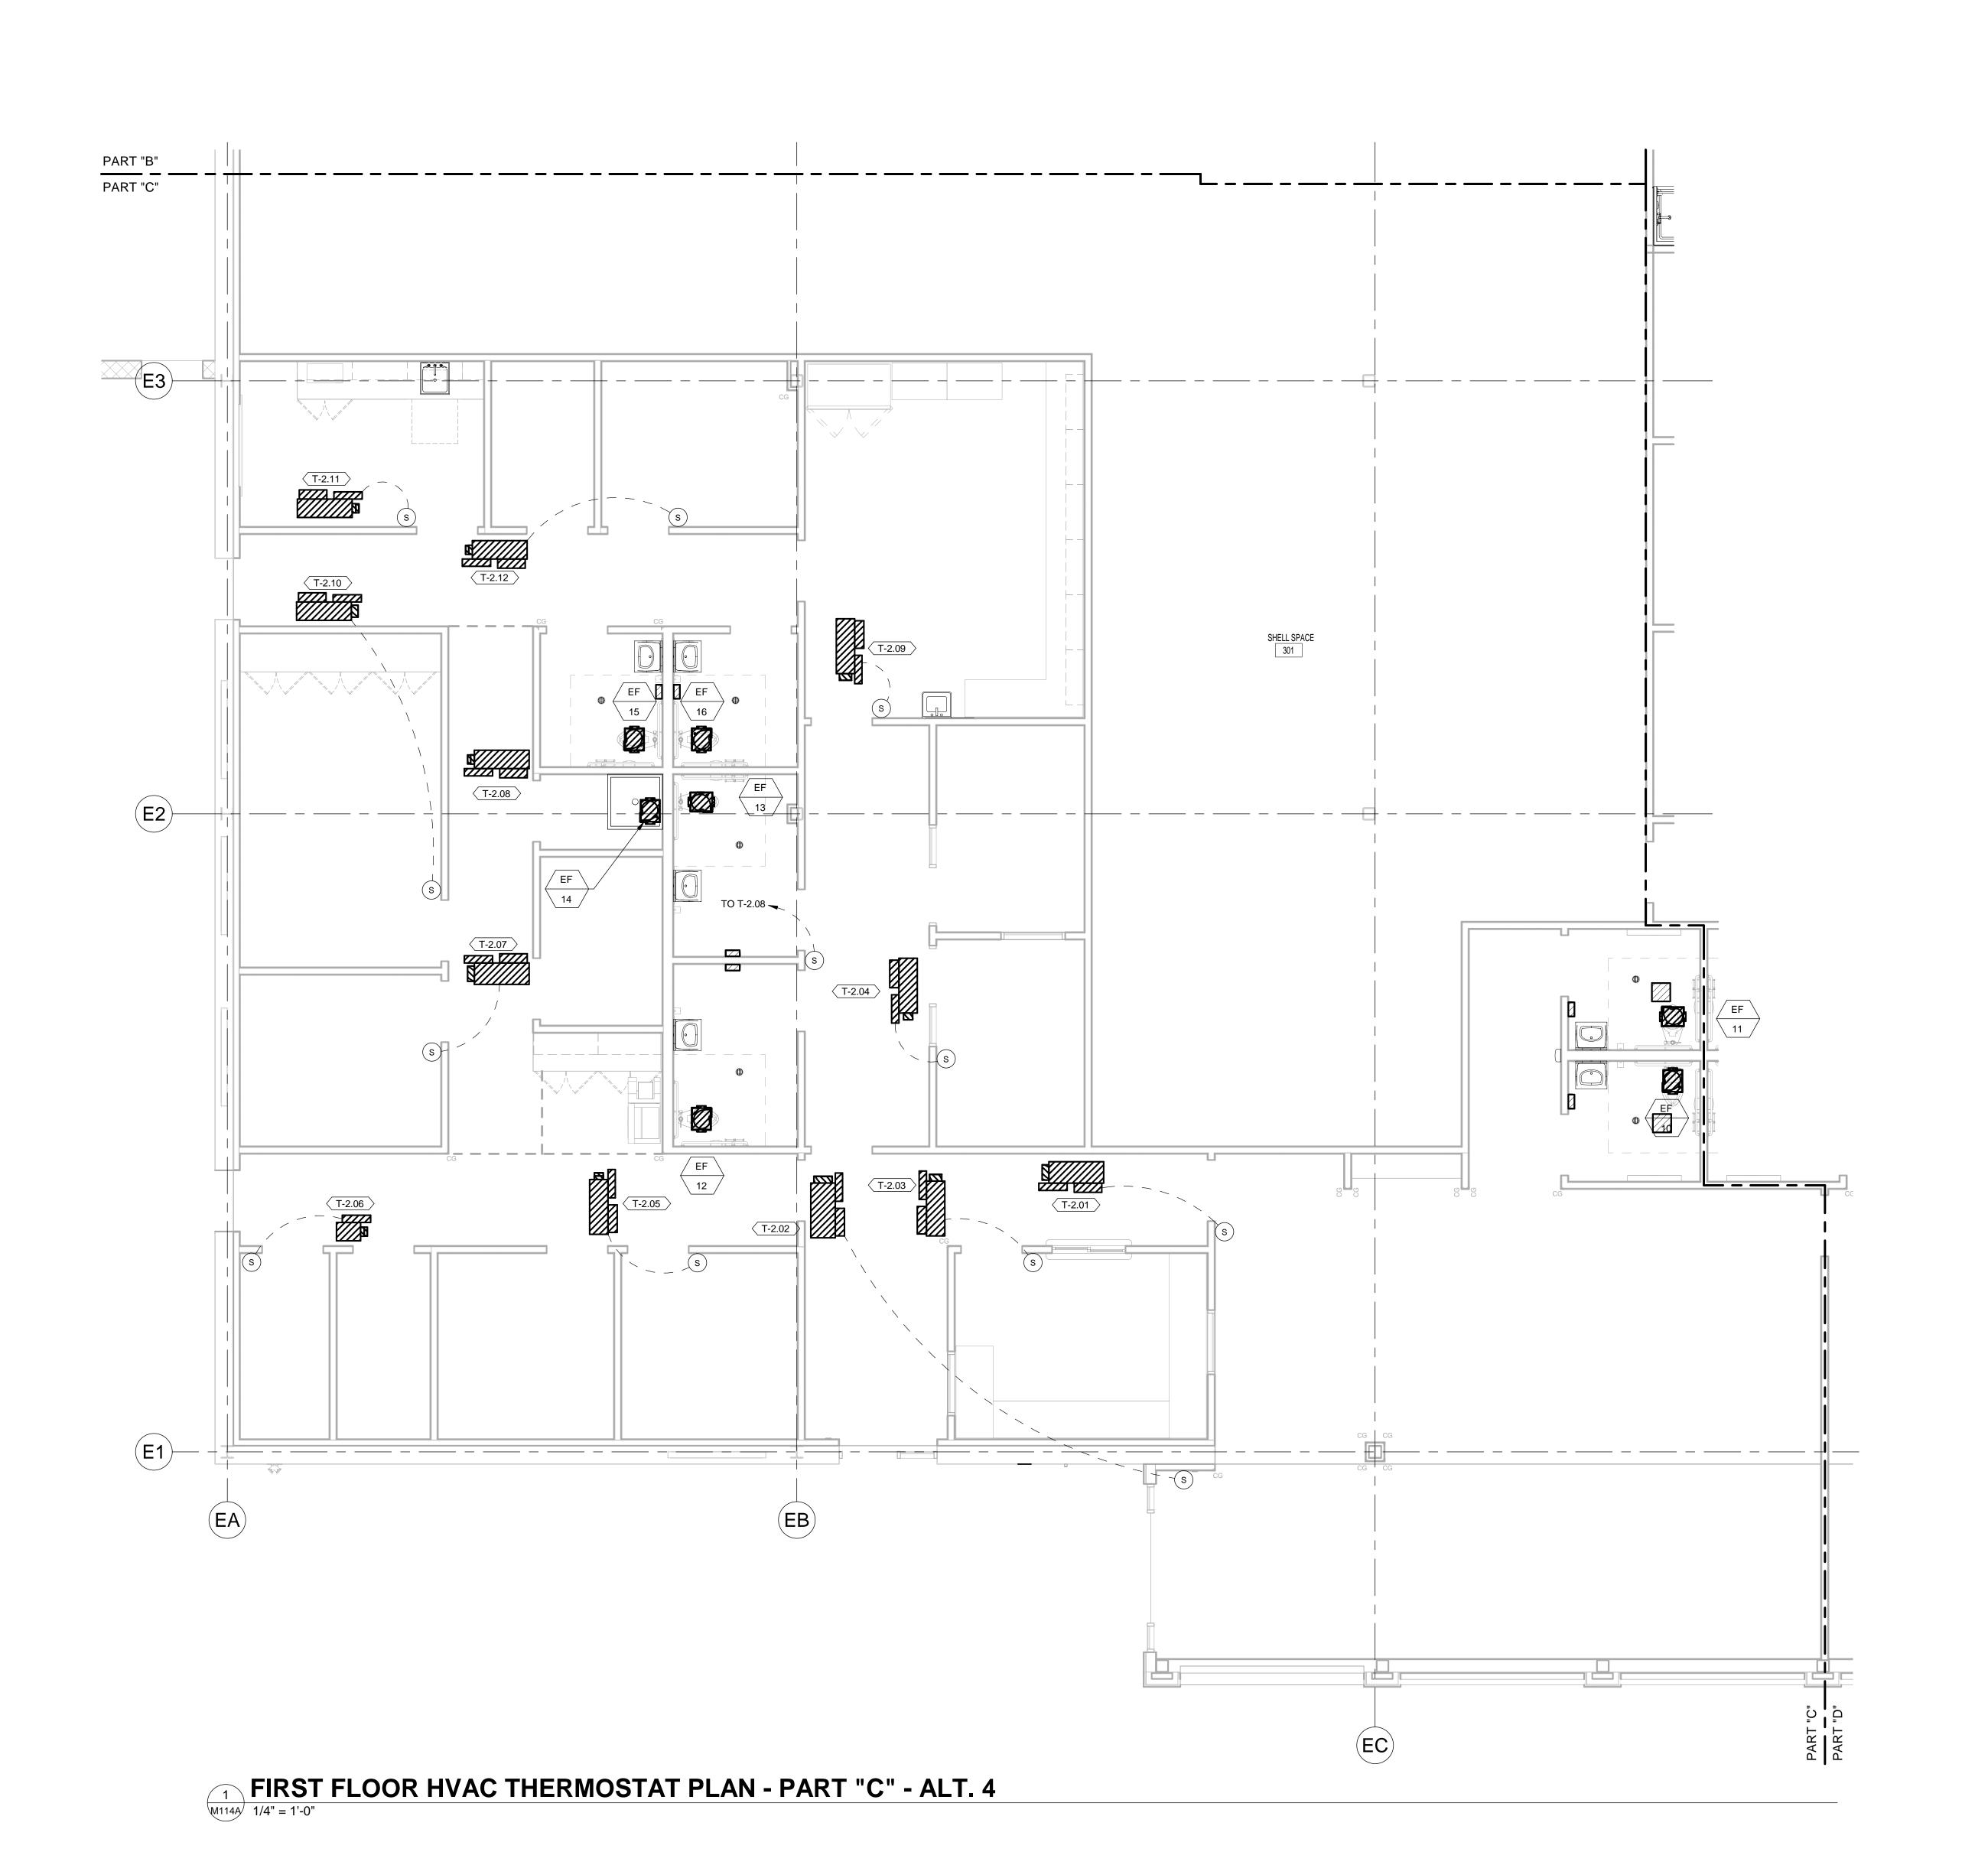



LPK ARCHITECTS, P.A.

Robert E. Luke, Architect

821 22ND AVENUE P.O. BOX 630
MERIDIAN, MISSISSIPPI 389022
P: 601.693.8990
F: 601.693.8940



Lauderdale County Public Safety Building


PROJECT ADDRESS:

ACTIVE DESIGN PHASE

FOR REVIEW ONLY FOR PERMITTING ONLY DESIGN DEVELOPMENT CONSTRUCTION BIDDING

AS-BUILT RECORD SET

CONSTRUCTION DOCUMENTS

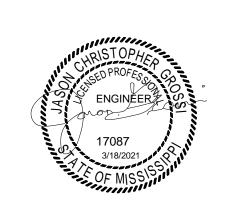


REVISIONS/SUBMISSIONS				
NO.	DATE	DESCRIPTION		
2	04/30/2021	ADDENDUM #3		

FIRST FLOOR HVAC THERMOSTAT PLAN - PART "C" -ALT 4

KEY PLAN



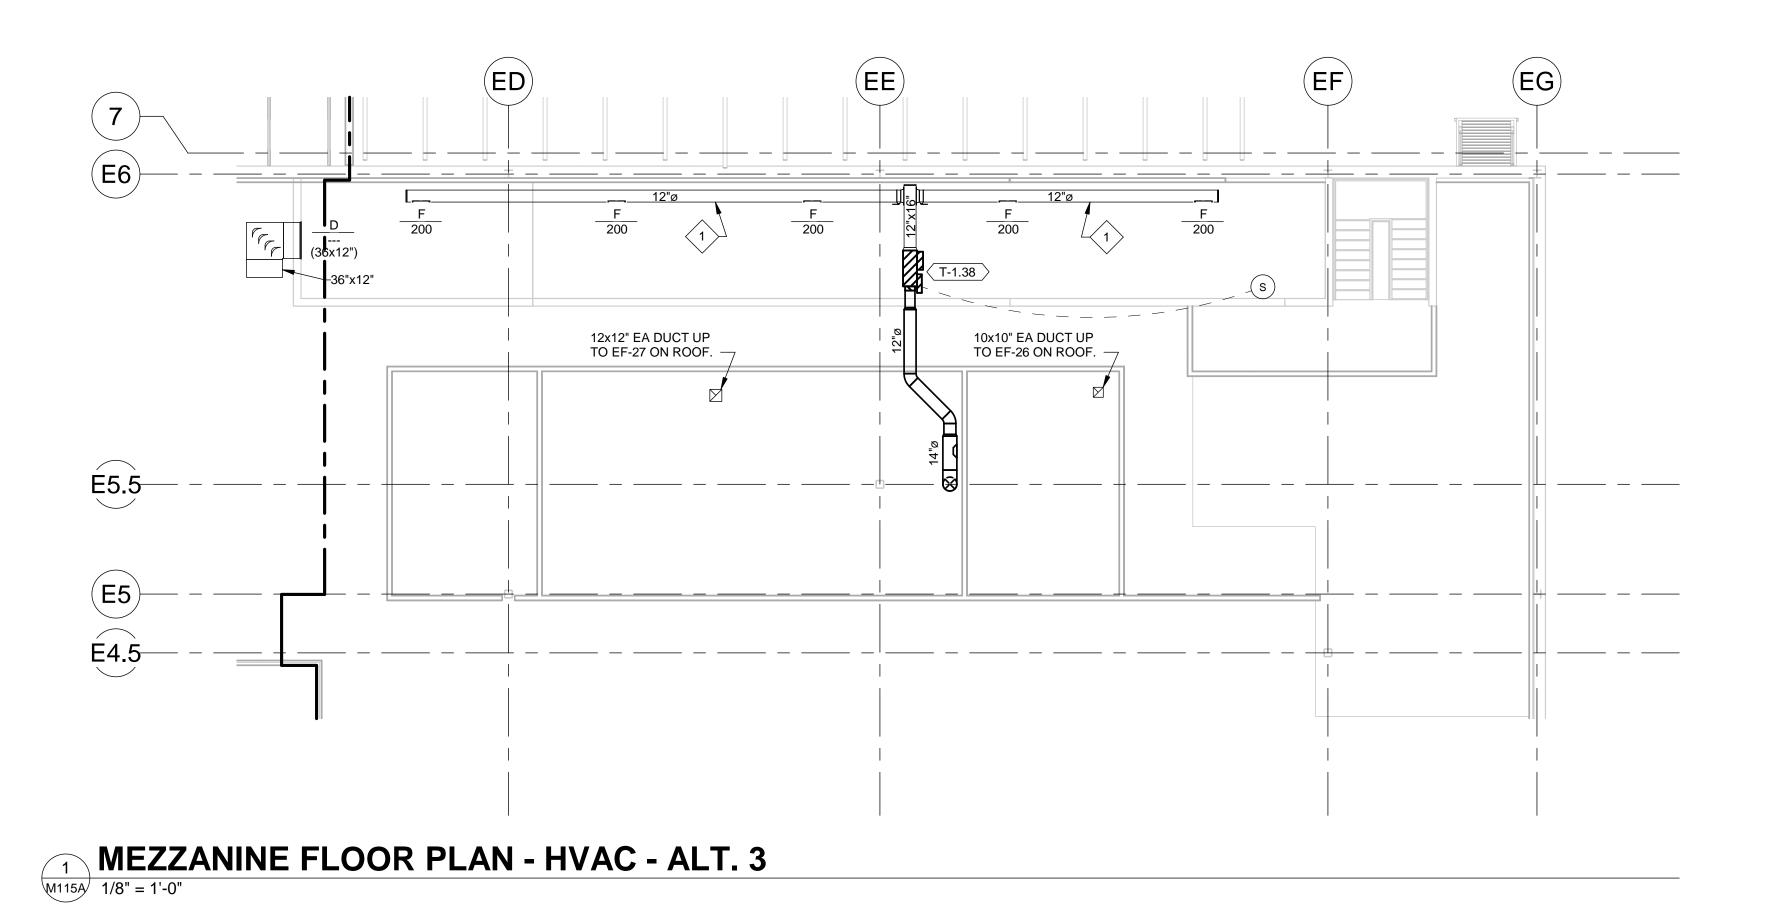

GENERAL NOTES:

A. CAP OPEN ENDS OF ALL DUCTWORK WITH 1/4" HARD WIRE CLOTH.

LAN NOTES:

ROUND LOW PRESSURE DUCTWORK SHALL BE DOUBLE WALL SPIRAL.

LPK ARCHITECTS, P.A.
Robert E. Luke, Architect

These documents are the sole property of LPK Architects P.A. and are not to reused. Any alterations, revisions or reuse of these documents without the written consent of LPK Architects will result in all curvative and reconcibilities for the action project become only and the control of LPK Architects will result in all curvative and reconcibilities for the action project become only and the control of LPK Architects.

copyright 2021 LPK Architects, P.A.

PROJECT INFORMATION



Lauderdale County
Public Safety Building

PROJECT ADDRESS:

Village Fair Mall Si 612 22nd Avenu (Winn-Dixie / LabCoro Buildin



KEY PLA


ACTIVE DESIGN PHASE

FOR REVIEW ONLY
FOR PERMITTING ONLY
SCHEMATIC DESIGN
DESIGN DEVELOPMENT
CONSTRUCTION BIDDING

CONSTRUCTION DOCUMENTS

AS-BUILT RECORD SET

SEAL

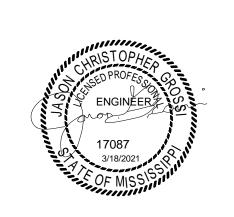

	REVISIONS/SUBMISSIONS		
NO.	DATE	DESCRIPTION	
2	04/30/2021	ADDENDUM #	

SHEET TITLE

MEZZANINE HVAC FLOOR PLA

- ALT 4




e Group

ce Drive

PROJECT NO.: 19-48

SHEET ISSUED: 03/18/2021

DRAWN BY: SHEET NO.

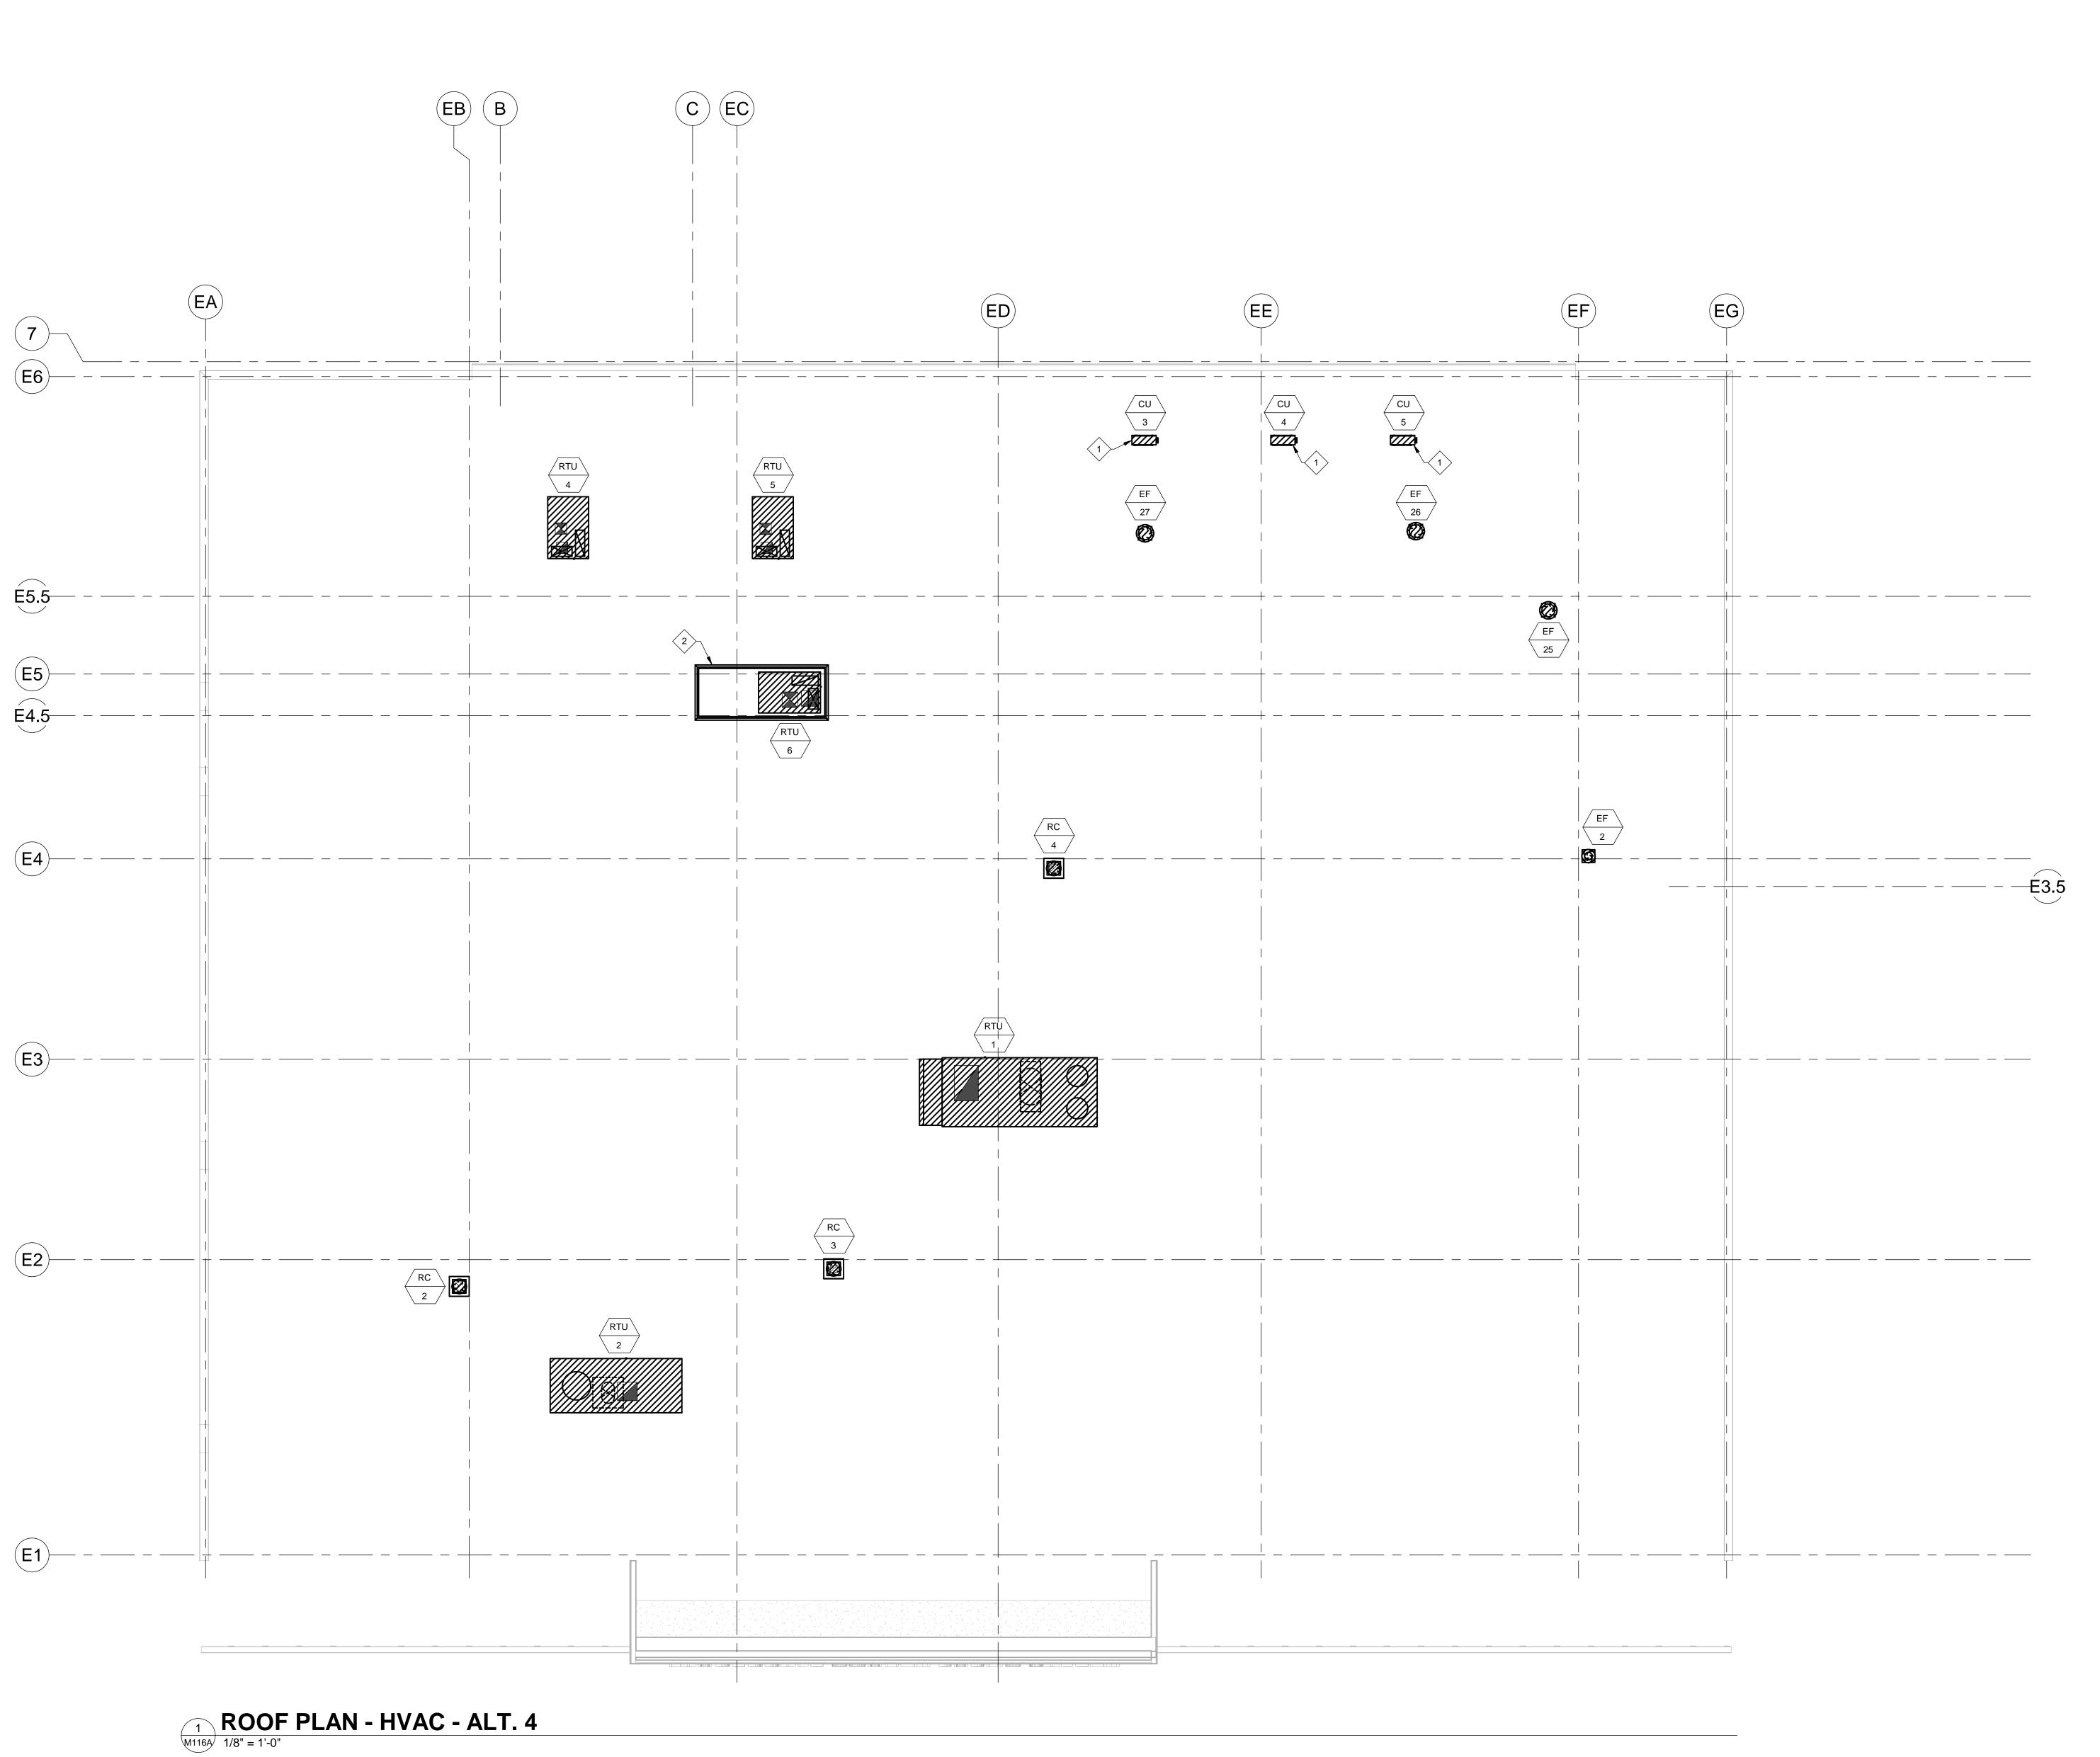

PLAN NOTES:

- PROVIDE AND INSTALL OUTDOOR UNITS ON THYBAR TEMS-1 EQUIPMENT SUPPORT. COORDINATE EXACT HEIGHT OF SUPPORT WITH ROOF INSULATION THICKNESS IN THIS AREA.
- 2. PROVIDE AND INSTALL ROOF CURB FOR RTU-3 FOR BASE BID AND ALL ALTERNATES. RTU-6 TO BE INSTALLED ON RTU-3'S ROOF CURB IF ALTERNATE 4 IS TAKEN. PROVIDE AND INSTALL CURB ADAPTER FOR INSTALLATION OF RTU-6 ON RTU-3'S ROOF CURB.

L P K architects

LPK ARCHITECTS, P.A.

Robert E. Luke, Architect

821 22ND AVENUE P.O. BOX 630
MERIDIAN, MISSISSIPP1 330302
P: 601 . 693 . 999 0
F: 601 . 693 . 8640

These documents are the sole property of LPK Architects P.A. and are not to reused. Any alterations, revisions or reuse of these documents without the written consent of LPK Architects P will result in all sureties and responsibilities for the entire project becoming null and void.



Lauderdale County
Public Safety Building

PROJECT ADDRESS:

Village Fair Mall Site 612 22nd Avenue (Winn-Dixie / LabCorp Building)

YATES


ACTIVE DESIGN PHASE

FOR REVIEW ONLY
FOR PERMITTING ONLY
SCHEMATIC DESIGN
DESIGN DEVELOPMENT
CONSTRUCTION BIDDING

CONSTRUCTION DOCUMENTS

AS-BUILT RECORD SET

SEAL

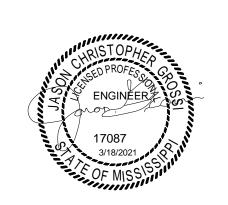

	REVISIONS	S/SUBMISSIONS						
NO. DATE DESCRIPTION								
2	04/30/2021	ADDENDUM :						

ROOF PLAN - HVAC - ALT 4

Engineering
Resource Group

350 Edgewood Terrace Drive
Jackson, MS 39206
Phone: (601) 362-3552
Fax: (601) 366-6418

20.087 PROJECT NO.:

SHEET ISSUED: SHEET NO.

GCC EVIEWED BY:

	~	~	~~~	~~~	~~~	~~~	\\\\\\\\\\\\\\\\\\\\\\\\\\\\\\\\\\\\\\	~		~~~		~	~~~		~		~	~	~~	~~~	\sim	~~	~		~~	~~~		
F	ÖOF	TÓP .	AIR COND	ITIONING U	VIT SCHE	DULE	7		T	T	•	· ·	7	•	•	•		•			,	1		•	1		,	
	F INS	HASE TALLED	TAG	MANUFACTURER & MODEL NO.(TON)	SERVES	REFR TYPE	SUPPLY FAN SUPPLY OA CF CFM MIN M	FM ESP) HP OAT	EDB EWB	COOLING DB CAPACITY (MBH) WB TOTAL SENS	MIN MIN EER IEER	COMPRESSO	OR CONDE	NSER EAT	HEATING ELECTRIC KW STAGES	VOLT/Ø	MCA M	OPE WT IOCP (LBS									
ВЕ	A1 A	2 A3	A4 A5 (RTU)	JOHNSON CONTROLS	S SHERIFF'S DEPARTMEN	S NT R-410A	18,000 2,000 2,	,000 2	15 95.0	77.2	516.9 321.7 56.6	10.8 16.0		215.0 142.0 4	3.4 EA		460/3	119.2	150 7000	HAIL GUARDS, HI FILTERS, BACNET	IGED ACCESS PAI CARD, POWERED	NELS, 14" TAL	L ROOF CURB, CE OUTLET, DI	, VAV CONTRO ISCONNECT, H	OLLER WITH VE HEAD PRESSUF	FD, ECONOMIZER RE CONTROL, FO	(DRY BULB) WITI JR STAGES OF C	H BAROMETRIC RELIEF (LOW-LEAKAGE DAMPER PER ASHRAE 90.1-CURRENT ADDITION), 2" MERV 8 DOLING, FACTORY MOUNTED AIRFLOW MEASURING STATION
ВЕ	A1 A	2 A3	A4 A5 (RTU)	JOHNSON CONTROLS AD15C0DK4	DRUG TESTING	R-410A	6,000 600 6	600 1.5	5.25 95.0	77.0	66.2 44.7 134.7 124.2	11.0 14.6	1@ 12.0 1@ 12.2	94.0 100.0 2	1.0 EA		460/3	43.5	50 2200	HAIL GUARDS, HI FILTERS, BACNET	IGED ACCESS PAI CARD, POWERED	NELS, 14" TAL	L ROOF CURB, CE OUTLET, DI	, VAV CONTRO ISCONNECT, H	OLLER WITH VE	FD, ECONOMIZER RE CONTROL, FO	(DRY BULB) WITI JR STAGES OF C	H BAROMETRIC RELIEF (LOW-LEAKAGE DAMPER PER ASHRAE 90.1-CURRENT ADDITION), 2" MERV 8 DOLING, FACTORY MOUNTED AIRFLOW MEASURING STATION
BE	A1 A	2 A3	A4 A5 (RTU)	JOHNSON CONTROLS	LEMA	R-410A	10,000 1000 1	000 2	10 95.0	77.0	9.0 205.0 163.8	11 14.2	1@ 19.2 2@ 10.6	147.0 75.0 4	1.3 EA		460/3	73.4	90 2600	HAIL GUARDS, HI (LOW-LEAKAGE D MOUNTED AIRFLO	IGED ACCESS PAI AMPER PER ASHR	AE 90.1-CURF		(ALLED FOR BASI IET CARD, POWE		
			A4 RTU	JOHNSON CONTROLS ZR049	TRAINING ROOM 331	R-410A	1,400 200 2	200 1.5	1.5 95.0	77.9	i3.4 44.7 33.6	12.1			60	15 2	460/3	32	35 1500	HAIL GUARDS, HI	IGED ACCESS PAI	NELS, 14" TAL						EAKAGE DAMPER PER ASHRAE 90.1-CURRENT ADDITION), 2" MERV 8 FILTERS, BACNET CARD, TED AIRFLOW MEASURING STATION
			A4 RTU	JOHNSON CONTROLS ZR049	TRAINING ROOM 331	R-410A	1,400 200 2	200 1.5	1.5 95.0	77.9	33.4 44.7 33.6	12.1			60	15 2	460/3	32	35 1500									EAKAGE DAMPER PER ASHRAE 90.1-CURRENT ADDITION), 2" MERV 8 FILTERS, BACNET CARD, TED AIRFLOW MEASURING STATION
			A4 RTU	JOHNSON CONTROLS ZR120	E-911 OFFICE, SER	VER R-410A	3,500 400 4	400 1.5	3 95.0	77.3	64.1 107 79	11.2 12.9			60	36 2	460/3	63.2	70 1500	HAIL GUARDS, HI	IGED ACCESS PAI	NELS, CURB A	DAPTOR (CUR	RB TO BE FULL	SIZE OF RTU-	3), ECONOMIZER	(DRY BULB) WITH	I BAROMETRIC RELIEF (LOW-LEAKAGE DAMPER PER ASHRAE 90.1-CURRENT ADDITION), 2" MERV 8 OLING, FACTORY MOUNTED AIRFLOW MEASURING STATION
				2.11.20	305 & 320					64.1	2.9									TIETERO, BRONE	0,1112,1 01121122	OOMEMEN			ILAB I NEGOCI	KE GOTTINGE, TW	0 01/1020 01 00	SEING, THOTOICH MOORITED FILLS CONTINUED OF THOSE
V	ARIA	BLE	AIR VOLUI			CHEDULE (E 1-5)						VAF	RIABL	E AIR	VOLU	ME TERMIN			ULE (C	ONT'D)				
		HASE TALLED	TAG	MANUFACTURER AND MODEL NO	INLET DESIGNAX	MIN TOTAL M DP	AX F IC CONTROL C	HEATING CFM EA		VOLT-Ø	REMARKS						PHAS	SE LED	TAG	MANUFACTURE AND MODEL NO	R INLET DESI SIZE MAX		TOTAL MAX DP NC	CONTROL	HEATING L CFM E	COIL AT LAT K	VOLT-Ø	REMARKS
			A4 A5 (T-1.01)	PRICE SDV5	6 200	30 0.04	17 SCR	120 55	5 90.0 1.3 5 90.0 1.3	277-1 277-1	SINGLE DUCT WITH ELECT 24 VAC CONTROL TRANSF SINGLE DUCT WITH ELECT	RMER, SCR C	ONTROLLER					A3 A4 A		PRICE SDV5	10 1080	170	0.01 17	SCR	650 5	55 90.0 7.2	2 480-3	SINGLE DUCT WITH ELECTRIC HEATING COIL, DISCONNET, FLOW RING, 24 VAC CONTROL TRANSFORMER, SCR CONTROLLER SINGLE DUCT WITH ELECTRIC HEATING COIL, DISCONNET, FLOW RING,
			A4 A5 (T-1.02) A4 A5 (T-1.03)	PRICE SDV5	6 200 10 1100	30 0.04 7 170 0.01		120 55 660 55		480-3	24 VAC CONTROL TRANSF SINGLE DUCT WITH ELECT 24 VAC CONTROL TRANSF	RMER, SCR C	ONTROLLER COIL, DISCONNE	· · · · · · · · · · · · · · · · · · ·					A5 (T-2.02) A5 (T-2.03)	PRICE SDV5 PRICE SDV5	12 1200 8 500		0.01 17 0.01 17	SCR SCR	720 5 330 5	70 00.0		24 VAC CONTROL TRANSFORMER, SCR CONTROLLER SINGLE DUCT WITH ELECTRIC HEATING COIL, DISCONNET, FLOW RING, 24 VAC CONTROL TRANSFORMER, SCR CONTROLLER
BE	A1 A	2 A3	A4 A5 (T-1.04)	PRICE SDV5	6 300	50 0.08	17 SCR	180 55	5 90.0 2.0	480-3	SINGLE DUCT WITH ELECT 24 VAC CONTROL TRANSF	RIC HEATING O	OIL, DISCONNE ONTROLLER	,		вв А	1 A2 A	A3 A4 A	A5 (T-2.04)	PRICE SDV5	6 300	50	0.08 17	SCR	180 5	55 90.0 2.0) 480-3	SINGLE DUCT WITH ELECTRIC HEATING COIL, DISCONNET, FLOW RING, 24 VAC CONTROL TRANSFORMER, SCR CONTROLLER
			A4 A5 (T-1.05)	PRICE SDV5	10 900	140 0.01		540 55	5 90.0 6.0	480-3	SINGLE DUCT WITH ELECT 24 VAC CONTROL TRANSF SINGLE DUCT WITH ELECT	RMER, SCR C	ONTROLLER						A5 (T-2.05)	PRICE SDV5	6 350		0.11 17	SCR	210 5	55 90.0 2.3	3 480-3	SINGLE DUCT WITH ELECTRIC HEATING COIL, DISCONNET, FLOW RING, 24 VAC CONTROL TRANSFORMER, SCR CONTROLLER SINGLE DUCT WITH ELECTRIC HEATING COIL, DISCONNET, FLOW RING,
			A4 A5 (T-1.06) A4 A5 (T-1.07)	PRICE SDV5 PRICE SDV5	10 730 6 200	30 0.04		440 55 120 55	5 90.0 4.9 5 90.0 1.3	480-3 277-1	24 VAC CONTROL TRANSF SINGLE DUCT WITH ELECT	RMER, SCR C	ONTROLLER COIL, DISCONNE	· · · · · · · · · · · · · · · · · · ·					A5 (T-2.06) A5 (T-2.07)	PRICE SDV5 PRICE SDV5	6 200 10 650		0.04 17 0.01 17	SCR	120 5 390 5	55 90.0 1.3 55 90.0 4.3	3 277-1 3 480-3	24 VAC CONTROL TRANSFORMER, SCR CONTROLLER SINGLE DUCT WITH ELECTRIC HEATING COIL, DISCONNET, FLOW RING,
			A4 A5 (T-1.08)	PRICE SDV5	8 450	70 0.01		270 55	5 90.0 3.0	480-3	24 VAC CONTROL TRANSF SINGLE DUCT WITH ELECT 24 VAC CONTROL TRANSF	RIC HEATING C	OIL, DISCONNE	ET, FLOW RING,					A5 (T-2.08)	PRICE SDV5	6 300		0.10 17	SCR	200 5	55 90.0 2.2	2 480-3	24 VAC CONTROL TRANSFORMER, SCR CONTROLLER SINGLE DUCT WITH ELECTRIC HEATING COIL, DISCONNET, FLOW RING, 24 VAC CONTROL TRANSFORMER, SCR CONTROLLER
BE	A1 A	2 A3	A4 A5 (T-1.09)	PRICE SDV5	10 650	100 0.01	17 SCR	390 55	5 90.0 4.3	480-3	SINGLE DUCT WITH ELECT 24 VAC CONTROL TRANSF	RMER, SCR C	ONTROLLER	,				A3 A4 A	A5 (T-2.09)	PRICE SDV5	8 400	60	0.01 17	SCR	240 5	55 90.0 2.7	480-3	SINGLE DUCT WITH ELECTRIC HEATING COIL, DISCONNET, FLOW RING, 24 VAC CONTROL TRANSFORMER, SCR CONTROLLER
			A4 A5 (T-1.10) A4 A5 (T-1.11)	PRICE SDV5	8 500 8 450	80 0.01 450 0.01		300 55 450 55		480-3 480-3	SINGLE DUCT WITH ELECT 24 VAC CONTROL TRANSF SINGLE DUCT WITH ELECT	RMER, SCR C	ONTROLLER	, , , , , , , , , , , , , , , , , , ,					A5 (T-2.10)		8 600 6 300		0.01 17 0.08 17	SCR SCR		55 90.0 4.0 55 90.0 2.0		SINGLE DUCT WITH ELECTRIC HEATING COIL, DISCONNET, FLOW RING, 24 VAC CONTROL TRANSFORMER, SCR CONTROLLER SINGLE DUCT WITH ELECTRIC HEATING COIL, DISCONNET, FLOW RING,
			A4 A5 (T-1.12)	PRICE SDV5	6 300	50 0.08		180 55		480-3	24 VAC CONTROL TRANSF SINGLE DUCT WITH ELECT 24 VAC CONTROL TRANSF	RIC HEATING C	OIL, DISCONNE	ET, FLOW RING,				A3 A4 A A3 A4 A	A5 (T-2.11) A5 (T-2.12)	PRICE SDV5 PRICE SDV5	6 330		0.10 17	SCR	100	55 90.0 2.0 55 90.0 2.2		24 VAC CONTROL TRANSFORMER, SCR CONTROLLER SINGLE DUCT WITH ELECTRIC HEATING COIL, DISCONNET, FLOW RING, 24 VAC CONTROL TRANSFORMER, SCR CONTROLLER
BE	A1 A	2 A3	A4 A5 (T-1.13)	PRICE SDV5	10 850	130 0.01	17 SCR	510 55	5 90.0 5.6	480-3	SINGLE DUCT WITH ELECT 24 VAC CONTROL TRANSF	RIC HEATING O	OIL, DISCONNE ONTROLLER															
			A4 A5 (T-1.14)	PRICE SDV5	8 500	80 0.01		300 55	5 90.0 3.3	480-3	SINGLE DUCT WITH ELECT 24 VAC CONTROL TRANSF SINGLE DUCT WITH ELECT	RMER, SCR C	ONTROLLER				1 A2 A		A5 (T-3.01)	PRICE SDV5	6 150		0.02 17	SCR	90 5		277-1	SINGLE DUCT WITH ELECTRIC HEATING COIL, DISCONNET, FLOW RING, 24 VAC CONTROL TRANSFORMER, SCR CONTROLLER SINGLE DUCT WITH ELECTRIC HEATING COIL, DISCONNET, FLOW RING,
			A4 A5 (T-1.15) A4 A5 (T-1.16)	PRICE SDV5	6 250 8 550	90 0.01		330 55	3 00.0 1.7	480-3 480-3	24 VAC CONTROL TRANSF SINGLE DUCT WITH ELECT 24 VAC CONTROL TRANSF	RMER, SCR C	ONTROLLER COIL, DISCONNE				1 A2 A		A5 (T-3.02) A5 (T-3.03)	PRICE SDV5 PRICE SDV5	6 150 14 1250		0.02 17 0.01 17	SCR	750 5	55 90.0 1.0 55 90.0 8.2	2 480-3	24 VAC CONTROL TRANSFORMER, SCR CONTROLLER SINGLE DUCT WITH ELECTRIC HEATING COIL, DISCONNET, FLOW RING, 24 VAC CONTROL TRANSFORMER, SCR CONTROLLER
BE	A1 A	2 A3	A4 A5 (T-1.17)	PRICE SDV5	8 400	60 0.01	17 SCR	240 55	5 90.0 2.7	480-3	SINGLE DUCT WITH ELECT 24 VAC CONTROL TRANSF	RIC HEATING C	OIL, DISCONNE	ET, FLOW RING,			1 A2 A		A5 (T-3.04)	PRICE SDV5	14 1350	210	0.01 17	SCR	810 5	55 90.0 9.0) 480-3	SINGLE DUCT WITH ELECTRIC HEATING COIL, DISCONNET, FLOW RING, 24 VAC CONTROL TRANSFORMER, SCR CONTROLLER
			A4 A5 (T-1.18)	PRICE SDV5	10 600	90 0.01		360 55	5 90.0 4.0	480-3	SINGLE DUCT WITH ELECT 24 VAC CONTROL TRANSF SINGLE DUCT WITH ELECT	RMER, SCR C	ONTROLLER				1 A2 A		A5 (T-3.05)	PRICE SDV5	12 1200		0.01 17	SCR		55 90.0 8.0) 480-3	SINGLE DUCT WITH ELECTRIC HEATING COIL, DISCONNET, FLOW RING, 24 VAC CONTROL TRANSFORMER, SCR CONTROLLER
			A4 A5 (T-1.19) A4 A5 (T-1.20)		8 450 8 450	70 0.01		270 55 270 55	5 90.0 3.0 5 90.0 3.0	480-3 480-3	24 VAC CONTROL TRANSF SINGLE DUCT WITH ELECT	RMER, SCR C	ONTROLLER COIL, DISCONNE				1 A2 A		A5 (T-3.06) A5 (T-3.07)	PRICE SDV5 PRICE SDV5	6 350 6 200		0.11 17 0.04 17	SCR SCR		90.0 90.0 90.0 90.0 1.3		SINGLE DUCT WITH ELECTRIC HEATING COIL, DISCONNET, FLOW RING, 24 VAC CONTROL TRANSFORMER, SCR CONTROLLER SINGLE DUCT WITH ELECTRIC HEATING COIL, DISCONNET, FLOW RING,
			A4 A5 (T-1.21)	PRICE SDV5	6 300	50 0.08		180 55		480-3	24 VAC CONTROL TRANSF SINGLE DUCT WITH ELECT 24 VAC CONTROL TRANSF	RIC HEATING C	COIL, DISCONNE	ET, FLOW RING,			1 A2 A		A5 (T-3.08)		6 350		0.11 17	SCR	210 5	55 90.0 2.3	3 480-3	24 VAC CONTROL TRANSFORMER, SCR CONTROLLER SINGLE DUCT WITH ELECTRIC HEATING COIL, DISCONNET, FLOW RING, 24 VAC CONTROL TRANSFORMER, SCR CONTROLLER
			A4 A5 (T-1.22)	PRICE SDV5	10 700	110 0.01		420 55	5 90.0 4.7	480-3	SINGLE DUCT WITH ELECT 24 VAC CONTROL TRANSF SINGLE DUCT WITH ELECT	RMER, SCR C	ONTROLLER			вв А	1 A2 A	A3 A	A5 (T-3.09)	PRICE SDV5	6 150	30	0.02 17	SCR	90 5	55 90.0 1.0	277-1	SINGLE DUCT WITH ELECTRIC HEATING COIL, DISCONNET, FLOW RING, 24 VAC CONTROL TRANSFORMER, SCR CONTROLLER
			A4 A5 (T-1.23) A4 A5 (T-1.24)	PRICE SDV5	10 750 8 550	750 0.01 7 90 0.01		750 55 330 55	5 90.0 8.3 5 90.0 3.7	480-3 480-3	24 VAC CONTROL TRANSF SINGLE DUCT WITH ELECT	RMER, SCR C	ONTROLLER COIL, DISCONNE	,			1 A2 A 1 A2 A		A5 (T-3.10) A5 (T-3.11)	PRICE SDV5 PRICE SDV5	6 250 6 150		0.06 17 0.02 17	SCR SCR	150 5	55 90.0 1.7 55 90.0 1.0	7 480-3 277-1	SINGLE DUCT WITH ELECTRIC HEATING COIL, DISCONNET, FLOW RING, 24 VAC CONTROL TRANSFORMER, SCR CONTROLLER SINGLE DUCT WITH ELECTRIC HEATING COIL, DISCONNET, FLOW RING,
			A4 A5 (T-1.25)	PRICE SDV5	6 300	50 0.08		180 55	5 90.0 2.0	480-3	24 VAC CONTROL TRANSF SINGLE DUCT WITH ELECT 24 VAC CONTROL TRANSF	RIC HEATING C	OIL, DISCONNE	ET, FLOW RING,			1 A2 A		A5 (T-3.12)		10 700		0.01 17	SCR	420 5	55 90.0 4.7	7 480-3	24 VAC CONTROL TRANSFORMER, SCR CONTROLLER SINGLE DUCT WITH ELECTRIC HEATING COIL, DISCONNET, FLOW RING, 24 VAC CONTROL TRANSFORMER, SCR CONTROLLER
BE	A1 A	2 A3	A4 A5 (T-1.26)	PRICE SDV5	6 150	30 0.02	17 SCR	90 55	5 90.0 1.0	277-1	SINGLE DUCT WITH ELECT 24 VAC CONTROL TRANSF	RMER, SCR C	ONTROLLER	, , , , , , , , , , , , , , , , , , ,		вв А	1 A2 A	A3 A	A5 (T-3.13	PRICE SDV5	6 300	50	0.08 17	SCR	180 5	55 90.0 2.0) 480-3	SINGLE DUCT WITH ELECTRIC HEATING COIL, DISCONNET, FLOW RING, 24 VAC CONTROL TRANSFORMER, SCR CONTROLLER
			A4 A5 (T-1.27) A4 A5 (T-1.28)	PRICE SDV5	6 150 8 400	30 0.02 60 0.01		90 55	5 90.0 1.0 5 90.0 2.7	277-1 480-3	SINGLE DUCT WITH ELECT 24 VAC CONTROL TRANSF SINGLE DUCT WITH ELECT	RMER, SCR C	ONTROLLER COIL, DISCONNE				1 A2 A		A5 (T-3.14) A5 (T-3.15)	PRICE SDV5 PRICE SDV5	6 300 10 1000		0.08 17 0.01 17	SCR SCR	180 5	55 90.0 2.0 55 90.0 6.6	480-3 480-3	SINGLE DUCT WITH ELECTRIC HEATING COIL, DISCONNET, FLOW RING, 24 VAC CONTROL TRANSFORMER, SCR CONTROLLER SINGLE DUCT WITH ELECTRIC HEATING COIL, DISCONNET, FLOW RING,
			A4 A5 (T-1.29)	PRICE SDV5	8 550	90 0.01		330 55		480-3	24 VAC CONTROL TRANSF SINGLE DUCT WITH ELECT 24 VAC CONTROL TRANSF	RIC HEATING C	OIL, DISCONNE	ET, FLOW RING,			1 A2 A		A5 (T-3.16)		8 400		0.01 17	SCR	240 5	55 90.0 2.7	7 480-3	24 VAC CONTROL TRANSFORMER, SCR CONTROLLER SINGLE DUCT WITH ELECTRIC HEATING COIL, DISCONNET, FLOW RING, 24 VAC CONTROL TRANSFORMER, SCR CONTROLLER
ВЕ	A1 A	2 A3	A4 A5 (T-1.30)	PRICE SDV5	8 450	70 0.01	17 SCR	270 55	5 90.0 3.0	480-3	SINGLE DUCT WITH ELECT 24 VAC CONTROL TRANSF	RMER, SCR C	ONTROLLER	, , , , , , , , , , , , , , , , , , ,		вв А	1 A2 A	A3 A	A5 (T-3.17)	PRICE SDV5	10 1000	150	0.01 17	SCR	600 5	55 90.0 6.6	3 480-3	SINGLE DUCT WITH ELECTRIC HEATING COIL, DISCONNET, FLOW RING, 24 VAC CONTROL TRANSFORMER, SCR CONTROLLER
			A4 A5 (T-1.31) A4 A5 (T-1.32)	PRICE SDV5	6 300 6 300	50 0.08		180 55 180 55		480-3 480-3	SINGLE DUCT WITH ELECT 24 VAC CONTROL TRANSF SINGLE DUCT WITH ELECT	RMER, SCR C	ONTROLLER COIL, DISCONNE	, , , , , , , , , , , , , , , , , , ,			1 A2 A		A5 (T-3.18) A5 (T-3.19)	PRICE SDV5	10 690 6 300		0.01 17 0.08 17	SCR SCR	420 5 180 5	55 90.0 4.7 55 90.0 2.0	7 480-3 0 480-3	SINGLE DUCT WITH ELECTRIC HEATING COIL, DISCONNET, FLOW RING, 24 VAC CONTROL TRANSFORMER, SCR CONTROLLER SINGLE DUCT WITH ELECTRIC HEATING COIL, DISCONNET, FLOW RING,
	AI	2 A3	T-1.33	PRICE SDV5	0 300	30 0.06	T/ SGK	160 30	NOT US		24 VAC CONTROL TRANSF	RMER, SCR C	ONTROLLER			- BB A	1 AZ P	43 7	45 (T-3.19)	PRICE SDV5	0 300	30	0.08	SCR	160	90.0 2.0	460-3	24 VAC CONTROL TRANSFORMER, SCR CONTROLLER
			(T-1.34)	•					NOT US	SED —						- DUC	CTLES	SS SP	PLIT-S	STEM HEA	T PUMP -	INDOO	R UNIT					
Dr	Δ1	2 12	\(\sqrt{T-1.35}\) \(\text{A4}\) \(\text{A5}\) \(\sqrt{T-1.36}\)	PRICE SDV5	6 200	30 0.04	17 SCR	120 55	NOT US	277-1	SINGLE DUCT WITH ELECT			ET, FLOW RING.		-	PHAS INSTALI		TAG	MANUFACTURE & MODEL NO	R TYPE	COOLING (MBH)	HEATING (MBH)		MCA MOC	OPER WT RE	MARKS	
			A4 A5 (T-1.36) A4 A5 (T-1.37)	PRICE SDV5 PRICE SDV5	6 200	30 0.04		120 55	5 90.0 1.3 5 90.0 1.3	277-1	24 VAC CONTROL TRANSF SINGLE DUCT WITH ELECT 24 VAC CONTROL TRANSF	RMER, SCR C	ONTROLLER COIL, DISCONNE	· · · · · · · · · · · · · · · · · · ·		ВВ А	1 A2 A	A3 A	A5 DSS 1	LG ARNU363V2A4	CEILING SUSPENDE	36.2	40.6	208-230/1	1.21 15		ALL MOUNTED RI	MOTE CONTROLLER (LG MS8650), INDOOR UNIT REQUIRES SEPARATE POWER CONNECTION
ВЕ	A1 A	2 A3	A4 A5 (T-1.38)	PRICE SDV5	10 1000	150 0.01	17 SCR	600 55	5 90.0 6.6	480-3	SINGLE DUCT WITH ELECT 24 VAC CONTROL TRANSF	RIC HEATING C RMER, SCR C	OIL, DISCONNE ONTROLLER	,		BB A	1 A2 A	A3 A	A5 DSS	LG ARNU363V2A4	CEILING SUSPENDE	26.2	40.6	208-230/1	1.21 15	150 W	ALL MOUNTED RI	MOTE CONTROLLER (LG MS8650), INDOOR UNIT REQUIRES SEPARATE POWER CONNECTION
BE	A1 A	2	A4 A5 (T-1.39)	PRICE SDV5	10 1000	150 0.01	17 SCR	600 55	5 90.0 6.6	480-3	SINGLE DUCT WITH ELECT 24 VAC CONTROL TRANSF	RIC HEATING O RMER, SCR C	OIL, DISCONNE ONTROLLER	ET, FLOW RING,				A3 A4 A	A5 DSS	LG	CEILING	22.0	26.0	208-230/1		40 W	ALL MOUNTED RI	MOTE CONTROLLER (LG MS8650), INDOOR UNIT POWERED FROM OUTDOOR UNIT
			AIF	R DISTRIBU	TION DEV	ICE SCHED	ULE											A3 A4 A	7000	LAN240HYV3	SUSPENDE	22.0	26.0	208-230/1				MOTE CONTROLLER (LG MS8650), INDOOR UNIT POWERED FROM OUTDOOR UNIT
			TAC	G TYPE	MANUFACTI & MODEL	JRER NO. NECK SIZ	E FACE SIZ	ZE RI	EMARKS										DSS\	LAN240HYV3	SUSPENDE	:D						
			А	CEILING MOUNTE SUPPLY AIR DEVI	DE PRICE SI	SCHEDULL BL	SCHEDULE B	BELOW FF	RAME MOUNT (TITUS	S TRM). NECK	DICATED ON PLANS. PROVID BIZE TO BE AS INDICATED O DICATED ON PLANS. PROVID	PLANS OR CO	NNECTION SCH	HEDULE BELOW.	STER	BB A	1 A2 A	A3 A4 A	A5 5	LAN240HYV3	SUSPENDE	22.0	26.0	208-230/1		40 W	ALL MOUNTED RI	MOTE CONTROLLER (LG MS8650), INDOOR UNIT POWERED FROM OUTDOOR UNIT
			В	RETURN AIR DEVI	ED PRICE 8	SCHEDULE BE	S/ SEE PLAN	SELOW W	ITH SCREW HOLES. ACE SIZE TO BE NEC	NECK SIZE TO CK SIZE PLUS 2	BE AS INDICATED ON PLAN ". PROVIDE WITH TYPE "A" E	OR CONNECT	TION SCHEDULE EW. NECK SIZE	TO BE AS		DUC	CTLES	SS SP	PLIT-SY	STEM HEA	T PUMP -	OUTDO	OOR UN	NIT SCH	IEDULE			
			D	SUPPLY AIR DEVI	ED PRICE 52	SCHEDULE BE	S/ SEE PLAN	NS/ FA	ACE SIZE TO BE NEC	CK SIZE PLUS	ION SCHEDULE BELOW. PR ". PROVIDE WITH TYPE "A" E ION SCHEDULE BELOW. PRO	TERNAL SCR	W. NECK SIZE	TO BE AS		-	PHAS INSTALI		TAG	MANUFACTURE & MODEL NO	R NOM RE	FR COOL	CAPACIT	, ,	ELECTR	SEE	OPEF R HSPF WT	REMARKS
			Е	CEILING MOUNTE EXHAUST AIR DEV	D PRIOR O	CEE DI ANI	S/ SEE PLAN	NS/ FA	ACE SIZE TO BE NEC	CK SIZE PLUS 2	". PROVIDE SURFACE MOUN ATED ON PLANS OR CONNE	WITH TYPE "/	\" EXTERNAL	2= DAIVIII ET		DD A	1 A2 A		A5 CU	LG	0.0 44	95.0	COOLING 38.0		MCA MOCP	VOLT/PH 208-230/1 17.0	9.0 250	INVERTER COMPRESSOR, LOW AMBIENT KIT TO ALLOW COOLING DOWN TO 0 DEG F
			F	DUCT MOUNTED SUPPLY AIR DEVI	E PRICE SD		18x8		ROVIDE WITH TYPE "	"A" EXTERNAL	SCREW. PROVIDE WITH OPI	OSED BLADE \	OLUME DAMPE	ER.					A5 1 CU	ARUN038GSS	0.0	47.0 95.0						
		G CEILING MOUNTED PRICE MSRRCD 12x12 14x14 H CEILING MOUNTED PRICE MSRRCD 12x12 16x16						1 A2 A		A5 <u>2</u>	ARUN038GSS		0A 47.0 95.0	38.0			208-230/1 17.0											
			NOTE:	EXHAUST AIR DEV S:	CE MSRRG	3 14X14	100010				AIR D	VICE CONNEC	CTION SCHEDUL	LE		BB A	1 A2 A	A3 A4 A	A5 3	LG LAU240HYV3	2.0 41	0A 47.0 95.0	22.0	26.0	19 30	208-230/1 22.5	12.5 150	INVERTER COMPRESSOR, LOW AMBIENT KIT TO ALLOW COOLING DOWN TO 0 DEG F
				SHADING ON PLANS.		OTHERWISE NOTED BY				AID OUANT				BRANCH DUC	CT SIZE	BB A	1 A2 A	A3 A4 A	A5 CU 4	LG LAU240HYV3	2.0 41	0A 47.0	22.0	26.0	19 30	208-230/1 22.5	12.5 150	INVERTER COMPRESSOR, LOW AMBIENT KIT TO ALLOW COOLING DOWN TO 0 DEG F
			3.	CONSTRUCTION DETAI AIR DEVICE FRAME AN	LS. D STYLE SHALL MA					AIR QUANTII (CFM)	Y CEILING MOUNTED SI NECK SIZE	EWALL MOUN NECK SIZE		OUND R	ALTERNATE ECTANGULAR DU		1 A2 A	A3 A4 A	A5 CU 5	LG LAU240HYV3	2.0 41	0A 95.0 47.0	22.0	26.0	19 30	208-230/1 22.5	12.5 150	INVERTER COMPRESSOR, LOW AMBIENT KIT TO ALLOW COOLING DOWN TO 0 DEG F
,			4.	REFER TO ARCHITECT FACE SIZE TO BE NECK	FOR FINISHES AN					0-100	6"Ø	8x4"	(6"Ø	8x4"		CHEN	1 E∪I i		IT HOOD SO	HEDIII E							June
										101-200	8"Ø	10x6"		8"Ø	10x6"		~:: □!\	& U	IVILL									

201-350

351-600

601-850

851-1200

10"Ø

12"Ø

14"Ø

16"Ø

14x10"

16x12"

18x16"

10"Ø

12"Ø

14"Ø

16"Ø

12x8"

16x12"

PHASE

INSTALLED

& MODEL NO.

DENLAR

1 D1030-D-RF_(NFPA101) EXHAUSTED

D1030-D-RF_(NFPA101) EXHAUSTED

& POSITION

MANUFACTURER CONFIGURATION OF DIMENSIONS (OVERALL) GREASE UL TEMP TOTAL EXHAUST

| SECTIONS | LENGTH | WIDTH | HEIGHT | POSITION | (°F) | (CFM)

30" 19" 10.5" LEFT

architects

LPK ARCHITECTS, P.A.

Robert E. Luke, Architect

821 22ND AVENUE P.O. BOX 630
MERIDIAN, MISSISSIPP 1 39002
P: 601.693.8940
F: 601.693.8640

These documents are the sole property of LPK Architects P.A. and are not to reused. Any alterations, revisions or reuse of these documents without the written consent of LPK Architects P.A. will result in all sureties and responsibilities for the entire project becoming null and void. PROJECT INFORMATION



Lauderdale County Public Safety Building

PROJECT ADDRESS:


Village Fair Mall Site 612 22nd Avenue (Winn-Dixie / LabCorp Building)



ACTIVE DESIGN PHASE

FOR REVIEW ONLY FOR PERMITTING ONLY SCHEMATIC DESIGN DESIGN DEVELOPMENT CONSTRUCTION BIDDING CONSTRUCTION DOCUMENTS

AS-BUILT RECORD SET

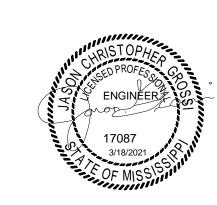

REVISIONS/SUBMISSIONS						
NO.	DATE	DESCRIPTION				
1	04/26/2021	ADDENDUM #2				
2	04/30/2021	ADDENDUM #3				

HVAC SCHEDULES

20.087 PROJECT NO.: 19-4894B SHEET ISSUED: SHEET NO.

REVIEWED BY:

350 Edgewood Terrace Drive Jackson, MS 39206 Phone: (601) 362-3552 Fax: (601) 366-6418

MANUAL PULL STATION KIT, ADA ACCESSIBLE CONTROL

MANUAL PULL STATION KIT, ADA ACCESSIBLE CONTROL

BOX, CLOCK BOX W/KEY-LOCK, 60W SHATTER PROOF

BOX, CLOCK BOX W/KEY-LOCK, 60W SHATTER PROOF

BULB, AUTO DISCONNECT RANGE ELEMENT KIT

BULB, AUTO DISCONNECT RANGE ELEMENT KIT

POWER VENTILATOR SCHEDULE	ELECTRIC UNIT HEATER SCHEDULE
PHASE INSTALLED TAG MANUFACTURER AND MODEL NO. TYPE CFM ESP RPM SOUND (dBA/SONES) ELECTRICAL BHP HP V/Ø ON/OFF INTERLOCK REMARKS	PHASE INSTALLED TAG MANUFACTURER AND MODEL NO. SERVES TYPE ELECTRICAL KW - V - Ø CFM REMARKS
BB A1 A2 A3 A4 A5 GREENHECK SP-A390-VG MOUNTED 150 0.375 1080 3.4 - 23W 115/1 WALL SWITCH NONE PRE-WIRED DISCONNECT, ECM MOTOR W/ DIAL, BACKDRAFT DAMPER, ISOLATOR KIT, WHITE ALUMINUM GRILLE	BB A1 A3 A4 A5 EUH MARKEL P3P5105CA1N VFD/LEMA STORAGE 335 VFD/LEMA STORAGE 335 VFD/LEMA STORAGE 335 STO
BB A1 A2 A3 A4 A5 G-090-VG ROOF MOUNTED 550 0.375 1543 0.5 6.1W 115/1 BMS NONE PRE-WIRED DISCONNECT, ECM MOTOR W/ DIAL, GALVANIZED BIRD SCREEN, COMPOSITE WHEEL MATERIAL, ROOF CURB, 24 HOURS / SEVEN DAYS A WEEK NORMAL OPERATION	BB A1 A3 A4 A5 EUH A3 A4 A5 FAN FORCED WALL HEATER 5-480-3 400 MOUNT 9'FT HIGH WITH WALL MOUNTING BRACKET, IN-BUILT THERMOSTAT AND INTEGRAL DISCONNECT
BB A1 A2 A3 A4 A5 FF GREENHECK SP-110-VG MOUNTED 100 0.375 936 2.5 8W 115/1 WALL SWITCH NONE PRE-WIRED DISCONNECT, ECM MOTOR W/ DIAL, BACKDRAFT DAMPER, ISOLATOR KIT, WHITE ALUMINUM GRILLE	BB A1 A3 A4 A5 EUH BB A1 A3 A4 A5 EUH BB A1 A5 EUH BB A1 A5 EUH BB A1 BB A1 A5 EUH BB A1 A5 EUH BB A1 A5 EUH BB A1 BB A1 BB A1 A5 BB
BB A1 A2 A3 A4 A5 FF GREENHECK SP-A390-VG MOUNTED 150 0.375 1080 3.4 - 23W 115/1 MOTION DETECTOR NONE PRE-WIRED DISCONNECT, ECM MOTOR W/ DIAL, BACKDRAFT DAMPER, ISOLATOR KIT, WHITE ALUMINUM GRILLE	BB A1 A2 A3 A4 A5 EUH MARKEL SALLYPORT 275 FAN FORCED 5- 480 - 3 400 THERMOSTAT AND INTEGRAL DISCONNECT
BB A1 A2 A3 A4 A5 EF GREENHECK CEILING 150 0.375 1090 3.4 33W 115/1 MOTION NONE PRE-WIRED DISCONNECT ECM MOTOR W/ DIAL BACKDRAFT DAMPER ISOLATOR KIT WHITE ALUMINUM GRILLE	WALL HEATER 51000 SERIES 5AN FORDER 5 400 0 MOUNT 9'FT HIGH WITH WALL MOUNTING BRACKET, IN-BUILT
EF CREENING CELLING	WALL HEATER MARKEL MOUNT 9'FT HIGH WITH WALL MOUNTING BRACKET, IN-BUILT
	BB A1 A2 A3 A4 A5 6 P3P5105CA1N SALLYPORT 275 FAN FORCED WALL HEATER 5-480-3 THERMOSTAT AND INTEGRAL DISCONNECT
SP-A390-VG MOUNTED 130 0.373 1000 3.4 25W 1131 DETECTOR 1300 3.4	
BB A1 A2 A3 A4 A5 GREENHECK SP-80-VG MOUNTED 50 0.375 786 1.4 6W 115/1 MOTION DETECTOR NONE PRE-WIRED DISCONNECT, ECM MOTOR W/ DIAL, BACKDRAFT DAMPER, ISOLATOR KIT	WALL LOUVER SCHEDULE
BB A1 A2 A3 A4 A5 GREENHECK SP-80-VG GREENHECK SP-80-VG MOUNTED 50 0.375 786 1.4 6W 115/1 MOTION DETECTOR NONE PRE-WIRED DISCONNECT, ECM MOTOR W/ DIAL, BACKDRAFT DAMPER, ISOLATOR KIT	PHASE INSTALLED TAG MANUFACTURER & MODEL NO. FUNCTION CFM MIN NET FREE AREA (SQFT) OVERALL SIZE (L X H) DEPTH MAX PD (IN.W.G.) REMARKS
BB A1 A2 A3 A4 A5 GREENHECK SP-80-VG GREENHECK SP-8	BB A1 A2 A3 A4 A5 CV GREENHECK EHH-601 EXHAUST AIR EF-3,4 & 5 400 0.56 14x17 6 0.1 FLUOROPOLYMER FINISH IN COLOR SELECTED BY ARCHITECT, ALUMINUM BIRDSCREEN
BB A1 A2 A3 A4 A5 GREENHECK SP-80-VG CEILING MOUNTED 50 0.375 786 1.4 - 6W 115/1 MOTION DETECTOR NONE PRE-WIRED DISCONNECT, ECM MOTOR W/ DIAL, BACKDRAFT DAMPER, ISOLATOR KIT	
BB A1 A2 A3 A4 A5 FF GREENHECK SP-80-VG MOUNTED 50 0.375 786 1.4 6W 115/1 MOTION DETECTOR NONE PRE-WIRED DISCONNECT, ECM MOTOR W/ DIAL, BACKDRAFT DAMPER, ISOLATOR KIT	ROOF EXHAUST/INTAKE CAP SCHEDULE
BB A1 A2 A3 A4 A5 FF GREENHECK SP-80-VG MOUNTED 50 0.375 786 1.4 6W 115/1 MOTION DETECTOR NONE PRE-WIRED DISCONNECT, ECM MOTOR W/ DIAL, BACKDRAFT DAMPER, ISOLATOR KIT	PHASE INSTALLED TAG MANUFACTURER AND MODEL NO. FUNCTION CFM DROP, IN W.C. THROAT SIZE, INCHES REMARKS
BB A1 A2 A3 A4 A5 FF GREENHECK SP-110-VG MOUNTED 100 0.375 936 2.5 8W 115/1 WALL SWITCH NONE PRE-WIRED DISCONNECT, ECM MOTOR W/ DIAL, BACKDRAFT DAMPER, ISOLATOR KIT, WHITE ALUMINUM GRILLE	BB A1 A2 A3 A5 GREENHECK GRSR-12 EXHAUST AIR 360 0.03 439 12.25 PROVIDE ROOF CURB TO MATCH ROOF SLOPE, BACKDRAFT DAMPER, ALUMINUM BIRDSCREEN
BB A1 A2 A3 A4 A5 FF GREENHECK CEILING 50 0.375 786 1.4 6W 115/1 MOTION NONE PRE-WIRED DISCONNECT, ECM MOTOR W/ DIAL, BACKDRAFT DAMPER, ISOLATOR KIT	BB A1 A2 A3 A4 A5 RC GRENHECK GRSR-10 EXHAUST AIR 250 0.03 439 10.25 PROVIDE ROOF CURB TO MATCH ROOF SLOPE, BACKDRAFT DAMPER, ALUMINUM BIRDSCREEN
BB A1 A2 A3 A4 A5 EF GREENHECK CEILING 50 0.375 786 1.4 55 6W 115/1 MOTION NONE PRE-WIRED DISCONNECT ECM MOTOR W/ DIAL BACKDRAFT DAMPER ISOLATOR KIT	DR A4 A2 A2 A4 A5 RC GREENHECK EXHAUST 250 A20 A20 PROVIDE ROOF CURB TO MATCH ROOF SLOPE,
SP-80-VG MOUNTED 50 0.375 786 1.4 6W 113/1 DETECTOR NONE PRE-WIRED DISCONNECT, ECWINIOTOR WIDIAL, BACKDRAIT BAWIFER, ISOLATOR RIT	BROWN AND AND AND AND AND AND AND AND AND AN
SP-80-VG MOUNTED 50 0.375 786 1.4 6W 113/1 DETECTOR NONE PRE-WIRED DISCONNECT, ECWINIOTOR WIDIAL, BACKDRAIT BAWIFER, ISOLATOR RIT	BACKDRAFT DAIWIPER, ALUMINOW BIRDSCREEN PC CREENUISCK INTAKE
BB A1 A2 A3 A5 GREENHECK SP-110-VG MOUNTED 100 0.375 936 2.5 8W 115/1 WALL SWITCH NONE PRE-WIRED DISCONNECT, ECM MOTOR W/ DIAL, BACKDRAFT DAMPER, ISOLATOR KIT, WHITE ALUMINUM GRILLE	BB AT AZ A3 A4 A5 5 FGR-22x22 AIR 2000 0.05 595 22x22 BACKDRAFT DAMPER, ALUMINUM BIRDSCREEN
BB A1 A2 A3 A5 GREENHECK SP-A390-VG MOUNTED 150 0.375 1080 3.4 - 23W 115/1 MOTION DETECTOR NONE PRE-WIRED DISCONNECT, ECM MOTOR W/ DIAL, BACKDRAFT DAMPER, ISOLATOR KIT, WHITE ALUMINUM GRILLE	BB AT A3 A4 A5 6 FGR-18x18 AIR 1300 0.05 578 BACKDRAFT DAMPER, ALUMINUM BIRDSCREEN
BB A1 A2 A3 A5 GREENHECK SP-A390-VG GREENHECK SP-A390-VG MOUNTED 150 0.375 1080 3.4 - 23W 115/1 MOTION DETECTOR NONE PRE-WIRED DISCONNECT, ECM MOTOR W/ DIAL, BACKDRAFT DAMPER, ISOLATOR KIT, WHITE ALUMINUM GRILLE	BB A1 A3 A4 A5 GREENHECK GRSR-12 EXHAUST AIR 500 0.06 671 12.25 PROVIDE ROOF CURB TO MATCH ROOF SLOPE, BACKDRAFT DAMPER, ALUMINUM BIRDSCREEN
BB A1 A2 A3 A4 A5 G-180-VG ROOF MOUNTED 2000 0.25 634 6.9 0.75 115/1 TSTAT/ GD-1 PRE-WIRED DISCONNECT, ECM MOTOR W/ DIAL, GALVANIZED BIRD SCREEN, COMPOSITE WHEEL MATERIAL, ROOF CURB	menument with the menument
BB A1 A3 A4 A5 GREENHECK G-140-VG ROOF MOUNTED 1300 0.25 860 6.9 0.25 115/1 TSTAT/ GD-2 PRE-WIRED DISCONNECT, ECM MOTOR W/ DIAL, GALVANIZED BIRD SCREEN, COMPOSITE WHEEL MATERIAL, ROOF CURB	
BB A1 A3 A4 A5 GREENHECK G-095-VG ROOF MOUNTED 400 0.35 1200 5.6 0.05 115/1 TSTAT MD-3 PRE-WIRED DISCONNECT, ECM MOTOR W/ DIAL, GALVANIZED BIRD SCREEN, COMPOSITE WHEEL MATERIAL, ROOF CURB	
BB A1 A3 A4 A5 FF GREENHECK G-099-VG MOUNTED 500 0.35 1042 6.0 0.06 115/1 TSTAT MD-4 PRE-WIRED DISCONNECT, ECM MOTOR W/ DIAL, GALVANIZED BIRD SCREEN, COMPOSITE WHEEL MATERIAL, ROOF CURB	
BB A1 A2 A3 A4 A5 FF GREENHECK G-095-VG MOUNTED 400 0.35 1200 5.6 0.05 115/1 TSTAT NONE PRE-WIRED DISCONNECT, ECM MOTOR W/ DIAL, GALVANIZED BIRD SCREEN, COMPOSITE WHEEL MATERIAL, ROOF CURB	
BB A1 A2 A3 A4 A5 F G-095-VG ROOF MOUNTED 400 0.35 1200 5.6 0.05 115/1 TSTAT NONE PRE-WIRED DISCONNECT, ECM MOTOR W/ DIAL, GALVANIZED BIRD SCREEN, COMPOSITE WHEEL MATERIAL, ROOF CURB	
PR A1 A2 A2 A4 A5 F GREENHECK ROOF 1000 0.25 1072 7.2 0.12 1/4 115/4 TSTAT NONE PRE-WIRED DISCONNECT ECM MOTOR W/ DIAL GALVANIZED RIPD SCREEN COMPOSITE WHEEL MATERIAL POOF CLIRR	\downarrow
BB AT AZ AS A4 AS SP-110-VG MOUNTED 100 0.373 930 2.5 110-VG MOUNTED 100 0.373 930 2.5	
BB AT AZ AS A4 AS 29 SP-110-VG MOUNTED 100 0.375 930 2.5 8W T13/T DETECTOR NONE PRE-WIRED DISCONNECT, ECW MOTOR W/ DIAL, BACKDRAFT BAWFER, ISOLATOR RIT, WHITE ALCOWING WIRED	
BB A1 A2 A3 A4 A5 GREENHECK SP-110-VG MOUNTED 100 0.375 936 2.5 8W 115/1 MOTION DETECTOR NONE PRE-WIRED DISCONNECT, ECM MOTOR W/ DIAL, BACKDRAFT DAMPER, ISOLATOR KIT, WHITE ALUMINUM GRILLE	
BB A1 A2 A3 A4 A5 GREENHECK SP-110-VG MOUNTED 100 0.375 936 2.5 8W 115/1 MOTION DETECTOR NONE PRE-WIRED DISCONNECT, ECM MOTOR W/ DIAL, BACKDRAFT DAMPER, ISOLATOR KIT, WHITE ALUMINUM GRILLE	
BB A1 A2 A3 A4 A5 GREENHECK SP-A510-VG GREENHECK SP	\downarrow
BB A1 A2 A3 A4 A5 GREENHECK SP-A390-VG CEILING MOUNTED 200 0.25 971 2.0 24W 115/1 TSTAT NONE PRE-WIRED DISCONNECT, ECM MOTOR W/DIAL, BACKDRAFT DAMPER, ISOLATOR KIT, WHITE ALUMINUM GRILLE	
BB A1 A2 A3 A5 KEF DENLAR D1030-D-RF MOUNTED 500 0.84 73 (DBA) 4 (AMPS) 115/1 WALL SWITCH HOOD PRE-WIRED DISCONNECT, ECM MOTOR W/ DIAL, GALVANIZED BIRD SCREEN, ROOF CURB	
BB A1 A2 A3 A5 KEF DENLAR D1030-D-RF MOUNTED 500 0.84 73 (DBA) 4 (AMPS) 115/1 WALL SWITCH HOOD PRE-WIRED DISCONNECT, ECM MOTOR W/ DIAL, GALVANIZED BIRD SCREEN, ROOF CURB	
MOTORIZED DAMPER SCHEDULE PHASE TAG DAMPER ACTUATOR INTERLOCK POWER CONTROLS & DEMARKS	\downarrow
INSTALLED TAG MODEL MODEL VOLTAGE/PHASE INTERLOCK WIRING INTERLOCK WIRING REMARKS REMARKS TAMPERPROOF SUPERVISORY SWITCHES TO MONITOR VALVE STATUS. VERIFY/COORDINATE DEDICATED POWER OR SYSTEM POWER	+ $)$
REQUIREMENTS. INTERLOCK WITH THERMOSTAT, EF-21 AND GAS DETECTOR SYSTEM. PROVIDE WITH STANDOFF BRACKET. TAMBERPROOF SUBERVISORY SWITCHES TO MONITOR VALVE STATUS. VERIEV/COORDINATE DEDICATED ROWER OR SYSTEM POWER.	
PER AT AS	\downarrow
BB A1 A3 A4 A5 GREENHECK VCD-43 BELIMO 120/1 EF-24 DIVISION 26 DIVISION 23 BAS TAMPERPROOF SUPERVISORY SWITCHES TO MONITOR VALVE STATUS. VERIFY/COORDINATE DEDICATED POWER OR SYSTEM POWER REQUIREMENTS. INTERLOCK WITH THERMOSTAT, EF-21 AND GAS DETECTOR SYSTEM. PROVIDE WITH STANDOFF BRACKET.	
BB A1 A3 A4 A5 GREENHECK VCD-43 BELIMO 120/1 EF-24 DIVISION 26 DIVISION 23 BAS TAMPERPROOF SUPERVISORY SWITCHES TO MONITOR VALVE STATUS. VERIFY/COORDINATE DEDICATED POWER OR SYSTEM POWER REQUIREMENTS. INTERLOCK WITH THERMOSTAT, EF-22 AND GAS DETECTOR SYSTEM. PROVIDE WITH STANDOFF BRACKET.	
GAS DETECTOR	\rceil
PHASE TAG MANUFACTURER MONITORING POWER INTERLOCK REMARKS	
DD A4 A2 A4 A5 GD HONEYWELL FOROINT DUAL COMOS 4004 FE 04/MD 4 MOUNT CO SENSOR 5'0" ABOVE FINISHED FLOOR AND NO2 SENSOR 2'0" BELOW ROOF STRUCTURE ABOVE. PROVIDE WITH 2 DPDT RELAYS. UNIT TO BE STAND ALONE WITH	
AUDIBLE AND VISUAL ALARMS. INSTALL UNIT AND ALL GAS DETECTORS PER MANUFACTURER'S RECOMMENDATIONS.	\downarrow

A1 A3 A4 A5 GD HONEYWELL E3POINT DUAL CO/NO2 120/1 EF-22/MD-2 MOUNT CO SENSOR 5'0" ABOVE FINISHED FLOOR AND NO2 SENSOR 2'0" BELOW ROOF STRUCTURE ABOVE. PROVIDE WITH 2 DPDT RELAYS. UNIT TO BE STAND ALONE WITH AUDIBLE AND VISUAL ALARMS. INSTALL UNIT AND ALL GAS DETECTORS PER MANUFACTURER'S RECOMMENDATIONS.

ELECTRIC UNIT HEATER SCHEDULE

	I	PH/ NST/	ASE ALLEI	D		TAG	MANUFACTURER AND MODEL NO.	SERVES	TYPE	ELECTRICAL KW - V - Ø	CAPACITY CFM	REMARKS
ВВ	A1		А3	A4	A5	EUH 1	MARKEL P3P5105CA1N	VFD/LEMA STORAGE 335	51000 SERIES FAN FORCED WALL HEATER	5- 480 - 3	400	MOUNT 9'FT HIGH WITH WALL MOUNTING BRACKET, IN-BUILT THERMOSTAT AND INTEGRAL DISCONNECT
ВВ	A1		А3	A4	A5	EUH 2	MARKEL P3P5105CA1N	PSB GARAGE 276	51000 SERIES FAN FORCED WALL HEATER	5- 480 - 3	400	MOUNT 9'FT HIGH WITH WALL MOUNTING BRACKET, IN-BUILT THERMOSTAT AND INTEGRAL DISCONNECT
ВВ	A1		А3	A4	A5	EUH 3	MARKEL P3P5105CA1N	PSB GARAGE 276	51000 SERIES FAN FORCED WALL HEATER	5- 480 - 3	400	MOUNT 9'FT HIGH WITH WALL MOUNTING BRACKET, IN-BUILT THERMOSTAT AND INTEGRAL DISCONNECT
ВВ	A1	A2	А3	A4	A5	EUH 4	MARKEL P3P5105CA1N	SALLYPORT 275	51000 SERIES FAN FORCED WALL HEATER	5- 480 - 3	400	MOUNT 9'FT HIGH WITH WALL MOUNTING BRACKET, IN-BUILT THERMOSTAT AND INTEGRAL DISCONNECT
ВВ	A1	A2	А3	A4	A5	EUH 5	MARKEL P3P5105CA1N	SALLYPORT 275	51000 SERIES FAN FORCED WALL HEATER	5- 480 - 3	400	MOUNT 9'FT HIGH WITH WALL MOUNTING BRACKET, IN-BUILT THERMOSTAT AND INTEGRAL DISCONNECT
ВВ	A1	A2	А3	A4	A5	EUH 6	MARKEL P3P5105CA1N	SALLYPORT 275	51000 SERIES FAN FORCED WALL HEATER	5- 480 - 3	400	MOUNT 9'FT HIGH WITH WALL MOUNTING BRACKET, IN-BUILT THERMOSTAT AND INTEGRAL DISCONNECT

WALL LOUVER SCHEDULE

PHASE INSTALLED	TAG	MANUFACTURER & MODEL NO.	FUNCTION	CFM	MIN NET FREE AREA (SQFT)	OVERALL SIZE (L X H)	DEPTH	MAX PD (IN.W.G.)	REMARKS
BB A1 A2 A3 A4 A5	LV 1	GREENHECK EHH-601	EXHAUST AIR EF-3,4 & 5	400	0.56	14x17	6	0.1	FLUOROPOLYMER FINISH IN COLOR SELECTED BY ARCHITECT, ALUMINUM BIRDSCREEN

OOF EXHAL	JST/INTAKE	CAP	SCHEDULE
OO: -/ 11 17 13		O / \\	001.12022

• • •			-,	.,		, ,							
	PHASE INSTALLED		TAG	MANUFACTURER AND MODEL NO.	FUNCTION	CAPACITY, CFM	PRESS. DROP, IN W.C.	THROAT VELOCITY, FPM	THROAT SIZE, INCHES	REMARKS			
ВВ	A1	A2	А3		A5	RC 1	GREENHECK GRSR-12	EXHAUST AIR	360	0.03	439	12.25	PROVIDE ROOF CURB TO MATCH ROOF SLOPE, BACKDRAFT DAMPER, ALUMINUM BIRDSCREEN
ВВ	A1	A2	А3	A4	A5	RC 2	GREENHECK GRSR-10	EXHAUST AIR	250	0.03	439	10.25	PROVIDE ROOF CURB TO MATCH ROOF SLOPE, BACKDRAFT DAMPER, ALUMINUM BIRDSCREEN
BB	A1	A2	А3	A4	A5	RC 3	GREENHECK GRSR-10	EXHAUST AIR	250	0.03	439	10.25	PROVIDE ROOF CURB TO MATCH ROOF SLOPE, BACKDRAFT DAMPER, ALUMINUM BIRDSCREEN
BB	A1	A2	А3	A4	A5	RC 4	GREENHECK GRSR-12	EXHAUST AIR	700	0.09	854	12.25	PROVIDE ROOF CURB TO MATCH ROOF SLOPE, BACKDRAFT DAMPER, ALUMINUM BIRDSCREEN
BB	A1	A2	А3	A4	A5	RC 5	GREENHECK FGR-22x22	INTAKE AIR	2000	0.05	595	22x22	PROVIDE ROOF CURB TO MATCH ROOF SLOPE, BACKDRAFT DAMPER, ALUMINUM BIRDSCREEN
BB	A1		А3	A4	A5	RC 6	GREENHECK FGR-18x18	INTAKE AIR	1300	0.05	578	18x18	PROVIDE ROOF CURB TO MATCH ROOF SLOPE, BACKDRAFT DAMPER, ALUMINUM BIRDSCREEN
BB	A1		А3	A4	A5	RC 7	GREENHECK GRSR-12	EXHAUST AIR	500	0.06	671	12.25	PROVIDE ROOF CURB TO MATCH ROOF SLOPE, BACKDRAFT DAMPER, ALUMINUM BIRDSCREEN

LPK ARCHITECTS, P.A.

Robert E. Luke, Architect

821 22ND AVENUE P.O. BOX 630
MERIDIAN, MISSISSIPP 13902
P: 601.693.9990
F: 601.693.8640

PROJECT INFORMATION




Lauderdale County Public Safety Building

Village Fair Mall Site 612 22nd Avenue (Winn-Dixie / LabCorp Building)

ACTIVE DESIGN PHASE

FOR REVIEW ONLY FOR PERMITTING ONLY SCHEMATIC DESIGN DESIGN DEVELOPMENT CONSTRUCTION BIDDING CONSTRUCTION DOCUMENTS


AS-BUILT RECORD SET

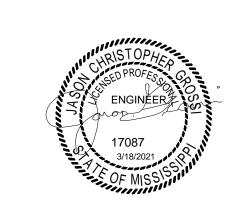

	REVISION	IS/SUBMISSIONS
NO.	DATE	DESCRIPTION
1	04/26/2021	ADDENDUM #2
2	04/30/2021	ADDENDUM #3

HVAC SCHEDULES

 BB
 A1
 A3
 A4
 A5
 GD 2
 HONEYWELL E3POINT
 DUAL
 CO/NO2
 120/1

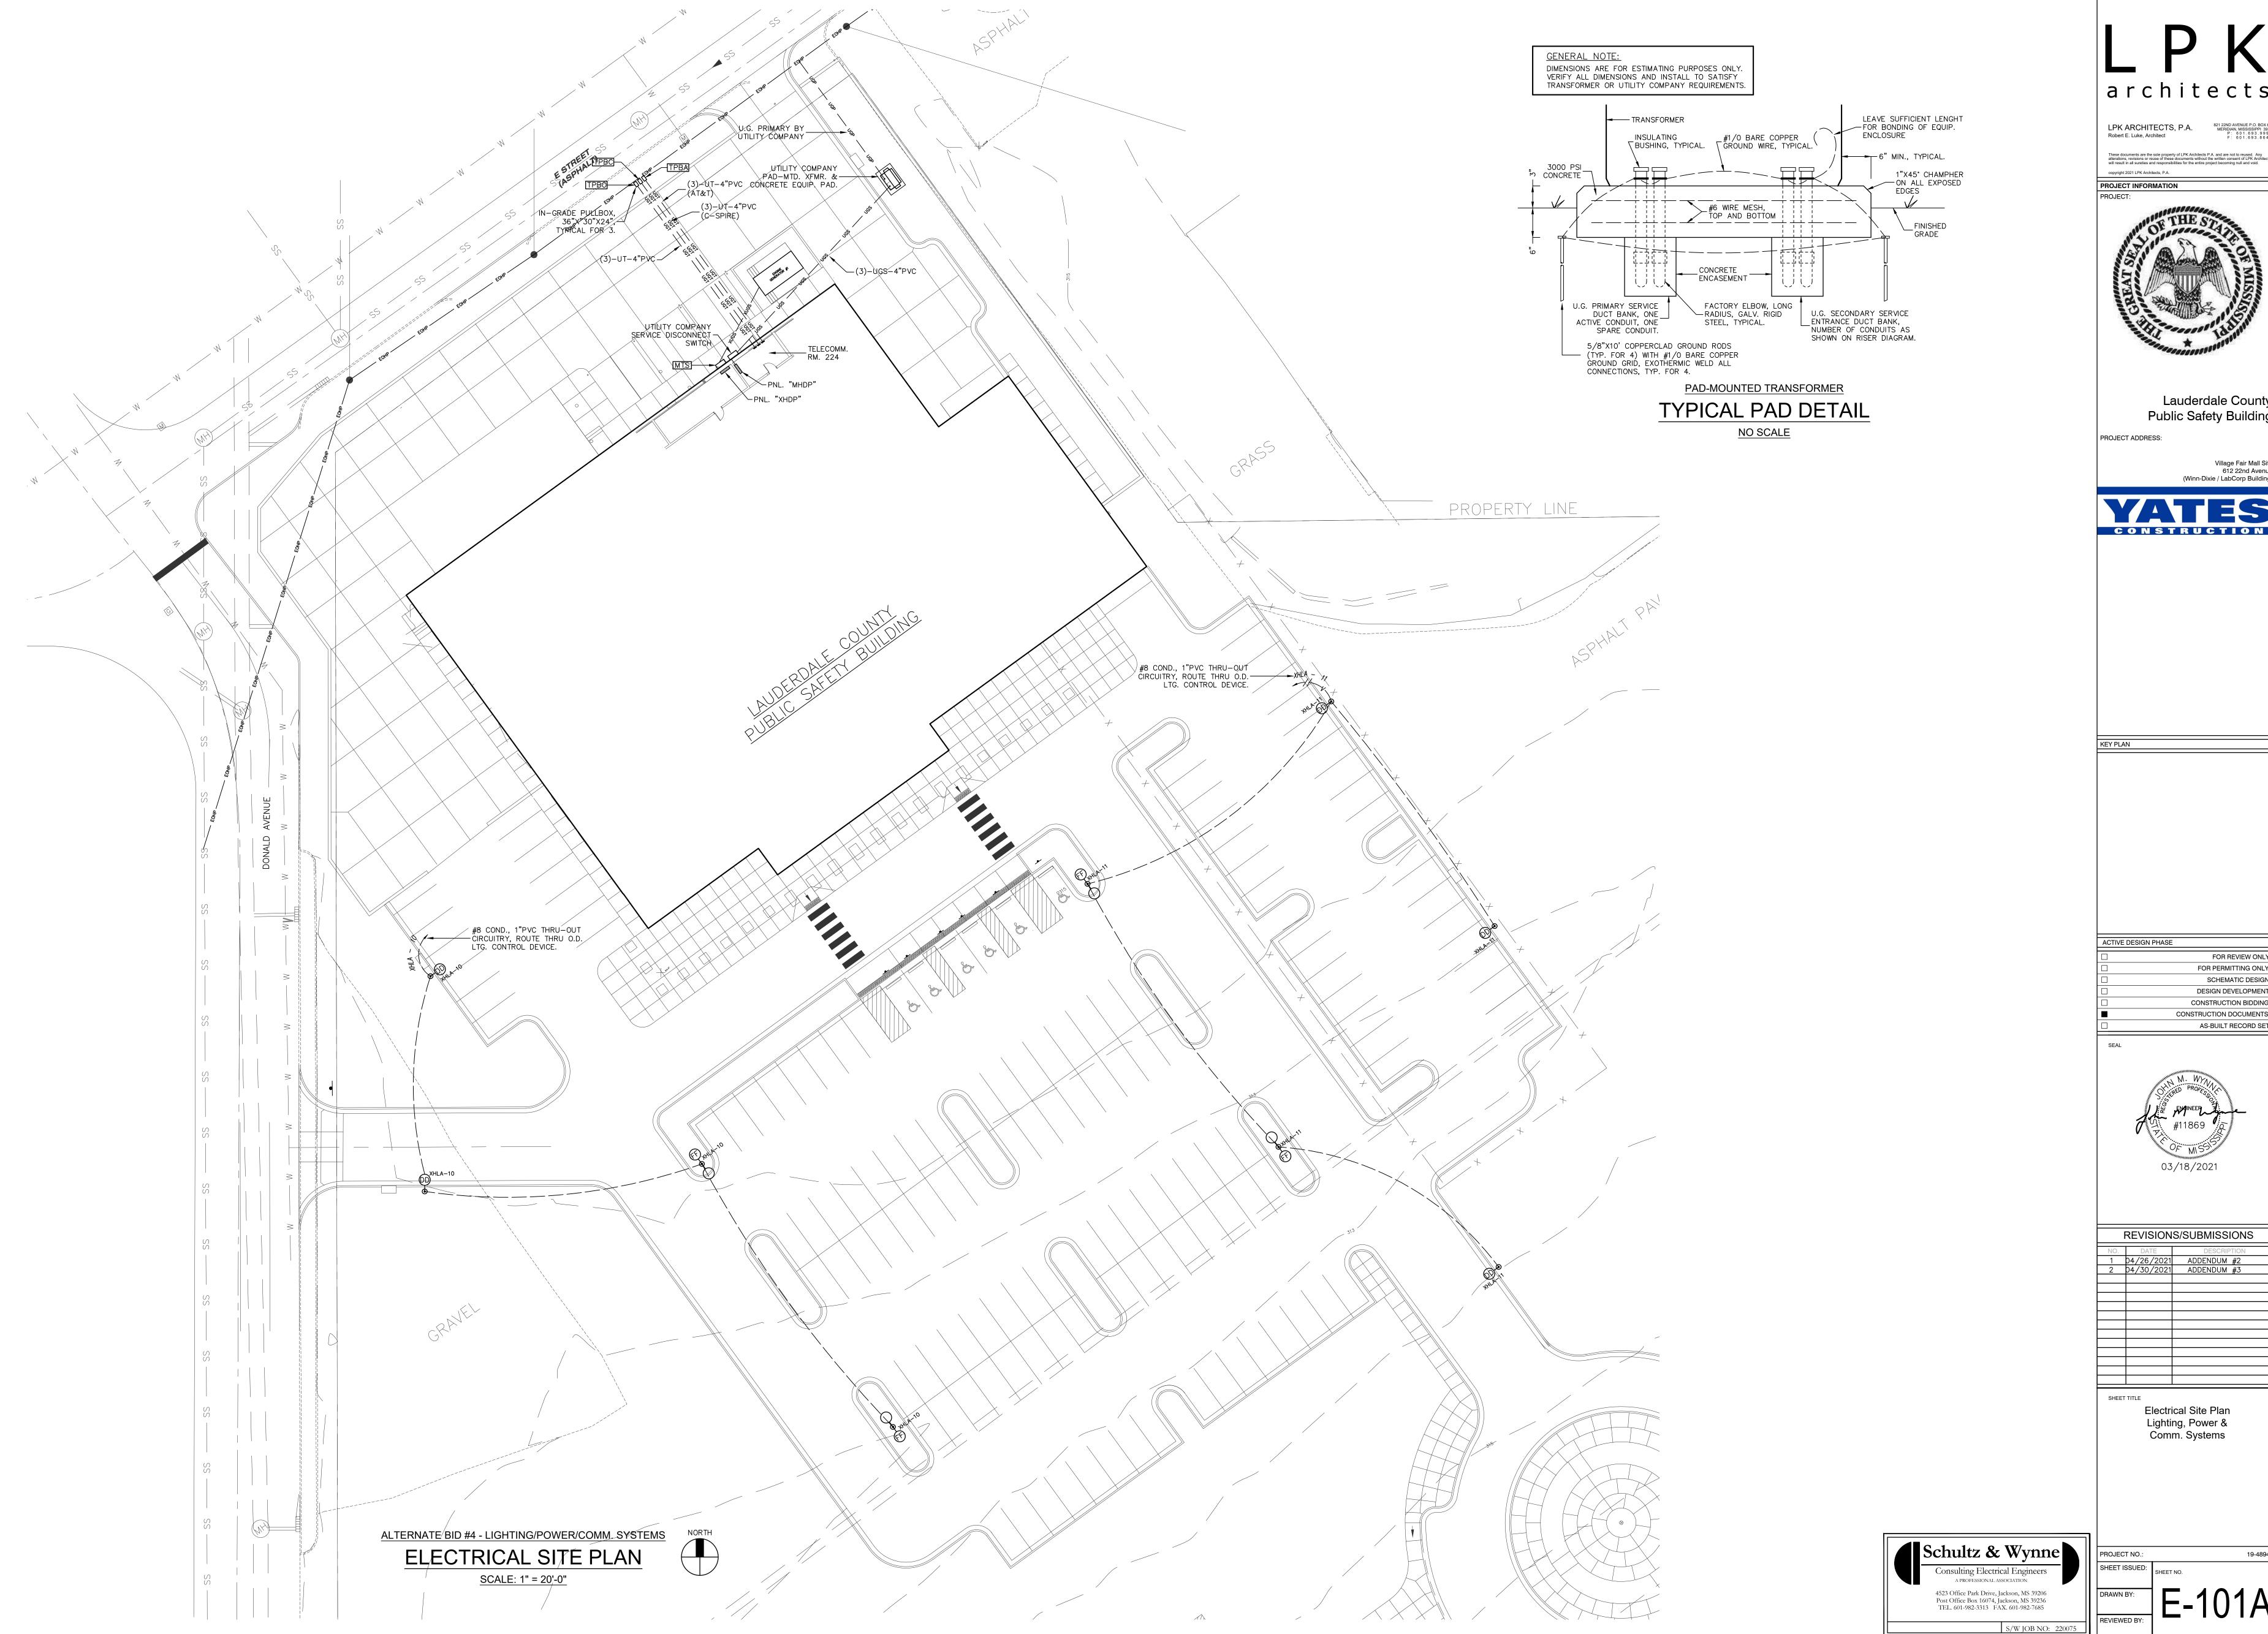

LPK ARCHITECTS, P.A.

Robert E. Luke, Architect

821 22ND AVENUE P.O. BOX 630
MERIDIAN, MISSISSIPPI 39302
P: 601.693.9990
F: 601.693.8940



Lauderdale County Public Safety Building

Village Fair Mall Site 612 22nd Avenue (Winn-Dixie / LabCorp Building)




FOR REVIEW ONLY FOR PERMITTING ONLY SCHEMATIC DESIGN DESIGN DEVELOPMENT CONSTRUCTION BIDDING CONSTRUCTION DOCUMENTS


AS-BUILT RECORD SET



	REVISIONS/SUBMISSIONS						
NO.	DATE	DESCRIPTION					
1	04/26/2021	ADDENDUM #2					
2	04/30/2021	ADDENDUM #3					

Electrical Site Plan Lighting, Power & Comm. Systems

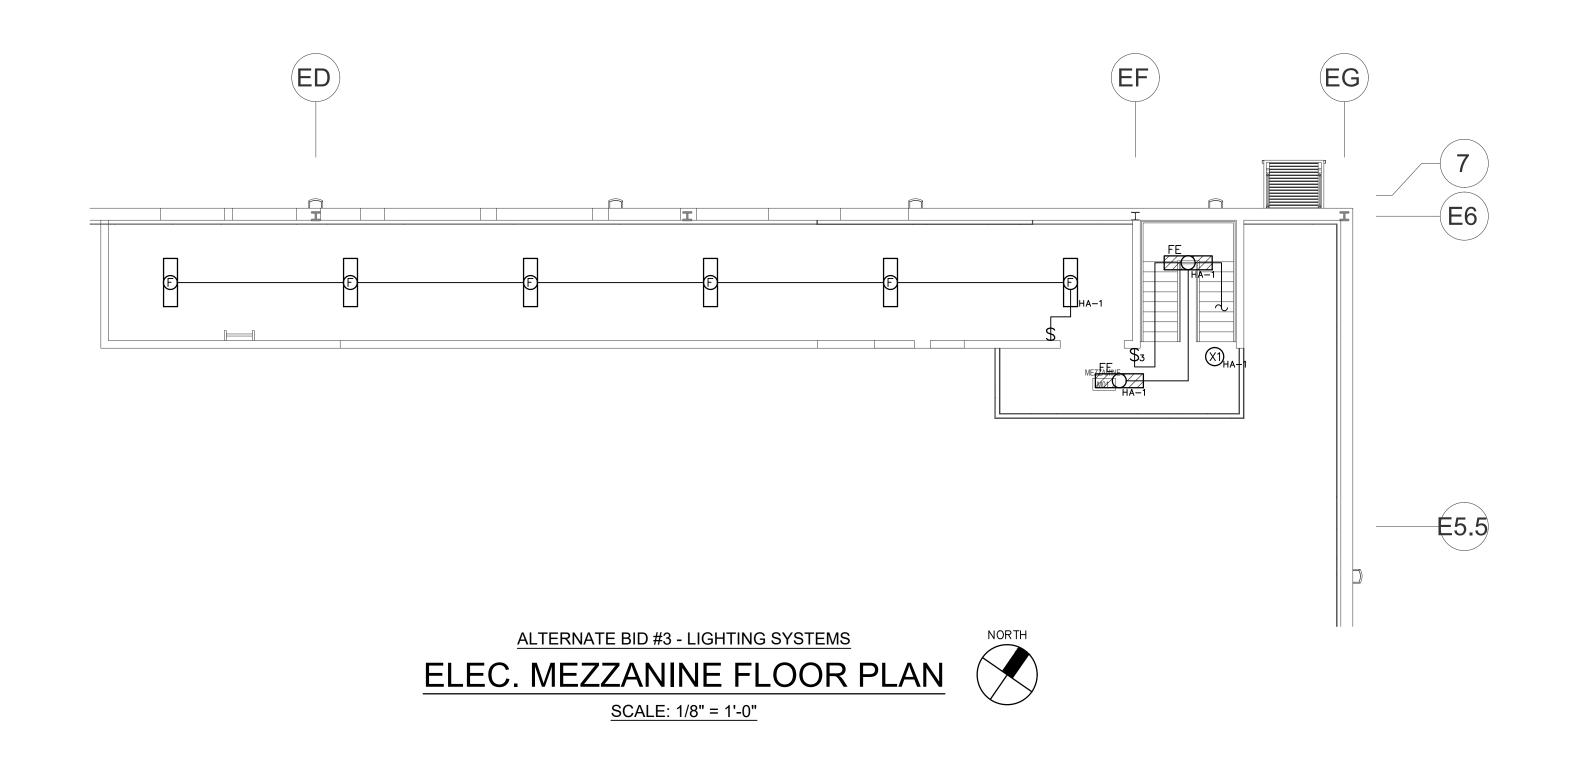

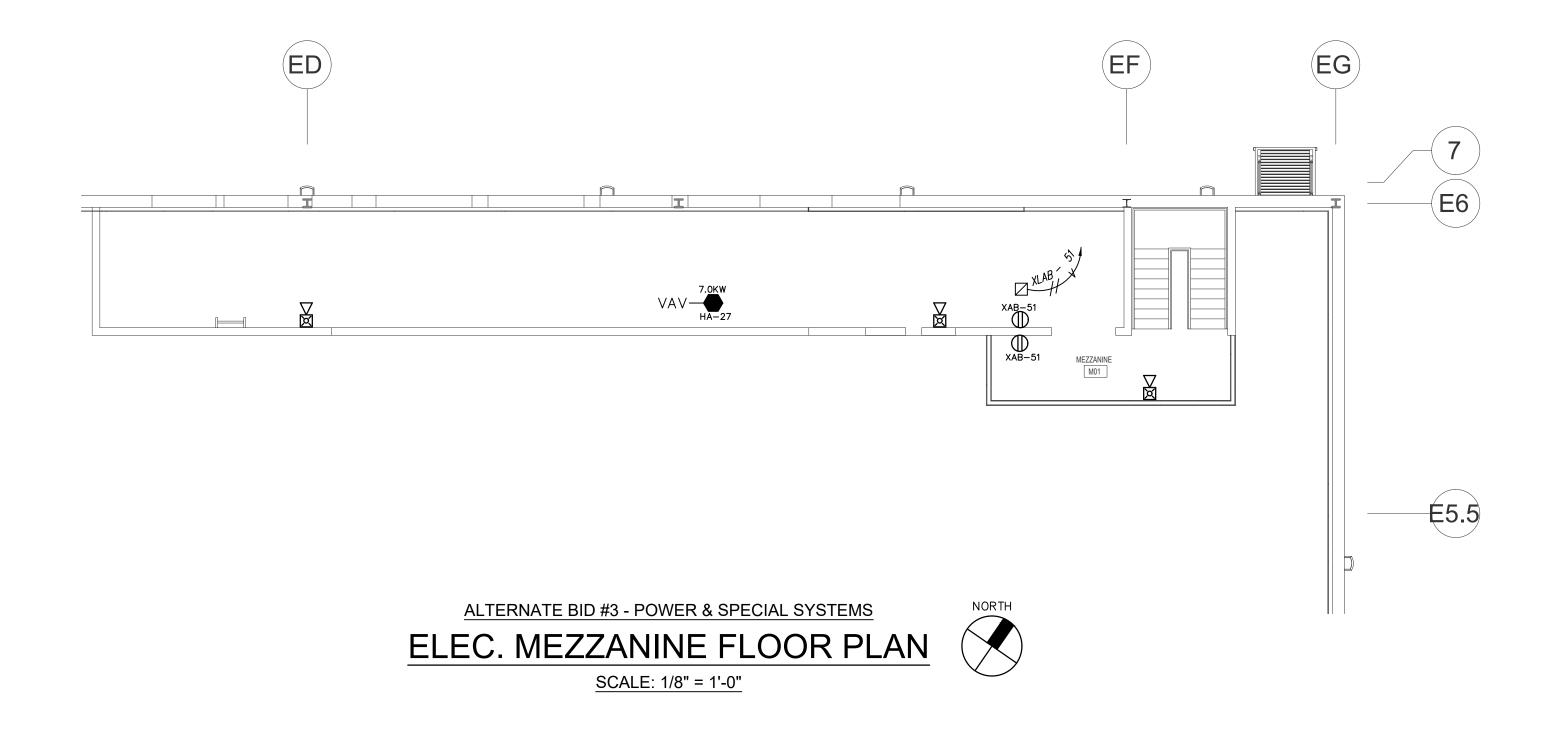



LPK ARCHITECTS, P.A.

Robert E. Luke, Architect

821 22ND AVENUE P.O. BOX 630
MERIDIAN, MISSISSIPPI 39302
P: 601.693.9990
F: 601.693.8640

and adults, revision or reduce in mese documents without the withern consent or PTR ATU
will result in all sureties and responsibilities for the entire project becoming null and void.

copyright 2021 LPK Architects, P.A.

PROJECT:



Lauderdale County Public Safety Building

PROJECT ADDRESS:

Village Fair Mall Site 612 22nd Avenue (Winn-Dixie / LabCorp Building)




KEY PLAN

ACTIVE DESIGN PHASE

FOR PERMITTING ONLY
SCHEMATIC DESIGN
DESIGN DEVELOPMENT
CONSTRUCTION BIDDING
CONSTRUCTION DOCUMENTS
AS-BUILT RECORD SET

FOR REVIEW ONLY

SEAL

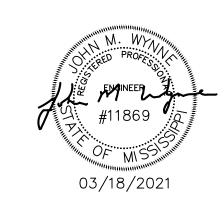

L								
	ſ	REVISIONS/SUBMISSIONS						
F	NO.	DATE	DESCRIPTION	_				
	1	04/26/2021	ADDENDUM #2					
	1	04/30/2021	ADDENDUM #3					
L								
L								
ļ								
L								

Electrical Floor Plans
Alternate Bid
Mezzanine Level

Consulting Electrical Engineers

A PROFESSIONAL ASSOCIATION

4523 Office Park Drive, Jackson, MS 39206
Post Office Box 16074, Jackson, MS 39236
TEL. 601-982-3313 FAX. 601-982-7685

S/W JOB NO: 220075


PROJECT NO.:

SHEET ISSUED: SHEET NO.


DRAWN BY:

REVIEWED BY:

E-2064

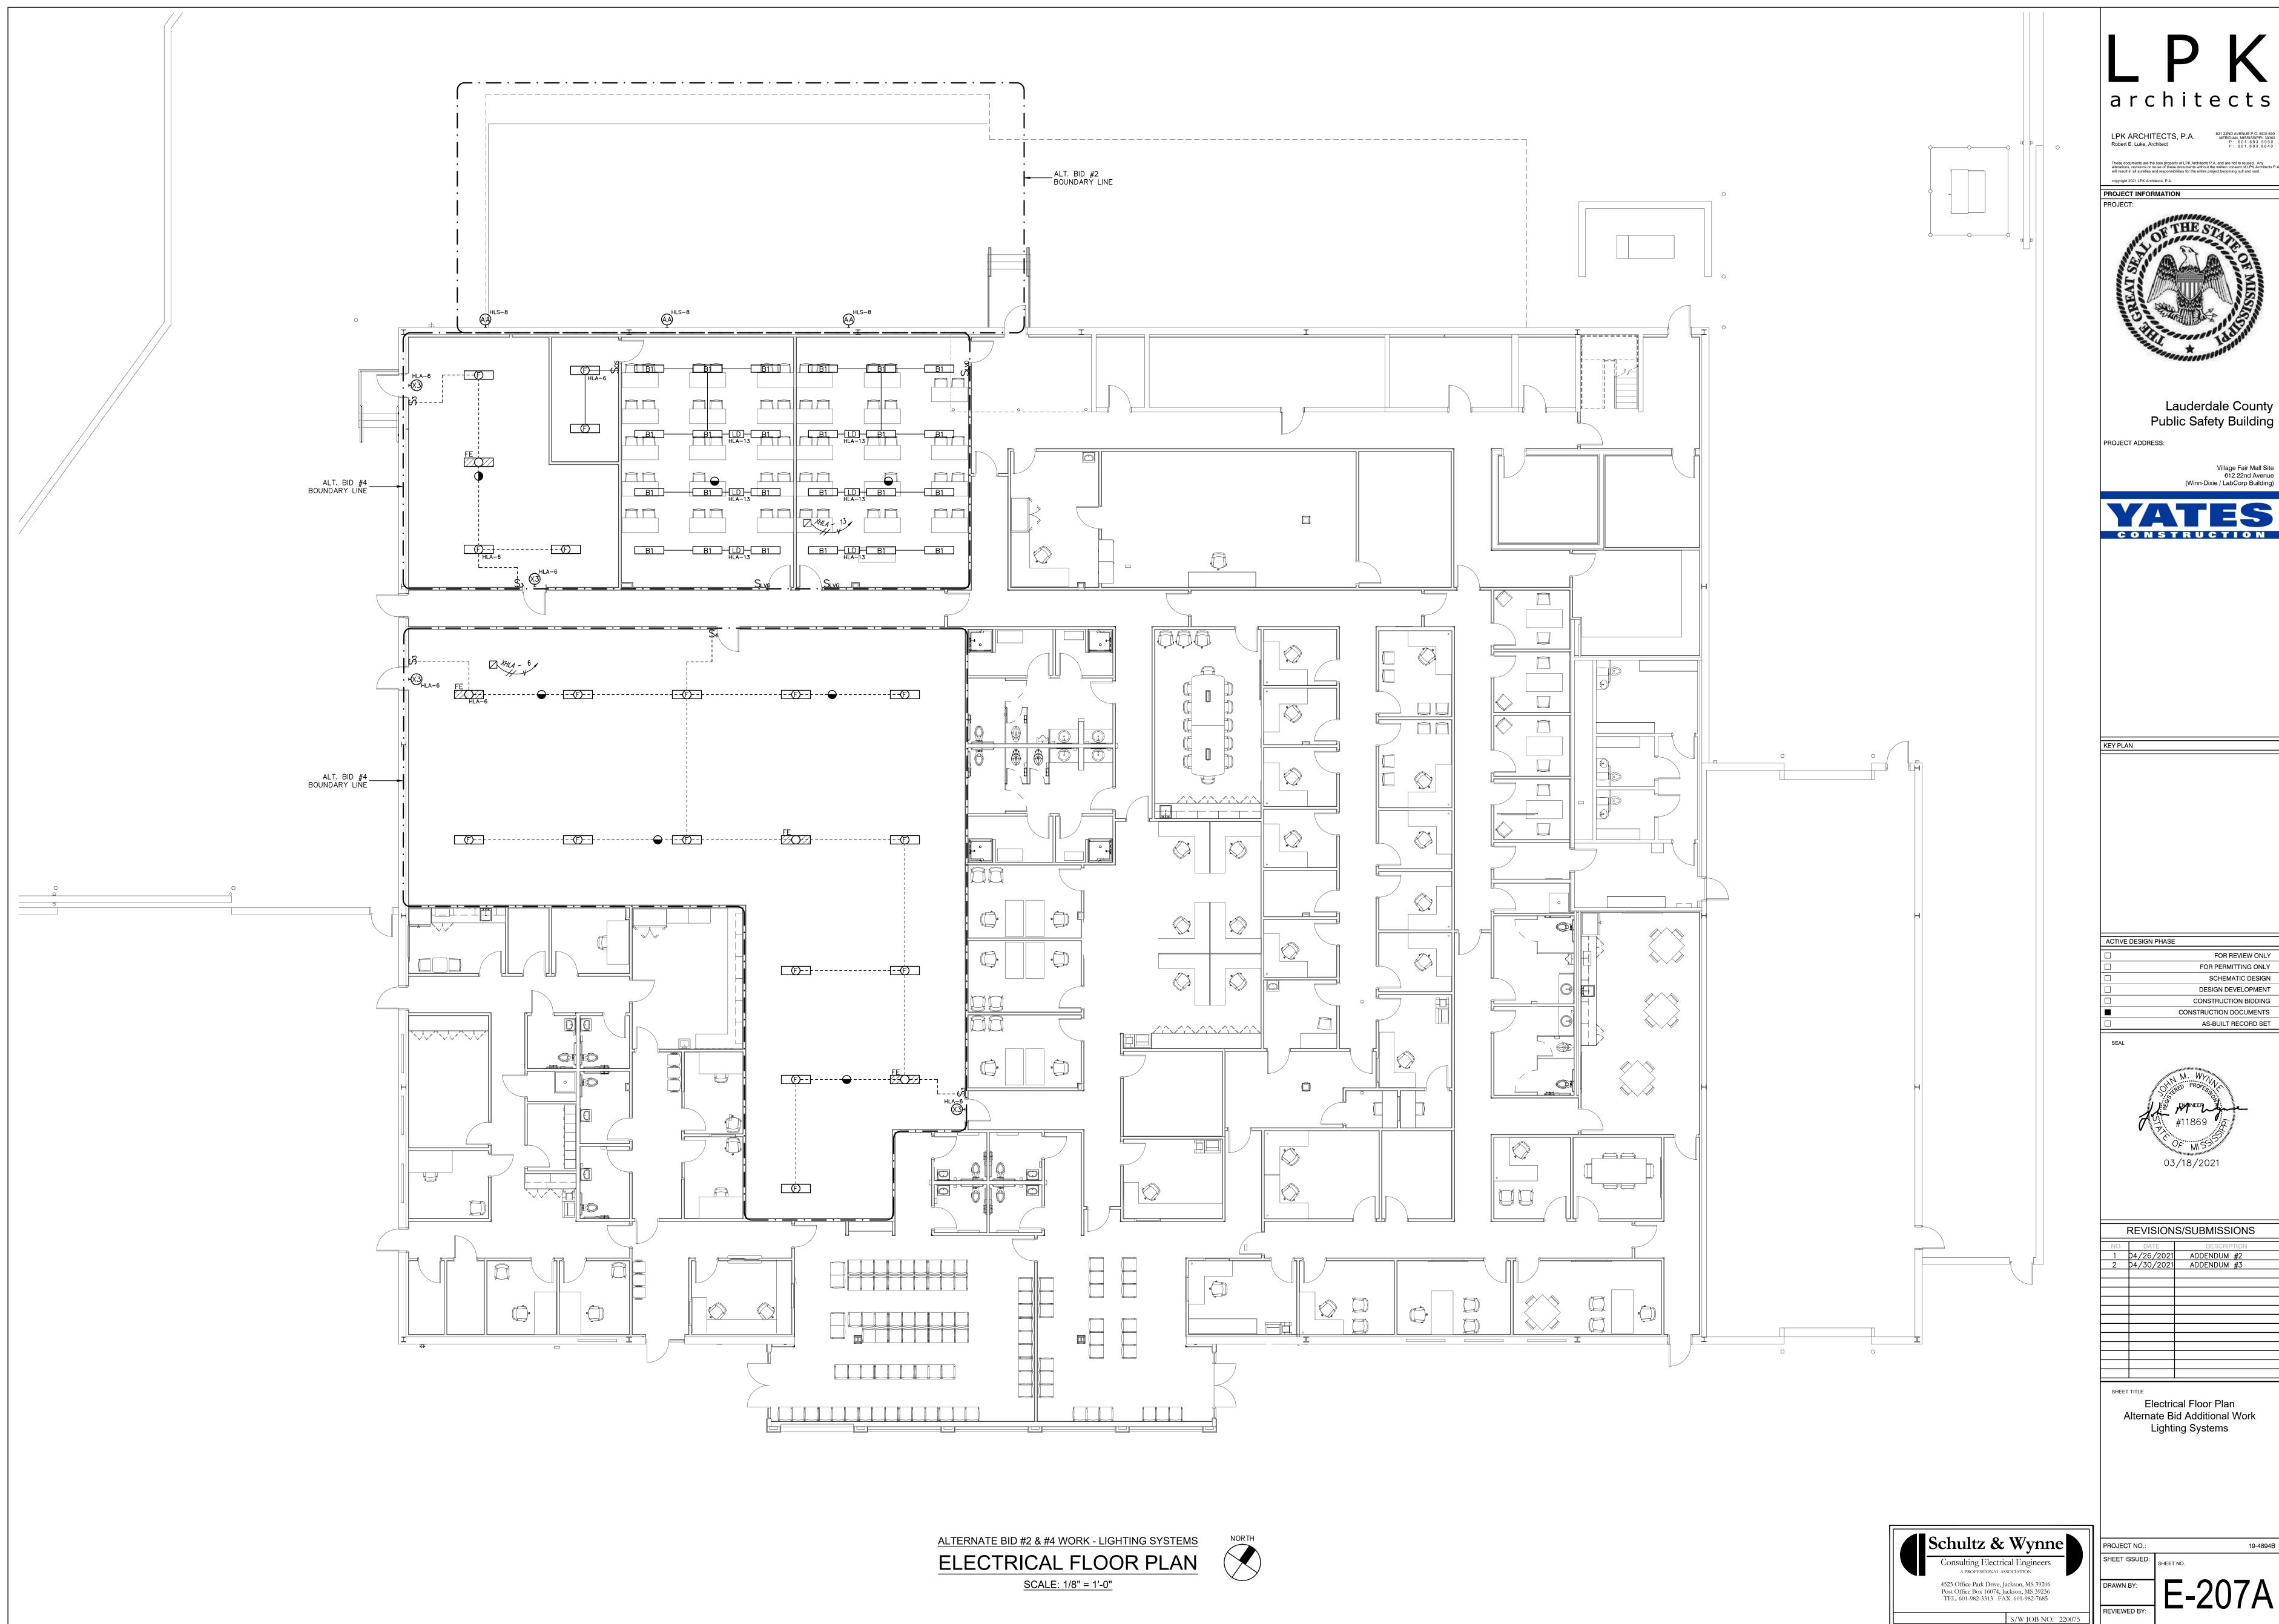



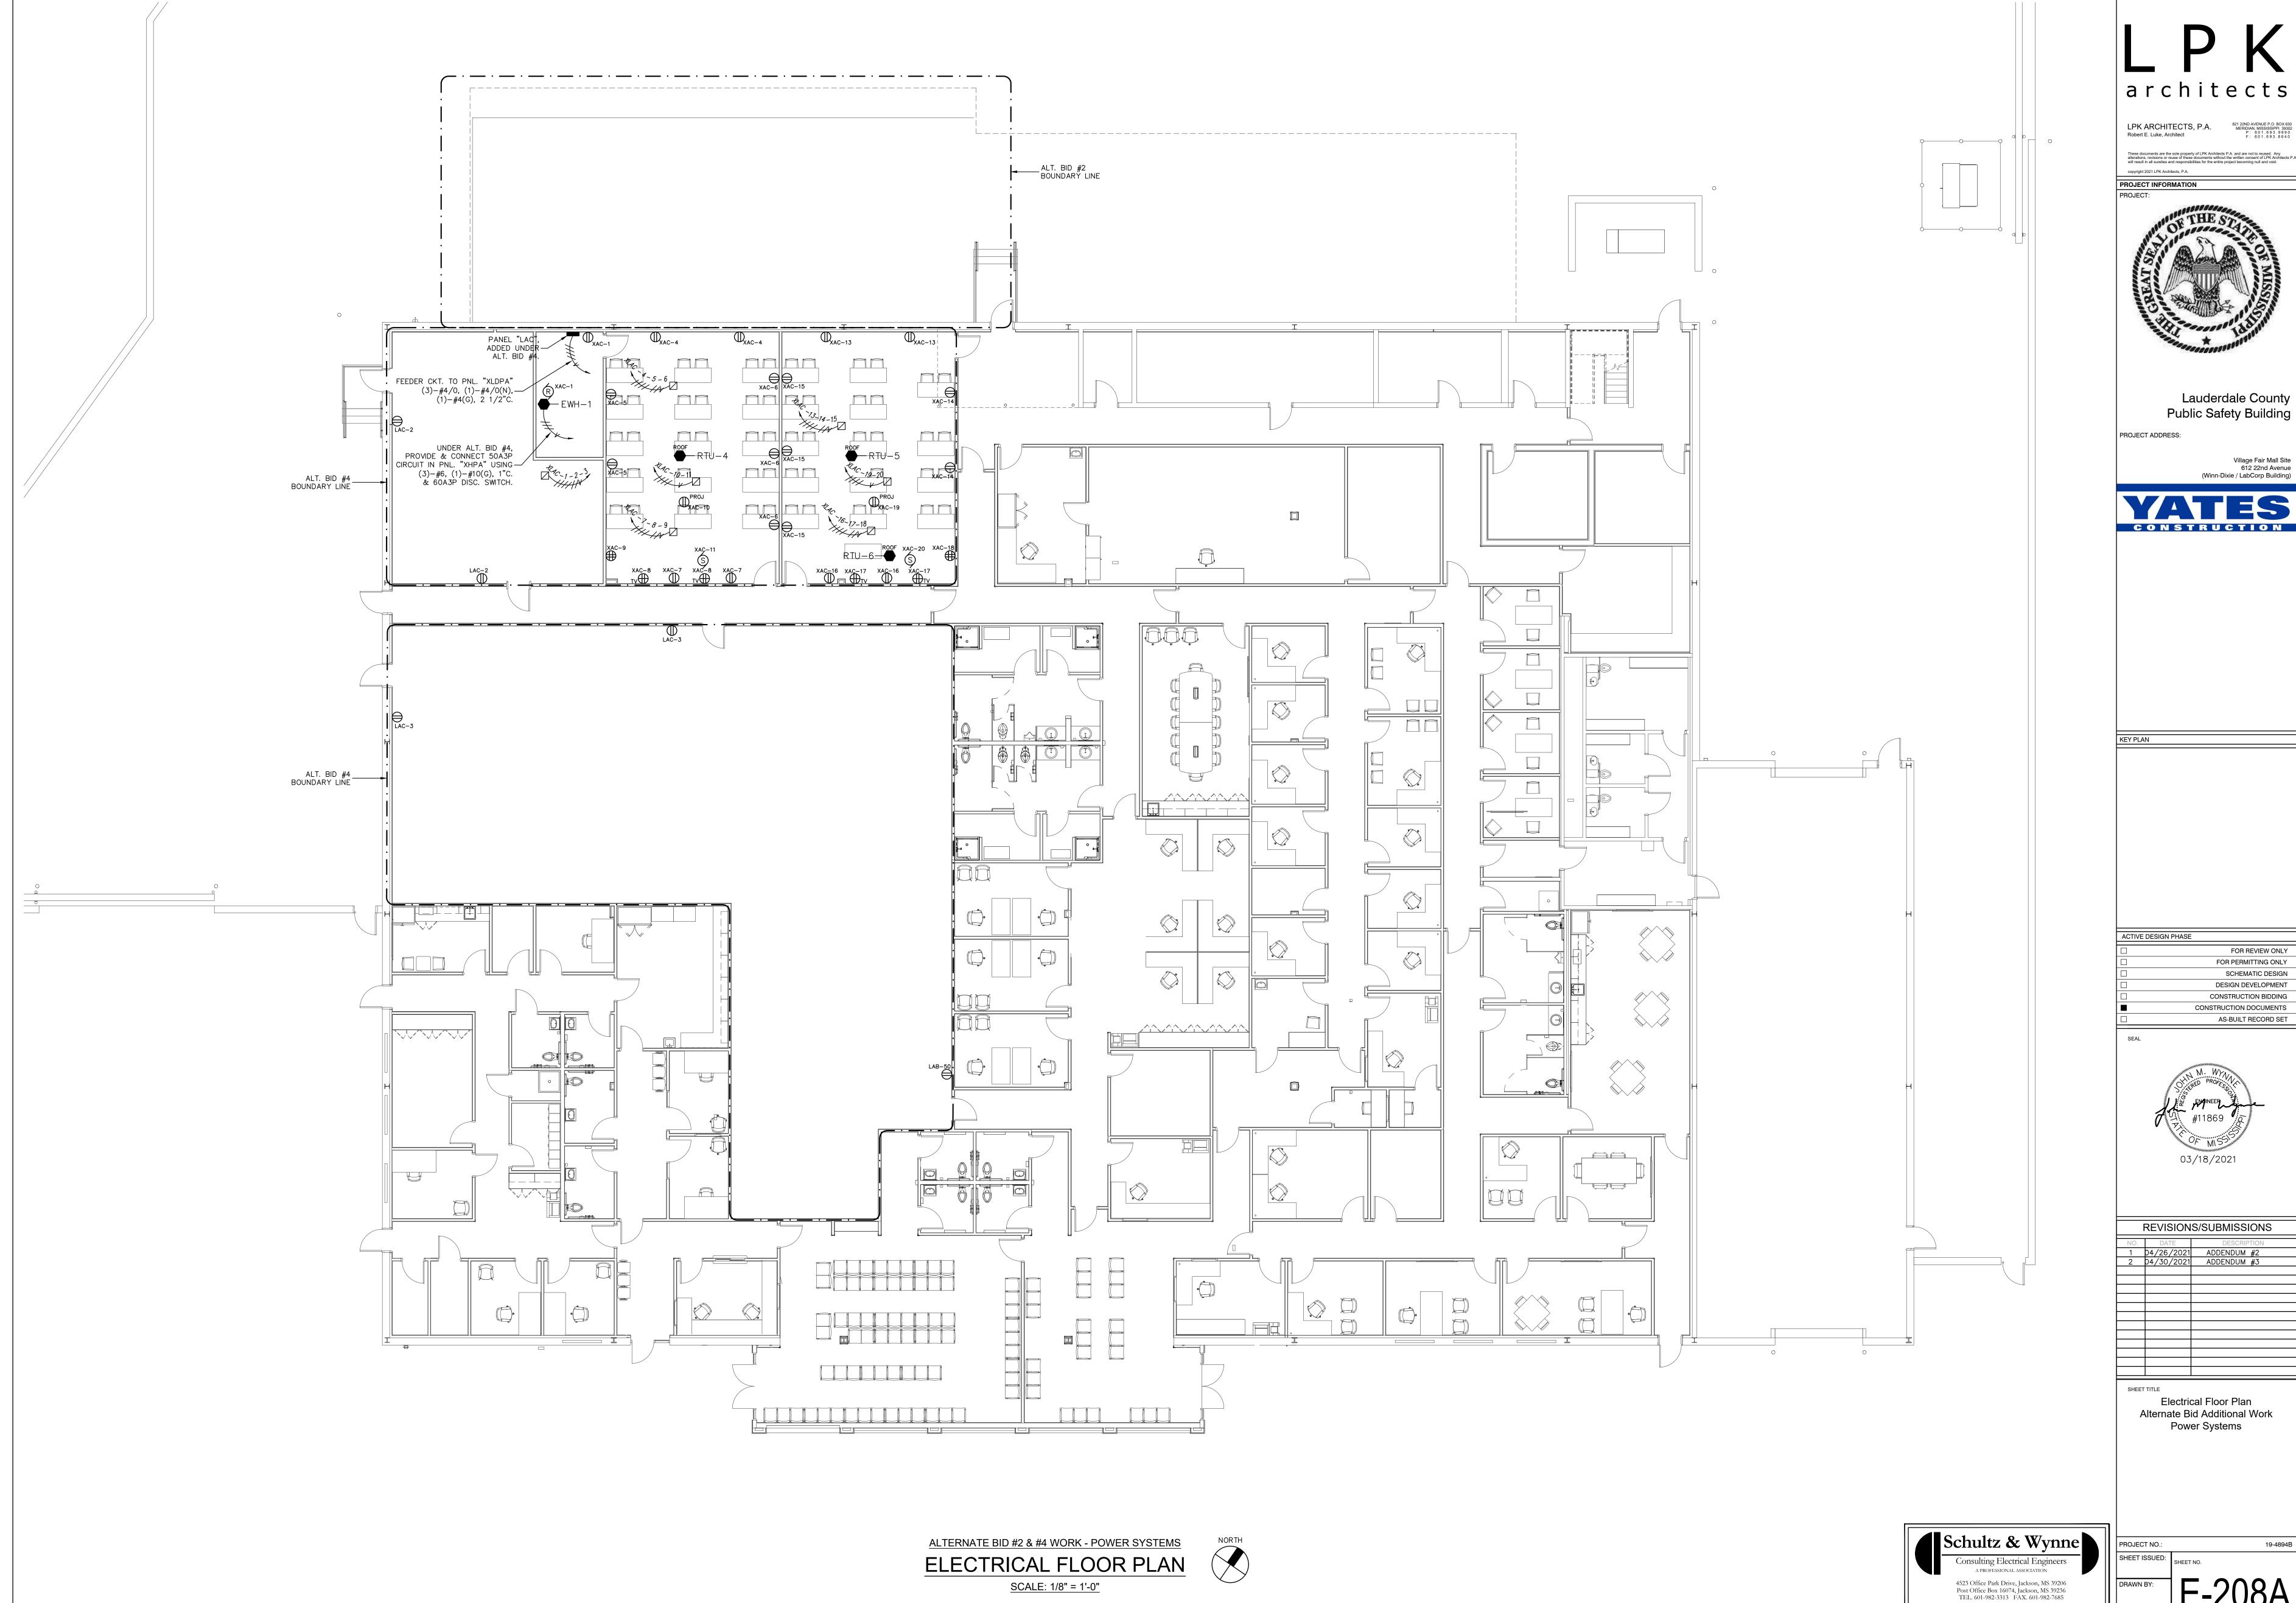






	REVISIONS/SUBMISSIONS						
NO.	DATE	DESCRIPTION					
1	04/26/2021	ADDENDUM #2					
2	04/30/2021	ADDENDUM #3					
		"					

S/W JOB NO: 220075

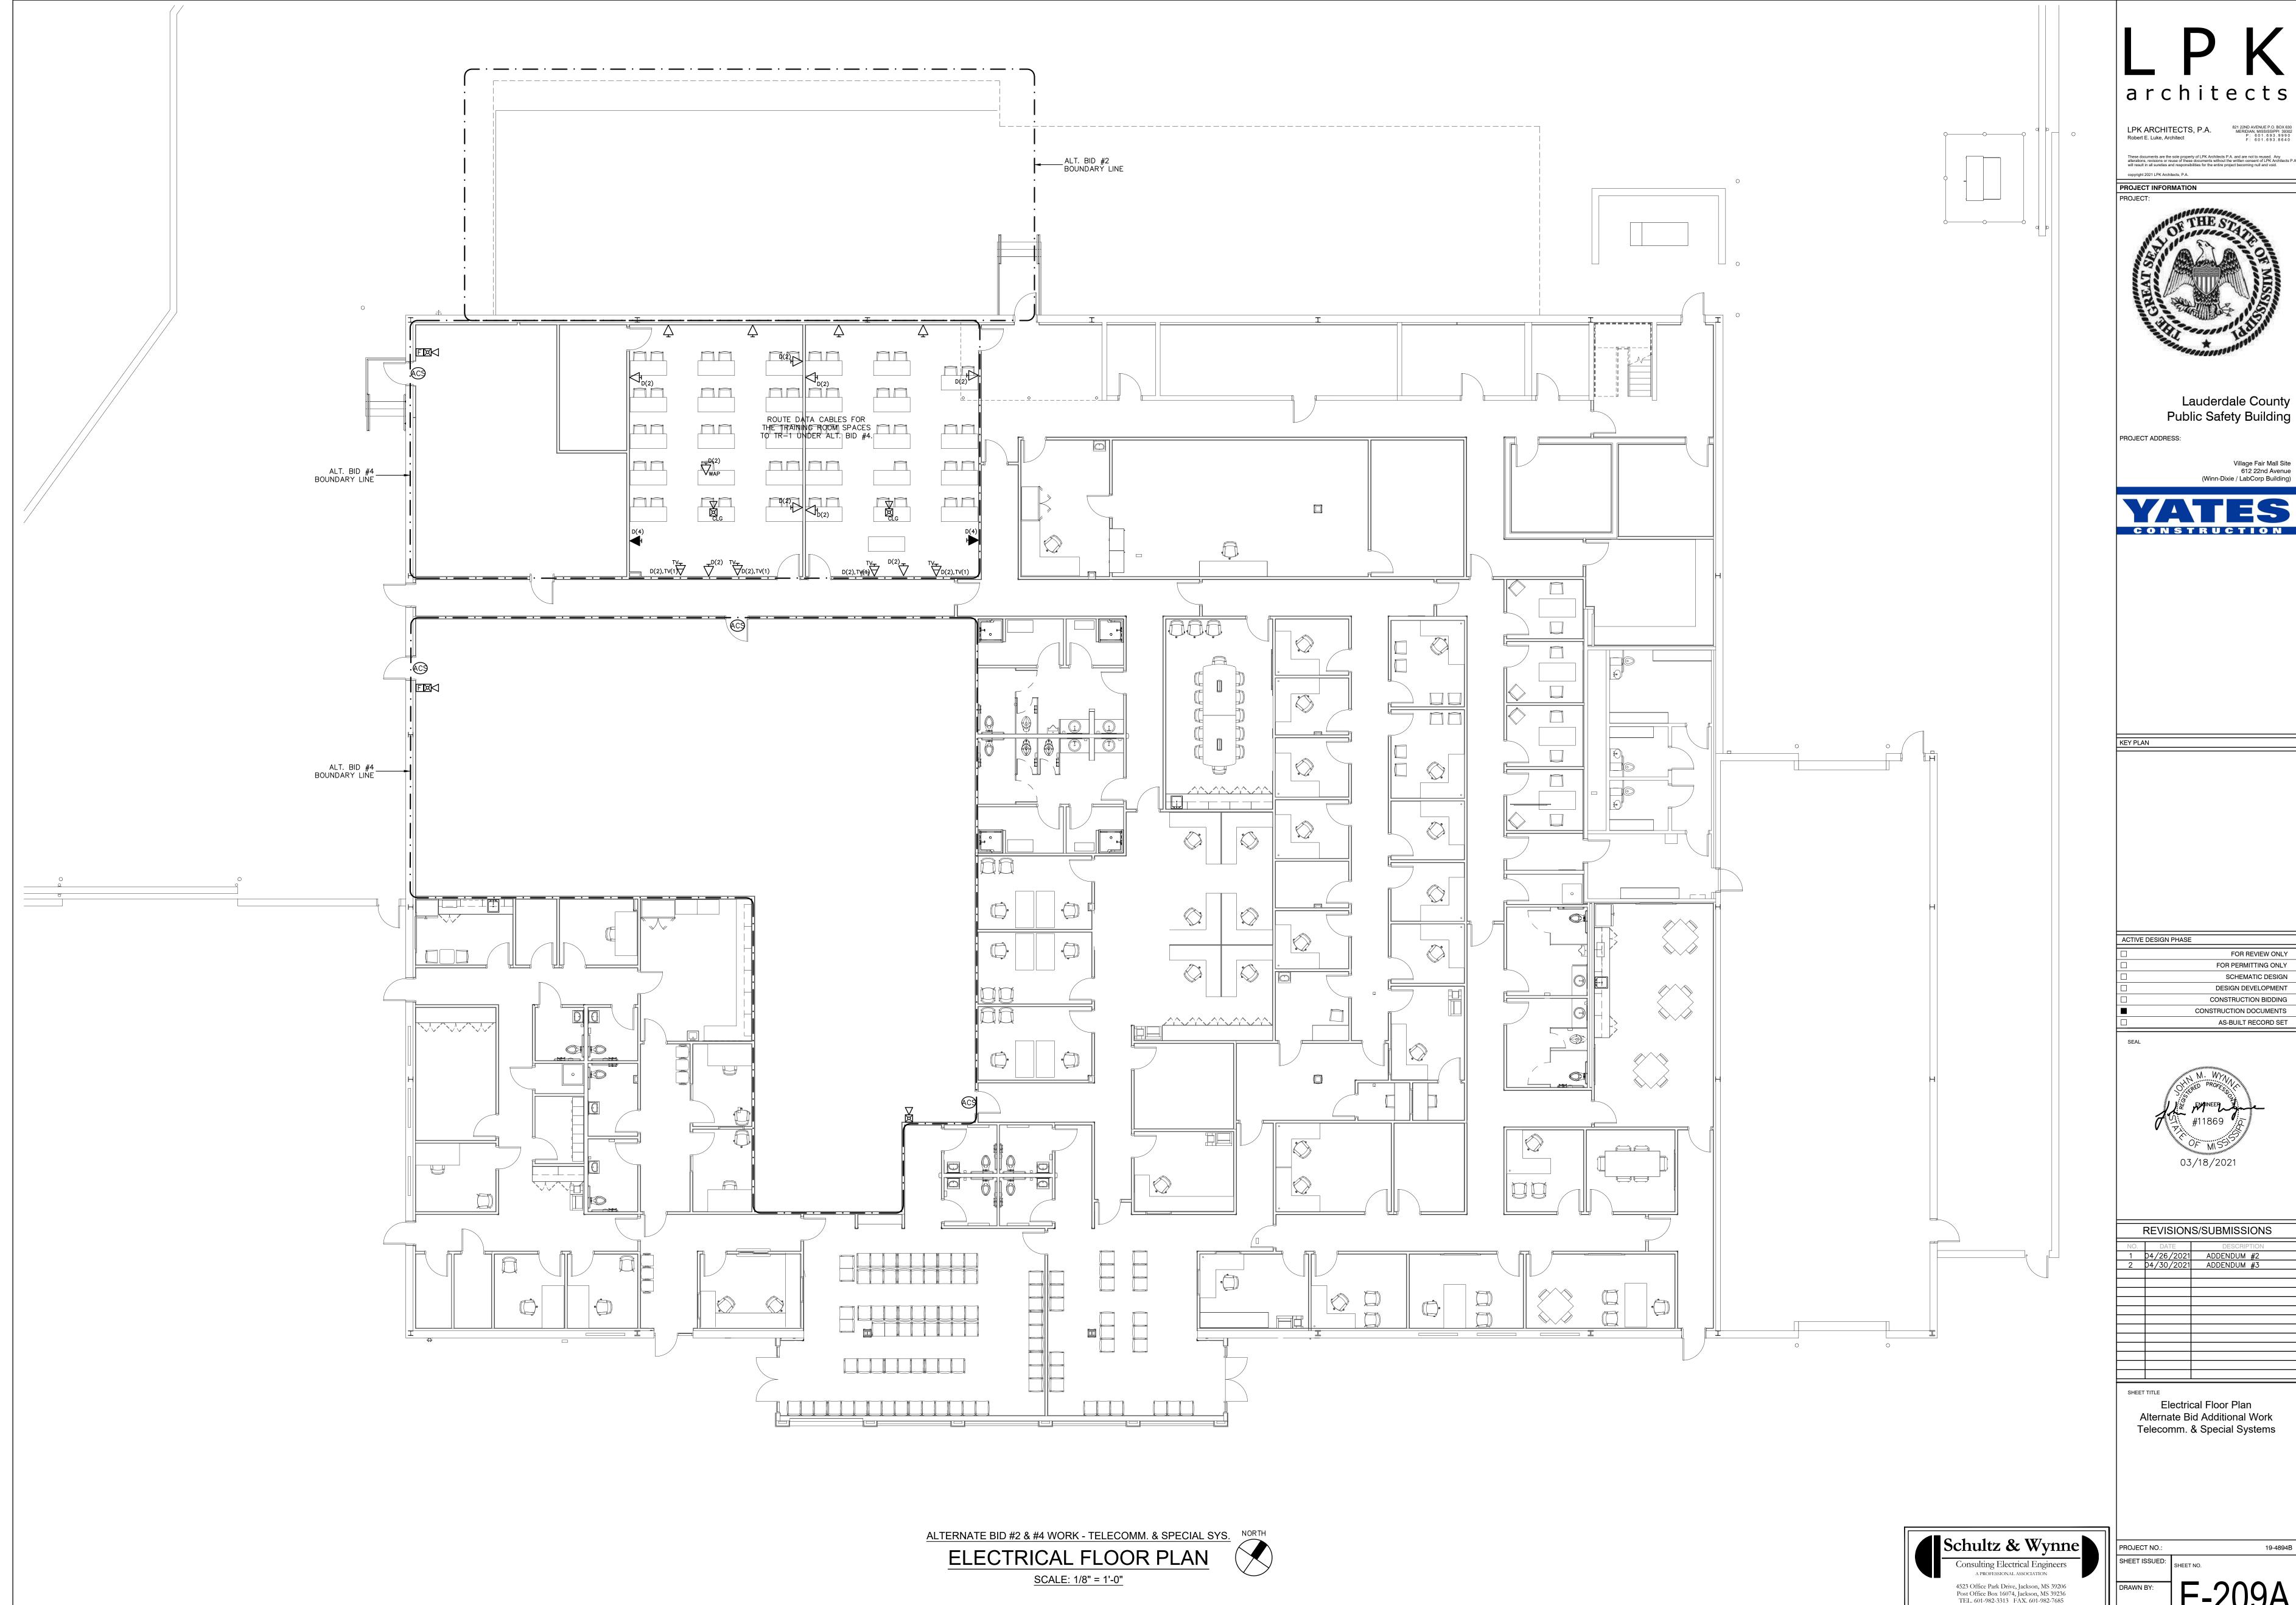

	REVISION	S/SUBMISSIONS
NO.	DATE	DESCRIPTION
1	04/26/2021	ADDENDUM #2
2	04/30/2021	ADDENDUM #3

S/W JOB NO: 220075

					F	PANEL	."Х	HDPB	11					
	VOLTS: 480Y/277 MAIN: 400A NEUTRAL: 100%		PHASE: WIRE: FROM:	4	BOARD	"XHDPA	." &	ENG. GI	ΞΝ. #2 \	/IA ATS	-В		MOUNTING: SURFACE K.A.I.C: 35 I BREAKER: NONE	
CKT.			KVA		BRE	AKER		BRE A	KER		KVA			CKT
NO.	LOAD DESCRIPTION	PH. A	PH. B	PH. C	AMPS	POLES	PH	POLES	AMPS	PH. A		PH. C	LOAD DESCRIPTION	NO
1	SURGE PROTECTION				60	3	Α	3	100				SPACE	2
	DEVICE (SPD)						В							
							С							
3	ROOF TOP UNIT RTU-3	20.37			90	3	Α	3	50	10.00			ELEC. WATER HEATER	4
			20.37				В				10.00		EWH-1	
_	DANEL BOARD IIV BRRI	00.00		20.37	475		C		005	04.00		10.00	DANIEL BOARD HV4 IDH	
5	PANELBOARD "XLDPB"	28.00	00.00		175	3	A	3	225	21.00	04.00		PANELBOARD "XHB"	6
	VIA 112.5 KVA XFMR.		28.00	00.00			В				21.00	04.00		
7	SPARE			28.00	225	3	C	3	225			21.00	SPACE	8
- 1	SPARE				223	3	A B	3	223				SPACE	0
	REMARKS:													
					F	PANEL	. "X	HDPB	1					
								_	-OTAL 5) - KVA:		195.1	
	TOTAL CONNECTED LO	AD - KV	A:								· AMPS:		234.9	
	PHASE A:	AD - KV	A:	79.4 79.4				ТО	TAL DE	MAND -	AMPS:		234.9	
		AD - KV	A:	79.4 79.4 79.4				ТО	TAL DE	MAND -			111111111111111111111111111111111111111	

				PAN	IEL "X	HB"		SEC	T. #1					
	VOLTS: 480Y/277	F	PHASE:	3									MOUNTING: SURFACE	
	MAIN: 225A		WIRE:	4									K.A.I.C: 22	
	NEUTRAL: 100%	FED	FROM:	PANEL	BOARD	"XHDPE	3"					MAIN	BREAKER: NONE	
CKT.			KVA			AKER		BREA			KVA			CK
NO.	LOAD DESCRIPTION	PH. A	PH. B	PH. C	AMPS	POLES	PH	POLES	AMPS	PH. A	PH. B.	PH. C	LOAD DESCRIPTION	NC
1	CORR./MISC./TLT. LTG.	0.80			20	1	Α	3	20	3.00			VAV TERM. UNITS	16
2	SIT./WEATHER LTG.		0.60		20	1	В				3.00		3.12, 3.13, 3.14	
_	DISP./SERVER LTG.			0.80	20	1	C					3.00		
4	OFFICE/MISC. LTG.	1.20			20	1	Α	3	20	2.33			VAV TERM. UNITS	
5	TRAINING LTG.		0.80		20	1	В				2.33		3.06, 3.08, 3.10	
6	TRAINING LTG.			0.80	20	1	С					2.33		
7	SPARE				20	1	Α	3	20	2.83			VAV TERM. UNIT 3.03	18
	SPARE				20	1	В				2.83			
9	SPARE				20	1	С					2.83		
10	VAV 3.01, 3.02	2.00			20	1	Α	3	20	3.00			VAV TERM. UNIT 3.04	19
11	VAV 3.09, 3.11		2.00		20	1	В				3.00			
12	VAV TERM. UNIT 3.07			1.50	20	1	С					3.00		
13	VAV TERM. UNITS	3.33			20	3	Α	3	20	2.66			VAV TERM. UNIT 3.05	20
	3.16, 3.18,3.19		3.33				В				2.66			
				3.33			С					2.66		
14	VAV TERM. UNIT 3.17	2.33			20	3	Α	3	20	1.67			ELEC. WATER HEATER	21
			2.33				В				1.67		EWH-2	
				2.33			С					1.67		
15	VAV TERM.UNIT 3.15	2.33			20	3	Α	3	20				SPARE	22
			2.33				В							
				2.33			С							

		PANEL "XHB"	
TOTAL CONNECTED LOAD - KVA:		TOTAL DEMAND - KVA: TOTAL DEMAND - AMPS:	63.2 76.1
PHASE A: PHASE B: PHASE C:	27.5 26.9 26.6	SPARE CAPACITY - %:	25%
TOTAL CONNECTED LOAD:	80.9	TOTAL LOAD - KVA: TOTAL LOAD - AMPS:	79.0 95.1

						PANEL	. "Х	LDPB	11					
	VOLTS: 208Y/120 MAIN: 400A	F	PHASE: WIRE:										MOUNTING: SURFACE K.A.I.C: 22	
	NEUTRAL: 100%	FED				"XHDPE	B" VI	A 112.5I	KVA XFI	ИR.		MAIN	I BREAKER: 400A3P	
CKT.			KVA			AKER			AKER		KVA			СКТ
NO.	LOAD DESCRIPTION	PH. A	PH. B	PH. C	AMPS	POLES	PH	POLES	AMPS	PH. A	PH. B.	PH. C	LOAD DESCRIPTION	NO
1	BLOWER UNIT DSS-1	0.25			15	2	Α	2	15	0.25			BLOWER UNIT DSS-2	2
			0.25				В				0.25			
3	H.P. COND. UNIT CU-1			2.03	40	2	С	2	40			20.30	H.P. COND. UNIT CU-2	4
_	00405	2.03	:				A			2.03			00405	_
5	SPARE				15	2	В	2	50				SPARE	6
7	CLIDGE DEOTECTION				60	3	C	3	100				CDACE	8
1	SURGE PROTECTION DEVICE (SPD)				60	3	A B	3	100				SPACE	0
	DEVICE (SFD)						С							
9	PANELBOARD "XLBA"	17.00			225	3	A	3	225	16.00			PANELBOARD "XLBB"	10
-	I ANLEBOARD ALBA	17.00	17.00		225	-	В	-	225	10.00	16.00		TANLEBOARD ALBE	10
			17.00	17.00			С				10.00	16.00		
11	SPARE			11.00	225	3	A	3	225			10.00	SPACE	12
-	0171112						В	Ť					517.62	<u> </u>
							С							
	REMARKS:					DANEI	"	'I DDD						
						PANEL	. "Х	LDPB						
	TOTAL CONNECTED LO	AD - KV	A:		,				TOTAL DE				101.6 282.5	
	PHASE A: PHASE B:			37.6 33.5	I .				SPARE	CAPAC	ITY - %:		25%	
	PHASE C:			55.3	ļ				TOT A	I I OAF) - KVA:		127.1	
	TOTAL CONNECTED LO	AD:		126.4	1					LOAD -			353.1	

NAIN BREAKER BREAKER KVA CADD DESCRIPTION NAIN BREAKER	ESCRIPTION R RM. RECPT R RM. RECPT R RM. RECEPT	K.A.I.C: I BREAKER: NO LOAD DESCRIF WEATHER RM. F WEATHER RM. F WEATHER RM. RE SERV. RM. RE	MAIN PH. C 1.00	1.00 1.00	1.00	AKER AMPS 20 20 20 20 20 20 20	BREA POLES 1 1 1	PH A	"XLDPB	BOARD	3 4	WIRE: FROM:		VOLTS: 208Y/120	
RECEPT. 1.00 20 1 A 1 20 1.00 SERV. RM. RECEPT. 1.00 20 1 B 1 20 1.00 SERV. RM. RECEPT. 1.00 20 1 B 1 20 1.00 SERV. RM. RECEPT. 1.00 20 1 B 1 20 1.00 SERV. RM. RECEPT. 1.00 20 1 B 1 20 1.00 SERV. RM. RECEPT. 1.00 20 1 B 1 20 1.00 SERV. RM. RECEPT. 1.00 20 1 B 1 20 1.00 SERV. RM. RECEPT. 1.00 20 1 B 1 20 1.00 SERV. RM. RECEPT. SERT.	ESCRIPTION R RM. RECPT R RM. RECPT R RM. RECEPT	LOAD DESCRIF WEATHER RM. F WEATHER RM. F WEATHER RM. F FIRE SUPP. CNTI SERV. RM. RE	PH. C 1.00	1.00 1.00	1.00	20 20 20 20 20 20 20	POLES 1 1 1 1	PH A	AKER			FROM:		VULIS. 2001/120	
REAL BREAKER BREAKER KVA CAD DESCRIPTION	ESCRIPTION R RM. RECPT R RM. RECPT R RM. RECPT P. CNTL. PNL RM. RECEPT	LOAD DESCRIF WEATHER RM. F WEATHER RM. F WEATHER RM. F FIRE SUPP. CNTI SERV. RM. RE	PH. C 1.00	1.00 1.00	1.00	20 20 20 20 20 20 20	POLES 1 1 1 1	PH A	AKER		PANEL			MAIN: 225A	
CRIPTION PH. A PH. B PH. C AMPS POLES PH POLES AMPS PH. A PH. B PH. C LOAD DESCRIPTION RECEPT. 1.00 20 1 A 1 20 1.00 WEATHER RM. RECPT. PT. 1.00 20 1 A 1 20 1.00 WEATHER RM. RECPT. PT. 1.00 20 1 A 1 20 1.00 WEATHER RM. RECPT. PT. 1.00 20 1 A 1 20 1.00 WEATHER RM. RECPT. PT. 1.00 20 1 A 1 20 1.00 FIRE SUPP. CNTL. PNL. RECEPT. 1.00 20 1 A 1 20 1.00 SERV. RM. RECEPT. PT. 1.00 20 1 A 1 20 1.00 SERV. RM. RECEPT. PT. 1.00 20 1 A 1 20 1.00 SERV. RM. RECEPT. PT. 1.00 20 1 B 1 20 1.00 SERV. RM. RECEPT. RECEPT. 1.00 20 1 B 1 20 1.00 SERV. RM. RECEPT. RECEPT. 1.00 20 1 B 1 20 1.00 SERV. RM. RECEPT. RECEPT. 1.00 20 1 B 1 20 1.00 SERV. RM. RECEPT. REPT. 1.00 20 1 B 1 20 1.00 SERV. RM. RECEPT. REPT. 1.00 20 1 B 1 20 1.00 SERV. RM. RECEPT. REPT. 1.00 20 1 B 1 20 1.00 SERV. RM. RECEPT. REPT. 1.00 20 1 A 1 20 1.00 SERV. RM. RECEPT. REPT. 1.00 20 1 A 1 20 1.00 SERV. RM. RECEPT. REPT. 1.00 20 1 A 1 20 1.00 SERV. RM. RECEPT. REPT. 1.00 20 1 A 1 20 1.00 SERV. RM. RECEPT. REPT. 1.00 20 1 A 1 20 1.00 DISPATCH RECEPT. REPT. 1.00 20 1 A 1 20 1.00 DISPATCH RECEPT. REPT. 1.00 20 1 A 1 20 1.00 DISPATCH RECEPT. REPT. 1.00 20 1 A 1 20 1.00 DISPATCH RECEPT. REPT. 1.00 20 1 A 1 20 1.00 DISPATCH RECEPT. REPT. 1.00 20 1 A 1 20 1.00 DISPATCH RECEPT. REPT. 1.00 20 1 A 2 20 1.00 DISPATCH RECEPT. REPT. 1.00 20 1 A 2 20 1.00 DISPATCH RECEPT. REPT. 1.00 20 1 A 2 20 1.00 DISPATCH RECEPT. RECEPT. 1.00 20 1 A 2 20 1.50 SERVER RM. RECEPT. RECEPT. 1.00 20 1 A 2 20 1.50 SERVER RM. RECEPT. RECEPT. 1.	R RM. RECPT R RM. RECPT R RM. RECPT C CNTL. PNL RM. RECEPT	WEATHER RM. F WEATHER RM. F WEATHER RM. F FIRE SUPP. CNTI SERV. RM. RE	1.00	1.00 1.00	1.00	20 20 20 20 20 20 20	POLES 1 1 1 1	Α		1			FED	NEUTRAL: 100%	
CRIPTION PH. A PH. B PH. C AMPS POLES PH POLES AMPS PH. A PH. B PH. C LOAD DESCRIPTION RECEPT. 1.00 20 1 A 1 20 1.00 WEATHER RM. RECPT. PT. 1.00 20 1 A 1 20 1.00 WEATHER RM. RECPT. PT. 1.00 20 1 A 1 20 1.00 WEATHER RM. RECPT. PT. 1.00 20 1 A 1 20 1.00 WEATHER RM. RECPT. PT. 1.00 20 1 A 1 20 1.00 FIRE SUPP. CNTL. PNL. RECEPT. 1.00 20 1 A 1 20 1.00 SERV. RM. RECEPT. PT. 1.00 20 1 A 1 20 1.00 SERV. RM. RECEPT. PT. 1.00 20 1 A 1 20 1.00 SERV. RM. RECEPT. PT. 1.00 20 1 B 1 20 1.00 SERV. RM. RECEPT. RECEPT. 1.00 20 1 B 1 20 1.00 SERV. RM. RECEPT. RECEPT. 1.00 20 1 B 1 20 1.00 SERV. RM. RECEPT. RECEPT. 1.00 20 1 B 1 20 1.00 SERV. RM. RECEPT. REPT. 1.00 20 1 B 1 20 1.00 SERV. RM. RECEPT. REPT. 1.00 20 1 B 1 20 1.00 SERV. RM. RECEPT. REPT. 1.00 20 1 B 1 20 1.00 SERV. RM. RECEPT. REPT. 1.00 20 1 A 1 20 1.00 SERV. RM. RECEPT. REPT. 1.00 20 1 A 1 20 1.00 SERV. RM. RECEPT. REPT. 1.00 20 1 A 1 20 1.00 SERV. RM. RECEPT. REPT. 1.00 20 1 A 1 20 1.00 SERV. RM. RECEPT. REPT. 1.00 20 1 A 1 20 1.00 DISPATCH RECEPT. REPT. 1.00 20 1 A 1 20 1.00 DISPATCH RECEPT. REPT. 1.00 20 1 A 1 20 1.00 DISPATCH RECEPT. REPT. 1.00 20 1 A 1 20 1.00 DISPATCH RECEPT. REPT. 1.00 20 1 A 1 20 1.00 DISPATCH RECEPT. REPT. 1.00 20 1 A 1 20 1.00 DISPATCH RECEPT. REPT. 1.00 20 1 A 2 20 1.00 DISPATCH RECEPT. REPT. 1.00 20 1 A 2 20 1.00 DISPATCH RECEPT. REPT. 1.00 20 1 A 2 20 1.00 DISPATCH RECEPT. RECEPT. 1.00 20 1 A 2 20 1.50 SERVER RM. RECEPT. RECEPT. 1.00 20 1 A 2 20 1.50 SERVER RM. RECEPT. RECEPT. 1.	R RM. RECPT R RM. RECPT R RM. RECPT C CNTL. PNL RM. RECEPT	WEATHER RM. F WEATHER RM. F WEATHER RM. F FIRE SUPP. CNTI SERV. RM. RE	1.00	1.00 1.00	1.00	20 20 20 20 20 20 20	POLES 1 1 1 1	Α						T	
RECEPT. 1.00	R RM. RECPT R RM. RECPT R RM. RECPT C CNTL. PNL RM. RECEPT	WEATHER RM. F WEATHER RM. F WEATHER RM. F FIRE SUPP. CNTI SERV. RM. RE	1.00	1.00	1.00	20 20 20 20 20 20	1 1 1	Α	POLES		DII O	10.00.00.0	DII A	LOAD DECODED TO N	KT.
PT. 1.00 20 1 B 1 20 1.00 WEATHER RM. RECPT. PT. 1.00 20 1 C 1 20 1.00 WEATHER RM. RECPT.	R RM. RECPT R RM. RECPT C CNTL. PNL RM. RECEPT	WEATHER RM. F WEATHER RM. F FIRE SUPP. CNTI SERV. RM. RE	1.00	1.00	1.00	20 20 20 20	1 1 1	_	1 4		PH. C	PH. B		LOAD DESCRIPTION	NO.
PT. 1.00 20	R RM. RECPT P. CNTL. PNL RM. RECEPT	WEATHER RM. F FIRE SUPP. CNTI SERV. RM. RE	1.00	1.00		20 20 20	1				 	1.00	1.00	ELEC./DATA RECEPT. T.B.B. RECEPT.	_
1.00	P. CNTL. PNL RM. RECEPT	FIRE SUPP. CNTI SERV. RM. RE	1.00			20 20	1	С			1.00	1.00		T.B.B. RECEPT.	
Table Tabl	RM. RECEPT	SERV. RM. RE	1.00			20	11.01				1.00		1.00	EMS PANEL	
SCREEN 1.00 20	RM. RECEPT RM. RECEPT RM. RECEPT RM. RECEPT RM. RECEPT RM. RECEPT RM. RECEPT RM. RECEPT RM. RECEPT	SERV. RM. RE SERV. RM. RE SERV. RM. RE SERV. RM. RE SERV. RM. RE SERV. RM. RE SERV. RM. RE		1.00	1.00	20	1	-				1.00		TLT. MISC./RECEPT.	
SCREEN	RM. RECEPT RM. RECEPT RM. RECEPT RM. RECEPT RM. RECEPT RM. RECEPT RM. RECEPT RM. RECEPT	SERV. RM. RE SERV. RM. RE SERV. RM. RE SERV. RM. RE SERV. RM. RE SERV. RM. RE	1.00	1.00	1.00		1	С	1	20	1.50			HAND DRYER	6
1.00 20 1 C 1 20 1.00 SERV. RM. RECEPT.	RM. RECEPT RM. RECEPT RM. RECEPT RM. RECEPT RM. RECEPT RM. RECEPT RM. RECEPT	SERV. RM. RE SERV. RM. RE SERV. RM. RE SERV. RM. RE SERV. RM. RE	1.00	1.00			-	_					1.00	CORR. RECEPT.	
DEPT. 1.00 20	RM. RECEPT RM. RECEPT RM. RECEPT RM. RECEPT RM. RECEPT RM. RECEPT	SERV. RM. RE SERV. RM. RE SERV. RM. RE SERV. RM. RE	1.00						-		4.00	1.00		MOTORIZED SCREEN	
DEPT. 1.00 20 1 B 1 20 1.00 SERV. RM. RECEPT.	RM. RECEPT RM. RECEPT RM. RECEPT RM. RECEPT RM. RECEPT	SERV. RM. RE SERV. RM. RE SERV. RM. RE			1.00		100	_			1.00		1.00	PROJECTOR	
Table Tabl	RM. RECEPT RM. RECEPT RM. RECEPT RM. RECEPT	SERV. RM. RE SERV. RM. RE		1.00	1.00			_	<u> </u>	1	<u> </u>	1.00	1.00	SIT. RM. RECEPT.	
DEPT. 1.00 20 1 A 1 20 1.00 SERV. RM. RECEPT.	RM. RECEPT RM. RECEPT RM. RECEPT	SERV. RM. RE	1 00	1.00			- 13	2000			1 00	1.00		SIT. RM. RECEPT.	
DEPT.	RM. RECEPT	OFFIL DM DF			1.00				-				1.00	SIT. RM. RECEPT.	
DEPT.	RM. RECEPT	, SERV. RM. RE		1.00		20	1		1	20		1.00		SIT. RM. RECEPT.	
CEPT. 1.00 20 1 B 1 20 1.00 DISPATCH RECEPT.	TCH RECEPT		1.00				1	-	1		1.00			SIT. RM. RECEPT.	
CEPT.		DISPATCH RE			1.00	20	1	Α	1	20			1.00	SIT. RM. RECEPT.	16
M. RECPT. 1.00 20 1 A 1 20 1.00 DISPATCH RECEPT.				1.00								1.00		SIT. RM. RECEPT.	
No.			1.00						1 1	100000	1.00			SIT. RM. RECEPT.	
No.				4.00	1.00							4.00	1.00	WEATHER RM. RECPT.	
PANEL "XLBA" SECT. #2 KVA BREAKER BREAKER KVA LOAD DESCRIPTION CRIPTION PH. A PH. B PH. C AMPS POLES AMPS PH. A PH. B. PH. C LOAD DESCRIPTION ECEPT. 1.00 20 1 A 2 20 1.50 SERVER RM. RECEPT. ECEPT. 1.00 20 1 B 1.50 SERVER RM. RECEPT. ECEPT. 1.00 20 1 C 2 20 1.50 SERVER RM. RECEPT.			1.00	1.00					-		1.00	1.00	-	WEATHER RM. RECPT. WEATHER RM. RECPT.	
ECEPT. 1.00 20 1 A 2 20 1.50 SERVER RM. RECEPT. ECEPT. 1.00 20 1 B 1.50 1.50 SERVER RM. RECEPT. ECEPT. 1.00 20 1 C 2 20 1.50 SERVER RM. RECEPT.												00 000 0 0			CKT.
ECEPT. 1.00 20 1 B 1.50 ECEPT. 1.00 20 1 C 2 20 1.50 SERVER RM. RECEPT.			PH. C	PH. B.	10				 		PH. C	PH. B		LOAD DESCRIPTION	
ECEPT. 1.00 20 1 C 2 20 1.50 SERVER RM. RECEPT.	RM. RECEPT	SERVER RM. RE		1.50	1.50	20	2	-				1.00	1.00		
	RM RECEPT	SERVER RM RE	1 50	1.50		20	2	_			1.00	1.00			
	MIL TREGET	OZIVI ZIVIVIII IVE	1.00		1.50		_	A	1	20			1.00	DISPATCH RECEPT.	
ECEPT. 1.00 20 1 B 2 20 1.50 SERVER RM. RECEPT.	RM. RECEPT	SERVER RM. RE		1.50		20	2	В	1	20		1.00		DISPATCH RECEPT.	47
			1.50					С	1	20	1.00			DISPATCH RECEPT.	
ECEPT. 1.00 20 1 C 1.50	RM. RECEPT	SERVER RM. RE		4.50	1.50	20	2	-				4.00	1.00		
ECEPT. 1.00 20 1 C 1.50 1.50 ECEPT. 1.00 20 1 A 2 20 1.50 SERVER RM. RECEPT.	DM DECEDT	SEDVED DM DE	1.50	1.50		20	2	_		1	1.00	1.00	-		
ECEPT. 1.00 20 1 C 1.50 1.50 ECEPT. 1.00 20 1 A 2 20 1.50 SERVER RM. RECEPT. ECEPT. 1.00 20 1 B 1.50 1.50	NIVI. NEGELT I	OLIVER RIVI. RE	1.50		1 50	20		_			1.00				
ECEPT. 1.00 20 1 C 1.50 SERVER RM. RECEPT. ECEPT. 1.00 20 1 A 2 20 1.50 SERVER RM. RECEPT. ECEPT. 1.00 20 1 B 1.50 1.50 SERVER RM. RECEPT. ECEPT. 1.00 20 1 C 2 20 1.50 SERVER RM. RECEPT.	RM. RECEPT	SERVER RM. RE		1.50		20	2	В	1	20				SPARE	
ECEPT. 1.00 20 1 C 1.50 SERVER RM. RECEPT. ECEPT. 1.00 20 1 A 2 20 1.50 SERVER RM. RECEPT. ECEPT. 1.00 20 1 B 1.50 SERVER RM. RECEPT. ECEPT. 1.00 20 1 C 2 20 1.50 SERVER RM. RECEPT. 20 1 A 1.50 1.50 SERVER RM. RECEPT.			1.50					С	1	20				SPARE	54
ECEPT. 1.00 20 1 C 1.50 ECEPT. 1.00 20 1 A 2 20 1.50 SERVER RM. RECEPT. ECEPT. 1.00 20 1 B 1.50 1.50 SERVER RM. RECEPT. ECEPT. 1.00 20 1 C 2 20 1.50 SERVER RM. RECEPT. 20 1 B 2 20 1.50 SERVER RM. RECEPT.	TCH RECEPT	DISPATCH RE			1.50	20	2	Α	1	20				SPARE	
ECEPT. 1.00 20 1 C SERVER RM. RECEPT. 1.00 20 1 B 1.50 SERVER RM. RECEPT. 1.00 20 1 B 1.50 SERVER RM. RECEPT. 1.00 20 1 C 2 20 1.50 SERVER RM. RECEPT. 1.00 20 1 B 20 1 B 1.50 SERVER RM. RECEPT. 1.00 20 1 B 20 1 SERVER RM. RECEPT. 1.50 SERVER RM.				1.50		00	_	В	1	20					
ECEPT. 1.00 20 1 C SERVER RM. RECEPT. ECEPT. 1.00 20 1 B SERVER RM. RECEPT. 1.00 20 1 B SERVER RM. RECEPT. 1.00 20 1 B SERVER RM. RECEPT. 1.00 20 1 C 2 20 SERVER RM. RECEPT. 1.00 20 1 B 20 1 SERVER RM. RECEPT. 1.50 SERVER	FOLL BECSES	DICEATO	4.50	000000000000000000000000000000000000000		20	2	_	_					The second control of	
ECEPT. 1.00 20 1 C SERVER RM. RECEPT. ECEPT. 1.00 20 1 B SERVER RM. RECEPT. 1.50 SERVER RM. RECEPT. 1.	TCH RECEPT	DISPATCH RE	1.50		1.50			А		20				OFARE	
ECEPT. 1.00 20 1 C SERVER RM. RECEPT. ECEPT. 1.00 20 1 B 1.50 SERVER RM. RECEPT. ECEPT. 1.00 20 1 B 1.50 SERVER RM. RECEPT. ECEPT. 1.00 20 1 C 2 20 1.50 SERVER RM. RECEPT. 20 1 B 2 20 1.50 SERVER RM. RECEPT. 20 1 C 1.50 SERVER RM. RECEPT. 20 1 C 1.50 SERVER RM. RECEPT. 20 1 B 2 20 1.50 SERVER RM. RECEPT. 20 1 B 2 20 1.50 DISPATCH RECEPT. 20 1 B 1.50 DISPATCH RECEPT. 20 1 A 1.50 DISPATCH RECEPT. 20 1 A 1.50 DISPATCH RECEPT. 20 1 A 1.50 DISPATCH RECEPT.			1.50	1.50	1.50	20	2	R	1	20				SPARE	50
ECEPT. 1.00 20 1 C SERVER RM. RECEPT. ECEPT. 1.00 20 1 B SERVER RM. RECEPT. 1.50 SERVER RM. RECEPT				1.50	1.50	20	2				0.50			SPARE SMOKE DAMPER	
ECEPT. 1.00 20 1 C SERVER RM. RECEPT. 1.00 20 1 B 1.50 SERVER RM. RECEPT. 1.00 20 1 B 1.50 SERVER RM. RECEPT. 1.00 20 1 B 1.50 SERVER RM. RECEPT. 1.00 20 1 A 1.50 SERVER RM. RECEPT. 1.00 20 1 B 2 20 1.50 SERVER RM. RECEPT.	TCH RECEPT	DISPATCH RE		1.50				С	1	20	0.50		0.50	SPARE SMOKE DAMPER SMOKE DAMPER	60
ECEPT. 1.00 20	TCH RECEPT	DISPATCH RE						C A B	1	20 20		1.00	0.50	SMOKE DAMPER	60 61 62
	RM. RE	SERVER RM. RE	1.50	1.50	1.50	20 20 20	2 2 2	B C A B C A B	1 1 1 1 1 1	20 20 20 20 20 20 20 20	1.00	1.00	1.00	DISPATCH RECEPT.	44 45 46 47 48 49
ECEPT. 1.00 20 1 C 1.50	RM. RECEPT	SERVER RM. RE			1.50	20	2	-					1.00		
ECEPT. 1.00 20 1 C 1.50				1.50				_	1	20		1.00			
ECEPT. 1.00 20 1 C 1.50 ECEPT. 1.00 20 1 A 2 20 1.50 SERVER RM. RECEPT.	RM. RECEPT	SERVER RM. RE	1.50			20	2	С	1		1.00				
ECEPT. 1.00 20 1 C 1.50 SERVER RM. RECEPT. ECEPT. 1.00 20 1 A 2 20 1.50 SERVER RM. RECEPT. ECEPT. 1.00 20 1 B 1.50 1.50 SERVER RM. RECEPT. ECEPT. 1.00 20 1 C 2 20 1.50 SERVER RM. RECEPT.					1.50			Α	1					T-201 T-201 W	
ECEPT. 1.00 20 1 C 1.50 ECEPT. 1.00 20 1 A 2 20 1.50 SERVER RM. RECEPT. ECEPT. 1.00 20 1 B 1.50 SERVER RM. RECEPT. ECEPT. 1.00 20 1 C 2 20 1.50 SERVER RM. RECEPT. 20 1 A 1.50 1.50 SERVER RM. RECEPT.	RM. RECEPT	SERVER RM. RE		1.50		20	2	1000							
ECEPT. 1.00 20 1 C 1.50 ECEPT. 1.00 20 1 A 2 20 1.50 SERVER RM. RECEPT. ECEPT. 1.00 20 1 B 1.50 1.50 SERVER RM. RECEPT. ECEPT. 1.00 20 1 C 2 20 1.50 SERVER RM. RECEPT. 20 1 B 2 20 1.50 SERVER RM. RECEPT.	TCH DECEDT	DISDATCH DE	1.50		1.50	20	2	-							
ECEPT. 1.00 20 1 C 1.50 SERVER RM. RECEPT. ECEPT. 1.00 20 1 A 2 20 1.50 SERVER RM. RECEPT. ECEPT. 1.00 20 1 B 1.50 SERVER RM. RECEPT. ECEPT. 1.00 20 1 C 2 20 1.50 SERVER RM. RECEPT. 20 1 B 2 20 1.50 SERVER RM. RECEPT. 20 1 B 2 20 1.50 SERVER RM. RECEPT. 20 1 C 1.50 SERVER RM. RECEPT.				1.50				-	1	-					
ECEPT. 1.00 20 1 C SERVER RM. RECEPT. 1.00 20 1 B 1.50 SERVER RM. RECEPT. 1.00 20 1 B 1.50 SERVER RM. RECEPT. 1.00 20 1 C 2 20 1.50 SERVER RM. RECEPT. 1.00 20 1 B 20 1 B 1.50 SERVER RM. RECEPT. 1.00 20 1 B 20 1 SERVER RM. RECEPT. 1.50 SERVER RM.						20	2	С	1	20				SPARE	57
ECEPT. 1.00 20 1 C SERVER RM. RECEPT. 1.00 20 1 B SERVER RM. RECEPT. 1.00 20 1 B SERVER RM. RECEPT. 1.00 20 1 C 2 20 SERVER RM. RECEPT. 1.50 SERVER RM	TCH RECEPT	DISPATCH RE		1.50				С	1	20	0.50		0.50	SMOKE DAMPER	60
ECEPT. 1.00 20	TCH RECEPT	DISPATCH RE						C A	1	20 20	0.50		0.50	SMOKE DAMPER SMOKE DAMPER	60 61
ECEPT. 1.00 20	TCH RECEPT	DISPATCH RE						C A	1	20 20	0.50	1.00	0.50	SMOKE DAMPER SMOKE DAMPER	60 61
ECEPT. 1.00 20	TCH RECEPT	DISPATCH RE					2	C A B	1	20 20		1.00	0.50	SMOKE DAMPER SMOKE DAMPER	60 61
	F	SERVER SERVER SERVER SERVER SERVER	1.50	1.50 1.50 1.50	1.50 1.50 1.50	AKER AMPS 20 20 20 20 20 20 20 20 20 20 20 20 20	BREA POLES 2 2 2 2 2 2 2 2	A B C A B C A B C A B C A B C C A B C C A C B C C A C C A C C C C	AKER POLES 1 1 1 1 1 1 1 1 1 1 1 1 1 1 1 1 1 1	BRE/ AMPS 20 20 20 20 20 20 20 20 20 20 20 20 20	1.00	1.00 1.00	1.00	LOAD DESCRIPTION DISPATCH RECEPT. SPARE SPARE SPARE SPARE SPARE	NO. 43 44 45 46 47 48 49 50 51 52 53 54 55 56 57

	VOLTS: 208Y/120 MAIN: 225A		PHASE: WIRE:	4									MOUNTING: SURFACE K.A.I.C: 22	
	NEUTRAL: 100%	FED	FROM:	PANEL	BOARD	"XLDPE	3"					MAII	N BREAKER: NONE	
CKT			KVA		BRE	AKER		BRE	AKER		KVA			C
NO.	LOAD DESCRIPTION	PH. A	PH. B	PH. C	AMPS	POLES	PH	POLES	AMPS	PH. A	PH. B.	PH. C		1
1	WAITING RM. RECEPT.	1.00			20	1	Α	1	20	1.00			TRAINING RM. RECEPT.	_
2	REC. OFFICE RECEPT.	<u> </u>	1.00	4.50	20	1	В	1	20		1.00	4.00	TRAINING RM. RECEPT.	_
3	COPIER RECEPT.	4.00		1.50	20	1	C	1	20	4.00		1.00	TRAINING RM. RECEPT.	_
4	OFFICE RECEPT. OFFICE RECEPT.	1.00	1.00		20 20	1	A B	1	20 20	1.00	1.00		TRAINING RM. RECEPT. TRAINING RM. RECEPT.	_
6	CORR. RECEPT.		1.00	1.00	20	1	С	1	20		1.00	1.00	TRAINING RM. RECEPT.	-
7	OFFICE RECEPT.	1.00		1.00	20	1	A	1	20	1.00		1.00	MOTORIZED SCREEN	-
8	OFFICE RECEPT.		1.00		20	1	В	1	20		1.00		PROJECTOR	_
9	OFFICE RECEPT.			1.00	20	1	С	1	20				SPARE	
10	OFFICE RECEPT.	1.00			20	1	Α	1	20	1.00			TRAINING RM. RECEPT.	
11	OFFICE RECEPT.		1.00	4.00	20	1	В	1	20		1.00	4.00	TRAINING RM. RECEPT. TRAINING RM. RECEPT.	
12	JAN. MISC./RECEPT. OFFICE RECEPT.	1.00		1.00	20	1	C A	1	20	1.00		1.00	TRAINING RM. RECEPT.	
0.0	TLT. MISC./RECEPT.	1.00	1.00		20	1	В	1	20	1.00	1.00		TRAINING RM. RECEPT.	+
14 15	TLT. MISC./RECEPT.		1.00	1.00	20	1	С	1	20		1.00	1.00	TRAINING RM. RECEPT.	_
16	HAND DRYER	1.50			20	1	A	1	20	1.00		1.00	MOTORIZED SCREEN	-
17	HAND DRYER	1.00	1.50		20	1	В	1	20		1.00		PROJECTOR	7.0
18	CORR. RECEPT.			1.00	20	1	С	1	20				SPARE	
19	SPARE				20	1	Α	1	20	1.00			LOUNGE RECEPT.	_
20	SPARE				20	1	В	1	20		1.00	4.55	LOUNGE RECEPT	-
21	SPARE		<u> </u>		20	1	С	1	20			1.00	STOR. RM. RECEPT.	
CKT.	LOAD DESCRIPTION	PH. A	KVA PH. B	PH. C		AKER POLES	PH		AKER AMPS	PH. A	KVA PH. B.	PH. C	LOAD DESCRIPTION	C
	BRK. RM. RECEPT.	1.00	111.5	111.0	20	1	Α	1	20	1.00	11,0	111.0	BREAK RM. RECEPT.	÷
	BUNK RM. RECEPT.		1.00		20	1	В	1	20		1.00		BREAK RM. RECEPT.	_
45	BUNK RM. RECEPT.			1.00	20	1	С	1	20			1.50	REFRIG. RECEPT.	
	REFRIG. RECEPT.	1.50			20	1	Α	1	20	1.50			KIT. CTR. RECEPT.	_
	KIT. CTR. RECEPT. KIT. CTR. RECEPT.	 	1.50	1.50	20	1	В	1	20		1.50	1 50	KIT. CTR. RECEPT. ICE MACH. RECEPT.	_
	MICROWAVE	1.50		1.50	20	1	C A	1	20			1.50	SPACE	_
	VENDING MACH.	1.00	1.50		20	1	В	1	20				SPACE	_
51	VENDING MACH.			1.50	20	1	С	1	20				SPACE	
	CORR. RECEPT.				20	1	Α	1	20				SPACE	-
	WASHING MACHINE	<u> </u>			20	1	В	1	20				SPACE	_
	SPARE SPARE				20	1	C A	1	20				SPACE SPACE	_
	SPARE				20	1	В	1	20				SPACE	-
	SPARE				20	1	С	1	20				SPACE	_
	CLOTHES DRYER	2.50			30	2	Α	1	20				SPACE	-
59	ELEO BANCE		2.50	4.00		_	В	1	20				SPACE	_
60	ELEC. RANGE	4.00		4.00	50	2	C	1	20				SPACE SPACE	_
61	ELEC. RANGE	4.00	4.00		50	2	A B	1	20				SPACE	_
61 62				4.00			С	1	20				SPACE	_
	REMARKS:			•		-		-	•					_
62	REMARKS.													
62	NEW/WWO.													_
62	TALIMATIO.					PANE	L ")	KLBB'						
62	TEMPUTO.									SEN44 NIE	1////		48.5	
62	TOTAL CONNECTED LO	AD - KV	A:						TOTAL [JEMANL	- NVA.			
62		AD - KV	A:							DEMANL EMAND -			134.8	
62	TOTAL CONNECTED LO	AD - KV	A:	26.5				TC	OTAL DE	MAND -	AMPS:		134.8	
62	TOTAL CONNECTED LO PHASE A: PHASE B:	AD - KV	A:	26.5	1			TC	OTAL DE		AMPS:			
62	TOTAL CONNECTED LO	AD - KV	A:		1			TC	SPARE	EMAND -	AMPS: TY - %:		134.8	
62	TOTAL CONNECTED LO PHASE A: PHASE B: PHASE C:		A:	26.5 26.5				TC	SPARE	EMAND - CAPACI AL LOAD	AMPS: TY - %:) - KVA:		134.8 25% 60.6	
62	TOTAL CONNECTED LO PHASE A: PHASE B:		A :	26.5				TC	SPARE	EMAND -	AMPS: TY - %:) - KVA:		134.8	

MARK		VOLTS/				RATI	NG	CIRCUIT	BRANCH CIRCUIT	(1)	DISC. SW./	
NO.	EQUIPMENT DESCRIPTION	PHASE	FLA (A)	MCA	MOCP	SIZE	UNITS	(PNL NO.)	CONDUCTORS	CONDUIT(S)	FUSE (2)	NOTES
RTU-1	ROOF TOP A/C UNIT	480/3	104.5	119.2	150.0	50.0	TON	XHDPA-3	(3)-#1, (1)-#6(G)	(1) - 1 1/2"	W/EQUIP	ROOF
RTU-2	ROOF TOP A/C UNIT	480/3	33.8	43.5	50.0	15.0	TON	HC-15	(3)-#6, (1)-#10(G)	(1) - 1"	W/EQUIP	ROOF
RTU-3	ROOF TOP A/C UNIT	480/3	59.6	73.4	90.0	25.0	TON	XHDPB-3	(3)-4, (1)-#8(G)	(1) - 1 1/4"	W/EQUIP	ROOF
VAV	VAV TERMINATL UNIT	277				SEE DWG	KW	SEE DWG	(1)-#12, (1)-#12(N), (1)-#12(G)	(1) - 3/4"	20A1P MMS	
VAV	VAV TERMINATL UNIT	480/3				SEE DWG	KW	SEE DWG	(3)-#12, (1)-#12(G)	(1) - 3/4"	20A3P MMS	
CU-1	H.P. CONDENSING UNIT	208/1	19.5	25.0	40.0	3.0	TON	XLDPB-3	(2)-#8, (1)-#10(G)	(1) - 3/4"	60A2P	ROOF
DSS-1	BLOWER UNIT	208/1	1.0	1.3	15.0			XLDPB-1	(2)-#12, (1)-#12(G)	(1) - 3/4"	20A2P MMS	
CU-2	H.P. CONDENSING UNIT	208/1	19.5	25.0	40.0	3.0	TON	XLDPB-4	(2)-#8, (1)-#10(G)	(1) - 3/4"	60A2P	ROOF
DSS-2	BLOWER UNIT	208/1	1.0	1.3	15.0			XLDPB-2	(2)-#12, (1)-#12(G)	(1) - 3/4"	20A2P MMS	
EWH-1	ELEC. WATER HEATER	480/3	36.1	45.2	50.0	30.0	KW	XHDPB-4	(3)-#6, (1)-#10(G)	(1) - 1"	60A3P	
EWH-2	ELEC. WATER HEATER	480/3	6.0	7.5	20.0	5.0	KW	XHB-21	(3)-#12, (1)-#12(G)	(1) - 3/4"	30A3P	
EWH-3	ELEC. WATER HEATER	480/3	6.0	7.5	20.0	5.0	KW	HC-16	(3)-#12, (1)-#12(G)	(1) - 3/4"	30A3P	
EWH-4	ELEC. WATER HEATER	480/3	18.1	22.6	30.0	15.0	KW	XHPA-26	(3)-#10, (1)-#10(G)	(1) - 3/4"	30A3P	
EWH-5	ELEC. WATER HEATER	480/3	6.0	7.5	20.0	5.0	KW	XHPA-25	(3)-#12, (1)-#12(G)	(1) - 3/4"	30A3P	
EUH	ELEC. UNIT HEATER	480/3	6.0	7.5	20.0	5.0	KW	SEE DWG	(3)-#12, (1)-#12(G)	(1) - 3/4"	30A3P	
AC-1	AIR COMPRESSOR	480/3	14.0	17.5	20.0	10.0	HP	XHPA-23	(3)-#10, (1)-#10(G)	(1) - 3/4"	30A3P	
CASC	CASCADE MACHINE	480/3	14.0	17.5	20.0	10.0	HP	XHPA-24	(3)-#10, (1)-#10(G)	(1) - 3/4"	30A3P	
LIFT	VEHICLE LIFT	208/1	15.0	18.8	30.0	2.0	HP	XLAB-71	(2)-#10, (1)-#10(G)	(1) - 3/4"	30A2P	
CU-3	H.P. CONDENSING UNIT	208/1	14.8	19.0	30.0	2.0	TON	XLAA-80	(2)-#10, (1)-#10(G)	(1) - 3/4"	30A2P	ROOF
DSS-3	BLOWER UNIT	208/1	0.5					XLAA-78	(2)-#12, (1)-#12(G)	(1) - 3/4"	20A2P MMS	
CU-4	H.P. CONDENSING UNIT	208/1	14.8	19.0	30.0	2.0	TON	XLAB-75	(2)-#10, (1)-#10(G)	(1) - 3/4"	30A2P	ROOF
DSS-4	BLOWER UNIT	208/1	0.5					XLAB-73	(2)-#12, (1)-#12(G)	(1) - 3/4"	20A2P MMS	
CU-5	H.P. CONDENSING UNIT	208/1	14.8	19.0	30.0	2.0	TON	XLAB-79	(2)-#10, (1)-#10(G)	(1) - 3/4"	30A2P	ROOF
DSS-5	BLOWER UNIT	208/1	0.5					XLAB-77	(2)-#12, (1)-#12(G)	(1) - 3/4"	20A2P MMS	
RTU-4	ROOF TOP A/C UNIT	480/3		32.0	35.0	4.0	TON	XHPA-29	(3)-#8, (1)-#10(G)	(1) - 3/4"	W/EQUIP	ROOF
RTU-5	ROOF TOP A/C UNIT	480/3		32.0	35.0	4.0	TON	XHPA-30	(3)-#8, (1)-#10(G)	(1) - 3/4"	W/EQUIP	ROOF
RTU-6	ROOF TOP A/C UNIT	480/3		63.2	70	10.0	TON	MHDP-3	(3)-#4, (1)-#8(G)	(1)-1 1/4"	W/EQUIP	ROOF

				PA	NEL "I	HC"		SEC	T. #1					
	VOLTS: 480Y/277	F	PHASE:	3									MOUNTING: SURFACE	
	MAIN: 225A		WIRE:	4									K.A.I.C: 22	
	NEUTRAL: 100%	FED	FROM:	ELEC.	SVCE. F	PANEL "	MHE	P"				MAIN	BREAKER: 225A3P	
CKT.			KVA		BRE	AKER		BREA	KER		KVA			CKT
NO.	LOAD DESCRIPTION	PH. A	PH. B	PH. C	AMPS	POLES	PH	POLES	AMPS	PH. A	PH. B.	PH. C	LOAD DESCRIPTION	NO
1	WAITING LTG.	0.90			20	1	Α	3	50	9.00			PANELBOARD "LC"	14
2	CORR./MISC./TLT. LTG.		1.40		20	1	В				9.00		VIA 30KVA XFMR.	
3	OFFICE LTG.			1.20	20	1	С					9.00		
4	SPARE				20	1	Α	3	50	12.00			ROOF-TOP-UNIT	15
5	SPARE				20	1	В				12.00		RTU-2	2
6	SPARE				20	1	С					12.00		
7	VAV TERM. UNIT 2.06	1.50			20	1	Α	3	20	1.67			ELEC. WATER HEATER	16
8	SPARE				20	1	В				1.67		EWH-3	3
9	SPARE				20	1	С					1.67		
10	VAV TERM. UNITS	3.67			20	3	Α	3	50				SPARE	17
	2.01, 2.03		3.67				В							
				3.67			С							
11	VAV TERM. UNITS	3.33			20	3	Α	3	20				SPARE	18
	2.02, 2.04		3.33				В							
				3.33			С							
12	VAV TERM. UNITS	3.33			20	3	Α	3					SPACE	19
	2.07, 2.08, 2.09		3.33				В							
				3.33			С							
13	VAV TERM. UNITS	2.83			20	3	Α	3					SPACE	20
	2.10, 2.11, 2.12		2.83				В							
				2.83			С							

PANEL "HC"

112.5

TOTAL DEMAND - KVA: TOTAL DEMAND - AMPS:

SPARE CAPACITY - %:

TOTAL LOAD - KVA: TOTAL LOAD - AMPS:

TOTAL CONNECTED LOAD - KVA:

TOTAL CONNECTED LOAD:

PHASE A: PHASE B:


PHASE C:

				PAN	EL "XI	_AC"		SEC	T. #1					
	VOLTS: 208Y/120	F	PHASE:	3									MOUNTING: SURFACE	
	MAIN: 225A		WIRE:	4									K.A.I.C: 22	
	NEUTRAL: 100%	FED	FROM:	PANEL	BOARD	"XLDPA	."					MAIN	BREAKER: NONE	
CKT.			KVA		BREA	KER		BREA	KER		KVA			CK
NO.	LOAD DESCRIPTION	PH. A	PH. B	PH. C	AMPS	POLES	PH	POLES	AMPS	PH. A	PH. B.	PH. C	LOAD DESCRIPTION	N
1	SHELL SPC. RECEPT.	1.00			20	1	Α	1	20				SPARE	2
2	SHELL SPC. RECEPT.		1.00		20	1	В	1	20				SPARE	2
3	SHELL SPC. RECEPT.			1.00	20	1	С	1	20				SPARE	
4	TRAINING RM. RECEPT.	1.00			20	1	Α	1	20				SPARE	
5	TRAINING RM. RECEPT.		1.00		20	1	В	1	20				SPARE	2
6	TRAINING RM. RECEPT.			1.00	20	1	С	1	20				SPARE	
7	TRAINING RM. RECEPT.	1.00			20	1	Α	1	20				SPARE	
8	TRAINING RM. RECEPT.		1.00		20	1	В	1	20				SPARE	
9	TRAINING RM. RECEPT.			1.00	20	1	С	1	20				SPARE	
10	TRAINING RM. RECEPT.	1.00	4 00		20	1	Α	1	20				SPARE	_
11	TRAINING RM. RECEPT.		1.00		20	1	В	1	20				SPARE	
	SPARE TRAINING RM. RECEPT.	4.00			20	1	C	1	20 20				SPARE SPARE	
13		1.00	4.00		20	1	A	1						
14	TRAINING RM. RECEPT. TRAINING RM. RECEPT.		1.00	4.00	20	1	В	1	20				SPARE	
15				1.00	20	1	С	1					SPARE	_
16	TRAINING RM. RECEPT.	1.00	4.00		20	1	Α	1	20				SPARE	
17	TRAINING RM. RECEPT.		1.00	4.00	20	1	В	1	20				SPARE	
18	TRAINING RM. RECEPT.	1.00		1.00	20	1	C	1	20				SPARE	
19 20	TRAINING RM. RECEPT. TRAINING RM. RECEPT.	1.00	1.00		20	1	A B	1	20				SPARE SPARE	
	SPARE		1.00	1.00	20	1	С	1	20				SPARE	
41	OI /IIIL			1.00	20				20				OI AILE	1 7

		PANEL "XLAC"	
TOTAL CONNECTED LOAD - KVA:		TOTAL DEMAND - KVA:	9.5
		TOTAL DEMAND - AMPS:	26.4
PHASE A:	7.0		
PHASE B:	7.0	SPARE CAPACITY - %:	25%
PHASE C:	6.0		
	<u></u>	TOTAL LOAD - KVA:	11.9
TOTAL CONNECTED LOAD:	20.0	TOTAL LOAD - AMPS:	33.0

				PA	NEL"	LC"		SEC	T. #1					
	VOLTS: 208Y/120	F	PHASE:										MOUNTING: SURFACE	
	MAIN: 125A	0-10-10 v	WIRE:									new 2001 Dec 20029 Til	K.A.I.C: 10	
	NEUTRAL: 100%	FED	FROM:									MAIN	BREAKER: NONE	
KT.			KVA		BRE	AKER		BRE	AKER		KVA			С
10.	LOAD DESCRIPTION	PH. A	PH. B	PH. C		POLES	PH	POLES		PH. A	PH. B.	PH. C	LOAD DESCRIPTION	N
1	WAITING RM. RECEPT.	1.00			20	1	Α	1	20	1.50			COPIER RECEPT.	+
2	WAITING RM. RECEPT.	1.00	1.00		20	1	В	1	20	1.00	1.00		WK. CTR. RECEPT.	. 1
3	WAITING RM. RECEPT.			1.00	20	1	С	1	20		1.00	1.00	FILE RM. RECEPT.	
4	PUBLIC TLT. RECEPT.	1.00			20	1	Α	1	20	1.00			OFFICE RECEPT.	,
5	HAND DRYER		1.50		20	1	В	1	20		1.00		CONF. RM. RECEPT.	. 2
6	HAND DRYER			1.50	20	1	С	1	20			1.00	CONF. RM. RECEPT.	. 2
7	PUBLIC TLT. RECEPT.	1.00			20	1	Α	1	20	1.00			JAN. MISC./RECEPT.	. 2
8	MOTORIZED DOOR		1.50		20	1	В	1	20		1.00		CORR. RECEPT.	. 2
9	SPARE				20	1	С	1	20			1.00	STAFF TLT. RECEPT.	. 2
10	CORR. RECEPT.	1.00			20	1	Α	1	20	1.50			HAND DRYER	2
11	REC. OFFICE RECEPT.		1.00		20	1	В	1	20		1.50		HAND DRYER	2
12	REC. OFFICE RECEPT.			1.00	20	1	С	1	20			1.00	STAFF TLT. RECEPT.	. 2
13	OFFICE RECEPT.	1.00			20	1	Α	1	20	1.00			BREAK RM. RECEPT.	. 2
14	OFFICE RECEPT.		1.00		20	1	В	1	20		1.50		REFRIG. RECEPT.	. 2
15	MISC./CORR. RECEPT.			1.00	20	1	С	1	20			1.50	BREAK RM. RECEPT.	. 3
	Г	ı	KVA	PA	NEL"	LC" AKER			T.#2 AKER		KVA			С
KT.			NVA				l		111					
	LOAD DESCRIPTION	PH. A		PH. C		POLES	PH			PH. A		PH. C	LOAD DESCRIPTION	
VO.		PH. A		PH. C			PH A			PH. A		PH. C	LOAD DESCRIPTION TLT. MISC./RECEPT.	N
NO. 31	LOAD DESCRIPTION			PH. C	AMPS	POLES			AMPS			PH. C	711 1 4 4 1 4 1 4 1 4 1 4 1 4 1 4 1 4 1	. A
NO. 31 32	LOAD DESCRIPTION BREAK RM. RECEPT.		PH. B	1.00	AMPS 20	POLES 1	Α		AMPS 20			PH. C	TLT. MISC./RECEPT.	. 4
31 32 33	LOAD DESCRIPTION BREAK RM. RECEPT. T.B.B. RECEPT.		PH. B		AMPS 20 20	POLES 1 1	A B	POLES 1 1	20 20			PH. C	TLT. MISC./RECEPT. SPARE	. 4
31 32 33 34	LOAD DESCRIPTION BREAK RM. RECEPT. T.B.B. RECEPT. T.B.B. RECEPT.	1.50	PH. B		20 20 20 20	POLES 1 1 1	A B C	POLES 1 1	20 20 20 20			PH. C	TLT. MISC./RECEPT. SPARE SPARE	N 2
32 33 34 35	LOAD DESCRIPTION BREAK RM. RECEPT. T.B.B. RECEPT. T.B.B. RECEPT. OFFICE RECEPT.	1.50	PH. B		20 20 20 20 20	POLES 1 1 1 1 1	A B C	POLES 1 1 1 1	20 20 20 20 20			PH. C	TLT. MISC./RECEPT. SPARE SPARE SPARE	N 2
31 32 33 34 35 36	LOAD DESCRIPTION BREAK RM. RECEPT. T.B.B. RECEPT. T.B.B. RECEPT. OFFICE RECEPT. LAB REFRIG. RECEPT.	1.50	PH. B	1.00	20 20 20 20 20 20 20	POLES 1 1 1 1 1 1 1	A B C A	POLES 1 1 1 1	20 20 20 20 20 20 20			PH. C	TLT. MISC./RECEPT. SPARE SPARE SPARE SPARE	N
31 32 33 34 35 36 37	LOAD DESCRIPTION BREAK RM. RECEPT. T.B.B. RECEPT. T.B.B. RECEPT. OFFICE RECEPT. LAB REFRIG. RECEPT. LAB RECEPT. LAB RECEPT. LAB RECEPT. LAB RECEPT.	1.50	PH. B	1.00	20 20 20 20 20 20 20 20 20 20	1 1 1 1 1 1	A B C A B C A B	POLES 1 1 1 1 1 1 1 1 1 1	20 20 20 20 20 20 20 20 20 20			PH. C	TLT. MISC./RECEPT. SPARE SPARE SPARE SPARE SPARE SPARE SPARE SPARE	N
31 32 33 34 35 36 37 38 39	LOAD DESCRIPTION BREAK RM. RECEPT. T.B.B. RECEPT. OFFICE RECEPT. LAB REFRIG. RECEPT. LAB RECEPT. LAB RECEPT. LAB RECEPT. LAB RECEPT. LAB RECEPT. LAB RECEPT.	1.00	1.00 1.50	1.00	20 20 20 20 20 20 20 20 20 20 20	POLES 1 1 1 1 1 1 1 1 1 1 1 1 1 1 1 1 1 1	A B C A B C A B	POLES 1 1 1 1 1 1 1 1 1 1 1 1 1	20 20 20 20 20 20 20 20 20 20 20	1.00		PH. C	TLT. MISC./RECEPT. SPARE SPARE SPARE SPARE SPARE SPARE SPARE SPARE SPARE	N
NO. 31 32 33 34 35 36 37 38 39 40	LOAD DESCRIPTION BREAK RM. RECEPT. T.B.B. RECEPT. OFFICE RECEPT. LAB REFRIG. RECEPT. LAB RECEPT. LAB RECEPT. LAB RECEPT. LAB RECEPT. LAB RECEPT. LAB RECEPT. OFFICE RECEPT.	1.50	1.00 1.50	1.00	20 20 20 20 20 20 20 20 20 20 20 20	POLES 1 1 1 1 1 1 1 1 1 1 1 1 1 1 1 1 1 1	A B C A B C A B C A	POLES 1 1 1 1 1 1 1 1 1 1 1 1	20 20 20 20 20 20 20 20 20 20		PH. B.	PH. C	TLT. MISC./RECEPT. SPARE SPARE SPARE SPARE SPARE SPARE SPARE SPARE	N
NO. 31 32 33 34 35 36 37 38 39 40	LOAD DESCRIPTION BREAK RM. RECEPT. T.B.B. RECEPT. OFFICE RECEPT. LAB REFRIG. RECEPT. LAB RECEPT. LAB RECEPT. LAB RECEPT. LAB RECEPT. LAB RECEPT. OFFICE RECEPT.	1.00	1.00 1.50	1.00	20 20 20 20 20 20 20 20 20 20 20 20 20	POLES 1 1 1 1 1 1 1 1 1 1 1 1 1 1 1 1 1 1	A B C A B C A B C A B C A B C	POLES 1 1 1 1 1 1 1 1 2	20 20 20 20 20 20 20 20 20 20 20 20	1.00		PH. C	TLT. MISC./RECEPT. SPARE T.B.B. RECEPT. 6-20R	N
NO. 331 332 333 334 335 336 337 338 339 440 441 442 443	LOAD DESCRIPTION BREAK RM. RECEPT. T.B.B. RECEPT. OFFICE RECEPT. LAB REFRIG. RECEPT. LAB RECEPT. LAB RECEPT. LAB RECEPT. LAB RECEPT. LAB RECEPT. COFFICE RECEPT. OFFICE RECEPT. OFFICE RECEPT. TLT. MISC./RECEPT. HAND DRYER	1.00	1.00 1.50	1.00	20 20 20 20 20 20 20 20 20 20 20 20 20 2	POLES 1 1 1 1 1 1 1 1 1 1 1 1 1 1 1 1 1 1	A B C A B C A B C A B C A B C A B C A B C	POLES 1 1 1 1 1 1 1 1 2 1 1 1 1 1 1 1 1 1 1	20 20 20 20 20 20 20 20 20 20 20 20 20	1.00	PH. B.	PH. C	TLT. MISC./RECEPT. SPARE SPACE SPACE	N A A A A A A A A A A A A A A A A A A A
NO. 31 32 33 34 35 36 37 38 39 40 41 42 43 44	LOAD DESCRIPTION BREAK RM. RECEPT. T.B.B. RECEPT. T.B.B. RECEPT. OFFICE RECEPT. LAB REFRIG. RECEPT. LAB RECEPT. LAB RECEPT. LAB RECEPT. LAB RECEPT. OFFICE RECEPT. OFFICE RECEPT. OFFICE RECEPT. CORR. RECEPT.	1.00	1.00 1.00 1.00	1.00	20 20 20 20 20 20 20 20 20 20 20 20 20 2	POLES 1 1 1 1 1 1 1 1 1 1 1 1 1 1 1 1 1 1	A B C A B C A B C A B C A B C A	POLES 1 1 1 1 1 1 1 1 2 1 1 1 1 1 1 1 1 1 1	20 20 20 20 20 20 20 20 20 20 20 20 20	1.00	PH. B.	PH. C	TLT. MISC./RECEPT. SPARE	
NO. 31 32 33 34 35 36 37 38 39 40 41 42 43 44	LOAD DESCRIPTION BREAK RM. RECEPT. T.B.B. RECEPT. OFFICE RECEPT. LAB REFRIG. RECEPT. LAB RECEPT. LAB RECEPT. LAB RECEPT. LAB RECEPT. CAB RECEPT. COFFICE RECEPT. OFFICE RECEPT. TLT. MISC./RECEPT. HAND DRYER HAND DRYER REMARKS:	1.00 1.00 1.00	1.00 1.50 1.00	1.00	20 20 20 20 20 20 20 20 20 20 20 20 20 2	POLES 1 1 1 1 1 1 1 1 1 1 1 1 1 1 1 1 1 1	A B C A B C A B C A B C A B C C A C A B C C A B C C A B C C A B C C A B C C C C	POLES 1 1 1 1 1 1 1 1 1 1 1 1 1 1 1 1 1 1	20 20 20 20 20 20 20 20 20 20 20 20 20 2	1.00	1.00		TLT. MISC./RECEPT. SPARE SPACE SPACE SPACE SPACE	N
NO. 331 332 333 334 335 336 337 338 339 440 441 442 443	LOAD DESCRIPTION BREAK RM. RECEPT. T.B.B. RECEPT. OFFICE RECEPT. LAB REFRIG. RECEPT. LAB RECEPT. LAB RECEPT. LAB RECEPT. LAB RECEPT. LAB RECEPT. OFFICE RECEPT. OFFICE RECEPT. OFFICE RECEPT. TLT. MISC./RECEPT. HAND DRYER HAND DRYER REMARKS:	1.00 1.00 1.00	1.00 1.50 1.00	1.00 1.00 1.00	AMPS 20 20 20 20 20 20 20 20 20 20 20 20 20	POLES 1 1 1 1 1 1 1 1 1 1 1 1 1 1 1 1 1 1	A B C A B C A B C A B C A B C C A C A B C C A B C C A B C C A B C C A B C C C C	POLES 1 1 1 1 1 1 1 1 1 1 1 1 1 1 1 1 1 1	20 20 20 20 20 20 20 20 20 20 20 20 20	1.00	1.00 1.00		TLT. MISC./RECEPT. SPARE SPACE SPACE	N
NO. 331 332 333 334 335 336 337 338 339 440 441 442 443	LOAD DESCRIPTION BREAK RM. RECEPT. T.B.B. RECEPT. OFFICE RECEPT. LAB REFRIG. RECEPT. LAB RECEPT. LAB RECEPT. LAB RECEPT. LAB RECEPT. CAB RECEPT. COFFICE RECEPT. OFFICE RECEPT. TLT. MISC./RECEPT. HAND DRYER HAND DRYER REMARKS:	1.00 1.00 1.00	1.00 1.50 1.00	1.00	AMPS 20 20 20 20 20 20 20 20 20 20 20 20 20	POLES 1 1 1 1 1 1 1 1 1 1 1 1 1 1 1 1 1 1	A B C A B C A B C A B C A B C C A C A B C C A B C C A B C C A B C C A B C C C C	POLES 1 1 1 1 1 1 1 1 1 1 1 1 1 1 T T T T T	20 20 20 20 20 20 20 20 20 20 20 20 20 2	1.00 1.00	1.00 1.00 1.07 - KVA:		TLT. MISC./RECEPT. SPARE SPACE SPACE SPACE SPACE	R



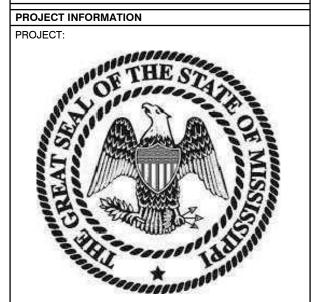

Lauderdale County Public Safety Building

PROJECT ADDRESS:

Village Fair Mall Site 612 22nd Avenue (Winn-Dixie / LabCorp Building)





FOR REVIEW ONLY
FOR PERMITTING ONLY

SCHEMATIC DESIGN
DESIGN DEVELOPMENT

ACTIVE DESIGN PHASE

REVISIONS/SUBMISSIONS		
NO.	DATE	DESCRIPTION
1	04/26/2021	ADDENDUM #2
2	04/30/2021	ADDENDUM #3

SHEET TITLE
Electrical Schedules

Schultz & Wynne

Consulting Electrical Engineers

A PROFESSIONAL ASSOCIATION

4523 Office Park Drive, Jackson, MS 39206

Post Office Box 16074, Jackson, MS 39236

TEL. 601-982-3313 FAX. 601-982-7685

S/W JOB NO: 220075

PROJECT NO.:

SHEET ISSUED: SHEET NO.

DRAWN BY:

DRAWN BY: