



06 December 2021

GS#610-012 MCM LeFleur's Bluff Park Improvements (Phase 1B)
Mississippi Department of Wildlife, Fisheries, and Parks



ADDENDUM NO. 03

NOTICE TO ALL DOCUMENT HOLDERS:

The following additions, deletions, changes and clarifications to the drawings and specifications are to be included as part of the Contract Documents.

CLARIFICATIONS

- ITEM NO. 01 Gate Install**
Gate and associated install (note found on C300) will not be included in scope of work.
- ITEM NO. 02 Trail / Exhibit / Monument Slab**
Reference 7/C600 for trail, exhibit pads, and monument slab detail.

ELECTRICAL

- ITEM NO. 03 E1.1 – Renovation Site Plan – 1B – Electrical**
REPLACE sheet with the attached **E1.1.**
Revises the boundary specifying where the work has been completed in Phase 1A.

Encl: **Drawings (1 Sheets - 24x36):**
E1.1 – Renovation Site Plan 1B

cc: All Document Holders
File 3517




MDWFP
Riverside Park Circle
Jackson, MS 39202

KEYED NOTES	
Mark	Description
①	FIXTURES PROVIDED BY OWNER.

NOTES:

ETR EXISTING DEVICE TO REMAIN. EXISTING CIRCUITRY TO REMAIN.

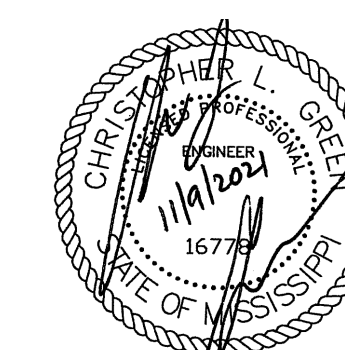

09 November 2021

**CONSTRUCTION
DOCUMENTS -
OWNER REVIEW**

WBA # 0619

REVISIONS		
NO.	DESCRIPTION	DATE

3 ADDENDUM 2021-12-01

RENOVATION SITE PLAN - 1B Scale: 1" = 60'-0"

E1.1
RENOVATION SITE
PLAN-1B