

BURRIS/WAGNON ARCHITECTS, P.A.


500L EAST WOODROW WILSON AVENUE JACKSON MS 39216 PH 6019697543 FAX 6019699374

13 January 2022

ADDENDUM NO. 1

Re: **GS# 354-050**
Tenant Improvement - DMH (1st, 2nd, 10th, 11th and 12th Floors)
Robert E. Lee Building
(Office of Capitol Facilities)
(Department of Finance and Administration)
Jackson, Mississippi

Bid Date: Thursday, January 27, 2022 (2:00 p.m.)

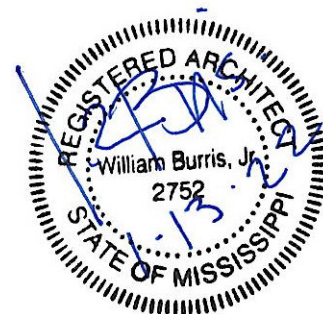

NOTICE TO ALL DOCUMENT HOLDERS:

The following additions, changes, and clarifications to the Specifications for the subject project are to be included as part of the Contract Documents, and thus amend the Scope of Work:

GENERAL

Item No. 1: A PRE-BID CONFERENCE WILL BE CONDUCTED on TUESDAY, JANUARY 18, 2022, 10:00 A.M., in the second floor lobby of the Robert E. Lee Building. Details of the project, and proper completion of the bid form, will be discussed at this meeting.

SPECIFICATIONS

Item No. 1: Refer to Section 10 14 00 and modify as follows: At 2.03 add subparagraph "C." as follows:

B. Cast Seal Plaque (Ballroom 1200):

1. General: Cast free from pits, gas holes, and warped surfaces.
2. Material: Cast bronze.
3. Size: 36" Diameter
4. Border: As shown on attached drawing herein (Exhibit "A")
5. Letter Style: As shown on attached drawing herein (Exhibit "A")
6. Mounting: Blind Stud Mount.
7. Artwork and Copy: As indicated on attached drawing herein (Exhibit "A")
8. Finishes:
 - a.) Background Finish: "Dark Oxide"
 - b.) Letters: Relieved Text, "Light Oxidized (+15%)" Bronze Finish.
9. Edge Condition: Return at edge to be $\frac{3}{4}$ " deep.

DRAWINGS

Item No. 1: Refer to Sheet 7.0, elevation "4", and modify as per attached Exhibit "A".

Item No. 2: Refer to Sheet 6.0, elevation "9", elevation "10" and section "19" and modify as per attached Exhibit "B".

No other items in this addendum.


Sincerely,

A handwritten signature in blue ink, appearing to read "B. Burris", is written over a light blue rectangular background.

Bill Burris, AIA

BURRIS/WAGNON ARCHITECTS, P.A.

End of Addendum No. 1

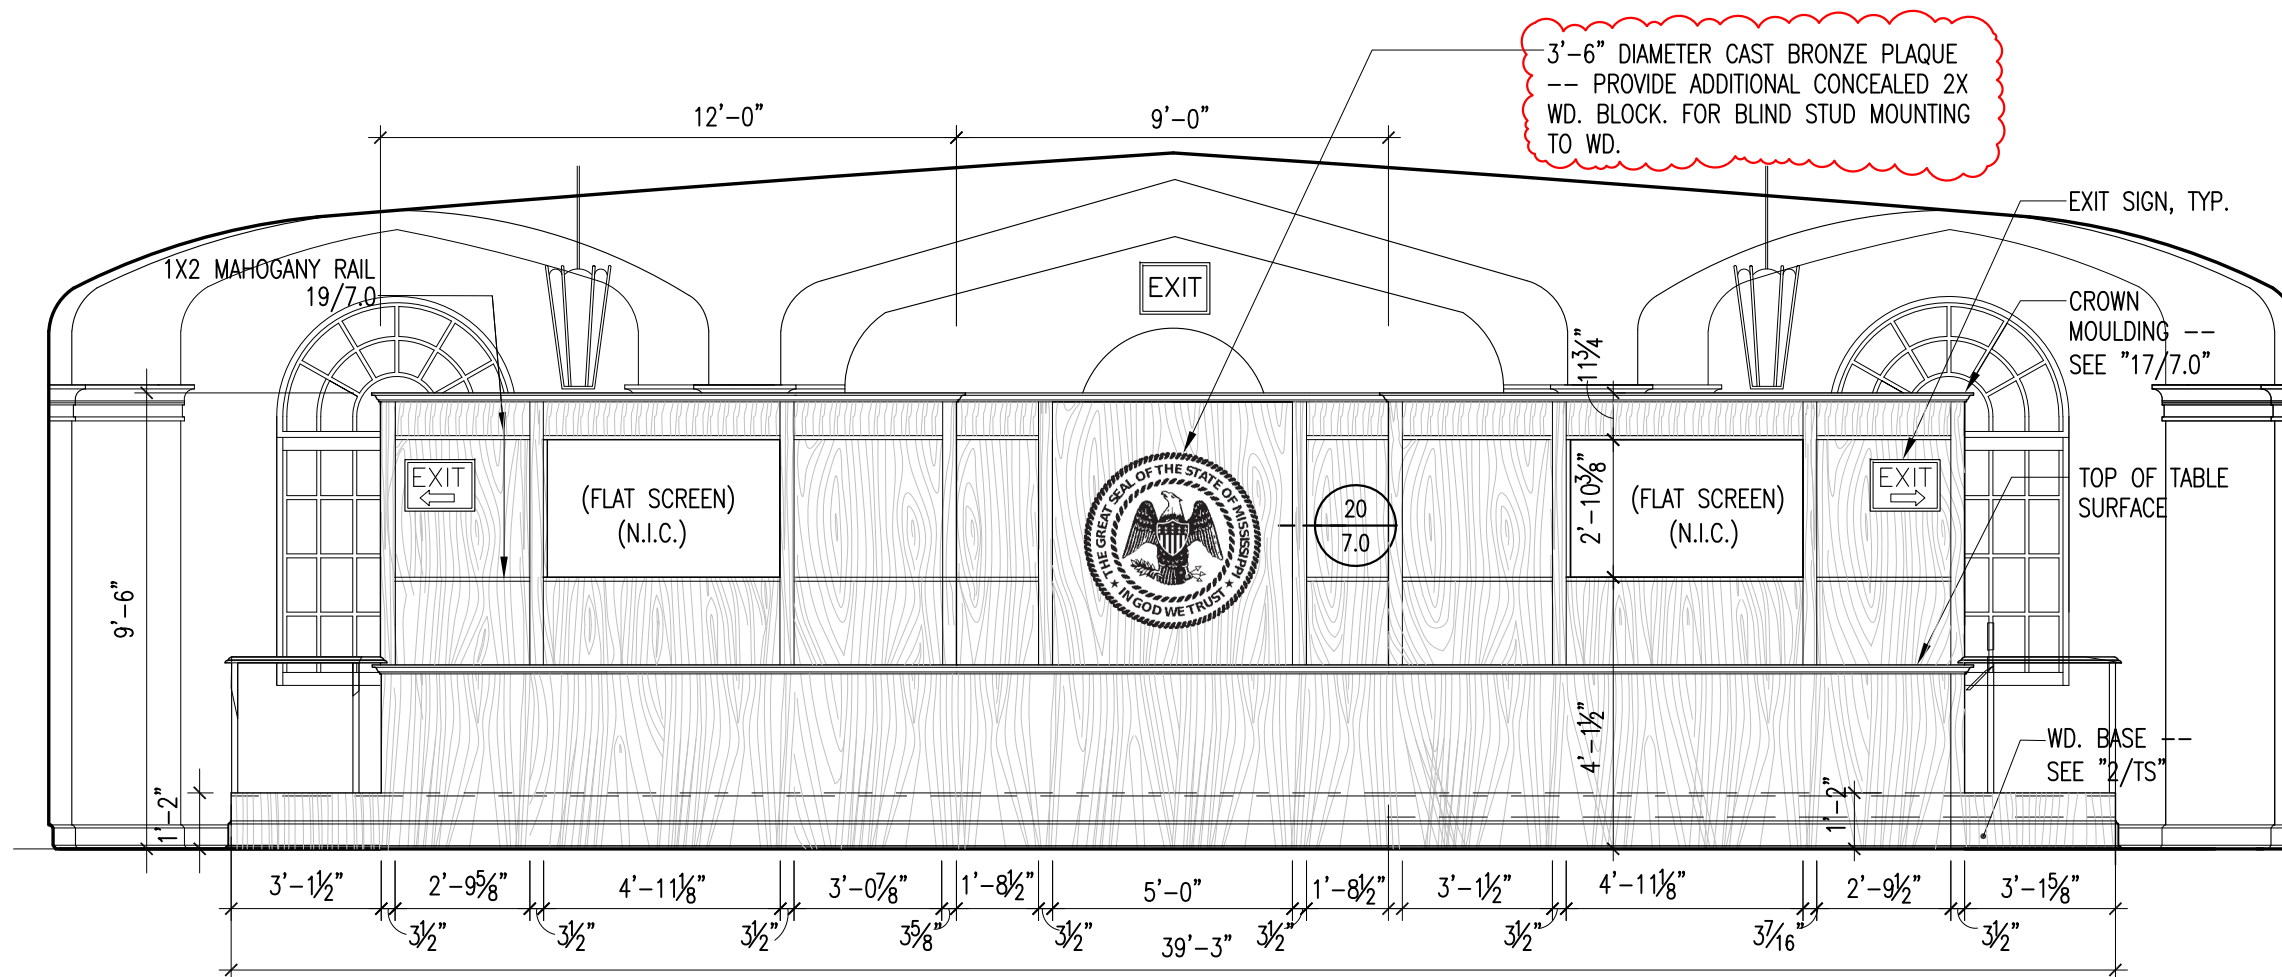

Revised West Side Interior Elev. Front View of Dais Facade

4
1/4"

14 September 2021

tenant improvement - DMH
robert e. lee building - (first, second, tenth, eleventh & twelfth floors)
(office of capitol facilities)
(dept. of finance and administration)
(jackson, mississippi)

GS #354-050 (PP003)

BURRIS/WAGNON ARCHITECTS, P.A.
 500L EAST WOODROW WILSON AVENUE JACKSON MS 39216 PH 6019697543 FAX 6019699374


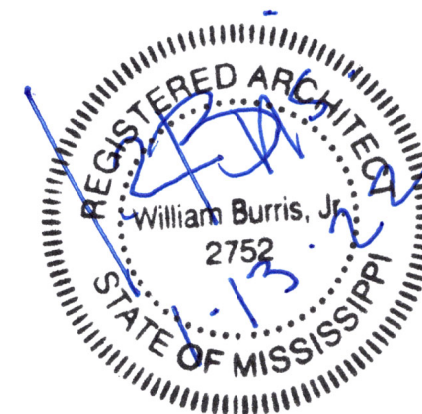



EXHIBIT "A"

SHEET 1 OF 1


(FROM DRAWINGS, SHEET "7.0")

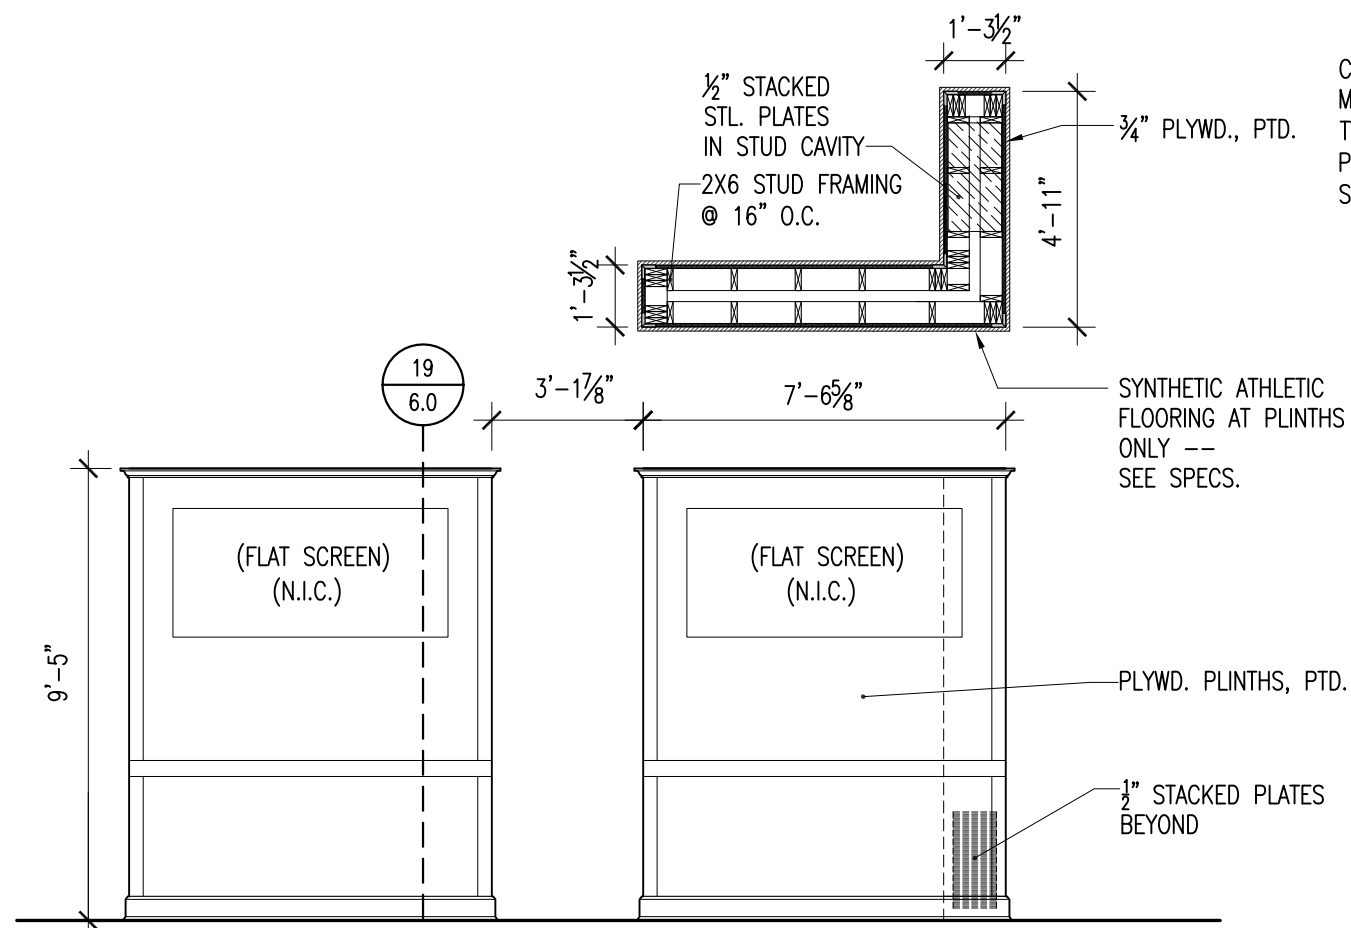

Revised West Side Interior Elev. Front View of Dais Facade 9
1/4"

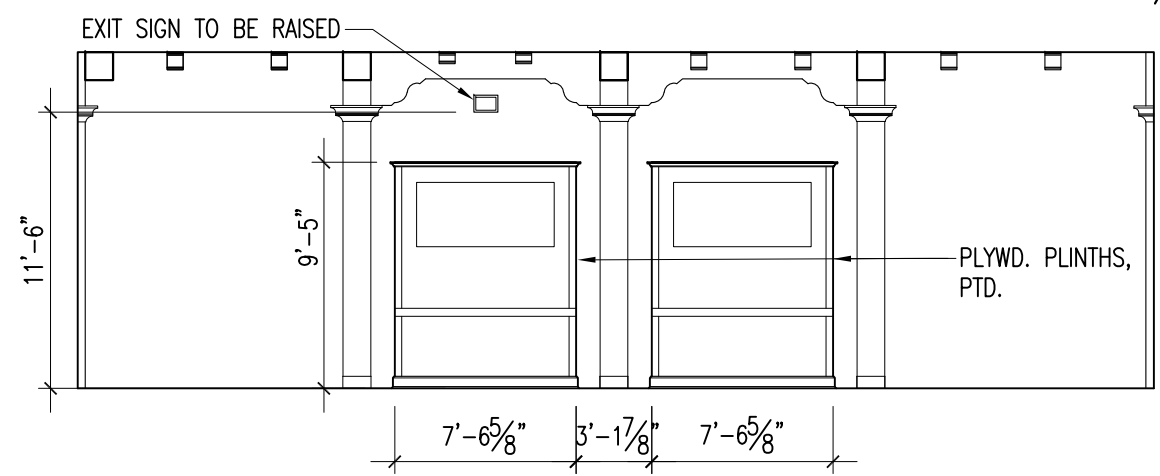

Revised Garden Room Interior Elevation 10
1/8"

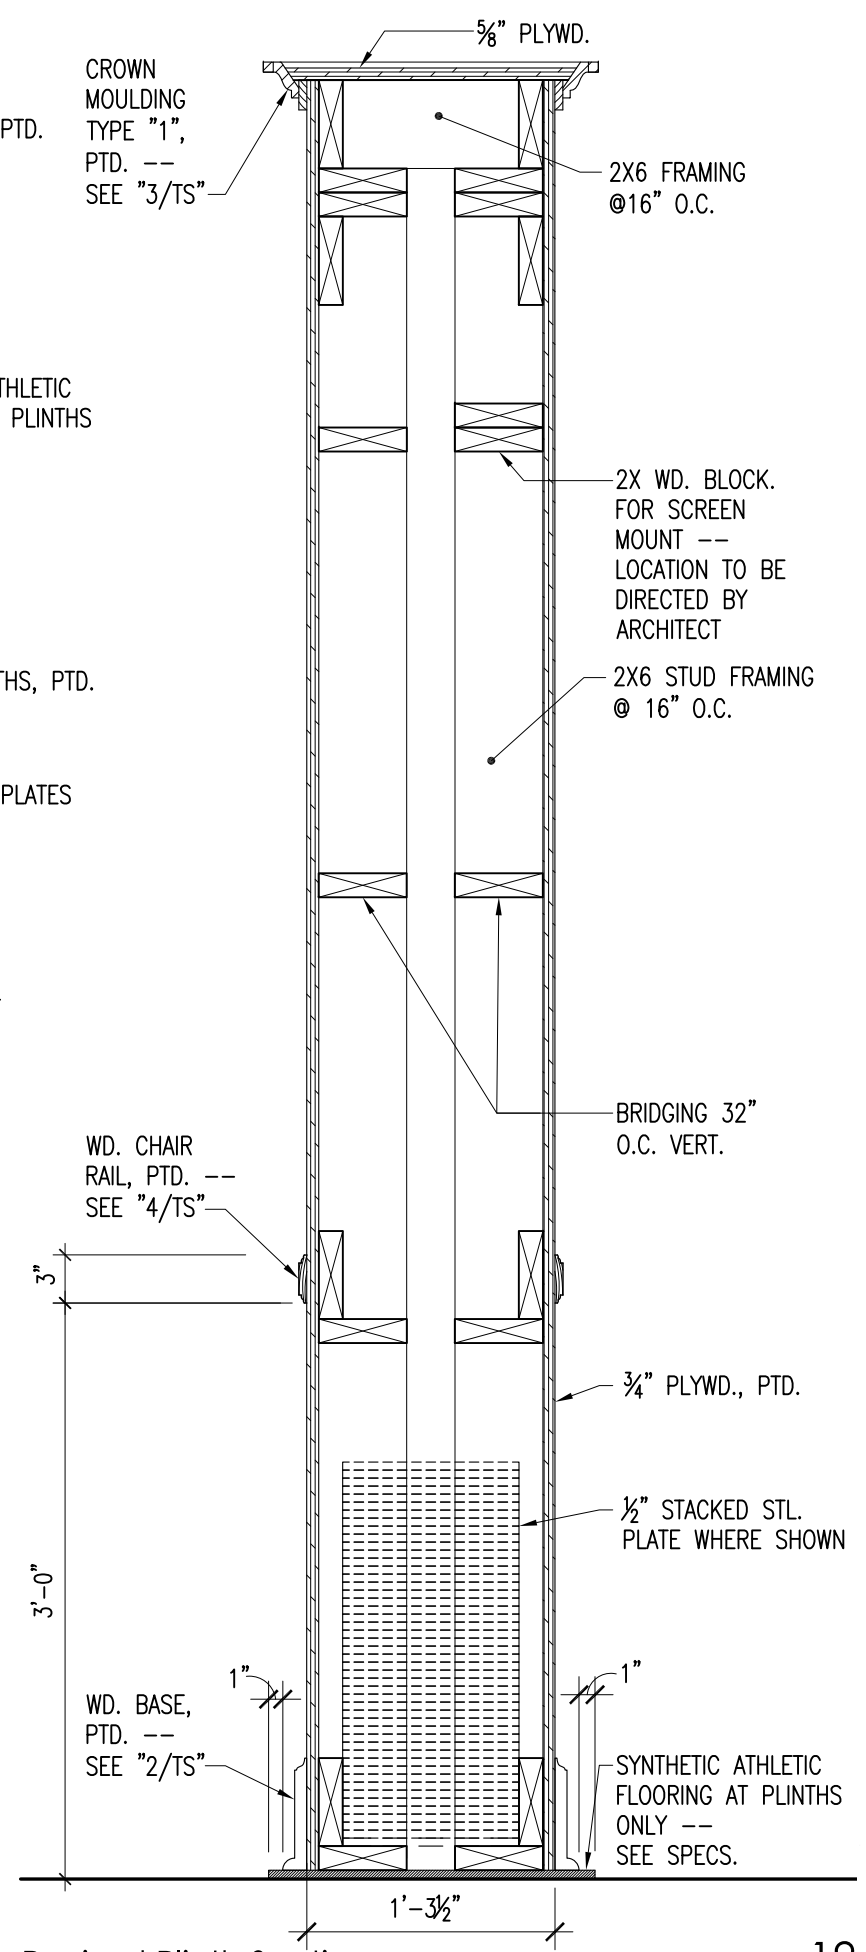

Revised Plinth Section 19
1"



EXHIBIT "B"
SHEET 1 OF 1
(FROM DRAWINGS, SHEET "6.0")