



Wednesday 09 February 2022

Baseball Field & Stadium Improvements  
Copiah-Lincoln Community College

---

## ADDENDUM NO. 02

### **NOTICE TO ALL DOCUMENT HOLDERS:**

The following additions, deletions, changes and clarifications to the drawings and specifications are to be included as part of the Contract Documents.

### **SPECIFICATIONS**

**ITEM NO. 01      SECTION 01.2300 ALTERNATES**  
**REPLACE** specification 01.2300 with the attached specification, **01.2300 Alternates** in its entirety.  
**Clarification:** Alternate descriptions have been revised to match the alternate descriptions in the drawings.

### **DRAWINGS**

**ITEM NO. 02      SHEET R100 – PROJECT INFO**  
**REPLACE** sheet R100 with the attached revised sheet **R100**.  
**Revises** Project Information to correctly show the Project Alternates.

**ITEM NO. 03      SHEET A123 – ENLARGED FLOOR PLAN & RCP – ALT #2**  
**REPLACE** sheet A123 with the attached revised sheet **A123**.

**ITEM NO. 04      SHEET A700 – PROJECT INFO**  
**REPLACE** sheet A700 with the attached revised sheet **A700**.

**ITEM NO. 05      SHEET E2.0 – DUGOUT ENLARGED POWER PLAN**  
**REPLACE** sheet E2.0 with the attached revised sheet **E2.0**.

Encl:    Specifications (8.5x11):  
          01.2300 ALTERNATES (1 page)  
          Drawings (4 Sheets - 24x36):  
          R101, A123, A700, E2.0

cc:        All Document Holders  
          File 21-053.C2



















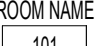

 

**Alternates****PART 1 GENERAL**



1. SECTION INCLUDES
  - A. Description of Alternates.
  - B. Procedures for pricing Alternates.
2. RELATED REQUIREMENTS
  - A. Document 00.2113 - Instructions to Bidders: Instructions for preparation of pricing for Alternates.
3. ACCEPTANCE OF ALTERNATES
  - A. Alternates quoted on Bid Forms will be reviewed and accepted or rejected at Owner's option. Accepted Alternates will be identified in the Owner-Contractor Agreement.
  - B. Coordinate related work and modify surrounding work to integrate the Work of each Alternate.
4. SCHEDULE OF ALTERNATES
  - A. Alternate No. 1 (ADD) - New Baseball Field Lighting: All labor, material and equipment to construct and ready for operation the work and all associated construction within the time stated and in strict accordance with the construction documents for the Baseball Field & Stadium.
  - B. Alternate No. 2 (ADD) - New Concrete Concourse with Chairback Seating; New Aluminum Bleacher System & Enclosure; New Pressbox Building; New Steel Shade Structure; Site Paving: All labor, material and equipment to construct and ready for operation the work and all associated construction within the time stated and in strict accordance with the construction documents for the Baseball Field & Stadium.
  - C. Alternate No. 3 (ADD) - New Entry Structure with Gate; New Masonry and Decorative Metal Fence; Site Paving and Entry Plaza; New Lighting at Sidewalks: All labor, material and equipment to construct and ready for operation the work and all associated construction within the time stated and in strict accordance with the construction documents for the Baseball Field & Stadium.
  - D. Alternate No. 4 (ADD) - New Concessions & Restroom Building; Extended Concrete Step Seating; Grass Berm Seating; Site Paving: All labor, material and equipment to construct and ready for operation the work and all associated construction within the time stated and in strict accordance with the construction documents for the Baseball Field & Stadium.

**PART 2 PRODUCTS - NOT USED****PART 3 EXECUTION - NOT USED****END OF SECTION**

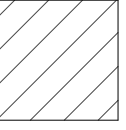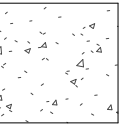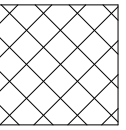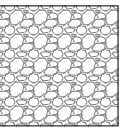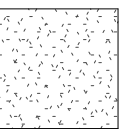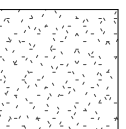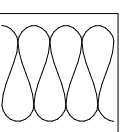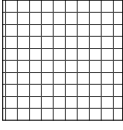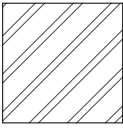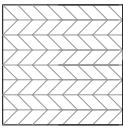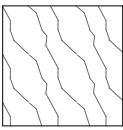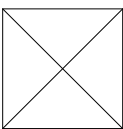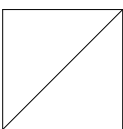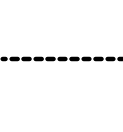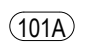

ARCHITECTURAL ABBREVIATIONS			
∠ & @ A/C ACM. ACOUS. ACT A/E A.F.F. A.H.U. ALT. ALUM. A.P.C. A.P. APPROX. ARCH. ASPH. ASY. ATTEN. A.V.	ANGLE AND AT AIR CONDITIONING ASBESTOS CONTAINING MATERIALS ACOUSTICAL ACOUSTICAL CEILING TILE ARCHITECT/ENGINEER ABOVE FINISHED FLOOR AIR HANDLING UNIT ALTERNATE ALUMINUM / ALUMINIUM ARCHITECTURAL PRECAST CONCRETE ACCESS PANEL APPROXIMATE ARCHITECTURAL ASPHALT ASSEMBLY ATTENTION AUDIO/VISUAL	K.O.  L.A.T. L.A.M. L.A.V. L.B.P. LBS. LT. LT. WT. L.V.R.	KNOCK DOWN  LAY-IN ACOUSTICAL TILE LAMINATE LAVATORY LEAD BASED PAINT POUNDS LIGHT LIGHT WEIGHT LOUVER
BD. BIT. BLDG. BLKG. BM. B.M. BOT. BRG. BRZ. BU B.U.R.	BOARD BITUMINOUS BUILDING BLOCKING BEAM BENCH MARK BOTTOM BEARING BRONZE BUILT-UP BUILT-UP ROOF	MAS. MAX. MECH. MEMB. MFGR. MH. MIN. MISC. M.O. M.R. GYP. BD. MTD. MTL. MATL. MIR. MULL.	MASONRY MAXIMUM MECHANICAL MEMBRANE MANUFACTURER MANHOLE MINIMUM MISCELLANEOUS MASONRY OPENING MOUNTED METAL MATERIAL MIRROR MULLION
[ / CH. CAB. C.B. CEM. CER. CFS C.G. C.I. CJ CLG. CLR. CMU C.O. COL. CONC. CONN. CONST. CONT. COORD. CPT. C.R. CH. CT CTS.K.	CHANNEL CABINET CATCH BASIN CEMENT CERAMIC COLD FORMED STEEL CORNER GUARD CONTINUOUS INSULATION CONTROL JOINT CEILING CLEAR CONCRETE MASONRY UNIT CASED OPENING COLUMN CONCRETE CONNECTION CONSTRUCTION CONTINUOUS COORDINATE CARPET COLD-ROLLED CHANNEL CERAMIC TILE COUNTERSUNK	N. N/A N.I.C. N.T.S. # NOM.	NORTH NOT APPLICABLE NOT IN CONTRACT NOT TO SCALE NUMBER NOMINAL
DBL. DEMO. DEPT. DTL DIA. DIM. DISP. DN. DP. DS. DWGS.	DOUBLE DEMOLITION / DEMOLISHED DEPARTMENT DETAIL DIAMETER DIMENSION DISPENSER DOWN DAMP-PROOFING DRAIN-OUT DRAWINGS	# PBD. PC. CONC. PLAM. P.I.P. P.L. PL PLAS. POL. PR. PRE-FAB PRE-FIN. PTD. PARTN. P.WMT. PLYWD	POUND PARTICLE BOARD PRECAST CONCRETE PLASTIC LAMINATE POURED IN PLACE PROPERTY LINE PLATE PLASTER POLISHED PAIR PRE-FABRICATED PRE-FINISHED PAINTED PARTITION PAVEMENT PLYWOOD
E. EA. E.D.F. E.F. E.I.F.S. E.J. ELEC. EL. ELEV. EMER. ENCL. E.P. EQ. EQUIP. EST. E.W. EXH. EXP. EXPO. EXIST. EXT.	EAST ELECTRICAL DRINKING FOUNTAIN EXHAUST FAN EXTERIOR INSULATION & FINISH SYSTEM EXPANSION JOINT ELECTRICAL ELEVATION ELEVATOR EMERGENCY ENCLOSURE EPOXY PAINT EQUAL EQUIPMENT SEAL SECTION SERVICE SINK SHEET SHELVES SHOWER SIMILAR SIM / SIM SPEC. SQ. SQ. FT. SS S.S. S.T.C. STD. ST. DR. STL. STRUCT. SUSP. SYM. SYS. SYN.	RAD. R.A.G. RB RC. RCP R.D. RD. REF. REINF. REQUIRE RESIL. R.H. RM. R.O.	RADIUS RETURN AIR GRILLE RUBBER BASE RESILIENT CHANNEL REFLECTED CEILING PLAN ROOF DRAIN ROUND REFERENCE / REFER REINFORCED / REINFORCEMENT RESILIENT ROBE HOOK ROOM ROUGH OPENING
F.A.P. FD FMDN. F.E. F.E.C. F.F. F.F.E. F.H. F.H.C. FIN. FKT. FLR. F.O.M. F.O.S. FP. F.S. ' FTG. FURN. FURR. F.W.C.	FIRE ALARM PANEL FLOOR DRAIN FOUNDATION FIRE EXTINGUISHER FIRE EXTINGUISHER CABINET FINISH FLOOR FINISH FLOOR ELEVATION FIRE HYDRANT FIRE HOSE CABINET FINISH FIXTURE FLOOR FACE OF MASONRY FACE OF STUD FIRE PROTECTION / FIREPROOFING FULL SIZE FOOT / FEET FOOTING FURNISHED FURRING FABRIC WALL COVERING	S. SC SCHED. S.C.WD. S.D. SEALANT SECT. SER. SK. SHT. SHVS. SHWR. SIM / SIM SP. SPEC. SQ. SQ. FT. SS S.S. S.T.C. STD. ST. DR. STL. STRUCT. SUSP. SYM. SYS. SYN.	SOUTH SOLID CORE SCHEDULE SOLID CORE WOOD SOAP DISPENSER SEALANT SECTION SERVICE SINK SHEET SHELVES SHOWER SIMILAR SPLASH BLOCK SPECIFICATION / SPECIFIED SQUARE SQUARE FEET SANITARY SEWER STAINLESS STEEL SOUND TRANSMISSION COEFFICIENT STANDARD STORM DRAIN STEEL STRUCTURAL SUSPENDED SYMMETRICAL SYSTEM SYNTHETIC
GA. GALV. G.B. GRD. G.C. G.L. GLASS / GLAZING GYP. GYP. BD.	GAUGE GALVANIZED GRAB BAR GRADE GENERAL CONTRACTOR GLASS / GLAZING GYPSUM GYPSUM BOARD	T.B. T.C. TEL. TEMP. T&G THRES. THK. T.O.S. TYP.	TOWEL BAR TOP OF CURB TELEPHONE TEMPORARY TONGUE & GROOVE THRESHOLD THICK / THICKNESS TOP OF STEEL TYPICAL
H.B. H.C. H.C. / HCP. HCWD. HDWE. HT. HISTORIC. H.M. HORIZ. HR. H.R. HVAC.	HOSE BIB HOLLOW CORE HANDICAP HOLLOW CORE WOOD HARDWARE HEIGHT HISTORICAL HOLLOW METAL HORIZONTAL HOUR HANDRAIL HEATING, VENTILATING, & AIR CONDITIONING	U.H. UNO U.P.S. U.S.	UNIT HEATER UNLESS NOTED OTHERWISE UNINTERRUPTABLE POWER SUPPLY UTILITY SHELF
* I.D. INSUL. INT. INV. I.P.	INCH INSIDE DIAMETER INSULATION INTERIOR INVERT IRON PIPE	VCT VERT. V.I.F. V.O.J. V.T.R. V.W.C.	VINYL COMPOSITION TILE VERTICAL VERIFY IN FIELD VERIFY ON JOB VENT-THRU-ROOF VINYL WALL COVERING
JAN. J.B. JT.	JANITOR JOIST BRG. JOINT	W. W/ W.C. WD. WDW. WH W/O W.P. WSC.T. WT. W.W.M.	WEST WITH WATER CLOSET WOOD WINDOW WATER HEATER WITHOUT WATERPROOF WAINSCOT WEIGHT WELDED WIRE MESH

MATERIALS LEGEND	
	BRICK
	CONCRETE
	CONCRETE MASONRY UNITS
	GRAVEL
	GROUT
	GYPSUM BOARD
	INSULATION (BATT)
	INSULATION (RIGID)
	METAL
	SHEATHING
	WOOD (SOLID WOOD)
	WOOD (CONTINUOUS BLOCKING)
	WOOD (DISCONTINUOUS BLOCKING)
	WATERPROOFING / DAMP PROOFING
SYMBOLS LEGEND	
	DOOR TAG
	ELEVATION MARK
	ELEVATION TAG
	ROOM MARK
	SECTION MARK
	STOREFRONT MARK
	PARTITION TYPE
	WINDOW TYPE
GENERAL NOTES	
1. NOTES APPEAR ON VARIOUS DRAWINGS FOR VARIOUS DISCIPLINES FOR DIFFERENT SYSTEMS AND MATERIALS. REVIEW ALL SHEETS AND APPLY NOTES TO RELATED BUILDING COMPONENTS.	
2. REFER TO COMPLETE SET OF ISSUED CONTRACT DOCUMENTS FOR OTHER APPLICABLE NOTES, ABBREVIATIONS, AND SYMBOLS.	
3. WHERE MATERIALS ARE APPLIED TO, OR ARE IN DIRECT CONTACT WITH WORK INSTALLED BY ANOTHER SUBCONTRACTOR, COMMENCEMENT OF WORK IMPLIES ACCEPTANCE OF THE SUBSTRATE AS SUITABLE FOR THE APPLICATION INTENDED.	
4. ISOLATE DISSIMILAR METALS TO PREVENT GALVANIC CORROSION.	
5. PARTITION TYPES AND FIRE RESISTIVE RATINGS INDICATED ON A WALL ARE TO BE CONTINUOUS FOR THE LENGTH AND HEIGHT OF A PARTITION.	
6. OPENINGS IN RATED WALL, FLOOR, CEILING AND ROOF ASSEMBLIES SHALL BE SEALED WITH PENETRATION SEALANT SYSTEMS MEETING OR EXCEEDING THE REQUIRED FIRE RESISTIVE RATINGS.	
7. MAINTAIN THE FIRE RATING OF CONSTRUCTION AROUND CABINETS, PANELS, AND BOXES RECESSED IN FIRE RATED WALL, FLOOR, AND CEILING ASSEMBLIES.	
8. PROVIDE CONTINUOUS PERIMETER FIRE SAFING BETWEEN FLOORS AND COORDINATE THE INSTALLATION WITH THE EXTERIOR WALL. FIRE RATING OF SAFING SHALL MATCH FIRE RATING OF FLOOR CONSTRUCTION.	
9. DO NOT SCALE THE DRAWINGS.	
10. FIELD MEASURE AND CONFIRM DIMENSIONS FOR OWNER PROVIDED EQUIPMENT AND FURNISHINGS.	
11. PROVIDE STIFFENERS, BRACING, BACKING PLATES AND BLOCKING REQUIRED FOR SECURE INSTALLATION OF TOILET PARTITIONS, DOORS AND DOOR HARDWARE INCLUDING WALL-MOUNTED DOOR STOPS, HANDRAILS, WALL-MOUNTED SHELVES, OPERABLE PARTITIONS, MISCELLANEOUS EQUIPMENT, AND SUSPENDED MECHANICAL AND ELECTRICAL EQUIPMENT.	
12. COORDINATE ALL BASE AND HOUSEKEEPING PADS WITH MECHANICAL, PLUMBING AND ELECTRICAL EQUIPMENT.	
13. LOCATE ACCESS PANELS AS INDICATED ON DRAWINGS. FOR ACCESS PANELS NOT SHOWN BUT REQUIRED BY PROVISIONS OF THE CONTRACT DOCUMENTS, LOCATED IN ACCORDANCE WITH APPLICABLE CODES. SUBMIT PROPOSED LOCATIONS TO THE ARCHITECT FOR REVIEW AND ACCEPTANCE PRIOR TO INSTALLATION.	

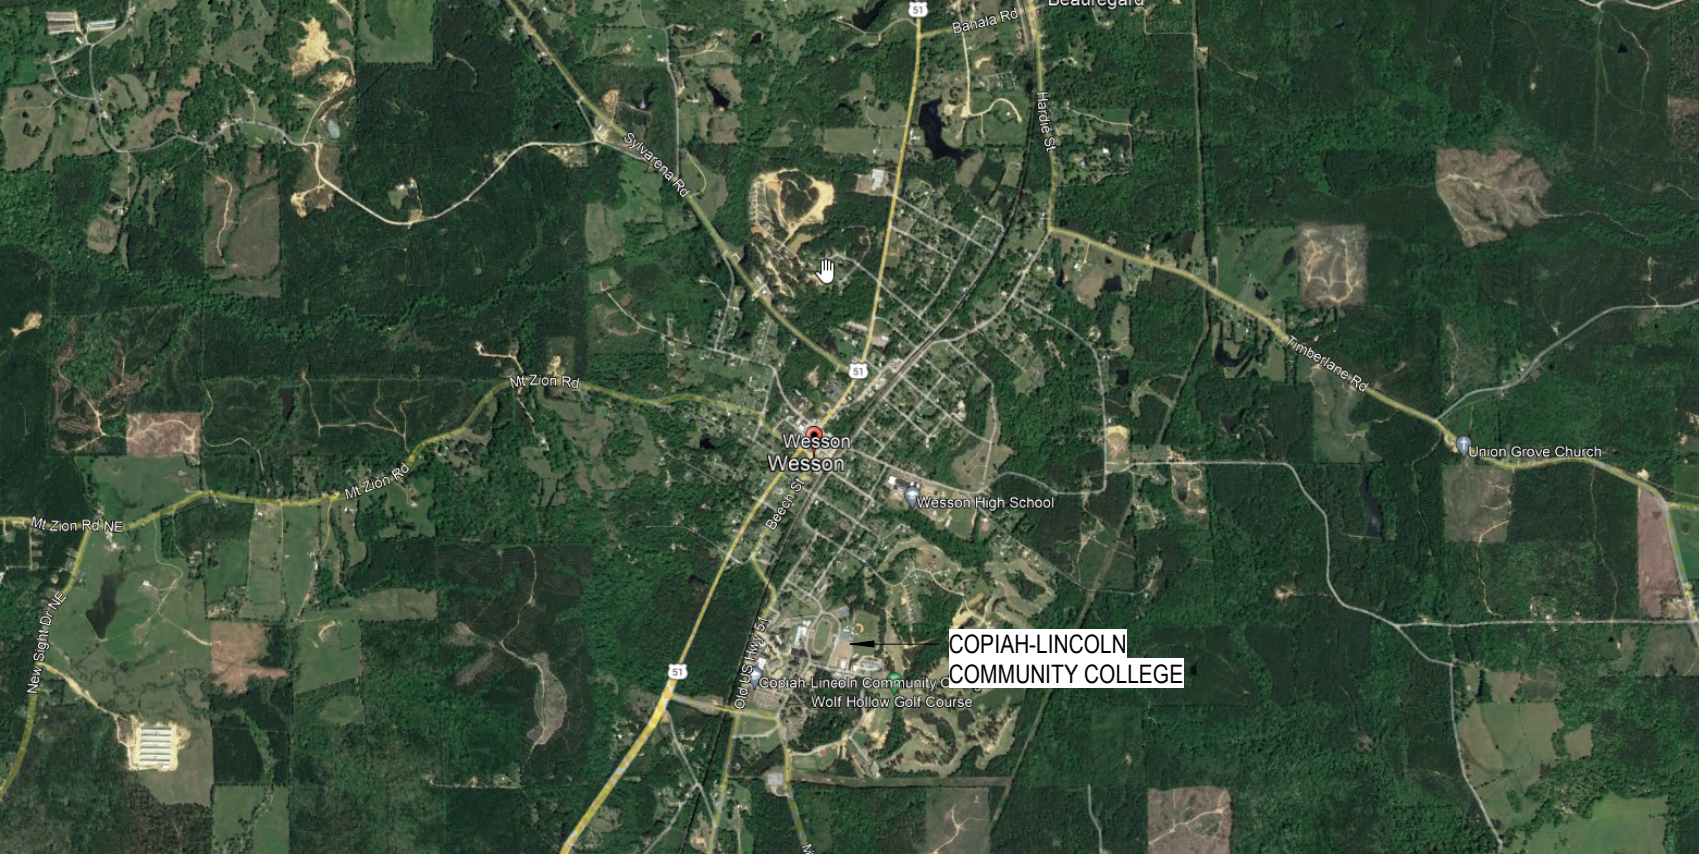PROJECT TEAM	
<b>OWNER</b>  COPIAH-LINCOLN COMMUNITY COLLEGE H F MCCARTY DR. WESSON, MS 39191 601.643.5101	
<b>ARCHITECT</b>  WIER BOERNER ALLIN ARCHITECTURE, PLLC. 2727 OLD CANTON RD., STE. 200 JACKSON, MS 39216 601.321.9107 (P) 601.321.9108 (F) JULIE MARKLE, AIA jmarkle@wbaarchitecture.com	
<b>CONSULTANT #1</b>  WGK INC. 204 WEST LEAKE STREET CLINTON, MS 39056 601.926.4444 (P) 601.924.6708 (F) MIKE MACKENZIE, P.E. mmckenzie@wgkengineers.com	<b>CONSULTANT #2</b>  SMITHERS ENGINEERS FLOWOOD, MS 39232 435 KATHERINE DR., SUITE A 768.216.3004 (P) 601.900.9905 (C) CHAS SMITHERS, P.E. chas@smithersengineers.com
<b>CONSULTANT #3</b>  GSK MECHANICAL, INC. 201 PARK COURT, SUITE A RIDGELAND, MS 39157 601.695.2330 (P) 601.421.5263 (C) KEVIN STARKS, P.E. kstarks@gskmech.com	<b>CONSULTANT #4</b>  THE POWER SOURCE, PLLC 305 HIGHWAY 51 RIDGELAND, MS 39157 601.695.4820 (P) 601.540.0808 (C) CHRIS GREEN, PE jmarkle@wbaarchitecture.com
PROJECT SCOPE OVERVIEW:	
<b>BASE BID SCOPE:</b>  A. REGRADE EXISTING BASEBALL FIELD (SEE CIVIL) B. INSTALL NEW FIELD SURFACE MATERIALS C. CONSTRUCT NEW HOME & VISITOR DUGOUTS D. CONSTRUCT NEW BACKSTOP WALL & SAFETY NETTING SYSTEM E. CHAIN LINK FENCE ENCLOSURE F. SITE PAVING FOR FACILITY ACCESS (SEE CIVIL)	
<b>ADD ALTERNATE 1 SCOPE:</b>  A. NEW BASEBALL FIELD LIGHTING (SEE ELECTRICAL)	
<b>ADD ALTERNATE 2 SCOPE:</b>  A. CONSTRUCT NEW CONCRETE CONCOURSE W/ CHAIRBACK SEATING B. CONSTRUCT NEW ALUM BLEACHER SYSTEM & ENCLOSURE C. CONSTRUCT NEW PRESSBOX BUILDING D. CONSTRUCT NEW STEEL SHADE STRUCTURE E. ADDITIONAL SITE PAVING (SEE CIVIL & STRUCTURAL)	
<b>ADD ALTERNATE 3 SCOPE:</b>  A. CONSTRUCT NEW ENTRY STRUCTURE WITH GATE B. CONSTRUCT NEW MASONRY AND DECORATIVE METAL FENCE C. ADDITIONAL SITE PAVING & ENTRY PLAZA D. NEW LIGHTING AT SIDEWALKS (SEE ELECTRICAL)	
<b>ADD ALTERNATE 4 SCOPE:</b>  A. CONSTRUCT NEW CONCESSIONS & RESTROOM BUILDING B. EXTEND CONCRETE STEP SEATING C. CONSTRUCT GRASS BERM SEATING D. ADDITIONAL SITE PAVING (SEE CIVIL & STRUCTURAL)	
VICINITY MAP	
Wesson, MS 39191	
	
PROJECT LOCATION	
	


DRAWING INDEX			
INDEX OF DRAWINGS			
SHEET NUMBER	SHEET NAME	ISSUE DATE	ISSUE DATE 2
01 - REFERENCE			
R000	COVER SHEET		
R100	PROJECT INFO		
R200	LIFE SAFETY & ACCESSIBILITY COMPLIANCE		
R201	LIFE SAFETY PLAN		
02 - CIVIL			
C100	GENERAL NOTES & INDEX		
C101	EXISTING TOPOLOGICAL SURVEY		
C102	CIVIL SITE IMPROVEMENTS - BASE BID		
C103	CIVIL SITE IMPROVEMENTS - ADD ALT. NO 1		
C104	CIVIL SITE IMPROVEMENTS - ADD ALT. NO 2		
C105	CIVIL SITE IMPROVEMENTS - ADD ALT. NO 3		
C106	CIVIL SITE IMPROVEMENTS - ADD ALT. NO 4		
C200	DEMOLITION PLAN		
C300	GRADING & DRAINAGE PLAN - OVERVIEW		
C301	GRADING & DRAINAGE PLAN - BASEBALL FIELD		
C302	GRADING & DRAINAGE PLAN - STADIUM AREA		
C303	GRADING & DRAINAGE PLAN - ENTRANCE		
C400	GEOMETRIC LAYOUT - OVERVIEW		
C401	GEOMETRIC LAYOUT - BASEBALL FIELD		
C402	GEOMETRIC LAYOUT - STADIUM AREA		
C403	GEOMETRIC LAYOUT - ENTRANCE AREA		
C500	UTILITY PLAN		
C600	FENCING DETAILS		
C700	CONSTRUCTION DETAILS		
C701	CONSTRUCTION DETAILS		
C800	EROSION CONTROL PLAN		
C801	EROSION CONTROL DETAILS		
04 - DEMOLITION			
D100	DEMOLITION PLAN		
05 - ARCHITECTURE			
A100	SITE PLAN - BASE BID		
A101	FIELD IMPROVEMENTS		
A102	FLOOR PLAN - BASE BID		
A103	ENLARGED FLOOR PLANS - BASE BID		
A104	ROOF PLAN & RCP MAIN LEVEL - BASE BID		
A110	SITE PLAN - ALT #1		
A120	SITE PLAN - ALT #2		
A121	FLOOR PLAN MAIN LEVEL - ALT #2		
A122	ENLARGED FLOOR PLAN - ALT #2		
A123	ENLARGED FLOOR PLAN & RCP - ALT #2		
A124	ROOF PLAN - ALT #2		
A130	SITE PLAN - ALT #3		
A131	PLAN, ELEVATIONS, DETAILS - ALT #3		
A140	SITE PLAN - ALT #4		
A141	FLOOR PLAN MAIN LEVEL - ALT #4		
A142	ENLARGED FLOOR PLAN ELEV / SECT. - ALT #4		
A143	ROOF PLAN AND RCP - ALT #4		
A200	BUILDING ELEVATIONS BASE BID		
A210	BUILDING ELEVATIONS ALT #2		
A300	BUILDING SECTIONS		
A301	BUILDING SECTIONS		
A400	WALL SECTIONS		
A401	WALL SECTIONS		
A500	DETAILS		
A501	DETAILS		
A600	DOORS, WINDOWS, & PARTITIONS		
A601	DOOR AND WINDOW DETAILS		
A602	DOOR AND WINDOW DETAILS		
A700	INTERIOR ELEVATIONS		
A800	MILLWORK GENERAL NOTES		
06 - STRUCTURAL			
S001	STRUCTURAL GENERAL NOTES		
S002	STRUCTURAL QUALITY ASSURANCE PLAN		
S101	OVERALL FOUNDATION PLAN		
S102	OVERALL ROOF FRAMING PLAN		
S201	BOWL/CANOPY FOUNDATION PLAN		
S202	BOWL/CANOPY ROOF FRAMING PLAN		
S203	HOME DUGOUT PLANS		
S204	VISITOR DUGOUT PLANS		
S205	PRESS BOX PLANS		
S206	CONCESSION PLANS		
S207	BUILDING SECTIONS		
S301	FOUNDATION DETAILS		
S302	FOUNDATION DETAILS		
S303	FOUNDATION DETAILS		
S304	FOUNDATION DETAILS		
S401	CML DETAILS		
S501	STEEL DETAILS		
S502	STEEL DETAILS		
S503	FRAMING DETAILS		
S504	FRAMING DETAILS		
07 - MECHANICAL			
M101	OVERALL MECHANICAL PLAN		
M110	MECHANICAL PLANS - BASE BID		
M120	MECHANICAL PLANS - ADD ALT NO. 2		
M130	PLUMBING PLANS - ADD ALT NO. 4		
M131	HVAC PLANS - ADD ALT NO. 3		
M201	MECHANICAL SCHEDULES - PLUMBING		
M202	MECHANICAL SCHEDULES - HVAC		
M301	MECHANICAL DETAILS		
10 - ELECTRICAL			
E0.0	ELECTRICAL LEGEND		
E0.1	ELECTRICAL DETAILS		
E0.2	ELECTRICAL DETAILS		
E0.3	ELECTRICAL PANEL SCHEDULES		
E0.4	RENOVATION PLAN - SITE		
E0.5	DEMOLITION PLAN - SITE - ALT #1		
E1.0	ALTERNATE #1 LIGHTING PLAN		
E1.1	OVERALL ALTERNATE LIGHTING PLAN		
E1.2	DUGOUT ENLARGED LIGHTING PLAN		
E1.3	STADIUM LIGHTING PLAN ADD ALT. #2 & #4		
E2.0	DUGOUT ENLARGED POWER PLAN		
E2.1	STADIUM POWER PLAN ADD ALT. #2 & #4		
E3.0	DUGOUT ENLARGED MECHANICAL PLAN		
E3.1	STADIUM MECHANICAL PLAN ADD ALT. #2 & #4		
REVISIONS			
NO.	DESCRIPTION	DATE	
1	Addendum No. 01	02/02/2022	
2	Addendum No. 02	02/09/2022	



## BASEBALL FIELD AND STADIUM IMPROVEMENTS

COPIAH-LINCOLN  
COMMUNITY  
COLLEGE

H F McCarthy Drive,  
Wesson, Mississippi  
39191

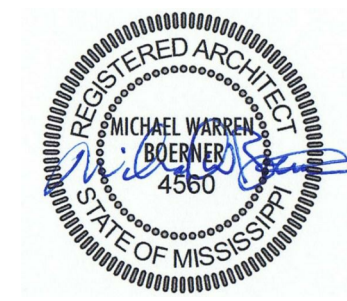

19 JANUARY 2022

CONSTRUCTION  
DOCUMENTS  
WBA # 21-053

REVISIONS		
NO.	DESCRIPTION	DATE
1	Addendum No. 01	02/02/2022
2	Addendum No. 02	02/09/2022

R100  
PROJECT INFO



## RCP GENERAL NOTES

A. REFER TO FP. DWGS. FOR ALL AUTOMATIC FIRE SUPPRESSION SYS. REQ. G.C. TO COORD. SPRINKLER SYS. W/ WORK OF ALL OTHER TRADES.

B. CONFIRM LIGHTING LAYOUT W/ ARCH. PRIOR TO INSTALLATION.

C. REFER TO MECH. & ELEC. DWGS. FOR WALL MTD. GRILLES & DIFFUSERS & ALL OTHER ADDITIONAL FIXTURES, DEVICES & ITEMS NOT SHOWN.

D. INSTALL ALL CEILING FIXTURES AS DIMENSIONED ON RCPs. IN ROOMS/SPACES W/ ONLY ONE FIXTURE, CENTER EA. WAY.


E. FOR TYP. CONDITIONS, FOLLOW INSTALLATION PARAMETERS AS SHOWN BELOW.

F. FOR ALL ATYPICAL CONDITIONS, & FOR ALL CONDITIONS WHERE CEILING COMPONENTS CANNOT BE INSTALLED AS SHOWN ON RCPs, COORDINATE EXACT LOCATIONS W/ ARCHITECT IN FIELD.

G. LIGHT FIXTURES, MECH. DIFFUSERS & GRILLES, & ALL OTHER DEVICES SHOWN ON REFLECTED CEILING PLANS (RCPs) ARE FOR COORD. PURPOSES ONLY. REFER TO MECH., ELEC., & PLUMBING/FIRE PROTECTION DWGS. FOR ALL PRICING TAKE-OFFS. COORD. W/ OWNER/ARCHITECT IN FIELD.

H. LOCATE ACCESS PANELS AS INDICATED ON DWGS. FOR ACCESS PANELS NOT SHOWN BUT REQ'D. BY PROVISIONS OF THE CONTRACT DOCUMENTS, LOCATE IN ACCORDANCE W/ APPLICABLE CODES. SUBMIT PROPOSED LOCATIONS TO THE ARCHITECT FOR REVIEW & ACCEPTANCE PRIOR TO INSTALLATION. ALL CEILING ACCESS PANELS ARE TO BE PROVIDED & INSTALLED TO MAINTAIN ALL REQ'D. FIRE RATINGS.

J. CONTRACTOR IS TO SUBMIT PROPOSED LOCATIONS TO THE ARCHITECT FOR REVIEW & ACCEPTANCE PRIOR TO INSTALLATION FOR ANY & ALL CEILING MTD. FIXTURES OR DEVICES NOT SHOWN BUT REQ'D. BY PROVISIONS OF THE CONTRACT DOCUMENTS.

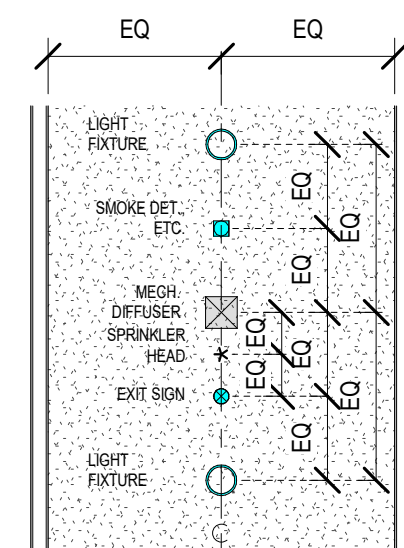


K. IN ALL CORRIDORS:

[a] ALIGN ALL RECESSED CAN LIGHT FIXTURES W/ 1/4 OF CORRIDOR & DIM. AS SHOWN ON RCP.

[b] WHERE DIFFUSERS & GRILLES OCCUR, ALIGN W/ 1/4 OF CORRIDOR & CENTER BETWEEN LIGHT FIXTURES.

[c] WHERE ALL OTHER ELEC. DEVICES OCCUR IN CEILINGS, CENTER BETWEEN ADJACENT LIGHT FIXTURES, DIFFUSERS, GRILLES, ETC. WHERE POSSIBLE.

[d] WHERE SPRINKLER HEADS OCCUR, ALIGN W/ 1/4 OF CORRIDOR & SPACE AS NECESSARY TO ACHIEVE REQUIRED COVERAGE.

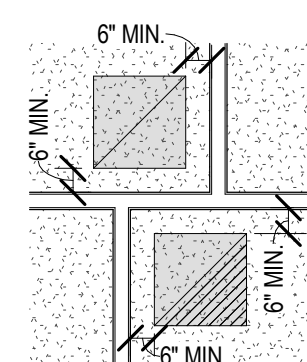


L. WHERE DIFFUSERS & GRILLES OCCUR TIGHT TO ROOM CORNERS, DIM. AS SHOWN IN ALL CONDITIONS WHERE POSSIBLE.

**NOTE:**  
SEE ELEC. DWGS. FOR LIGHT FIXTURE INFORMATION.

SEE MECH. DWGS. FOR HVAC INFORMATION.


REFER TO EXT. ELEVATIONS FOR ADDITIONAL LIGHTING & MECH. REQ.

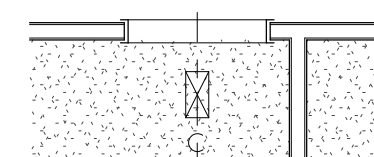



M. WHERE DIFFUSERS & GRILLES OCCUR AT DOORWAYS, ALIGN AT CENTERLINE OF DOORWAY AS SHOWN. POSITION IN OTHER DIRECTION AS DIM. ON RCP. COORD. W/ ARCHITECT IN FIELD U.N.O.

## RCP LEGEND


### CEILING TYPE LEGEND:

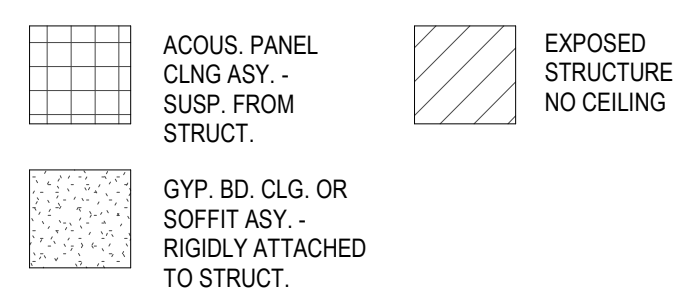


### CEILING SYMBOL LEGEND:

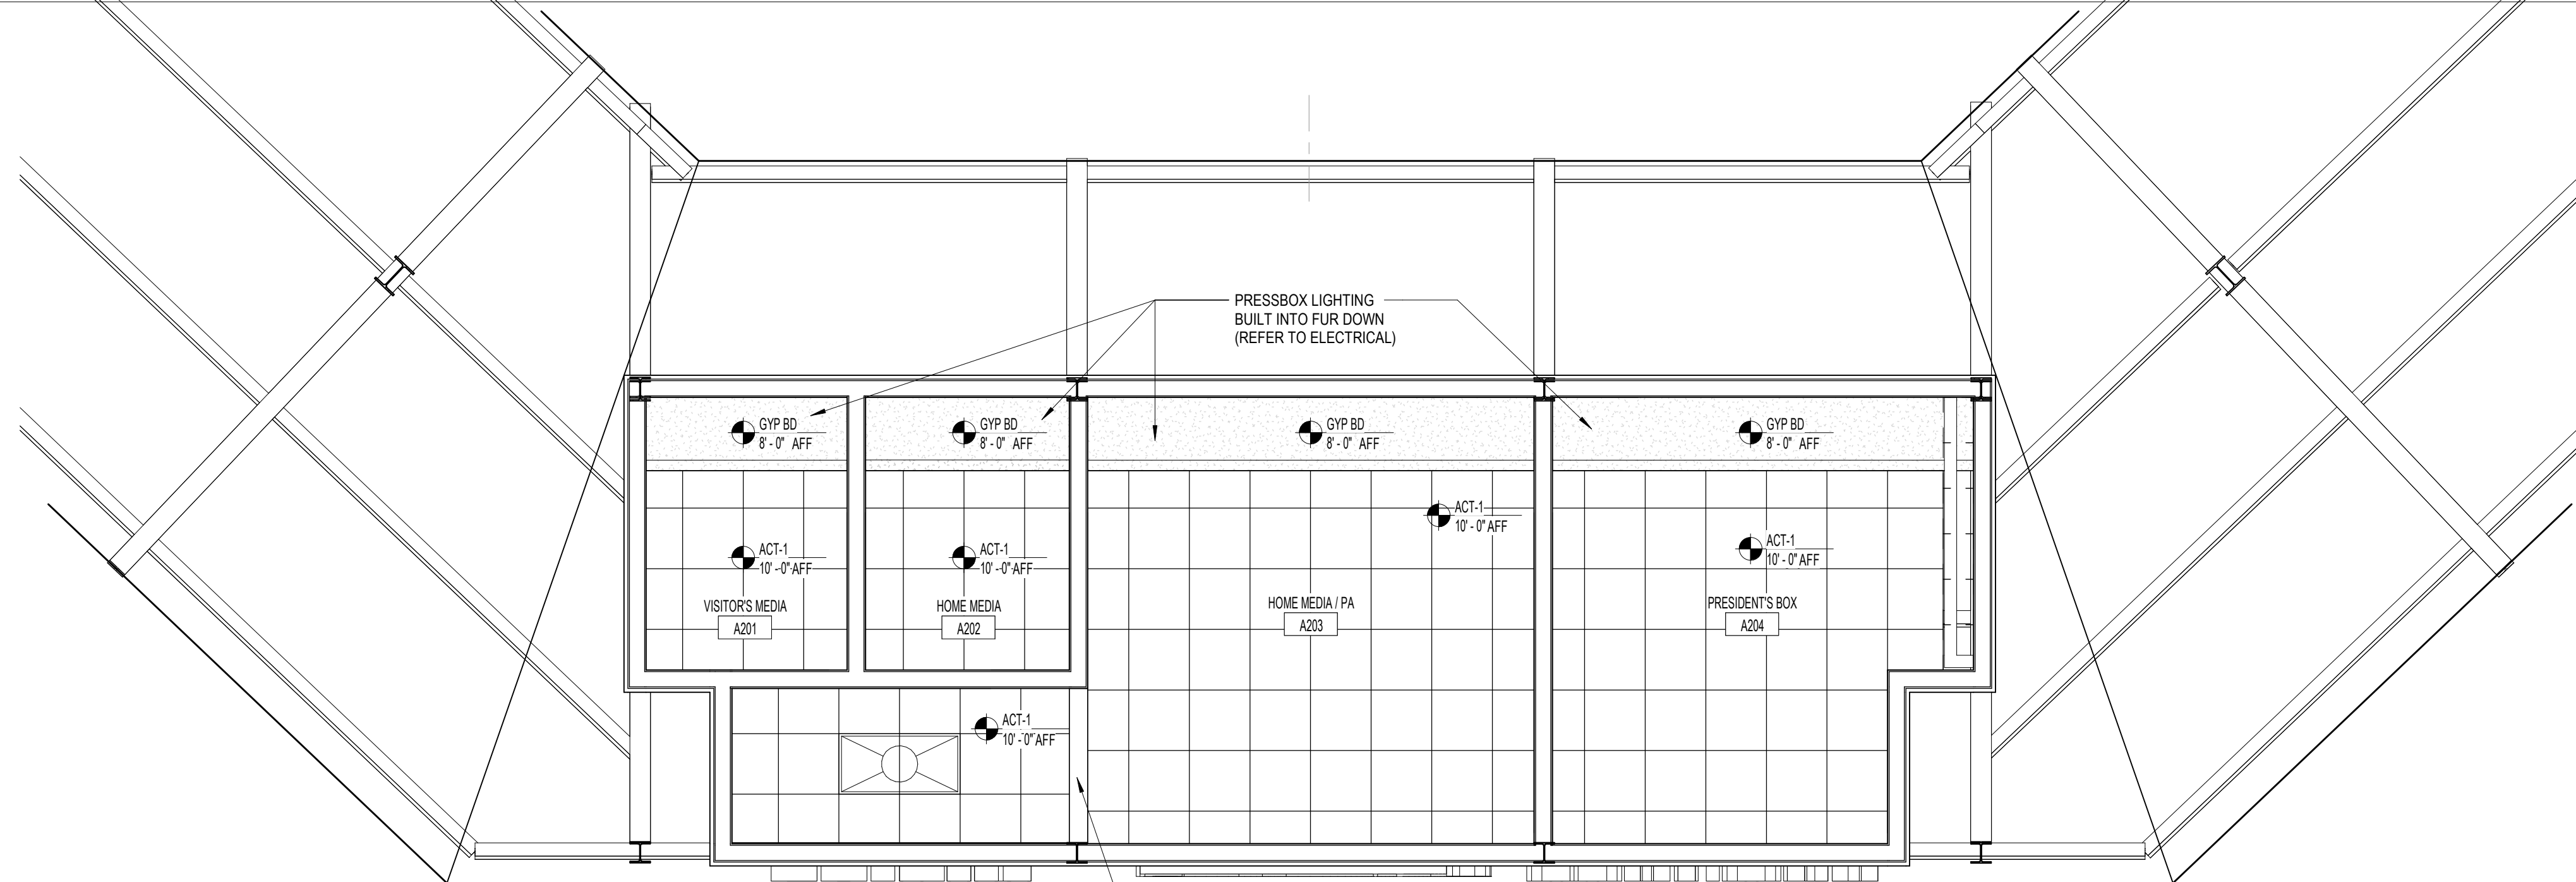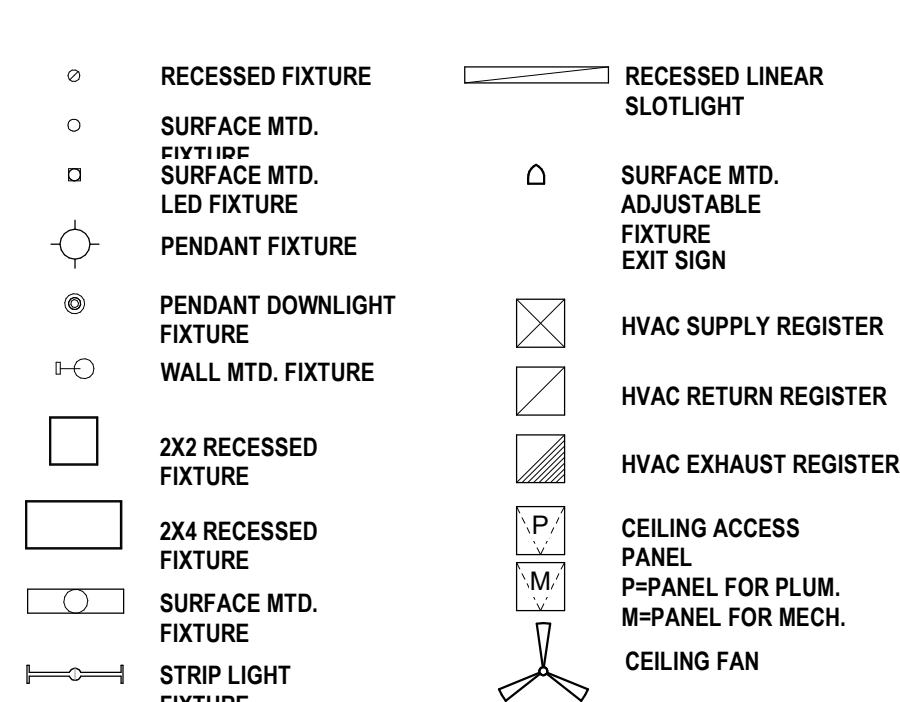

2 PRESS BOX RCP - ALTERNATE NO.2  
1/4" = 1'-0"

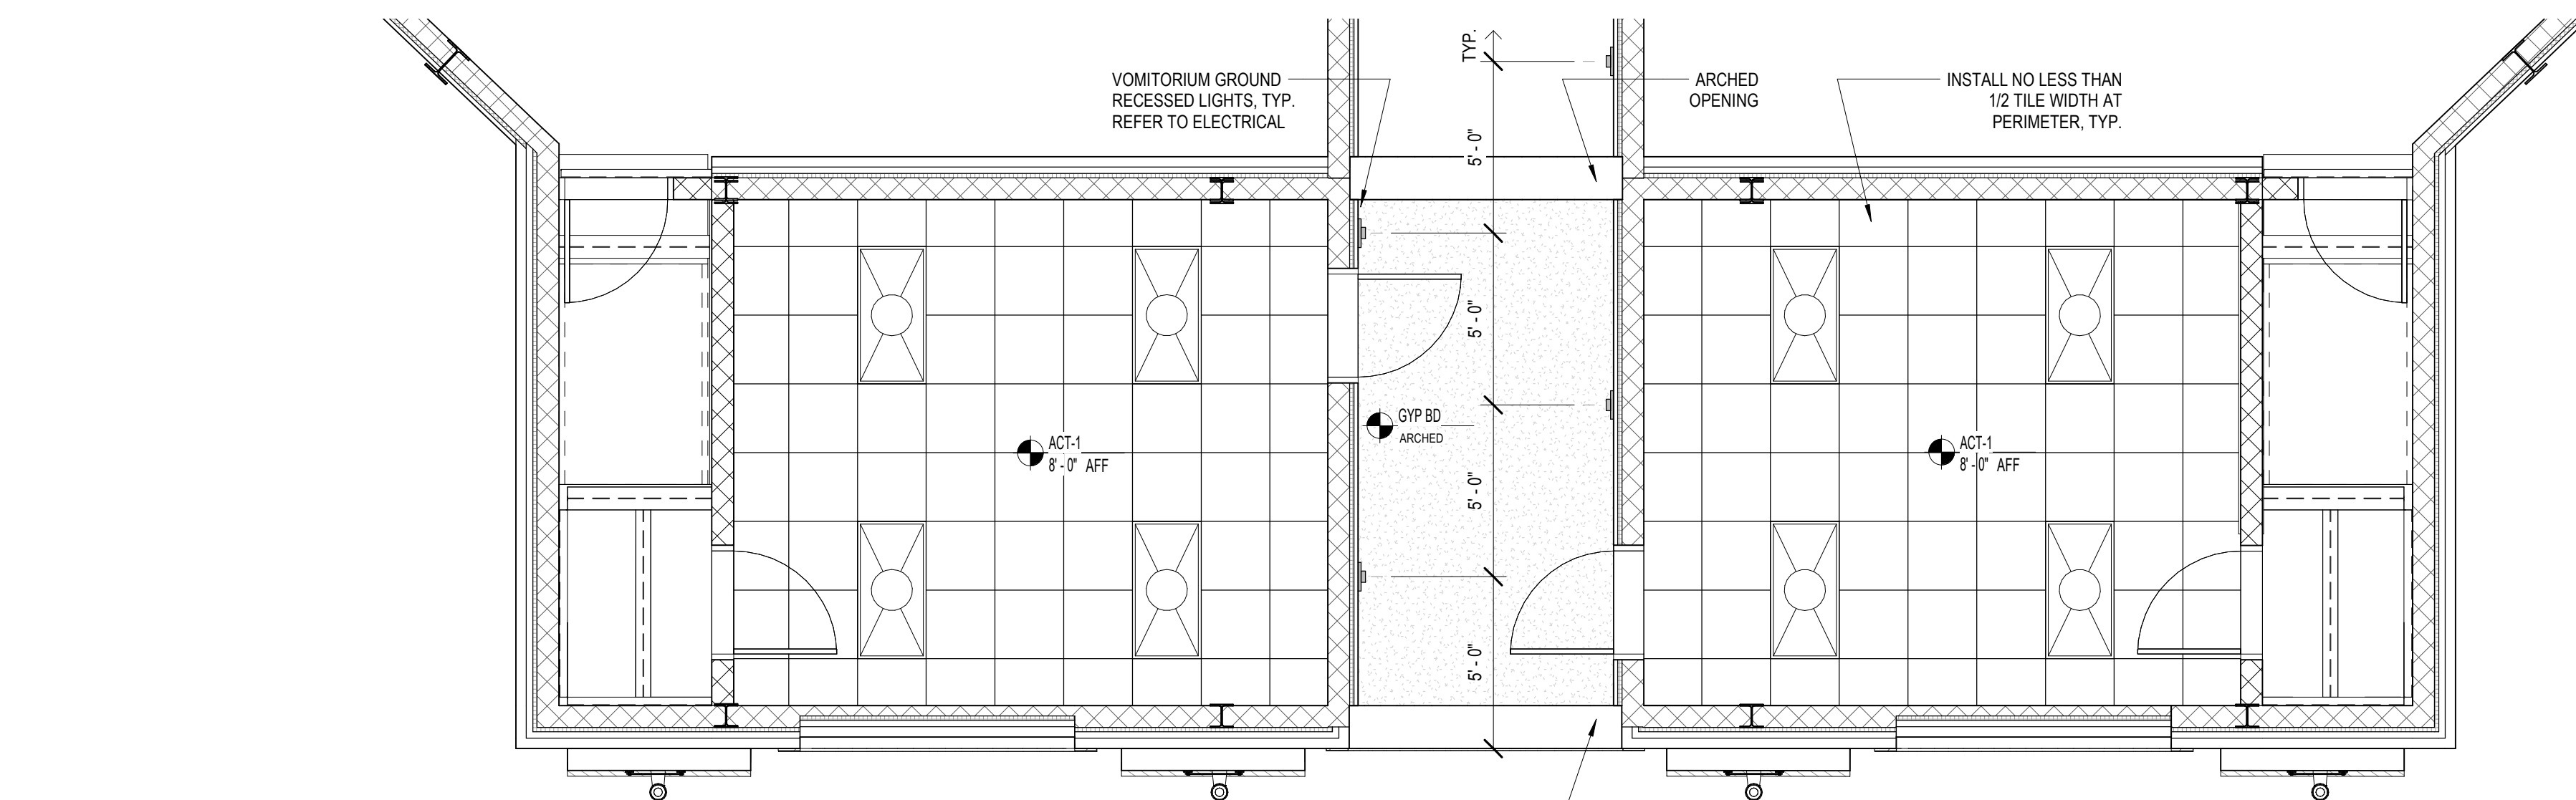


1 STORAGE AND LOUNGE RCP - ALTERNATE NO.2  
1/4" = 1'-0"

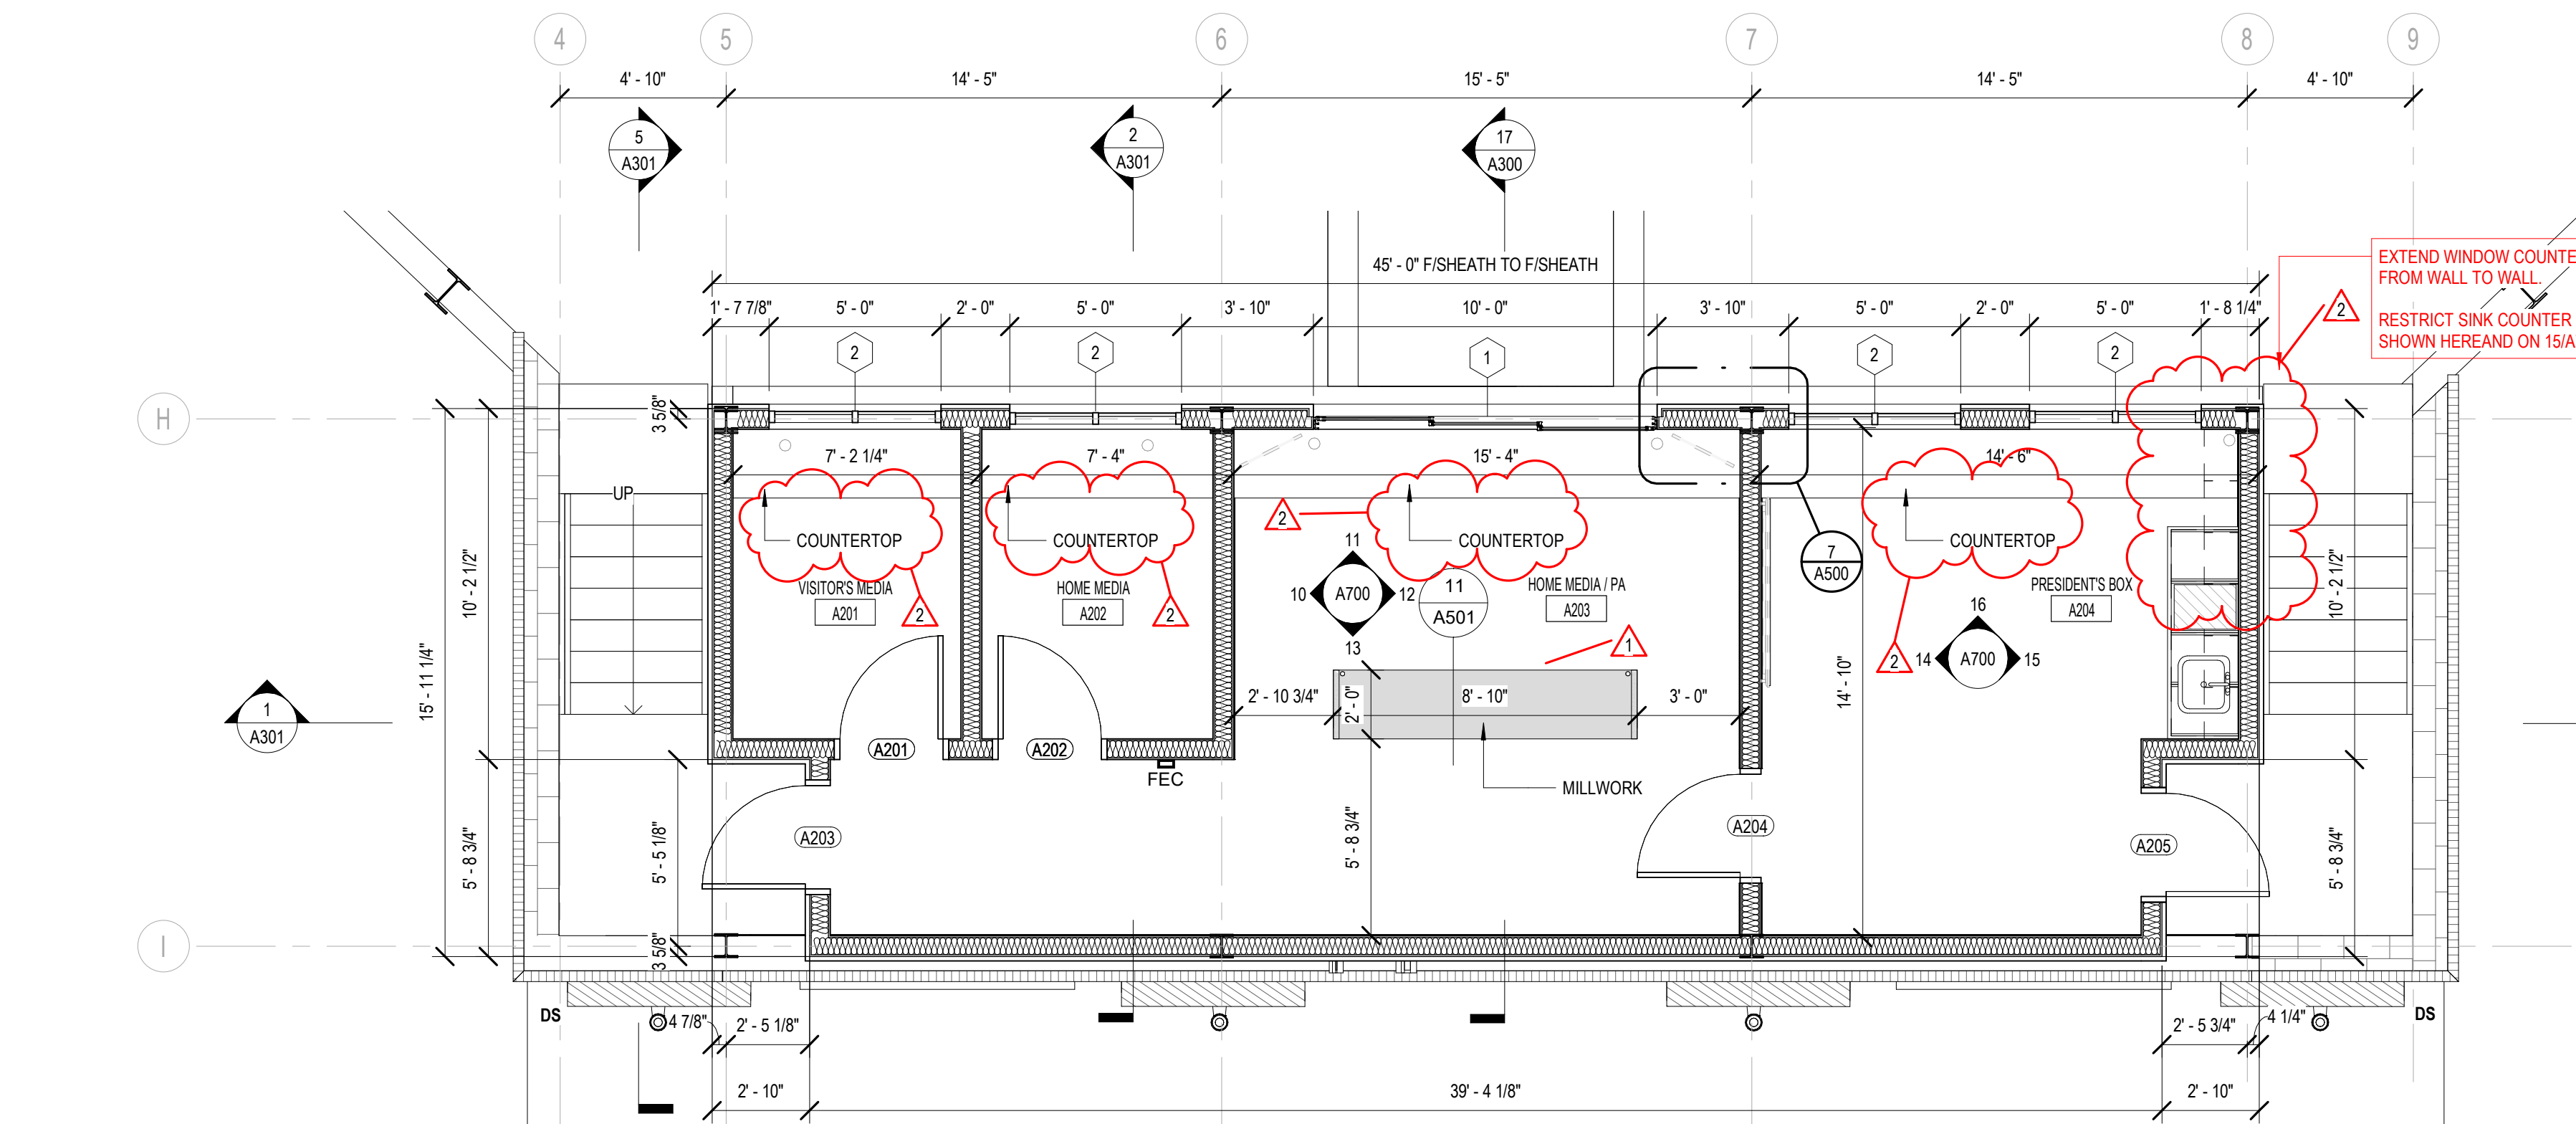


3 PRESS BOX ENLARGED FLOOR PLAN - ALTERNATE NO.2  
1/4" = 1'-0"




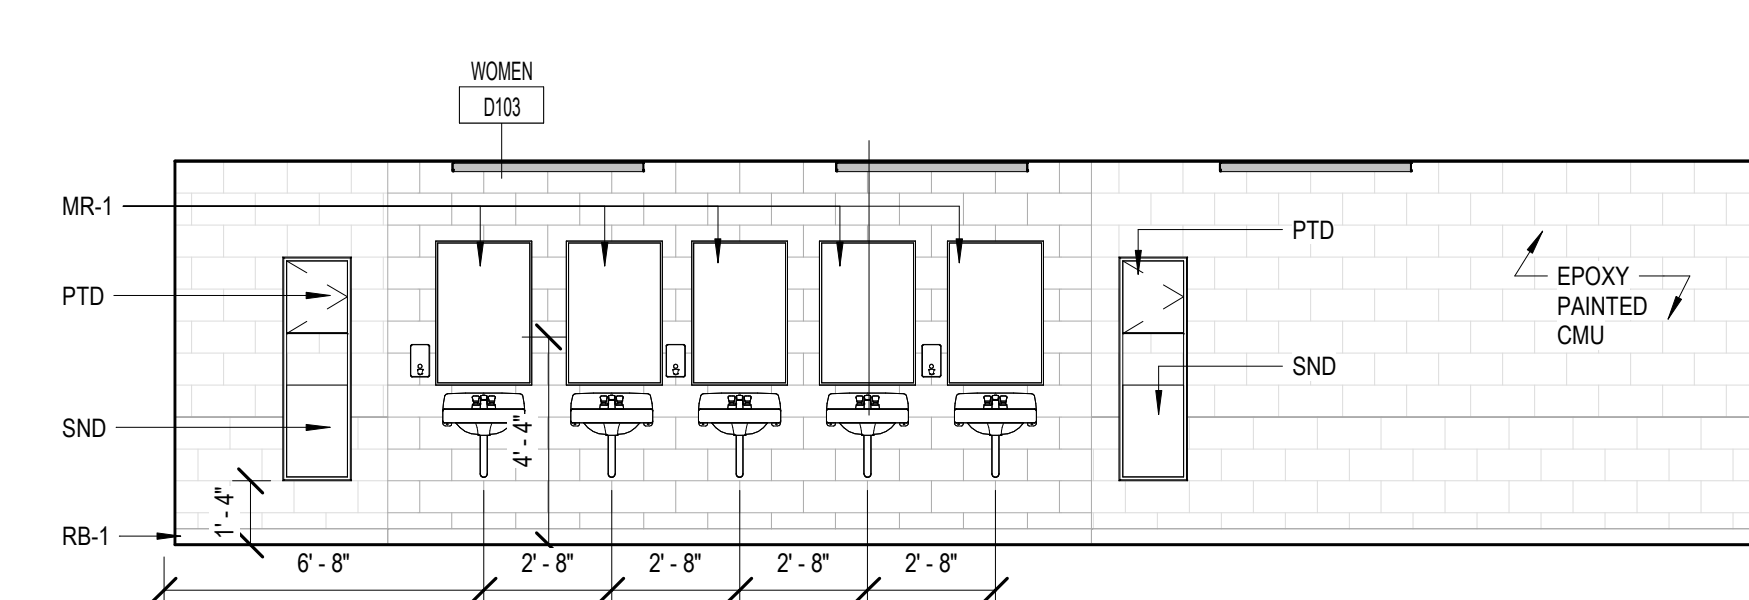


1 INTERIOR ELEVATION  
1/4" = 1'-0"

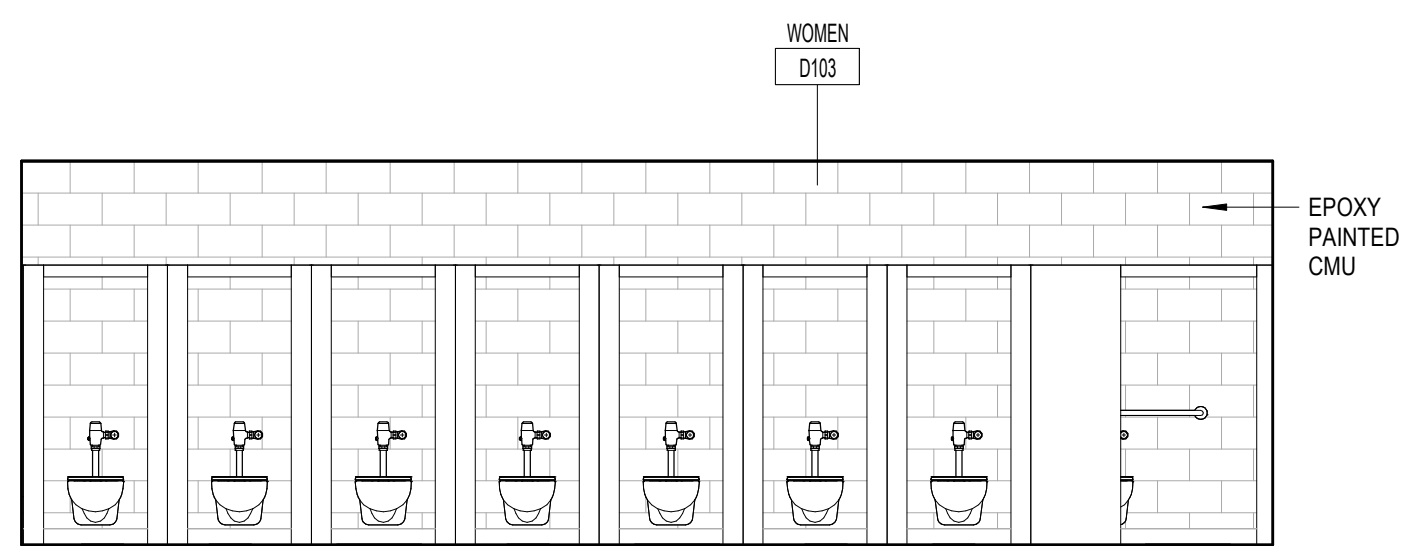


2 INTERIOR ELEVATION  
1/4" = 1'-0"

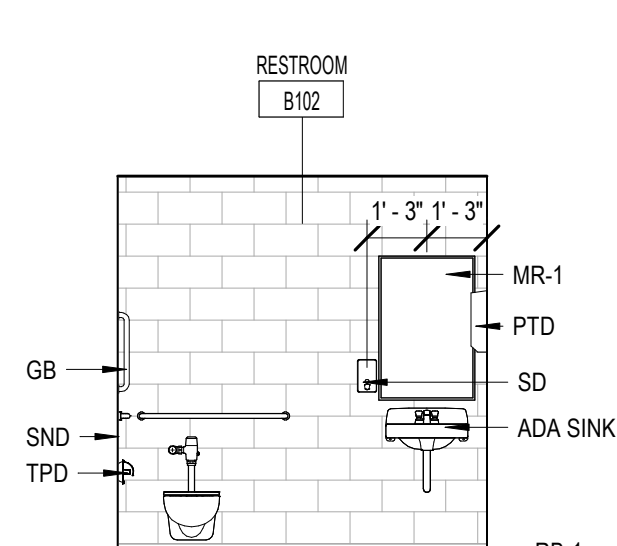


3 INTERIOR ELEVATION  
1/4" = 1'-0"

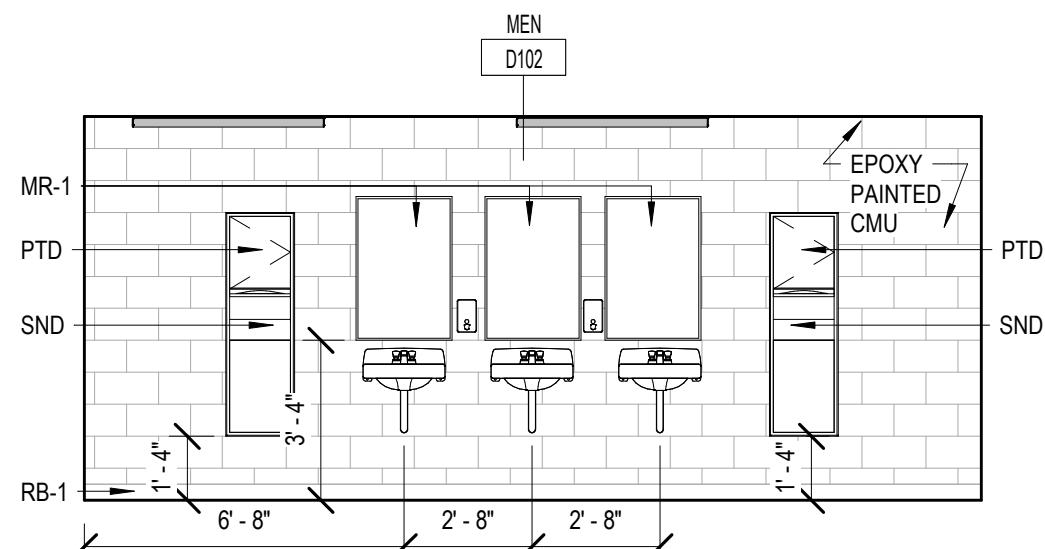


5 INTERIOR ELEVATION  
1/4" = 1'-0"

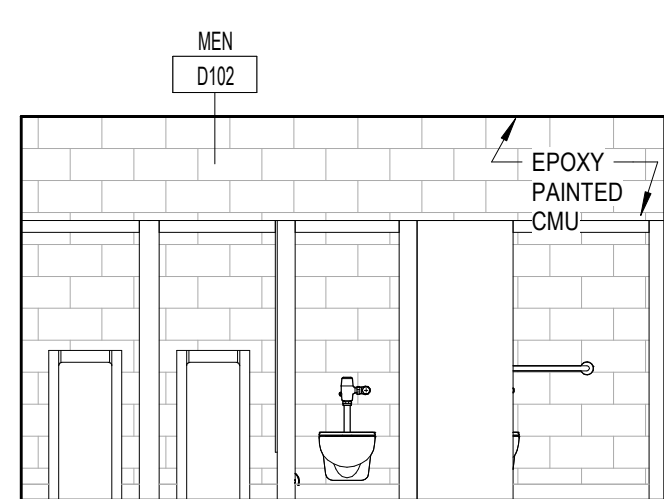


6 INTERIOR ELEVATION  
1/4" = 1'-0"

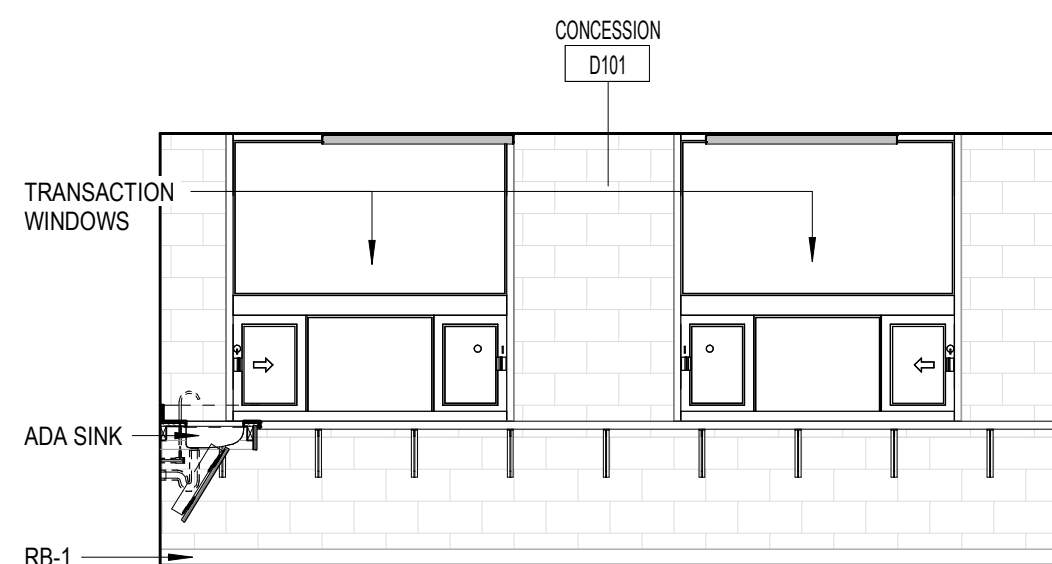


7 INTERIOR ELEVATION  
1/4" = 1'-0"

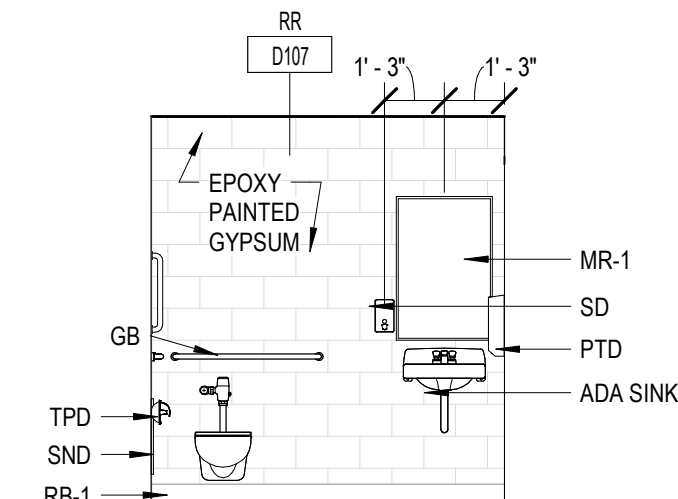


8 INTERIOR ELEVATION  
1/4" = 1'-0"

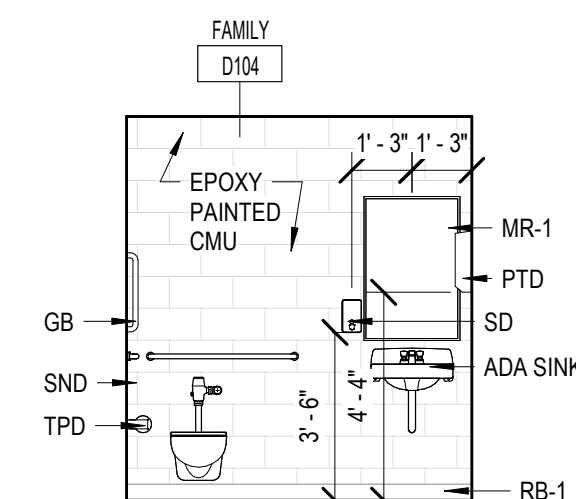


9 INTERIOR ELEVATION  
1/4" = 1'-0"

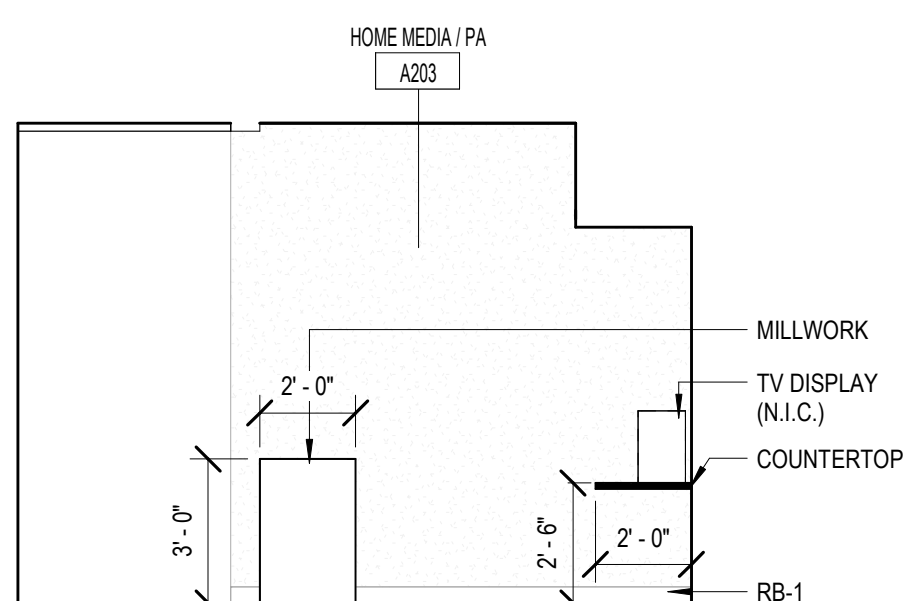


10 INTERIOR ELEVATION  
1/4" = 1'-0"

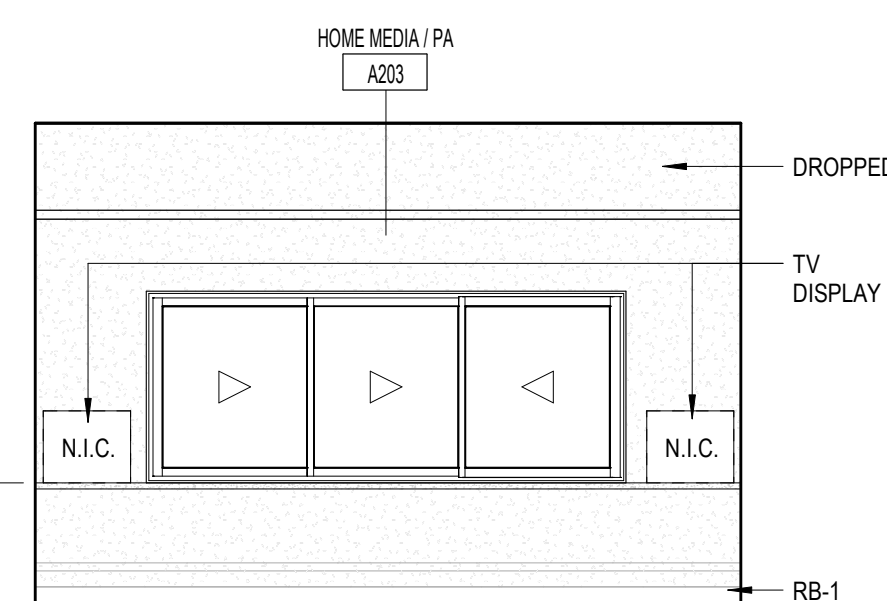


11 INTERIOR ELEVATION  
1/4" = 1'-0"

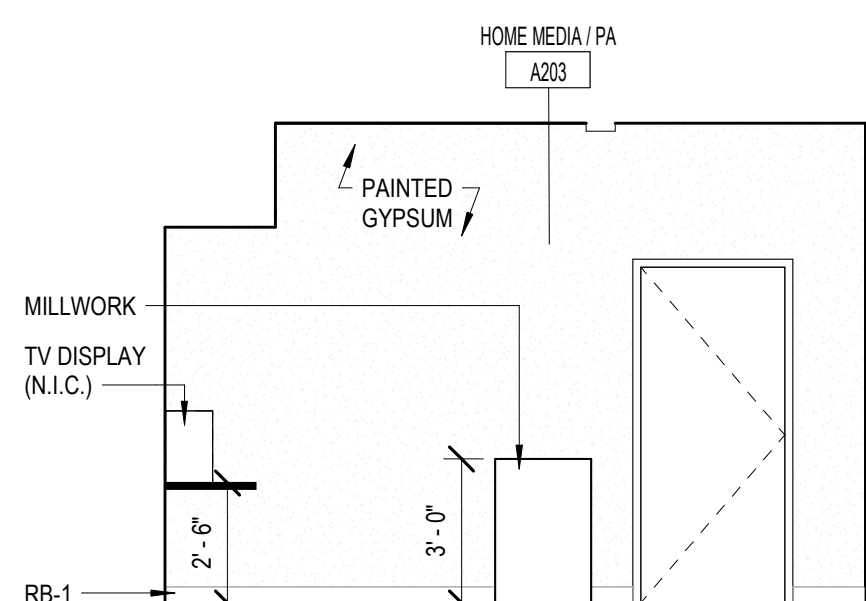


12 INTERIOR ELEVATION  
1/4" = 1'-0"

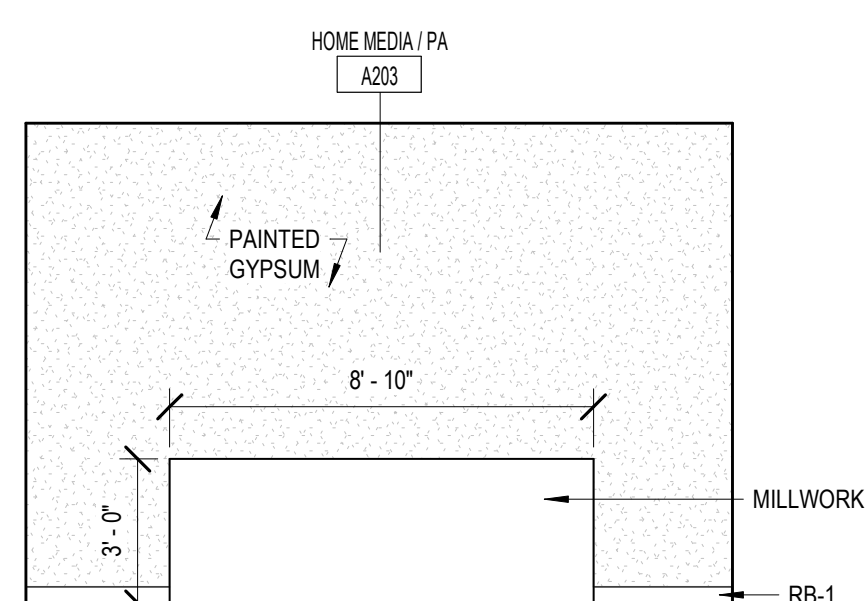


13 INTERIOR ELEVATION  
1/4" = 1'-0"

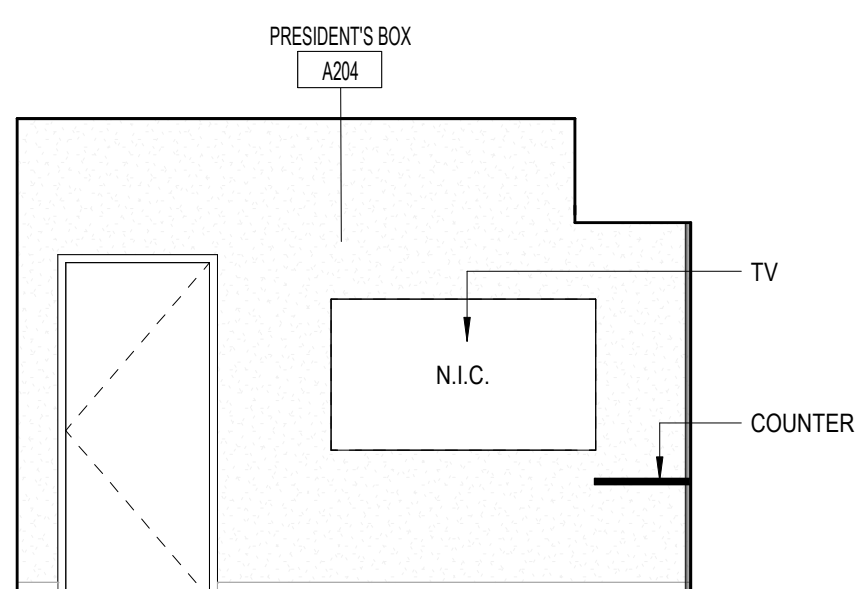

14 INTERIOR ELEVATION  
1/4" = 1'-0"

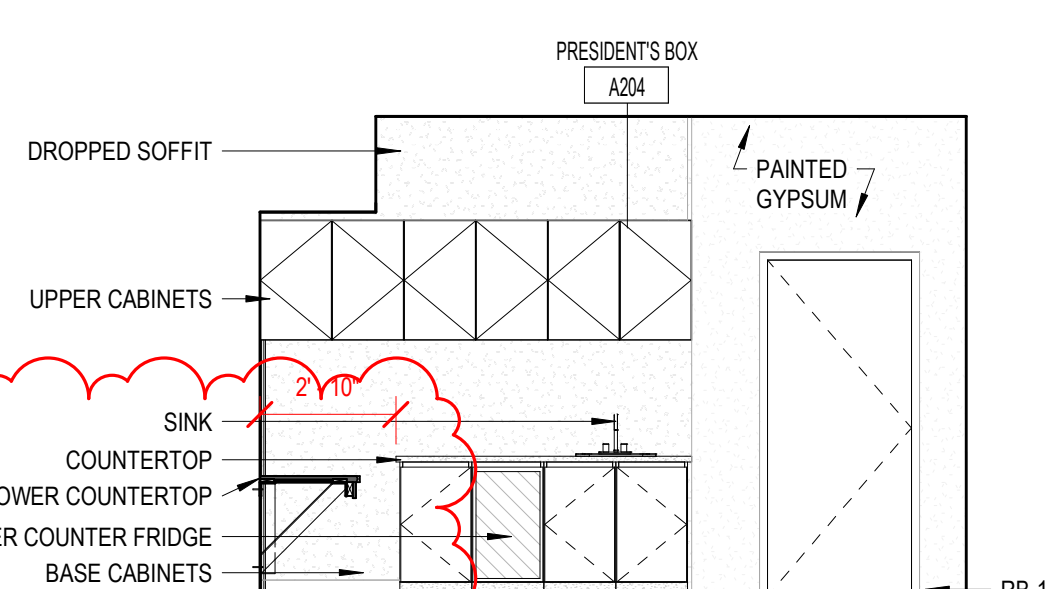



15 INTERIOR ELEVATION  
1/4" = 1'-0"

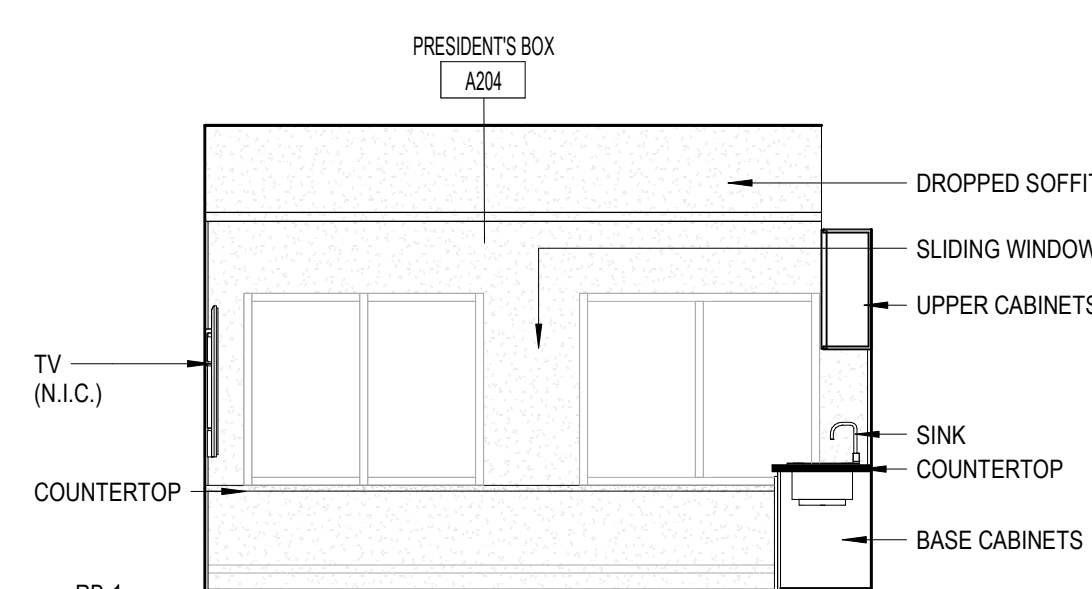

16 INTERIOR ELEVATION  
1/4" = 1'-0"

### TOILET ACCESSORIES

TPD TOILET PAPER DISPENSER  
PTD PAPER TOWEL DISPENSER  
HD HAND DRYER  
SD SOAP DISPENSER  
SND SANITARY NAPKIN DISPOSAL  
GB18 18" ADA GRAB BAR  
GB36 36" ADA GRAB BAR  
GB42 42" ADA GRAB BAR  
MR-1 MIRROR

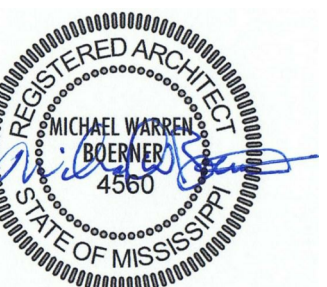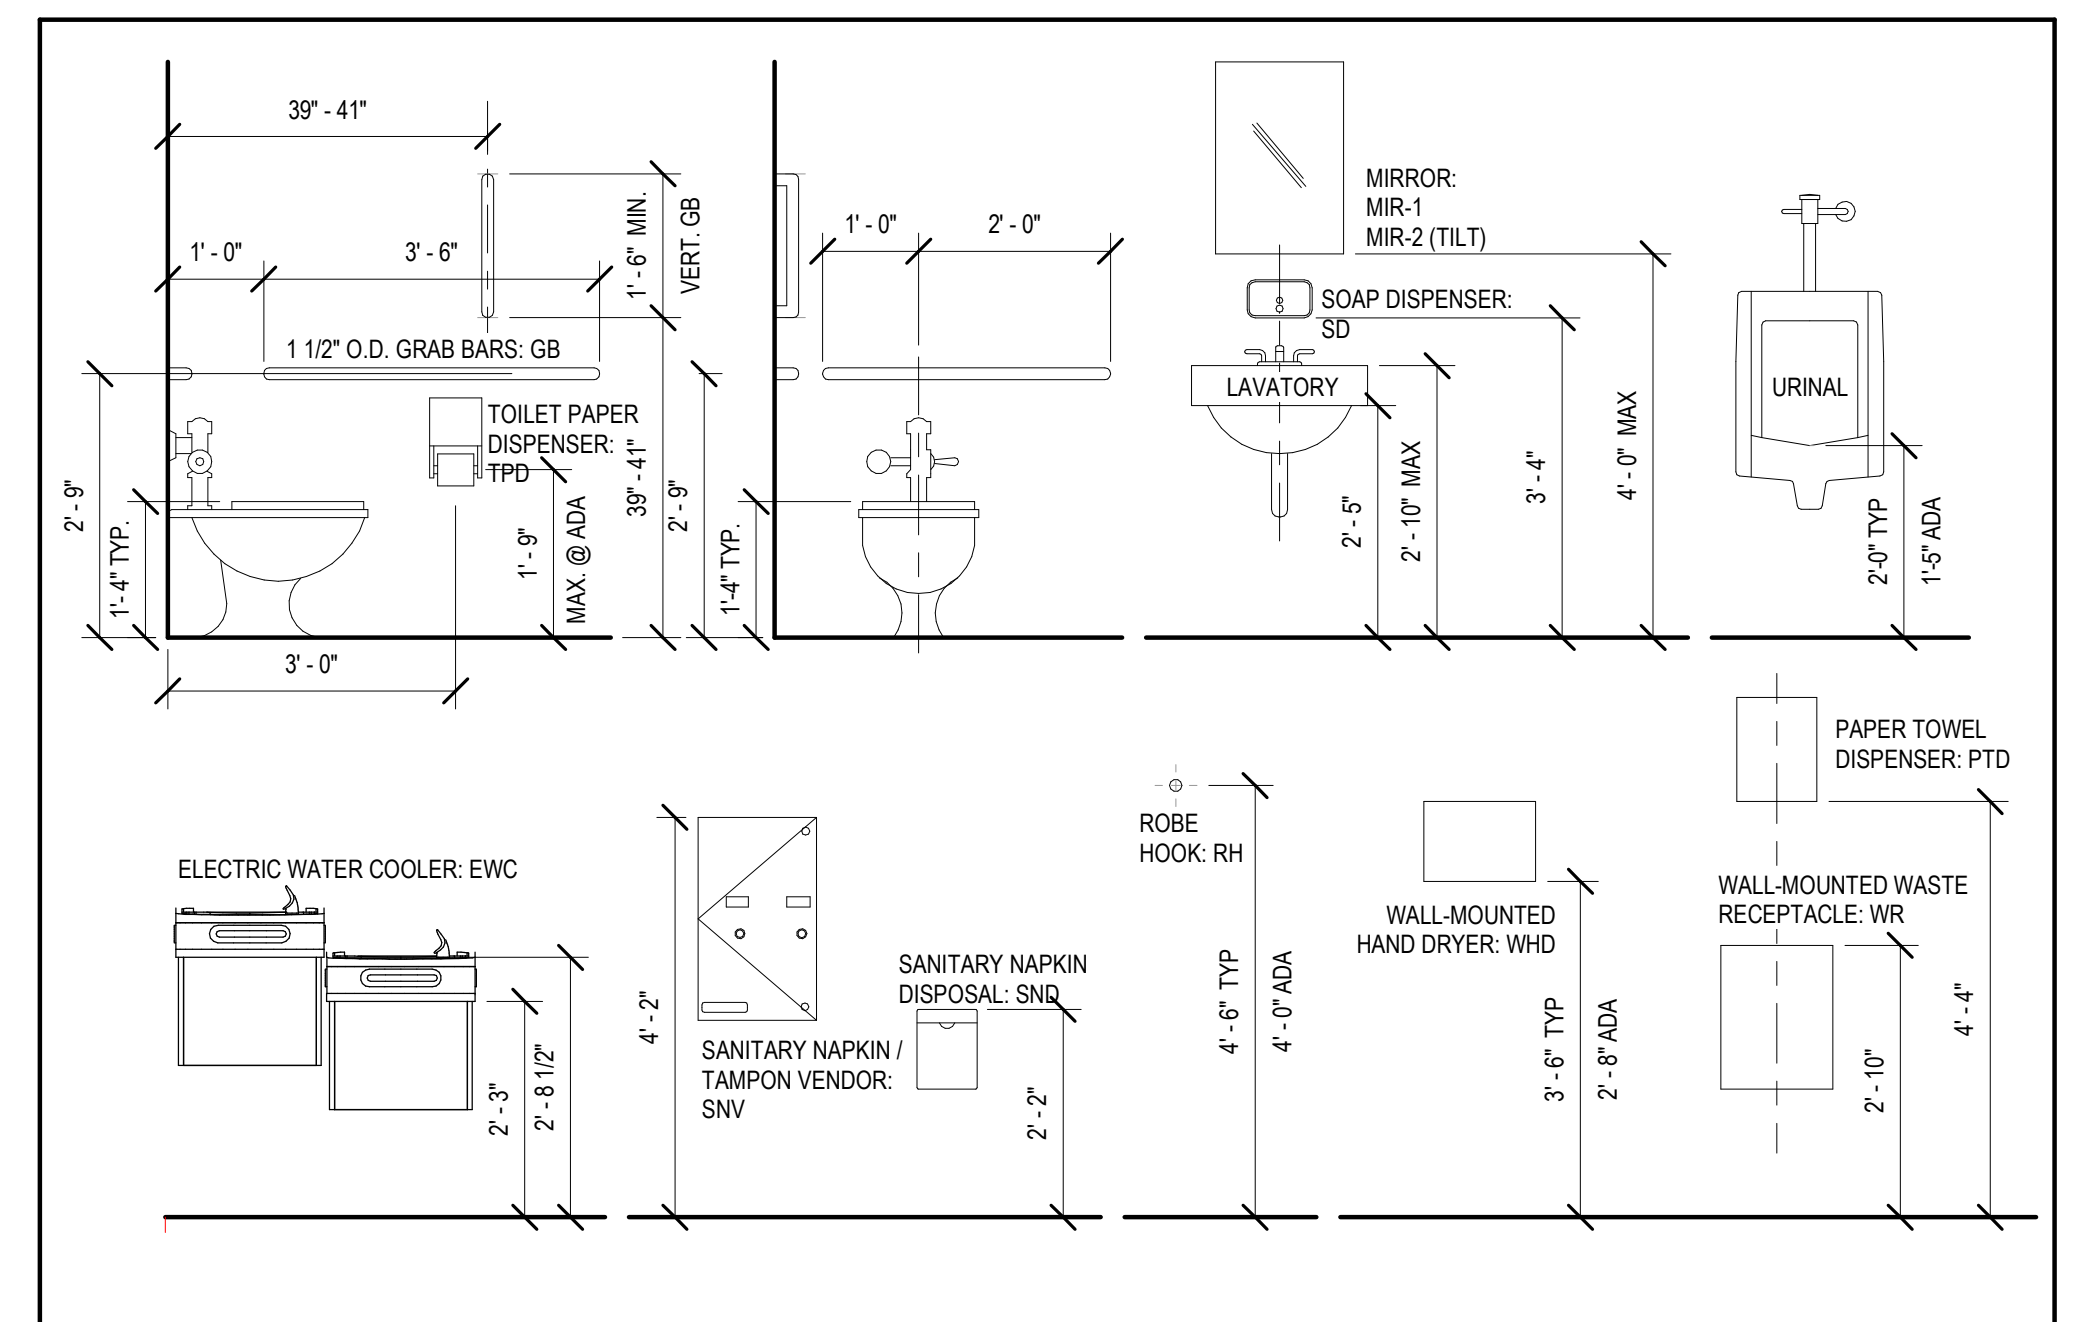


19 JANUARY 2022

**CONSTRUCTION  
DOCUMENTS**  
WBA # 21-053

REVISIONS		
NO.	DESCRIPTION	DATE
2	Addendum No. 02	02/09/2022

**A700**  
INTERIOR  
ELEVATIONS

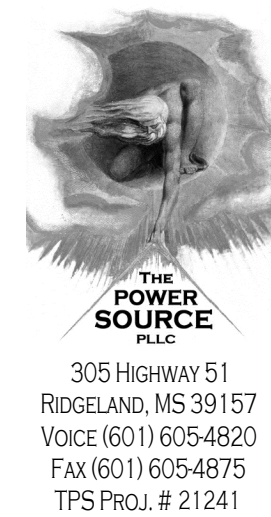



305 HIGHWAY 51  
RIDGELAND, MS 39157  
VOICE (601) 605-4820  
FAX (601) 605-4875  
TPS PROJ. # 21241



## BASEBALL FIELD AND STADIUM IMPROVEMENTS

COPIAH-LINCOLN  
COMMUNITY  
COLLEGE


H F McCarthy DRIVE,  
Wesson, Mississippi  
39191

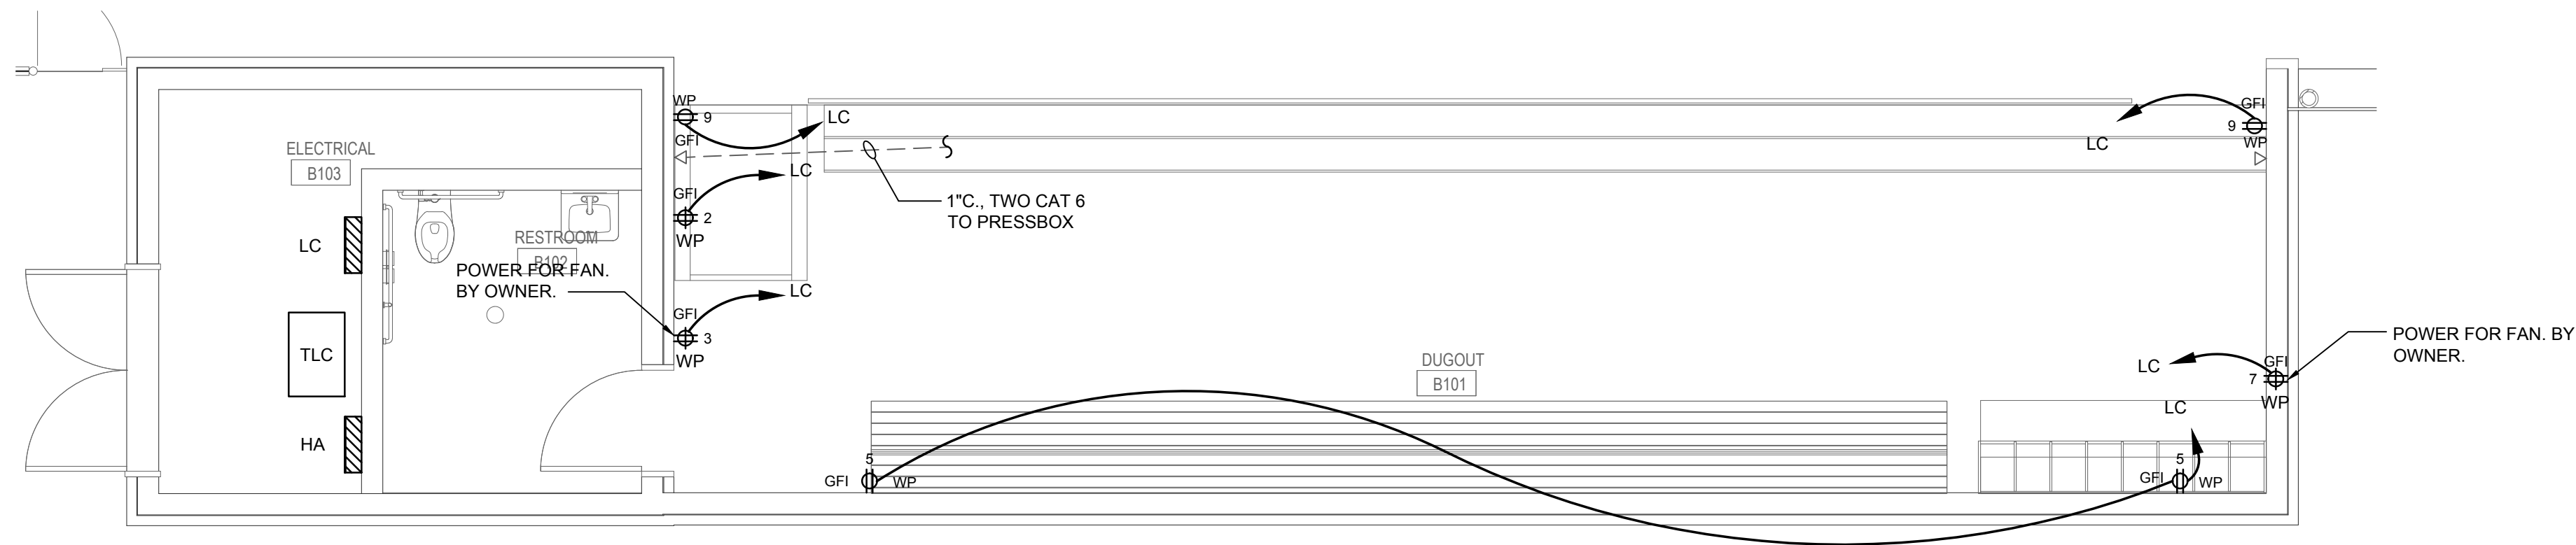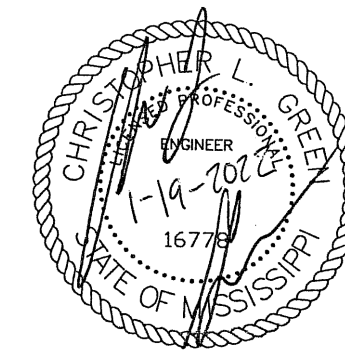

1  
E2.0

### HOME DUGOUT - ENLARGED PLAN - BASE BID

Scale: 1/4" = 1'-0"

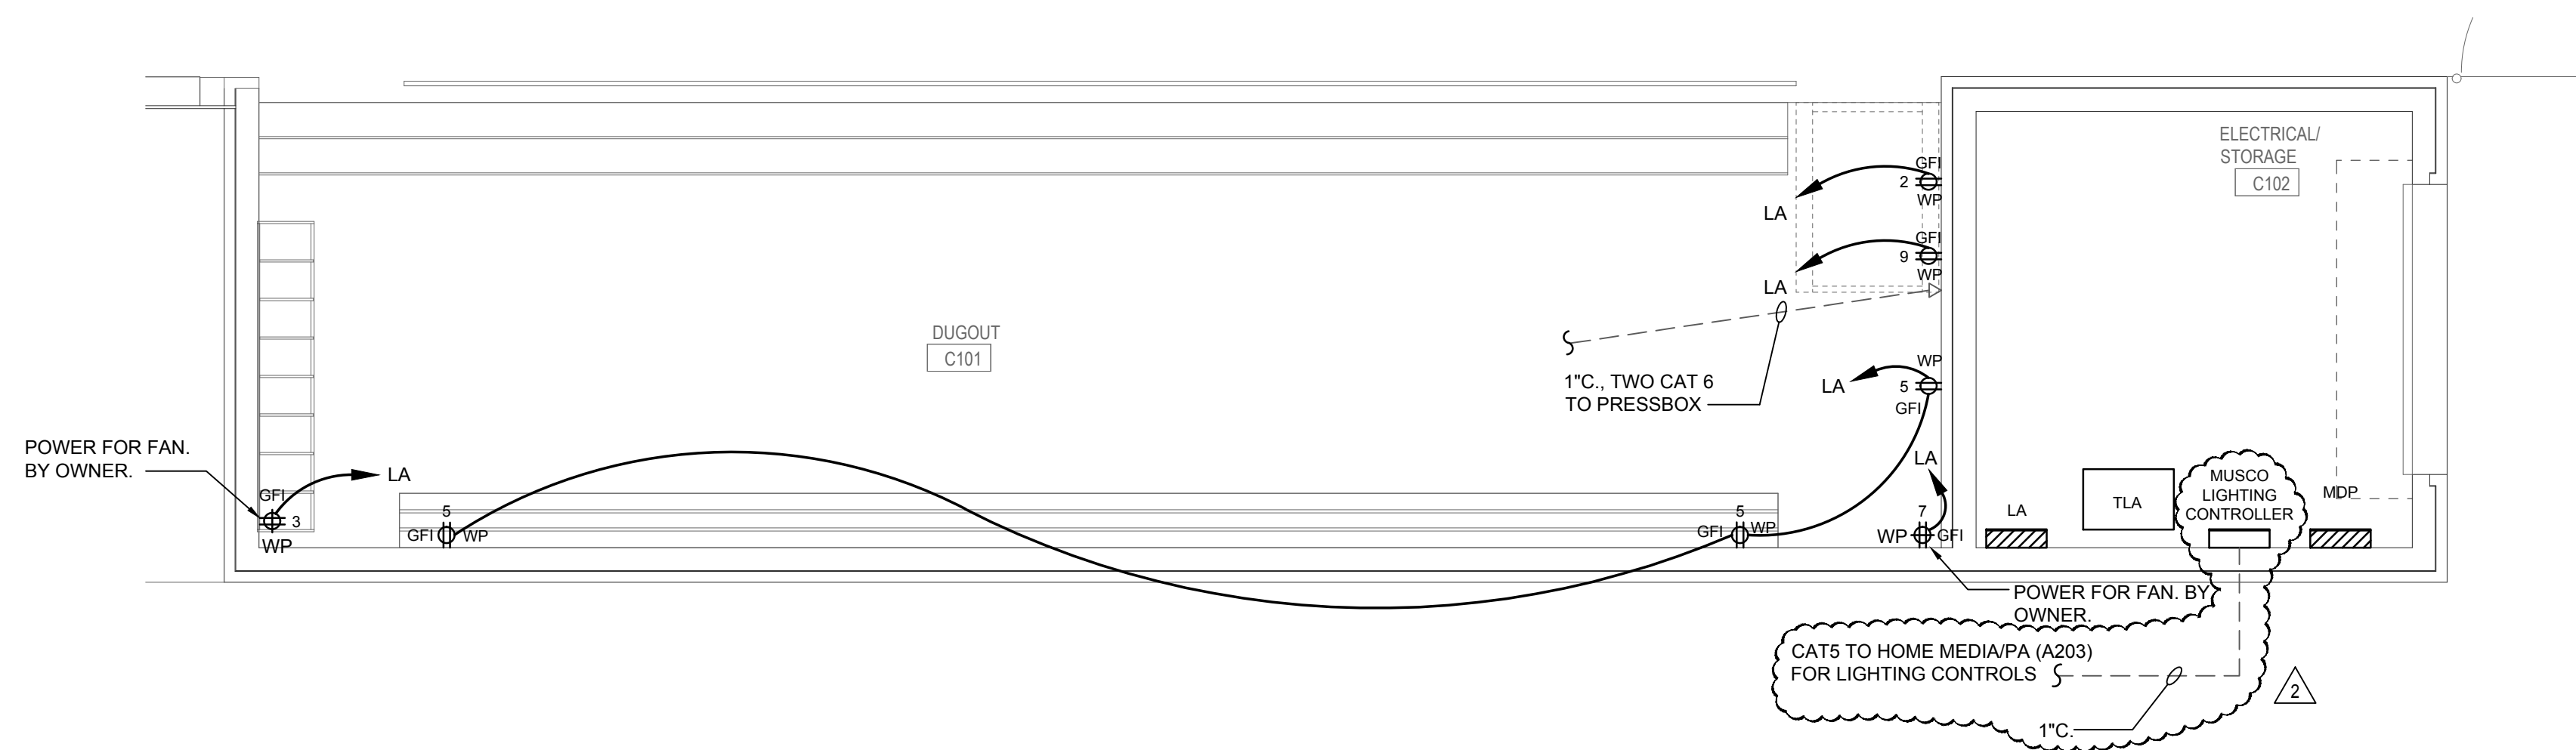

2  
E2.0

### VISITOR'S DUGOUT - ENLARGED PLAN - BASE BID

Scale: 1/4" = 1'-0"

19 JANUARY 2022

CONSTRUCTION  
DOCUMENTS  
WBA # 21-053

#### REVISIONS

NO.	DESCRIPTION	DATE
1	ADD #1	2022-02-02
2	ADD #2	2022-02-09

E2.0  
DUGOUT  
ENLARGED  
POWER PLAN