



Wednesday, April 6, 2022

Baseball Field Improvements  
Copiah-Lincoln Community College

---

## ADDENDUM NO. 01

### NOTICE TO ALL DOCUMENT HOLDERS:

The following additions, deletions, changes and clarifications to the drawings and specifications are to be included as part of the Contract Documents.

### SPECIFICATIONS



- ITEM NO. 01**      **SECTION 01.2100 ALLOWANCES**  
**Part 1 General, Section 5**  
**ADD** the following paragraph:  
D.    Package A: Irrigation System: Include the stipulated sum of \$25,000 for the purchase, delivery, and installation of a new Irrigation System. Design of irrigation system shall be coordinated and approved by the Civil Engineer.
- ITEM NO. 02**      **SECTION 32.1817 OUTDOOR SYNTHETIC PLAYING FIELD SURFACING**  
**Part 2 Products, Paragraph 1.B**  
**REPLACE** paragraph 1.B with the following:  
B.    Basis of Design: YSR Powerbase by Brock USA; 3090 Sterling Circle, Suite 102, Boulder, CO 80301, Phone: 303.544.5800, brockusa.com or approved equal.

### DRAWINGS

- ITEM NO. 03**      **SHEET C200 DEMOLITION PLAN**  
**Field Demolition Notes**  
**DELETE** Field Demolition Note #5.  
**Clarification:** The existing irrigation system will not be salvaged. A new irrigation system will be designed and installed under the irrigation allowance.
- ITEM NO. 04**      **SHEET C500 – UTILITY PLAN**  
**REPLACE** sheet C500 with the attached revised sheet **C500**.

Encl:    Drawings (1 Sheet - 24x36):  
          C500

cc:        All Document Holders  
          File 21-053.C2

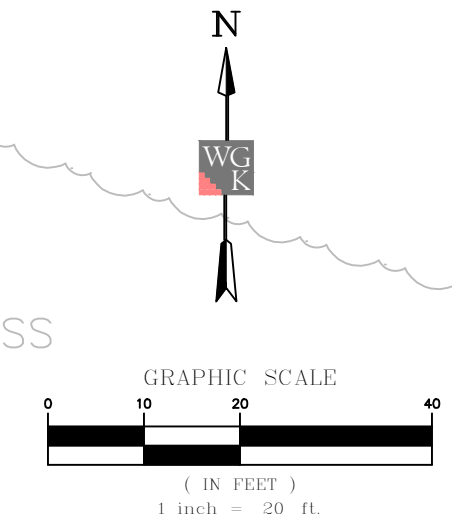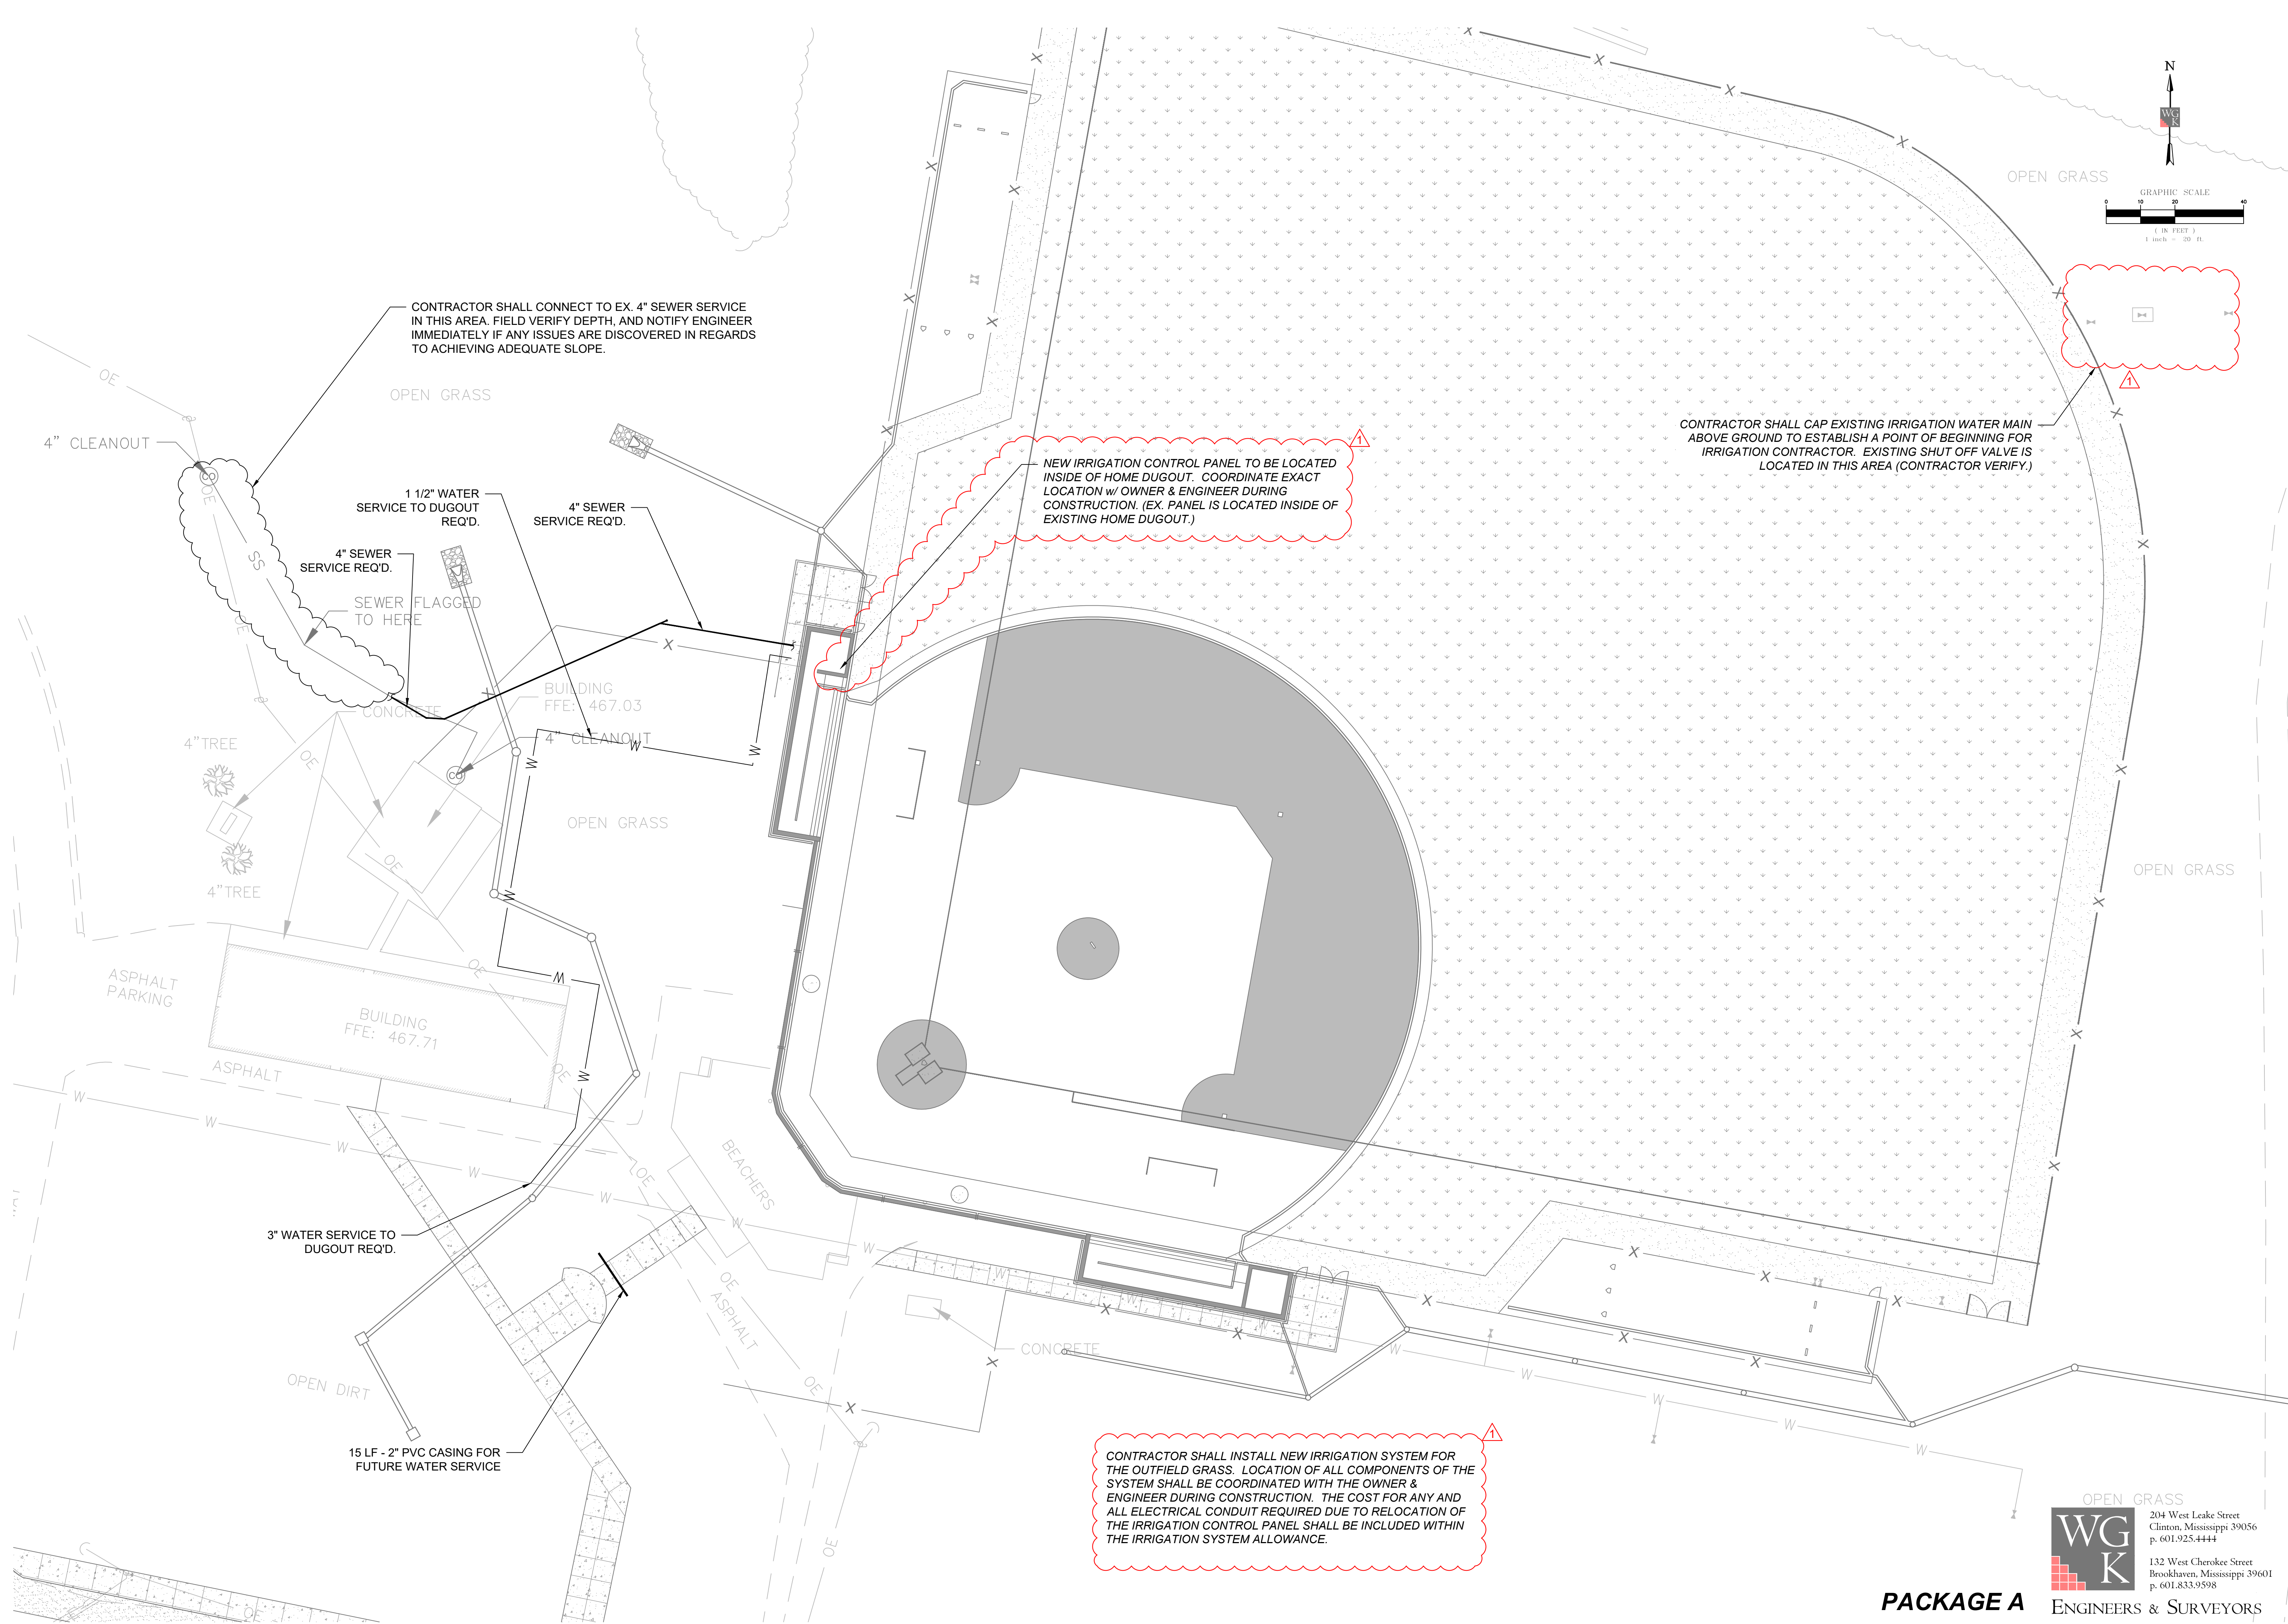

**BASEBALL  
FIELD  
IMPROVEMENTS**

**COPIAH-LINCOLN  
COMMUNITY  
COLLEGE**  
H.F. McCarthy DRIVE,  
Wesson, Mississippi  
39191



**CONSTRUCTION  
DOCUMENTS**  
WBA # 21-053

| REVISIONS |               |            |
|-----------|---------------|------------|
| NO.       | DESCRIPTION   | DATE       |
| 1         | Addendum No.1 | 04/06/2022 |

OPEN GRASS

**WG K**

ENGINEERS & SURVEYORS

204 West Leake Street  
Clinton, Mississippi 39056  
p. 601.925.4444

132 West Cherokee Street  
Brookhaven, Mississippi 39601  
p. 601.833.9598

**PACKAGE A**

**C500**  
UTILITY PLAN