



7 October 2022

GS#610-012 MCM LeFleur's Bluff Park Improvements (Phase 2)  
Mississippi Department of Wildlife, Fisheries, and Parks



---

## ADDENDUM NO. 04

### NOTICE TO ALL DOCUMENT HOLDERS:

The following additions, deletions, changes and clarifications to the drawings and specifications are to be included as part of the Contract Documents.


### CLARIFICATION

- ITEM NO. 01      ALTERNATE 01 EARTHWORK**  
**CLARIFICATION:** The 12" of liming mentioned in the Geotechnical Report - *Section 5.6 Guideline Pavement Recommendations* is not required under the Alternate 01 walking trail.
- ITEM NO. 02      MILL AND OVERLAY**  
**CLARIFICATION:** All mill and overlay work to be at a depth of 1.5".

### ARCHITECTURE

- ITEM NO. 03      A100 – ARCHITECTURAL SITE PLAN**  
**REPLACE** sheet with the attached **A100**.  
ADDS scope related to fencing at entry gate: demolition of portion of existing fencing and installation of new fencing to match existing. Swing gates to remain in place.

cc:      All Document Holders  
         File 0619

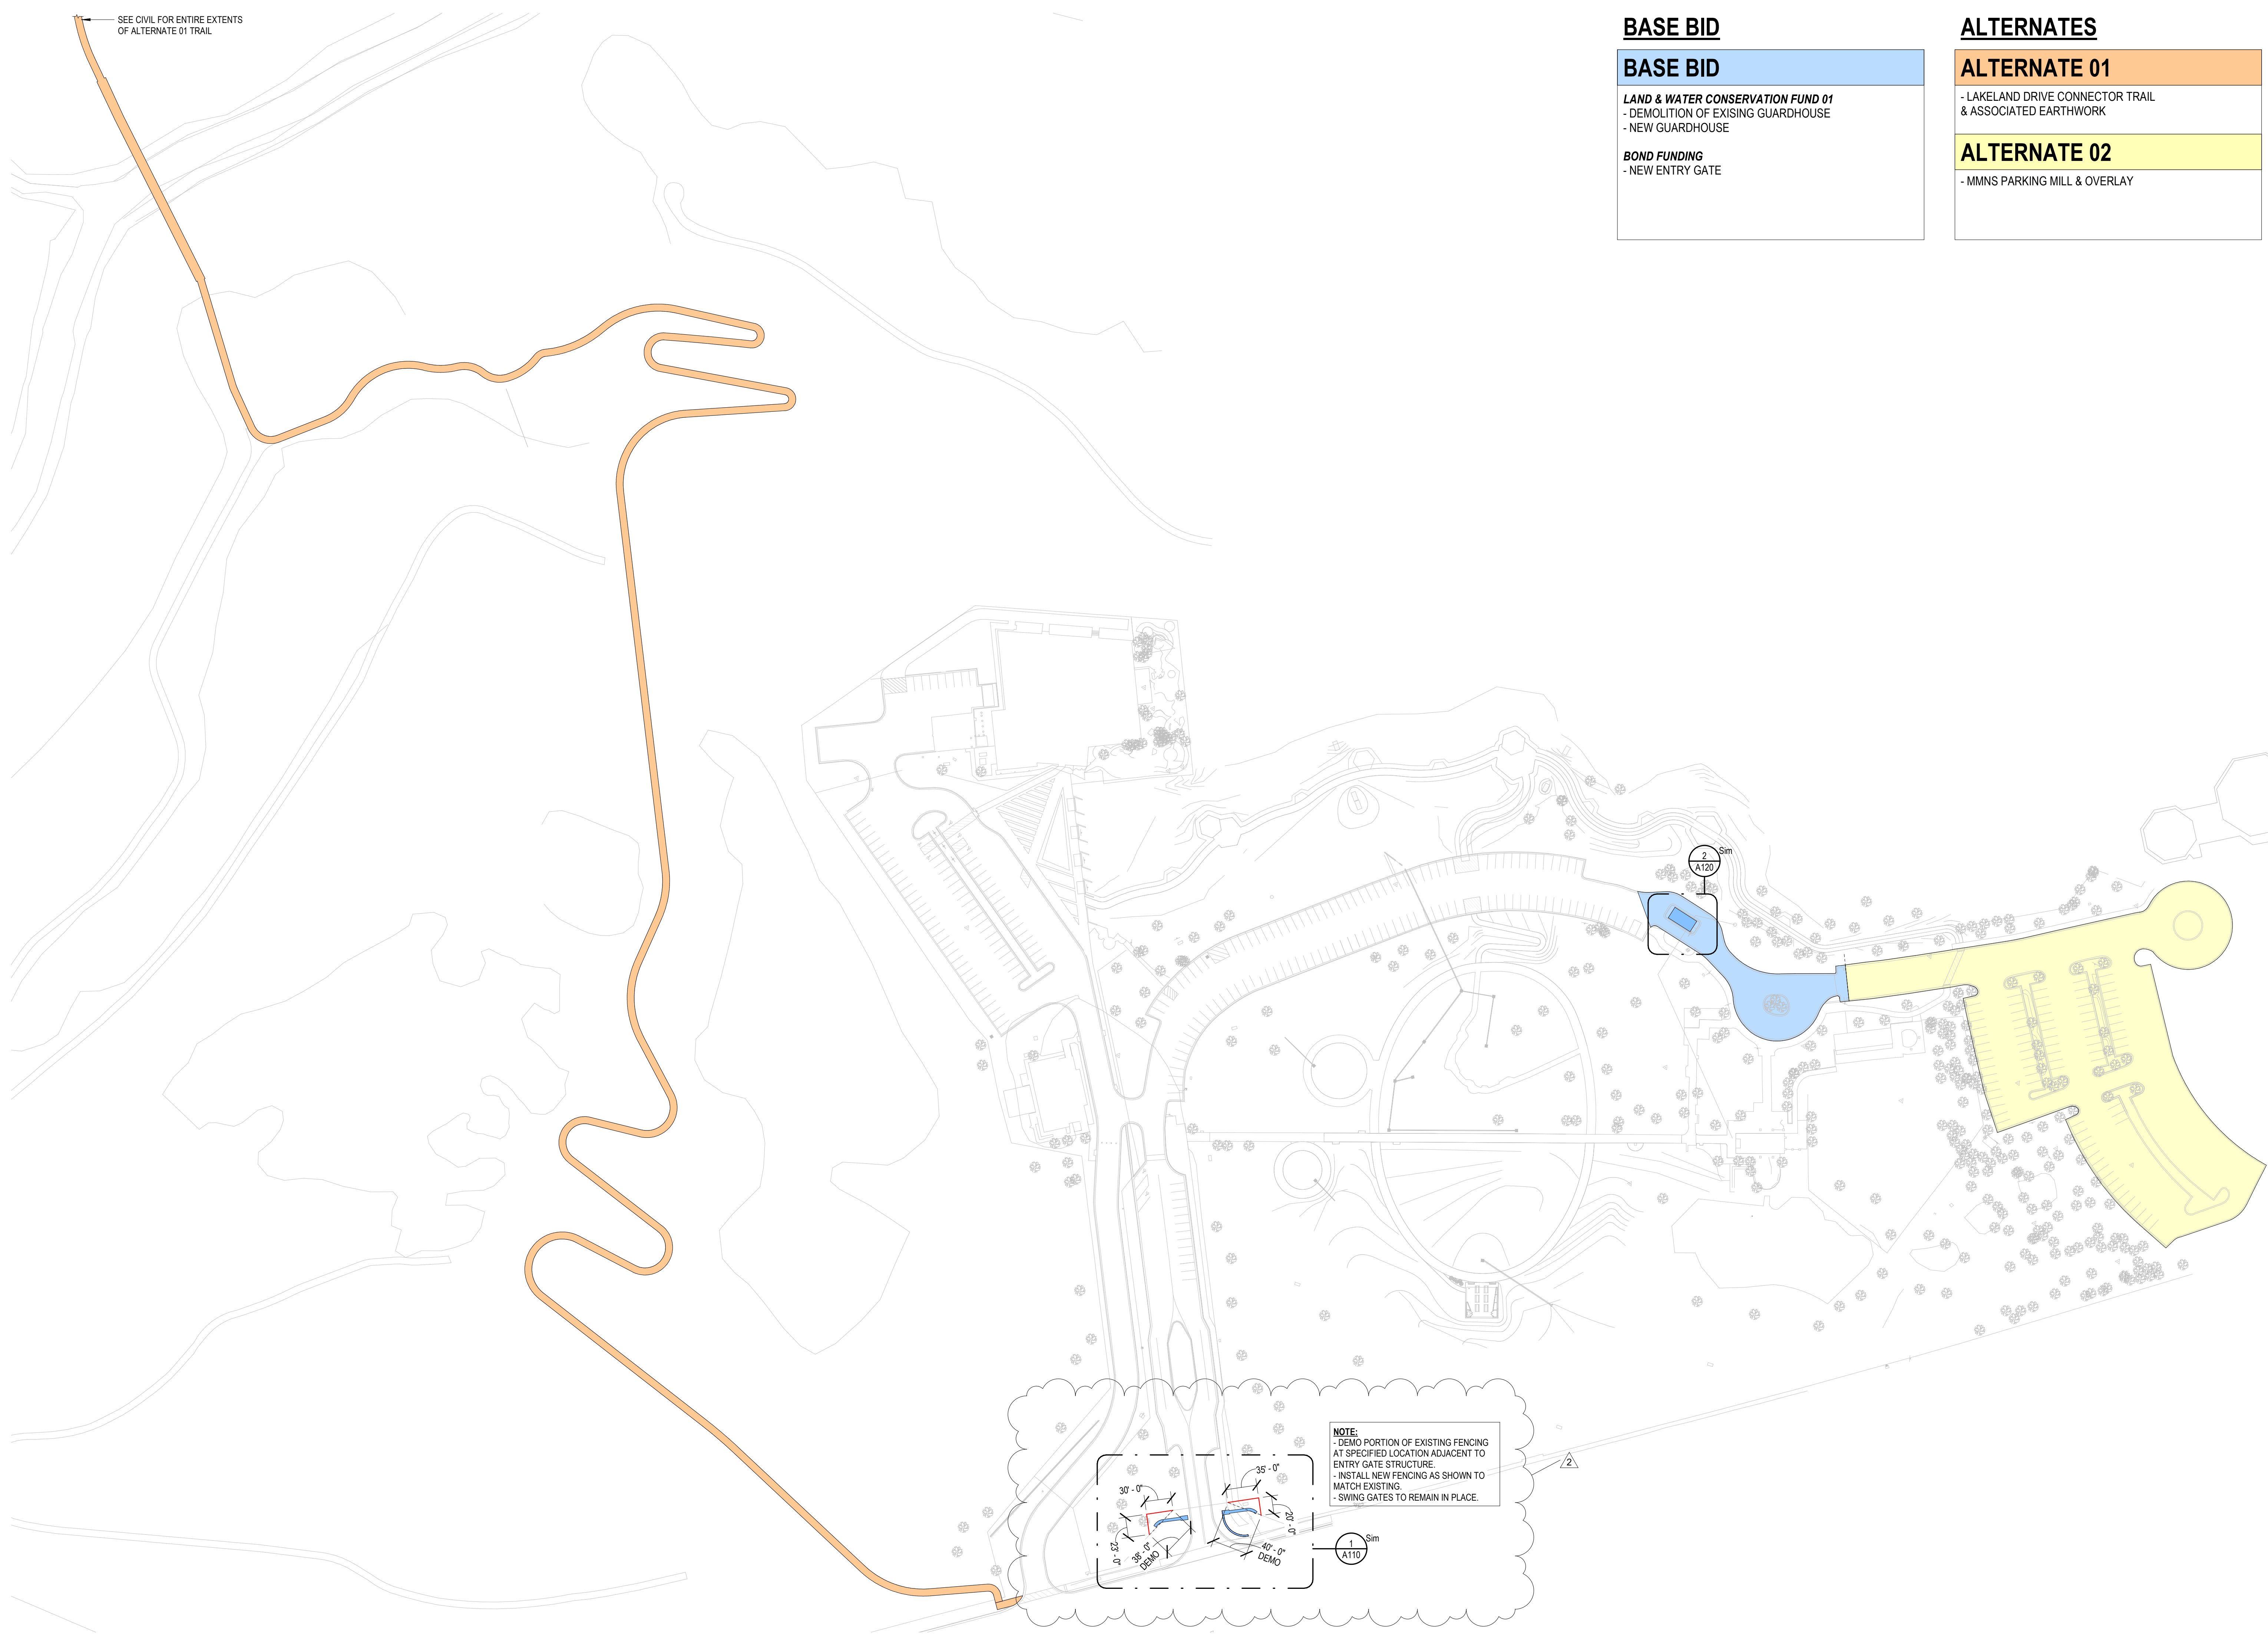

SEE CIVIL FOR ENTIRE EXTENTS  
OF ALTERNATE 01 TRAIL

**BASE BID**

**BASE BID**

**LAND & WATER CONSERVATION FUND 01**  
- DEMOLITION OF EXISING GUARDHOUSE  
- NEW GUARDHOUSE

**BOND FUNDING**  
- NEW ENTRY GATE

**ALTERNATES**

**ALTERNATE 01**

- LAKELAND DRIVE CONNECTOR TRAIL  
& ASSOCIATED EARTHWORK

**ALTERNATE 02**

- MMNS PARKING MILL & OVERLAY



**GS# 610-012**  
**MDWFP**  
**LEFLEUR'S BLUFF**  
**PARK**  
**IMPROVEMENTS**  
**(PHASE 2)**

MISSISSIPPI  
DEPARTMENT OF  
WILDLIFE, FISHERIES,  
AND PARKS  
Riverside Park Circle  
Jackson, MS 39202

7/29/22

**CONSTRUCTION**  
**DOCUMENTS**

WBA # 0619

REVISIONS

NO.	DESCRIPTION	DATE
1	ADDENDUM 02	9.23.22
2	ADDENDUM 04	10.7.22

**A100**  
ARCHITECTURAL  
SITE PLAN