

Addendum-1

To: Bidders

Job Name:

Hinds Parkway Gateway
Signage Landscaping

From: Jared Acy

WAS Job #:

206007-002


Date: Dec 7, 2022

Job Phase:

BID

Re: Addendum-1

- 1) Fountain equipment shall be by Coastal Pond and Fountain (Contact -Frank Scott at P: 800.782.6179) or approved equal.
- 2) All sides of the large sign wall shall receive stucco including the back of the wall.
- 3) The Contractor will be responsible for running required wire and 1.5" conduit from service to meter at back of sign and any associated fees required by entergy.
- 4) Junction box shown within the fountain basin is schematic in nature. Junction box to be located in the ground at the back of sign wall.
- 5) Lower wall precast caps to be broken by scuppers with the precast caps butting into scuppers. See attached sign elevation for clarification.
- 6) The Contractor will be responsible for any and all fees associated with meter tap and placement.
- 7) The Font for the wall text did not print correctly within the bid documents. See attached PDF for correct style of font.
- 8) Back-lit sign letters to be warm light max 3000k to match water feature lighting.
- 9) A photocell shall be included for sign and water feature lighting.
- 10) Reference sheet LH201 for spec of the control panel shown on sheet ES100 at back of sign.

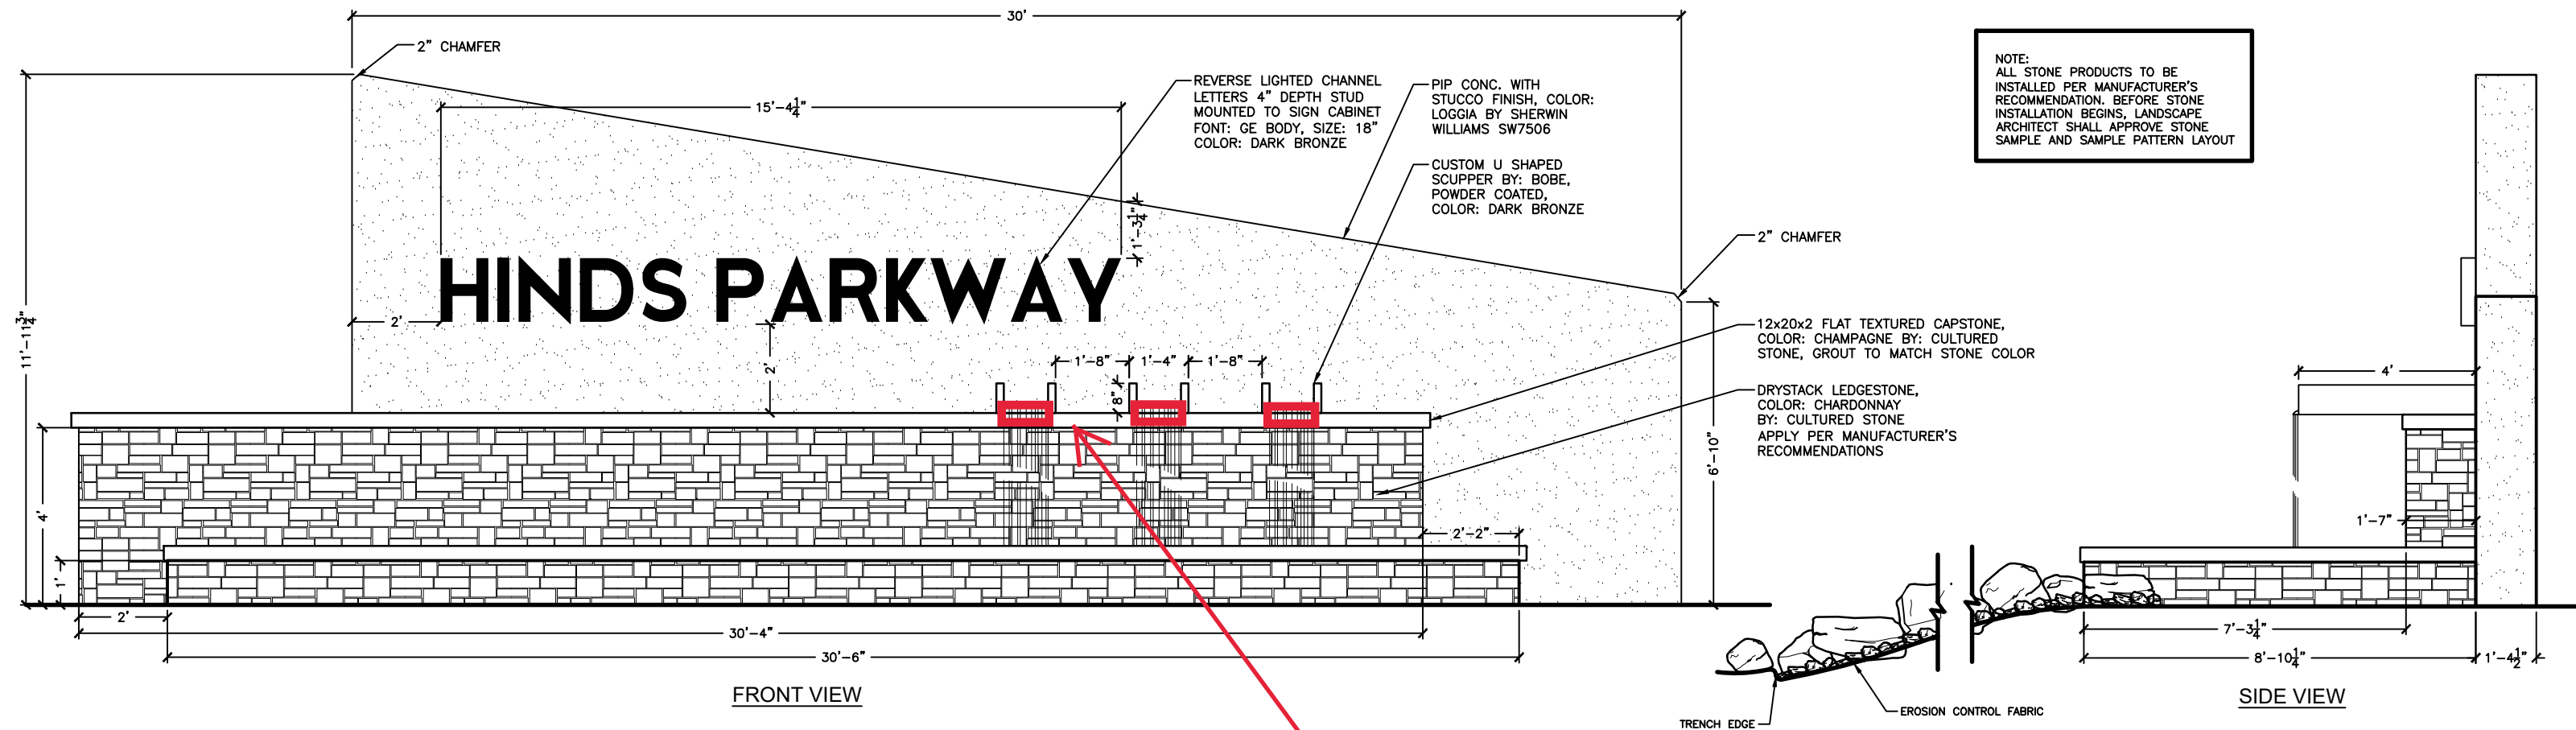

1 SIGN ELEVATIONS

Not to scale

Move scuppers
down, precast cap
to butt scuppers