



Addendum-2

To: Bidders

Job Name:

Hinds Parkway Gateway

From: Jared Acy

WAS Job #:

Signage Landscaping

Date: Dec 8, 2022

Job Phase:

206007-002

BID

Re: Addendum-1

- 1) Meter location and water source adjusted. Water to be supplied from the existing water main located at the East side of Davis Road in front of the Dollar General. This will require an additional boring.
- 2) See updated irrigation plans Addendum-2 dated 12/08/22.

A Landscape Development Plan for
Hinds Parkway
Byram, Mississippi

Revisions		
No.	Date	Revisions / Submissions
1	11.11.22	ISSUED FOR BID
2	12.08.22	ADDENDUM 2



LDC	_____	Registration
Drawn	_____	
JLA	_____	
Checked	_____	
206007-002	_____	
Project No.	_____	
07.14.22	_____	
Date	_____	


REGISTERED LANDSCAPE ARCHITECT
JULIA A. WATKINS
498
STATE OF MISSISSIPPI

Sheet Title

**OVERALL
IRRIGATION PLAN**

Sheet No.
LI100

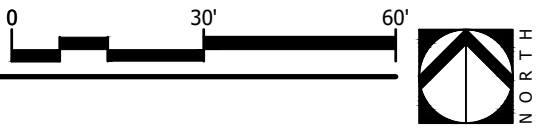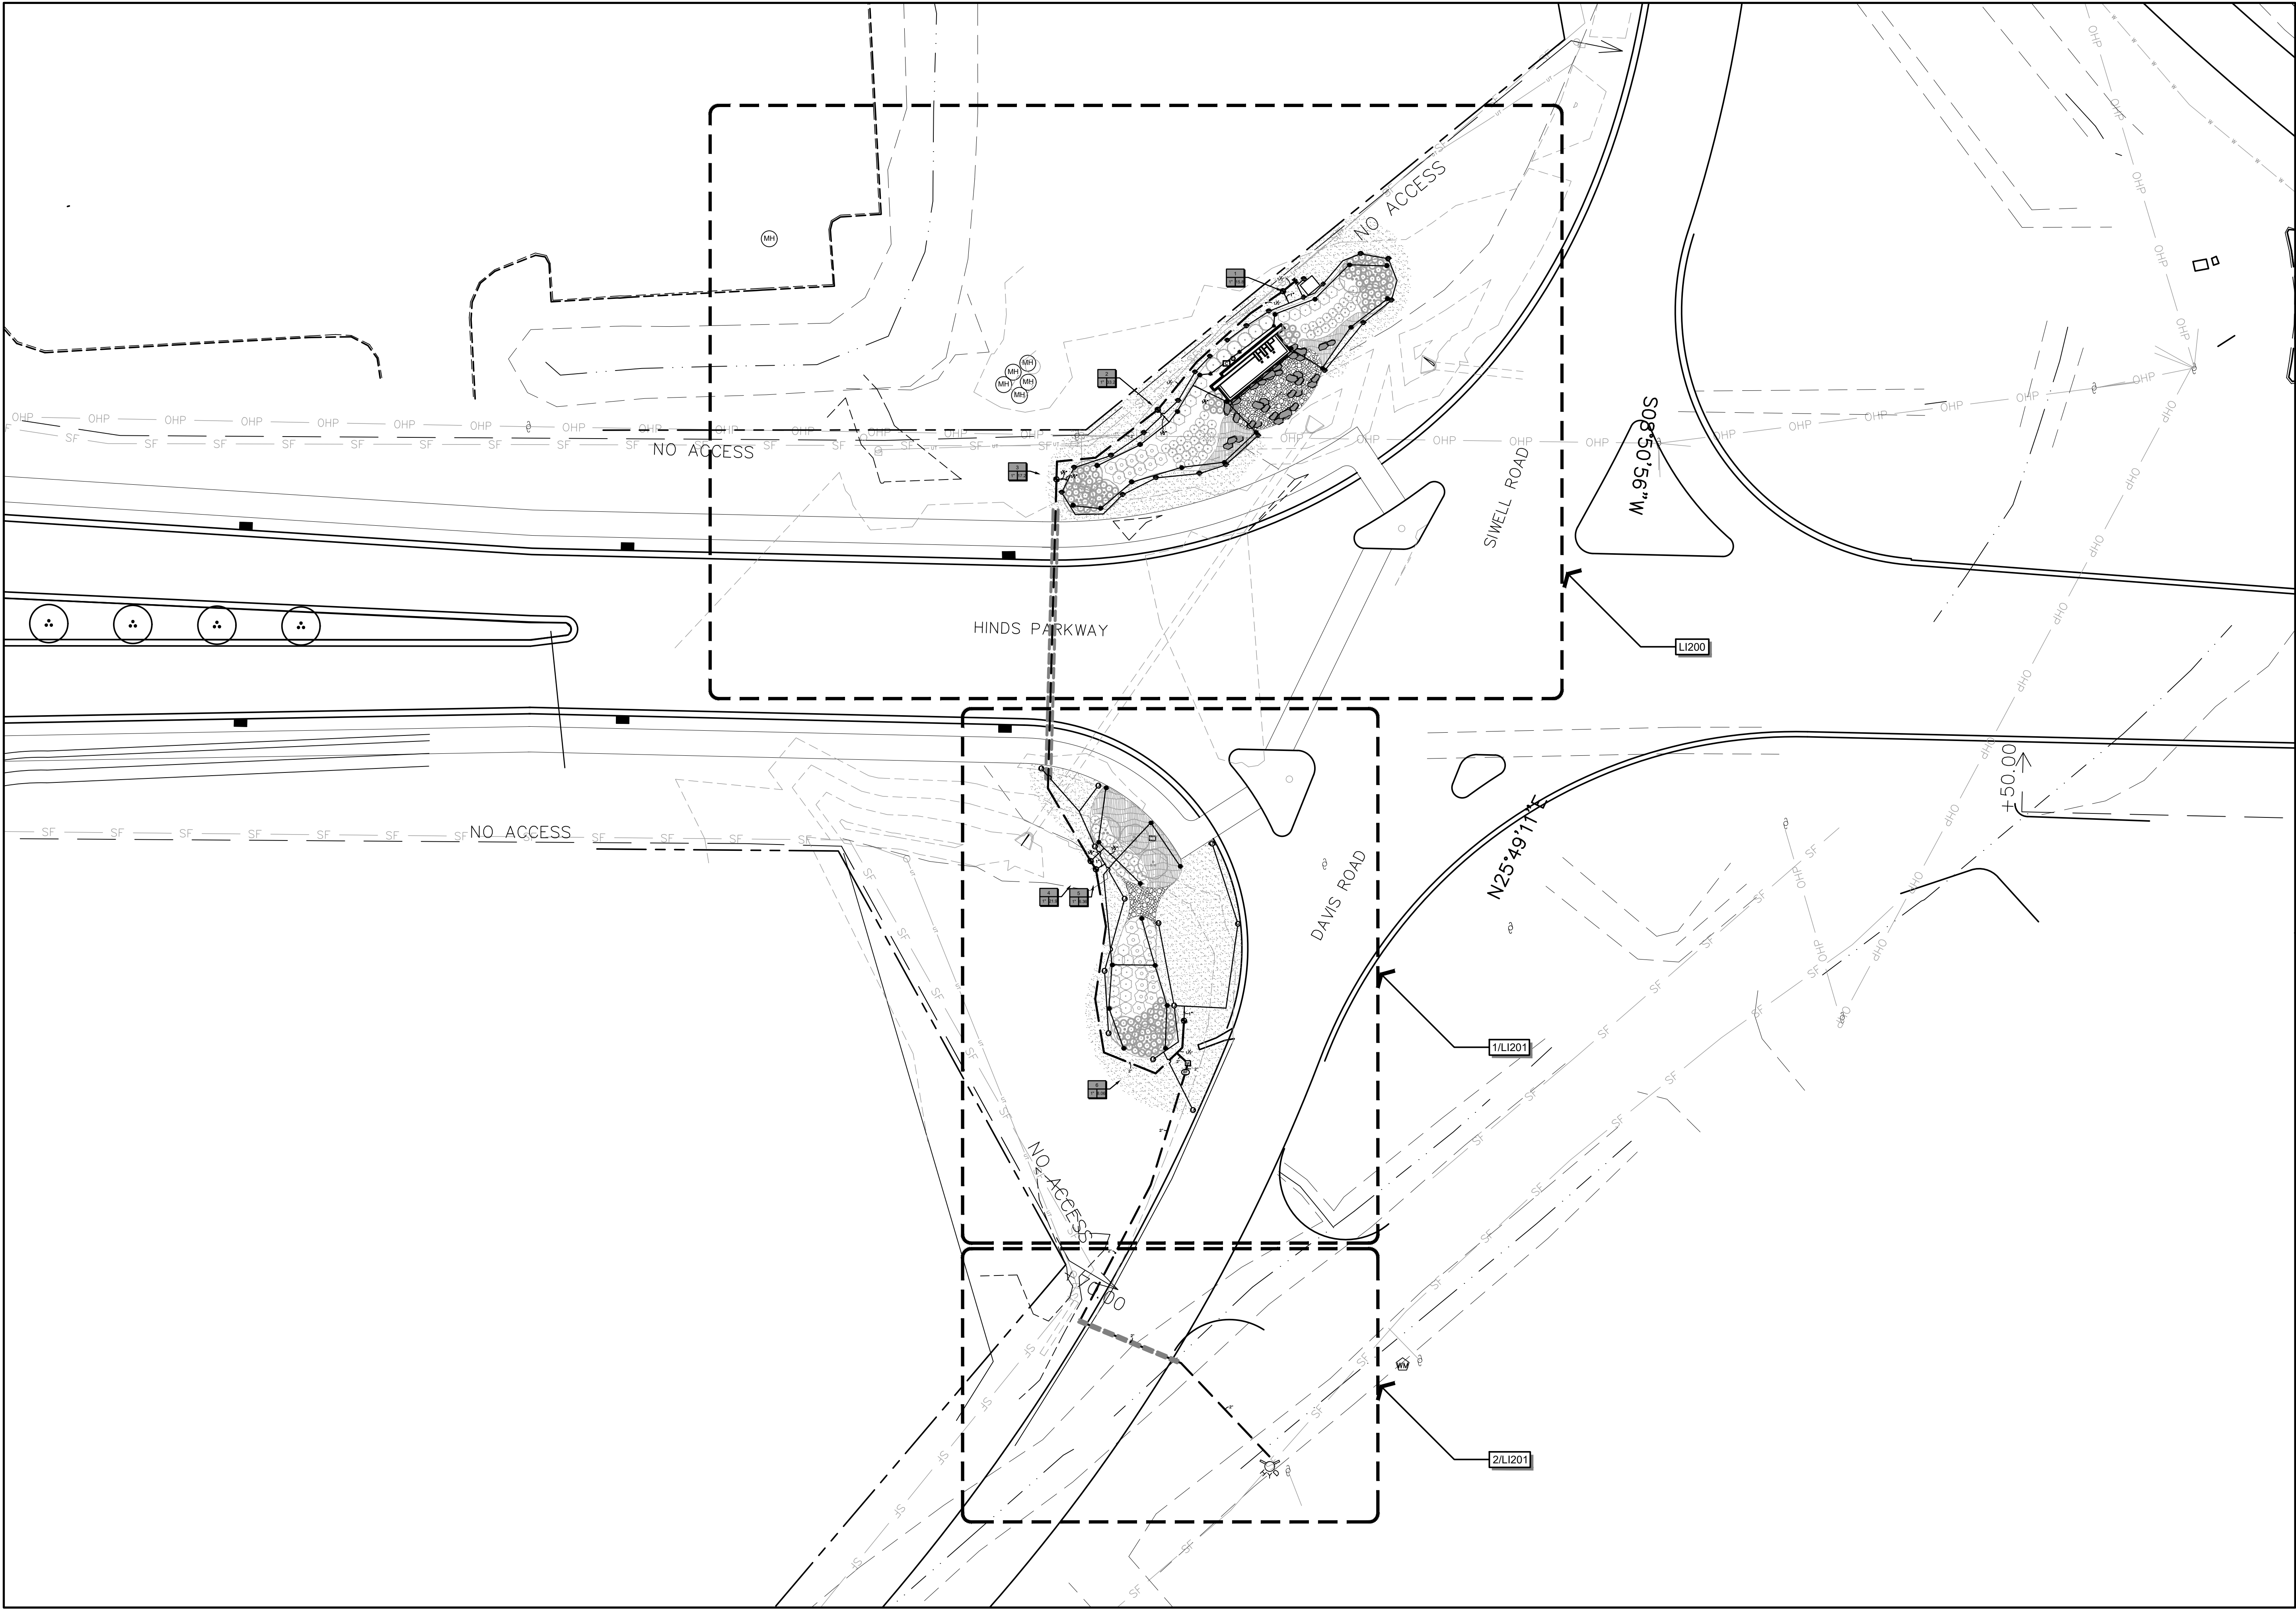

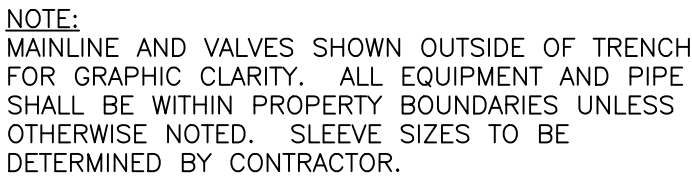

A Landscape Development Plan for Hinds Parkway

Byram, Mississippi

LDC
Drown
JLA
Checked
206007-002
Project No.
07.14.22
Date



IRRIGATION PLAN ENLARGEMENT

LI200

A Landscape Development Plan for
Hinds Parkway
Byram, Mississippi


Revisions		
No.	Date	Revisions / Submissions
	11.11.22	ISSUED FOR BID
1	12.08.22	ADDENDUM 2

Registration	
LDC Drawn	
JLA Checked	
206007-002 Project No.	
07.14.22 Date	


REGISTERED LANDSCAPE ARCHITECT
JULIA A. WATSON
498
STATE OF MISSISSIPPI

Sheet Title

**IRRIGATION PLAN
ENLARGEMENT**

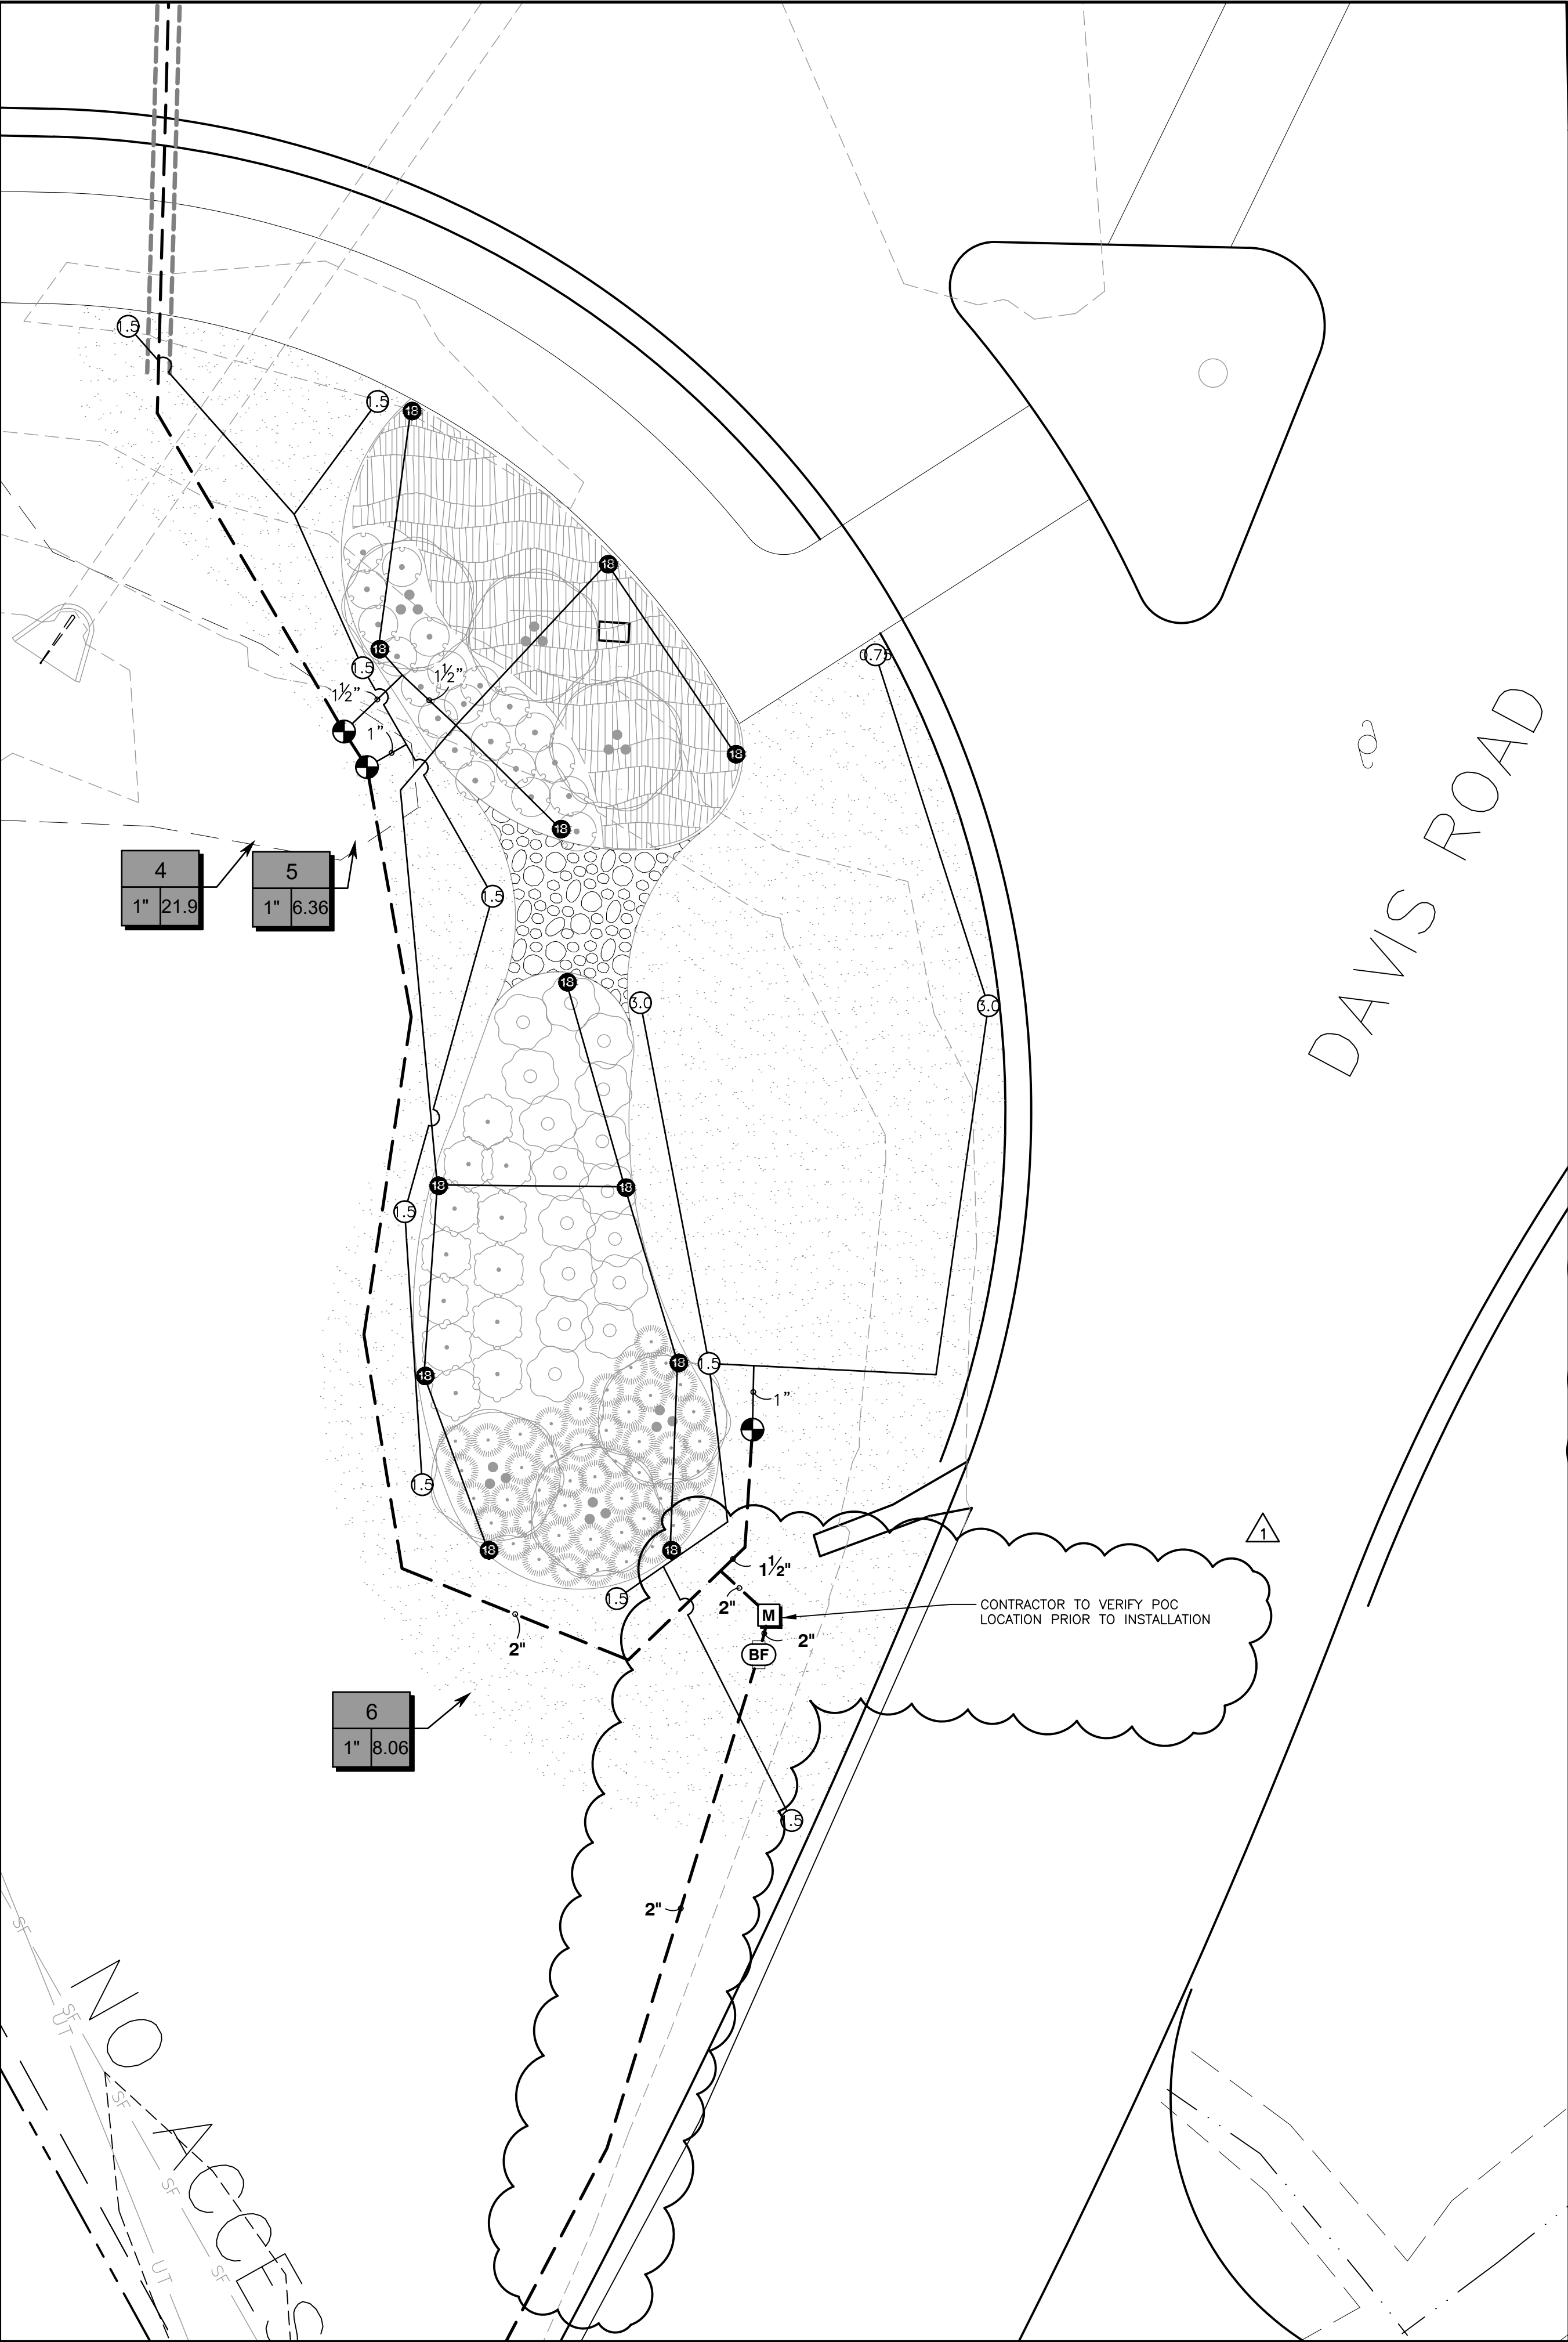

1 IRRIGATION PLAN ENLARGEMENT
Scale: 1" = 10'

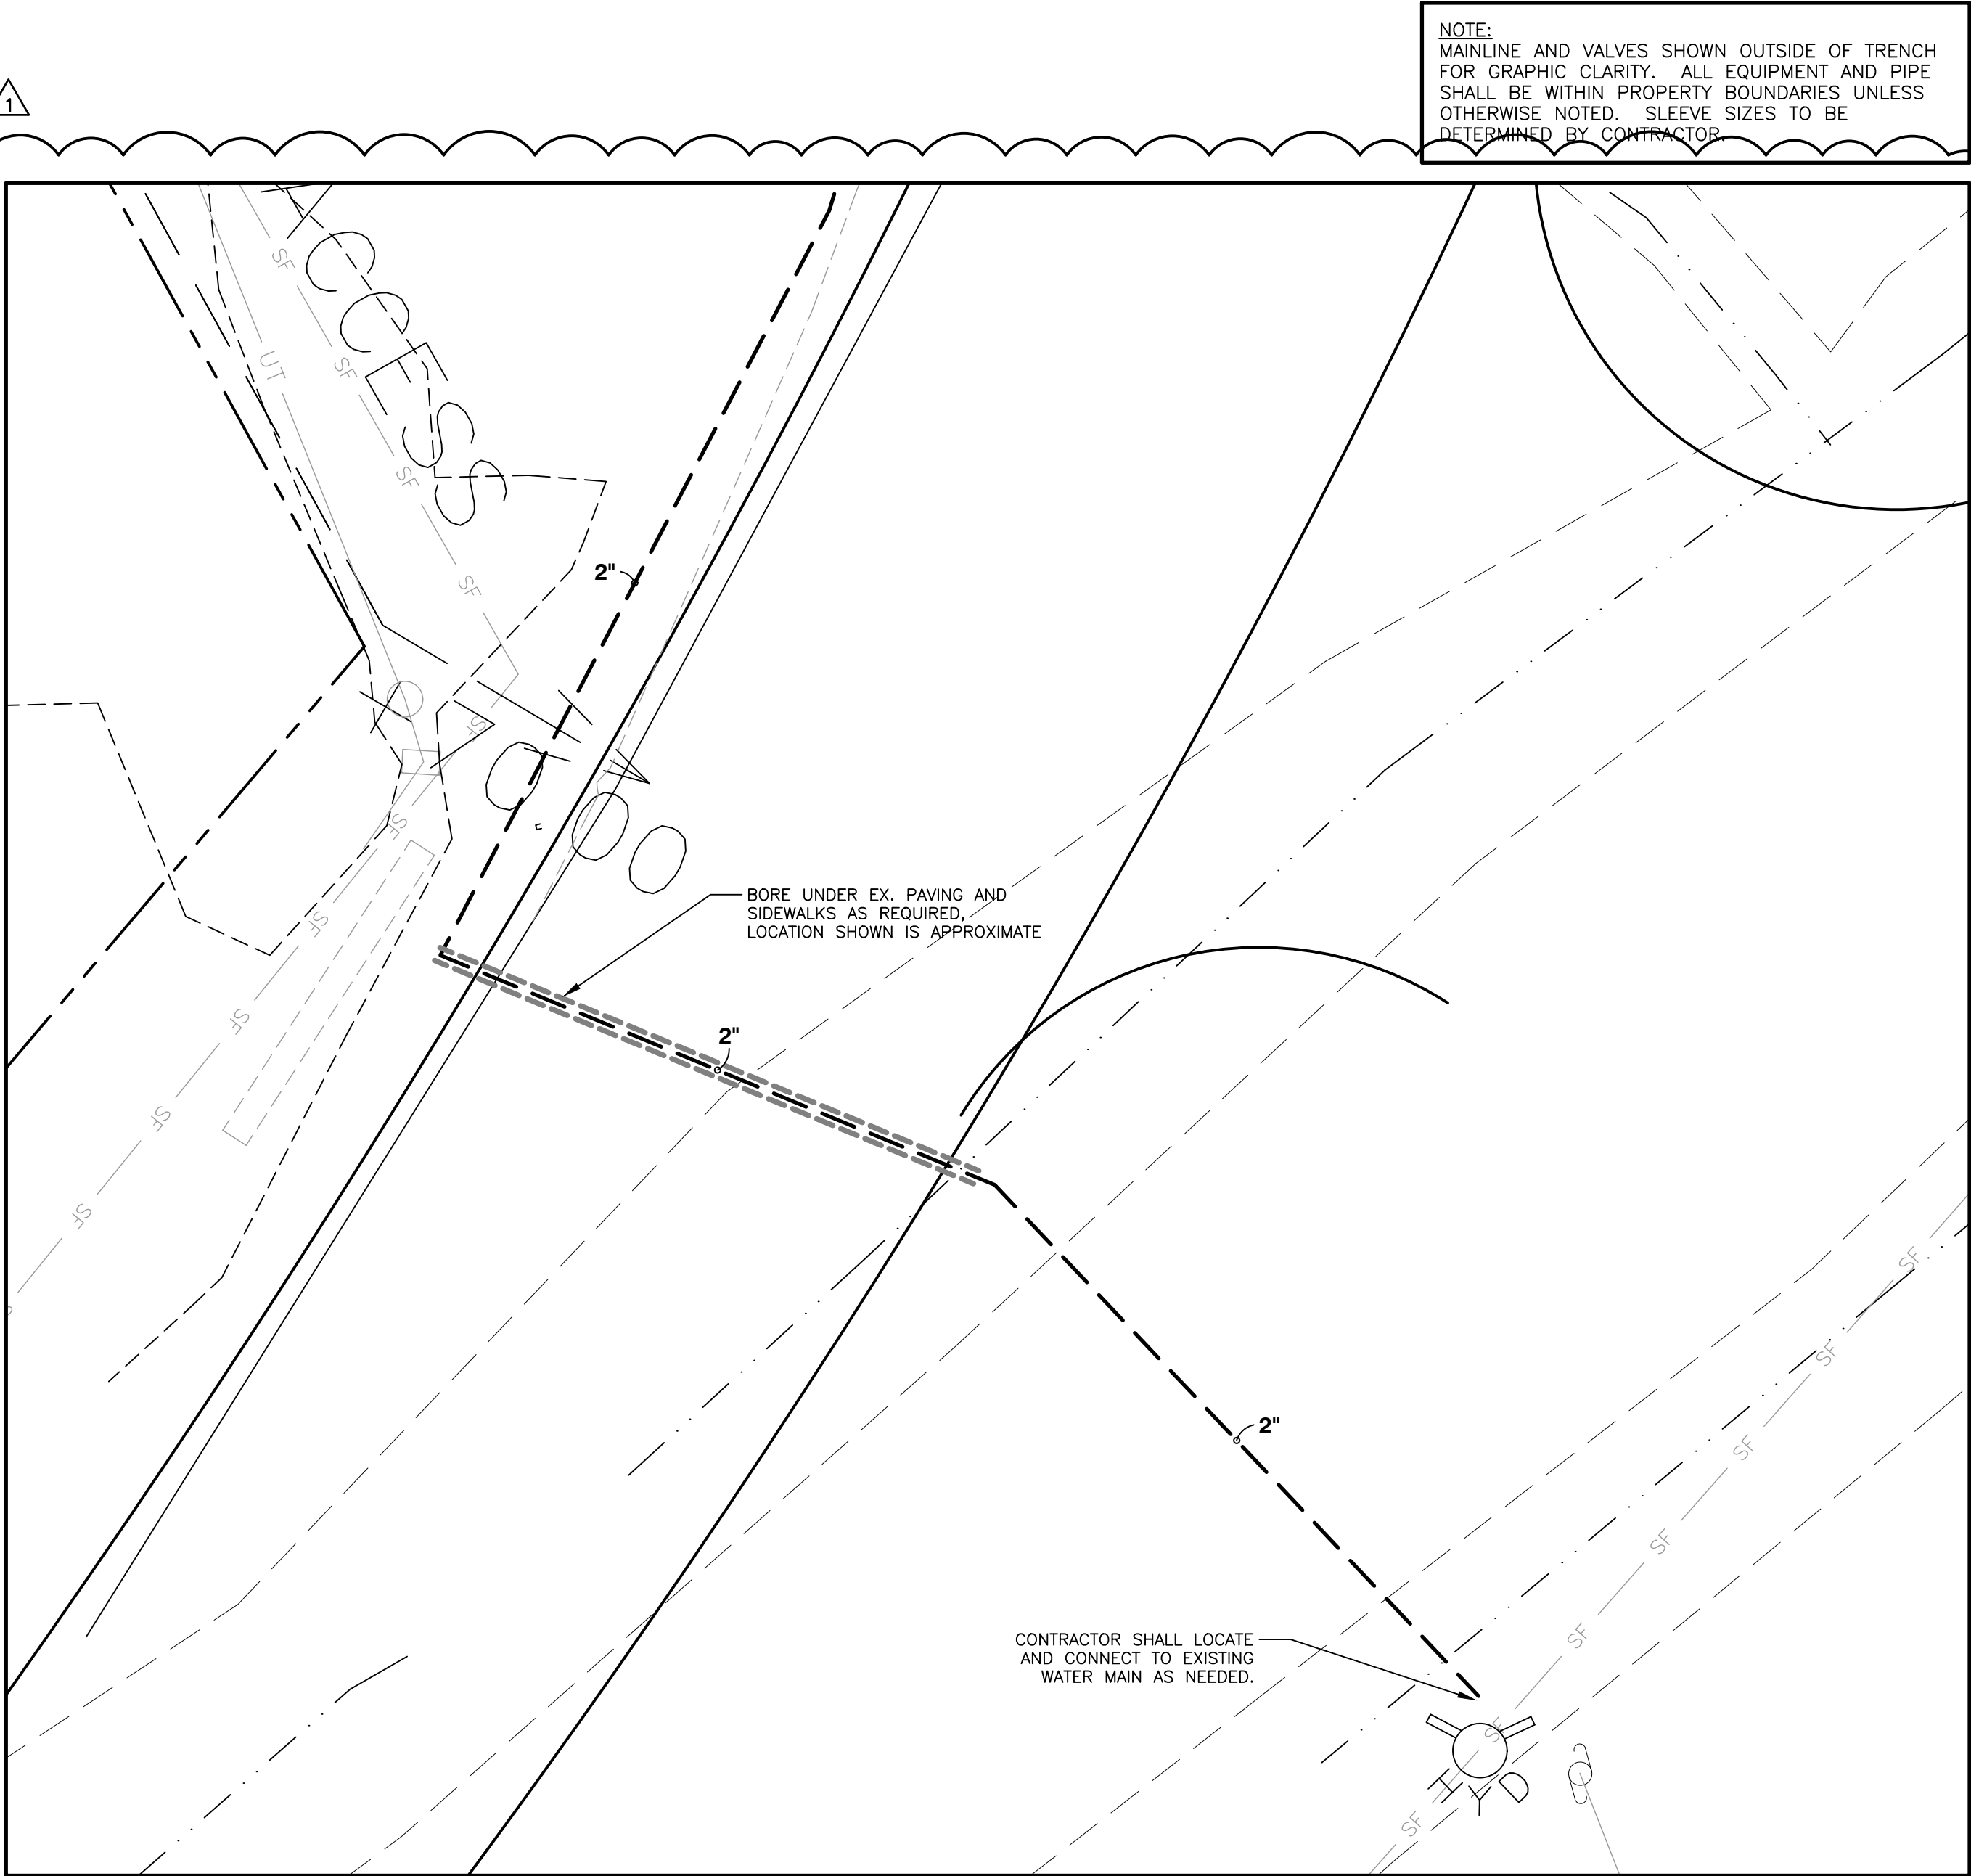


2 IRRIGATION PLAN ENLARGEMENT
Scale: 1" = 10'

Valve Callout

Valve Number

Valve Flow

Valve Size

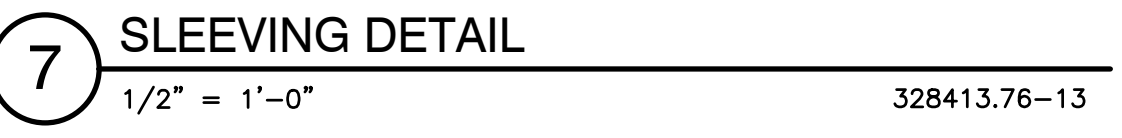

A Landscape Development Plan for Hinds Parkway

Byram, Mississippi

LDC _____
 Drawn _____
 JLA _____
 Checked _____
 206007-002 _____
 Project No. _____
 07.14.22 _____
 Date _____

Registration
 REGISTERED LANDSCAPE ARCHITECT
 468
 STATE OF MISSISSIPPI

IRRIGATION DETAILS

LI500