

BURRIS/WAGNON ARCHITECTS, P.A.

500L EAST WOODROW WILSON AVENUE JACKSON MS 39216 PH 6019697543 FAX 6019699374

9 January 2025

ADDENDUM NO. 3

Re: **Batson Finishes 3rd Floor**
University of Mississippi Medical Center
Jackson, MS
IHL #209-585



Bid Date: Tuesday, January 14th, 2025 (2:00 P.M)

NOTICE TO ALL DOCUMENT HOLDERS:

The following additions, changes, and clarifications to the Specifications for the subject project are to be included as part of the Contract Documents, and thus amend the Scope of Work:

DRAWINGS

- Item No. 1: Refer to Sheet 1.0, Floor Plan, and note the following at room C370 (Safe Room):
Provide Sika EVERBUILD Technic Anti Pick 109 caulk, or equal, at all caulking applications this room (and adjacent toilet).
- Item No. 2: Refer to detail "4/Supp.1" (attached Exhibit "A") for location of detail "9/Supp.1".


No other items in this addendum.

Sincerely,

Bill Burris, AIA, LEED AP
BURRIS/WAGNON ARCHITECTS, P.A.

End of Addendum No. 3

EXHIBIT "A"

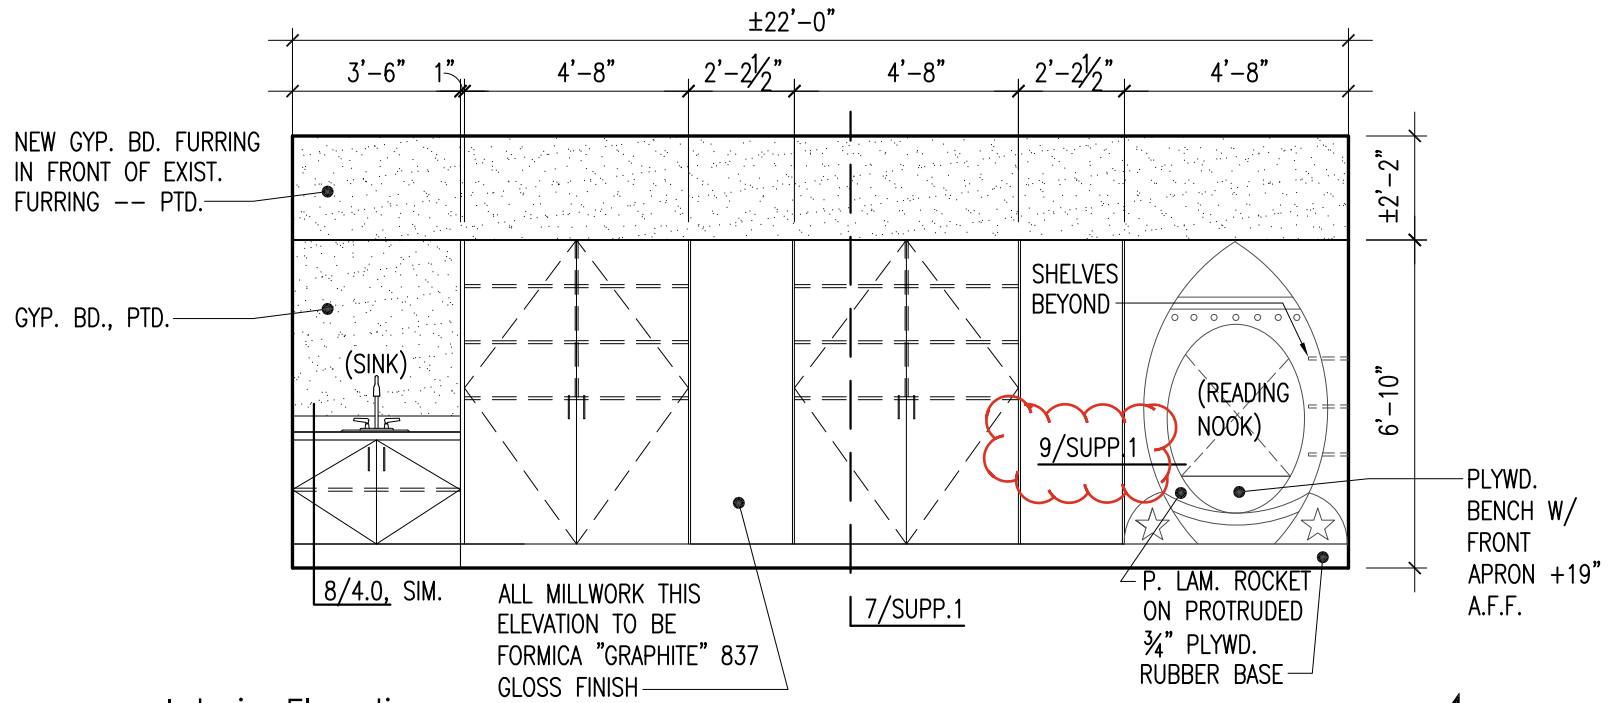

Interior Elevation