

ADDENDUM NO. ONE (1)

July 7, 2017

Owner:	Pearl River Valley Water Supply District
Project:	Shoreline Protection Rehabilitation, Phase 2

The following items are to be modified in the Contract Documents and Specifications for the referenced Project:

1.0 Contract Documents:

1. Agreement: Replace Paragraph 3 with the following:

The CONTRACTOR will commence the work required by the CONTRACT DOCUMENTS within ten (10) calendar days after the date of the NOTICE TO PROCEED and will complete the same within One Hundred and Eighty (180) calendar days unless the period for completion is extended otherwise by the CONTRACT DOCUMENTS. The CONTRACTOR further agrees to pay, as liquidated damages, the sum of Eight Hundred and 00/100 Dollars (\$800.00) for each consecutive calendar day thereafter as hereinafter provided in the Contract Documents.

2.0 Technical Specifications:

1. Section 01025, Part 1.2.3, Item 2, Paragraph B: Replace Paragraph B with the following:

Basis of Payment: Payment for vinyl sheet pile wall shall be based on the linear foot of bulkhead installed. Payment shall be full compensation for installation of sheet pile supplied by the Owner. Payment shall include all materials, equipment, tools, labor, and incidentals.

Transition fittings or special fittings necessary to complete the work will not be paid for separately, but shall be supplied by the Contractor and included in the unit price bid for Vinyl Sheet Pile, whether the vinyl sheet pile is Owner-Supplied or Contractor-Supplied.

2. Section 01025, Part 1.2.3, Item 4, Paragraph B: Replace Paragraph B with the following:

Basis of Payment: Payment for bulkhead cap shall be based on the linear foot of cap acceptably installed. Payment shall be full compensation for the supply and/or installation of the cap. Payment shall include all materials, equipment, tools, labor, and incidentals.

Sleeves, elbows, or special fittings necessary to complete the work will not be paid for separately, but shall be supplied by the Contractor and included in the unit price bid for Bulkhead Cap, whether the bulkhead cap is Owner-Supplied or Contractor-Supplied.

3. Section 04000, Part 2.1, Paragraph D: Replace Paragraph D with the following:

Tie-Back System shall consist of earth anchors installed to accommodate a working tensile load of 4.8 kips as specified on the plans. All components of the earth anchor shall be hot dip galvanized in accordance with ASTM A 123 or ASTM A 153.

3.0 Drawings:


1. Sheet C1.03: Add labels to Sheet C1.03 to indicate the lot line separating Lots 9 and 10 and the drainage easement on Lot 10 (see attached drawing).

4.0 Clarification:


1. The total bid for each additive alternate shall be the sum of the individual bid items for each alternate. No allowance for vibration monitoring is to be included in computing the total bid for each additive alternate.

This Addendum is to be acknowledged by the Bidder on the Bid Form.

Pickering Firm, Inc.

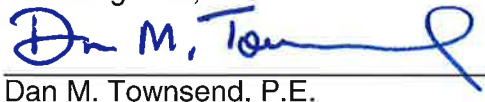

Dan M. Townsend, P.E.

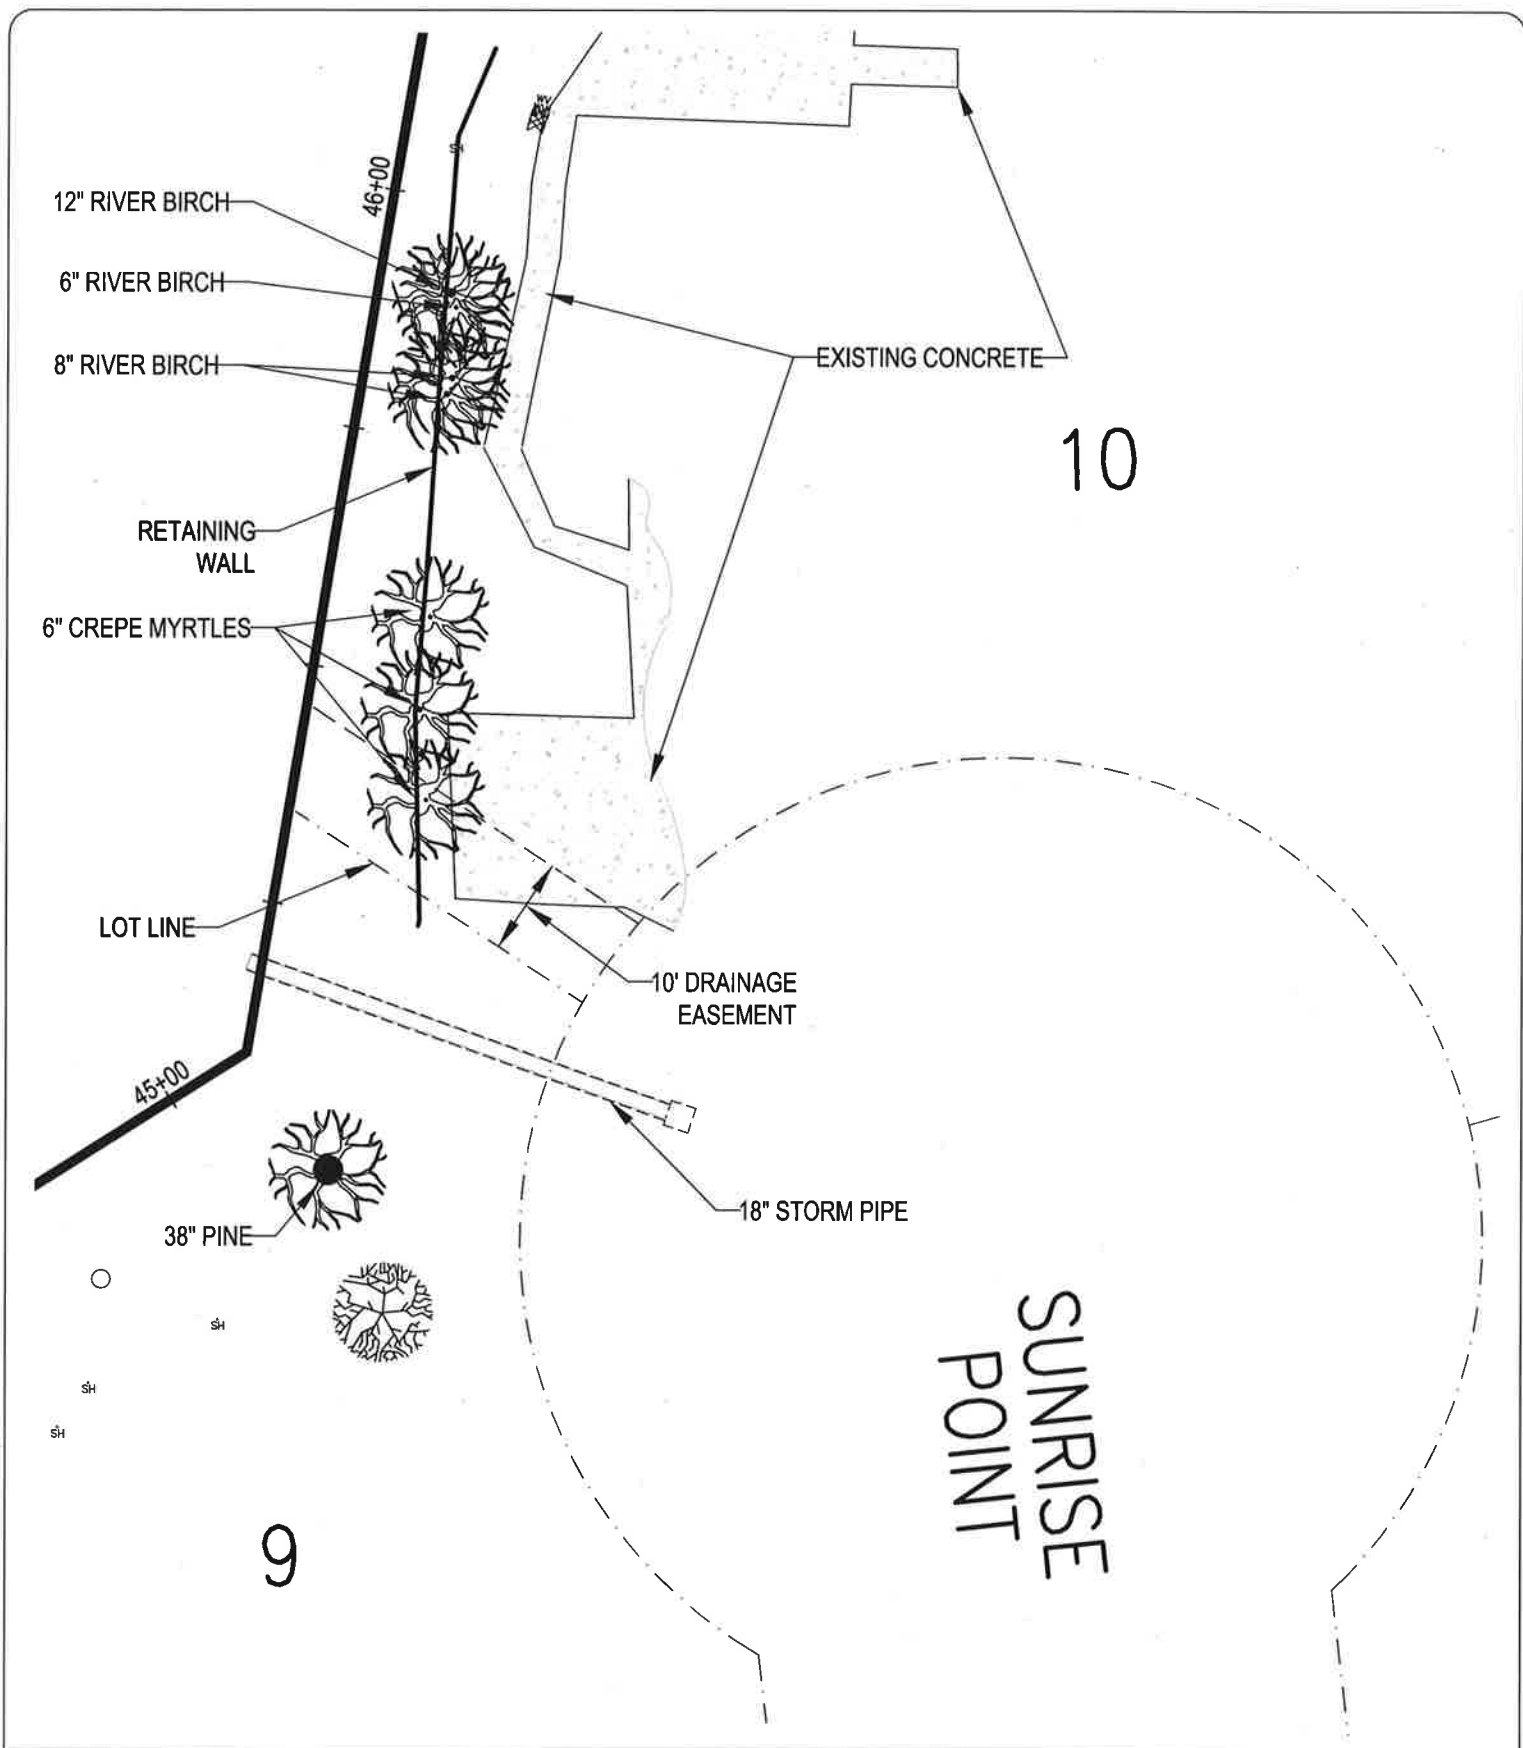

Pickering Firm, Inc.
 Facility Design • Civil Engineering • Surveying •
 Transportation • Natural / Water Resources
 2001 Airport Road, Suite 201
 Flowood, MS 39232
 601.956.3663

**PEARL RIVER VALLEY WATER SUPPLY DISTRICT
 SHORELINE PROTECTION
 REHABILITATION, PHASE 2
 RANKIN COUNTY, MISSISSIPPI**

DESCRIPTION
ADDENDUM NO. 1

SCALE
1" = 20'

PROJECT #
19729.08

DATE
07-05-2017

SHEET #
1