

October 17, 2019

ADDENDUM NUMBER ONE (1)

Project: Smith County School District
New Softball Facilities
Raleigh and Mize, MS
PN: 19064

FROM: Dean and Dean/Associates Architects, P.A.
4400 Old Canton Road, Suite 200
Jackson, MS 39211
(601) 939-7717

The following additions, changes, clarifications and/or substitutions to the Project Drawings as indicated, are hereby made a part of the Contract Documents. Acknowledge receipt of this Addendum by inserting its number and date in the Proposal Form where indicated.

Architectural Specifications:

Item #1: Section 002113 – Instructions To Bidders, page 4, paragraph 1.09, Item A, added as follows. Replace in its entirety.

1. Award of Contract will be awarded to one General Contractor based on the cumulative low bid total of Base Bid for Raleigh and Mize plus any and all alternates the owner accepts.

Item #2: Section 004100 – Bid Form, page 1, paragraph 1.05, Item E, changed as follows. Replace in its entirety.

- E. Alternate #2 – Clean, Prime, Paint and Repair existing Raleigh Softball Bleachers as identified in the Construction Documents as Alternate #2.

Item #3: Section 012300 – Alternatives, page 1, paragraph 1.04, Item B, changed as follows. Replace in its entirety.

- B. Alternate #2 – Clean, Prime, Paint and Repair existing Raleigh Softball Bleachers as identified in the Construction Documents as Alternate #2.

Architectural Drawings:

Item #1: Replace the following sheets in their entirety:

- A101
- A102
- A103
- A201
- A202

Smith County School District
New Softball Facilities
Raleigh and Mize, MS
PN: 19064
Addendum #1
October 17, 2019

Civil

SEE ATTACHED CIVIL ITEMS PROVIDED BY SPENCER ENGINEERING.

Mechanical

SEE ATTACHED MECHANICAL ITEMS PROVIDED BY EDMONDS ENGINEERING.


Electrical

SEE ATTACHED ELECTRICAL ITEMS PROVIDED BY EDMONDS ENGINEERING.

END OF ADDENDUM NUMBER ONE (1)

Dean and Dean/Associates
architects p.a.


J. Alan Grant, AIA, NCARB
Vice President

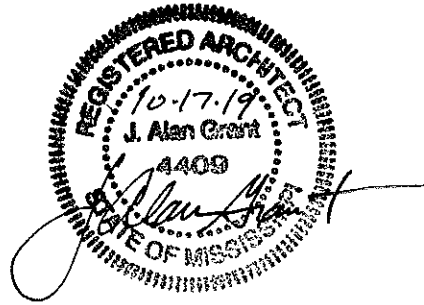

PLEASE ATTACH THIS ADDENDUM TO THE INSIDE FRONT COVER OF EACH SET OF SPECIFICATIONS.

SECTION 002113
INSTRUCTIONS TO BIDDERS

PART 1 - GENERAL

1.01 GENERAL REQUIREMENTS

- A. Interpretations: Should a bidder find discrepancies in or omissions from the plans and specifications or be in doubt as to their written meaning, he should immediately notify the Architect in writing. The Architect will then send a written instruction or interpretation to all known holders of the documents if deemed appropriate by the Architect. Neither the Owner nor the Architect will be responsible for nor bound by any oral instructions.
- B. Addenda: Any addenda to the plans and/or specifications issued before or during the time of bidding will become a part of the Contract and receipt of same must be acknowledged by Bidder in his proposal.
- C. Substitutions: Refer to Section 007300 and to Section 016000 - Product Requirements : Bidder is advised that some sections of the specifications do not allow for substitutions and that the requirements of Sections 007300 and 016000 must be strictly complied with to obtain a substitution where substitution is allowed. Failure to strictly comply with Sections 007300 and 016000 and any requirements in the technical specifications which do not conflict with and which are in addition to Sections 007300 and 016000 may, in the Owner's sole discretion, result in the rejection of the request for substitution. The Architect will not consider requests for substitutions during bidding.
- D. Non-Asbestos Containing Materials: The Contractor shall furnish a letter of Certification of non-use of asbestos containing materials prior to Substantial Completion in accordance with Section 007300.
- E. Pre-Bid Conference:
 - 1. **A Pre-Bid Conference has been scheduled for 2:00 p.m. on October 1st at Raleigh High School.**
 - a. All Bidders, Subcontractors and Suppliers are urged to attend.
 - b. All Bidders are expected to visit the site, and familiarize themselves of all conditions relating to the Work prior to the pre-bid conference. Failure to visit the site will in no way relieve the successful Bidder from his obligation to complete all work in accordance with the Contract Documents without additional cost to the Owner.

1.02 BIDDING

- A. Contract for Construction: Lump sum, single bids (base bid & alternates) received from General Contractors shall include General, Mechanical, Electrical, Plumbing, Structural and Sitework as well as all other work shown on plans and specified herein.
 - 1. General Contractor must submit a bid on both projects (Raleigh and Mize base bid and alternates) to be considered a complete bid proposal.
- B. General Contractors, Subcontractors and Suppliers: The Bidder is specifically advised that any person, firm, or other party to whom it is proposed to award a Contract, Subcontract or Purchase Order must be acceptable to the Owner.
 - 1. The Owner may make such investigation as he deems necessary to determine the ability of the Bidder or subcontractors or suppliers to perform the work, and the Bidder shall furnish to the Owner all such information and data for this purpose as the Owner may request. The Owner reserves the right to reject any bid if the evidence submitted by, or investigation of, such Bidder fails to satisfy the Owner that such Bidder is properly qualified to carry out the obligations of the Contract and to complete the work contemplated therein within the time required.
 - 2. All subcontractors must have a current, valid, Contractor's License.
 - 3. Listing of Subcontractors and Suppliers:
 - a. Failure to list subcontractors that may be required on the Bid Form may result in the rejection of the Bidder's bid as non-responsive.

- b. The successful Bidder shall use the subcontractor and supplier identified by him as being included in his lump sum price, provided however, the Bidder assumes the risk that the subcontractor or supplier listed will be acceptable to the Owner and the Architect. The Bidder shall not substitute another subcontractor for the listed subcontractor or supplier unless agreed to in writing by the Owner.
- c. If Bidder lists itself as a supplier for any of the classifications listed, then the Bidder will be required to furnish such product from its manufacturing inventory and to demonstrate to the Owner and Architect that it has satisfactory qualifications and prior experience manufacturing and furnishing such materials, equipment and/or products. If Bidder lists itself as a subcontractor for any of the classifications listed, then the Bidder will be required to perform the work with its own regularly employed personnel and to demonstrate to the Owner and Architect that it has satisfactory qualifications and prior experience performing such work with its own regularly employed personnel. The Owner reserves the right to reject any bid if the evidence submitted by Bidder fails to satisfy the Owner that the Bidder has satisfactory qualifications and prior experience performing such work and/or furnishing such materials, equipment and/or products.

1.03 CERTIFICATE OF RESPONSIBILITY

- A. Each Bidder submitting a bid in excess of \$50,000.00 must show on his bid and on the face of the envelope containing the bid, his Certificate of Responsibility Number, as required by Section 31-3-15 and 31-3-21 (latest edition) Mississippi Code of 1972. If the bid does not exceed \$50,000.00, a notation so stating must appear on the face of the envelope.
- B. In accordance with Mississippi law, if the Bidder is a joint venture, either the joint venture or all of the Contractors which make up the joint venture must hold certificates of responsibility from the State Board of Contractors. Each of the Contractors participating in the bid must indicate their individual Certificate of Responsibility numbers on the bid and on the face of the envelope.
- C. Each subcontractor whose Subcontract exceeds \$50,000.00 shall have a Certificate of Responsibility Number, as required by Section 31-3-15 and 31-3-21 (latest revision), Mississippi Code.
- D. Evidence: No bid will be opened, considered or accepted unless the above information is given as specified. Sufficient evidence that said Certificate of Responsibility has been issued and is in effect at the time of receiving bids must be submitted when required by the Owner or the Architect. Likewise, it shall be the responsibility of the Prime Contractor to require a Certificate of Responsibility Number from any subcontractor that falls in the category of "B" above.

1.04 NON-RESIDENT CONTRACTOR

- A. When a non-resident Contractor submits a bid for a Mississippi public project, he shall, prior to submission of the bid, attach thereto a copy of his resident State's current law pertaining to such States treatment of non-resident Contractors as required by Section 31-3-15 and 31-3-21, Mississippi Code, (latest revisions) or, if the State has no such law, a statement indicating the "State of (name of State) has no resident Contractor preference law". Failure to include this information or statement will result in the bid being considered non-responsive and it will be rejected.

1.05 BID SECURITY

- A. Each bid, exceeding \$5,000.00 must be accompanied by the Bidder's certified check or a bid bond duly executed by the Bidder as principal and wherein the security on such bond will be by a duly authorized surety company deemed to do business in the State of Mississippi which is acceptable to the Owner, in the amount of five percent of the bid. All bid bonds must be accompanied by the appropriate Power of Attorney designating the Mississippi Resident Agent.

1.06 OPENING OF PROPOSALS

- A. Refer to the Advertisement for Bids.

1.07 PREPARATION OF BID

- A. Conditions of Work: Each Bidder must fully inform himself of the conditions relating to the construction of the project and employment of labor thereon. Failure to do so will not relieve a successful Bidder of his obligation to furnish all material and labor necessary to carry out the provisions of his Contract. The Contractor must employ methods or means to cause no interruptions of or interference with the work of any other Contractor.
- B. Examination of Site: All Bidders, including the general contractor and subcontractors, will visit the site of the building, and inform themselves of all conditions. Failure to visit the site will in no way relieve the successful Bidder from his obligation to complete all work in accordance with the Contract Documents without additional cost to the Owner.
- C. Staging and Access: All Bidders, including the general contractor and subcontractors, acknowledge that the construction premises are restricted and that access is affected by the location of the Project, by the Facilities surrounding the Project and by other construction that may be performed during the performance of this Contract; All Bidders, including the general contractor and subcontractors, further acknowledge that such limitations in space and accessibility have been taken into account in estimating their bids.
- D. Laws and Regulations: The Bidder's attention is directed to the fact that all applicable state laws, municipal ordinances, and the rules and regulations of all authorities having jurisdiction over construction of the project apply to the Contract. The successful Bidder shall be required to comply with all applicable laws, ordinances, rules and regulations at no additional cost to Owner whether such laws, ordinances, rules and/or regulations are enacted or adopted before or after bid opening.
- E. Obligation of Bidder: At the time of opening of bids, Bidder will be presumed to have inspected the site and to have read and be thoroughly familiar with the plans and specifications, including all addenda. The submission of a Bid will be construed as conclusive evidence that the Bidder has made such examination.
- F. Modification to Bid: A Bidder may modify the bid on the outside of the sealed envelope containing the bid.
- G. Telegraphic Bids / Modifications: Absolutely no facsimile (fax), telegraphic bid or telegraphic modification of bid will not be considered.
- H. Irregularities: The omission of any information requested on the Proposal Form may be considered as an informality, or irregularity, by the Owner when in their opinion the omitted information does not alter the amounts contained in the submitted bid proposal, or place other Bidders at a disadvantage.

1.08 PROPOSALS

- A. Form: Submit all proposals on forms provided and fill all applicable blank spaces without interlineation, alteration, or erasure and recapitulations of the work to be done. No oral, telegraphic, or telephonic proposals will be considered. Receipt of any and all addenda issued during the bidding must be noted on the Proposal Form.
- B. Withdrawal: Any bid may be withdrawn prior to the time for opening of bids or authorized postponement thereof. Any bid received after the time and date specified will not be considered. All bids are irrevocable offers to contract at the price bid, which may not be withdrawn until 60 days after bid opening.
- C. Submittal: Submit bids in duplicate in an opaque sealed envelope bearing on the outside, the name and Certificate of Responsibility number of the Bidder, his address, bid opening date, and time.
- D. Unauthorized conditions, limitations, or provisions attached or on the outside of the envelope will render the bid non-responsive and it shall be rejected.
- E. Mailing: If forwarded by mail, the sealed envelope containing the bid must be enclosed in another envelope addressed to:
Smith County School District

Attn: Robert Miles, Director of Purchasing
P.O. Box 308
Raleigh, MS 39153

Bidders are urged to hand deliver their bid. Owner and Architect will not be responsible for mis-delivery of mail or express deliveries.

- F. Electronic Bids: Electronic or Digital bids will not be accepted by Smith County School District or Dean and Dean Associates architects. Bids must be forwarded by mail or delivered in person.

1.09 CONTRACT

- A. Award of Contract: Award shall be made to the lowest and best Bidder, pursuant to Mississippi law and these Instructions to Bidders. The lowest bid shall be the base bid or combination of base bid and those alternates which produce a total within available funds and in accordance with Owner priorities. The Owner reserves the right to waive irregularities and to reject any and all bids.
 - 1. Award of Contract will be awarded to one General Contractor based on the cumulative low bid total of Base Bid for Raleigh and Mize plus any and all alternates the owner accepts.
- B. Disqualification of Bidder: The Owner reserves the right to award to other than the low Bidder when, in the Owner's judgment, it is in his best interest to do so. For instance, a Bidder may be disqualified for such reasons as:
 - 1. Bidder being in arrears on existing contracts.
 - 2. Bidder being in litigation with the Owner or the institution.
 - 3. Bidder having defaulted on or failed to satisfactorily complete a previous contract with the Owner or institution, including Bidder's failure to satisfactorily fulfill the warranty obligations of a previous contract with the Owner or institution.
 - 4. Bidder having failed to furnish the List of Subcontractors, materials and suppliers and the Preliminary Construction Schedule.
 - 5. The above is not an inclusive list.
- C. Security for Faithful Performance: When the bid exceeds \$5,000.00, the Contractor will furnish simultaneously with his delivery of the executed Contract, a payment and a performance bond in accordance with Section 31-5-51 et. seq. of the Mississippi Code (latest edition) along with policies of insurance or insurance certificates as required by the Contract Documents. The surety on such bonds will be by a duly authorized surety company licensed to do business in the state of Mississippi, which is acceptable to the Owner.
- D. Time of Completion: By submission of its bid, Bidder agrees to commence work on or before a date specified in a written "Proceed Order" and to fully complete the Project within the time stated on the Bid Proposal Form.
- E. Substantial Completion: Substantial completion of the project as defined by Section 007300, requires the submittal by Contractor of all closeout documents required by Section 017000 and Section 017800, all ownership and maintenance manuals required by Section 013000 and/or the technical sections of the Contract, the Guarantee of Work required by Section 007300..
- F. Liquidated Damages for Failure to Enter Into Contract: The successful Bidder, upon his failure or refusal to execute and deliver the Contract and required bonds within ten days after he has received notice of the acceptance of his bid, will forfeit to the Owner as liquidated damages the security deposited with his bid.
- G. Liquidated Damages for Failure to Substantially Complete Project in Time Stipulated: Applicable when stipulated sum is shown in Section 007300.

1.10 BID DOCUMENTS

- A. Plans and Specifications are available upon deposit by calling the office of Dean and Dean/Associates Architects, 4400 Old Canton Road, Suite 200, Jackson, Mississippi, 39211 (601) 939-7717.
 - 1. Deposit will be refunded upon return of plans and specifications in good and usable condition within ten (10) days after the bid date.

2. Cost of reproduction will be deducted from deposits on bid documents, which are deemed unusable.
3. Local plan rooms will be issued one (1) set free of charge if requested.
4. No partial sets of drawings or project manual will be issued.

END OF SECTION

SECTION 004100

BID FORM

THE PROJECT AND THE PARTIES

1.01 TO:

- A. Owner
 - 1. Smith County School District, 212 Sylvarena Avenue, P.O. Box 308 Raleigh, Mississippi, 39153

1.02 FOR:

- A. Project: SCSD New Softball Facilities - Raleigh and Mize

1.03 DATE: _____ (BIDDER TO ENTER DATE)

1.04 SUBMITTED BY: (BIDDER TO ENTER NAME AND ADDRESS)

- A. Bidder's Full Name _____
 - 1. Address _____
 - 2. City, State, Zip _____

1.05 OFFER

- A. Having examined the Place of The Work and all matters referred to in the Instructions to Bidders and the Contract Documents prepared by _____ for the above mentioned project, we, the undersigned, hereby offer to enter into a Contract to perform the Work for the Sum of:
- B. Base Bid: Raleigh Softball Concession Stand and Press Box _____ dollars (\$ _____), in lawful money of the United States of America.
- C. Base Bid: Mize Softball Locker Room _____ dollars (\$ _____), in lawful money of the United States of America.
- D. Alternate #1 - Renovate existing Raleigh Softball Concession Stand to New Locker Room as identified in the Construction Documents as Alternate #1. _____ dollars (\$ _____), in lawful money of the United States of America.
- E. Alternate #2 - Clean, Prime, Paint and Repair existing Raleigh Softball Bleachers as identified in the Construction Documents as Alternate #2 _____ dollars (\$ _____), in lawful money of the United States of America.
- F. Alternate #3 - HVAC System for Concessions and Press Box as identified in the Construction Documents as Alternate #3 _____ dollars (\$ _____), in lawful money of the United States of America.
- G. We have included the required security deposit as required by the Instruction to Bidders.
- H. All applicable federal taxes are included and State of _____ taxes are included in the Bid Sum.
- I. All Cash and Contingency Allowances described in Section 012100 - ALLOWANCES are included in the Bid Sum.

1.06 ACCEPTANCE

- A. This offer shall be open to acceptance and is irrevocable for sixty days from the bid closing date.
- B. If this bid is accepted by Owner within the time period stated above, we will:
 - 1. Execute the Agreement within seven days of receipt of Notice of Award.
 - 2. Furnish the required bonds within seven days of receipt of Notice of Award.

- C. If this bid is accepted within the time stated, and we fail to commence the Work or we fail to provide the required Bond(s), the security deposit shall be forfeited as damages to Owner by reason of our failure, limited in amount to the lesser of the face value of the security deposit or the difference between this bid and the bid upon which a Contract is signed.
- D. In the event our bid is not accepted within the time stated above, the required security deposit shall be returned to the undersigned, in accordance with the provisions of the Instructions to Bidders; unless a mutually satisfactory arrangement is made for its retention and validity for an extended period of time.

1.07 CONTRACT TIME

- A. If this Bid is accepted, we will:
- B. Complete the Work by the 7th day of February, 2020.

1.08 CHANGES TO THE WORK

- A. When Architect establishes that the method of valuation for Changes in the Work will be net cost plus a percentage fee in accordance with General Conditions, our percentage fee will be:
 - 1. Fifteen (15) percent overhead and profit on the net cost of our own Work;
 - 2. Ten (10) percent on the cost of work done by any Subcontractor.
 - 3. Markup for profit and overhead will not be allowed for items to be paid from project allowances identified in Section 012100.

1.09 ADDENDA

- A. The following Addenda have been received. The modifications to the Bid Documents noted below have been considered and all costs are included in the Bid Sum.
 - 1. Addendum # _____ Dated _____.
 - 2. Addendum # _____ Dated _____.
 - 3. Addendum # _____ Dated _____.
 - 4. Addendum # _____ Dated _____.

1.10 BID FORM SUPPLEMENTS

- A. The following Supplements are attached to this Bid Form and are considered an integral part of this Bid Form:
 - 1. Document 004336 - Proposed Subcontractors Form: Include the names of all Subcontractors and the portions of the Work they will perform.

1.11 BID FORM SIGNATURE(S)

- A. The Corporate Seal of
- B. _____
- C. (Bidder - print the full name of your firm)
- D. was hereunto affixed in the presence of:
- E. _____
- F. (Authorized signing officer, Title)
- G. (Seal)

END OF BID FORM

**SECTION 012300
ALTERNATIVES**

PART 1 GENERAL

1.01 SECTION INCLUDES

- A. Procedures for pricing Alternates.

1.02 RELATED REQUIREMENTS

- A. Document 002113 - Instructions to Bidders: Instructions for preparation of pricing for Alternates.

1.03 ACCEPTANCE OF ALTERNATES

- A. Alternates quoted on Bid Forms will be reviewed and accepted or rejected at Owner's option. Accepted Alternates will be identified in the Owner-Contractor Agreement.
- B. Coordinate related work and modify surrounding work to integrate the Work of each Alternate.

1.04 SCHEDULE OF ALTERNATES

- A. Alternative No. 1 - Renovate existing Raleigh Softball Concession Stand to New Locker Room as identified in the Construction Documents as Alternate #1
- B. Alternative No. 2 - Clean, Prime, Paint and Repair existing Raleigh Softball bleachers as identified in Construction Documents as Alternate #2
- C. Alternative No. 3 - HVAC System for Concessions and Press Box as identified in Construction Documents as Alternate #3.

PART 2 PRODUCTS - NOT USED

PART 3 EXECUTION - NOT USED

END OF SECTION

October 17, 2019

ADDENDUM NO. 1

PROJECT: Smith County School District
New Softball Facilities
Raleigh and Mize Schools

FROM: Edmonds Engineering, Inc.
1900 Lakeland Drive, Suite 1
Jackson, Mississippi 39216

The following additions, changes, clarifications and/or substitutions to the Project Drawings as indicated are hereby made a part of the Contract Documents. Acknowledge receipt of this Addendum by inserting its number and date in the Proposal Form where indicated.

Item No. 1: Specifications, Section 221100, Pipe and Fittings, Paragraph 1.2 Materials, A.1, replace with the following:

Soil, Waste and Vent Piping: Schedule 40 PVC solid core with solvent weld joints for below slab. Above slab use Schedule 40 PVC solid core with solvent weld joints. All underground piping outside of building shall have continuous #12 solid copper tracer wire.


END OF ADDENDUM NO. 1

October 17, 2019

SMITH COUNTY SCHOOL DISTRICT
NEW SOFTBALL FACILITIES
RALEIGH AND MIZE, MISSISSIPPI

CIVIL ADDENDUM

- Item No. 1 Ref. Sheet C100 and C200 – The plan text that refers to notes #7, #8, and #9 are from the original survey. These notes are not applicable to this project.
- Item No. 2 Ref. Sheet C200 – The new water line size shall match the existing water line size. Field verify correct size.
- Item No. 3 Ref. Sheet C200 – Condensate drain shown on M103 shall daylight and spill out onto the sidewalk. Coordinate location with owner.

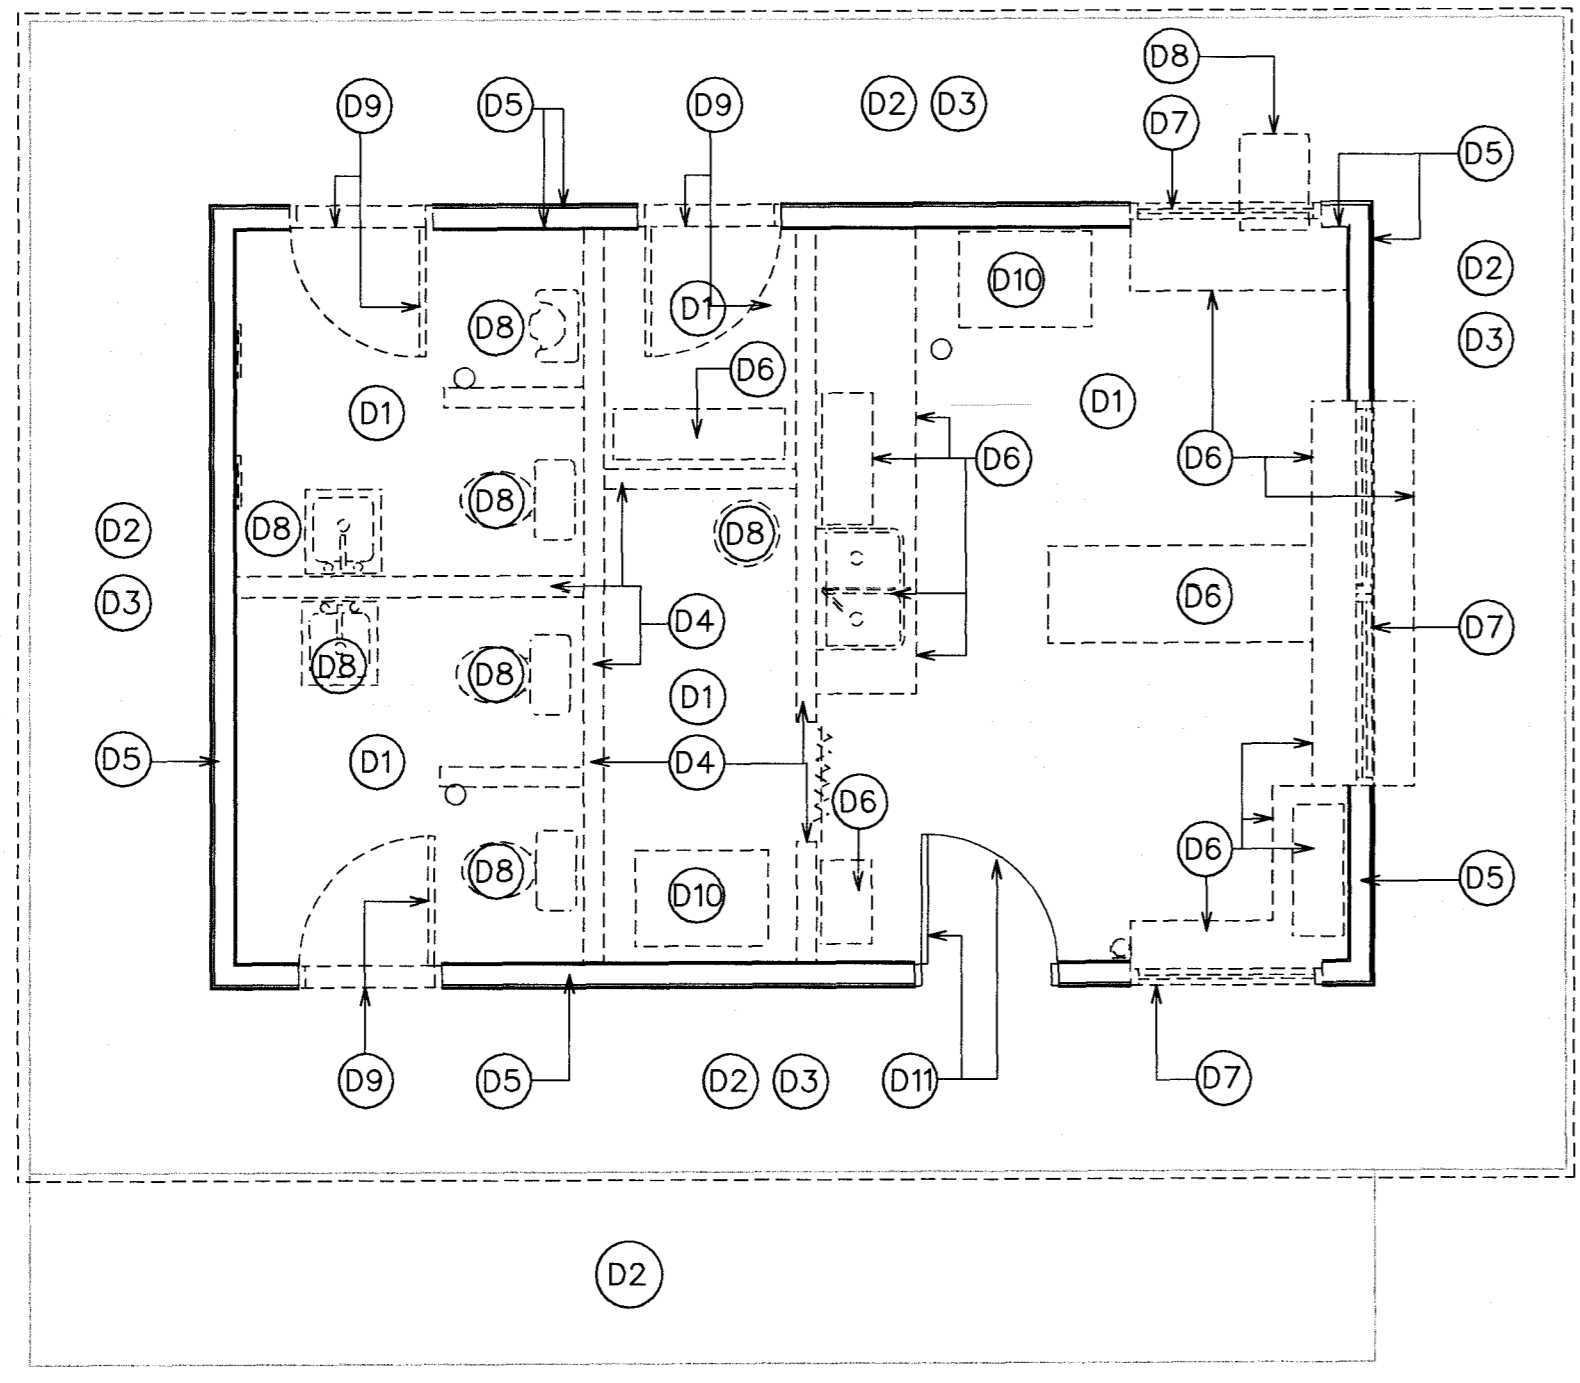

1
A102 RALEIGH H.S.
EXISTING CONCESSIONS BUILDING
DEMOLITION FLOOR PLAN
SCALE: 1/4" = 1'-0"

ADD
ALTERNATE NUMBER 1



GENERAL NOTES:

- A THE GENERAL CONTRACTOR IS RESPONSIBLE FOR SURVEYING THE EXISTING CONDITIONS AND BUILDING MATERIALS FOR ANY ASBESTOS CONTAINING MATERIALS. PRIOR TO ANY DEMO OR NEW WORK, PROVIDE DOCUMENTATION TO THE ARCHITECT.
- B THE CONTRACTOR IS REQUIRED TO COORDINATE WITH THE OWNER ON REMOVAL OF ALL WALL MOUNTED ITEMS SUCH AS FANS, PAPER TOWEL HOLDERS, ETC. PRIOR TO BEGINNING CONSTRUCTION WORK.

DEMOLITION NOTES:

- D1 EXISTING CONCRETE SLAB TO REMAIN. CLEAN ALL INTERIOR CONCRETE SLAB SURFACES. PATCH SLAB AS REQUIRED. PREP CONCRETE FOR NEW CONCRETE SEALER. SEE ELECTRICAL AND MECHANICAL DRAWINGS FOR ADDITIONAL DEMO NOTES.
- D2 EXISTING CONCRETE SIDEWALKS TO REMAIN. CLEAN, PRESSURE WASH ALL EXPOSED EXTERIOR CONCRETE SURFACES.
- D3 EXISTING SOFFITS TO REMAIN. CLEAN AND PREP ALL SOFFIT AND EAVE SURFACES TO RECEIVE NEW PRIME AND PAINT FINISH.
- D4 DEMO AND REMOVE EXISTING WALLS, GYP BOARD, WOOD STUDS, SILL PLATES, SCREWS, ETC. AND ALL ACCESSORIES. PATCH CONCRETE FLOORS WHERE WOOD SILL PLATE IS REMOVED.
- D5 EXISTING EXTERIOR WALLS TO REMAIN. CLEAN AND PREP EXTERIOR AND INTERIOR WALL SURFACES TO RECEIVE NEW PRIME AND PAINT FINISH.
- D6 DEMO AND REMOVE EXISTING MILLWORK IN ITS ENTIRETY. DO NOT SALVAGE. SEE MECHANICAL AND ELECTRICAL DRAWINGS FOR ADDITIONAL DEMO WORK IN THIS AREA. PATCH ALL WALL SURFACES WHERE MILLWORK IS REMOVED AND PREP WALL FOR NEW PRIME AND PAINT FINISH.
- D7 DEMO AND REMOVE EXISTING WINDOW, WINDOW TRIM, ANCHORS, IN ITS ENTIRETY. CLEAN AND PREP OPENING TO BE INFILLED WITH NEW WALL CONSTRUCTION.
- D8 DEMO AND REMOVE EXISTING PLUMBING FIXTURE OR WATER HEATER IN ITS ENTIRETY. SEE PLUMBING DRAWINGS FOR ADDITIONAL INFORMATION.
- D9 DEMO AND REMOVE EXISTING DOOR, DOOR TRIM, HARDWARE, THRESHOLD, ANCHORS, IN ITS ENTIRETY. CLEAN AND PREP OPENING TO BE INFILLED WITH NEW WALL CONSTRUCTION.
- D10 REMOVE REFRIGERATOR/BEVERAGE COOLER AND RE-LOCATE PER OWNERS REQUEST
- D11 EXISTING DOOR, FRAME AND HARDWARE TO REMAIN. CLEAN AND PREP TO DOOR TO BE PRIMED AND PAINTED.
- D12 EXISTING EXISTING CEILING TO REMAIN. CLEAN AND PREP TO DOOR TO BE PRIMED AND PAINTED. PATCH CEILING IN AREAS WHERE WALLS WERE DEMOED/ REMOVED.

WALL LEGEND

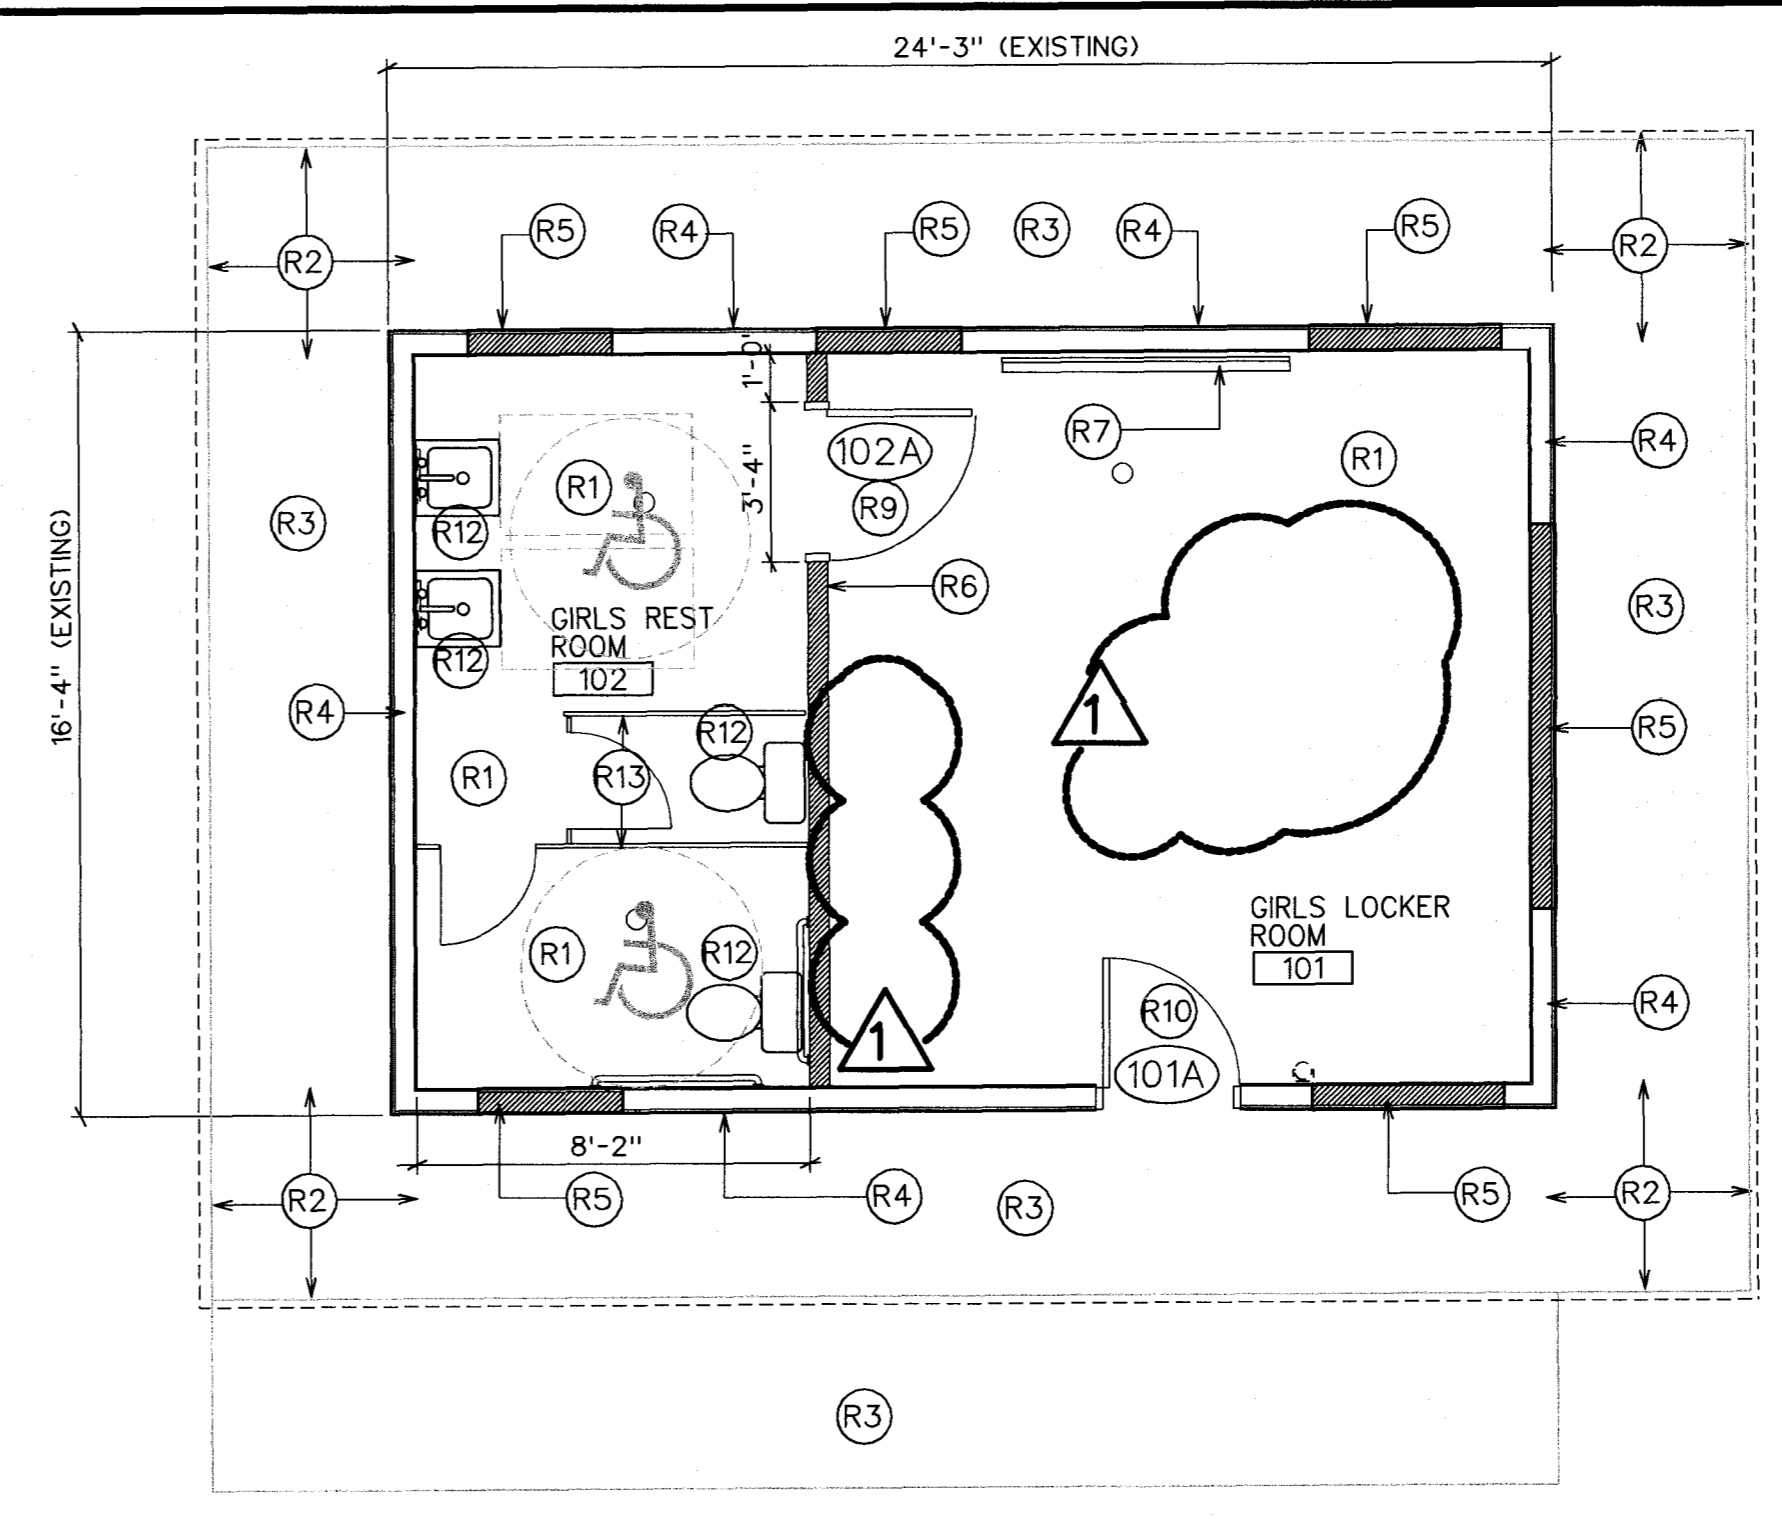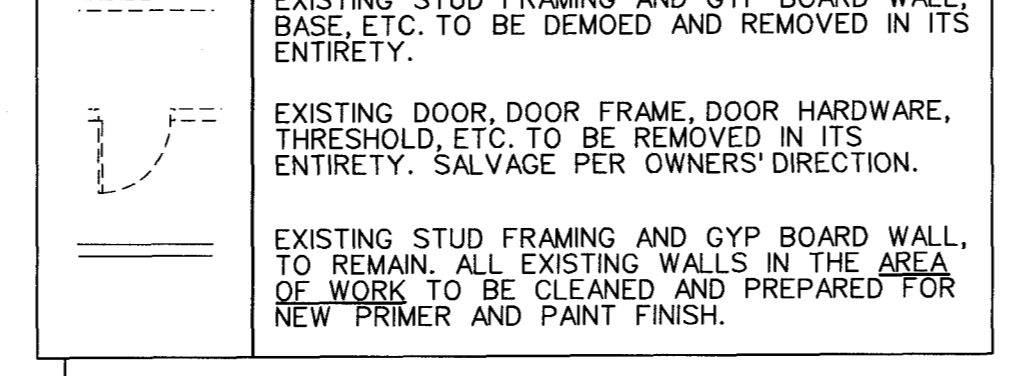

2
A102 RALEIGH H.S.
GIRLS LOCKER ROOM FLOOR PLAN (RENOVATION)
SCALE: 1/4" = 1'-0"

ADD
ALTERNATE NUMBER 1



GENERAL NOTES:


- A THE GENERAL CONTRACTOR IS RESPONSIBLE FOR SURVEYING THE EXISTING CONDITIONS AND BUILDING MATERIALS FOR ANY ASBESTOS CONTAINING MATERIALS. PRIOR TO ANY DEMO OR NEW WORK, PROVIDE DOCUMENTATION TO THE ARCHITECT.
- B THE CONTRACTOR IS REQUIRED TO COORDINATE WITH THE OWNER ON REMOVAL OF ALL WALL MOUNTED ITEMS SUCH AS FANS, PAPER TOWEL HOLDERS, ETC. PRIOR TO BEGINNING CONSTRUCTION WORK.

RENOVATION NOTES:

- R1 SEAL CONCRETE SLAB WITH CONCRETE SEALER
- R2 PRIME AND PAINT EXISTING SOFFITS AND EAVES/FASCIA. COLOR AS SELECTED BY ARCHITECT.
- R3 EXISTING CONCRETE SIDEWALKS TO REMAIN. CLEAN, PRESSURE WASH ALL EXPOSED EXTERIOR CONCRETE SURFACES.
- R4 PRIME AND PAINT EXTERIOR WALL SURFACES/SIDING, TRIM. COLOR AS SELECTED BY ARCHITECT.
- R5 INSTALL NEW EXTERIOR WALL CONSTRUCTION. MATCH ADJACENT WALL CONSTRUCTION. WOOD STUDS, SHEATHING, AIR BARRIERS, EXTERIOR SIDING AND INTERIOR GYP BOARD. PRIME AND PAINT FINISH. COLOR AS SELECTED BY ARCH.
- R6 INSTALL NEW 7" INTERIOR WALL, 2 X 6 WOOD STUDS AT 16" O.C. WITH 5/8" PLYWOOD ON EACH SIDE. PRIME AND PAINT INTERIOR WALL SURFACES. COLOR AS SELECTED BY ARCHITECT.
- R7 OMIT/NOT USED
- R8 OMIT/NOT USED
- R9 INSTALL NEW 3'-0" X 7'-0" DOOR AND FRAME, PRIME AND PAINT
- R10 CLEAN, PRIME, AND PAINT EXISTING DOOR AND DOOR FRAME.
- R11 OMIT/NOT USED
- R12 INSTALL NEW PLUMBING FIXTURES AS SHOWN. SEE PLUMBING DRAWINGS FOR FIXTURE TYPE AND ADDITIONAL INFORMATION.
- R13 INSTALL NEW TOILET PARTITIONS AS SHOWN.

WALL LEGEND

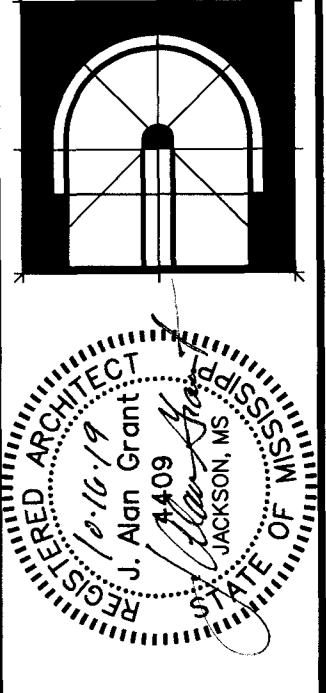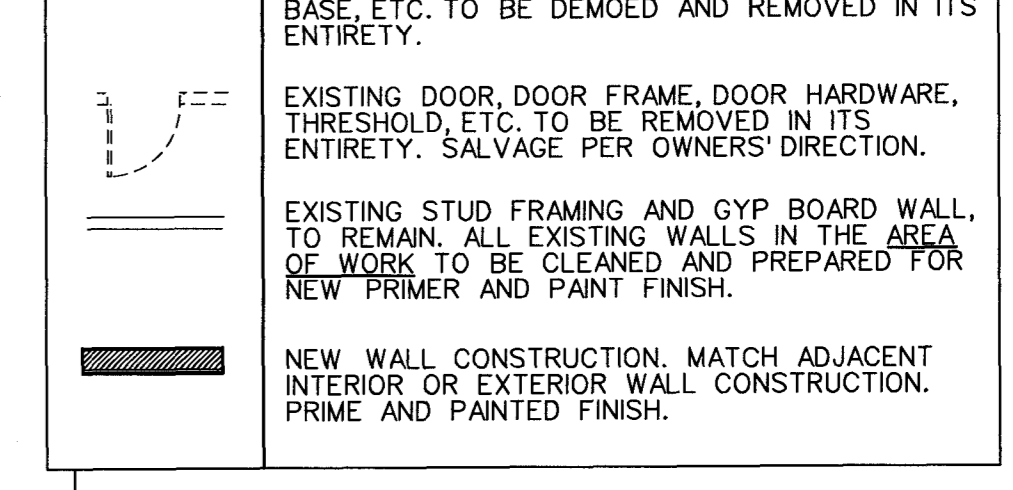

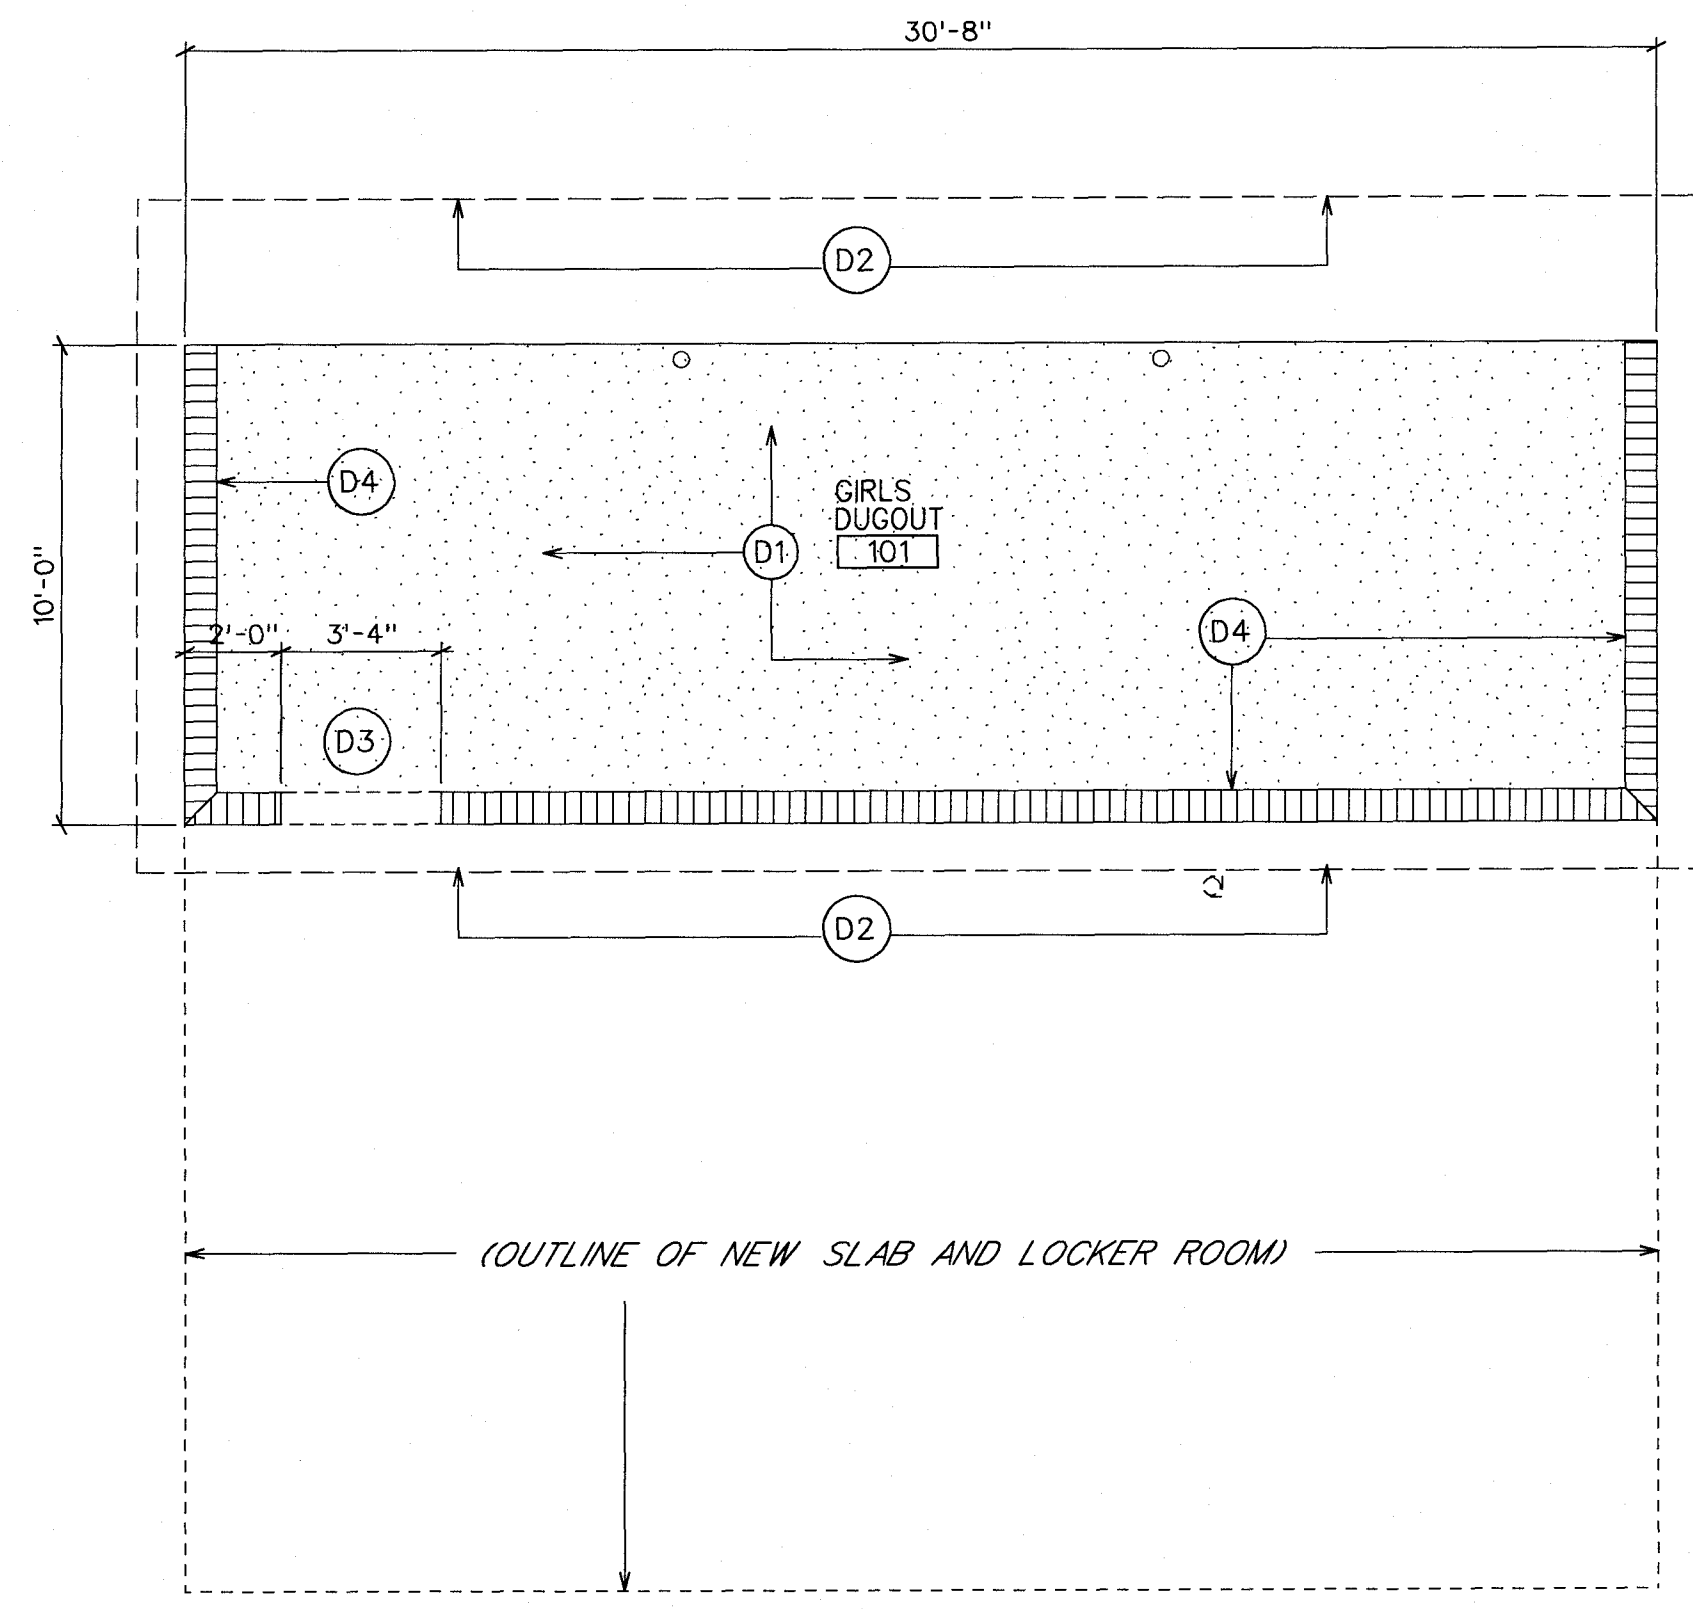

1
A103
MIZE HIGH SCHOOL
DUGOUT FLOOR PLAN (EXISTING/DEMOLITION)
SCALE: 1/4" = 1'-0"

GENERAL NOTES:


- A THE GENERAL CONTRACTOR IS RESPONSIBLE FOR SURVEYING THE EXISTING CONDITIONS AND BUILDING MATERIALS FOR ANY ASBESTOS CONTAINING MATERIALS. PRIOR TO ANY DEMO OR NEW WORK, PROVIDE DOCUMENTATION TO THE ARCHITECT.
- B THE CONTRACTOR IS REQUIRED TO COORDINATE WITH THE OWNER ON REMOVAL OF ALL WALL MOUNTED ITEMS SUCH AS FANS, PAPER TOWEL HOLDERS, ETC. PRIOR TO BEGINNING CONSTRUCTION WORK.

DEMOLITION NOTES:

- D1 EXISTING CONCRETE SLAB TO REMAIN. CLEAN, PRESSURE WASH ALL EXPOSED EXTERIOR CONCRETE SURFACES.
- D2 EXISTING SOFFITS TO REMAIN. CLEAN AND PREP ALL SOFFIT AND EAVE SURFACES TO RECEIVE NEW PRIME AND PAINT FINISH.
- D3 DEMO AND REMOVE EXISTING CMU WALL AREA. PREP WALL FOR INSTALLATION OF NEW 3'-0" X 7'-0" HOLLOW METAL DOOR, FRAME AND THRESHOLD.
- D4 EXISTING EXTERIOR WALLS TO REMAIN. CLEAN AND PREP EXTERIOR AND INTERIOR WALL SURFACES TO RECEIVE NEW PRIME AND PAINT FINISH.
- D5 EXISTING EXTERIOR WALLS TO REMAIN. CLEAN AND PREP EXTERIOR AND INTERIOR WALL SURFACES TO RECEIVE NEW PRIME AND PAINT FINISH.

WALL LEGEND

- EXISTING STUD FRAMING AND GYP BOARD WALL, BASE, ETC. TO BE DEMOED AND REMOVED IN ITS ENTIRETY.
- - - EXISTING DOOR, DOOR FRAME, DOOR HARDWARE, THRESHOLD, ETC. TO BE REMOVED IN ITS ENTIRETY. SALVAGE PER OWNERS' DIRECTION.
- ▤ EXISTING CMU WALLS TO REMAIN. ALL EXISTING CMU WALLS TO BE CLEANED AND PREPARED FOR NEW PRIMER AND PAINT FINISH.

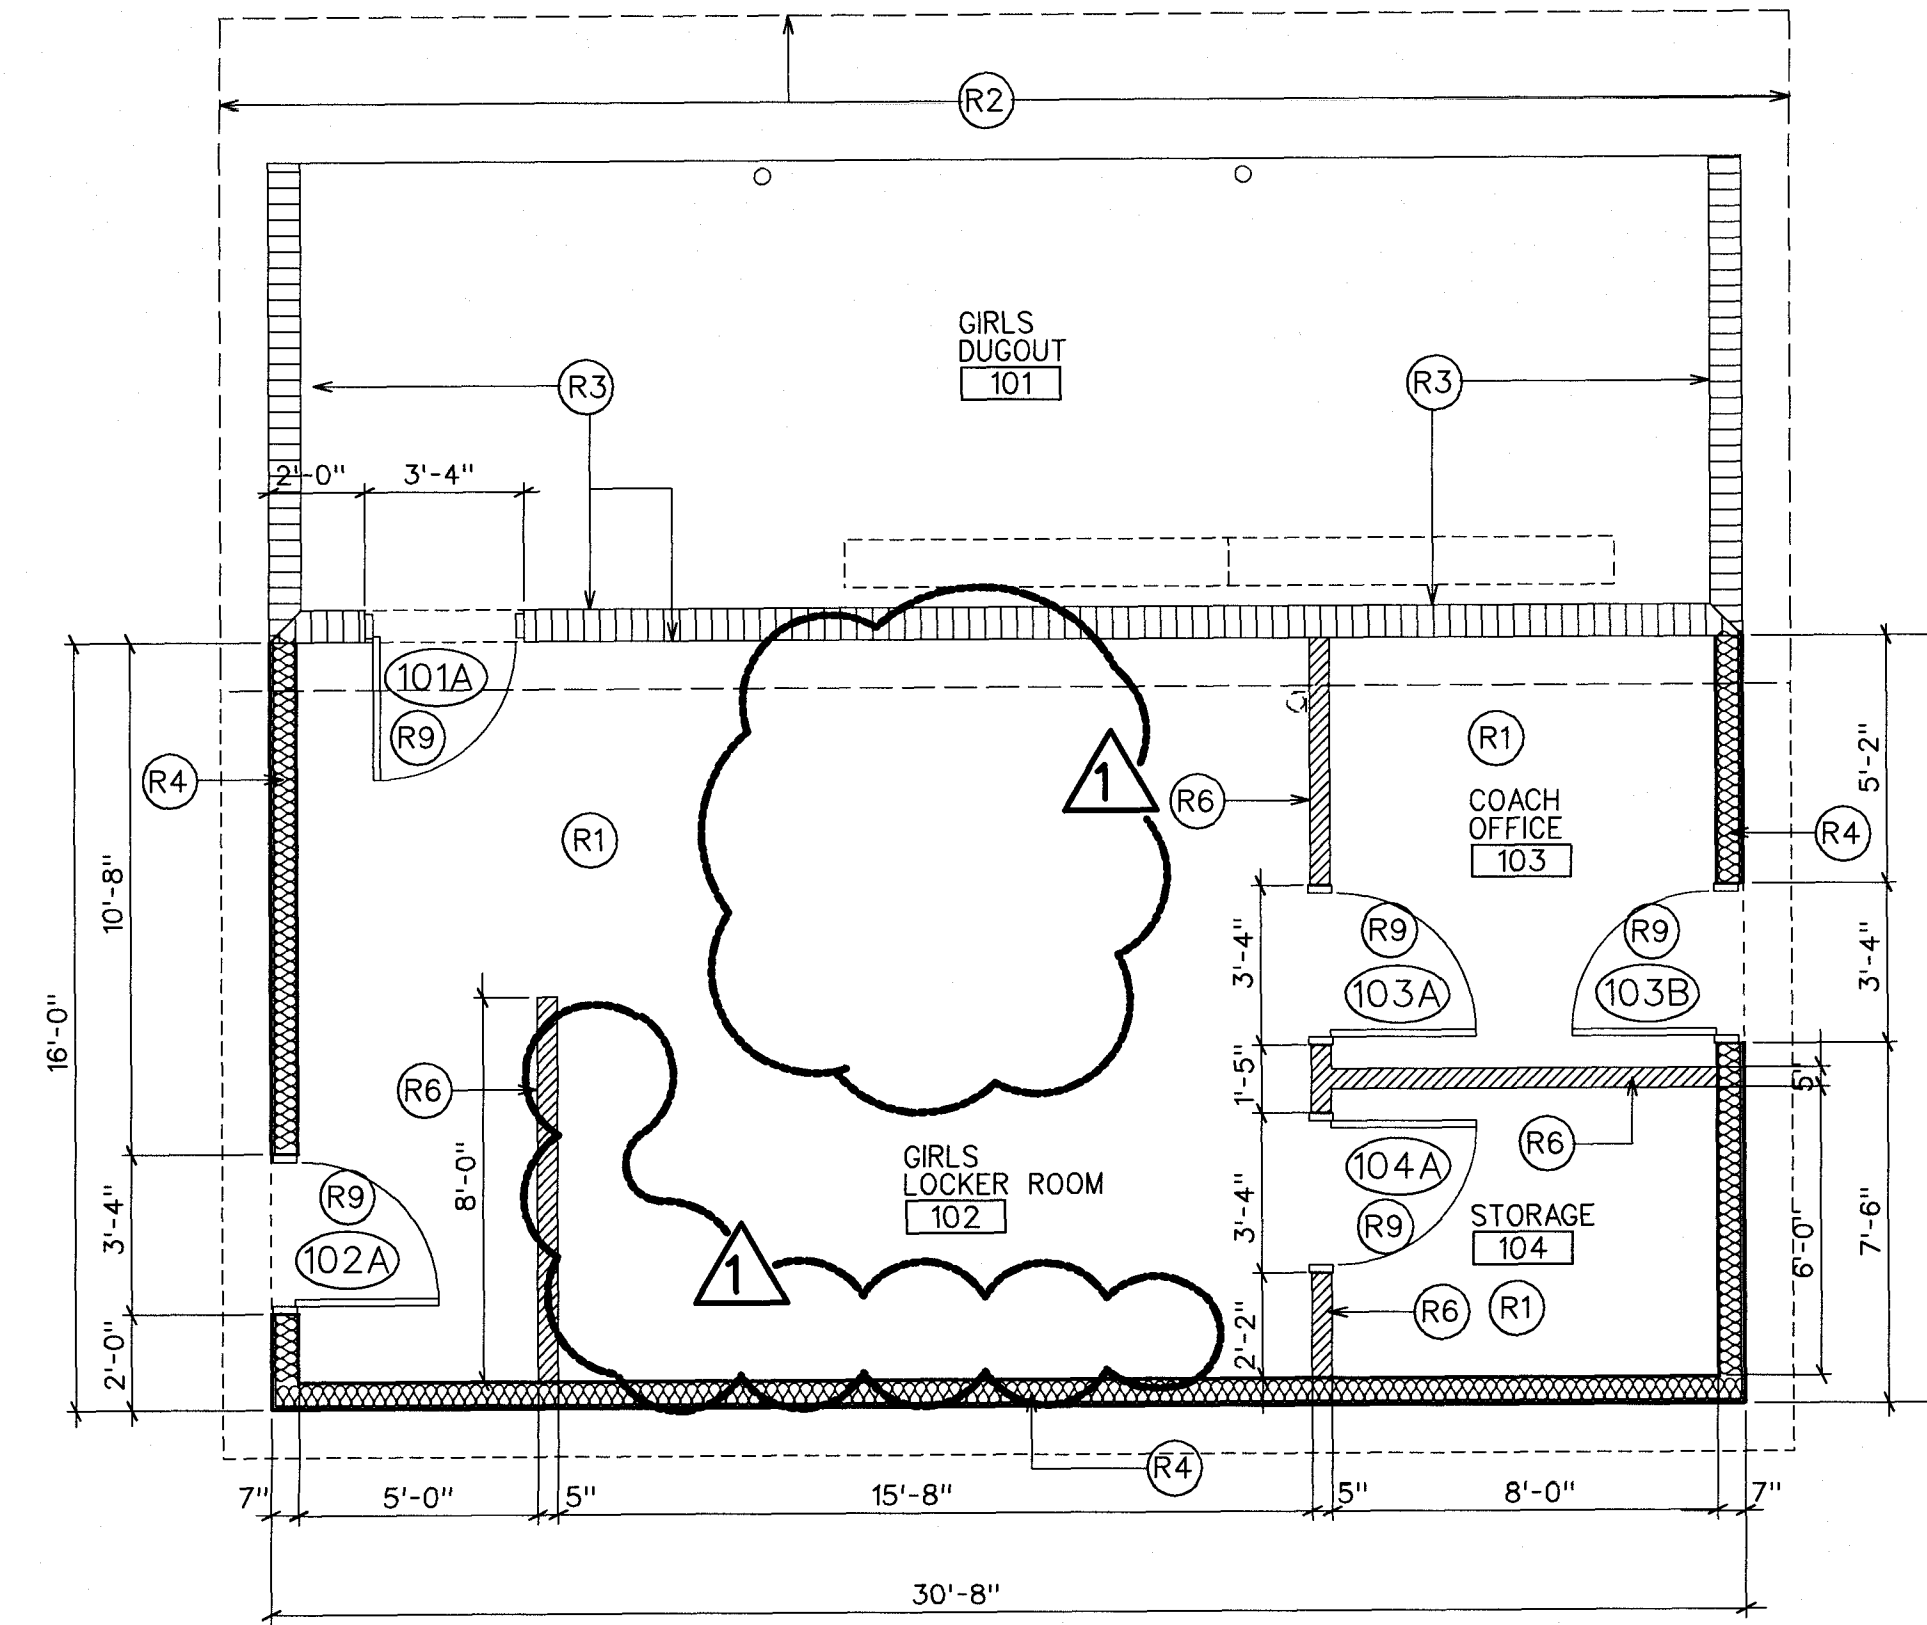

2
A103
MIZE HIGH SCHOOL
DUGOUT FLOOR PLAN AND LOCKER ROOM FLOOR PLAN
(ADDITION/RENOVATION)
SCALE: 1/4" = 1'-0"

GENERAL NOTES:


- A THE GENERAL CONTRACTOR IS RESPONSIBLE FOR SURVEYING THE EXISTING CONDITIONS AND BUILDING MATERIALS FOR ANY ASBESTOS CONTAINING MATERIALS. PRIOR TO ANY DEMO OR NEW WORK, PROVIDE DOCUMENTATION TO THE ARCHITECT.
- B THE CONTRACTOR IS REQUIRED TO COORDINATE WITH THE OWNER ON REMOVAL OF ALL WALL MOUNTED ITEMS SUCH AS FANS, PAPER TOWEL HOLDERS, ETC. PRIOR TO BEGINNING CONSTRUCTION WORK.

RENOVATION NOTES:


- R1 SEAL NEW CONCRETE SLAB WITH CONCRETE SEALER. MATCH F.F.E. OF ADJACENT SLAB.
- R2 PRIME AND PAINT EXISTING SOFFITS AND EAVES/FASCIA. COLOR AS SELECTED BY ARCHITECT.
- R3 PRIME AND PAINT EXISTING CMU WALL SURFACES. COLOR AS SELECTED BY ARCHITECT.
- R4 EXTERIOR WALLS, 2" X 6" WOOD STUDS @ 16" O.C., W/ 5/8" PLYWOOD SHEATHING AND AIR BARRIER. EXTERIOR SIDING IS 5" WIDE X 3/4" THICK FIBER CEMENT SIDING. (PAINTED). 5/8" PLYWOOD ON THE INTERIOR SURFACE (PAINTED).
- R5
- R6 INSTALL NEW 5" INTERIOR WALL, 2 X 4 WOOD STUDS AT 16" O.C. WITH 5/8" PLYWOOD ON EACH SIDE. PRIME AND PAINT INTERIOR WALL SURFACES. COLOR AS SELECTED BY ARCHITECT.
- R7 OMIT/NOT USED
- R8 OMIT/NOT USED
- R9 INSTALL NEW 3'-0" X 7'-0" DOOR AND FRAME, PRIME AND PAINT
- R10 OMIT/NOT USED

WALL LEGEND

- EXISTING STUD FRAMING AND GYP BOARD WALL, BASE, ETC. TO BE DEMOED AND REMOVED IN ITS ENTIRETY.
- - - EXISTING DOOR, DOOR FRAME, DOOR HARDWARE, THRESHOLD, ETC. TO BE REMOVED IN ITS ENTIRETY. SALVAGE PER OWNERS' DIRECTION.
- ▤ EXISTING CMU WALLS TO REMAIN. ALL EXISTING CMU WALLS TO BE CLEANED AND PREPARED FOR NEW PRIMER AND PAINT FINISH.
- ▨ NEW 5" (NOM.) WIDE INTERIOR PARTITION, 2" X 4" WOOD STUDS AT 16" O.C. WITH 5/8" PLYWOOD EACH SIDE. PRIME AND PAINTED FINISH.
- ▩ NEW 7" (NOM.) EXTERIOR WALLS, 2" X 6" WOOD STUDS @ 16" O.C. W/ 5/8" PLYWOOD SHEATHING AND AIR BARRIER. EXTERIOR SIDING IS 5" WIDE X 3/4" THICK FIBER CEMENT SIDING. (PAINTED). 5/8" PLYWOOD ON THE INTERIOR SURFACE (PAINTED).

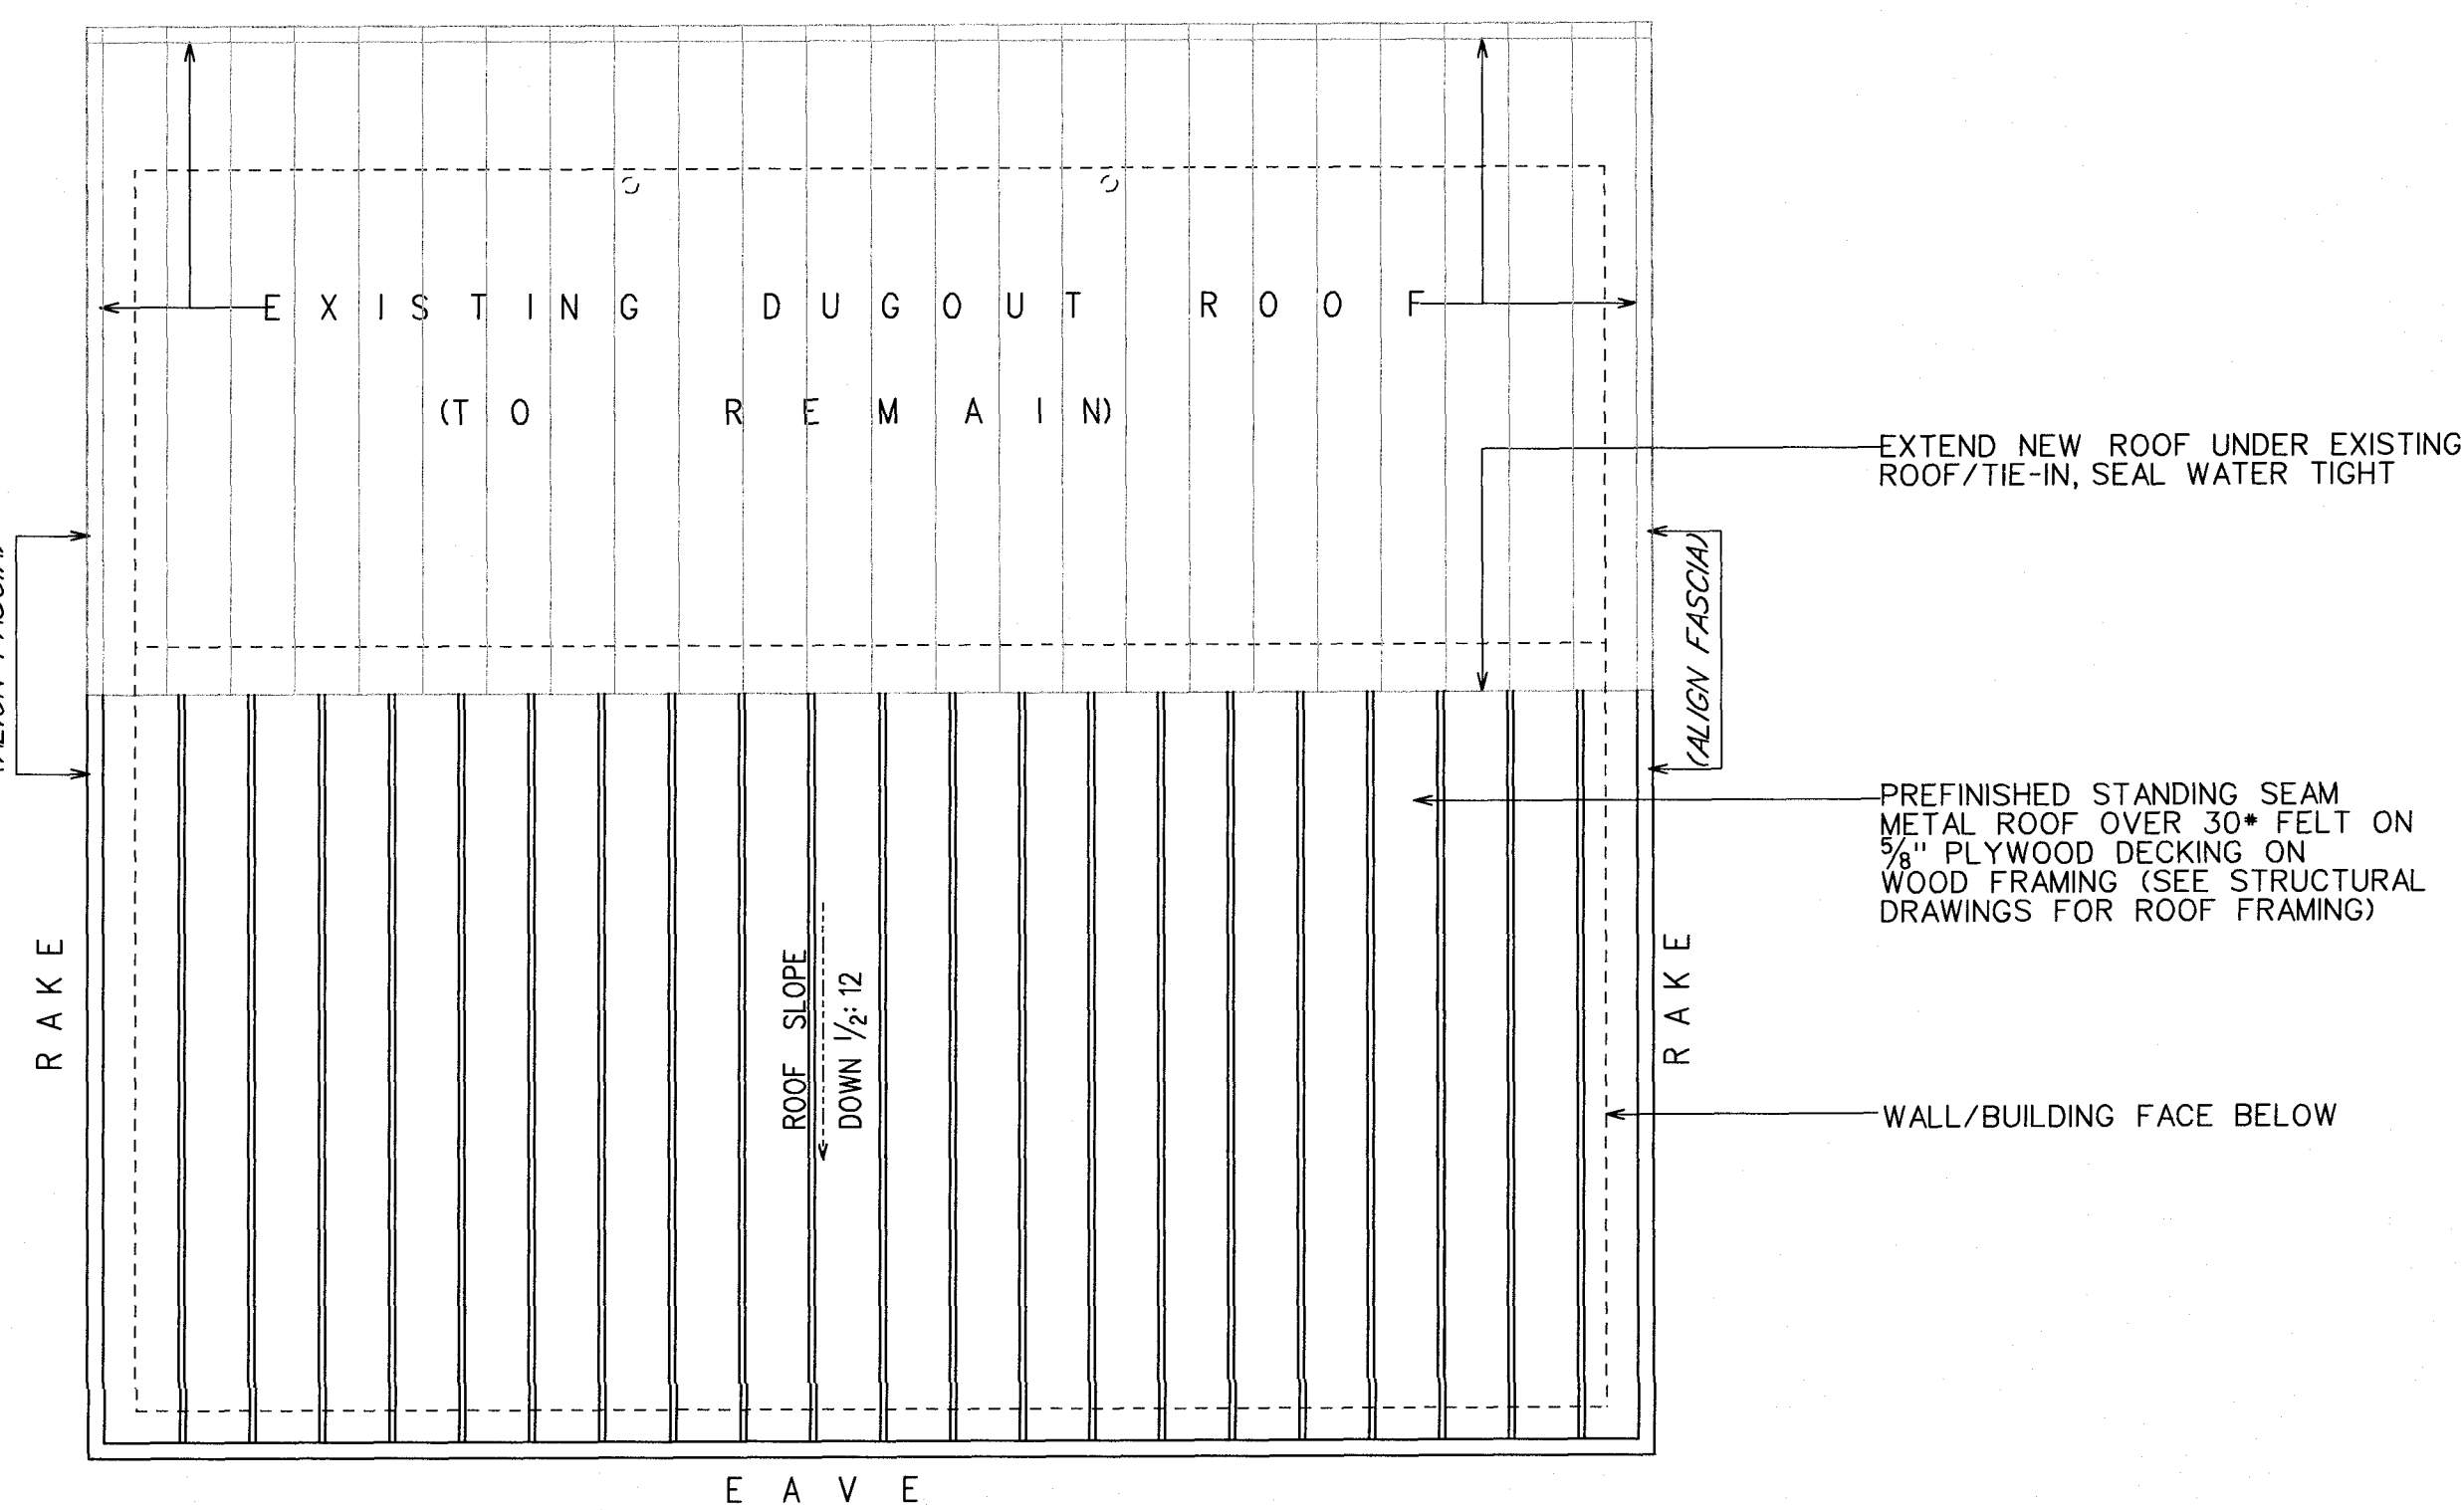

3
A103
MIZE HIGH SCHOOL
DUGOUT/LOCKER ROOM ROOF PLAN
(ADDITION/RENOVATION)
SCALE: 1/4" = 1'-0"

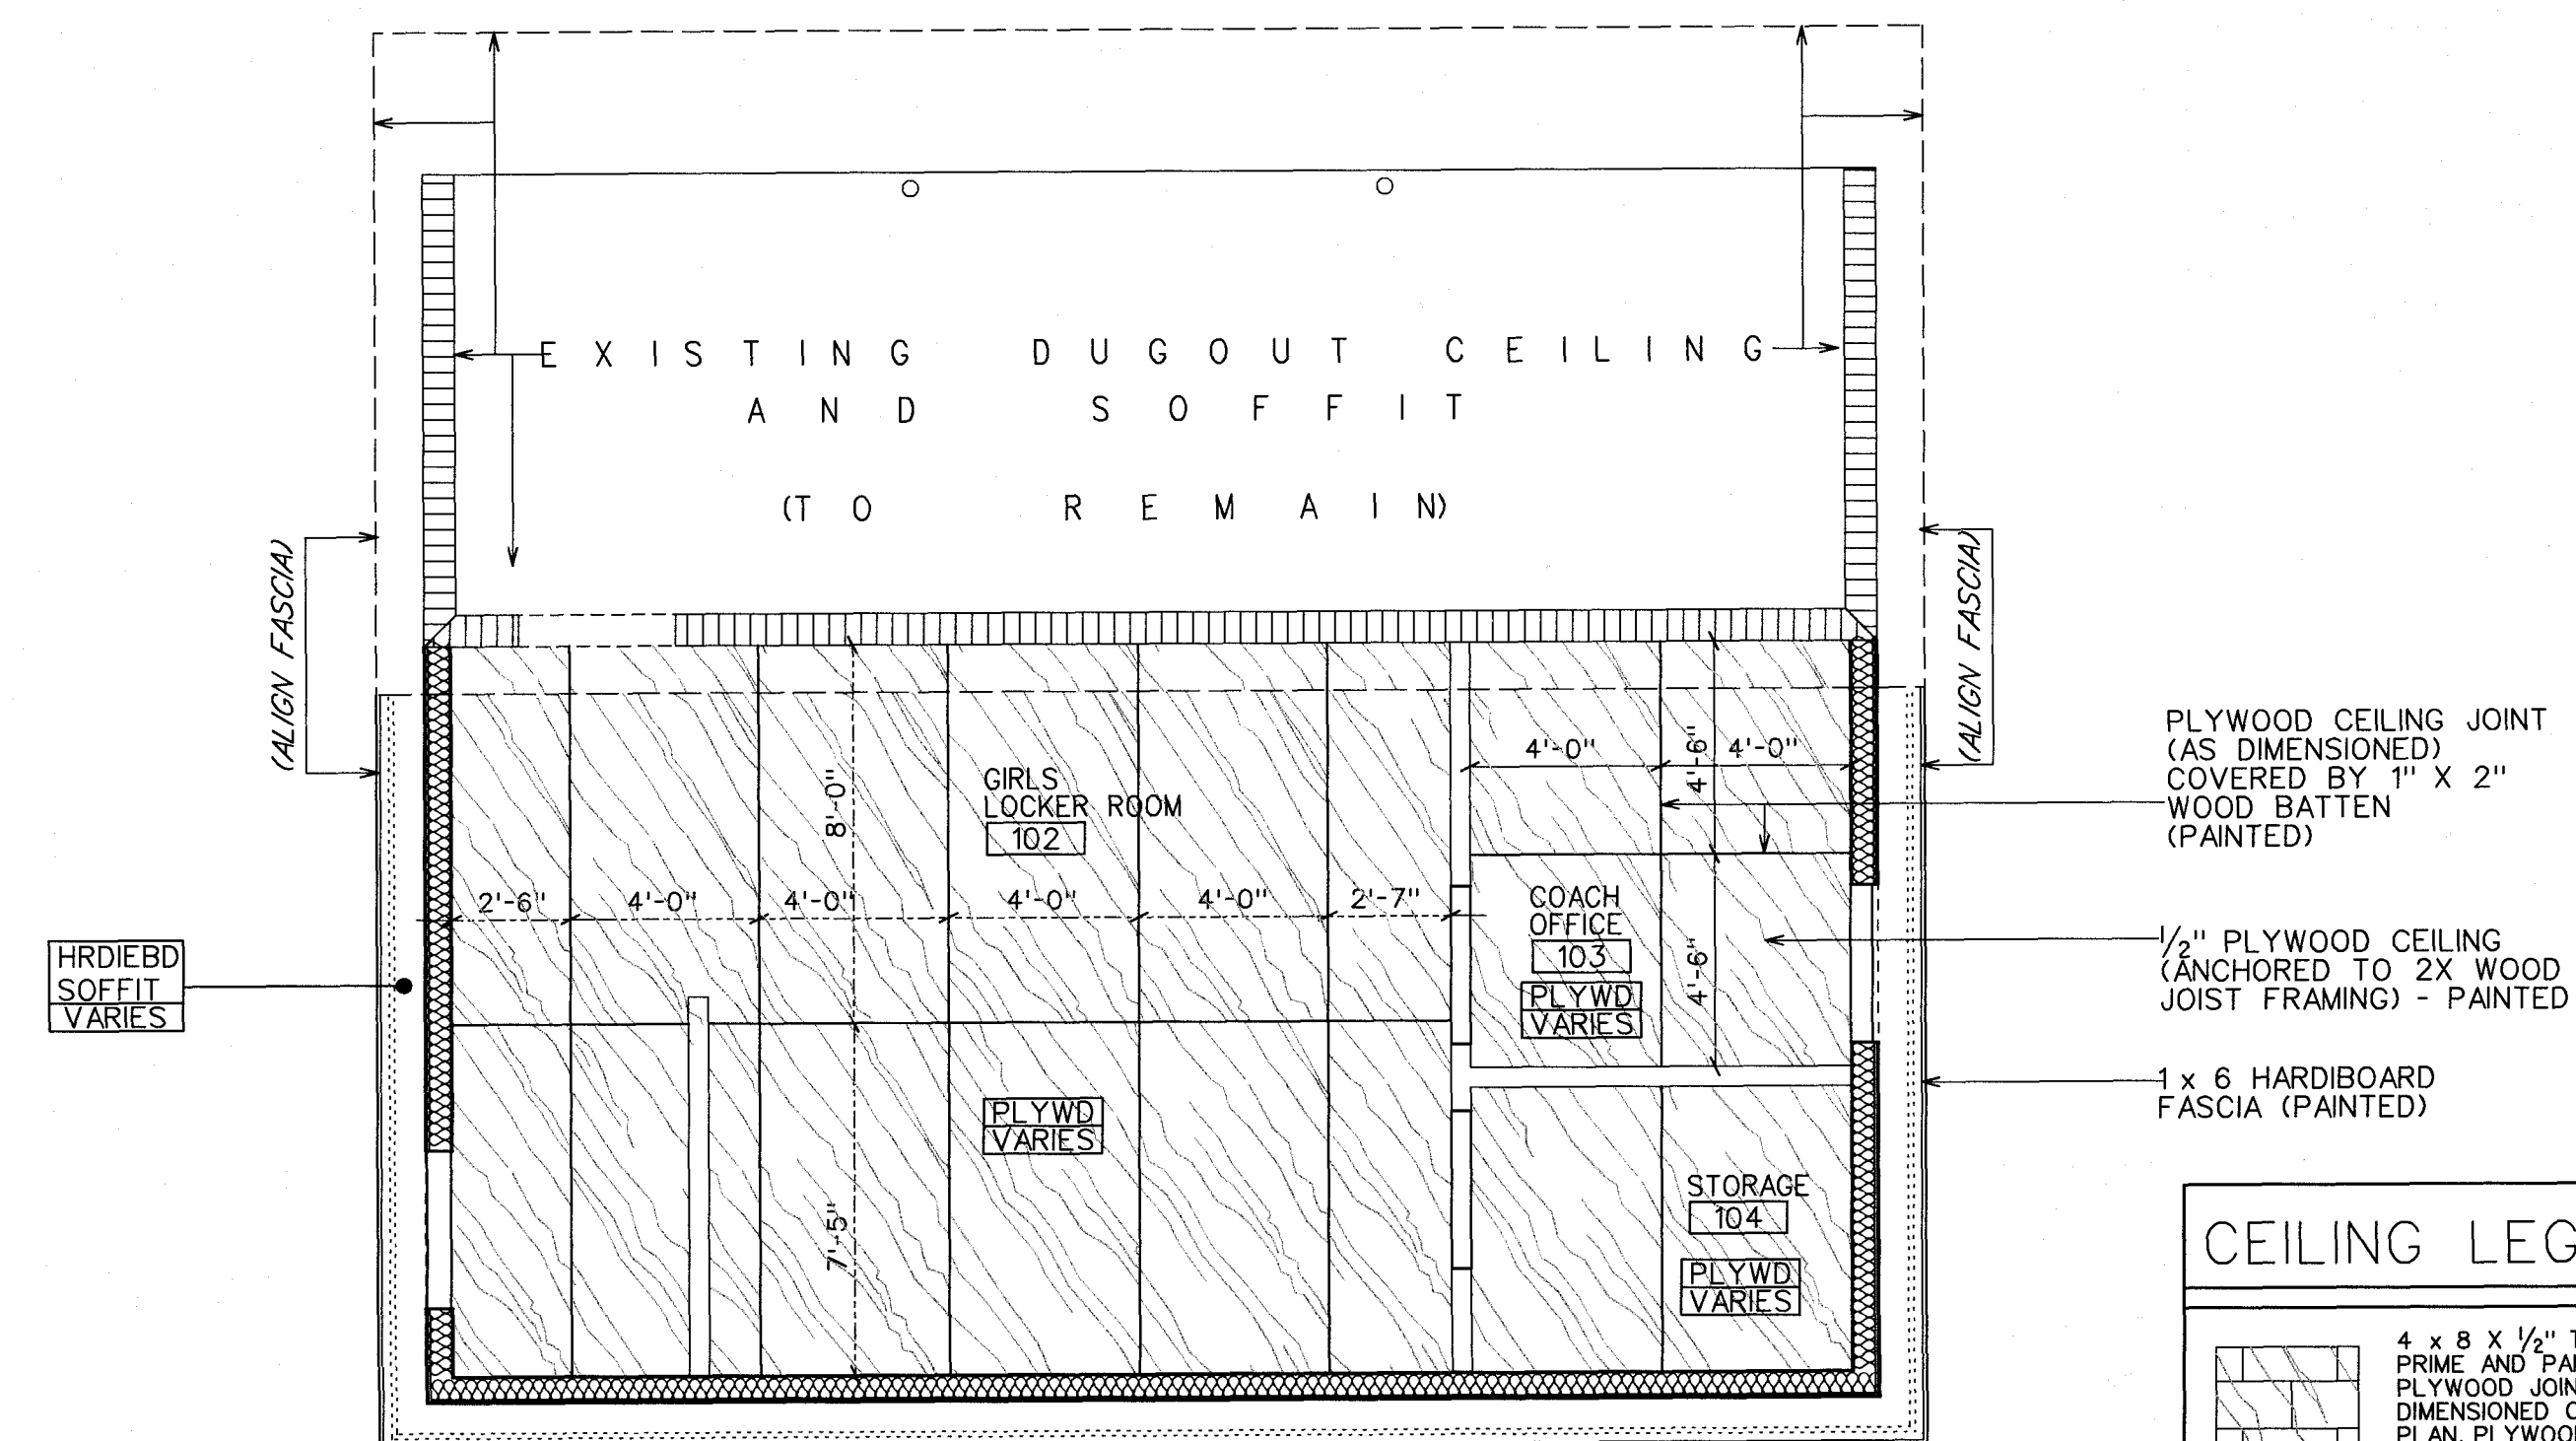

4
A103
MIZE HIGH SCHOOL
LOCKER ROOM REFLECTED CEILING PLAN
(ADDITION/RENOVATION)
SCALE: 1/4" = 1'-0"

CEILING LEGEND

- ▨ 4 X 8 X 1/2" THICK PLYWOOD WITH PRIME AND PAINTED FINISH. PLYWOOD JOINTS AS SHOWN DIMENSIONED ON REFLECTED CEILING PLAN. PLYWOOD ANCHORED TO B.D. CEILING JOISTS. ALL JOISTS TO BE COVERED WITH 1" X 2" WOOD BATTENS, AND PAINTED TO MATCH PLYWOOD.
- ▩ HARDBOARD VENTED SOFFIT PANELS. PAINTED. SOFFIT WIDTH TO MATCH AND ALIGN WITH EXISTING SOFFIT.

SCSD NEW SOFTBALL FACILITIES
RALEIGH AND MIZE
FN 19064

Dean and Dean / Associates
architects a professional association
DEAN • GEDDIE • GRANT • OUBRE
P.O. Box 4685 Jackson, MS 39206 4400 Old Canton Rd. Suite 200, Highland Bluff, Jackson, MS 39211 (601) 939-7717
www.deandean.com

Project No: 19064 Revisions: OCTOBER 16, 2019
Date: SEPTEMBER 18, 2019
Drawn: JMD, AG
Checked: AG



SMITH COUNTY SCHOOL DISTRICT
NEW SOFTBALL FACILITIES

MIZE HIGH SCHOOL
GIRLS DUGOUT LOCKER ROOM ADDITION

RALEIGH AND MIZE, MISSISSIPPI


A103

SCSD NEW SOFTBALL FACILITIES
RALEIGH AND MIZE
PM 19064

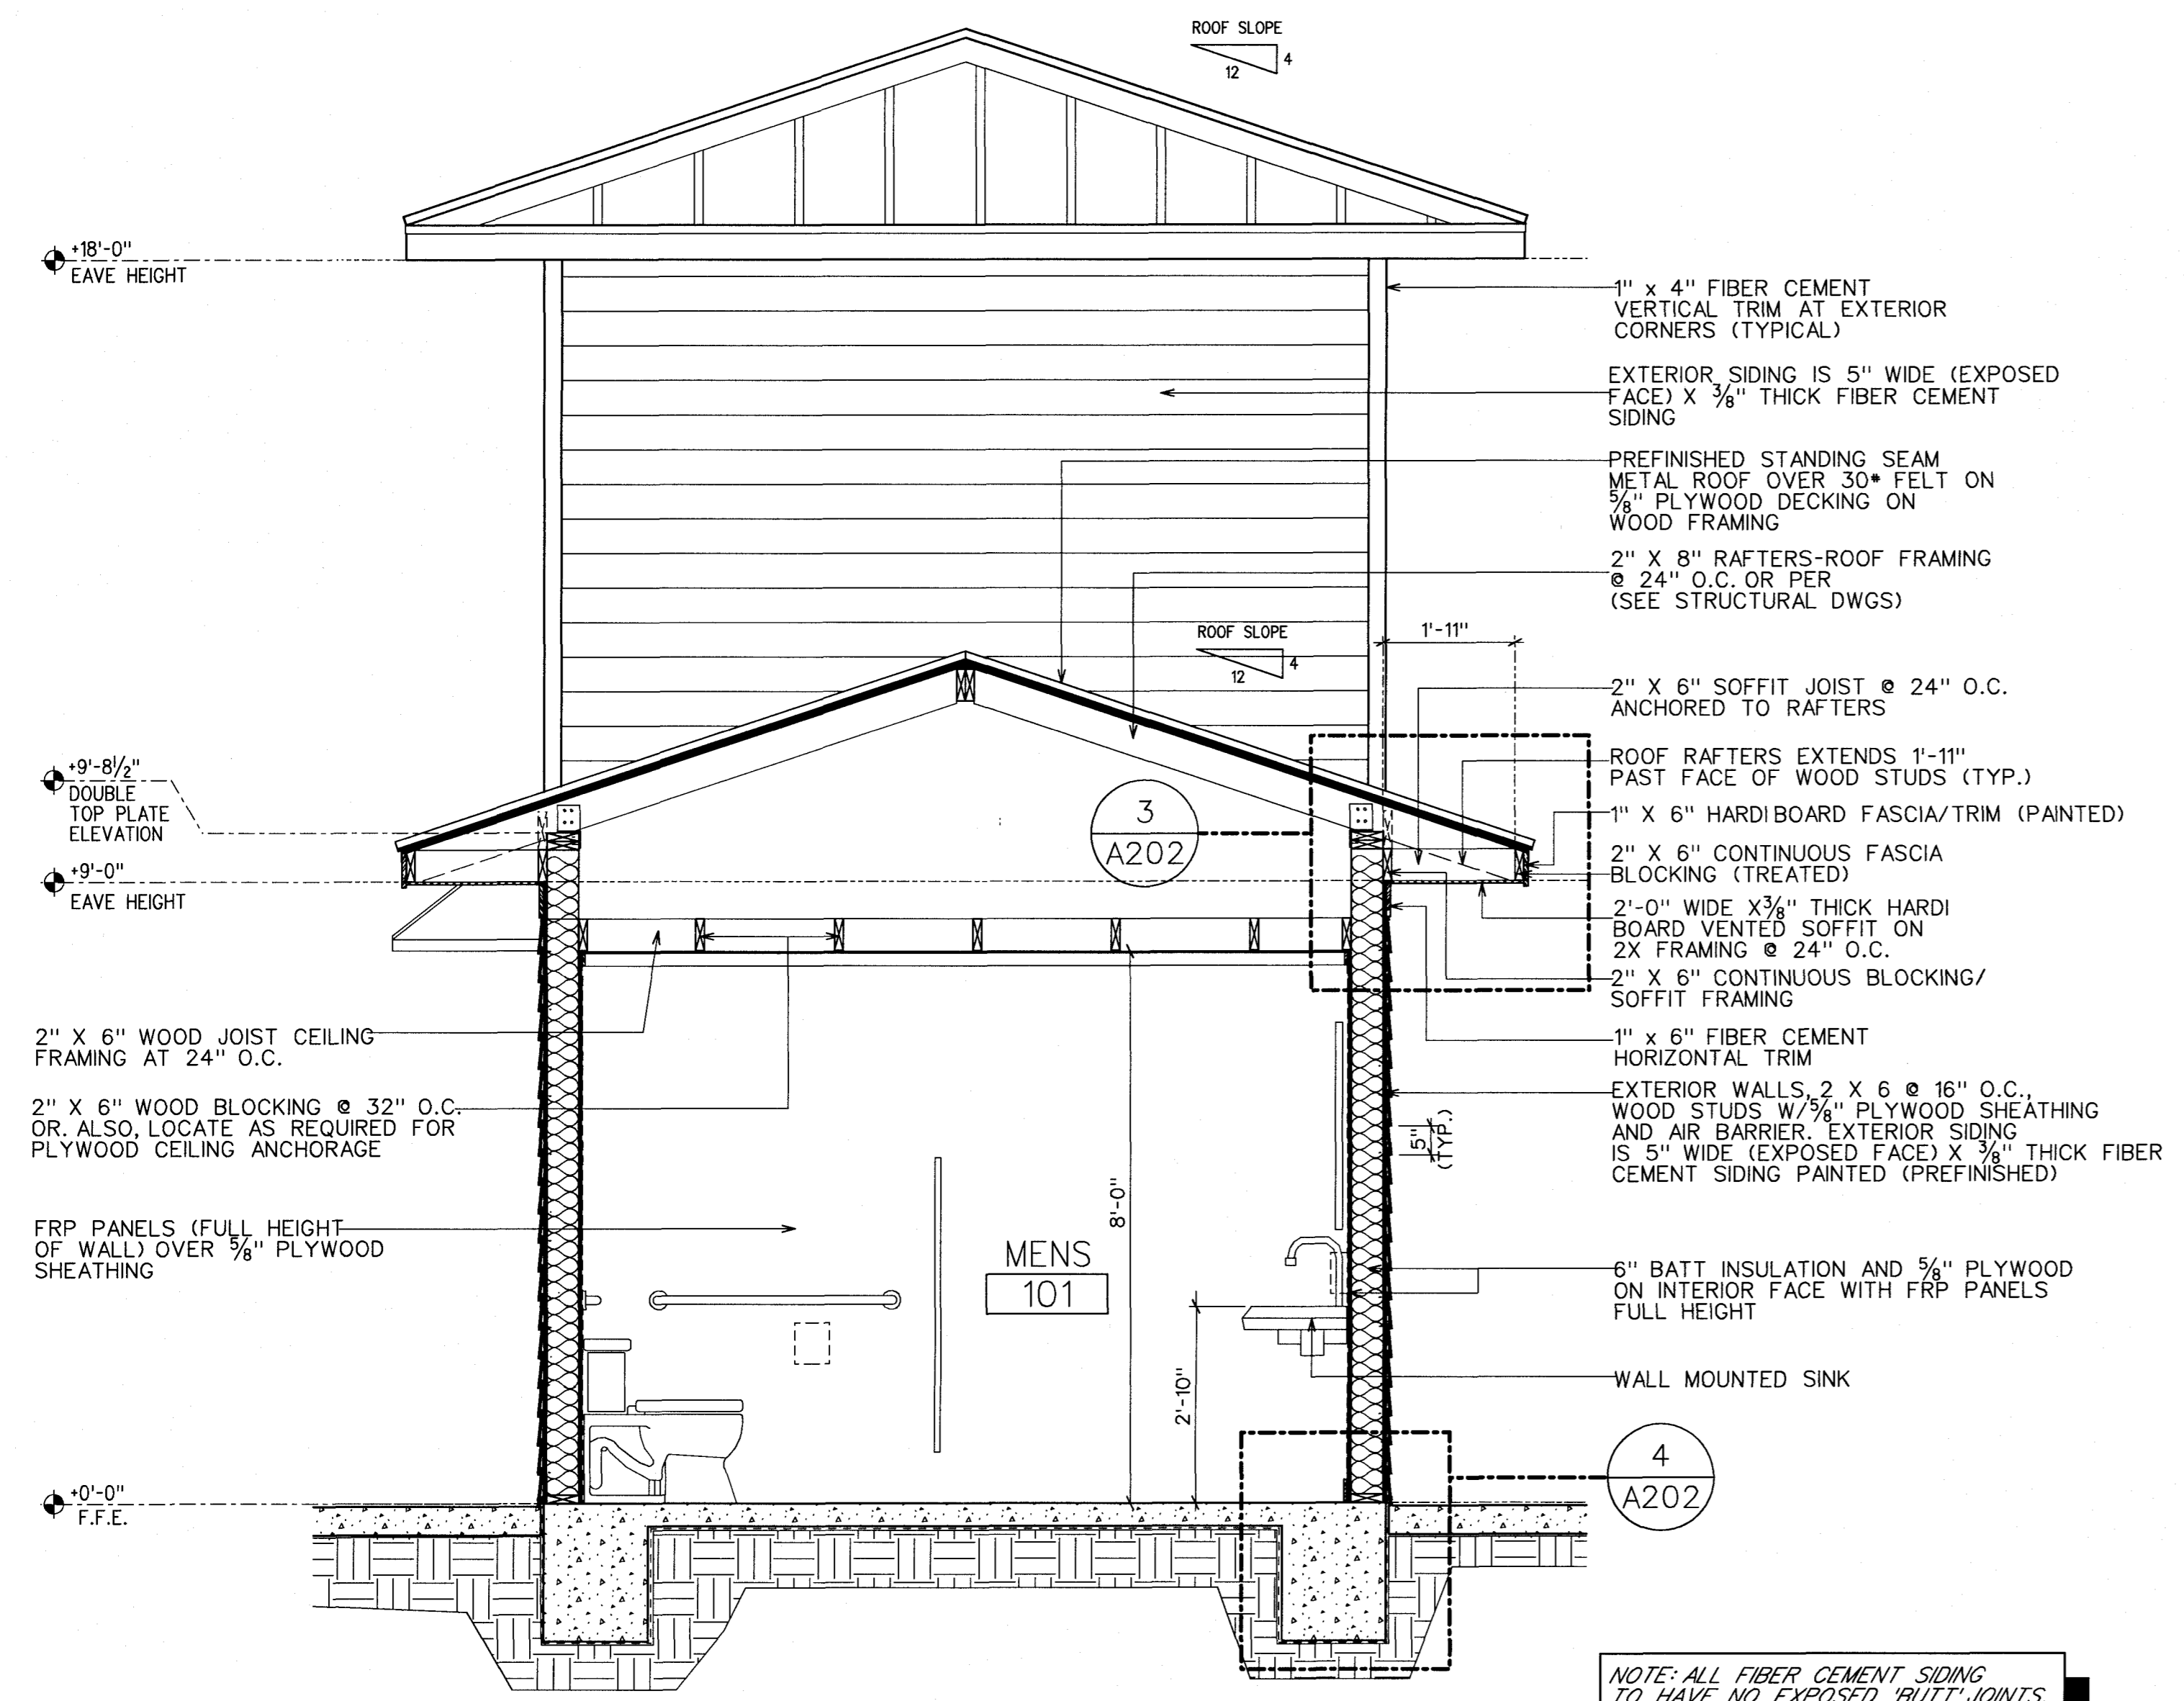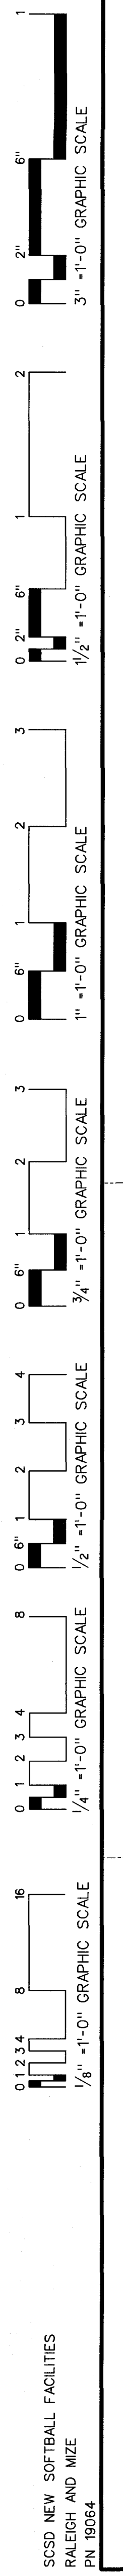


1
A202
RALEIGH H.S. PRESSBOX/CONCESSIONS
BUILDING SECTION
SCALE: 1/2" = 1'-0"

NOTE: ALL FIBER CEMENT SIDING TO HAVE NO EXPOSED BUTT JOINTS. SIDING TO BE CUT TO LENGTHS SHOWN ON ELEVATIONS, FRAMED BY 1" X 2" TRIM SECTIONS AS SHOWN.

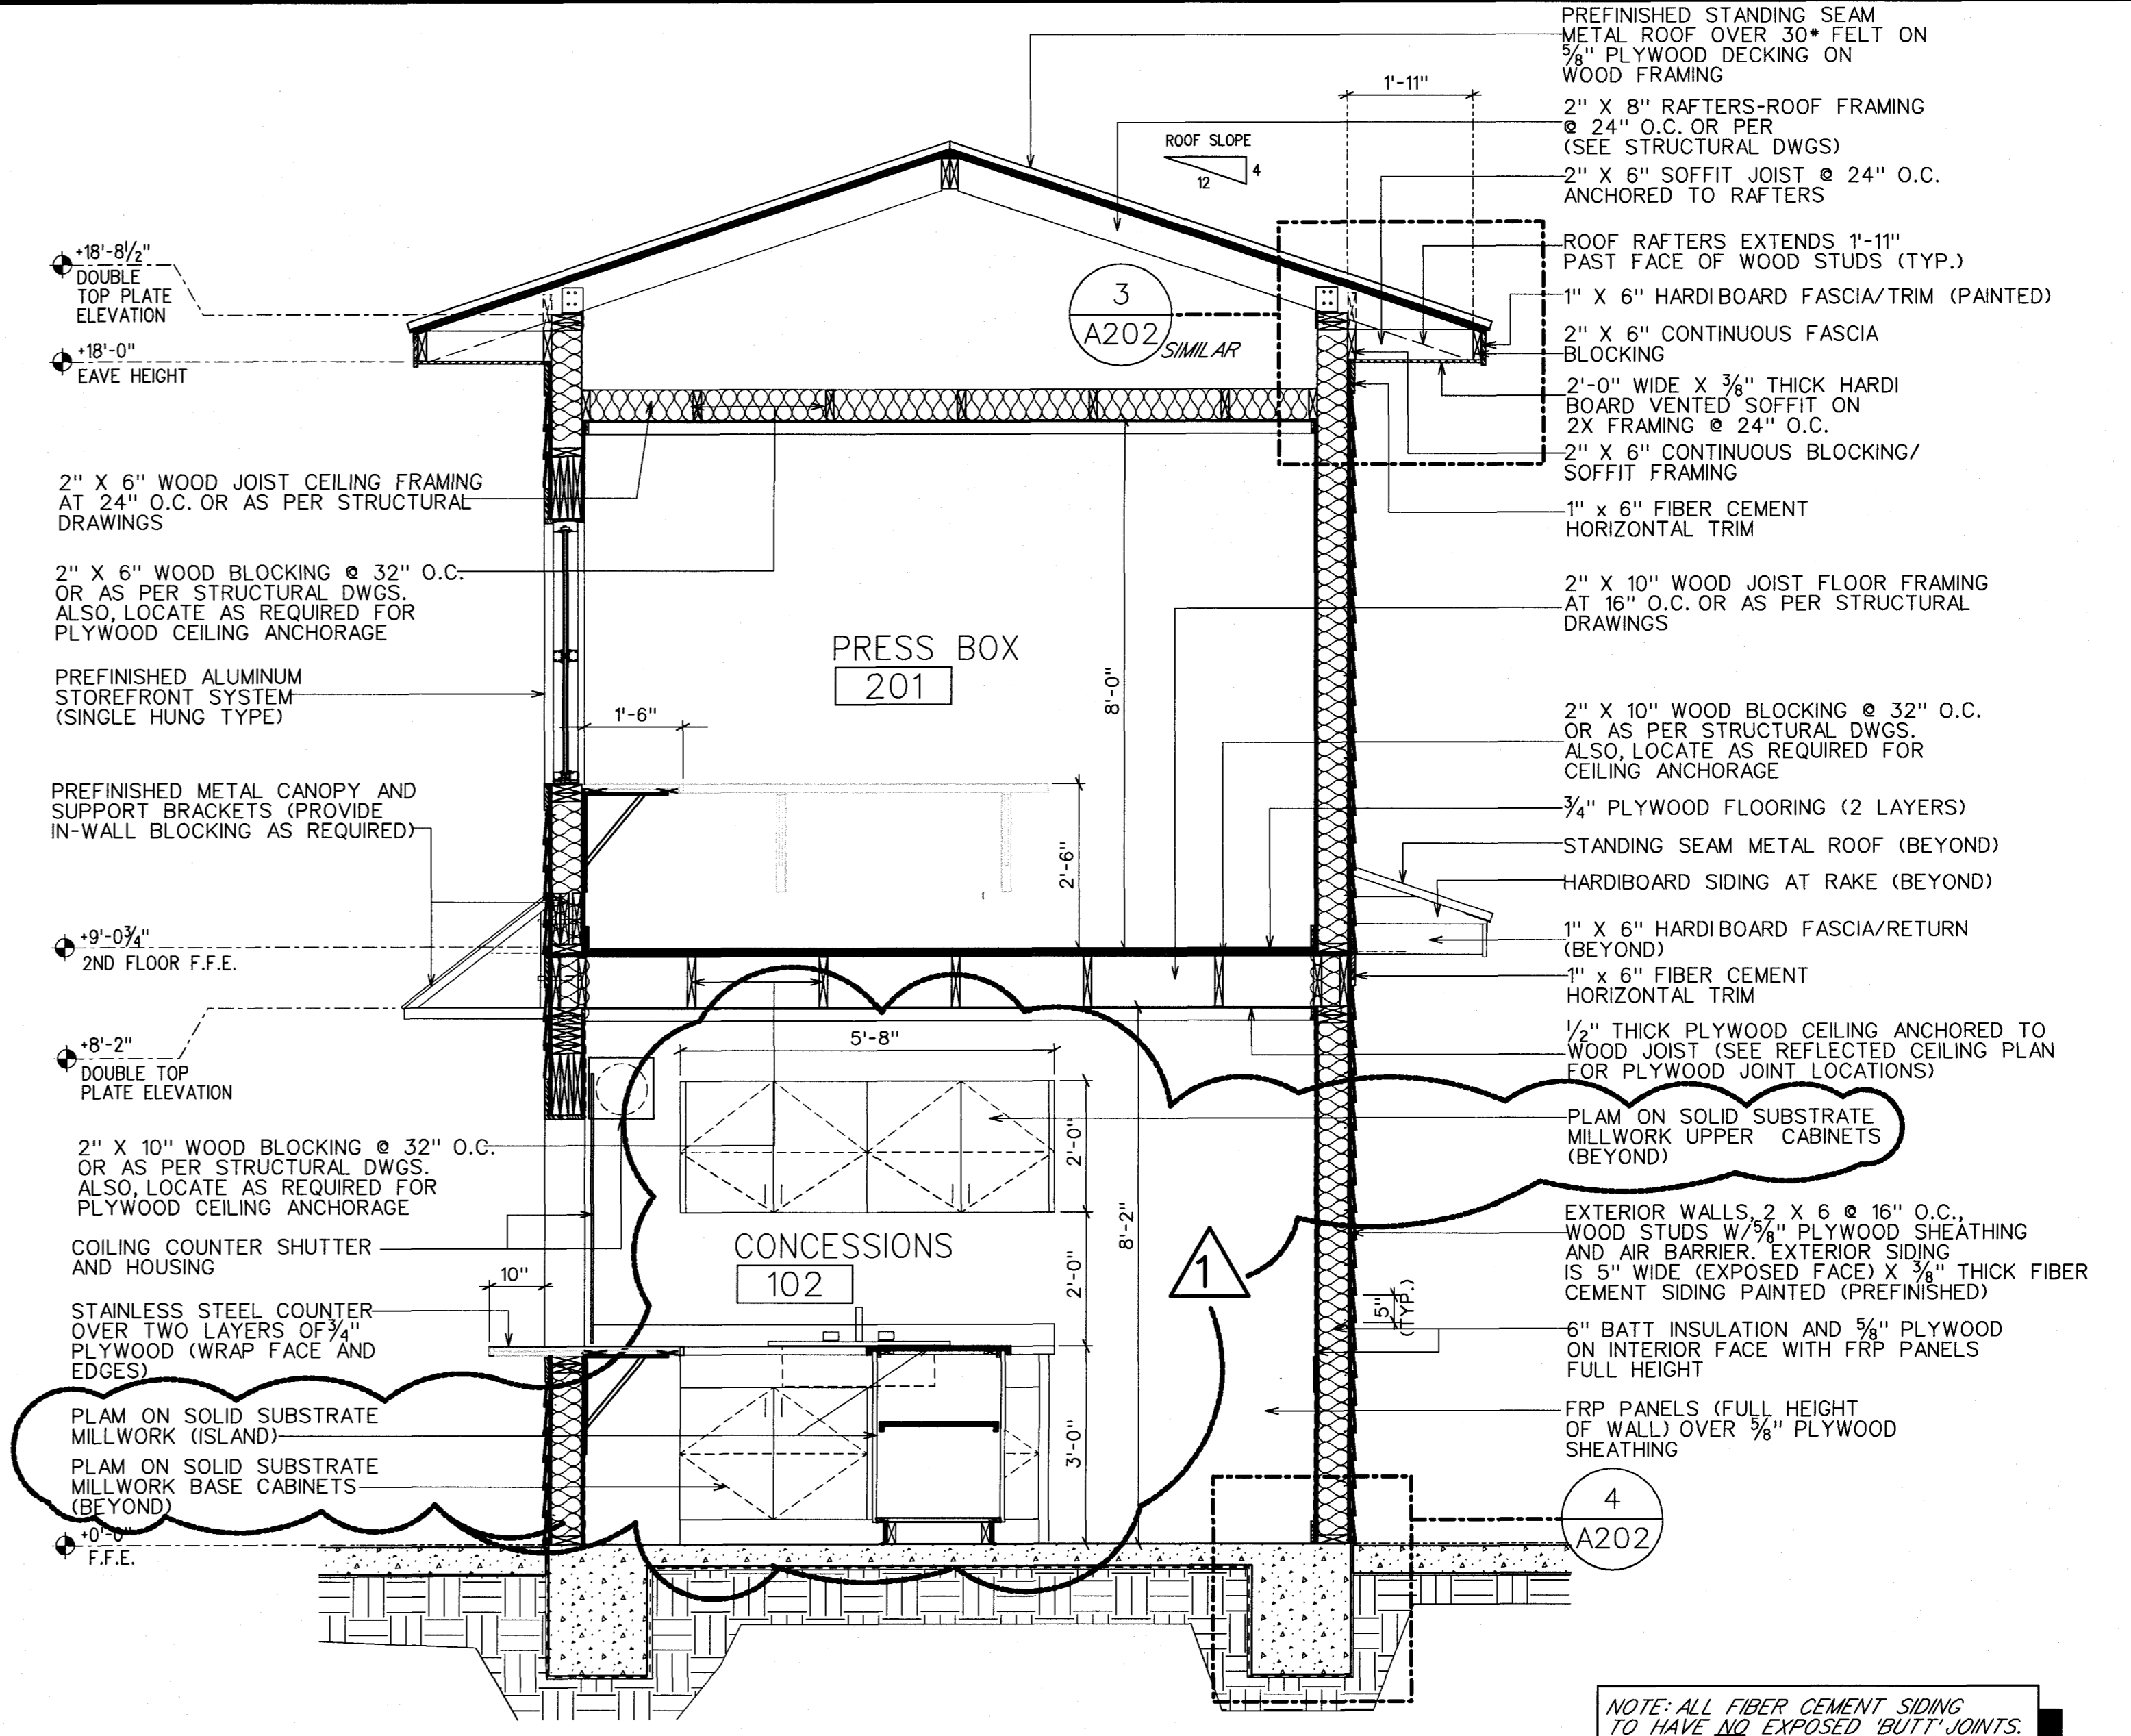


2
A202
RALEIGH H.S. PRESSBOX/CONCESSIONS
BUILDING SECTION
SCALE: 1/2" = 1'-0"

NOTE: ALL FIBER CEMENT SIDING TO HAVE NO EXPOSED BUTT JOINTS. SIDING TO BE CUT TO LENGTHS SHOWN ON ELEVATIONS, FRAMED BY 1" X 2" TRIM SECTIONS AS SHOWN.

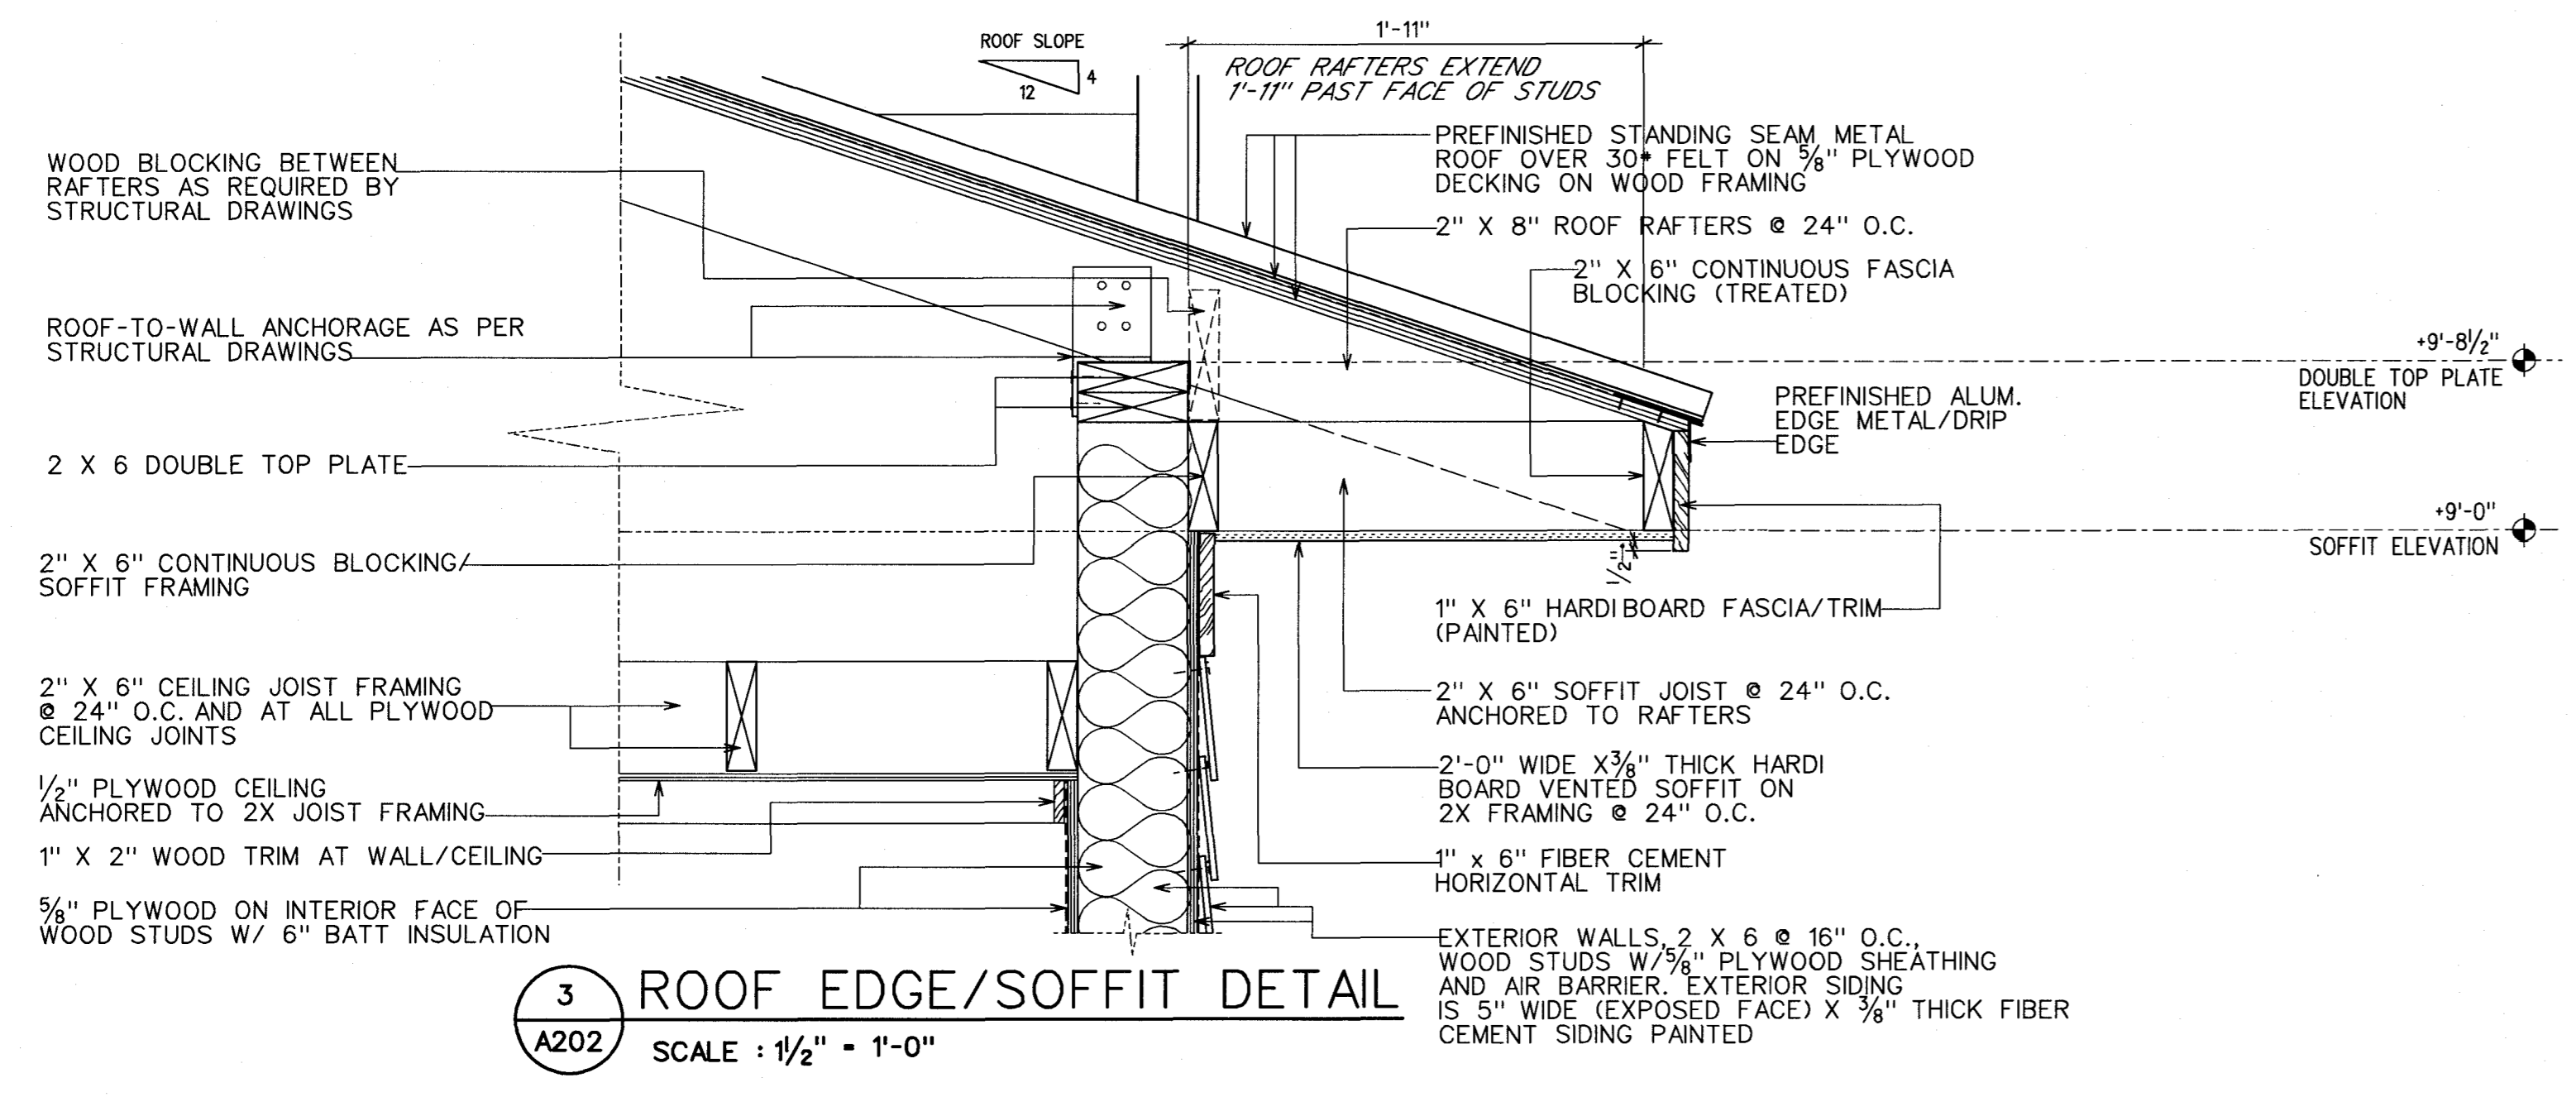

3
A202
RALEIGH H.S. PRESSBOX/CONCESSIONS
ROOF EDGE/SOFFIT DETAIL
SCALE: 1/2" = 1'-0"

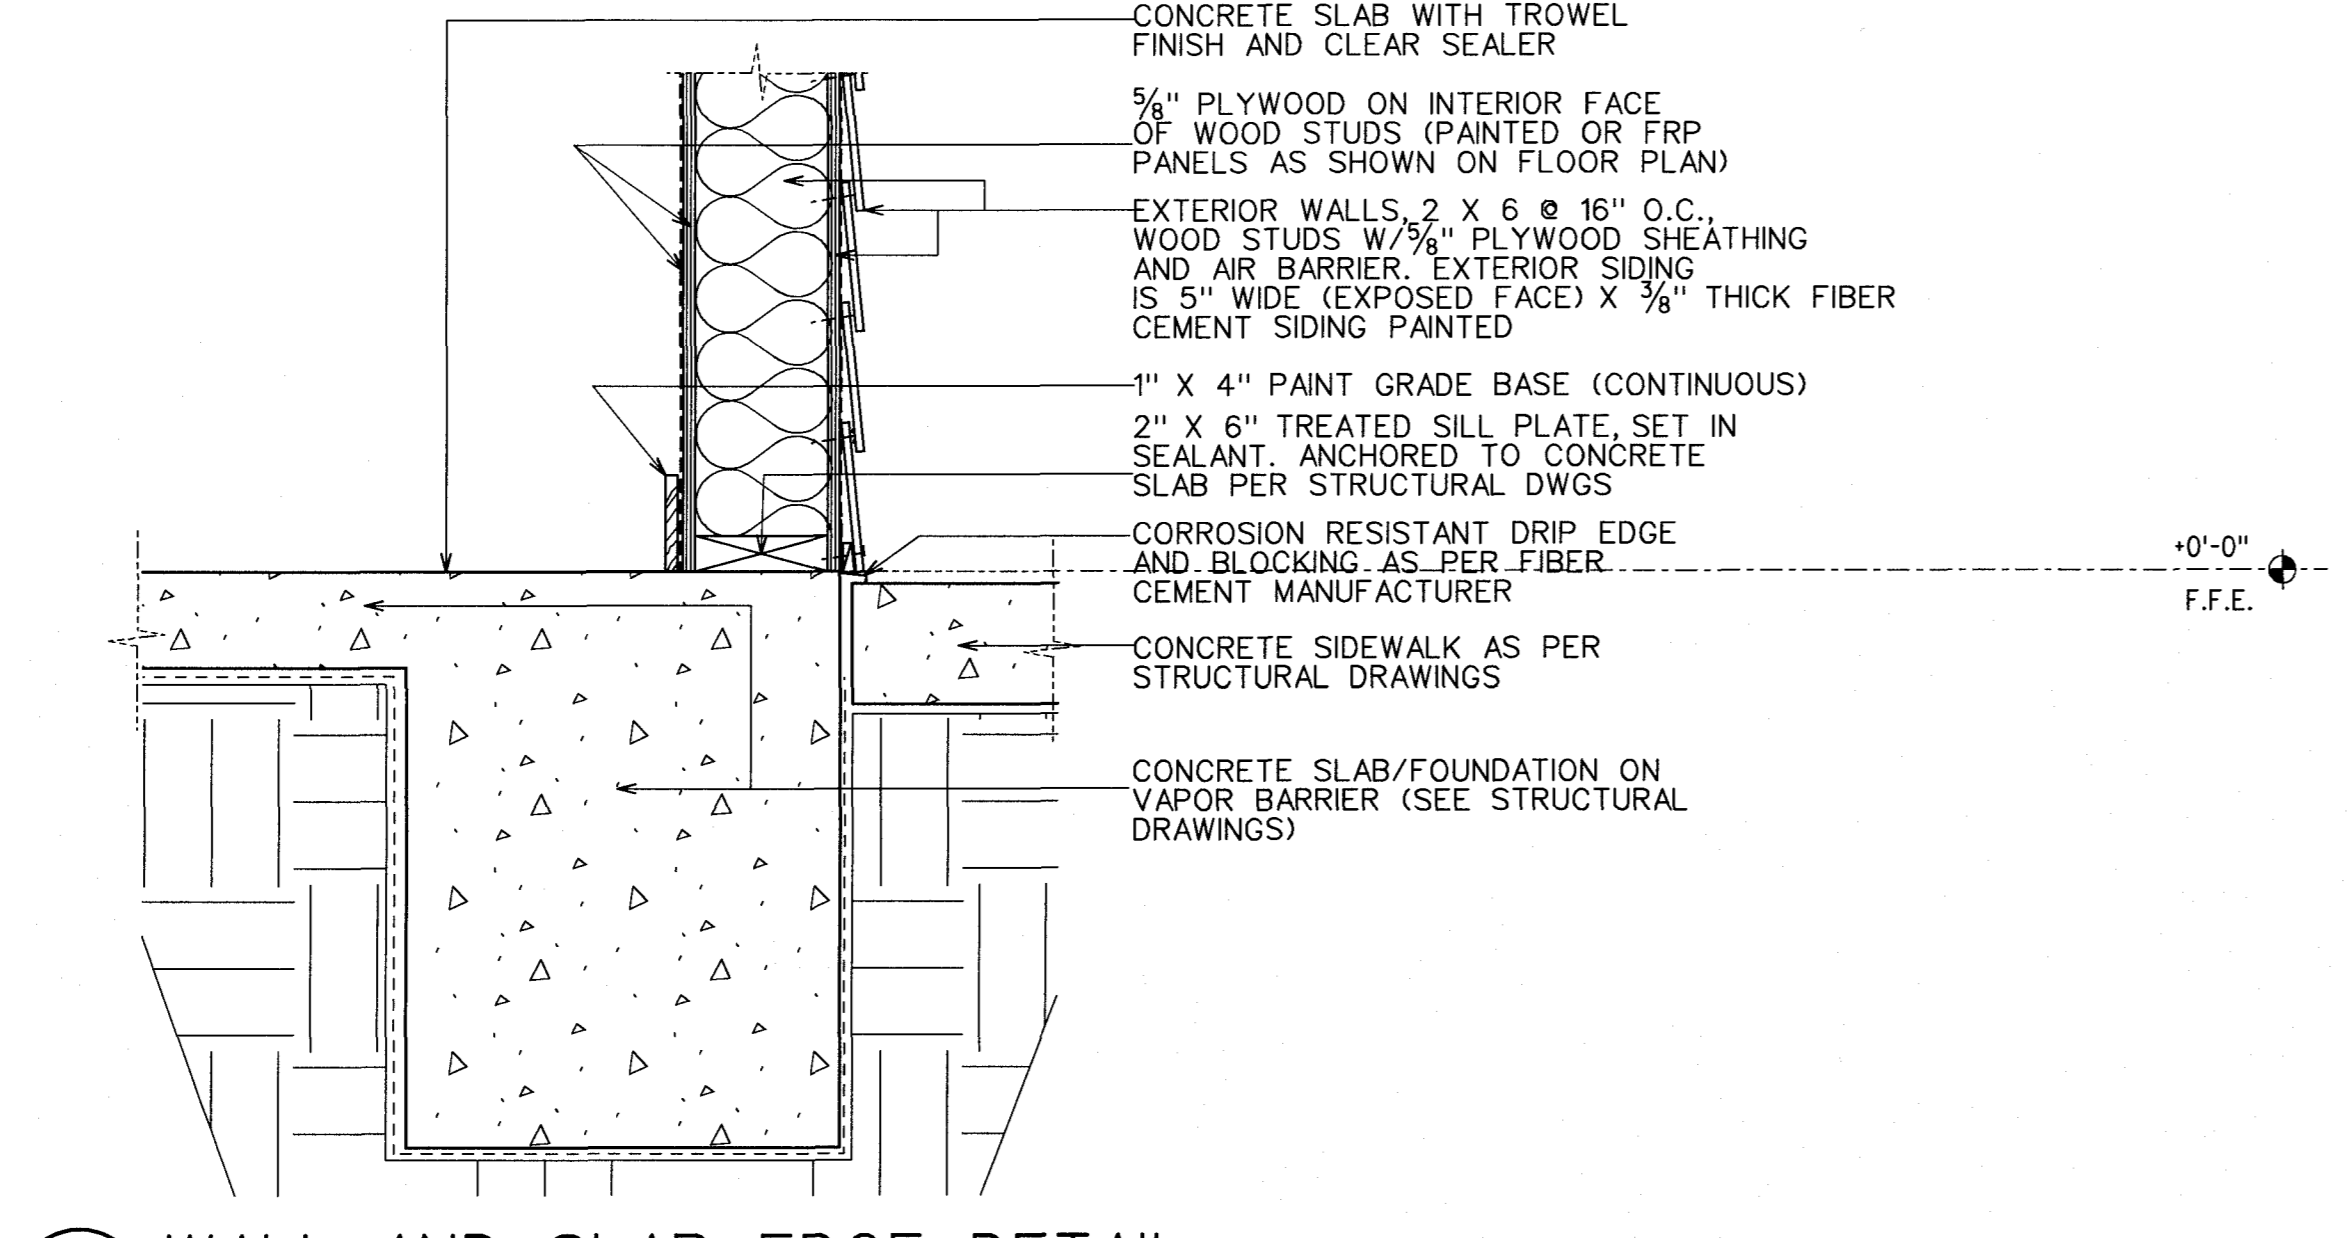

4
A202
RALEIGH H.S. PRESSBOX/CONCESSIONS
WALL AND SLAB EDGE DETAIL
SCALE: 1/2" = 1'-0"

