

**Pediatric Clinic 2022
Neshoba General
Philadelphia, MS**

**From: Foil Wyatt Architects & Planners, PLLC
1510 North State Street, Suite 200
Jackson, MS 39202**

Addendum No. 3
September 9, 2022

This addendum forms a part of the contract documents and modifies the original plans and specifications dated July 14, 2022.

Previous Addenda:

Item 3.1: Addendum No. 2: Sheet A-102 Reflected Ceiling Plan - Suite 600

Replace: with the enclosed revised Sheet A-102.

Specifications:

Item 3.2: Bid Form

Replace: with the enclosed revised Bid Form.

Drawings:

Item 3.3: Sheet A-601, Finish Schedule

Change: "VCT" to "Resilient Plank".

Item 3.4: Sheet E-1, Partial Floor Plan – Suite 600 - Power

Note: See attached sheet E-1P for revised/additional receptacle locations.

Item 3.5: Sheet E-1, Partial Floor Plan – Suite 600 - Communications

Note: See attached sheet E-1C for revised/additional data outlet locations.

End of Addendum No. 3

Bid Form
Pediatric Clinic 2022 - Neshoba General

CERTIFICATE OF RESPONSIBILITY NUMBER: _____

CONTRACTOR: _____

ADDRESS: _____

BID DATE: September 22, 2022

BID TIME: 2:00 P.M. Central Time

PROJECT: Pediatric Clinic 2022
Neshoba General

ADDENDUM ACKNOWLEDGEMENT:

We hereby acknowledge receipt of the following Addenda to the Contract Documents:

Addendum No. _____ Dated: _____

Addendum No. _____ Dated: _____

Addendum No. _____ Dated: _____

Addendum No. _____ Dated: _____

BASE BID _____ (\$ _____)

UNIT PRICES:

Unit price No. 1: Porcelain wall tile: PT-04.

_____ (\$ _____)
Per Sq. Ft. (minimum of 100 sq. ft.)

Unit Price No. 2: Porcelain floor tile: PT-06.

_____ (\$ _____)
Per Sq. Ft. (minimum of 100 sq. ft.)

The Project shall be constructed in one phase. The Project shall be completed within 180 calendar days from the Notice to Proceed. Prior to award of a specified bid package the Contractor shall provide schedule documentation acceptable to the Owner and Architect to develop the Master Project Schedule that best meets the Project Schedule Requirements as determined by the Owner. Contractors agree that the Master Project Schedule as approved by the Architect and the Owner will be the Master Project Schedule for the Project. Contractors shall cooperate fully with Owner forces or separate contractors so work on those contracts may be carried out smoothly, without interfering with or delaying the Work.

I (We) agree to hold our bid open for acceptance for Sixty (60) calendar days from the bid date.

Bid Form
Pediatric Clinic 2022 - Neshoba General


If awarded this Contract, I, (We) agree to execute the Contract, provide all required documents, commence and complete work as specified in Instructions to Bidders of the Contract Documents, subject to the terms and conditions of the Contract.

Bid Security as specified in Instructions to Bidders and Bid Security Form is required with the submission of the bid.

SIGNATURE: _____ (Company Officer)

SIGNATURE: _____ (Print)

TITLE: _____

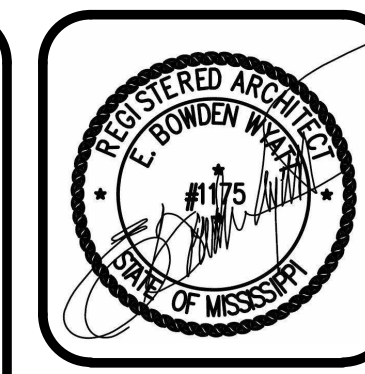

FOLWATT
Architects & Planners, P.A.
SUITE 400
1510 NORTH STATE STREET
TEL: (608) 352-3071
FAX: (608) 352-3078

MOB - PEDIATRIC CLINIC (2022)
NESHOBA COUNTY GENERAL HOSPITAL
PHILADELPHIA, MS


REFLECTED
CEILING PLAN -
SUITE 600

project no.
1431-13
date
JULY 14 2022
revised
09/01/2022



SMG
drawn by

sheet no.
A-102

of

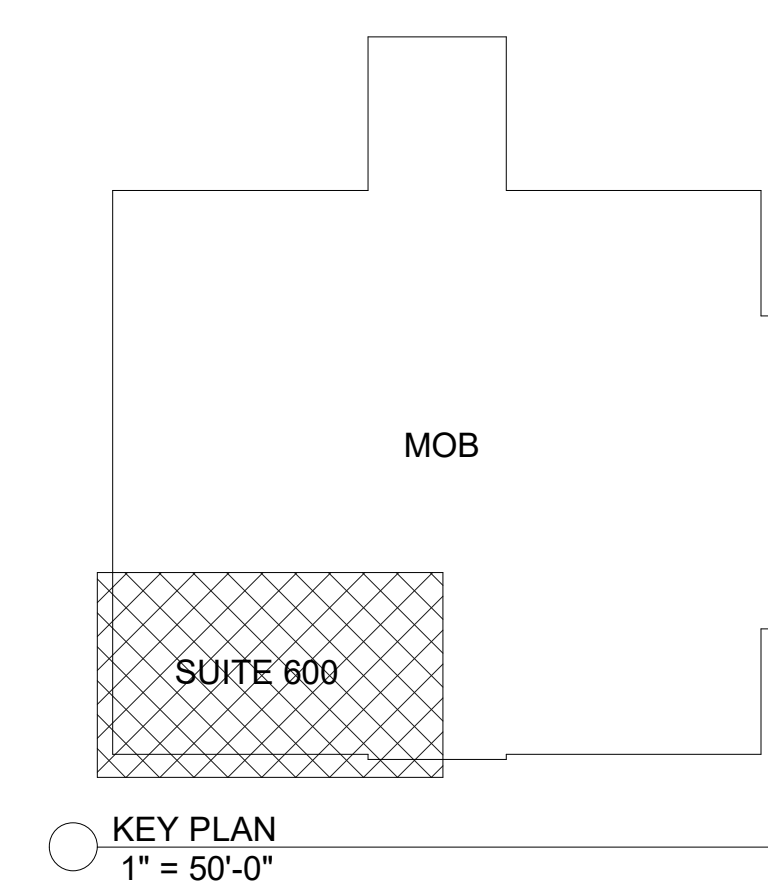

KEY PLAN
1" = 50'-0"

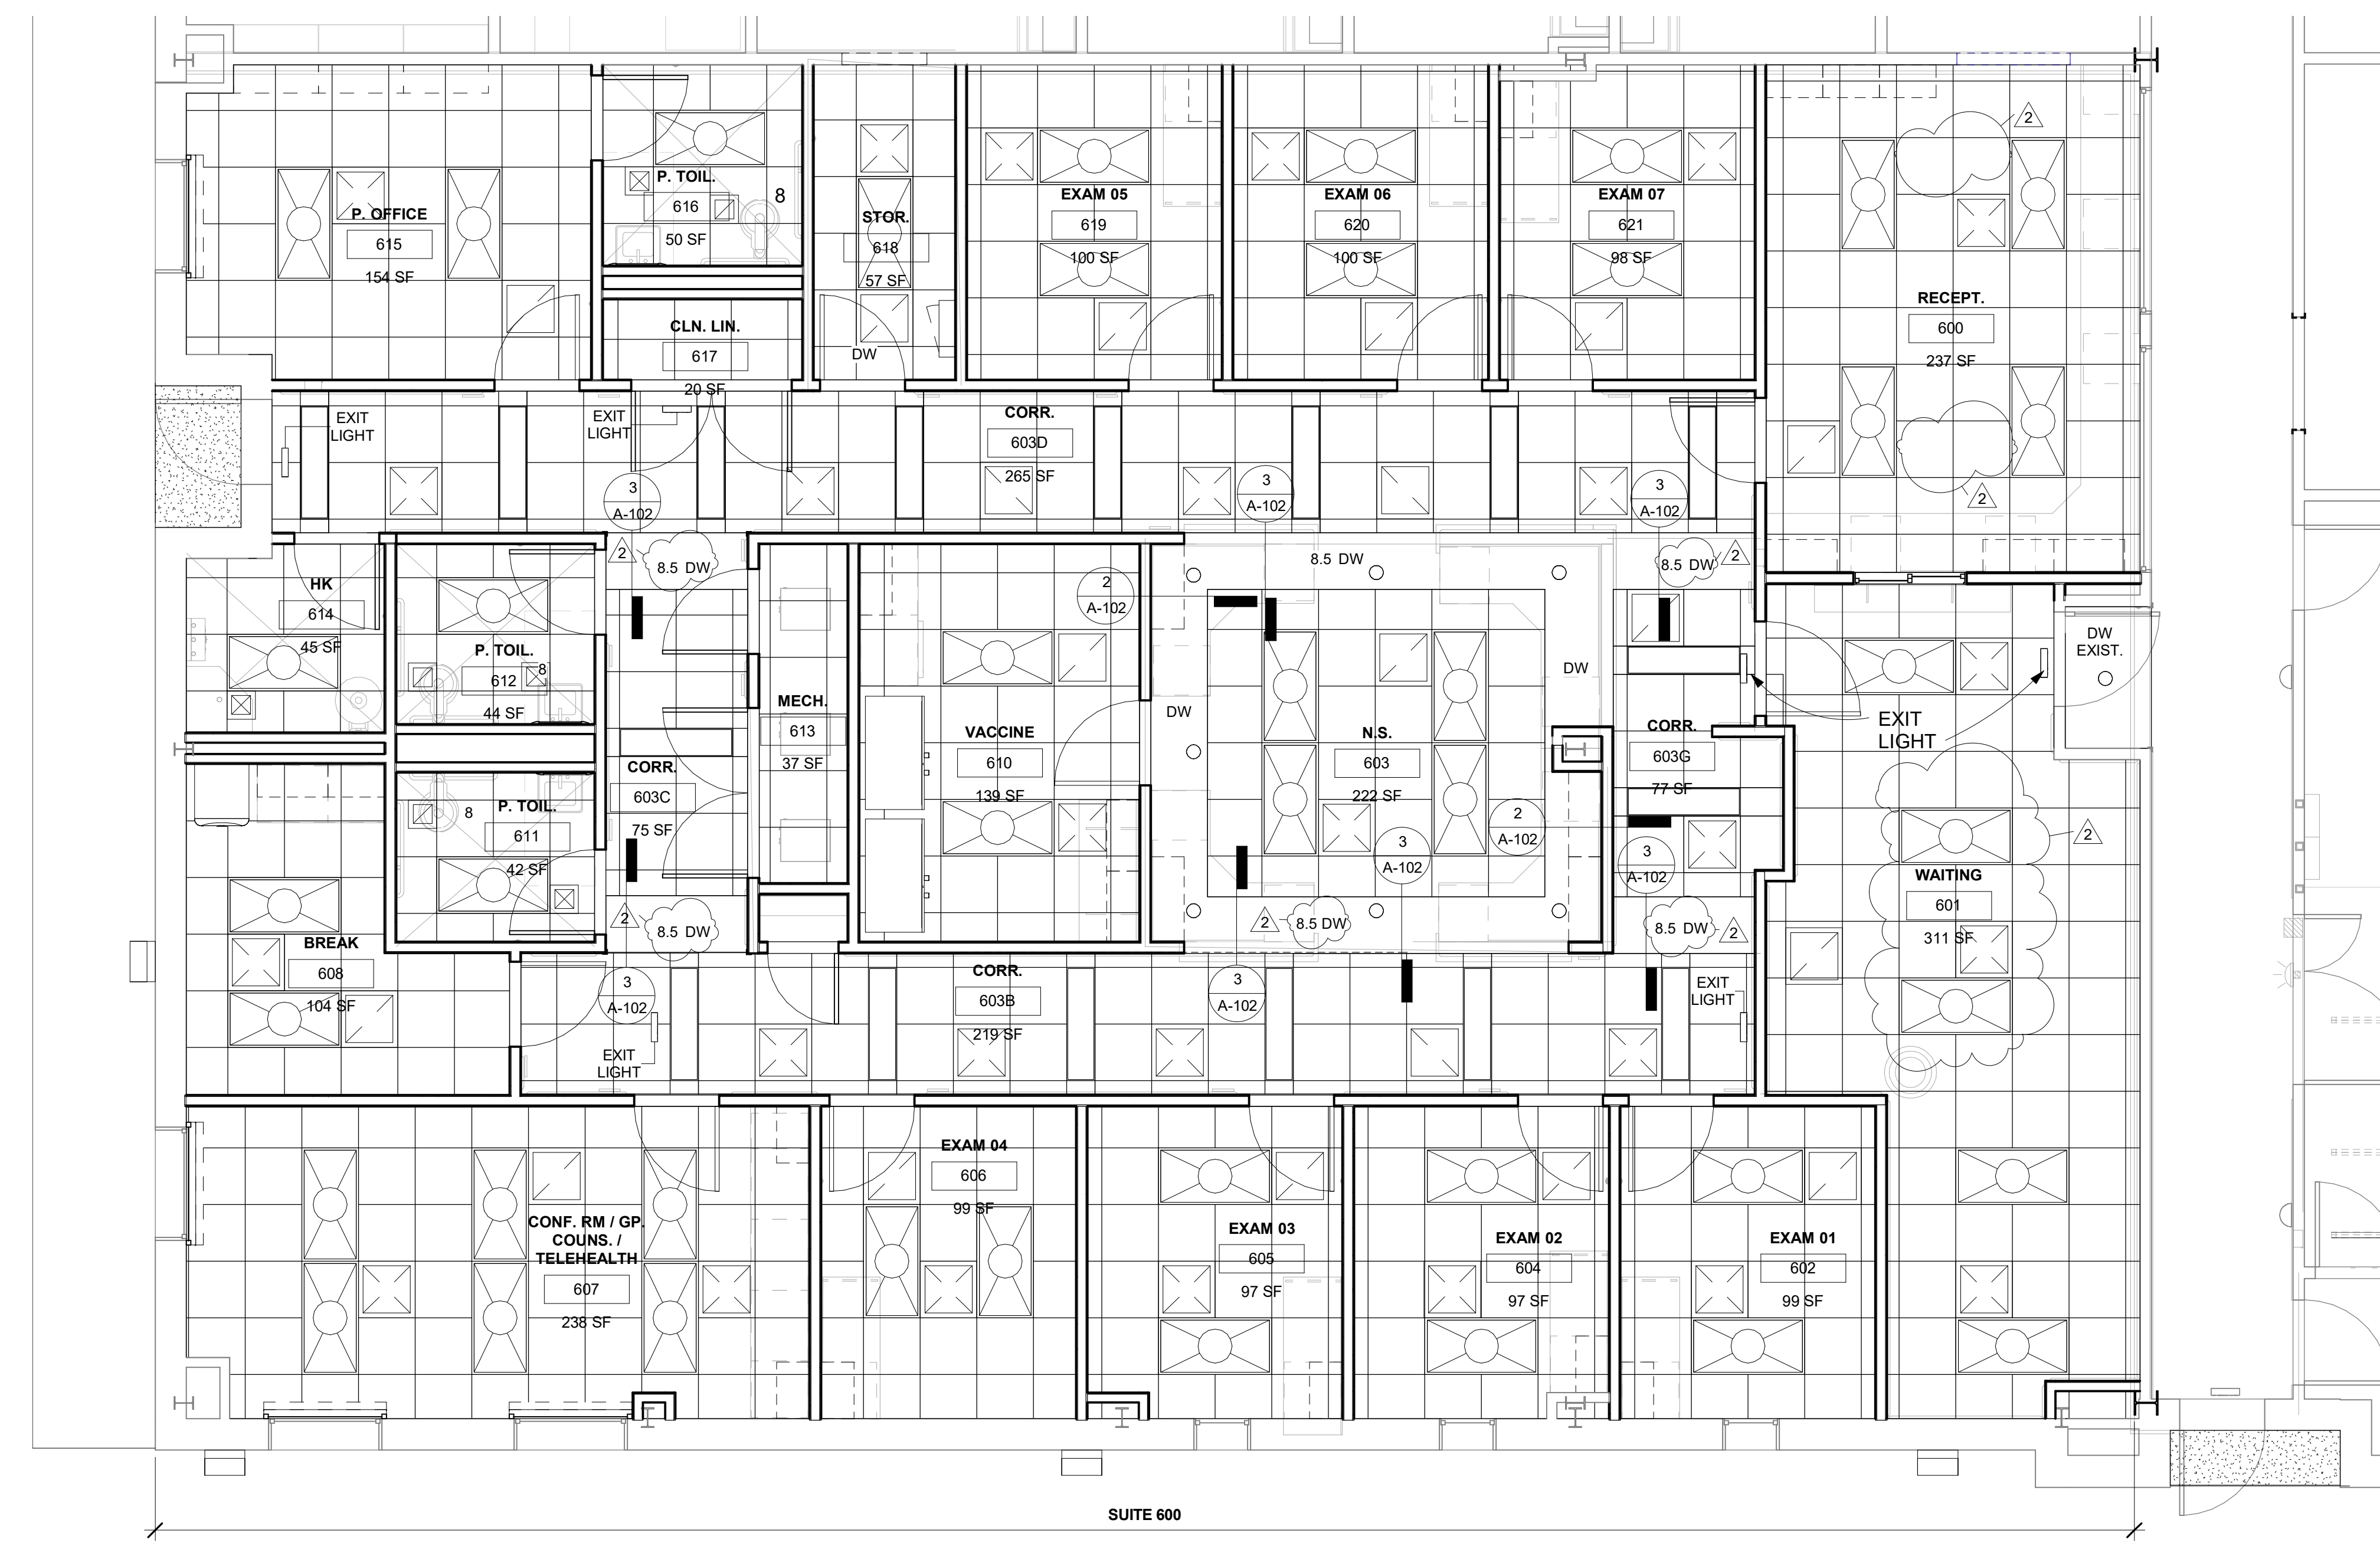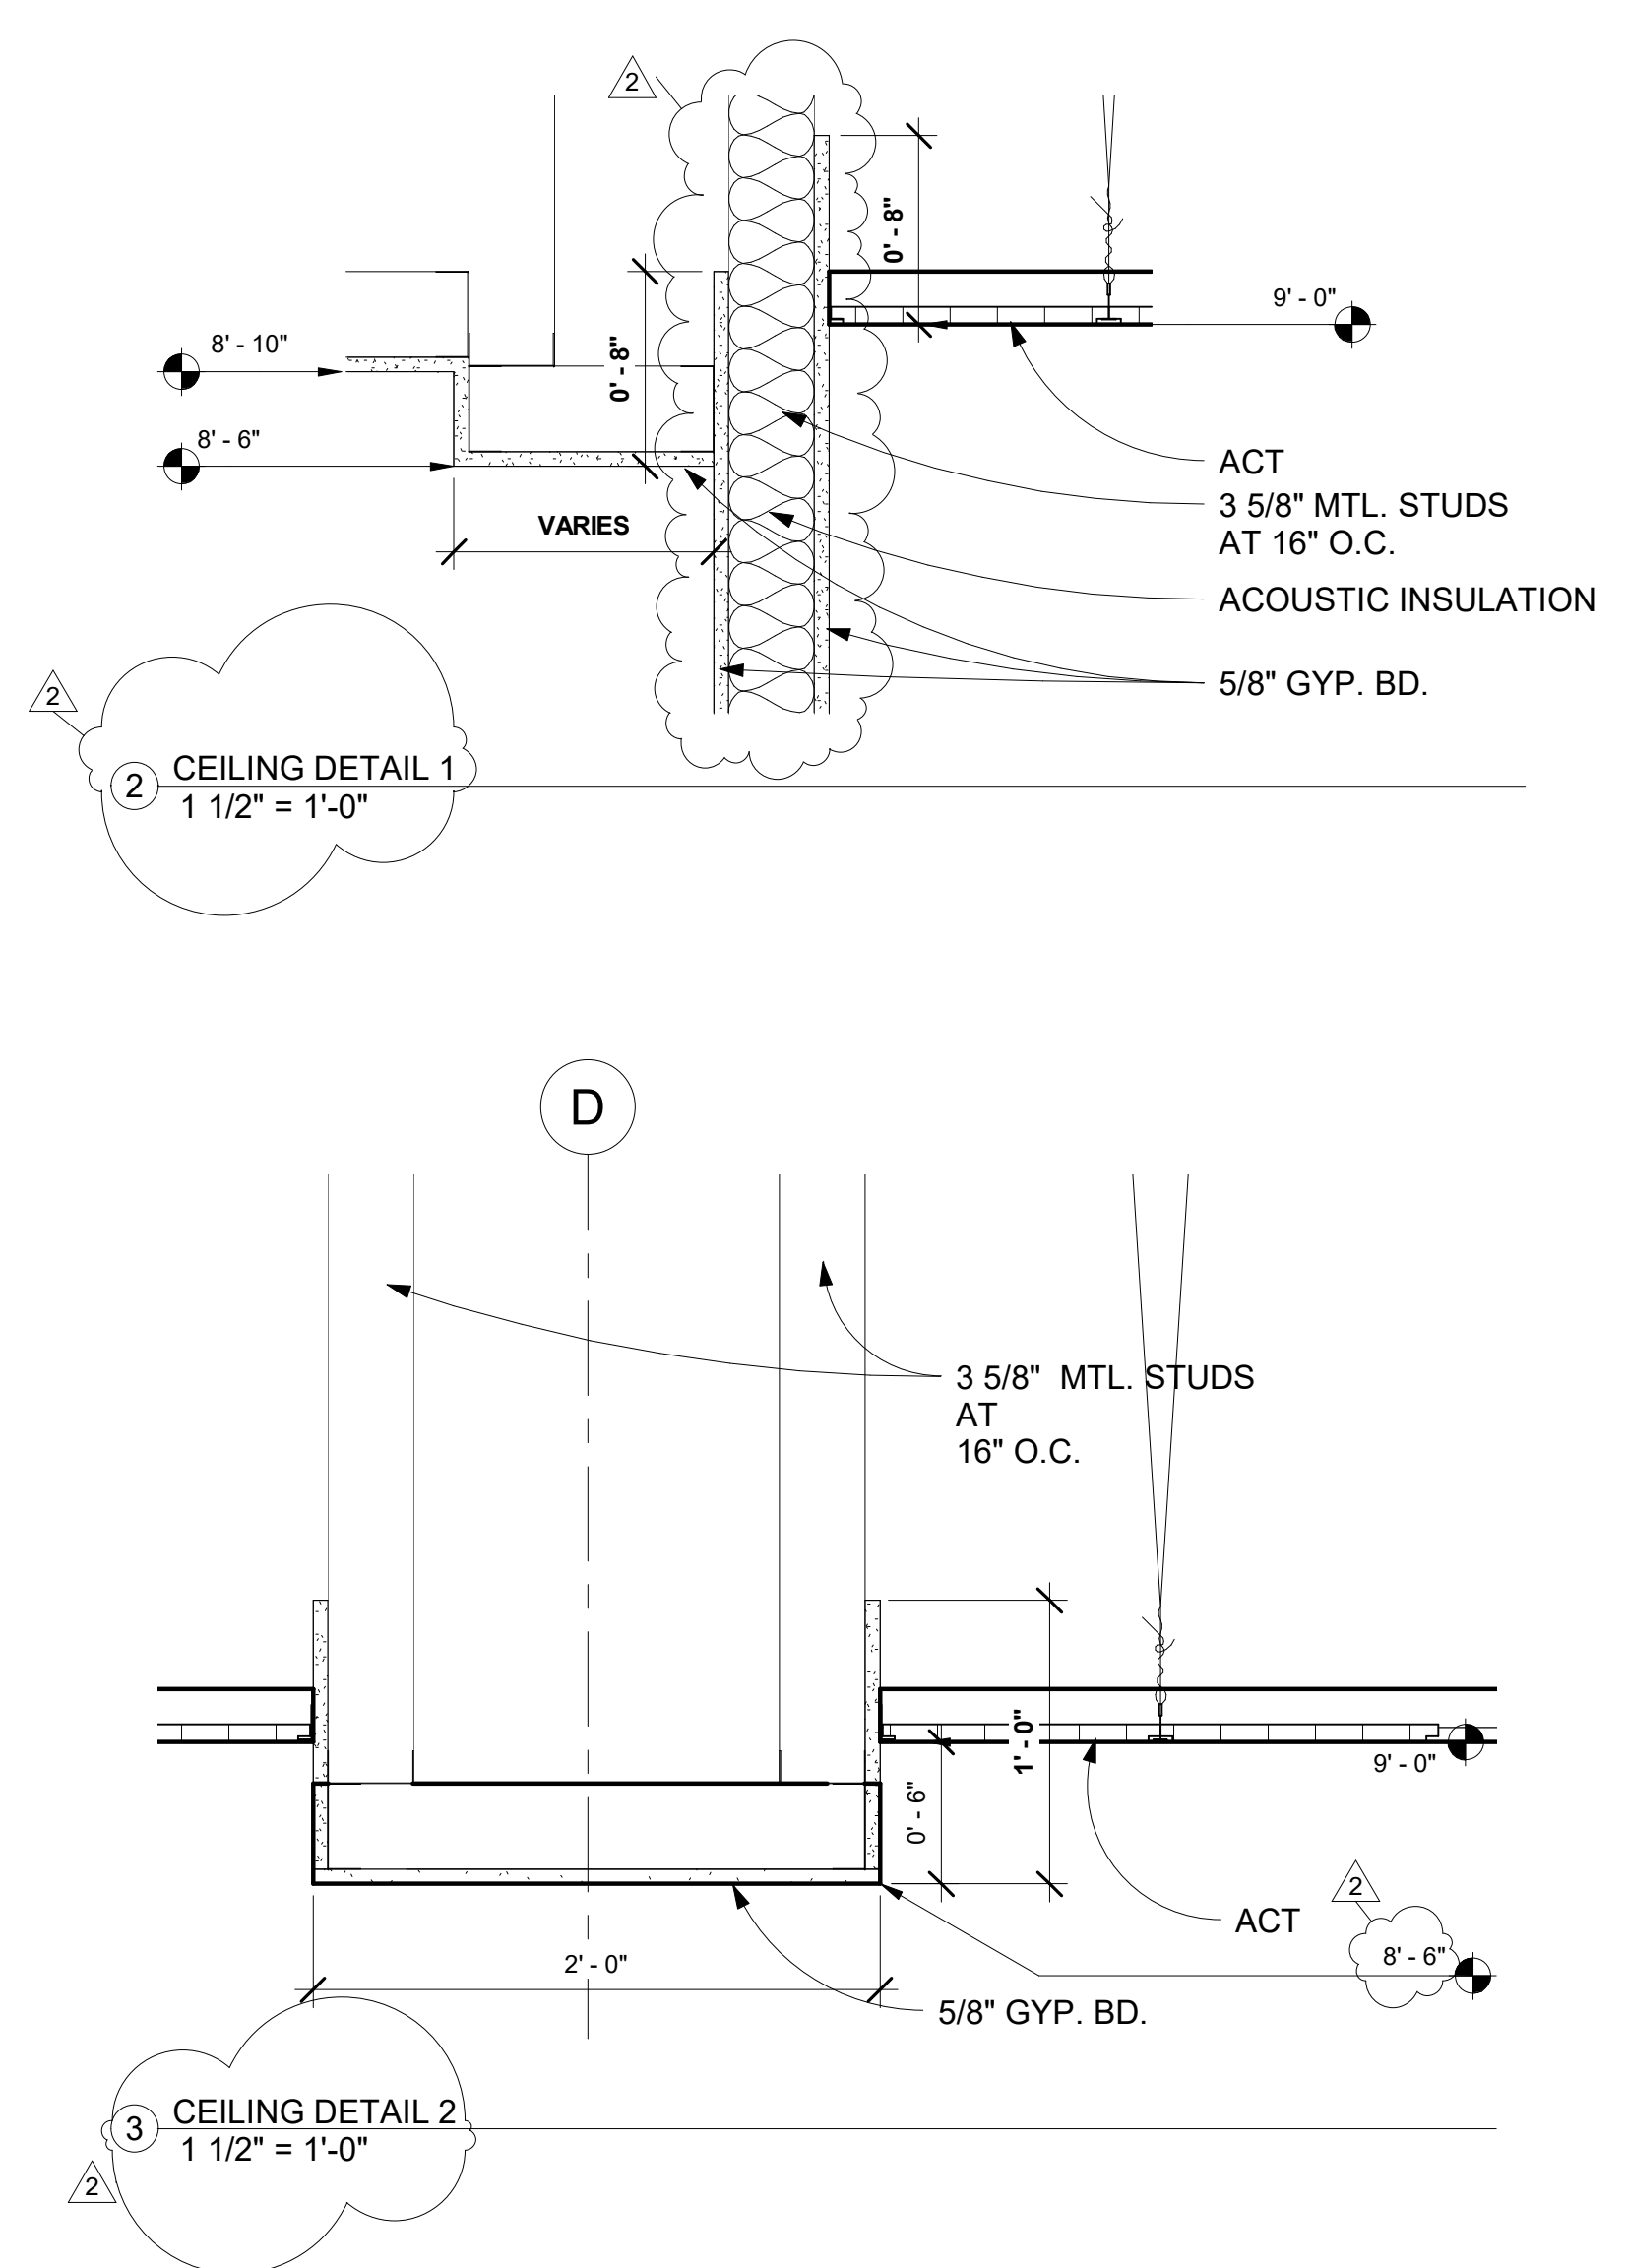

NOTE: CEILING HT IS 9'-0" AFF UNLESS OTHERWISE NOTED

REFLECTED CEILING PLAN
1/4" = 1'-0"




Folio Watt
Architects & Planners, P.A.
1010 SOUTH MAIN STREET
PHILADELPHIA, PA 19107
(215) 582-3071
FAX: (215) 582-3070

MOB - PEDIATRIC CLINIC (2022)
NESHOBA COUNTY GENERAL HOSPITAL
PHILADELPHIA, MS

project no.
1421-13
date
14 JULY 2022

drawn by
JCH

sheet no.
E-1P

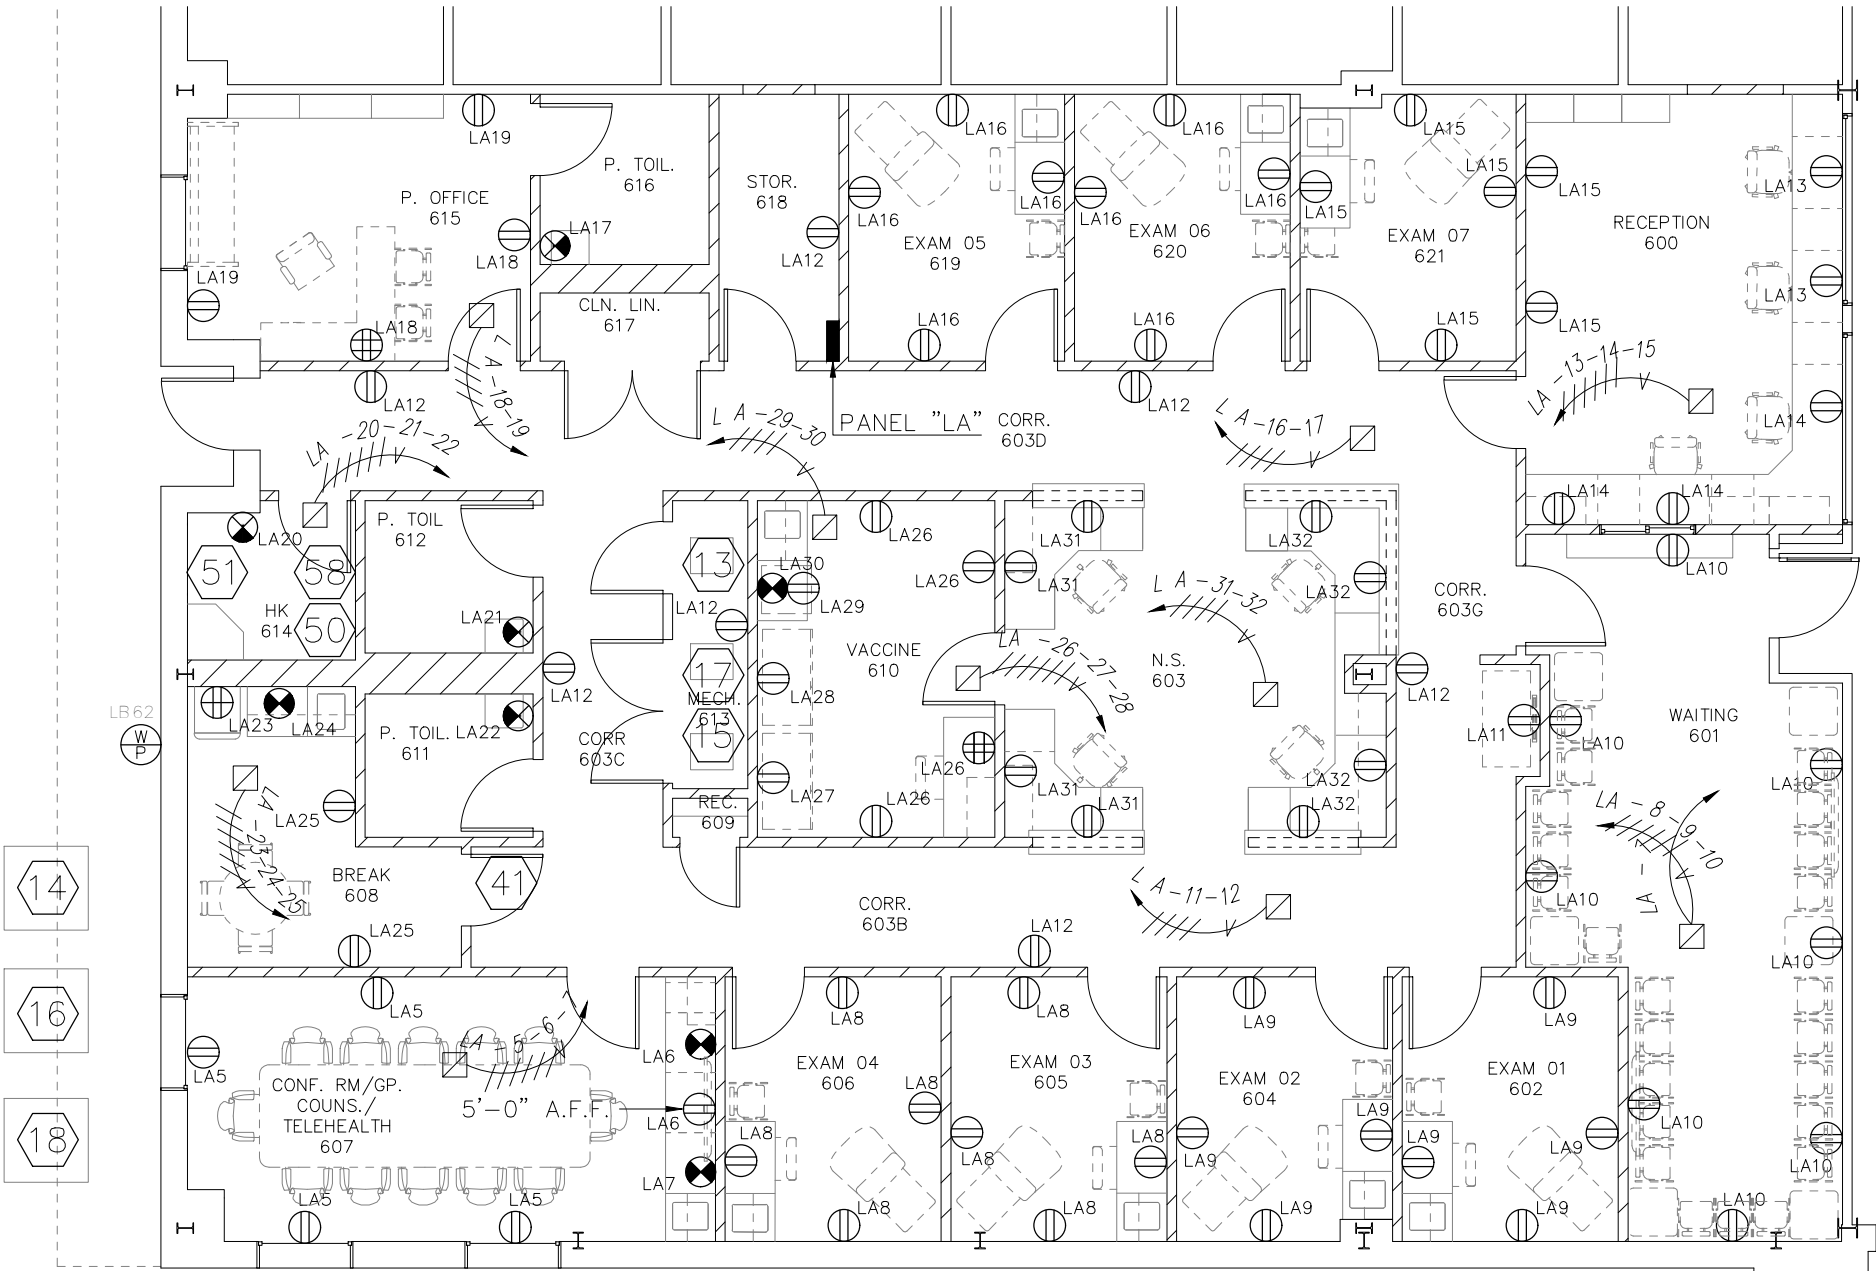

14

16

18



POWER
PARTIAL FLOOR PLAN - SUITE 600
SCALE: 1/8" = 1'-0"



