



Meridian Airport Authority, Dean Aircraft Services Hangar Additions & Alterations

ADDENDUM NO. 2

TO: All Bidders on the Above Referenced Product

FROM: Davis Purdy Architects, PLLC

DATE: March 29, 2021

SUBJECT: ADDENDUM NO. 2

ACKNOWLEDGEMENT OF RECEIPT OF ADDENDUM IS REQUIRED ON BID FORM.

Clarifications and revisions to Contract Documents for the referenced project are as follows:

- CLARIFICATION: Sealed bids will be received in the Meridian Regional Airport
 Terminal Building located at 2811 Highway 11 South, Meridian, MS 39307 until 2:00
 PM, Local Time, Friday April 2, 2021. This building is a different location than the
 building where the Pre-Bid was held.
- 2. **DELETE:** Delete ALL **Factory Mutual (FM) Global** requirements. There are no FM Global requirements for this project.
- **3. CLARIFICATION:** Awarded bidder shall provide Builder's Risk policy that includes "Business Interruption".
- **4. CLARIFICATION:** Davis Bacon and DBE requirements DO NOT APPLY to this project.
- **5. CLARIFICATION:** Provided 5/8" minimum thickness for plywood ceilings as indicated on the drawings.
- **6. ADD:** Add Geotechnical Investigation dated 10/21/20 prepared by Engineering Plus, Inc to the bid documents. Geotechnical Investigation is attached.





- 7. CLARIFICATION: If the fire protection engineer, required by the contract documents, confirms with their stamped calculates that the existing fire pump and storage tanks are sufficient for the new hanger, then no additional tank is needed nor does the fire pump need to be replaced. Ensure that the design meets as NFPA requirements for both hangers to run simultaneously.
- **8. CLARIFICATION:** Variable Frequency Drive (VFD-1) to be provide by Air Turnover Unit (ATO-1) manufacturer. VFD to be NEMA 1 enclosure with two contactor bypass, circuit breaker and disconnect, BACnet Comm Card and EMI-RFI Filter.

SPECIFICATIONS

- 9. CLARIFICATION: Specification section 00 21 13 Instructions to Bidders dated 3/3/21 indicates that a copy of AIA Document A701, "Instructions to Bidders" is bound in the Project Manual. A copy of AIA Document A701 2018 was not originally included. A sample copy of AIA Document A701 2018 is attached.
- 10. CHANGE: Specification section 00 41 13 Bid Form General Trades Bid Package dated 3/1/21 states TIME OF COMPLETION to be 365 days. Change TIME OF COMPLETION to be 450 days.
- 11. DELETE: Specification section 00 26 00 PROCUREMENT SUBSTITUTION PROCEDURES dated 2/28/21.
- **12. CLARIFICATION:** Specification section **00 43 22 Unit Prices** dated 3/3/21 only pertains to Aircraft Concrete Apron as shown on Civil sheet C-103 dated 3/3/21.
- 13. CLARIFICATION: Specification section 00 43 22 Unit Prices, 1.3 Unit Prices, A. Unit-Price No. 1: Removal of Obstructions refers to required material to be removed for HDPE Drainage Pipe Construction.
- **14. CLARIFICATION**: Liquidated Damages are referenced on the Bid Form and in Specification Section 01 29 00 Payment Procedures with no amount indicated.





Liquidated Damages shall be in the amount of **Five Hundred Dollars (\$500.00)** per **day** for every day beyond the allotted project as described in Specification Section 00 44 13 – Bid Form dated 3/1/21.

- **15. REPLACE:** Replace the Specification section **01 25 00 Substitution Procedures** dated 2/28/21 with specification section **01 25 00 Substitution Procedures Systems** dated 3/26/21. Specification section 01 25 00 is attached.
- 16. CLARIFICATION: Specification section 06 41 16 Plastic Laminate-Faced Architectural Cabinets indicates requirements for AWI/QCP certifications. Waive all AWI/QCP certification requirements.
- **17. ADD:** Add specification section **07 41 13.16 Standing Seam Metal Roof Panels**. Specification section **07 41 13.16** is attached.
- **18. CHANGE:** Specification section **08 11 13 Hollow Metal Doors and Frames** indicates construction to be full profile welded. Frame construction needs to change to knock down construction in lieu of welded profiles.
- 19. REPLACE: Replace the Specification section 13 34 10 Pre-Engineered Metal Building Systems dated 3/3/21 with specification section 13 34 10 Pre-Engineered Metal Building Systems dated 3/26/21. Specification section 13 34 10 is attached.

DRAWINGS

- **20. REPLACE:** Replace Mechanical sheet M502 dated 3/2/21 with the same sheet dated 3/26/21. Mechanical sheet M502 is attached.
- **21. REPLACE:** Replace the following Electrical sheets dated 3/2/21 with the same sheets dated 3/18/21. Minor changes are indicated with clouds on sheets. Electrical sheets are attached:

a. E-000



D+P Architects, PLLC P.O. Box 703 Meridian, MS 39302 www.davispurdyarchitects.com

- b. E-001
- c. E-002
- d. E-003
- e. E-005
- f. E-006
- g. E-100
- h. E-200
- i. E-201
- j. E-300
- k. E-301
- I. E-302
- m. E-401
- n. ED-100

Submitted By

John L. Purdy, AIA

Davis Purdy Architects, PLLC

March 29, 2021

ACKNOWLEDGEMENT OF RECEIPT OF THIS ADDENDUM IS REQUIRED AND SHALL BE INDICATED ON BID FORM

Phone (601)-693-4234 FAX (601)-485-3884 engplus@engineeringplus.com

Engineering Plus

Planning • Surveying • Testing • Landscape Design

October 21, 2019

Mr. John L. Purdy, AIA, NCARB D+P Architects, PLLC 2011 23rd Avenue Meridian, MS 39305

RE: GEOTECHNICAL INVESTIGATION

Dean Maintenance Hangar Expansion - Key Field, Meridian, Mississippi

EP Project No. 17-278

Dear Mr. Purdy:

Engineering Plus appreciates the opportunity to serve as consultant for the above referenced project. The attached report presents field and laboratory methods utilized in assembling data for the assessment of subsurface soils and ground water encountered for the proposed aircraft hangar expansion at Key Field Dean Maintenance Hangar in Meridian, MS. All field and laboratory procedures have been accomplished in general accordance with applicable ASTM standard specifications.

We believe the information presented herein is sufficient for continued planning and development. We appreciate the opportunity to work with you and look forward to assisting you in a successful project. Please contact us should you have questions regarding the information provided or if we may be of additional service.

Sincerely yours,

ENGINEERING PLUS, INC.

Richmond L. Alexander, P.E.

Project Engineer

GEOTECHNICAL INVESTIGATION

DEAN MAINTENANCE HANGAR EXPANSION Key Field - Meridian, MS

FOR

D+P Architects, PLLC Meridian, Mississippi

October 2019

Prepared by:

ENGINEERING PLUS, INC.
MERIDIAN, MISSISSIPPI



TABLE OF CONTENTS

PURPOSE AND WORK PERFORMED	1
DESCRIPTION OF SITE CONDITIONS	1
FIELD INVESTIGATION	1
LABORATORY TESTING	2
SUBSURFACE CONDITIONS	2
EARTHWORK AND SITE GRADING	
FOUNDATION RECOMMENDATIONS	

APPENDICES

٨	CITE	VICT	TETT	MAN
A	SHE	VICI	NII Y	WAP

- B BORING LOCATION PLAN
- C USCS CHART & BORING LOGS
- D SOIL TEST RESULTS
- E GENERAL REMARKS/REPORT LIMITATIONS

PURPOSE AND WORK PERFORMED

The purpose of this geotechnical investigation is to determine the general characteristics of surface and subsurface soils within the area of proposed expansion. Using the information gathered during the investigation, recommendations for earthwork and foundation construction will be made. The work performed during this investigation consisted of the following:

- Six (6) soil borings in the footprint of the proposed expansion construction to depths of 30 feet;
- Natural moisture content tests on selected samples;
- Atterberg Limit determinations on selected samples;
- Grain size analyses on selected samples;
- Field observations related to site topography, and geology for the subject property and adjacent properties;
- Preparation of this report presenting our conclusions and recommendations relative to geotechnical aspects of the proposed construction.

Included in our report are discussions of site preparation considerations, including available material types and their suitability for use as foundation materials or engineered fill and design criteria for building foundations.

DESCRIPTION OF SITE CONDITIONS

The project site investigated is situated in part of the E ½ of Section 27, Township 6 North, Range 15 East, Lauderdale County, Mississippi. Specifically, the site is located on the south side of the existing Dean Maintenance Hangar site within Key Field at Meridian Regional Airport. The airport is located along US Highway 11 South (Airport Blvd.) in Meridian, Mississippi. The project site is currently a recently graded building pad adjacent to the existing hangar facility.

Proposed site improvements include a new multi-story office building and aircraft hangar to supplement the existing hangar and serve as an expansion to the existing facility.

FIELD INVESTIGATION

Six (6) borings were drilled by an Engineering Plus drill crew utilizing a Mobile B-47 truck-mounted continuous flight auger in the footprint of the proposed expansion to depths of thirty (30) feet below ground surface. The approximate boring locations were staked by an Engineering Plus drill crew and plotted on the Boring Location Plan in Appendix B. Preliminary site plan information and proposed boring locations for the expansion was provided by D+P Architects, PLLC prior to drilling at the project location.

Representative samples were collected from auger cuttings or a 2-inch outside diameter split barrel sampler. Samples were collected continuously for the first 6 to 10 ½ feet and at 5-foot to 10-foot intervals to boring termination. Additionally, Standard Penetration Resistance values (See ASTM D-1586) were determined and recorded on the boring logs for the various soils encountered. The Standard Penetration Resistance, or "N" value, is the number of blows required to drive an 18-inch standard split barrel sampler the final 12 inches utilizing a 140-pound hammer

and a free fall height of 30 inches. A rope and cathead drop system was utilized during Standard Penetration Testing. As the samples were collected, they were field classified and immediately placed in airtight containers for future testing and classification.

Groundwater was encountered during our investigation. Additional comments regarding groundwater are located in the section titled Subsurface Conditions.

LABORATORY TESTING

Laboratory analysis of selected samples included visual classification, moisture content determination, Atterberg limits and grain size analysis. A professional engineer prepared the final boring logs from field logs, collected samples and laboratory test results.

To aid in the general interpretation of the soil conditions at the project site, in-situ moisture contents (See ASTM D-4643) were determined within the various soil strata. This determination was made possible by placing extracted samples in sealed containers immediately upon removal from the sub-surface. Results of moisture content testing are depicted on the attached boring logs (See Appendix C).

Atterberg limit tests were conducted to determine the susceptibility of the cohesive soils encountered to shrink and swell with changes in moisture content. Liquid and plastic limit tests (See ASTM D-4318) were performed for selected representative samples taken from the various soil strata encountered. The liquid limit (LL) is the moisture content above which a soil behaves as a viscous fluid, whereas the plastic limit (PL) is the moisture content below which the soil behaves as a solid. The plasticity index (PI) is the numerical difference between the liquid and plastic limit and is indicative of the relative activity of a cohesive soil.

Soils exhibiting a low plasticity index are relatively inactive and are ordinarily suitable as a foundation material. Conversely, soils having a high plasticity index are susceptible to varying degrees of volume change (i.e. shrinkage and swelling) with fluctuations in moisture content.

Atterberg limit testing for representative samples taken from the project area indicate the near surface soils have plasticity indices ranging from 4 to 20. Based on this information, the near-surface soils encountered are considered to have a low to moderate potential for moisture induced volume change. Results of Atterberg limit testing are depicted on the attached boring logs (See Appendix C).

Grain size analyses were conducted on representative samples of the various soils encountered to determine the particle size distribution of materials comprising the strata. Results of these tests can be utilized in classifying the soils in accordance with the Unified Soil Classification System (See ASTM D-2487).

For your convenience, a listing of the symbols recognized by the Unified Soil Classification System and their meaning is provided with the boring logs (See Appendix C).

SUBSURFACE CONDITIONS

Details of subsurface conditions encountered by the soil borings are shown on the boring logs located in Appendix C. The boring logs represent our interpretation of the subsurface conditions based upon examination of the collected samples and laboratory testing of selected samples. Stratification lines on the boring logs represent approximate boundaries between soil types; however, the actual transition between soil types may be gradual. The general soil conditions and

their pertinent characteristics are discussed below.

Boring No. 1 discovered 2.5 feet of dense clayey sand followed by 3.5 feet of stiff to very stiff silty clay. Silty sand was then discovered to boring termination due to auger refusal at 7.5 feet below ground surface. The drilling crew encountered a hard surface at approximately 7.5 feet and could not advance the auger to deeper depths. Groundwater was not encountered during drilling activities.

Boring No. 2 encountered 4.5 feet of clayey sand underlain 3.5 feet of silty clay. Fat clay was then encountered for 4 feet followed by elastic silt and saturated silty sand to boring termination at 30 feet below ground surface. Groundwater was encountered during drilling activities at 18 feet below ground surface.

Boring No. 3 encountered 1.5 feet of medium dense clayey sand underlain by 1.5 feet of stiff silty clay. Medium dense silty sand was then encountered for 3 feet above 3 feet of loose silty sand. A layer of fat clay was then discovered for 7 feet above saturated silty sand to boring termination at 30 feet below ground surface. Groundwater was encountered during drilling activities at 18.5 feet below ground surface.

Boring No. 4 discovered 3 feet of clayey sand above 2 feet of slightly silty, sandy clay. Silty clay and clayey silt were then encountered for 3 feet above 10 feet of wet clayey and elastic silt. Saturated silty sand was then discovered to boring termination at 30 feet below ground surface. Groundwater was encountered during drilling activities at 18 feet below ground surface.

Boring No. 5 encountered 4.5 feet of clayey sand underlain by 3 feet of silty clay. Elastic silt was then encountered for 10.5 feet above saturated silty sand to boring termination at 30 feet below ground surface. Groundwater was encountered during drilling activities at 18 feet below ground surface.

Boring No. 6 discovered 4 feet of clayey sand followed by 3 feet of soft, moist slightly clayey silty sand. Wet elastic silt was then discovered for 6 feet underlain by 5 feet of fat clay. Saturated silty sand was then discovered to boring termination at 30 feet below ground surface. Groundwater was encountered during drilling activities at 18 feet below ground surface.

The borings are representative of subsurface conditions at each particular boring location and for their vertical reach only. Should materials not described in this report be encountered during construction, we respectfully request the opportunity to evaluate those materials and, if warranted, make changes and/or additions to our recommendations.

Groundwater was encountered during our drilling activities at approximately 18 feet below ground surface. It should be noted that groundwater levels may fluctuate seasonally and can be affected by changes in site development. Based on past experience at Key Field, groundwater may greatly influence foundation or sitework construction depending on the time of year in which construction occurs.

EARTHWORK AND SITE GRADING

We understand site improvements include new multi-story building and hangar construction to expand the existing Dean Maintenance Hangar Facility. The site has previously been graded for building construction. Based on existing topography and site conditions earthwork will consist of excavations for foundation construction.

Our borings indicate mostly clayey and silty sands as well as silty clays within the near-surface strata. Theses soils encountered are largely considered acceptable for foundation construction. At depths down to approximately 4-5 feet within the boring locations, these soils exhibited a medium dense to dense consistency in the clayey sands and a stiff consistency in the silty clays. As such, earthwork activities should involve excavations for foundation construction, preparation, compaction as necessary, and foundation construction in accordance with the following criteria:

Prior to foundation construction, any debris, organics and humus matter encountered during excavations should be removed from structural areas. With this particular site being a newly constructed pad for this project, it is not anticipated that any debris will be encountered. It is recommended that the existing pad compaction be verified with project specifications prior to any excavations for foundation construction. Compaction verification will also provide opportunity to confirm stability or locate any unstable areas. "Proof-rolling" may be utilized to confirm stability of the in-place soils. Proof-rolling is conducted by traversing the site with a loaded tandem-axle dump truck to identify ruts or signs of in-stability. Remediation of soft or unstable areas may consist of re-mixing, moisture conditioning, over-excavation, and/or geotextile reinforcement, and should be determined on a case-by-case basis by the engineer.

As noted above, soils encountered in **Boring No. 6** at anticipated foundation bearing elevations had a soft and moist consistency. This area should be inspected upon excavation to verify soil stability. It should be noted that during construction, remediation may be required to stabilize the foundation soils

In areas which will support structures, the soil subgrade and any necessary fill placement should be compacted to a minimum of 98% of maximum dry density per Modified Proctor (ASTM-D 1557). Compaction should be achieved in maximum loose lifts of 12 inches at a moisture content comparable (\pm 2.0%) to the optimum moisture content established in the laboratory and compaction verified with each lift. It is recommended minimum of one density test be performed every 2,000 square feet per lift.

Materials suitable for borrow material used as fill placement should consist of a debris-free material, non-organic and classified as a lean clay, sandy clay, silty or clayey sand (CL, SM or SC) with a plasticity index (PI) within the range of 4 to 20 and a liquid limit less than 40.

It appears the existing soils on-site have maintained stability since construction however, they may be prone to instability during inclement weather and when subjected to repetitive construction traffic. As such, we recommend any earthwork be performed during the dry summer or fall season, if the schedule permits. Final grading, as well as any grading during construction, should be such that surface water and storm water is expediently removed from the proximity of any structures. Further, construction traffic across the site should be limited to prevent subgrade materials, which initially may demonstrate adequate stability, from becoming unstable.

Should significant revisions be made prior to the final design, we respectfully request the opportunity to re-evaluate these recommendations with the final design documents.

FOUNDATION RECOMMENDATIONS

Based upon our analysis and adherence to recommendations outlined above, the proposed structure can be supported by a shallow foundation system consisting of a monolithically cast reinforced slab-on-grade with perimeter grade beams or turned-down footings, stiffened grade beams below any load bearing walls and column footings. Any columns should be supported by widened portions of the grade beams.

The maximum allowable soil pressure beneath foundation members should not exceed 2,000 psf (pounds per square foot of contact area). Bearing capacities have been determined utilizing a factor of safety of 3.0. We recommend that perimeter grade beams or turned-down footings around the perimeter of the building bear a minimum of 2.5 feet below the finish grade elevation and have a minimum width of 24 inches. It is recommended that any interior grade beams bear a minimum of 2 feet below the bottom of the slab. Final footing size and required reinforcing steel and details should be determined by the structural consultant.


Based on the soils encountered during drilling activities, the anticipated loads imposed by the structure and foundation installation, we estimate the range for maximum total and differential settlement to be ¾ inch to 1 ¼ inch. Previous construction and fill placement on the site has exposed a certain level of preloading on in-situ soils which should assist in minimizing post-construction settlements.

Floor slabs can be designed utilizing a modulus of subgrade reaction of 100 pci (pounds per square inch of contact area per inch of deflection). If a granular leveling material is not used as a capillary break beneath the floor slab, a 6-mil vapor barrier should be used. Typically, frost heave is not a problem in this area due to the climate and the anticipated bearing elevations provide more than adequate depth.

We recommend that foundation excavations be left open for the shortest amount of time possible to minimize the chance of bearing soils being exposed to moisture.

The bearing capacities recommended are applicable for structural fill provided the fill material meets the requirements described under **EARTHWORK AND SITE GRADING**.

APPENDIX A SITE VICINITY MAP

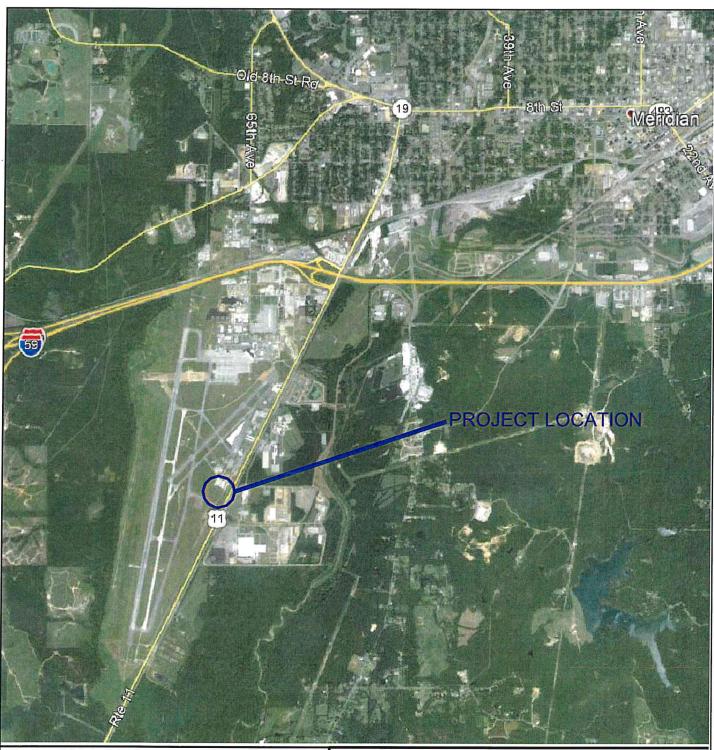



NORTH

Not to Scale

SITE VICINITY MAP DEAN HANGAR EXPANSION KEY FIELD - MERIDIAN, MS

Engineering Plus


Planning • Surveying • Testing • Landscape Design 1724–B 23rd Ave. Meridian, Mississippi 39301 (601) 693–4234 DWG FILE: M:\wpwin60\2017\Geotech\17-278
Dean Maintenance Hangar

JOB NO. 17-278 DRAWING NO.

DATE: 10-15-19 DRAWN BY: RLA CHECKED BY: KT SHEET:

1 OF 1

APPENDIX B BORING LOCATION PLAN

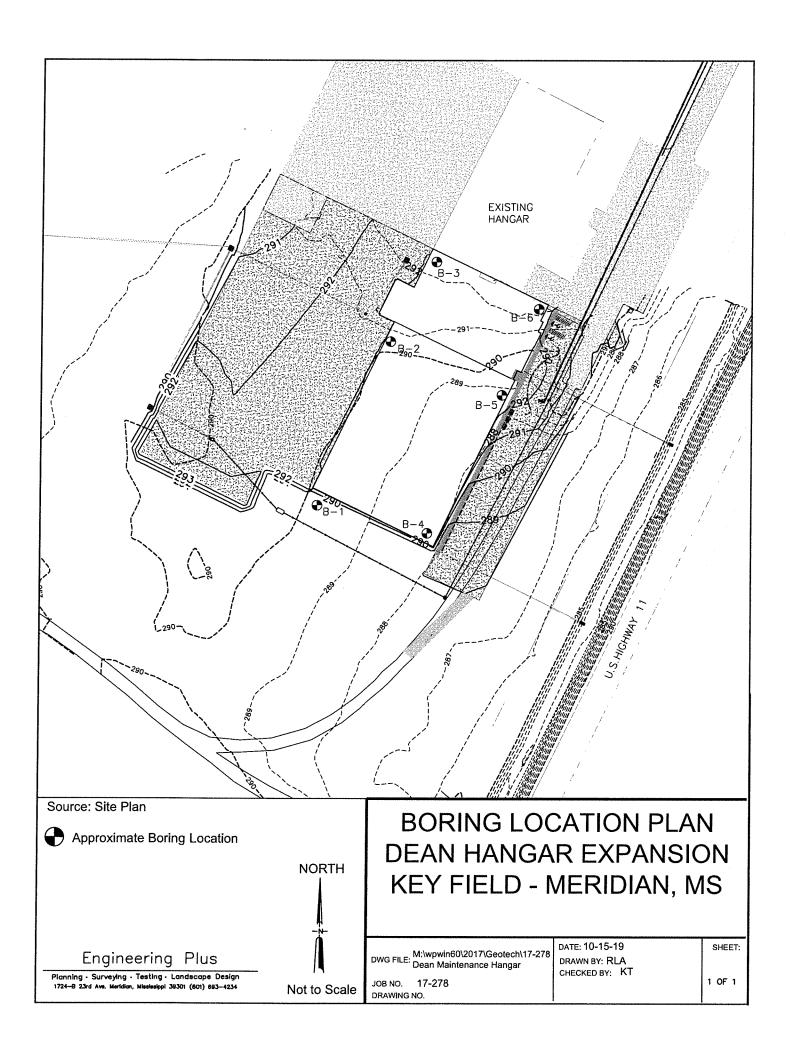

APPENDIX C USCS CHART & BORING LOGS

	Major Divis	ions	Groe Symb		Typical Names		Laborate	ory Classification C.	riteria
	is larger	ravels no fines)	GW	1	Well-graded gravels, gravel sand mixtures, little or no fines	arse-		C _u =D ₆₀	₀ /D ₁₀ >4;) between 1 and 3
size)	els se fraction ieve size)	Clean gravels (Little or no fines)	GP		Poorly graded gravels, gravel- sand mixtures, little or no fines	e curve.	W, SP IM, SC ing dual syr		dation requirements GW
Coarse-grained soils (More than half of material is larger than No. 200 sieve size)	Gravels (More than half of coarse fraction is larger than No. 4 sieve size)	Gravels with fines (Appreciable amount of fines)	GM*	d u	Silty gravels, gravel-sand-silt mixtures	Determine percentages of gravel and sand from grain-size curve. Depending of percentage of fines (fraction smaller than No. 200 sieve size), coarse- Grained soils are classified as follows:	GW, GP, SW, SP GM, GC, SM, SC Borderline cases requiring dual symbols**	Atterberg limits below "A" line with P.I. less than	Above "A" line with P.I. between 4 and 7 are
ained soils larger than N	(More tha	Gravels v (Appreciab of fil	GC		Clayey gravels, gravel-sand- clay mixtures	rcentages of gravel and sand from gra ge of fines (fraction smaller than No. 2 Grained soils are classified as follows:	Borderline	Atterberg limits above "A" line with P.I. greater than 7	borderline cases requiring use of dual symbols
Coarse-gr material is	tion is	Clean sands tle or no fines)	sw		Well-graded sands, gravelly sands, little or no fiines	es of grave les (fraction soils are c			/D ₁₀ >6, between 1 and 3
han half of	ds coarse frac 5. 4 sieve si	Clean sands (Little or no fines)	SP		Poorly graded sands, gravelly sands, little or no fines	percentage ntage of fir Grained	than 5 percent than 12 percent to 12 percent		dation requirements SW
(More t	Sands (More than half of coarse fraction is smaller than No. 4 sieve size	th fines ciable of fines)	SM*	d u	Silty sands, sand-silt mixtures	Determine ing of perce	Less than 5 percent More than 12 percent 5 to 12 percent	Atterberg limits below "A" line with P.I. less than 4	Limits plotting in hatched zone with P.I. between
	(More 1	Sands with fines (Appreciable amount of fines)	SC		Clayey sands, sand-clay mixtures	Debend		Attergerg limits Above "A" line with P.I. greater than 7	4 and 7 are borderline requiring use of dual symbols
	Ų	an 50)	ML		Inorganic silts and very fine sands, rock flour, silty or clayey fine sands or clayey silts with slight plasticity			Mark and Marketiness Warr	
200 sieve size)	Silts and Clave	id limit less than 50)	CL		Inorganic clays of low to medium plasticity, gravelly clays, sandy clays, silty clays lean clays	70 -		Plasticity Chart	
		(Líquio	OL		Organic silts and organic silty clays of low plasticity	60 - 8 50 -			CH "A" Line
Fine-grained soils terial is smaller th	y y	, than 50)	МН		Inorganic silts, micaceous or diatomaceous fine sandy or silty, elastic silts	Plasticity Index		"U" Line	МН
Fine-grained soils (More than half of material is smaller than No.	Silts and clavs	(Liquid limit greater than 50)	СН		Inorganic clays of high plasticity, fat clays	10 - 0 -	CL-ML	30 40 50 60	70 80 90 100
lore than ha		(Liquid	ОН		Organic clays of medium to high plasticity, organic silts	·		Liquid Limit	
ک)	Highly	organic soils	Pt		Peat and other highly organic soils				

^{*}Division of GM and SM groups into subdivisions of d and u are for roads and airfields only. Subdivision is based on Atterberg limits; suffix d used when L.L. is 28 or less and the P.I. is 6 or less; the suffix u used when L.L. is greater than 28.

**Borderline classifications, used for possessing characteristics of two groups, are designated by combinations of group symbols. For example: GW-GC, well-graded gravel-sand mixture with clay binder.

Planning - Surveying - Testing - Landscape Design 1724 B 23rd Avenue Meridian, Mississippi 39301 (601) 693-4234

PRO	JECT:						Hangar Expansion	L BOMING LOO				F	PROJ	ECT NO	o: 17-2	78	
CLIE		D+	PΑ	rchi	tects,									ING N			
LOGO				xanc	der										E: 10/3		
DRIL	LER:	В.	Low	ery		1				S	1	ACE			v: ±292		
Water Level	Donth	ple		N - Value	DCP (blows/.75")	Classification	Rig: Mobile Drilling Method: 2 1/4 9 Backfill Method: Cutting	SSA w/ SPT gs	Moisture Content-(%)	Liquid Limit	Plasticity Index	% (Ham		stic Lim	and Cathead it / Moisture t / N - Value	
Wat	Depth (ft)	Sample	SPT	ż	ē	Sa	Boring Depth: Visual Classifica	30 Feet tion - Remarks	≥ 8	ij	Plas	- 200 %	O	ı	40	80	120
	- 0 -					SC SC	Light reddish brown cl Brownish red clayey s	na na nacantenseum aneminaji san azamena an elepte									
			0			CL	Light brown silty clay		19	38	20	67	менте в насам јанускупанизми ком сукализарод		•		
	- 5	X	2 6 12	18		CL SM	Grayish brown silty cla Grayish brown silty sa							•			
							Auger Refusal @ 7.5 f	f.									
	- 25																
	Auger	AEO:						: Boring terminated @ -30						AL 17-1-		- - - - - - - - - -	
	ASTM D 1 Standard F Fest (AST)	ene	tratio	n)	▽ ▼	Initi	STM D 1587) ial Water Level ayed Water Level	Groundwater was not en during drilling activities.	count	ered				N - Value Liquid Lir		■Moisture Plastic Inde	ЭХ
				-												***************************************	

Planning - Surveying - Testing - Landscape Design 1724 B 23rd Avenue Meridian, Mississippi 39301 (601) 693-4234

PRO.	JECT:	De	an I	Mair	ntenai	nce l	Hangar Expansion	L BURING LUG				F	PRO.I	ECT NO	17-27	78	
CLIE		D+	РΑ	rchi	tects,									ING NO			***************************************
LOG				cano	ler										10/3/		
DRIL	LER:	В.	Low	ery	Т	т			γ	S		ACE	·	VATION:			
Water Level	5	ple		N - Value	DCP (blows/.75")	Classification	Rig: Mobile Drilling Method: 2 1/4 S Backfill Method: Cutting	SSA w/ SPT gs	Moisture Content-(%)	Liquid Limit	Plasticity Index	%	Ham		tic Limi	and Cathead t / Moisture / N - Value	d
Wat	Depth (ft)	Sample	SPT	<u>-</u> 2	ē	Cla	Boring Depth: Visual Classificat	30 Feet tion - Remarks	≥ වි	:5	Plas	- 200 %	0		40	80	120
	0 -					sc	Reddish brown clayey	sand w/ gravel									
						sc	Brownish red clayey s	and									Printed descriptions and a specifical section of the section of th
						sc	Brownish red clayey s	and									es de servicio de la constanción de la
	— 5 —					CL	Brownish gray silty cla	y	15	25	7	54	era majera de de deserva de la compansión de la compansió	⊕ E -			Andrewsker and Erick States Services
	10					СН	Light brown fat clay										
						MH	Light brown elastic silt	TO STITLE WHILE WHILE MAKES WHILE A STATE OF THE POST AND ARRIVE MAKES MAKES AND THE STATE AND					daran makan merenda seman mengapungan upunjuk paman semakan da mbanda da				
-	15					мн	Light brown elastic silt	TO LIGHT MICH STATE, THE CONTRACT MICH. STATE ST					органия выпальный ференцијански при приментального предоставания по предоставания по предоставания по предоста				enember of the own transport page (see the control of the control
又	— 20 —					SM "	Light brown silty sand saturated						ene e distributura de reactiones en				
	Auger (ASTM D 1 Standard F	ene	tratio		□ □ □ □ □ □ □ □ □ □ □ □ □ □ □ □ □ □ □	(AS Initi	See Next Page Solby Tube Notes TM D 1587) Sold Water Level Sold Water Level	:: Boring terminated @ -30 Groundwater was encou during drilling activities (below ground surface	intered					N - Value	it	■Moisture •Plastic Ind	ex

Planning - Surveying - Testing - Landscape Design 1724 B 23rd Avenue Meridian, Mississippi 39301 (601) 693-4234

PRO	JECT:	De	an l	Mair	itenai	nce	Hangar Expansion	SOKING LOG				F	PROJ	ECT NO:	17-27	8	
CLIE	NT:	D+	PΑ	rchi	tects,	PLL	.C							RING NO:	B-2 (0	Cont'd)	
LOGG				canc	ler										10/3/2		
DRIL	LER:	В.	Low	ery I	ı	Т_	Rig: Mobile B-4	17	Ι	T	_	ACE		VATION:			
<u>ē</u>					DCP (blows/.75")	Classification	Drilling Method: 2 1/4 SSA		Moisture Content-(%)	Ē	Plasticity Index		Пап	nmer: Place		nd Cathead / Moisture	
Le		<u>e</u>		<u>E</u>	DCP ws/.7	ific	Backfill Method: Cuttings		istu	d Li	Ě	8				N - Value	
Water Level	Depth	Sample	SPT	N - Value	음	lass	Boring Depth: 30		ĕ ĕ	Liquid Limit	astic	- 200 %					
3	(ft)	Š	S	z	<u> </u>	0	Visual Classification	- Remarks			ă	-2	0		40	80	120
	<u> </u>					sм	Light brown silty sand										
							saturated										
							Cataratos										
													-				- Constant
																	* Annalis and the Control of the Con
		ı															and the second
	— 30 —	l					Boring Terminated @ -30	ff									ep. compression
							Doming Forminated & Oo	,									
			l										- Contraction				
		ı											***************************************				
			ı														
		- [ĺ							***************************************				
	_ 33 _											l					
l [- 1		l													
		ı		l								ı	Publicana de la compositorio del				
			Ì										9				
					l	l											
-	— 40 —												1				
				ı	ĺ								austinaman				- Constant
						ı							-				
-				ĺ							- 1		-				de la constanta
		- 1				- 1							BACKARAN MAIN				
-			ı	İ					l			ļ	***************************************				
	- 45									- 1		- 1	***************************************				and delicated the second
 												ĺ					
					ı												
-			l						ı			1					
F		ı											4				
L			ĺ						ı	İ	ĺ						
F									ļ				Libidicana				
	- 50 -			ļ		- 1				İ		1	Olivano apparatu				
	Auger	L	L			Sh.	elby Tube Notes: B	oring terminated @ -30) ft			\dashv			**********		
	(ASTM D	1452)			(AS	STM D 1587) G	roundwater was encou		d			'	■ N - Value		■Moisture	
	Standard I Test (AST	ene	tratio	n N	∇			uring drilling activities @	<u> 1</u> 9 -18	ft.				-Liquid Limi	t	●Plastic Inde	ex
بكا	1 COL (MO)	ט ואו	1360	')	<u> </u>	Del	ayed Water Level					L	<u> </u>				

Planning - Surveying - Testing - Landscape Design 1724 B 23rd Avenue Meridian, Mississippi 39301 (601) 693-4234

PRO.	JECT:	Dea	an I	/lain	tenar	nce l	Hangar Expansion				F	PROJ	ECT NO	: 17-2	78	,
CLIE					ects,	PLL	С						RING NO): B-3		
LOG				anc	ler									: 10/3/		
DRIL	LER:	B. I	_OW	ery						_	ACE	_	VATION			
Water Level	Domition	ple		N - Value	DCP (blows/.75")	Classification	Rig: Mobile B-47 Drilling Method: 2 1/4 SSA w/ SPT Backfill Method: Cuttings	Moisture Content-(%)	Liquid Limit	Plasticity Index	200 %	Han		stic Limi	and Cathead t / Moisture / N - Value	<u> </u>
Wat	Depth (ft)	Sample	SPT	\-\N	ig)	Cla	Boring Depth: 30 Feet Visual Classification - Remarks	ي ≥	Ë	Plas	- 200	o)	40	80	120
Wa Wa		Sar Sar	11 6 6 5 4 12 17 10 3 4 5	12 16 17 9		SC CL SM SM SM CH		16		15 15				40	80	120
	_ 25 —						See Next Page									
	Auger (ASTM D 1			n	∇	(AS	Notes: Boring terminated @ -30 TM D 1587) Groundwater was encou al Water Level during drilling activities @	ıntere					●N - Value		■Moisture	
\geq	Standard F Test (AST)	M D	1586	rı)	<u>×</u>		ayed Water Level	<i>w</i> 16.	J IL.				•Liquid Lir	nit	●Plastic Ind	ex

Planning - Surveying - Testing - Landscape Design 1724 B 23rd Avenue Meridian, Mississippi 39301 (601) 693-4234

PROJ	IECT:	De	an N	Main	tena	100	SOIL BURING LUG	•				_	nn	IEOT NO. 4	7 279	
CLIE					tects,		Hangar Expansion C					F		IECT NO: 1	7-278 3-3 (Cont'd)	
LOGO			Alex			1 L.L							יטם		0/3/2019	
DRILL			Low					**********		SI	JRF	ACF	FLE	VATION: ±		
				Γ,		Ĕ	Rig: Mobile B-47	T	्रा	_			~~~		ope and Cathe	ad
vel					75	ăţ	Drilling Method: 2 1/4 SSA w/ SPT	e e	§ .	[특]	<u>n</u>		l		Limit / Moistur	
Į,		əje		alue	DCP ws/.7	Sific	Backfill Method: Cuttings		ig.	ᇢ	city	%	<u> </u>	Liquid	Limit / N - Valu	е
Water Level	Depth	Sample	SPT	N - Value	DCP (blows/.75")	Classification	Boring Depth: 30 Feet	Moisture	悥:	Liquid Limit	Plasticity Index	200) 40	80	120
>	(ft)	S	S	Z		Ŭ	Visual Classification - Remarks		-		<u>-</u>	<u> </u>			, 00 ———————————————————————————————————	120
	— 25 —					SM	Dark gray silty sand									
							saturated									
								ı								
1 1										ı						
											Ì					Total State of the
1 1									ı							
	— 30 —							1		ı	ı					-
	_ 30 _						Boring Terminated @ -30 ft.									-
			ļ							- 1						
			l													17441894004
									Ì							
			- 1	ı							ı					COLUMN TO THE CO
		ĺ														ateronoliine
lt	— 35 —							İ		Ì						and the same
F	_ 33 _	- 1														
		ļ		ı				1		ı						
				ļ								ı				
				l												
										- 1						
				ı		İ						ı				
	- 40 -		ı		ļ					-						
									ļ	1						
- -			İ					l	1			ı				
		ĺ		1		l										
 			- 1										-			
		- 1			1			1					o stanione stanion a			
-		l	1	Ì				}		1			-			
	- 45 -		ļ										-			
F			ı	İ									and the same of th			
-			- [l				-1						2000
				İ												n-())-Productive-side
 													-			vi in and and and and and and and and and an
E				- 1									- Annual Control			dui pundivene
F													ALTERNATION AND AND AND AND AND AND AND AND AND AN			TOPPOSITE
F	- 50			l									A. Continuous and Con			racycopy
F	- 50	l			l								***************************************			ebby/tention
	Auger	L_				S Sh	elby Tube Notes: Boring terminated @	-30 ft				\dashv	L			
	ASTM D	1452)				STM D 1587) Groundwater was end							⊚ N i - Value	■Moisture	•
	Standard I	Pene	tratio	n	∇	Initi	al Water Level during drilling activitie			ft.				-Liquid Limit	∞Plastic I	ndex
	Test (AST	МD	1586)	¥	Del	ayed Water Level						<u></u>		-, 1031/01	

Planning - Surveying - Testing - Landscape Design 1724 B 23rd Avenue Meridian, Mississippi 39301 (601) 693-4234

	JECT:						Hangar Expansion				-	PRO.	JECT	NO: 1	7-278	
CLIE					ects,	PLL	С					во		NO: B		
LOG			Alex		ler										0/3/2019	
DRIL	LER:	В. І	_ow	ery	1	T		· · · · ·	S		ACE			ION: ±2		
<u>-</u>					5")	Classification	Rig: Mobile B-47	- ° §	Ħ	Plasticity Index		Har	mmer:		ope and Cath	
Fe				ne	DCP ws/.7	fica	Drilling Method: 2 1/4 SSA w/ SPT Backfill Method: Cuttings	- in it	<u>ב</u>	<u>-</u>					Limit / Moistu	
Water Level	Depth	du du	_	N - Value	DCP (blows/.75")	assi	Boring Depth: 30 Feet	Moisture Content-(%)	Liquid Limit	ži.	200 %	\vdash		Liquia L	imit / N - Val	ue
×	(ft)	Sample	SPT	ż	9	ਹੱ	Visual Classification - Remarks	վ [_] ŏ] =	Pla	2	(0	40	80	120
	<u> </u>					sc	Red clayey sand						Name of the last o			- Hamiltonian Lank
							(Import Fill)									delining in the second
						CL	Brownish red sandy clay	16	26	9	57		8	•		Parintenne established in december 2000
	- 5 -					CL	Brownish red silty clay									
						CL ML	Light brown clayey silt	19	21	4	51	-	8	•		African processor and the state of the state
·						ML	Dark brown clayey silt to elastic silt									
	— 10 —						wet									THE REAL PROPERTY AND ADDRESS OF THE PROPERTY AND ADDRESS.
	15															
☑	- 20					SM	Light brown silty sand saturated					enember eta eta de significación de la establicación				
	- 25						See Next Page	0.4								
	Auger (ASTM D 1	452)				lby Tube Notes: Boring terminated @ -3 TM D 1587) Groundwater was enco		ď		İ		@ N - V	alue	■Moistu	re
	Standard F			n	∇		al Water Level during drilling activities									
	Test (ASTI				•		ayed Water Level	ر. س	•••				- Liquid	d Limit	●Plastic	index

Planning - Surveying - Testing - Landscape Design 1724 B 23rd Avenue Meridian, Mississippi 39301 (601) 693-4234

PRO.	JECT:						Hangar Expansion					F	PROJ	IECT NO	: 17-27	'8	
CLIE		D+	РΑ	rchi	tects,									RING NO	: B-4 (0	Cont'd)	
LOGO			Alex		ler										10/3/2		
DRIL	LER:	В.	Low	ery	T		1			S		ACE		VATION			
<u></u>]				[]	Classification	Rig: Mobile		©	#	Plasticity Index		Han	nmer:		ind Cathead	
ě				e e	DCP (blows/.75")	icat	Drilling Method: 2 1/4 S		Moisture Content-(%)	Liquid Limit	드					/ Moisture	
er L	Donth	ple		/alr	DCP ows/.7	ssif	Backfill Method: Cutting		를 를	β	ticit	%	L	Liqu	id Limit	/ N - Value	
Water Level	Depth (ft)	Sample	SPT	N - Value	▣	응	Boring Depth: Visual Classificat		≥ී රි	13	las	- 200 %	C)	40	80	120
	25							TO THE TANK	ļ		┢	┝┷			1		
	20					SM	Light brown silty sand	•									-
	<u> </u>						saturated										

	30																
	<u> </u>						Boring Terminated @	30 ft.									
			İ														,
		ļ															
			ı														
l †																	
		- 1															
}			ı										-				
l	— 35 —			ı									ospulado-car				and the same of th
			İ														
l						İ				l							
			- 1						- [İ					
-				ı					- 1	İ							
		l	- 1						İ			ı					
				İ						ĺ							
 	— 40 —					l			ı			- 1					
			ı	Ì	1								* TOTAL TOTA				
 		İ				l						İ					
			ĺ														
 		ļ		- 1		ı					ı	ı	t-				
<u> </u>		-	İ									ļ	-				
F					1				ı			ı					
ŀ	- 45	ı							l								
					1				I								American
F			ļ			- 1				ı							
h									l								
F		ı		ı		l											
-													depresentation				
E													and the state of t				
F	- 50 -												-				
H																	
	Auger							Boring terminated @ -30	ft.			\dashv			***************************************		
	ASTM D 1					(AS	TM D 1587)	Groundwater was encou	ntered				*	N - Value		■Moisture	
	Standard F				▽ ▼		al Water Level	during drilling activities @	2) -18	ft.				- Liquid Lim	it	●Plastic Inde	x
	Test (ASTI	ע וע	1000	,		nel	ayed Water Level										

Planning - Surveying - Testing - Landscape Design 1724 B 23rd Avenue Meridian, Mississippi 39301 (601) 693-4234

PRO	JECT:	De	an N	∕lair	ntenar	nce	Hangar Expansion				F	PROJ	IECT NO:	17-278		
CLIE		D+	PΑ	rchi	tects,			***************************************					RING NO:			
LOG			Alex	-	ler								DATE:	10/3/20	19	
DRIL	LER:	B.	Low	ery	·		,		S	SURF	ACE	ELE	VATION: :	±292.2		
Water Level	Depth	Sample	1	N - Value	DCP (blows/.75")	Classification	Rig: Mobile B-47 Drilling Method: 2 1/4 SSA w/ SPT Backfill Method: Cuttings Boring Depth: 30 Feet	Moisture Content-(%)	Liquid Limit	Plasticity Index	200 %	Har	Plasti	Rope and c Limit / N Limit / N		
×a	(ft)	Sar	SPT	ż	9	ਹੱ	Visual Classification - Remarks	ŏ	Ë	Plas	- 20) 4	0	80	120
						SC CL CL MH	Red clayey sand (Import Fill) Reddish brown clayey sand Gray silty clay Brown elasitic silt	16	28		55		⊘a -			
	— 20 — Auger (ASTM D 1) Standard F	ene	tratio	n)	\textstyle \textstyle	(AS Initi	See Next Page slby Tube Notes: Boring terminated @ -30 TM D 1587) Groundwater was encount during drilling activities of a speed water Level Groundwater Level See Next Page Author See Notes: Boring terminated @ -30 Groundwater was encount during drilling activities of a speed water Level	untered					●N - Value - Liquid Limit		Moisture Plastic Index	

Planning - Surveying - Testing - Landscape Design 1724 B 23rd Avenue Meridian, Mississippi 39301 (601) 693-4234

PROJECT:	De	an I	Mair	itenai	nce	Hangar Expansion	KING LOG					DO I	ECT NO:	17-27	a a	
CLIENT:				tects,						***********			ING NO:			
LOGGER:		Alex											DATE:			
DRILLER:		Low							S	URF	ACE	ELE'	VATION:			
Mater Level (tt)				DCP (blows/.75")	Classification	Rig: Mobile B-47 Drilling Method: 2 1/4 SSA w/ Backfill Method: Cuttings	SPT	Moisture Content-(%)	T	Plasticity Index		T	nmer: Plast	Rope a	nd Cathead / Moisture N - Value	j
Mage of the part o	Sample	SPT	N - Value	old)	Class	Boring Depth: 30 Visual Classification - F	Feet Remarks	Con	Lig	Plasti	- 200 %	0		10	80	120
- 35 - 35 - 40 - 45 - 50 - 50 -		5	V. The state of th		SM	Brown silty sand saturated Boring Terminated @ -30 ft.	RETHALKS			d.						
Auger (ASTM D Standard Test (AST	Pene	tratio	ın)	\\\\\\\\\\\\\\\\\\\\\\\\\\\\\\\\\\\\\\	(AS	TM D 1587) Grou	ng terminated @ -30 undwater was encou ng drilling activities (ntered					▶N - Value • Liquid Limit		■Moisture Plastic Ind	ex

Planning - Surveying - Testing - Landscape Design 1724 B 23rd Avenue Meridian, Mississippi 39301 (601) 693-4234

PRO	DJECT:	De	an f	Mair	ntenai	nce l	Hangar Expansion		PROJECT NO: 17-278								
	ENT:	D+	PΑ	rchi	tects,	PLL	C						ING NO		7 0		
	GER:		Alex											10/3/	2019		
DRI	LLER:	B.	Low	ery					S	URF	ACE	ELE	VATION				
Water Level		ple		N - Value	DCP (blows/.75")	Classification	Rig: Mobile B-47 Drilling Method: 2 1/4 SSA w/ SPT Backfill Method: Cuttings	Moisture Content-(%)	Τ	Plasticity Index		Ham	mer: Plas	Rope :	and Cathead t / Moisture / N - Value	d	
Wate	Depth (ft)	Sample	SPT	/- N	ĕ	Clas	Boring Depth: 30 Feet Visual Classification - Remarks	Co ⊠	Lig	Plast	- 200 %	0		40	80	120	
∇ V	- 10 - 15 - 20 - 25 - 25 -					SC SC SM	Red clayey sand Gray slightly clayey silty sand soft, moist Brown elastic silt wet Dark brown fat clay Dark brownish gray silty sand saturated	18	22	4	43						
	Auger					She	lby Tube Notes: Boring terminated @ -30	ft.			\dashv		***************************************				
	(ASTM D					(AS	TM D 1587) Groundwater was encour	ntered				9	N - Value		■Moisture		
\boxtimes	Standard F Test (AST	Pene M D	tratio 1586	n)	▽		al Water Level during drilling activities @ ayed Water Level) 18 fi	t.				Liquid Lim	it	●Plastic Inde	ex	
				·													

Planning - Surveying - Testing - Landscape Design

1724 B 23rd Avenue Meridian, Mississippi 39301 (601) 693-4234

PRO.	JECT:	De	an I	Mair	itena	nce	Hangar Expansion	L BORING LOG					מחט:	IECT NO. 1	17 270		
CLIE					tects,									IECT NO: 1			
LOG	GER:		Alex				***************************************							DATE:			
DRIL	LER:	<u>B.</u>	Low	ery						S	URF	ACE	ELE	VATION: ±			
Water Level	_	ed ed		alue	DCP (blows/.75")	Classification	Rig: Mobile Drilling Method: 2 1/4 Backfill Method: Cuttin	SSA w/ SPT gs	Moisture Content-(%)	Liquid Limit	Plasticity Index	%	Han	Plastic	Limit / I	d Cathead Moisture I - Value	
Wate	Depth (ft)	Sample	SPŢ	N - Value	€	Clas	Boring Depth: Visual Classifica	30 Feet tion - Remarks	Şδ	Ę	Plasti	- 200 %	C) 40	כ	80	120
	<u> </u>					SM	Dark brownish gray s	lty sand									- Control of the Cont
							saturated										
							·							•			a Liver year (Liver year)
																	Control of the Contro
	30						Boring Terminated @	-30 ft					-				
																	0.000
ļ																	raibrerroaaueauea
Ē	— 35 —												-				or a distance of the second
	- 55												***************************************				and the second
-													and the second second second				
Ė								,					and the same	,			
										ĺ							
-	- 40 - 																

F	- 50 —																- Comment of the Comm
	30 =												**************************************				
	Auger ASTM D	1452)				elby Tube Notes TM D 1587)	 Boring terminated @ -30 Groundwater was encour 		1				N - Value		■Moisture	
	Standard I est (AST				\ ▼		al Water Level ayed Water Level	during drilling activities (⊉ -18	ft.				- Liquid Limit	•	Plastic Index	

APPENDIX D SOIL TEST RESULTS

Planning - Surveying - Testing - Landscape Design

1724 B 23rd Avenue Meridian, Mississippi 39301 (601) 693-4234

Sieve Analysis

PROJECT: Dean Maintenance Hangar Expansion

PROJECT NO:

17-278


CLIENT:

D+P Architects, PLLC

DATE:

10/9/2019

Sieve Analysis

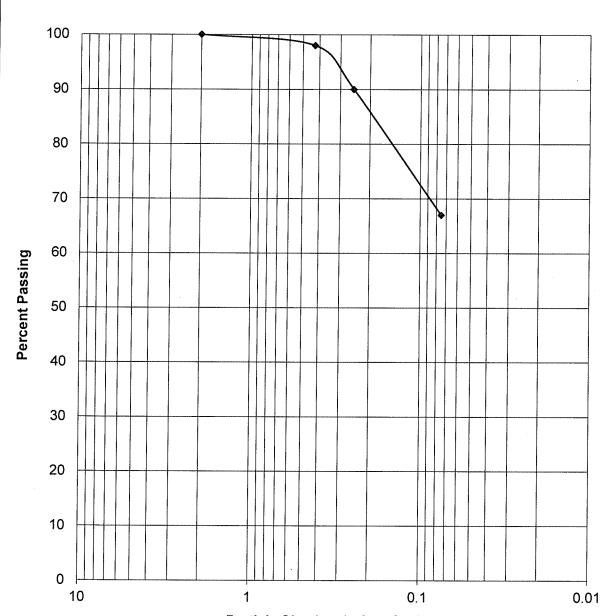

Particle Size (mm) - Log Scale

Description: Light brown silty clay

Boring No: B-1			Moisture		Atterberg Limit	ts	Volume	Classification		
Depth:	3.5-4.5		Content	LL	PL	PI	Change	Unified	AASHTO	
			19	38	18	20	32%	CL		
Sieve	Sieve Size (mm)	% Passing					···			
No. 10	2	100			***************************************		·			
No. 40	0.425	98				****				
No. 60	0.25	90								
No. 200	0.075	67								

Planning - Surveying - Testing - Landscape Design

1724 B 23rd Avenue Meridian, Mississippi 39301 (601) 693-4234

Sieve Analysis

PROJECT: Dean Maintenance Hangar Expansion

PROJECT NO:

17-278


CLIENT: D+P Ar

D+P Architects,PLLC

DATE:

10/9/2019

Sieve Analysis

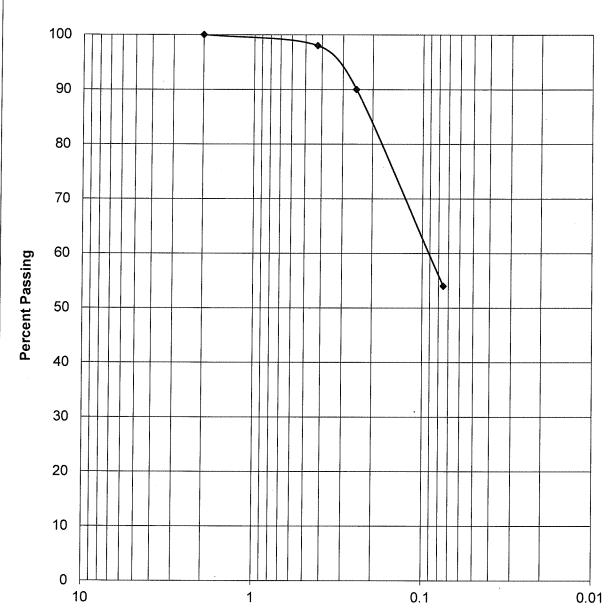

Particle Size (mm) - Log Scale

Description: Brownish gray silty clay

Boring No:	B-2		Moisture		Atterberg Limit	S	Volume	Class	fication
Depth:	4.5-8		Content	LL	PL	PI	Change	Unified	AASHTO
			15	25	18	7	13%	CL	
Sieve	Sieve Size (mm)	% Passing							
No. 10	2	100							
No. 40	0.425	98							
No. 60	0.25	90							
No. 200	0.075	54							

Planning - Surveying - Testing - Landscape Design

1724 B 23rd Avenue Meridian, Mississippi 39301 (601) 693-4234

Sieve Analysis

PROJECT: Dean Maintenance Hangar Expansion

PROJECT NO:


17-278

CLIENT: D+F

D+P Architects,PLLC

DATE: 10/9/2019

Sieve Analysis

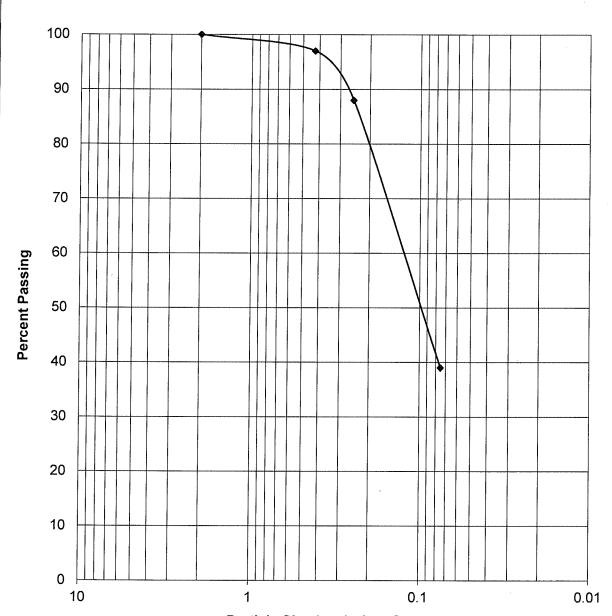

Particle Size (mm) - Log Scale

Description:	Brownish	gray silty sand
--------------	----------	-----------------

Boring No:	B-3		Moisture		Atterberg Limit	S	Volume	Class	fication
Depth:	4.5-6		Content	LL	PL	PI	Change	Unified	AASHTO
			16	37	22	15	14%	SC	
Sieve	Sieve Size (mm)	% Passing							
No. 10	2	100						,	
No. 40	0.425	97						*************	
No. 60	0.25	88							
No. 200	0.075	39							

Planning - Surveying - Testing - Landscape Design

1724 B 23rd Avenue Meridian, Mississippi 39301 (601) 693-4234

Sieve Analysis

PROJECT: Dean Maintenance Hangar Expansion


PROJECT NO:

17-278

CLIENT: D+P Architects, PLLC DATE:

10/9/2019

Sieve Analysis

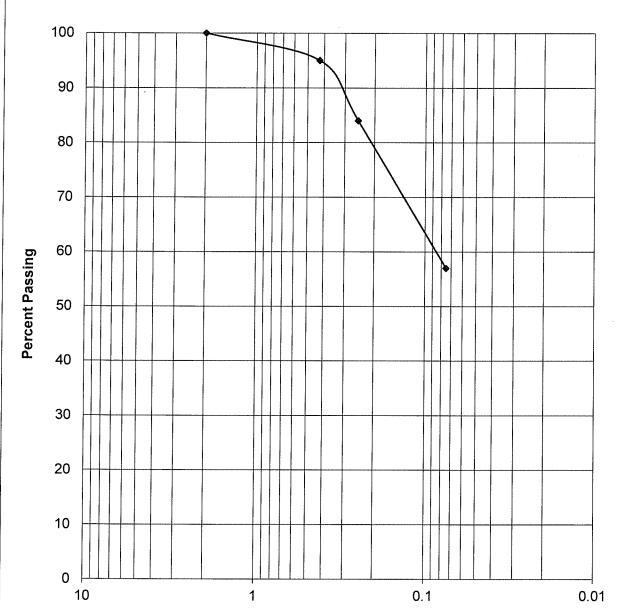

Particle Size (mm) - Log Scale

Description: Brownish red sandy clay

Boring No:	B-4		Moisture		Atterberg Limit	ts	Volume	Classi	fication
Depth:	3-5		Content	LL	PL	PI	Change	Unified	AASHTO
			16	26	17	9	24%	CL	
Sieve	Sieve Size (mm)	% Passing							
No. 10	2	100							
No. 40	0.425	95						,	
No. 60	0.25	84							***
No. 200	0.075	57							

Planning - Surveying - Testing - Landscape Design 1724 B 23rd Avenue Meridian, Mississippi 39301 (601) 693-4234

Sieve Analysis

PROJECT: Dean Maintenance Hangar Expansion

PROJECT NO:


17-278

CLIENT: D+P Architects, PLLC

DATE:

10/9/2019



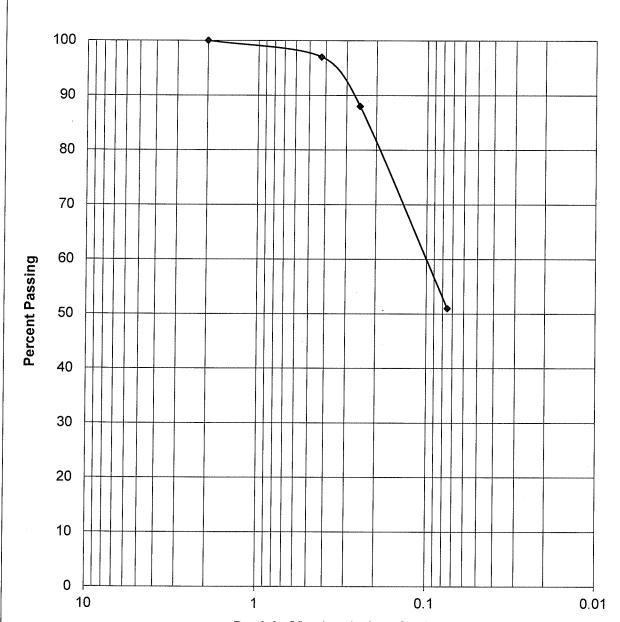

Particle Size (mm) - Log Scale

Description:	Light brown	clayey silt	

Boring No:	B-4		Moisture Content		Atterberg Limit	s	Volume	Classification		
Depth:	6-8			LL	PL	Pl	Change	Unified	AASHTO	
			19	21	17	4	15%	CL-ML		
Sieve	Sieve Size (mm)	% Passing								
No. 10	2	100								
No. 40	0.425	97					***************************************			
No. 60	0.25	88						WWW.TW.F.		
No. 200	0.075	51	***************************************							

Planning - Surveying - Testing - Landscape Design

1724 B 23rd Avenue Meridian, Mississippi 39301 (601) 693-4234

Sieve Analysis

PROJECT: Dean Maintenance Hangar Expansion

PROJECT NO:


17-278

CLIENT: D+P Architects,PLLC

DATE:

10/9/2019

Sieve Analysis

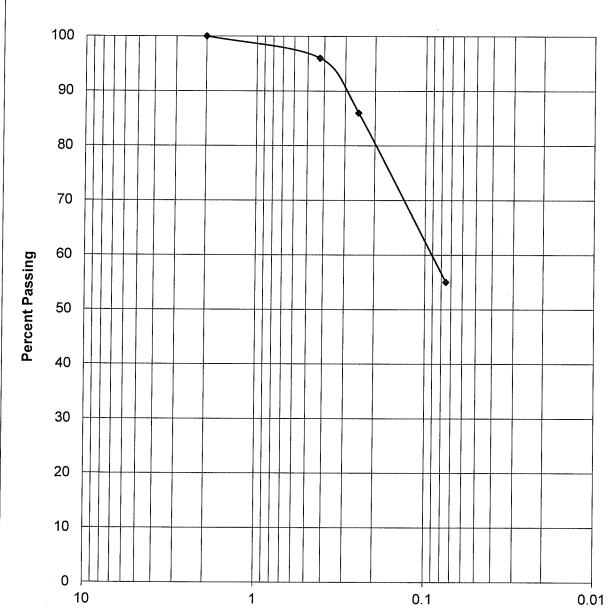

Particle Size (mm) - Log Scale

Description: Gray silty clay

Boring No:	B-5		Moisture		Atterberg Limit	S	Volume	Classi	fication	
Depth:	4.5-6		Content	LL	PL	PI	Change	Unified	AASHTO	
			16	28	17	11	20%	CL		
Sieve	Sieve Size (mm)	% Passing		***************************************						
No. 10	2	100								
No. 40	0.425	96		· · · · · · · · · · · · · · · · · · ·						
No. 60	0.25	86								
No. 200	0.075	55								

Engineering Plus, Inc.

Planning - Surveying - Testing - Landscape Design

1724 B 23rd Avenue Meridian, Mississippi 39301 (601) 693-4234

Sieve Analysis

PROJECT: Dean Maintenance Hangar Expansion


PROJECT NO:

17-278

CLIENT: D+P Architects, PLLC

DATE: 10/9/2019

Sieve Analysis

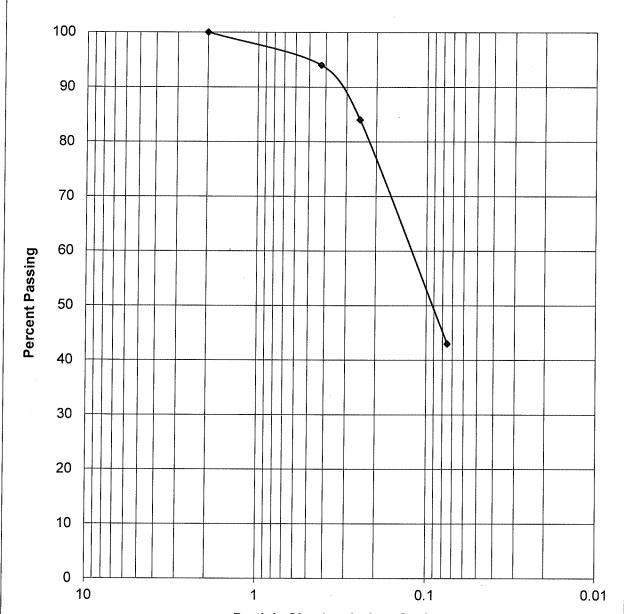

Particle Size (mm) - Log Scale

Description: Gray slightly clayey silty sand

Boring No:	ng No: B-6		Moisture	Atterberg Limits			Volume	Classification	
Depth:	4-7		Content	LL	PL	PI	Change	Unified	AASHTO
			18	22	18	4	16%	SC-SM	
Sieve	Sieve Size (mm)	% Passing							
No. 10	2	100							
No. 40	0.425	94							
No. 60	0.25	84							
No. 200	0.075	42						***************************************	

APPENDIX E GENERAL REMARKS/REPORT LIMITATIONS

GENERAL REMARKS/REPORT LIMITATIONS

- This report has been prepared for the exclusive use of the owner for specific application to the subject property.
- This publication is intended for the use of professional personnel competent to evaluate the significance and limitations of its contents and responsible for the applications of the information and recommendations presented.
- All recommendations contained in this report have been made in accordance with generally accepted soil and foundation engineering practices. No other warranties are implied or expressed.
- Assessment of site environmental conditions or the presence of contaminants in the soil, or in groundwater at the site is beyond the scope of this investigation, unless otherwise noted.
- The analysis and recommendations are based upon the data obtained from the soil borings. The nature and extent of variations between the soil test borings may not become evident until construction. If variations then appear evident, it may be necessary to re-evaluate the recommendations of this report.
- This report was prepared for design purposes only and is not intended to be utilized as an earthwork specification for construction. Contractors reviewing this report should acknowledge that discussions and recommendations contained herein are for design purposes.
- When the plans and specifications are more complete or if significant changes are made in the character of the proposed structure, a consultation should be arranged to review them with respect to prevailing soil conditions. At that time, it may be necessary to submit supplementary recommendations.
- The geotechnical engineer should be retained to review the final plans and specifications to verify that recommendations in this report are properly interpreted and incorporated in the design. If the geotechnical engineer is not accorded the privilege of making this review, then he can assume no responsibility for misinterpretation of recommendations.

for the following Project: (Name, location, and detailed description)

THE OWNER:

(Name, legal status, address, and other information)

THE ARCHITECT:

(Name, legal status, address, and other information)

TABLE OF ARTICLES

- 1 DEFINITIONS
- 2 BIDDER'S REPRESENTATIONS
- 3 BIDDING DOCUMENTS
- 4 BIDDING PROCEDURES
- 5 CONSIDERATION OF BIDS
- 6 POST-BID INFORMATION
- 7 PERFORMANCE BOND AND PAYMENT BOND
- 8 ENUMERATION OF THE PROPOSED CONTRACT DOCUMENTS

This document has important legal consequences. Consultation with an attorney is encouraged with respect to its completion or modification.

FEDERAL, STATE, AND LOCAL LAWS MAY IMPOSE REQUIREMENTS ON PUBLIC PROCUREMENT CONTRACTS. CONSULT LOCAL AUTHORITIES OR AN ATTORNEY TO VERIFY REQUIREMENTS APPLICABLE TO THIS PROCUREMENT BEFORE COMPLETING THIS FORM.

It is intended that AIA Document G612[™]–2017, Owner's Instructions to the Architect, Parts A and B will be completed prior to using this document.

ARTICLE 1 DEFINITIONS

- § 1.1 Bidding Documents include the Bidding Requirements and the Proposed Contract Documents. The Bidding Requirements consist of the advertisement or invitation to bid, Instructions to Bidders, supplementary instructions to bidders, the bid form, and any other bidding forms. The Proposed Contract Documents consist of the unexecuted form of Agreement between the Owner and Contractor and that Agreement's Exhibits, Conditions of the Contract (General, Supplementary and other Conditions), Drawings, Specifications, all Addenda, and all other documents enumerated in Article 8 of these Instructions.
- § 1.2 Definitions set forth in the General Conditions of the Contract for Construction, or in other Proposed Contract Documents apply to the Bidding Documents.
- § 1.3 Addenda are written or graphic instruments issued by the Architect, which, by additions, deletions, clarifications, or corrections, modify or interpret the Bidding Documents.
- § 1.4 A Bid is a complete and properly executed proposal to do the Work for the sums stipulated therein, submitted in accordance with the Bidding Documents.
- § 1.5 The Base Bid is the sum stated in the Bid for which the Bidder offers to perform the Work described in the Bidding Documents, to which Work may be added or deleted by sums stated in Alternate Bids.
- § 1.6 An Alternate Bid (or Alternate) is an amount stated in the Bid to be added to or deducted from, or that does not change, the Base Bid if the corresponding change in the Work, as described in the Bidding Documents, is accepted.
- § 1.7 A Unit Price is an amount stated in the Bid as a price per unit of measurement for materials, equipment, or services, or a portion of the Work, as described in the Bidding Documents.
- § 1.8 A Bidder is a person or entity who submits a Bid and who meets the requirements set forth in the Bidding Documents.
- § 1.9 A Sub-bidder is a person or entity who submits a bid to a Bidder for materials, equipment, or labor for a portion of the Work.

ARTICLE 2 BIDDER'S REPRESENTATIONS

- § 2.1 By submitting a Bid, the Bidder represents that:
 - .1 the Bidder has read and understands the Bidding Documents;
 - .2 the Bidder understands how the Bidding Documents relate to other portions of the Project, if any, being bid concurrently or presently under construction;
 - .3 the Bid complies with the Bidding Documents;
 - .4 the Bidder has visited the site, become familiar with local conditions under which the Work is to be performed, and has correlated the Bidder's observations with the requirements of the Proposed Contract Documents;
 - .5 the Bid is based upon the materials, equipment, and systems required by the Bidding Documents without exception; and
 - .6 the Bidder has read and understands the provisions for liquidated damages, if any, set forth in the form of Agreement between the Owner and Contractor.

ARTICLE 3 BIDDING DOCUMENTS

§ 3.1 Distribution

§ 3.1.1 Bidders shall obtain complete Bidding Documents, as indicated below, from the issuing office designated in the advertisement or invitation to bid, for the deposit sum, if any, stated therein.

(Indicate how, such as by email, website, host site/platform, paper copy, or other method Bidders shall obtain Bidding Documents.)

- § 3.1.2 Any required deposit shall be refunded to Bidders who submit a bona fide Bid and return the paper Bidding Documents in good condition within ten days after receipt of Bids. The cost to replace missing or damaged paper documents will be deducted from the deposit. A Bidder receiving a Contract award may retain the paper Bidding Documents, and the Bidder's deposit will be refunded.
- § 3.1.3 Bidding Documents will not be issued directly to Sub-bidders unless specifically offered in the advertisement or invitation to bid, or in supplementary instructions to bidders.
- § 3.1.4 Bidders shall use complete Bidding Documents in preparing Bids. Neither the Owner nor Architect assumes responsibility for errors or misinterpretations resulting from the use of incomplete Bidding Documents.
- § 3.1.5 The Bidding Documents will be available for the sole purpose of obtaining Bids on the Work. No license or grant of use is conferred by distribution of the Bidding Documents.

§ 3.2 Modification or Interpretation of Bidding Documents

- § 3.2.1 The Bidder shall carefully study the Bidding Documents, shall examine the site and local conditions, and shall notify the Architect of errors, inconsistencies, or ambiguities discovered and request clarification or interpretation pursuant to Section 3.2.2.
- § 3.2.2 Requests for clarification or interpretation of the Bidding Documents shall be submitted by the Bidder in writing and shall be received by the Architect at least seven days prior to the date for receipt of Bids. (Indicate how, such as by email, website, host site/platform, paper copy, or other method Bidders shall submit requests for clarification and interpretation.)
- § 3.2.3 Modifications and interpretations of the Bidding Documents shall be made by Addendum. Modifications and interpretations of the Bidding Documents made in any other manner shall not be binding, and Bidders shall not rely upon them.

§ 3.3 Substitutions

§ 3.3.1 The materials, products, and equipment described in the Bidding Documents establish a standard of required function, dimension, appearance, and quality to be met by any proposed substitution.

§ 3.3.2 Substitution Process

- § 3.3.2.1 Written requests for substitutions shall be received by the Architect at least ten days prior to the date for receipt of Bids. Requests shall be submitted in the same manner as that established for submitting clarifications and interpretations in Section 3.2.2.
- § 3.3.2.2 Bidders shall submit substitution requests on a Substitution Request Form if one is provided in the Bidding Documents.
- § 3.3.2.3 If a Substitution Request Form is not provided, requests shall include (1) the name of the material or equipment specified in the Bidding Documents; (2) the reason for the requested substitution; (3) a complete description of the proposed substitution including the name of the material or equipment proposed as the substitute, performance and test data, and relevant drawings; and (4) any other information necessary for an evaluation. The request shall include a statement setting forth changes in other materials, equipment, or other portions of the Work, including changes in the work of other contracts or the impact on any Project Certifications (such as LEED), that will result from incorporation of the proposed substitution.
- § 3.3.3 The burden of proof of the merit of the proposed substitution is upon the proposer. The Architect's decision of approval or disapproval of a proposed substitution shall be final.
- § 3.3.4 If the Architect approves a proposed substitution prior to receipt of Bids, such approval shall be set forth in an Addendum. Approvals made in any other manner shall not be binding, and Bidders shall not rely upon them.

§ 3.3.5 No substitutions will be considered after the Contract award unless specifically provided for in the Contract Documents.

§ 3.4 Addenda

§ 3.4.1 Addenda will be transmitted to Bidders known by the issuing office to have received complete Bidding Documents.

(Indicate how, such as by email, website, host site/platform, paper copy, or other method Addenda will be transmitted.)

- § 3.4.2 Addenda will be available where Bidding Documents are on file.
- § 3.4.3 Addenda will be issued no later than four days prior to the date for receipt of Bids, except an Addendum withdrawing the request for Bids or one which includes postponement of the date for receipt of Bids.
- § 3.4.4 Prior to submitting a Bid, each Bidder shall ascertain that the Bidder has received all Addenda issued, and the Bidder shall acknowledge their receipt in the Bid.

ARTICLE 4 BIDDING PROCEDURES

§ 4.1 Preparation of Bids

- § 4.1.1 Bids shall be submitted on the forms included with or identified in the Bidding Documents.
- § 4.1.2 All blanks on the bid form shall be legibly executed. Paper bid forms shall be executed in a non-erasable medium.
- § 4.1.3 Sums shall be expressed in both words and numbers, unless noted otherwise on the bid form. In case of discrepancy, the amount entered in words shall govern.
- § 4.1.4 Edits to entries made on paper bid forms must be initialed by the signer of the Bid.
- § 4.1.5 All requested Alternates shall be bid. If no change in the Base Bid is required, enter "No Change" or as required by the bid form.
- § 4.1.6 Where two or more Bids for designated portions of the Work have been requested, the Bidder may, without forfeiture of the bid security, state the Bidder's refusal to accept award of less than the combination of Bids stipulated by the Bidder. The Bidder shall neither make additional stipulations on the bid form nor qualify the Bid in any other manner.
- § 4.1.7 Each copy of the Bid shall state the legal name and legal status of the Bidder. As part of the documentation submitted with the Bid, the Bidder shall provide evidence of its legal authority to perform the Work in the jurisdiction where the Project is located. Each copy of the Bid shall be signed by the person or persons legally authorized to bind the Bidder to a contract. A Bid by a corporation shall further name the state of incorporation and have the corporate seal affixed. A Bid submitted by an agent shall have a current power of attorney attached, certifying the agent's authority to bind the Bidder.
- § 4.1.8 A Bidder shall incur all costs associated with the preparation of its Bid.

§ 4.2 Bid Security

§ 4.2.1 Each Bid shall be accompanied by the following bid security: (*Insert the form and amount of bid security.*)

- § 4.2.2 The Bidder pledges to enter into a Contract with the Owner on the terms stated in the Bid and shall, if required, furnish bonds covering the faithful performance of the Contract and payment of all obligations arising thereunder. Should the Bidder refuse to enter into such Contract or fail to furnish such bonds if required, the amount of the bid security shall be forfeited to the Owner as liquidated damages, not as a penalty. In the event the Owner fails to comply with Section 6.2, the amount of the bid security shall not be forfeited to the Owner.
- § 4.2.3 If a surety bond is required as bid security, it shall be written on AIA Document A310™, Bid Bond, unless otherwise provided in the Bidding Documents. The attorney-in-fact who executes the bond on behalf of the surety shall affix to the bond a certified and current copy of an acceptable power of attorney. The Bidder shall provide surety bonds from a company or companies lawfully authorized to issue surety bonds in the jurisdiction where the Project is located.
- § 4.2.4 The Owner will have the right to retain the bid security of Bidders to whom an award is being considered until (a) the Contract has been executed and bonds, if required, have been furnished; (b) the specified time has elapsed so that Bids may be withdrawn; or (c) all Bids have been rejected. However, if no Contract has been awarded or a Bidder has not been notified of the acceptance of its Bid, a Bidder may, beginning _____ days after the opening of Bids, withdraw its Bid and request the return of its bid security.

§ 4.3 Submission of Bids

§ 4.3.1 A Bidder shall submit its Bid as indicated below:

(Indicate how, such as by website, host site/platform, paper copy, or other method Bidders shall submit their Bid.)

- § 4.3.2 Paper copies of the Bid, the bid security, and any other documents required to be submitted with the Bid shall be enclosed in a sealed opaque envelope. The envelope shall be addressed to the party receiving the Bids and shall be identified with the Project name, the Bidder's name and address, and, if applicable, the designated portion of the Work for which the Bid is submitted. If the Bid is sent by mail, the sealed envelope shall be enclosed in a separate mailing envelope with the notation "SEALED BID ENCLOSED" on the face thereof.
- § 4.3.3 Bids shall be submitted by the date and time and at the place indicated in the invitation to bid. Bids submitted after the date and time for receipt of Bids, or at an incorrect place, will not be accepted.
- § 4.3.4 The Bidder shall assume full responsibility for timely delivery at the location designated for receipt of Bids.
- § 4.3.5 A Bid submitted by any method other than as provided in this Section 4.3 will not be accepted.

§ 4.4 Modification or Withdrawal of Bid

- § 4.4.1 Prior to the date and time designated for receipt of Bids, a Bidder may submit a new Bid to replace a Bid previously submitted, or withdraw its Bid entirely, by notice to the party designated to receive the Bids. Such notice shall be received and duly recorded by the receiving party on or before the date and time set for receipt of Bids. The receiving party shall verify that replaced or withdrawn Bids are removed from the other submitted Bids and not considered. Notice of submission of a replacement Bid or withdrawal of a Bid shall be worded so as not to reveal the amount of the original Bid.
- § 4.4.2 Withdrawn Bids may be resubmitted up to the date and time designated for the receipt of Bids in the same format as that established in Section 4.3, provided they fully conform with these Instructions to Bidders. Bid security shall be in an amount sufficient for the Bid as resubmitted.
- § 4.4.3 After the date and time designated for receipt of Bids, a Bidder who discovers that it made a clerical error in its Bid shall notify the Architect of such error within two days, or pursuant to a timeframe specified by the law of the jurisdiction where the Project is located, requesting withdrawal of its Bid. Upon providing evidence of such error to the reasonable satisfaction of the Architect, the Bid shall be withdrawn and not resubmitted. If a Bid is withdrawn pursuant to this Section 4.4.3, the bid security will be attended to as follows:

(State the terms and conditions, such as Bid rank, for returning or retaining the bid security.)

ARTICLE 5 CONSIDERATION OF BIDS

§ 5.1 Opening of Bids

If stipulated in an advertisement or invitation to bid, or when otherwise required by law, Bids properly identified and received within the specified time limits will be publicly opened and read aloud. A summary of the Bids may be made available to Bidders.

§ 5.2 Rejection of Bids

Unless otherwise prohibited by law, the Owner shall have the right to reject any or all Bids.

§ 5.3 Acceptance of Bid (Award)

§ 5.3.1 It is the intent of the Owner to award a Contract to the lowest responsive and responsible Bidder, provided the Bid has been submitted in accordance with the requirements of the Bidding Documents. Unless otherwise prohibited by law, the Owner shall have the right to waive informalities and irregularities in a Bid received and to accept the Bid which, in the Owner's judgment, is in the Owner's best interests.

§ 5.3.2 Unless otherwise prohibited by law, the Owner shall have the right to accept Alternates in any order or combination, unless otherwise specifically provided in the Bidding Documents, and to determine the lowest responsive and responsible Bidder on the basis of the sum of the Base Bid and Alternates accepted.

ARTICLE 6 POST-BID INFORMATION

§ 6.1 Contractor's Qualification Statement

Bidders to whom award of a Contract is under consideration shall submit to the Architect, upon request and within the timeframe specified by the Architect, a properly executed AIA Document A305TM, Contractor's Qualification Statement, unless such a Statement has been previously required and submitted for this Bid.

§ 6.2 Owner's Financial Capability

A Bidder to whom award of a Contract is under consideration may request in writing, fourteen days prior to the expiration of the time for withdrawal of Bids, that the Owner furnish to the Bidder reasonable evidence that financial arrangements have been made to fulfill the Owner's obligations under the Contract. The Owner shall then furnish such reasonable evidence to the Bidder no later than seven days prior to the expiration of the time for withdrawal of Bids. Unless such reasonable evidence is furnished within the allotted time, the Bidder will not be required to execute the Agreement between the Owner and Contractor.

§ 6.3 Submittals

§ 6.3.1 After notification of selection for the award of the Contract, the Bidder shall, as soon as practicable or as stipulated in the Bidding Documents, submit in writing to the Owner through the Architect:

- .1 a designation of the Work to be performed with the Bidder's own forces;
- .2 names of the principal products and systems proposed for the Work and the manufacturers and suppliers of each; and
- .3 names of persons or entities (including those who are to furnish materials or equipment fabricated to a special design) proposed for the principal portions of the Work.
- § 6.3.2 The Bidder will be required to establish to the satisfaction of the Architect and Owner the reliability and responsibility of the persons or entities proposed to furnish and perform the Work described in the Bidding Documents.
- § 6.3.3 Prior to the execution of the Contract, the Architect will notify the Bidder if either the Owner or Architect, after due investigation, has reasonable objection to a person or entity proposed by the Bidder. If the Owner or Architect has reasonable objection to a proposed person or entity, the Bidder may, at the Bidder's option, withdraw the Bid or submit an acceptable substitute person or entity. The Bidder may also submit any required adjustment in the Base Bid or Alternate Bid to account for the difference in cost occasioned by such substitution. The Owner may accept the adjusted bid price or disqualify the Bidder. In the event of either withdrawal or disqualification, bid security will not be forfeited.
- § 6.3.4 Persons and entities proposed by the Bidder and to whom the Owner and Architect have made no reasonable objection must be used on the Work for which they were proposed and shall not be changed except with the written consent of the Owner and Architect.

ARTICLE 7 PERFORMANCE BOND AND PAYMENT BOND

§ 7.1 Bond Requirements

- § 7.1.1 If stipulated in the Bidding Documents, the Bidder shall furnish bonds covering the faithful performance of the Contract and payment of all obligations arising thereunder.
- § 7.1.2 If the furnishing of such bonds is stipulated in the Bidding Documents, the cost shall be included in the Bid. If the furnishing of such bonds is required after receipt of bids and before execution of the Contract, the cost of such bonds shall be added to the Bid in determining the Contract Sum.
- § 7.1.3 The Bidder shall provide surety bonds from a company or companies lawfully authorized to issue surety bonds in the jurisdiction where the Project is located.
- § 7.1.4 Unless otherwise indicated below, the Penal Sum of the Payment and Performance Bonds shall be the amount of the Contract Sum.
- (If Payment or Performance Bonds are to be in an amount other than 100% of the Contract Sum, indicate the dollar amount or percentage of the Contract Sum.)

§ 7.2 Time of Delivery and Form of Bonds

- § 7.2.1 The Bidder shall deliver the required bonds to the Owner not later than three days following the date of execution of the Contract. If the Work is to commence sooner in response to a letter of intent, the Bidder shall, prior to commencement of the Work, submit evidence satisfactory to the Owner that such bonds will be furnished and delivered in accordance with this Section 7.2.1.
- § 7.2.2 Unless otherwise provided, the bonds shall be written on AIA Document A312, Performance Bond and Payment Bond.
- § 7.2.3 The bonds shall be dated on or after the date of the Contract.
- § 7.2.4 The Bidder shall require the attorney-in-fact who executes the required bonds on behalf of the surety to affix to the bond a certified and current copy of the power of attorney.

ARTICLE 8 ENUMERATION OF THE PROPOSED CONTRACT DOCUMENTS

- § 8.1 Copies of the proposed Contract Documents have been made available to the Bidder and consist of the following documents:
 - .1 AIA Document A101TM_2017, Standard Form of Agreement Between Owner and Contractor, unless otherwise stated below.
 - (Insert the complete AIA Document number, including year, and Document title.)
 - AIA Document A101TM—2017, Exhibit A, Insurance and Bonds, unless otherwise stated below. (Insert the complete AIA Document number, including year, and Document title.)
 - AIA Document A201TM–2017, General Conditions of the Contract for Construction, unless otherwise stated below.
 - (Insert the complete AIA Document number, including year, and Document title.)
 - .4 AIA Document E203TM_2013, Building Information Modeling and Digital Data Exhibit, dated as indicated below:
 - (Insert the date of the E203-2013.)

.5	Drawings									
	Number	Title	Date							
.6	Specifications									
	Section	Title	Date	Pages						
.7	Addenda:									
	Number	Date	Pages							
.8	Other Exhibits: (Check all boxes that apply and include appropriate information identifying the exhibit where require									
	☐ AIA Document E204 TM —2017, Sustainable Projects Exhibit, dated as indicated below: (<i>Insert the date of the E204-2017.</i>)									
	☐ The Sustainability Plan;									
	Title	Date	Pages							
	☐ Supplementary and other Conditions of the Contract:									
	Document	Title	Date	Pages						
.9	Other documents listed below: (List here any additional documents the Documents.)	nat are intended to form part	of the Proposed C	Contract						

SECTION 01 25 00 SUBSTITUTION PROCEDURES

SECTION 01 25 00 - SUBSTITUTION PROCEDURES

PART 1 - GENERAL

1.1 SUMMARY

- A. Section includes administrative and procedural requirements for substitutions.
- B. Related Requirements:
 - 1. Section 01 60 00 "Product Requirements" for requirements for submitting comparable product submittals for products by listed manufacturers.

1.2 DEFINITIONS

A. Substitutions: Changes in products, materials, equipment, and methods of construction from those required by the Contract Documents and proposed by Contractor.

1.3 ACTION SUBMITTALS

- A. Substitution Requests: Submit three copies of each request for consideration. Identify product or fabrication or installation method to be replaced. Include Specification Section number and title and Drawing numbers and titles.
 - 1. Substitution Request Form: Use CSI Form 13.1A.
 - 2. Documentation: Show compliance with requirements for substitutions and the following, as applicable:
 - a. Statement indicating why specified product or fabrication or installation cannot be provided, if applicable.
 - Coordination information, including a list of changes or revisions needed to other parts of the Work and to construction performed by Owner and separate contractors, that will be necessary to accommodate proposed substitution.
 - c. Detailed comparison of significant qualities of proposed substitution with those of the Work specified. Include annotated copy of applicable Specification Section. Significant qualities may include attributes such as performance, weight, size, durability, visual effect, sustainable design characteristics, warranties, and specific features and requirements indicated. Indicate deviations, if any, from the Work specified.
 - d. Product Data, including drawings and descriptions of products and fabrication and installation procedures.
 - e. Samples, where applicable or requested.

SECTION 01 25 00 SUBSTITUTION PROCEDURES

- f. Certificates and qualification data, where applicable or requested.
- g. List of similar installations for completed projects with project names and addresses and names and addresses of architects and owners.
- h. Material test reports from a qualified testing agency indicating and interpreting test results for compliance with requirements indicated.
- i. Research reports evidencing compliance with building code in effect for Project.
- j. Detailed comparison of Contractor's construction schedule using proposed substitution with products specified for the Work, including effect on the overall Contract Time. If specified product or method of construction cannot be provided within the Contract Time, include letter from manufacturer, on manufacturer's letterhead, stating date of receipt of purchase order, lack of availability, or delays in delivery.
- k. Cost information, including a proposal of change, if any, in the Contract Sum.
- I. Contractor's certification that proposed substitution complies with requirements in the Contract Documents except as indicated in substitution request, is compatible with related materials, and is appropriate for applications indicated.
- m. Contractor's waiver of rights to additional payment or time that may subsequently become necessary because of failure of proposed substitution to produce indicated results.
- 3. Architect's Action: If necessary, Architect will request additional information or documentation for evaluation within (3) three business days of receipt of a request for substitution. Architect will notify Contractor through Construction Manager of acceptance or rejection of proposed substitution within (5) five business days of receipt of additional information or documentation, whichever is later.
 - a. Forms of Acceptance: Change Order, Construction Change Directive, or Architect's Supplemental Instructions for minor changes in the Work.
 - b. Use product specified if Architect does not issue a decision on use of a proposed substitution within time allocated.

1.4 QUALITY ASSURANCE

A. Compatibility of Substitutions: Investigate and document compatibility of proposed substitution with related products and materials. Engage a qualified testing agency to perform compatibility tests recommended by manufacturers.

SECTION 01 25 00 SUBSTITUTION PROCEDURES

PART 2 - PRODUCTS

2.1 SUBSTITUTIONS

- A. Substitutions for Cause: Submit requests for substitution immediately on discovery of need for change, but no later than 30 days after the Notice of Award.
 - 1. Conditions: Architect will consider Contractor's request for substitution when the following conditions are satisfied:
 - a. Requested substitution is consistent with the Contract Documents and will produce indicated results.
 - b. Requested substitution will not adversely affect Contractor's construction schedule.
 - c. Requested substitution has received necessary approvals of authorities having jurisdiction.
 - d. Requested substitution is compatible with other portions of the Work.
 - e. Requested substitution has been coordinated with other portions of the Work
 - f. Requested substitution provides specified warranty.
 - g. If requested substitution involves more than one contractor, requested substitution has been coordinated with other portions of the Work, is uniform and consistent, is compatible with other products, and is acceptable to all contractors involved.
- B. Substitutions for Convenience: Not allowed unless otherwise indicated.
- C. Substitutions for Convenience: Architect will consider requests for substitution if received within 60 days after the Notice of Award.
 - 1. Conditions: Architect will consider Contractor's request for substitution when the following conditions are satisfied:
 - a. Requested substitution offers Owner a substantial advantage in cost, time, energy conservation, or other considerations, after deducting additional responsibilities Owner must assume. Owner's additional responsibilities may include compensation to Architect for redesign and evaluation services, increased cost of other construction by Owner, and similar considerations.
 - b. Requested substitution does not require extensive revisions to the Contract Documents.
 - c. Requested substitution is consistent with the Contract Documents and will produce indicated results.
 - d. Requested substitution will not adversely affect Contractor's construction schedule.
 - e. Requested substitution has received necessary approvals of authorities having jurisdiction.

3/26/2021

SECTION 01 25 00 SUBSTITUTION PROCEDURES

- f. Requested substitution is compatible with other portions of the Work.
- g. Requested substitution has been coordinated with other portions of the Work.
- h. Requested substitution provides specified warranty.
- i. If requested substitution involves more than one contractor, requested substitution has been coordinated with other portions of the Work, is uniform and consistent, is compatible with other products, and is acceptable to all contractors involved.

PART 3 - EXECUTION (Not Used)

END OF SECTION 01 25 00

SECTION 07 41 13.16 STANDING-SEAM METAL ROOF PANELS

SECTION 07 41 13.16 - STANDING-SEAM METAL ROOF PANELS

PART 1 - GENERAL

1.1 SUMMARY

A. Section includes standing-seam metal roof panels.

1.2 PREINSTALLATION MEETINGS

A. Preinstallation Conference: Conduct conference at Project site.

1.3 ACTION SUBMITTALS

- A. Product Data: For each type of product.
- B. Shop Drawings: Include fabrication and installation layouts of metal panels; details of edge conditions, joints, panel profiles, corners, anchorages, attachment system, trim, flashings, closures, and accessories; and special details.
- C. Samples: For each type of metal panel indicated.

1.4 INFORMATIONAL SUBMITTALS

- A. Product test reports.
- B. Warranties: Sample of special warranties.

1.5 CLOSEOUT SUBMITTALS

A. Maintenance data.

1.6 QUALITY ASSURANCE

- A. Installer Qualifications: An entity that employs installers and supervisors who are trained and approved by manufacturer.
- B. UL-Certified, Portable Roll-Forming Equipment: UL-certified, portable roll-forming equipment capable of producing metal panels warranted by manufacturer to be the same as factory-formed products. Maintain UL certification of portable roll-forming equipment for duration of work.

SECTION 07 41 13.16 STANDING-SEAM METAL ROOF PANELS

1.7 WARRANTY

- A. Special Warranty: Manufacturer's standard form in which manufacturer agrees to repair or replace components of metal panel systems that fail in materials or workmanship within specified warranty period.
 - 1. Warranty Period: Two years from date of Substantial Completion.
- B. Special Warranty on Panel Finishes: Manufacturer's standard form in which manufacturer agrees to repair finish or replace metal panels that show evidence of deterioration of factory-applied finishes within specified warranty period.
 - 1. Finish Warranty Period: 20 years from date of Substantial Completion.
- C. Special Weathertightness Warranty: Manufacturer's standard form in which manufacturer agrees to repair or replace standing-seam metal roof panel assemblies that fail to remain weathertight, including leaks, within specified warranty period.
 - 1. Warranty Period: 20 years from date of Substantial Completion.

PART 2 - PRODUCTS

2.1 PERFORMANCE REQUIREMENTS

- A. Energy Performance: Provide roof panels that are listed on the EPA/DOE's ENERGY STAR "Roof Product List" for low-slope roof products.
- B. Energy Performance: Provide roof panels according to one of the following when tested according to CRRC-1:
 - 1. Three-year, aged solar reflectance of not less than 0.55 and emissivity of not less than 0.75.
 - 2. Three-year, aged Solar Reflectance Index of not less than 64 when calculated according to ASTM E 1980.
- C. Structural Performance: Provide metal panel systems capable of withstanding the effects of the following loads, based on testing according to ASTM E 1592:
 - 1. Wind Loads: As indicated on Drawings.
 - 2. Other Design Loads: As indicated on Drawings.
 - 3. Deflection Limits: For wind loads, no greater than 1/180 of the span.
- D. Air Infiltration: Air leakage of not more than 0.0028 cfm/sq. ft. when tested according to ASTM E 1680 or ASTM E 283 at the following test-pressure difference:
 - 1. Test-Pressure Difference: +/-20 lbs/sq ft.
- E. Water Penetration under Static Pressure: No water penetration when tested according to ASTM E 1646 or ASTM E 331 at the following test-pressure difference:
 - 1. Test-Pressure Difference: +/-20 lbs/sq ft.

SECTION 07 41 13.16 STANDING-SEAM METAL ROOF PANELS

- F. Hydrostatic-Head Resistance: No water penetration when tested according to ASTM E 2140.
- G. Wind-Uplift Resistance: Provide metal roof panel assemblies that comply with UL 580 for wind-uplift-resistance class indicated.
 - 1. Uplift Rating: UL 90.
- H. Thermal Movements: Allow for thermal movements from ambient and surface temperature changes by preventing buckling, opening of joints, overstressing of components, failure of joint sealants, failure of connections, and other detrimental effects. Base calculations on surface temperatures of materials due to both solar heat gain and nighttime-sky heat loss.
 - 1. Temperature Change (Range): 120 deg F (67 deg C), ambient; 180 deg F (100 deg C), material surfaces.

2.2 STANDING-SEAM METAL ROOF PANELS

- A. General: Provide factory-formed metal roof panels designed to be installed by lapping and interconnecting raised side edges of adjacent panels with joint type indicated and mechanically attaching panels to supports using concealed clips in side laps. Include clips, cleats, pressure plates, and accessories required for weathertight installation.
 - 1. Steel Panel Systems: Unless more stringent requirements are indicated, comply with ASTM E 1514.
 - Aluminum Panel Systems: Unless more stringent requirements are indicated, comply with ASTM E 1637.
- B. Vertical-Rib, Seamed-Joint, Standing-Seam Metal Roof Panels: Formed with vertical ribs at panel edges and plank & pencil ribs between panel edge vertical ribs; designed for sequential installation by mechanically attaching panels to supports using concealed clips located under one side of panels, engaging opposite edge of adjacent panels, and mechanically seaming panels together.
 - 1. <u>Basis-of-Design Product</u>: Subject to compliance with requirements, provide MBCI; LokSeam® Metal Roof Panels (LSMSMBCI) or comparable product by one of the following, but not limited to:
 - a. CENTRIA Architectural Systems.
 - b. Exceptional Metals.
 - c. Metl-Span.
 - d. McElroy Metal

2.

- 3. Metallic-Coated Steel Sheet: Zinc-coated (galvanized) steel sheet complying with ASTM A 653/A 653M, G90 (Z275) coating designation, or aluminum-zinc alloy-coated steel sheet complying with ASTM A 792/A 792M, Class AZ50 (Class AZM150) coating designation; structural quality. Pre-painted by the coil-coating process to comply with ASTM A 755/A 755M.
 - a. Nominal Thickness: 22ga.

SECTION 07 41 13.16 STANDING-SEAM METAL ROOF PANELS

- b. Exterior Finish: Two-coat fluoropolymer
- c. Color: As selected by Architect from manufacturer's full range.
- 4. Clips: Two-piece floating to accommodate thermal movement.
 - a. Material: 0.064-inch- (1.63-mm-) nominal thickness, zinc-coated (galvanized) or aluminum-zinc alloy-coated steel sheet.
 - b. Material: 0.062-inch- (1.59-mm-) thick, stainless-steel sheet.
- 5. Joint Type: As standard with manufacturer.
- 6. Panel Coverage: 24 inches (610 mm)
- 7. Panel Height: 2 3/8 inches

2.3 UNDERLAYMENT MATERIALS

- A. Self-Adhering, High-Temperature Underlayment: Provide self-adhering, cold-applied, sheet underlayment, a minimum of 30 mils (0.76 mm) thick, consisting of slip-resistant, polyethylene-film top surface laminated to a layer of butyl or SBS-modified asphalt adhesive, with release-paper backing. Provide primer when recommended by underlayment manufacturer.
 - 1. Thermal Stability: Stable after testing at 240 deg F (116 deg C); ASTM D 1970.
 - Low-Temperature Flexibility: Passes after testing at minus 20 deg F (29 deg C);
 ASTM D 1970.
 - 3. <u>Manufacturers:</u> Subject to compliance with requirements, available manufacturers offering products that may be incorporated into the Work include, but are not limited to the following:
 - a. <u>Carlisle Residential; a division of Carlisle Construction Materials.</u>
 - b. Drexel Metals.
 - c. Grace Construction Products; W.R. Grace & Co. -- Conn.
 - d. Henry Company.
 - e. Kirsch Building Products, LLC.
 - f. Owens Corning.
- B. Felt Underlayment: ASTM D 226/D 22M, Type II (No. 30), asphalt-saturated organic felts.
- C. Slip Sheet: Manufacturer's recommended slip sheet, of type required for application.

2.4 MISCELLANEOUS MATERIALS

- A. Miscellaneous Metal Subframing and Furring: ASTM C 645; cold-formed, metallic-coated steel sheet, ASTM A 653/A 653M, G90 (Z275 hot-dip galvanized) coating designation or ASTM A 792/A 792M, Class AZ50 (Class AZM150) coating designation unless otherwise indicated. Provide manufacturer's standard sections as required for support and alignment of metal panel system.
- B. Panel Accessories: Provide components required for a complete, weathertight panel system including trim, copings, fasciae, mullions, sills, corner units, clips, flashings, sealants, gaskets,

SECTION 07 41 13.16 STANDING-SEAM METAL ROOF PANELS

fillers, closure strips, and similar items. Match material and finish of metal panels unless otherwise indicated.

- 1. Closures: Provide closures at eaves and ridges, fabricated of same metal as metal panels.
- 2. Backing Plates: Provide metal backing plates at panel end splices, fabricated from material recommended by manufacturer.
- 3. Closure Strips: Closed-cell, expanded, cellular, rubber or crosslinked, polyolefin-foam or closed-cell laminated polyethylene; minimum 1-inch- (25-mm-) thick, flexible closure strips; cut or premolded to match metal panel profile. Provide closure strips where indicated or necessary to ensure weathertight construction.
- C. Flashing and Trim: Provide flashing and trim formed from same material as metal panels as required to seal against weather and to provide finished appearance. Locations include, but are not limited to, eaves, rakes, corners, bases, framed openings, ridges, fasciae, and fillers. Finish flashing and trim with same finish system as adjacent metal panels.
- D. Gutters and Downspouts: Formed from same material as roof panels according to SMACNA's "Architectural Sheet Metal Manual." Finish to match roof fascia and rake trim.
- E. Roof Curbs: Fabricated from same material as roof panels, 0.048-inch (1.2-mm) nominal thickness; with bottom of skirt profiled to match roof panel profiles and with welded top box and integral full-length cricket. Fabricate curb subframing of 0.060-inch- (1.52-mm-) nominal thickness, angle-, C-, or Z-shaped steel sheet. Fabricate curb and subframing to withstand indicated loads of size and height indicated. Finish roof curbs to match metal roof panels.
- F. Panel Fasteners: Self-tapping screws designed to withstand design loads.
- G. Panel Sealants: Provide sealant type recommended by manufacturer that are compatible with panel materials, are nonstaining, and do not damage panel finish.
 - 1. Sealant Tape: Pressure-sensitive, 100 percent solids, gray polyisobutylene compound sealant tape with release-paper backing; 1/2 inch (13 mm) wide and 1/8 inch (3 mm) thick
 - 2. Joint Sealant: ASTM C 920; as recommended in writing by metal panel manufacturer.
 - 3. Butyl-Rubber-Based, Solvent-Release Sealant: ASTM C 1311.

2.5 FABRICATION

- A. General: Fabricate and finish metal panels and accessories at the factory, by manufacturer's standard procedures and processes, as necessary to fulfill indicated performance requirements demonstrated by laboratory testing. Comply with indicated profiles and with dimensional and structural requirements.
- B. On-Site Fabrication: Subject to compliance with requirements of this Section, metal panels may be fabricated on-site using UL-certified, portable roll-forming equipment if panels are of same profile and warranted by manufacturer to be equal to factory-formed panels. Fabricate according to equipment manufacturer's written instructions and to comply with details shown.
- C. Provide panel profile, including major ribs and intermediate stiffening ribs, if any, for full length of panel.

SECTION 07 41 13.16 STANDING-SEAM METAL ROOF PANELS

- D. Fabricate metal panel joints with factory-installed captive gaskets or separator strips that provide a weathertight seal and prevent metal-to-metal contact, and that minimize noise from movements.
- E. Sheet Metal Flashing and Trim: Fabricate flashing and trim to comply with manufacturer's recommendations and recommendations in SMACNA's "Architectural Sheet Metal Manual" that apply to design, dimensions, metal, and other characteristics of item indicated.

2.6 FINISHES

A. Panels and Accessories:

- 1. Two-Coat Fluoropolymer: AAMA 621 Fluoropolymer finish containing not less than 70 percent PVDF resin by weight in color coat.
- 2. Concealed Finish: White or light-colored acrylic or polyester backer finish.

PART 3 - EXECUTION

3.1 PREPARATION

A. Miscellaneous Supports: Install subframing, furring, and other miscellaneous panel support members and anchorages according to ASTM C 754 and metal panel manufacturer's written recommendations.

3.2 UNDERLAYMENT INSTALLATION

- A. Self-Adhering Sheet Underlayment: Apply primer if required by manufacturer. Comply with temperature restrictions of underlayment manufacturer for installation. Apply at locations indicated below, wrinkle free, in shingle fashion to shed water, and with end laps of not less than 6 inches (152 mm) staggered 24 inches (610 mm) between courses. Overlap side edges not less than 3-1/2 inches (90 mm). Extend underlayment into gutter trough. Roll laps with roller. Cover underlayment within 14 days.
 - 1. Apply over the entire roof surface.
- B. Slip Sheet: Apply slip sheet over underlayment before installing metal roof panels.
- C. Flashings: Install flashings to cover underlayment to comply with requirements specified in Section 076200 "Sheet Metal Flashing and Trim."

3.3 METAL PANEL INSTALLATION

- A. Standing-Seam Metal Roof Panel Installation: Fasten metal roof panels to supports with concealed clips at each standing-seam joint at location, spacing, and with fasteners recommended in writing by manufacturer.
 - 1. Install clips to supports with self-tapping fasteners.

SECTION 07 41 13.16 STANDING-SEAM METAL ROOF PANELS

- 2. Install pressure plates at locations indicated in manufacturer's written installation instructions.
- 3. Snap Joint: Nest standing seams and fasten together by interlocking and completely engaging factory-applied sealant.
- 4. Seamed Joint: Crimp standing seams with manufacturer-approved, motorized seamer tool so clip, metal roof panel, and factory-applied sealant are completely engaged.
- 5. Watertight Installation:
 - Apply a continuous ribbon of sealant or tape to seal joints of metal panels, using sealant or tape as recommend in writing by manufacturer as needed to make panels watertight.
 - b. Provide sealant or tape between panels and protruding equipment, vents, and accessories.
 - c. At panel splices, nest panels with minimum 6-inch (152-mm) end lap, sealed with sealant and fastened together by interlocking clamping plates.
- B. Accessory Installation: Install accessories with positive anchorage to building and weathertight mounting, and provide for thermal expansion. Coordinate installation with flashings and other components.
- C. Flashing and Trim: Comply with performance requirements, manufacturer's written installation instructions, and SMACNA's "Architectural Sheet Metal Manual." Provide concealed fasteners where possible, and set units true to line and level as indicated. Install work with laps, joints, and seams that will be permanently watertight and weather resistant.

3.4 CLEANING AND PROTECTION

A. Remove temporary protective coverings and strippable films, if any, as metal panels are installed, unless otherwise indicated in manufacturer's written installation instructions. On completion of metal panel installation, clean finished surfaces as recommended by metal panel manufacturer. Maintain in a clean condition during construction.

END OF SECTION 07 41 13.16

3/26/2021

SECTION 13 34 10 PRE-ENGINEERED METAL BUILDING SYSTEMS

SECTION 13 34 10 - PRE-ENGINEERED METAL BUILDING SYSTEMS

PART 1 - GENERAL

1.1 SUMMARY

A. Section Includes:

- 1. Structural-steel framing.
- 2. Metal roof panels.
- 3. Metal wall panels.
- 4. Metal soffit panels.
- 5. Thermal insulation.

1.2 PREINSTALLATION MEETINGS

A. Pre-installation Conference: Conduct conference at Project site.

1.3 REFERENCE STANDARDS

- A. American Institute of Steel Construction (AISC):
 - 1. AISC 360 Specification for Structural Steel Buildings.
 - 2. AISC 341 Seismic Provisions for Structural Steel Buildings (when appropriate).
 - 3. AISC Design Guide 3 Serviceability for Steel Buildings
- B. American Iron and Steel Institute (AISI):
 - 1. AISI S100 North American Specification for the Design of Cold-Formed Steel Structural Members.
- C. American Welding Society (AWS):
 - 1. AWS D1.1 / D1.1M Structural Welding Code Steel.
 - 2. AWS D1.3 / D1.3M Structural Welding Code Sheet Steel.
- D. Association for Iron & Steel Technology (AISE):
 - 1. AISE 13 Specifications for Design and Construction of Mill Buildings.
- E. ASTM International (ASTM):
 - ASTM A 325 Standard Specification for Structural Bolts, Steel, Heat Treated, 120/105 ksi Minimum Tensile Strength.
 - 2. ASTM A 653 / A 653M Standard Specification for Steel Sheet, Zinc-Coated (Galvanized) or Zinc-Iron Alloy-Coated (Galvannealed) by the Hot-Dip Process.
 - 3. ASTM A 792 / A 792M Standard Specification for Steel Sheet, 55 % Aluminum-Zinc Alloy-Coated by the Hot-Dip Process.

- 4. ASTM B 117 Standard Practice for Operating Salt Spray (Fog) Apparatus.
- 5. ASTM C 518 Standard Test Method for Steady-State Thermal Transmission Properties by Means of the Heat Flow Meter Apparatus.
- 6. ASTM C 1363 Standard Test Method for Thermal Performance of Building Materials and Envelope Assemblies by Means of a Hot Box Apparatus.
- 7. ASTM D 522 Standard Test Methods for Mandrel Bend Test of Attached Organic Coatings.
- 8. ASTM D 523 Standard Test Method for Specular Gloss.
- 9. ASTM D 968 Standard Test Methods for Abrasion Resistance of Organic Coatings by Falling Abrasive.
- 10. ASTM D 1308 Standard Test Method for Effect of Household Chemicals on Clear and Pigmented Organic Finishes.
- 11. ASTM D 2244 Standard Practice for Calculation of Color Tolerances and Color Differences from Instrumentally Measured Color Coordinates.
- 12. ASTM D 2247 Standard Practice for Testing Water Resistance of Coatings in 100% Relative Humidity.
- 13. ASTM D 2794 Standard Test Method for Resistance of Organic Coatings to the Effects of Rapid Deformation (Impact).
- 14. ASTM D 3361 Standard Practice for Unfiltered Open-Flame Carbon-Arc Exposures of Paint and Related Coatings.
- 15. ASTM D 4214 Standard Test Methods for Evaluating the Degree of Chalking of Exterior Paint Films.
- 16. ASTM E 84 Standard Test Method for Surface Burning Characteristics of Building Materials.
- 17. ASTM E 96 / E 96M Standard Test Methods for Water Vapor Transmission of Materials.
- 18. ASTM E 1592 Standard Test Method for Structural Performance of Sheet Metal Roof and Siding Systems by Uniform Static Air Pressure Difference.
- 19. ASTM G 87 Standard Practice for Conducting Moist SO2 Tests.
- F. Metal Building Manufacturers Association (MBMA):
 - 1. MBMA Metal Building Systems Manual.
 - 2. Seismic Design Guide for Metal Building Systems.
- G. North American Insulation Manufacturers Association (NAIMA):
 - NAIMA 202 Standard For Flexible Fiber Glass Insulation to be Laminated for Use in Metal Buildings.
- H. The Society for Protective Coatings (SSPC):
 - SSPC-Paint 15 Primer for Use Over Hand Cleaned Steel performs to SSPC-Paint 15 standards.
 - 2. SSPC-SP2 Hand Tool Cleaning.
- I. Underwriters Laboratories (UL):
 - UL 580 Standard for Tests for Uplift Resistance of Roof Assemblies.
 - 2. UL 723 Standard for Test for Surface Burning Characteristics of Building Materials.

3/26/2021

SECTION 13 34 10 PRE-ENGINEERED METAL BUILDING SYSTEMS

1.4 SUBMITTALS

- A. See Section 01 30 00 "Submittal Procedures".
- B. Product Data: For each type of metal building system component.
- C. Shop Drawings: Indicate components by others. Include full building plan, elevations, sections, details and attachments to other work.
- D. Samples: For units with factory-applied finishes.
- E. Welding certificates.
- F. Letter of Design Certification: Signed and sealed by a qualified professional engineer. Include the following:
 - 1. Name and location of Project.
 - 2. Order number.
 - 3. Name of manufacturer.
 - 4. Name of Contractor.
 - 5. Building dimensions including width, length, height, and roof slope.
 - 6. Indicate compliance with AISC standards for hot-rolled steel and AISI standards for cold-rolled steel, including edition dates of each standard.
 - 7. Governing building code and year of edition.
 - 8. Design Loads: Include dead load, roof live load, collateral loads, roof snow load, deflection, wind loads/speeds and exposure, seismic design category or effective peak velocity-related acceleration/peak acceleration, and auxiliary loads (cranes).
 - 9. Load Combinations: Indicate that loads were applied acting simultaneously with concentrated loads, according to governing building code.
 - 10. Building-Use Category: Indicate category of building use and its effect on load importance factors.
- G. Material test reports.
- H. Source quality-control reports.
- I. Field quality-control reports.
- J. Sample warranties.

1.5 CLOSEOUT SUBMITTALS

A. Maintenance data.

3/26/2021

SECTION 13 34 10 PRE-ENGINEERED METAL BUILDING SYSTEMS

1.6 QUALITY ASSURANCE

- A. Manufacturer Qualifications: A qualified manufacturer.
 - Accreditation: Manufacturer's facility accredited according to the International Accreditation Service's AC472, "Accreditation Criteria for Inspection Programs for Manufacturers of Metal Building Systems."
 - 2. Engineering Responsibility: Preparation of comprehensive engineering analysis and Shop Drawings by a professional engineer who is legally qualified to practice in jurisdiction where Project is located.
- B. Erector Qualifications: An experienced erector who specializes in erecting and installing work similar in material, design, and extent to that indicated for this Project and who is acceptable to manufacturer.
- C. Welding Qualifications: Qualify procedures and personnel according to the following:
 - 1. AWS D1.1/D1.1M, "Structural Welding Code Steel."
 - 2. AWS D1.3, "Structural Welding Code Sheet Steel."

D. Material Testing:

- In addition to material certifications of structural steel, metal building system manufacturer shall provide, upon request at time of order, evidence of compliance with specifications through testing.
- 2. This quality assurance testing shall include testing of structural bolts, nuts, screw fasteners, mastics, and metal coatings (primers, metallic coated products, and painted coil products).

1.7 DELIVERY, STORAGE, AND HANDLING

- A. Delivery and Acceptance Requirements: Deliver materials to site in manufacturer's original, unopened containers and packaging, with labels clearly identifying product name and manufacturer.
- B. Storage and Handling Requirements:
 - 1. Store and handle materials in accordance with manufacturer's instructions.
 - 2. Keep materials in manufacturer's original, unopened containers and packaging until installation.
 - 3. Do not store materials directly on ground.
 - 4. Store materials on flat, level surface, raised above ground, with adequate support to prevent sagging.
 - 5. Protect materials and finish during storage, handling, and installation to prevent damage.

1.8 WARRANTY

- A. Building System Warranty Only applicable per contract documents.
 - Furnish manufacturer's standard warranty for the metal building system, excluding primer.
 - 2. The manufacturer shall warranty the metal building system against failure due to defective material or workmanship for a period of one (1) year from date of shipment.
 - 3. The liability under this warranty shall be limited to furnishing, but not dismantling or installing, necessary replacement material F.O.B. manufacturer's plant. In no consequential, or special damages.
 - 4. Building must be installed by a qualified erector to be covered under manufacturer's warranty.
- B. Roof and Wall Panel Finish Warranty Only applicable per contract documents
 - 1. Paint Systems
 - a. Furnish manufacturer's standard warranty for the metal panel paint system against chipping, peeling, blistering, fading in excess of 5 NBS Hunter units, and chalking in excess of 8 units as set forth in ASTM D4214.
 - b. The warranty shall be for a period of 35 years from the date of shipment for fluoropolymer (PVDF) paint systems.
 - c. The warranty shall be for a period of 25 years from the date of shipment for silicone-polyester (SP) paint systems.
 - 2. Zinc-Aluminum systems
 - Furnish manufacturer's standard warranty for the zinc-aluminum hot dipped alloy-coated panels against roof and rupture, structural failure, or perforation due to normal atmospheric conditions.
 - b. The warranty shall be for a period of 20 years from the date of shipment for zinc-aluminum systems.
 - 3. The liability under this warranty shall be limited to furnishing, but not dismantling or installing, necessary replacement material F.O.B. manufacturer's plant. In no event shall the manufacturer be liable for loss of profits, or other incidental, consequential, or special damages.
- C. Roof System Weather-tightness Warranty Only applicable per contract documents
 - Furnish manufacturer's warranty for the metal building roof system. The warranty period of 20 years from the final inspection (if applicable) and acceptance from the manufacturer. See contract documents for more information.

3/26/2021

SECTION 13 34 10 PRE-ENGINEERED METAL BUILDING SYSTEMS

PART 2 - PRODUCTS

2.1 MANUFACTURERS

- A. Must be current member of MBMA
- B. The metal building systems manufacturer shall be accredited under the International Accreditation Service, Accreditation Criteria for Inspection Programs for Manufacturers of Metal Building Systems (AC472)

2.2 PERFORMANCE REQUIREMENTS

- A. Structural Performance: Metal building systems shall withstand the effects of gravity loads and the following loads and stresses within limits and under conditions indicated according to procedures in MBMA's "Metal Building Systems Manual", and as indicated in the Structural Drawings.
- B. Design Loads:
 - 1. Roof Live Load: 20 PSF
 - 2. Roof Dead Load: See Structural Drawings
 - 3. Collateral Load: 8 PSF
 - 4. Roof Snow Load: 5 PSF
 - 5. Wind: 115 MPH (Vult)
 - 6. Wind Importance Factor, lw: 1.0
 - 7. Exposure: C
 - 8. Seismic: Ss:0.161, S1:0.083
 - a. Site Class D
 - b. Seismic Importance Factor le: 1.0
 - c. Seismic Design Category: B
 - 9. Design Loads: See Structural Drawings for Additional Notes.
 - 10. Deflection and Drift Limits: Design metal building system assemblies to withstand serviceability design loads without exceeding deflections and drift limits recommended in AISC Steel Design Guide No. 3 "Serviceability Design Considerations for Steel Buildings." See Structural Drawings.
 - 11. Deflection and Drift Limits: See Structural Drawings for limitations.
- C. Seismic Performance: See Structural Drawings
- D. Thermal Movements: Allow for thermal movements from ambient and surface temperature changes by preventing buckling, opening of joints, overstressing of components, failure of joint sealants, failure of connections, and other detrimental effects. Base calculations on surface temperatures of materials due to both solar heat gain and nighttime-sky heat loss.

- 1. Temperature Change: 120 deg F (67 deg C), ambient; 180 deg F (100 deg C), material surfaces.
- E. Fire-Resistance Ratings: Where assemblies are indicated to have a fire-resistance rating, provide metal panel assemblies identical to those of assemblies tested for fire resistance per ASTM E 119 or ASTM E 108 by a qualified testing agency. Identify products with appropriate markings of applicable testing agency.
 - 1. Indicate design designations from UL's "Fire Resistance Directory," FM Global's "Approval Guide," or from the listings of another qualified testing agency.
- F. Fire-Rated Door Assemblies: Assemblies complying with NFPA 80 that are listed and labeled by a qualified testing agency, for fire-protection ratings indicated, based on testing at positive pressure according to NFPA 252 or UL 10C.
 - Oversize Fire-Rated Door Assemblies: For units exceeding sizes of tested assemblies, provide certification by a qualified testing agency that doors comply with standard construction requirements for tested and labeled fire-rated door assemblies except for size.
- G. Structural Performance for Metal Roof [and Wall Panels: Provide metal panel systems capable of withstanding the effects of the following loads, based on testing according to ASTM E 1592:
 - 1. Wind Loads: See component & cladding pressures specified in the Structural Drawings.
- H. Wind-Uplift Resistance: Provide metal roof panel assemblies that comply with UL 580 for wind-uplift-resistance class indicated.
 - 1. Uplift Rating: Class 90.
- I. FM Global Listing: Provide metal roof panels and component materials that comply with requirements in FM Global 4471 as part of a panel roofing system and that are listed in FM Global's "Approval Guide" for Class 1 or noncombustible construction, as applicable. Identify materials with FM Global markings.

2.3 STRUCTURAL-STEEL FRAMING

- A. Structural Steel: Comply with AISC 360, "Specification for Structural Steel Buildings."
- B. Bolted Connections: Comply with RCSC's "Specification for Structural Joints Using High-Strength Bolts."

- C. Cold-Formed Steel: Comply with AISI's "North American Specification for the Design of Cold-Formed Steel Structural Members" for design requirements and allowable stresses.
- D. Primary Framing: Manufacturer's standard primary-framing system, designed to withstand required loads and specified requirements. Primary framing includes transverse and lean-to frames; rafters and rake beams; sidewall, intermediate, endwall, and corner columns; and wind bracing.
 - 1. General: Provide frames with attachment plates, bearing plates, and splice members. Factory drill for field-bolted assembly. Provide frame span and spacing indicated.
 - a. Slight variations in span and spacing may be acceptable if necessary to comply with manufacturer's standard, as approved by Architect.
 - 2. Frame Configuration: Single gable and Lean-to, with high side connected to and supported by main structure.
 - 3. Exterior Column: As recommended by manufacturer.
 - 4. Rafter: As recommended by manufacturer.
- E. End-Wall Framing: Manufacturer's standard primary end-wall framing fabricated for field-bolted assembly to comply with the following:
- F. Secondary Framing: Manufacturer's standard secondary framing, including purlins, girts, eave struts, flange bracing, base members, gable angles, clips, headers, jambs, and other miscellaneous structural members. Unless otherwise indicated, fabricate framing from either cold-formed, structural-steel sheet or roll-formed, metallic-coated steel sheet, pre-painted with coil coating, to comply with the following:
- G. Anchor Rods: Headed anchor rods as indicated in Anchor Rod Plan for attachment of metal building to foundation. See Structural Drawings for minimum anchor rod lengths required.

2.4 METAL ROOF PANELS

- A. General: Provide factory-formed metal roof panels designed to be installed by lapping and interconnecting raised side edges of adjacent panels with joint type indicated and mechanically attaching panels to supports using concealed clips in side laps. Include clips, cleats, pressure plates, and accessories required for weathertight installation.
 - 1. Steel Panel Systems: Unless more stringent requirements are indicated, comply with ASTM E 1514.
 - Aluminum Panel Systems: Unless more stringent requirements are indicated, comply with ASTM E 1637.

- B. Standing-Seam Metal Roof Panels: Formed with vertical ribs at panel edges and plank & pencil ribs between panel edge vertical ribs; designed for sequential installation by mechanically attaching panels to supports using concealed clips located under one side of panels, engaging opposite edge of adjacent panels, and mechanically seaming panels together.
 - 1. Type: Single skin panels with concealed clips.
 - 2. Panel Strength: Determine and certify panel strength as follows:
 - a. Positive Loading (Toward Panel Supports): Determine in accordance with AISI \$100
 - b. Negative Loading (Away from Panel Supports): Determine in accordance with ASTM E 1592.
 - 3. Panel profile Basis of Design: Double-Lok:
 - a. Panel Type: Trapezoidal machine seamed, 1/4:12 minimum roof slope.
 - b. Panel width: 18 inches wide x 3 inches
 - c. Thickness: 24 gauge.
 - d. Finish: PVDF Metallic.
 - e. Color: Selected from manufacturer standard colors.
 - f. Air Infiltration: Maximum air infiltration of 0.04 cubic feet per minute per square foot of specimen area when tested to ASTM E 1680 at a pressure differential of +/- 1.57 psf (75 Pa).
 - g. Water Infiltration: No uncontrollable water leakage when tested to ASTM E 1646 at a 20 psf (955 Pa) pressure differential when sprayed with 5 gallons of water per hour per square foot (203 liters per square meter) of specimen area.

2.5 THERMAL INSULATION

- A. Faced Metal Building Insulation: ASTM C 991, Type II, glass-fiber-blanket insulation; 0.5-lb/cu. ft. density; 2-inch-wide, continuous, vapor-tight edge tabs; with a flame-spread index of 25 or less.
- B. Unfaced Metal Building Insulation: ASTM C 991, Type I, or NAIMA 202, glass-fiber-blanket insulation; 0.5-lb/cu. ft.; density; 2-inch-wide, continuous, vapor-tight edge tabs; with a flame-spread index of 25 or less.
- C. Retainer Strips: For securing insulation between supports, 0.025-inch (0.64-mm) nominal-thickness, formed, metallic-coated steel or PVC retainer clips colored to match insulation facing.
- D. Vapor-Retarder Facing: ASTM C 1136, with permeance not greater than 0.02 perm when tested according to ASTM E 96/E 96M, Desiccant Method.
- E. Wall and Roof insulation shall have a minimum R-Value of R-19.

2.6 PERSONNEL DOORS AND FRAMES

A. Swinging Personnel Doors and Frames: Metal building system manufacturer's standard doors and frames; prepared and reinforced at strike and at hinges to receive factory-and field-applied hardware according to BHMA A156 Series.

1. Hardware:

- a. Provide hardware for each door leaf, as follows:
 - 1) Hinges: BHMA A156.1. Three plain-bearing, standard-weight, full-mortise, stainless-steel or bronze, template-type hinges; 4-1/2 by 4-1/2 inches (114 by 114 mm), with nonremovable pin.
 - 2) Lockset: BHMA A156.2. Mortise, with lever handle type.
 - 3) Exit Device: BHMA A156.3. Touch- or push-bar type.
 - 4) Threshold: BHMA A156.21. Extruded aluminum.
 - 5) Silencers: Pneumatic rubber; three silencers on strike jambs of single door frames and two silencers on heads of double door frames.
 - 6) Closer: BHMA A156.4. Surface-applied, standard-duty hydraulic type.
 - 7) Weather Stripping: Vinyl applied to head and jambs, with vinyl sweep at sill.

B. Finishes for Personnel Doors and Frames:

- 1. Prime Finish: Factory-apply manufacturer's standard primer immediately after cleaning and pretreating.
- 2. Factory-Applied Paint Finish: Manufacturer's standard, complying with SDI A250.3 for performance and acceptance criteria.
 - a. Color and Gloss: As selected by the County Engineer from manufacturer's full range.

2.7 ACCESSORIES

- A. General: Provide accessories as standard with metal building system manufacturer and as specified. Fabricate and finish accessories at the factory to greatest extent possible, by manufacturer's standard procedures and processes. Comply with indicated profiles and with dimensional and structural requirements.
 - 1. Form exposed sheet metal accessories that are without excessive oil-canning, buckling, and tool marks and that are true to line and levels indicated, with exposed edges folded back to form hems.
- B. Roof Panel Accessories: Provide components required for a complete metal roof panel assembly including copings, fasciae, corner units, ridge closures, clips, sealants,

gaskets, fillers, closure strips, and similar items. Match material and finish of metal roof panels unless otherwise indicated.

- C. Wall Panel Accessories: Provide components required for a complete metal wall panel assembly including copings, fasciae, mullions, sills, corner units, clips, sealants, gaskets, fillers, closure strips, and similar items. Match material and finish of metal wall panels unless otherwise indicated.
- D. Flashing and Trim: Zinc-coated (galvanized) or aluminum-zinc alloy-coated steel sheet, 0.018-inch (0.46-mm) nominal uncoated steel thickness, prepainted with coil coating; finished to match adjacent metal panels.
- E. Gutters: Zinc-coated (galvanized) or aluminum-zinc alloy-coated steel sheet, 0.018-inch (0.46-mm) nominal uncoated steel thickness, prepainted with coil coating; finished to match roof fascia and rake trim. Match profile of gable trim, complete with end pieces, outlet tubes, and other special pieces as required. Fabricate in minimum 96-inch- (2438-mm-) long sections, sized according to SMACNA's "Architectural Sheet Metal Manual."
 - 1. Gutter Supports: Fabricated from same material and finish as gutters.
 - 2. Strainers: Bronze, copper, or aluminum wire ball type at outlets.
- F. Downspouts: Zinc-coated (galvanized) or aluminum-zinc alloy-coated steel sheet, 0.018-inch (0.46-mm) nominal uncoated steel thickness, prepainted with coil coating; finished to match metal wall panels. Fabricate in minimum 10-foot- (3-m-) long sections, complete with formed elbows and offsets.
 - 1. Mounting Straps: Fabricated from same material and finish as gutters.
- G. Pipe Flashing: Premolded, EPDM pipe collar with flexible aluminum ring bonded to base.

2.8 FABRICATION

- A. General: Design components and field connections required for erection to permit easy assembly.
 - 1. Mark each piece and part of the assembly to correspond with previously prepared erection drawings, diagrams, and instruction manuals.
 - 2. Fabricate structural framing to produce clean, smooth cuts and bends. Punch holes of proper size, shape, and location. Members shall be free of cracks, tears, and ruptures.
- B. Tolerances: Comply with MBMA's "Metal Building Systems Manual" for fabrication and erection tolerances.

- C. Primary Framing: Shop fabricate framing components to indicated size and section, with baseplates, bearing plates, stiffeners, and other items required for erection welded into place. Cut, form, punch, drill, and weld framing for bolted field assembly.
- D. Secondary Framing: Shop fabricate framing components to indicated size and section by roll forming or break forming, with baseplates, bearing plates, stiffeners, and other plates required for erection welded into place. Cut, form, punch, drill, and weld secondary framing for bolted field connections to primary framing.
- E. Metal Panels: Fabricate and finish metal panels at the factory to greatest extent possible, by manufacturer's standard procedures and processes, as necessary to fulfill indicated performance requirements. Comply with indicated profiles and with dimensional and structural requirements.
 - 1. Provide panel profile, including major ribs and intermediate stiffening ribs, if any, for full length of metal panel.

2.9 SOURCE QUALITY CONTROL

- A. Special Inspection: Owner will engage a qualified special inspector to perform source quality control inspections and to submit reports.
 - Accredited Manufacturers: Special inspections will not be required if fabrication is performed by an IAS AC472-accredited manufacturer approved by authorities having jurisdiction to perform such Work without special inspection.
- B. Product will be considered defective if it does not pass tests and inspections.
- C. Prepare test and inspection reports.

PART 3 - EXECUTION

3.1 ERECTION OF STRUCTURAL FRAMING

- A. Erect metal building system according to manufacturer's written instructions and drawings.
- B. Do not field cut, drill, or alter structural members without written approval from metal building system manufacturer's professional engineer.
- C. Set structural framing accurately in locations and to elevations indicated, according to AISC specifications referenced in this Section. Maintain structural stability of frame during erection.

- D. Base and Bearing Plates: Clean concrete- and masonry-bearing surfaces of bond-reducing materials, and roughen surfaces prior to setting plates. Clean bottom surface of plates.
 - 1. Set plates for structural members on wedges, shims, or setting nuts as required.
 - 2. Tighten anchor rods after supported members have been positioned and plumbed. Do not remove wedges or shims but, if protruding, cut off flush with edge of plate before packing with grout.
 - 3. Promptly pack grout solidly between bearing surfaces and plates so no voids remain. Neatly finish exposed surfaces; protect grout and allow to cure. Comply with manufacturer's written installation instructions for shrinkage-resistant grouts.
- E. Align and adjust structural framing before permanently fastening. Before assembly, clean bearing surfaces and other surfaces that will be in permanent contact with framing. Perform necessary adjustments to compensate for discrepancies in elevations and alignment.
 - 1. Level and plumb individual members of structure.
 - 2. Make allowances for difference between temperature at time of erection and mean temperature when structure will be completed and in service.
- F. Primary Framing and End Walls: Erect framing level, plumb, rigid, secure, and true to line. Level baseplates to a true even plane with full bearing to supporting structures, set with double-nutted anchor bolts. Use grout to obtain uniform bearing and to maintain a level base-line elevation. Moist-cure grout for not less than seven days after placement.
 - Make field connections using high-strength bolts installed according to RCSC's "Specification for Structural Joints Using High-Strength Bolts" for bolt type and joint type specified.
 - a. Joint Type: Snug tightened or pretensioned as required by manufacturer.
- G. Secondary Framing: Erect framing level, plumb, rigid, secure, and true to line. Field bolt secondary framing to clips attached to primary framing.
 - 1. Provide rake or gable purlins with tight-fitting closure channels and fasciae.
 - 2. Locate and space wall girts to suit openings such as doors and windows.
 - 3. Provide supplemental framing at entire perimeter of openings, including doors, windows, ventilators, and other penetrations of roof and walls.
- H. Steel Joists: Install joists and accessories plumb, square, and true to line; securely fasten to supporting construction according to SJI's "Standard Specifications and Load Tables for Steel Joists and Joist Girders," joist manufacturer's written instructions, and requirements in this Section.
 - 1. Before installation, splice joists delivered to Project site in more than one piece.

- 2. Space, adjust, and align joists accurately in location before permanently fastening.
- 3. Install temporary bracing and erection bridging, connections, and anchors to ensure that joists are stabilized during construction.
- 4. Joist Installation: Bolt joists to supporting steel framework using carbon-steel bolts unless otherwise indicated.
- 5. Joist Installation: Bolt joists to supporting steel framework using high-strength structural bolts unless otherwise indicated. Comply with RCSC's "Specification for Structural Joints Using High-Strength Bolts" for high-strength structural bolt installation and tightening requirements.
- 6. Joist Installation: Weld joist seats to supporting steel framework.
- 7. Install and connect bridging concurrently with joist erection, before construction loads are applied. Anchor ends of bridging lines at top and bottom chords if terminating at walls or beams.
- I. Bracing: Install bracing in roof and sidewalls where indicated on erection drawings.
 - 1. Tighten rod and cable bracing to avoid sag.
 - 2. Locate interior end-bay bracing only where indicated.
- J. Framing for Openings: Provide shapes of proper design and size to reinforce openings and to carry loads and vibrations imposed, including equipment furnished under mechanical and electrical work. Securely attach to structural framing.
- K. Erection Tolerances: Maintain erection tolerances of structural framing within AISC 303.

3.2 METAL PANEL INSTALLATION, GENERAL

- A. General: Anchor metal panels and other components of the Work securely in place, with provisions for thermal and structural movement.
 - 1. Field cut metal panels as required for doors, windows, and other openings. Cut openings as small as possible, neatly to size required, and without damage to adjacent metal panel finishes.
 - a. Field cutting of metal panels by torch is not permitted unless approved in writing by manufacturer.
 - 2. Install metal panels perpendicular to structural supports unless otherwise indicated.
 - 3. Flash and seal metal panels with weather closures at perimeter of openings and similar elements. Fasten with self-tapping screws.
 - 4. Locate and space fastenings in uniform vertical and horizontal alignment.
 - 5. Locate metal panel splices over structural supports with end laps in alignment.

- 6. Lap metal flashing over metal panels to allow moisture to run over and off the material.
- B. Lap-Seam Metal Panels: Install screw fasteners using power tools with controlled torque adjusted to compress EPDM washers tightly without damage to washers, screw threads, or metal panels. Install screws in predrilled holes.
 - 1. Arrange and nest side-lap joints so prevailing winds blow over, not into, lapped joints. Lap ribbed or fluted sheets one full rib corrugation. Apply metal panels and associated items for neat and weathertight enclosure. Avoid "panel creep" or application not true to line.
- C. Metal Protection: Where dissimilar metals contact each other or corrosive substrates, protect against galvanic action by painting contact surfaces with corrosion-resistant coating, by applying rubberized-asphalt underlayment to each contact surface, or by other permanent separation as recommended by metal roof panel manufacturer.
- D. Joint Sealers: Install gaskets, joint fillers, and sealants where indicated and where required for weatherproof performance of metal panel assemblies. Provide types of gaskets, fillers, and sealants indicated; or, if not indicated, provide types recommended by metal panel manufacturer.
 - 1. Seal metal panel end laps with double beads of tape or sealant the full width of panel. Seal side joints where recommended by metal panel manufacturer.
 - 2. Prepare joints and apply sealants to comply with requirements in Section 079200 "Joint Sealants."

3.3 METAL ROOF PANEL INSTALLATION

- A. General: Provide metal roof panels of full length from eave to ridge unless otherwise indicated or restricted by shipping limitations.
 - 1. Install ridge caps as metal roof panel work proceeds.
 - 2. Flash and seal metal roof panels with weather closures at eaves and rakes. Fasten with self-tapping screws.
- B. Standing-Seam Metal Roof Panels: Refer to Specification Section 07 41 13.16 "Standing-Seam Metal Roof Panels".
- C. Lap-Seam Metal Roof Panels: Fasten metal roof panels to supports with exposed fasteners at each lapped joint, at location and spacing recommended by manufacturer.
 - 1. Provide metal-backed sealing washers under heads of exposed fasteners bearing on weather side of metal roof panels.
 - 2. Provide sealant tape at lapped joints of metal roof panels and between panels and protruding equipment, vents, and accessories.

- 3. Apply a continuous ribbon of sealant tape to weather-side surface of fastenings on end laps and on side laps of nesting-type metal panels, on side laps of ribbed or fluted metal panels, and elsewhere as needed to make metal panels weatherproof to driving rains.
- 4. At metal panel splices, nest panels with minimum 6-inch (152-mm) end lap, sealed with butyl-rubber sealant and fastened together by interlocking clamping plates.
- D. Metal Fascia Panels: Align bottom of metal panels and fasten with blind rivets, bolts, or self-drilling or self-tapping screws. Flash and seal metal panels with weather closures where fasciae meet soffits, along lower panel edges, and at perimeter of all openings.

3.4 METAL WALL PANEL INSTALLATION

- A. General: Install metal wall panels in orientation, sizes, and locations indicated on Drawings. Install panels perpendicular to girts, extending full height of building, unless otherwise indicated. Anchor metal wall panels and other components of the Work securely in place, with provisions for thermal and structural movement.
 - 1. Unless otherwise indicated, begin metal panel installation at corners with center of rib lined up with line of framing.
 - 2. Shim or otherwise plumb substrates receiving metal wall panels.
 - 3. When two rows of metal panels are required, lap panels 4 inches (102 mm) minimum.
 - 4. When building height requires two rows of metal panels at gable ends, align lap of gable panels over metal wall panels at eave height.
 - 5. Rigidly fasten base end of metal wall panels and allow eave end free movement for thermal expansion and contraction. Predrill panels.
 - 6. Flash and seal metal wall panels with weather closures at eaves and rakes, and at perimeter of all openings. Fasten with self-tapping screws.
 - 7. Install screw fasteners in predrilled holes.
 - 8. Install flashing and trim as metal wall panel work proceeds.
 - 9. Apply elastomeric sealant continuously between metal base channel (sill angle) and concrete, and elsewhere as indicated on Drawings; if not indicated, as necessary for waterproofing.
 - 10. Align bottom of metal wall panels and fasten with blind rivets, bolts, or self-drilling or self-tapping screws.
 - 11. Provide weatherproof escutcheons for pipe and conduit penetrating exterior walls.
- B. Metal Wall Panels: Install metal wall panels on exterior side of girts. Attach metal wall panels to supports with fasteners as recommended by manufacturer.

3.5 METAL SOFFIT PANEL INSTALLATION

- A. Provide metal soffit panels the full width of soffits. Install panels perpendicular to support framing.
- B. Flash and seal metal soffit panels with weather closures where panels meet walls and at perimeter of all openings.

3.6 THERMAL INSULATION INSTALLATION

- A. General: Install insulation concurrently with metal panel installation, in thickness indicated to cover entire surface, according to manufacturer's written instructions.
 - 1. Set vapor-retarder-faced units with vapor retarder toward warm side of construction unless otherwise indicated. Do not obstruct ventilation spaces except for firestopping.
 - 2. Tape joints and ruptures in vapor retarder, and seal each continuous area of insulation to the surrounding construction to ensure airtight installation.
 - 3. Install factory-laminated, vapor-retarder-faced blankets straight and true in onepiece lengths, with both sets of facing tabs sealed, to provide a complete vapor retarder.
 - 4. Install blankets straight and true in one-piece lengths. Install vapor retarder over insulation, with both sets of facing tabs sealed, to provide a complete vapor retarder.
- B. Blanket Roof Insulation: Comply with the following installation method:
 - 1. Over-Framing Installation: Extend insulation and vapor retarder over and perpendicular to top flange of secondary framing. Hold in place by metal roof panels fastened to secondary framing.
 - 2. Between-Purlin Installation: Extend insulation and vapor retarder between purlins. Carry vapor-retarder-facing tabs up and over purlin, overlapping adjoining facing of next insulation course and maintaining continuity of retarder. Hold in place with bands and crossbands below insulation.
 - Over-Purlin-with-Spacer-Block Installation: Extend insulation and vapor retarder over and perpendicular to top flange of secondary framing. Install layer of filler insulation over first layer to fill space formed by metal roof panel standoffs. Hold in place by panels fastened to standoffs.
 - a. Thermal Spacer Blocks: Where metal roof panels attach directly to purlins, install thermal spacer blocks.
 - 4. Two-Layers-between-Purlin-with-Spacer-Block Installation: Extend insulation and vapor retarder between purlins. Carry vapor-retarder-facing tabs up and over purlin, overlapping adjoining facing of next insulation course and maintaining continuity of retarder. Install layer of filler insulation over first layer to fill space

between purlins formed by thermal spacer blocks. Hold in place with bands and crossbands below insulation.

- a. Thermal Spacer Blocks: Where metal roof panels attach directly to purlins, install thermal spacer blocks.
- 5. Retainer Strips: Install retainer strips at each longitudinal insulation joint, straight and taut, nesting with secondary framing to hold insulation in place.
- C. Blanket Wall Insulation: Extend insulation and vapor retarder over and perpendicular to top flange of secondary framing. Hold in place by metal wall panels fastened to secondary framing.
 - 1. Retainer Strips: Install retainer strips at each longitudinal insulation joint, straight and taut, nesting with secondary framing to hold insulation in place.

3.7 DOOR AND FRAME INSTALLATION

- A. General: Install doors and frames plumb, rigid, properly aligned, and securely fastened in place according to manufacturers' written instructions. Coordinate installation with wall flashings and other components. Seal perimeter of each door frame with elastomeric sealant used for metal wall panels.
- B. Personnel Doors and Frames: Install doors and frames according to NAAMM-HMMA 840.
 - 1. At fire-rated openings, install frames according to, and doors with clearances specified in, NFPA 80.
- C. Field Glazing: Comply with installation requirements in Section 088000 "Glazing."
- D. Door Hardware:
 - Install surface-mounted items after finishes have been completed at heights indicated in DHI's "Recommended Locations for Architectural Hardware for Standard Steel Doors and Frames."
 - 2. Set units level, plumb, and true to line and location. Adjust and reinforce attachment substrates as necessary for proper installation and operation.
 - 3. Drill and countersink units that are not factory prepared for anchorage fasteners. Space fasteners and anchors according to industry standards.
 - 4. Set thresholds for exterior doors in full bed of sealant complying with requirements for concealed mastics specified in Section 079200 "Joint Sealants."

3.8 WINDOW INSTALLATION

- A. General: Install windows plumb, rigid, properly aligned, without warp or rack of frames or sash, and securely fasten in place according to manufacturer's written instructions. Coordinate installation with wall flashings and other components. Seal perimeter of each window frame with elastomeric sealant used for metal wall panels.
 - 1. Separate dissimilar materials from sources of corrosion or electrolytic action at points of contact with other materials by complying with requirements specified in AAMA/WDMA/CSA 101/I.S.2/A440.
- B. Set sill members in bed of sealant or with gaskets, for weathertight construction.
- C. Install windows and components to drain condensation, water penetrating joints, and moisture migrating within windows to the exterior.
- D. Mount screens directly to frames with tapped screw clips.

3.9 ACCESSORY INSTALLATION

- A. General: Install accessories with positive anchorage to building and weathertight mounting, and provide for thermal expansion. Coordinate installation with flashings and other components.
 - 1. Install components required for a complete metal roof panel assembly, including trim, copings, ridge closures, seam covers, flashings, sealants, gaskets, fillers, closure strips, and similar items.
 - 2. Install components for a complete metal wall panel assembly, including trim, copings, corners, seam covers, flashings, sealants, gaskets, fillers, closure strips, and similar items.
 - 3. Where dissimilar metals contact each other or corrosive substrates, protect against galvanic action by painting contact surfaces with corrosion-resistant coating, by applying rubberized-asphalt underlayment to each contact surface, or by other permanent separation as recommended by manufacturer.
- B. Flashing and Trim: Comply with performance requirements, manufacturer's written installation instructions, and SMACNA's "Architectural Sheet Metal Manual." Provide concealed fasteners where possible, and set units true to line and level. Install work with laps, joints, and seams that will be permanently watertight and weather resistant.
 - 1. Install exposed flashing and trim that is without excessive oil-canning, buckling, and tool marks and that is true to line and levels indicated, with exposed edges folded back to form hems. Install sheet metal flashing and trim to fit substrates and to result in waterproof and weather-resistant performance.
 - 2. Expansion Provisions: Provide for thermal expansion of exposed flashing and trim. Space movement joints at a maximum of 10 feet (3 m) with no joints allowed


within 24 inches (600 mm) of corner or intersection. Where lapped or bayonet-type expansion provisions cannot be used or would not be sufficiently weather resistant and waterproof, form expansion joints of intermeshing hooked flanges, not less than 1 inch (25 mm) deep, filled with mastic sealant (concealed within joints).

- C. Gutters: Join sections with riveted-and-soldered or lapped-and-sealed joints. Attach gutters to eave with gutter hangers spaced as required for gutter size, but not more than 36 inches (914 mm) o.c. using manufacturer's standard fasteners. Provide end closures and seal watertight with sealant. Provide for thermal expansion.
- D. Downspouts: Join sections with 1-1/2-inch (38-mm) telescoping joints. Provide fasteners designed to hold downspouts securely 1 inch (25 mm) away from walls; locate fasteners at top and bottom and at approximately 60 inches (1524 mm) o.c. in between.
 - 1. Provide elbows at base of downspouts to direct water away from building.
 - 2. Tie downspouts to underground drainage system indicated.
- E. Circular Roof Ventilators: Set ventilators complete with necessary hardware, anchors, dampers, weather guards, rain caps, and equipment supports. Mount ventilators on flat level base. Install preformed filler strips at base to seal ventilator to metal roof panels.
- F. Continuous Roof Ventilators: Set ventilators complete with necessary hardware, anchors, dampers, weather guards, rain caps, and equipment supports. Join sections with splice plates and end-cap skirt assemblies where required to achieve indicated length. Install preformed filler strips at base to seal ventilator to metal roof panels.
- G. Roof Curbs: Install curbs at locations indicated on Drawings. Install flashing around bases where they meet metal roof panels.
- H. Pipe Flashing: Form flashing around pipe penetration and metal roof panels. Fasten and seal to panel as recommended by manufacturer.

3.10 FIELD QUALITY CONTROL

- A. Special Inspections: See Structural Drawings and Specification Section 01 40 15 "Special Inspections and Testing".
- B. Product will be considered defective if it does not pass tests and inspections.
- C. Prepare test and inspection reports.

END OF SECTION 13 34 10

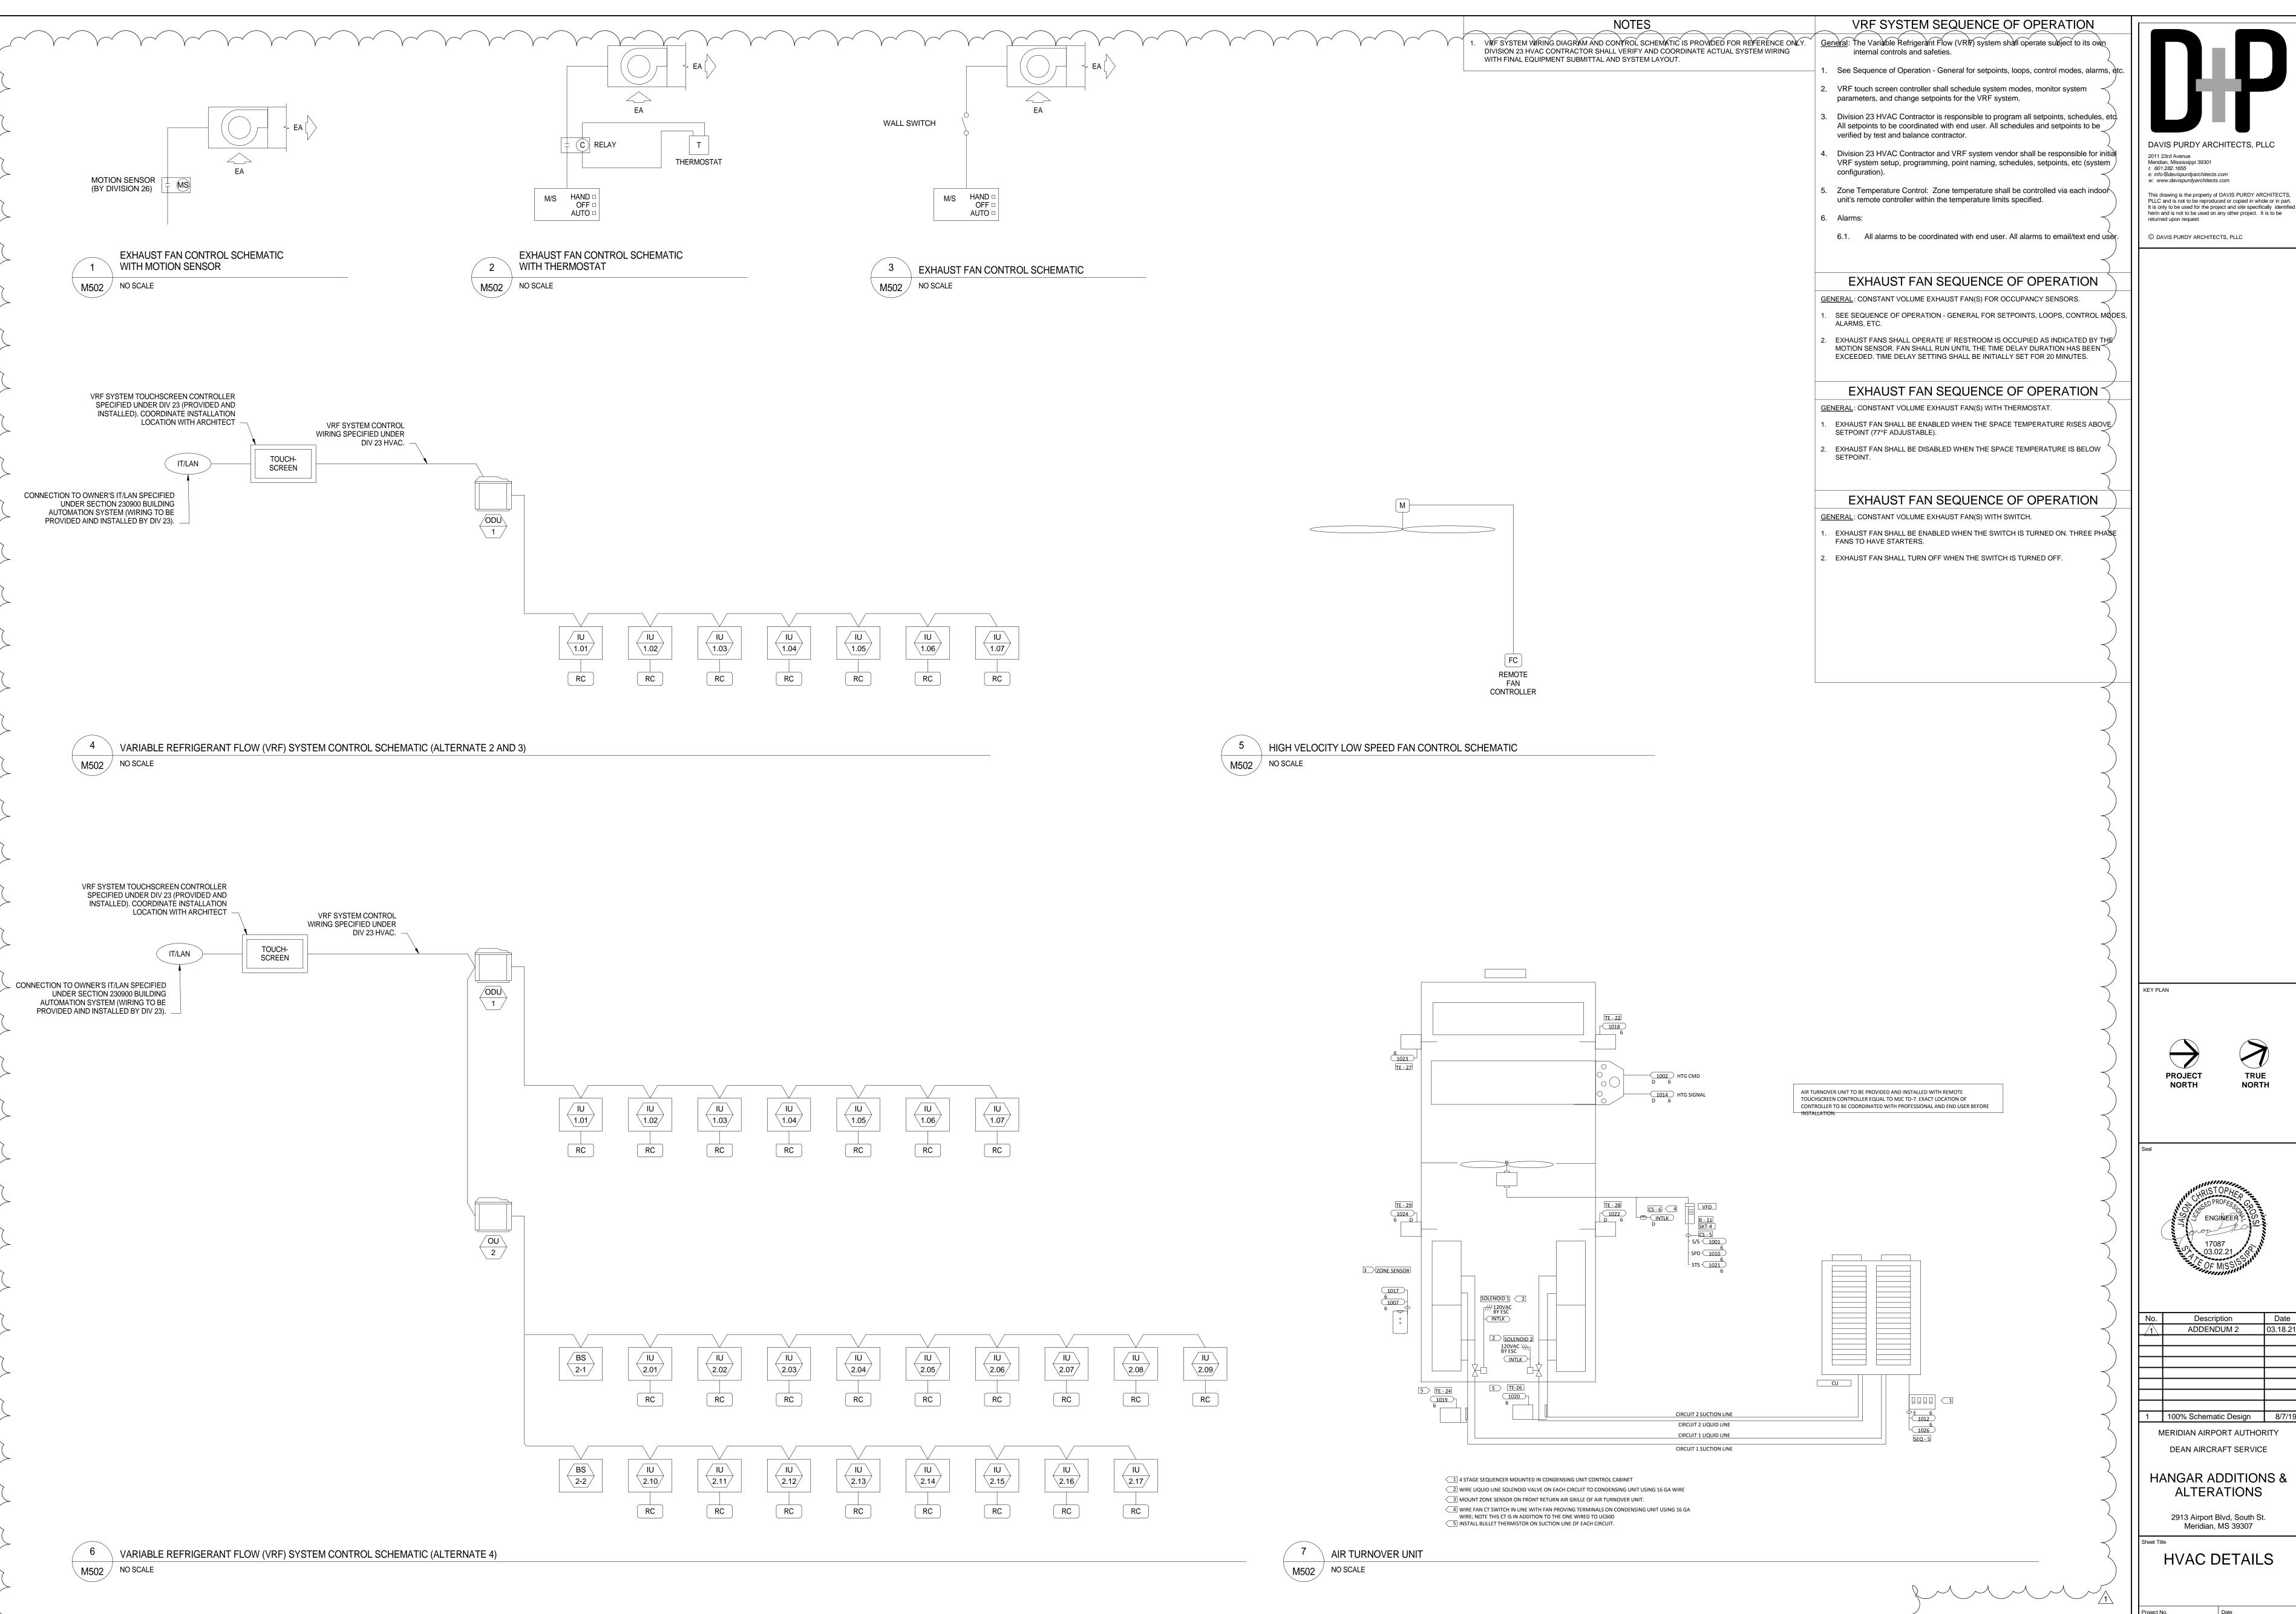

DAVIS PURDY ARCHITECTS, PLLC

2011 23rd Avenue
Meridian, Mississippi 39301
t: 601.282.1655
e: info@davispurdyarchitects.com
w: www.davispurdyarchitects.com This drawing is the property of DAVIS PURDY ARCHITECTS,

© DAVIS PURDY ARCHITECTS, PLLC

PROJECT

TRUE NORTH



Description ADDENDUM 2 1 100% Schematic Design 8/7/19 MERIDIAN AIRPORT AUTHORITY

DEAN AIRCRAFT SERVICE

HANGAR ADDITIONS & **ALTERATIONS**

> 2913 Airport Blvd, South St. Meridian, MS 39307

HVAC DETAILS

3/2/21 19-006 E R ENGINEERING RESOURCE GROUP

	ELECTRICAL LEGEND
GENERAL NOTES	FIRE ALARM SYSTEM
ALL EQUIPMENT AND DEVICES ARE TO BE FLUSH MOUNTED UNLESS OTHERWISE NOTED. DEVICES NOTED AS "GFI" SHALL BE GROUND FAULT CIRCUIT	MANUAL PULL STATION. MOUNT 48"A.F.F. TO CENTERLINE OF BOX.
INTERRUPTING DEVICES DEVICES NOTED AS "WP" SHALL BE WEATHERPROOF WHILE—IN—USE DEVICES NOTED AS "DL" SHALL BE RATED FOR DAMP LOCATION DEVICES NOTED AS "NL" SHALL BE NIGHT LIGHTS. PROVIDE UNSWITCHED POWER TO FIXTURE.	STROBE. MOUNT 80"A.F.F. TO BOTTOM OF BOX. COMBINATION HORN AND STROBE. MOUNT 80"A.F.F. TO BOTTOM OF BOX.
DEVICES NOTED AS "WG" SHALL BE PROVIDED AND INSTALLED WITH A WIRE GUARD. DEVICES NOTED AS "TR" SHALL BE TAMPER RESISTANT. PROVIDE UNSWITCHED POWER TO EMERGENCY BATTERY PACKS.	SMOKE DETECTOR. THERMAL DETECTOR.
LUMINAIRES (See Light Fixture Schedule) OTE: THE NUMBER INSIDE THE CIRCLE IS THE CIRCUIT NUMBER. THE LETTER BESIDE THE LYMBOL IS THE FIXTURE TYPE DESCRIBED IN THE LIGHT FIXTURE SCHEDULE.	DUCT SMOKE DETECTOR IN RETURN DUCT. DUCT SMOKE DETECTOR IN SUPPLY DUCT.
?	ELEVATOR RECALL SMOKE DETECTOR. FACE FIRE ALARM CONTROL PANEL.
2'X4' RECESSED FIXTURE.	FAAP FIRE ALARM ANNUNCIATOR PANEL.
1'X4' RECESSED FIXTURE.	FS FLOW SWITCH.
2'X4' RECESSED EMERGENCY FIXTURE.	TAMPER SWITCH. FIRE ALARM HORN AND STROBE MOUNTED ON THE CEILING TO
? ////// 1'X4' RECESSED EMERGENCY FIXTURE.	FAHS A FLUSH MOUNTED BOX.
SURFACE MOUNTED OR SUSPENDED FIXTURE.	FIRE ALARM STROBE MOUNTED ON THE CEILING TO A FLUSH MOUNTED BOX.
SURFACE MOUNTED OR SUSPENDED EMERGENCY FIXTURE.	RECEPTACLES
? RECESSED CEILING FIXTURE.	→ ? DUPLEX RECEPTACLE, NEMA 5-20R, MOUNTED 18" A.F.F. TO CENTERLINE OF BOX UNLESS NOTED OTHERWISE.
? RECESSED EMERGENCY CEILING FIXTURE.	? DOUBLE DUPLEX RECEPTACLE, NEMA 5-20R, ONE COVER PLATE, MOUNTED 18" A.F.F. TO CENTERLINE OF BOX UNLESS NOTED OTHERWISE.
? CEILING MOUNTED EXIT SIGN. PROVIDE CHEVRONS AS INDICATED BY ARROWS.	DOUBLE DUPLEX RECEPTACLE, NEMA 5-20R, ONE COVER PLATE, MOUNTED WITH BOTTOM OF BOX 2" ABOVE COUNTER BACKSPLASH. WHERE THERE IS NO BACKSPLASH MOUNT 6" ABOVE COUNTER. WHERE RECEPTACLE IS SHOWN IN AN AREA
EXIT SIGN WITH EMERGENCY LIGHTING.	WITH NO COUNTER, MOUNT 45"A.F.F. TO CENTERLINE OF BOX. DUPLEX RECEPTACLE, NEMA 5-20R, MOUNTED WITH BOTTOM OF
WALL MOUNTED EXIT SIGN. PROVIDE CHEVRONS AS INDICATED BY ARROWS. WALL MOUNTED FIXTURE.	BOX 2" ABOVE COUNTER BACKSPLASH. WHERE THERE IS NO BACKSLPASH MOUNT 6" ABOVE COUNTER. WHERE RECEPTACLE IS SHOWN IN AN AREA WITH NO COUNTER, MOUNT 45"A.F.F. TO CENTERLINE OF BOX.
WALL MOUNTED LINEAR FIXTURE.	DUPLEX RECEPTACLE, NEMA 5-20R, FOR DRINKING FOUNTAIN FED FROM GFCI BREAKER. MOUNTED IN ACCORDANCE WITH MANUFACTURER'S ROUGH-IN REQUIREMENTS. VERIFY
WALL MOUNTED EMERGENCY LINEAR FIXTURE.	CONNECTION TYPE PRIOR TO BID. PROVIDE PROPER EQUIPMENT FOR CONNECTION TYPE REQUIRED. DUPLEX RECEPTACLE, NEMA 5-20R, MOUNTED IN A FLOOR BOX.
? SITE ARM MOUNT POLE LIGHT FIXTURE.	? DOUBLE DUPLEX RECEPTACLE, NEMA 5-20R, MOUNTED IN A
₹? ₹? ₹? SURFACE MOUNTED TRACK AND TRACK LIGHTING FIXTURE.	FLOOR BOX. SINGLE RECEPTACLE, NEMA 14-50R. PROVIDE 6' CORD AND
MISCELLANEOUS	MATCHING PLUG WHERE REQUIRED. MOUNTING DETERMINED BY NEC FOR TYPE OF EQUIPMENT BEING CONNECTED.
© CONTACTOR.	SINGLE RECEPTACLE, NEMA 6-30R, MOUNTED 18" A.F.F. TO CENTERLINE OF BOX UNLESS NOTED OTHERWISE.
PE PHOTOCELL.	SINGLE RECEPTACLE, NEMA $6-20R$, MOUNTED 36 " A.F.F. TO -9 ? CENTERLINE OF BOX UNLESS NOTED OTHERWISE
① CEILING MOUNTED JUNCTION BOX.	? DUPLEX RECEPTACLE, NEMA 5-20R, MOUNTED FLUSH IN THE CEILING UNLESS NOTED OTHERWISE.
	\leftrightarrow ? APPLETON 009391 RECEPTACLE. 208 30, 60A, 4W
SWITCHES	ACCESS CONTROL
\$ SINGLE-POLE, SINGLE-THROW SWITCH. MOUNT CENTERLINE OF BOX AT 45"A.F.F. UNLESS NOTED OTHERWISE.	CARD READER. 4" GANG BOX WITH SINGLE GANG EXTENSION RING.
DOUBLE—POLE, SINGLE—THROW, 30 AMP SWITCH. MOUNT CENTERLINE OF BOX AT 45"A.F.F. UNLESS NOTED OTHERWISE.	ACCESS CONTROL PANEL. PS POWER SUPPLY
THREE—WAY SWITCH. MOUNT CENTERLINE OF BOX AT 45"A.F.F.	
UNLESS NOTED OTHERWISE. FOUR-WAY SWITCH. MOUNT CENTERLINE OF BOX AT 45"A.F.F. UNLESS NOTED OTHERWISE.	COMMUNICATIONS TELEPHONE CONNECTION FOR ELEVATOR CONTROLLER. INCLUDE
LED DIMMER EQUAL TO LEVITON #IP710-LFZ MOUNT CENTERLINE OF BOX AT 45"A.F.F. UNLESS NOTED OTHERWISE.	ALL CABLING AND ACTIVATION OF TELEPHONE SERVICE. ROUTE CABLE INTO THE ELEVATOR CONTROLLER.
	DATA OUTLET MOUNTED 18" A.F.F. TO CENTERLINE OF BOX
ALITOMATIC WALL SWITCH SENSORSWITCH #WSD_DDT OR	UNLESS NOTED OTHERWISE. 4" GANG BOX WITH SINGLE GANG EXTENSION RING.
AUTOMATIC WALL SWITCH. SENSORSWITCH #WSD-PDT OR APPROVED EQUAL. MOUNT CENTERLINE OF BOX AT 45" A.F.F. UNLESS NOTED OTHERWISE. AUTOMATIC WALL SWITCH WITH INTEGRAL 0-10V DIMMER. SENSORSWITCH #WSX-PDT-D-VA OR APPROVED EQUAL. MOUNT	UNLESS NOTED OTHERWISE. 4" GANG BOX WITH SINGLE GANG EXTENSION RING. DATA OUTLET MOUNTED WITH BOTTOM OF BOX 2" ABOVE COUNTER BACKSPLASH. WHERE THERE IS NO BACKSPLASH MOUNT 6" ABOVE COUNTER. WHERE TELEPHONE/DATA OUTLET IS SHOWN IN AN AREA WITH NO COUNTER, MOUNT 45" A.F.F. TO










CEILING MOUNTED. SENSORSWITCH #CM-PDT-9 OR APPROVED EQUAL. **PASSIVE INFRARED AND ULTRASONIC DUAL TECHNOLOGY OCCUPANCY SENSOR WITH A 28" RADIAL COVERAGE. CEILING MOUNTED. SENSORSWITCH #CM-PDT-10 OR APPROVED EQUAL. **PASSIVE INFRARED AND ULTRASONIC DUAL TECHNOLOGY OCCUPANCY SENSOR WITH A 2000 SQ. FT. COVERAGE. MOUNT IMMEDIATELY BELOW CEILING. SENSORSWITCH #WV-PDT-16 OR APPROVED EQUAL. **POWER PACK MOUNTED ABOVE CEILING. SENSORSWITCH #PP20 OR APPROVED EQUAL. **INTRUSION DETECTION SYSTEM** **CCTV SYSTEM** **CCTV SYSTEM** **CEILING MOUNTED CAMERA.** **WALL MOUNTED CAMERA.** **WALL MOUNTED CAMERA.** **UNSIDE CORNER MOUNTED CAMERA.** **OUNTED.** **INSIDE CORNER MOUNTED CAMERA.** **OUNTED.**	UNLESS NOTED OTHERWISE. 4" GANG BOX WITH SINGLE GANG EXTENSION RING. DATA OUTLET MOUNTED WITH BOTTOM OF BOX 2" ABOVE COUNTER BACKSPLASH. WHERE THERE IS NO BACKSPLASH MOUNT 6" ABOVE COUNTER. WHERE TELEPHONE/DATA OUTLET IS SHOWN IN AN AREA WITH NO COUNTER, MOUNT 45" A.F.F. TO CENTERLINE OF BOX. 4" GANG BOX WITH SINGLE GANG EXTENSION RING. COMBINATION TELEPHONE/DATA OUTLET MOUNTED IN A FLOOR BOX. DUPLEX RECEPTACLE, NEMA 5-20R AND A COMBINATION TELEPHONE/DATA OUTLET MOUNTED IN A FLOOR BOX. DOUBLE DUPLEX RECEPTACLE, NEMA 5-20R AND A COMBINATION TELEPHONE/DATA OUTLET MOUNTED IN A FLOOR BOX. TELEVISION CABLE OUTLET MOUNTED IN A FLOOR BOX. TELEVISION CABLE OUTLET MOUNTED 18" A.F.F. TO CENTERLINE OF BOX UNLESS NOTED OTHERWISE. DATA OUTLET MOUNTED IN THE CEILING. WIRELESS ACCESS POINT. CONDUCTORS IN CONDUIT CONCEALED WITHIN WALL OR CEILING. TIC MARKS INDICATE NUMBER OF CONDUCTORS. THE EQUIPMENT GROUNDING CONDUCTOR IS NOT SHOWN, BUT SHALL BE PROVIDED. SIZE THE EQUIPMENT GROUNDING CONDUCTOR SHOULD BE PROVIDED. FOR EXAMPLE, THE MARKINGS TO THE LEFT SIGNIFY THAT THREE CONDUCTORS PLUS AN
AUTOMATIC WALL SWITCH. SENSORSWITCH #WSD-PDT OR APPROVED EQUAL. MOUNT CENTERLINE OF BOX AT 45" A.F.F. UNLESS NOTED OTHERWISE. AUTOMATIC WALL SWITCH WITH INTEGRAL 0-10V DIMMER. SENSORSWITCH #WSX-PDT-D-VA OR APPROVED EQUAL. MOUNT CENTERLINE OF BOX AT 45"A.F.F. UNLESS NOTED OTHERWISE. THORSEPOWER RATED SWITCH WITH THERMAL OVERLOADS (MANUAL MOTOR STARTER). PASSIVE INFRARED AND ULTRASONIC DUAL TECHNOLOGY OCCUPANCY SENSOR WITH A 12" RADIAL COVERAGE. CEILING MOUNTED. SENSORSWITCH #CM-PDT-9 OR APPROVED EQUAL. PASSIVE INFRARED AND ULTRASONIC DUAL TECHNOLOGY OCCUPANCY SENSOR WITH A 28" RADIAL COVERAGE. CEILING MOUNTED. SENSORSWITCH #CM-PDT-10 OR APPROVED EQUAL. PASSIVE INFRARED AND ULTRASONIC DUAL TECHNOLOGY OCCUPANCY SENSOR WITH A 2000 SQ. FT. COVERAGE. MOUNT IMMEDIATELY BELOW CEILING. SENSORSWITCH #WV-PDT-16 OR APPROVED EQUAL. POWER PACK MOUNTED ABOVE CEILING. SENSORSWITCH #PP20 OR APPROVED EQUAL. INTRUSION DETECTION SYSTEM CCTV SYSTEM CEILING MOUNTED CAMERA. WALL MOUNTED CAMERA.	UNLESS NOTED OTHERWISE. 4" GANG BOX WITH SINGLE GANG EXTENSION RING. ATA OUTLET MOUNTED WITH BOTTOM OF BOX 2" ABOVE COUNTER BACKSPLASH. WHERE THERE IS NO BACKSPLASH MOUNT 6" ABOVE COUNTER. WHERE TELEPHONE/DATA OUTLET IS SHOWN IN AN AREA WITH NO COUNTER, MOUNT 45" A.F.F. TO CENTERLINE OF BOX. 4" GANG BOX WITH SINGLE GANG EXTENSION RING. COMBINATION TELEPHONE/DATA OUTLET MOUNTED IN A FLOOR BOX. DUPLEX RECEPTACLE, NEMA 5–20R AND A COMBINATION TELEPHONE/DATA OUTLET MOUNTED IN A FLOOR BOX. DUBLED DUPLEX RECEPTACLE, NEMA 5–20R AND A COMBINATION TELEPHONE/DATA OUTLET MOUNTED IN A FLOOR BOX. TELEVISION CABLE OUTLET MOUNTED IN A FLOOR BOX. DATA OUTLET MOUNTED IN THE CEILING. WIRELESS ACCESS POINT. CONDUIT AND WIRING CONDUCTORS IN CONDUIT CONCEALED WITHIN WALL OR CEILING. TIC MARKS INDICATE NUMBER OF CONDUCTORS. THE EQUIPMENT GROUNDING CONDUCTOR IS NOT SHOWN, BUT SHALL BE PROVIDED. SIZE THE EQUIPMENT GROUNDING CONDUCTOR SHOULD BE PROVIDED. FOR EXAMPLE, THE MEC. THE ABSENCE OF TIC MARKS SIGNIFIES THAT TWO CONDUCTORS PLUS AN EQUIPMENT GROUNDING CONDUCTOR SHOULD BE PROVIDED. THE LEFT SIGNIFY THAT THREE CONDUCTORS PLUS AN EQUIPMENT GROUNDING CONDUCTOR SHOULD BE PROVIDED. THE TEXT INSIDE THE ARC INDICATES THE AWG SIZE OF THE CONDUCTORS THAT SHALL BE RUN IN THE CONDUIT.

CONDUCTORS IN CONDUIT CONCEALED BELOW GRADE OR

FLOOR. TIC MARKS INDICATE NUMBER OF CONDUCTORS.

THE EQUIPMENT GROUNDING CONDUCTOR IS NOT SHOWN,
BUT SHALL BE PROVIDED. SIZE THE EQUIPMENT
GROUNDING CONDUCTOR AND THE CONDUIT PER THE NEC.
THE ABSENCE OF TIC MARKS SIGNIFIES THAT TWO

CONDUCTORS PLUS AN EQUIPMENT GROUNDING CONDUCTOR

SHOULD BE PROVIDED. THE MARKINGS TO THE LEFT SIGNIFY THAT THREE CONDUCTORS PLUS AN EQUIPMENT

HOMERUN TO PANELBOARD. ARC DENOTES CONCEALED

CIRCUIT NUMBER. DEVICES HAVING CIRCUIT NUMBERS

PARTIAL HOMERUN TO PANELBOARD. COMBINE ALL PARTIAL

LOW VOLTAGE CONDUCTORS USED FOR MOTION DETECTOR

CIRCUITRY. SEE MANUFACTURER'S RECOMMENDATIONS FOR

LOCATED BESIDE THEM MAY NOT SHOW THE CIRCUIT

HOMERUNS THAT ARE ON THE SAME CIRCUIT IN A JUNCTION BOX PRIOR TO ENTERING THE PANELBOARD.

GROUNDING CONDUCTOR SHOULD BE PROVIDED.

CIRCUITRY. TEXT DENOTES PANELBOARD NAME WITH

NUMBERS AT THE HOMERUN ARROWS.

CONDUCTOR REQUIREMENTS.

7/?/? FUSED DISCONNECT SWITCH. TEXT INDICATES AMPACITY/NUMBER

COMBINATION CIRCUIT BREAKER AND MAGNETIC MOTOR STARTER.

DOOR BELL SYSTEM

of Poles/Enclosure Type; F-(RATING OF FUSES).

 $rac{2!7!}{F-?}$ COMBINATION FUSED DISCONNECT AND MAGNETIC MOTOR

DOOR BELL WEATHERPROOF INDUSTRIAL PUSHBUTTON.

TRANSFORMER MOUNTED ABOVE CEILING.

?/?/? NON-FUSED DISCONNECT SWITCH. TEXT INDICATES

riangle AMPACITY/NUMBER OF POLES/ENCLOSURE TYPE.

MAGNETIC MOTOR STARTER.

STARTER.

NEMA SIZE?


? PANELBOARD.


industrial Chime.

Volto	ige	Circuit Length	Conductor Size (AWG)
120)	< 50'	#12
120)	> 50'	#10
120)	> 90'	#8
120)	> 140'	#6
277	7	< 130'	#12
277	7	> 130'	#10
277	7	> 200'	#8
277	7	> 330'	#6
1) CIRCUI	DROP CHART SIZES INDI ENTS. REFE	CATED ON THE DRAWIN	NGS ARE MINIMUM R UPSIZING CONDUCTORS AS
		CONDUCTORS LARGER ITCH. PROVIDE A JUN 12 AT THE DEVICE.	THAN #10 DIRECTLY TO A NCTION BOX TO DOWNSIZE
		GER THAN THOSE LIST ONDUCTOR SIZES.	ED ABOVE, CONSULT WITH

	LIGE	HTING FIX	TURI	E SC	
TYPE	MANUFACTURER	PART NUMBER	LAMPS	MOUNTING	REMARKS
Α	LITHONIA	EPANL-2X4-5400LM-80CRI-50K- ZT-MVOLT	LED — 49W 5,679.41 LUMENS	RECESSED	
ΑE	LITHONIA	EPANL-2X4-5400LM-80CRI 50K- ZT-MVOLT-E10WCP	LED — 49W 5,679.41 LUMENS	RECESSED	WITH 120V EMERGENCY BATTERY PACK
В	LITHONIA	EPANL-2X4-4000LM-80CRI-50K- ZT-MVOLT	LED - 38W 4,240 LUMENS	RECESSED	
BE	LITHONIA	EPANL-2X4-4000LM-80CRI 50K- ZT-MVOLT-E10WCP	LED — 38W 4,240 LUMENS	RECESSED	WITH 120V EMERGENCY BATTERY PACK
С	LITHONIA	EPANL-2X4-3000LM-80CRI 50K- ZT-MVOLT	LED — 29W 3,267 LUMENS	RECESSED	
CE	LITHONIA	EPANL-2X4-3000LM-80CRI-50K- ZT-MVOLT-E10WCP	LED — 29W 3,267 LUMENS	RECESSED	WITH 120V EMERGENCY BATTERY PACK
D	LITHONIA	LDN6/50/10-L06/AR-LS-MVOLT- GZ10 2	LED - 10.4W 950.1 LUMENS	RECESSED	
DE	LITHONIA	LDN6/50/10-LO6/AR-LS-MVOLT- GZ10-ELR/2	LED - 10.4W 950.1 LUMENS	RECESSED	WITH 120V EMERGENCY BATTERY PACK
EP	LITHONIA	FEM-L48-4000LM-LPPFL-WD-MVOLT- GZ10-50K-80CRI-E10WMCP-CNP164CWWL	LED - 23.8W 3,595 LUMENS	WALL	WITH 120V EMERGENCY BATTERY PACK
F	LITHONIA	LDN6/50/15-L06/AR-LS-MVOLT- GZ10	LED - 17.5W 1,514 LUMENS	RECESSED	
FE	LITHONIA	LDN6/50/15-LO6/AR-LS-MVOLT- GZ10-ELR/2	LED - 17.5W 1,514 LUMENS	RECESSED	WITH 120V EMERGENCY BATTERY PACK
G	LITHONIA 🖄	ZLNN-L48-5000LM-FST-MVOLT- (50K)-80CRI-(**	LED — 34W 4585 LUMENS	SURFACE/ SUSPENDED	* - FINISH BY ARCHITECT
GE	LITHONIA 🖄	ZLNN-L48-5000LM-FST-MVOLT- (50K)-80CRI-E10WLCP-*	LED — 34W 4585 LUMENS	SURFACE/ SUSPENDED	WITH 120V EMERGENCY BATTERY PACK * - FINISH BY ARCHITECT
Н	LITHONIA	IBG-60000LM-SEF-PCL-GND-MVOLT- GZ10+50K+80CRI-*	LED - 365W 57,621LUMENS	SURFACE/ SUSPENDED	* - FINISH BY ARCHITECT
HE	LITHONIA	IBG-60000LM-SEF-PCL-GND-MVOLT- GZ10+50K+80CRI-IE30WCPHE-*	LED - 365W 57,621LUMENS	SURFACE/ SUSPENDED	WITH 120V EMERGENCY BATTERY PACK * - FINISH BY ARCHITECT
H2	LITHONIA	IBGN-24000LM-SEF-AFL-WD-MVOLT- MVOLT-GZ10-50K-80CRI-*	LED — 146W 25,035 LUMENS	SURFACE/ SUSPENDED	* - FINISH BY ARCHITECT
H2E	LITHONIA	IBGN-24000LM-SEF-AFL-WD-MVOLT- MVOLT-GZ1&-50K-8&CRI-IE30WCPHE-*	LED — 146W 25,035 LUMENS	SURFACE/ SUSPENDED	WITH 120V EMERGENCY BATTERY PACK * - FINISH BY ARCHITECT
J	LITHONIA	WST LED-P1 (50K) VW-120-PE-*	LED — 12W 1659 LUMENS	WALL	*COLOR BY ARCHITECT.
JE	LITHONIA	WST LED-P1 (50K) VW-120-PE-* E7WH	LED — 12W 1659 LUMENS	WALL	*COLOR BY ARCHITECT. WITH EMERGENCY BATTERY PACK.
K	ALW	SP4SMB-S5-MED/80/5000K-0/10/0%- CR/S-N-N-N-N-N-N-N-X-UNV	LED - 21.6W 2,800 LUMENS	SURFACE/ WALL	* - FINISH BY ARCHITECT
KE	ALW	SP4SMB-S5-MED/80/5000K+0/10/0%- CR/S-N-N-N-N-N-N-N-*-UNV-EMB/1	LED - 21.6W 2,800 LUMENS	SURFACE/ WALL	* - FINISH BY ARCHITECT WITH 120V EMERGENCY BATTERY APACK
L	LITHONIA	LIL LED 50K MVOLT-PE-*	LED — 8.4W 800 LUMENS	WALL	* - FINISH BY ARCHITECT
SA	NLS LIGHTING	VUE-1-T4-64L-1-50K-UNV-WM- *-PC	LED — 205W 20,705 LUMENS	WALL	*COLOR BY ARCHITECT.
SB	NLS LIGHTING	VUE-3-T4-192L-1 50K UNV-KM-*	LED - 594W 61,182 LUMENS	WALL	*COLOR BY ARCHITECT.
Χ	LITHONIA	LQM-S-3-R-120/277-EL N	LED	UNIVERSAL	
KEM	LITHONIA	LHQM-LED-R	LED	UNIVERSAL	


Mark	Description
1	REFER TO ARCHITECTURAL DRAWINGS FOR BASE BID AND ALL ALTERNATE DESCRIPTIONS.

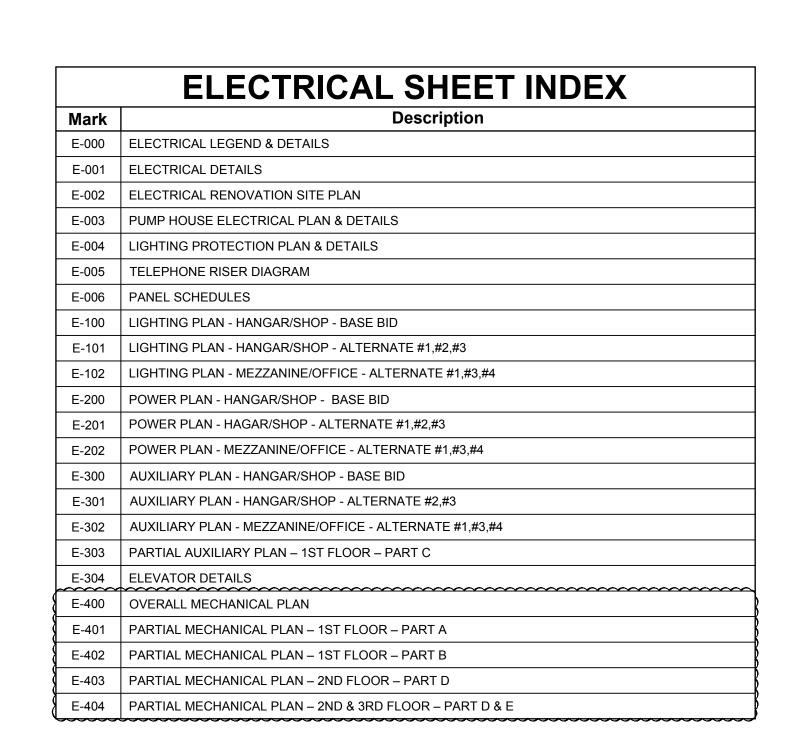

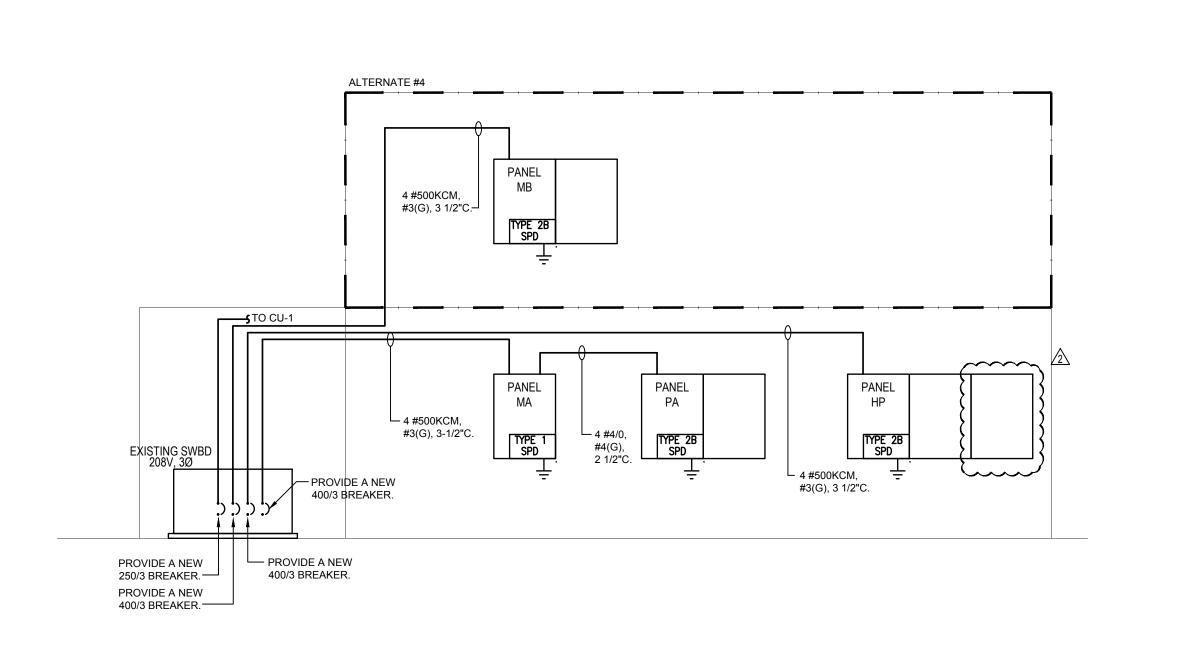






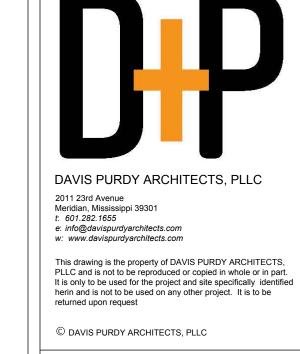

PROJECT Description ADDENDUM #2 1 100% Construction Doc. MERIDIAN AIRPORT AUTHORITY DEAN AIRCRAFT SERVICE HANGAR ADDITIONS & **ALTERATIONS** 2913 Airport Blvd, South St. Meridian, MS 39307 ELECTRICAL LEGEND

19-006 3/03/2021

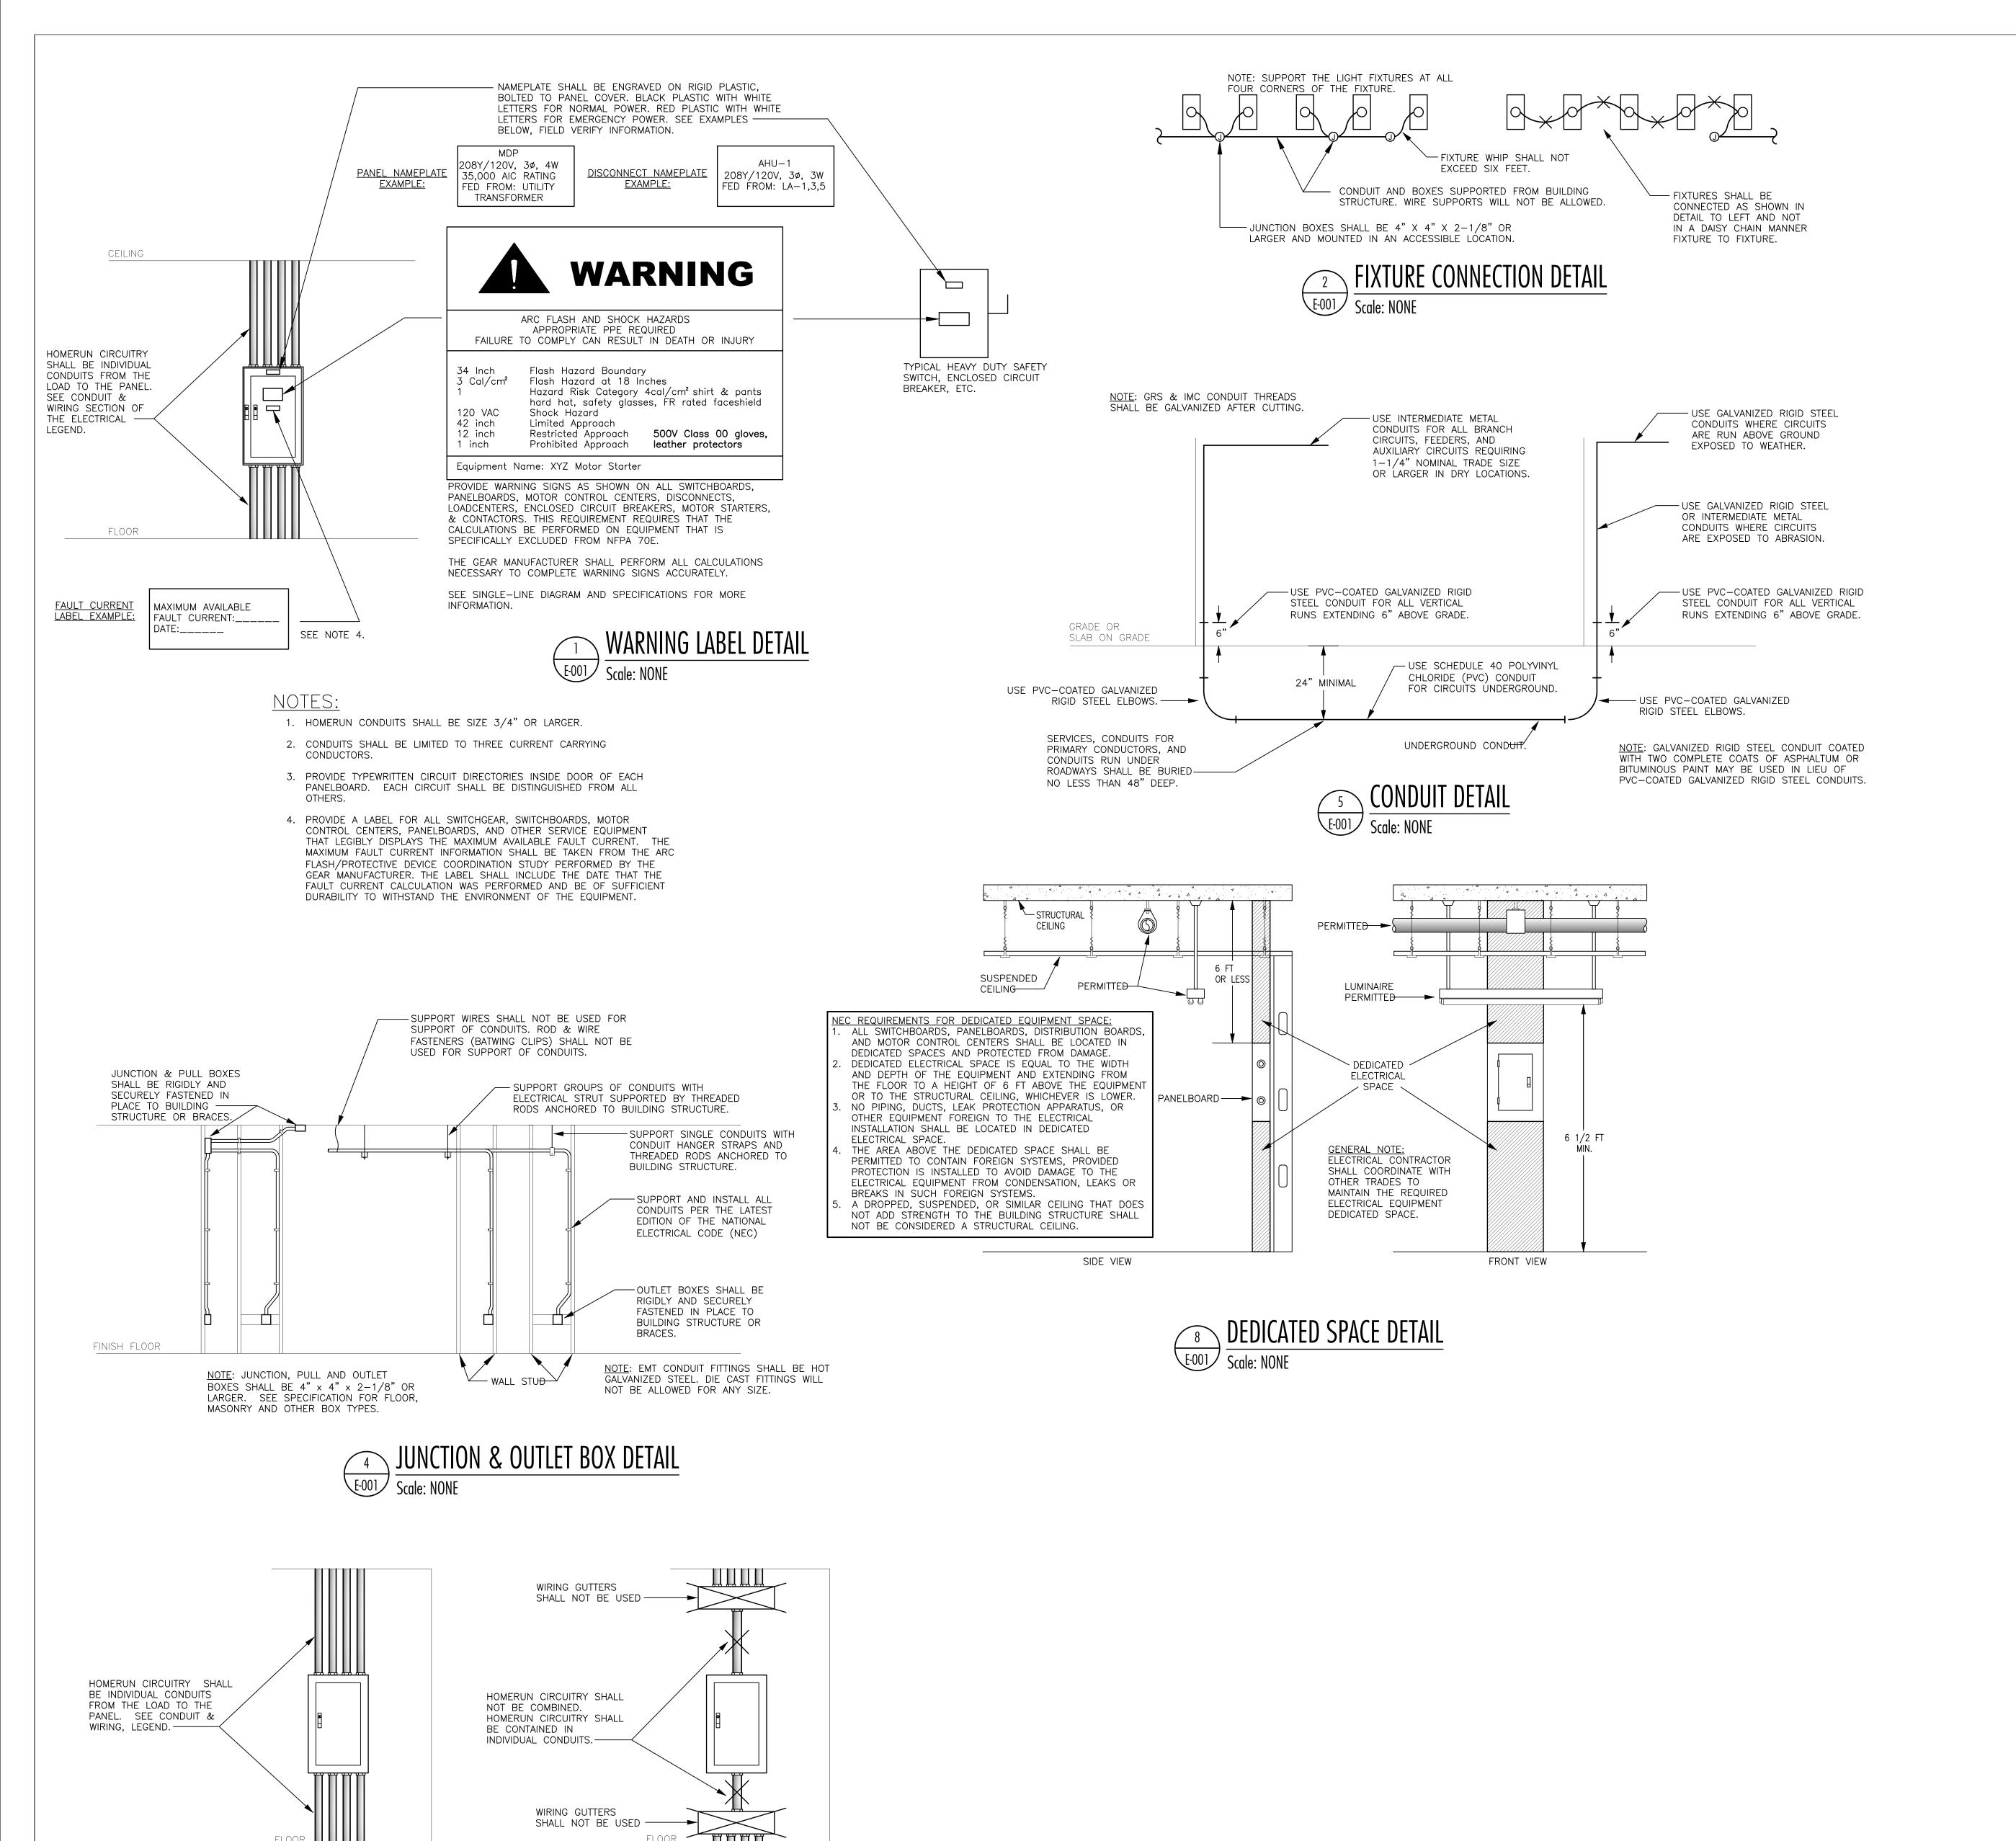

NOTES:


1. HOMERUN CONDUITS SHALL BE SIZE

2. CONDUITS SHALL BE LIMITED TO THREE CURRENT CARRYING CONDUCTORS

3/4" OR LARGER.



- A. THESE DRAWINGS ARE BASED ON THE BEST INFORMATION AVAILABLE AT THE TIME OF DESIGN. COORDINATE WITH THE MILLWORK CONTRACTOR TO DETERMINE THE EXACT LOCATION OF OUTLETS BEING PLACED IN AND AROUND MILLWORK.
- B. RECEPTACLES SHOWN AS GFI MAY BE NON GFI TYPE RECEPTACLES IF FED FROM A 20/1 GFI BREAKER OR THE LOAD SIDE OF A GFI RECEPTACLE IN THE SAME ROOM, ON THE SAME CIRCUIT AND RATED 20 AMP FEED—THRU CAPACITY. COVER PLATES SHALL BE CLEARLY MARKED GFI.
- C. NON GFI RECEPTACLES SHALL NOT BE CONNECTED IN A FEED-THRU MANNER. WIRE CONNECTIONS IN RECEPTACLE BOXES SHALL BE MADE IN A

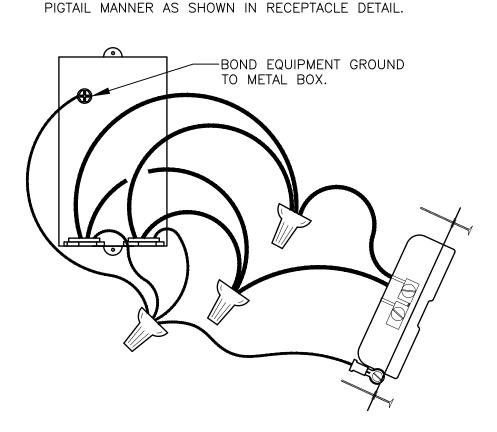





Voice (601) 605-4820

Fax (601) 605-4875

TPS Proj. # 19111

DAVIS PURDY ARCHITECTS, PLLC
2011 23rd Avenue
Meridian, Mississippi 39301
t. 601.282.1655
e: info@davispurdyarchitects.com
w: www.davispurdyarchitects.com

This drawing is the property of DAVIS PURDY ARCHITECTS, PLLC and is not to be reproduced or copied in whole or in part. It is only to be used for the project and site specifically identified herin and is not to be used on any other project. It is to be returned upon request

© DAVIS PURDY ARCHITECTS, PLLC

AER/L PROFESSION OF MI

KEY PLAN



TRUE

NORTH

o. Description Date

ADDENDUM #2 03/18 100% Construction Doc. 03/03

MERIDIAN AIRPORT AUTHORITY

DEAN AIRCRAFT SERVICE

HANGAR ADDITIONS & ALTERATIONS

2913 Airport Blvd, South St. Meridian, MS 39307

ELECTRICAL DETAILS

Date 19-006 3/03/2021

E-001

GENERAL NOTES

Mark

Description

1. REFER TO ARCHITECTURAL DRAWINGS FOR BASE BID AND ALL ALTERNATE DESCRIPTIONS.





DAVIS PURDY ARCHITECTS, PLLC 2011 23rd Avenue
Meridian, Mississippi 39301
t: 601.282.1655
e: info@davispurdyarchitects.com
w: www.davispurdyarchitects.com This drawing is the property of DAVIS PURDY ARCHITECTS, PLLC and is not to be reproduced or copied in whole or in part. It is only to be used for the project and site specifically identified herin and is not to be used on any other project. It is to be returned upon request © DAVIS PURDY ARCHITECTS, PLLC





Description

ADDENDUM #2 1 100% Construction Doc. MERIDIAN AIRPORT AUTHORITY

DEAN AIRCRAFT SERVICE


HANGAR ADDITIONS & ALTERATIONS


2913 Airport Blvd, South St. Meridian, MS 39307

PLAN

Sheet Title ELECTRICAL RENOVATION SITE

19-006 Date 3/03/2021

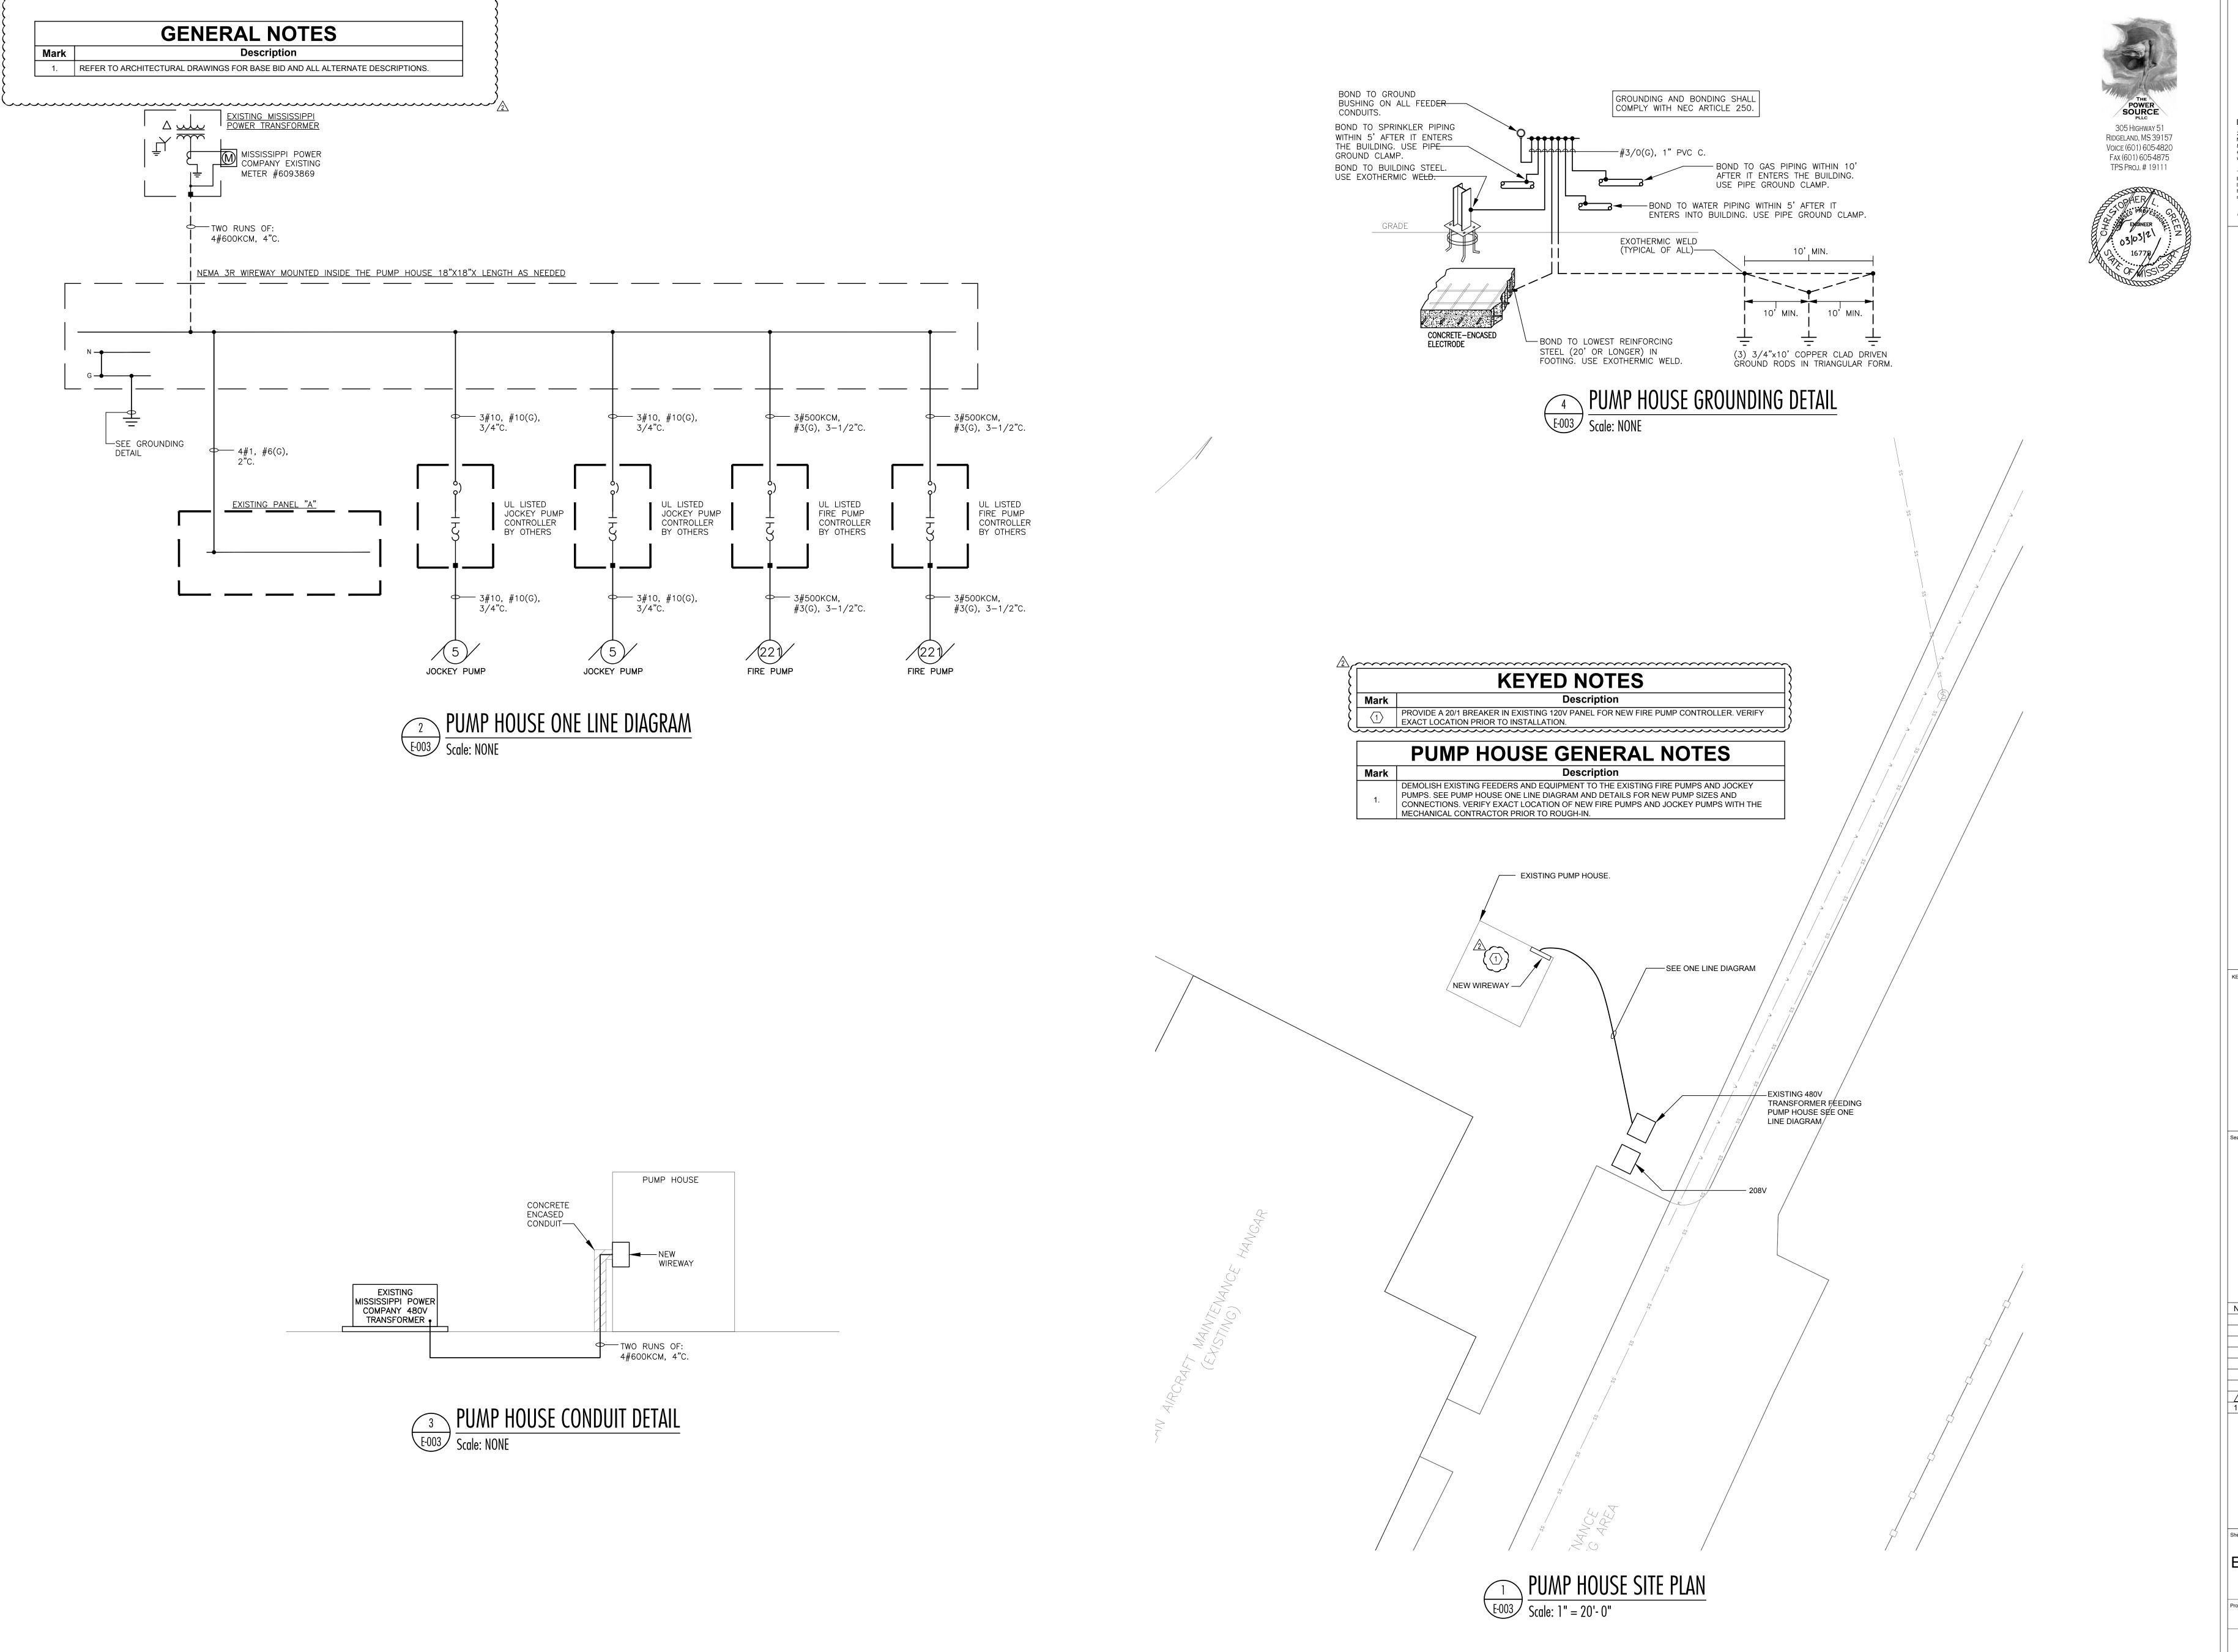

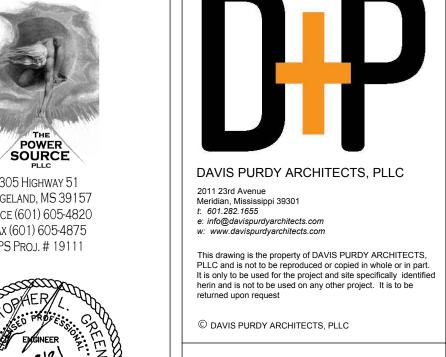

PROJECT NORTH

Description

ADDENDUM #2 1 100% Construction Doc.

MERIDIAN AIRPORT AUTHORITY DEAN AIRCRAFT SERVICE

HANGAR ADDITIONS & ALTERATIONS

2913 Airport Blvd, South St. Meridian, MS 39307


PUMP HOUSE ELECTRICAL PLAN &


DETAILS


19-006 3/03/2021


GENERAL NOTES REFER TO ARCHITECTURAL DRAWINGS FOR BASE BID AND ALL ALTERNATE DESCRIPTIONS.

Mark

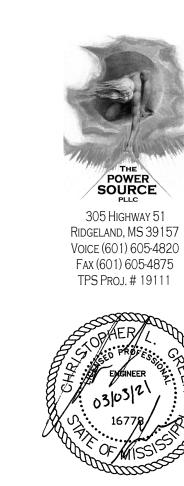

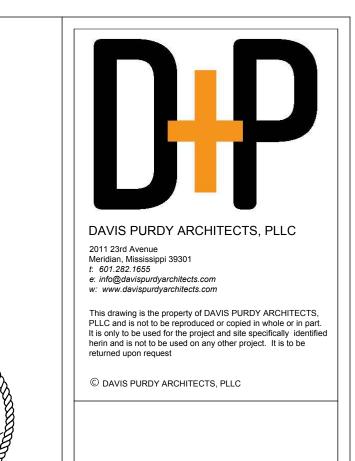

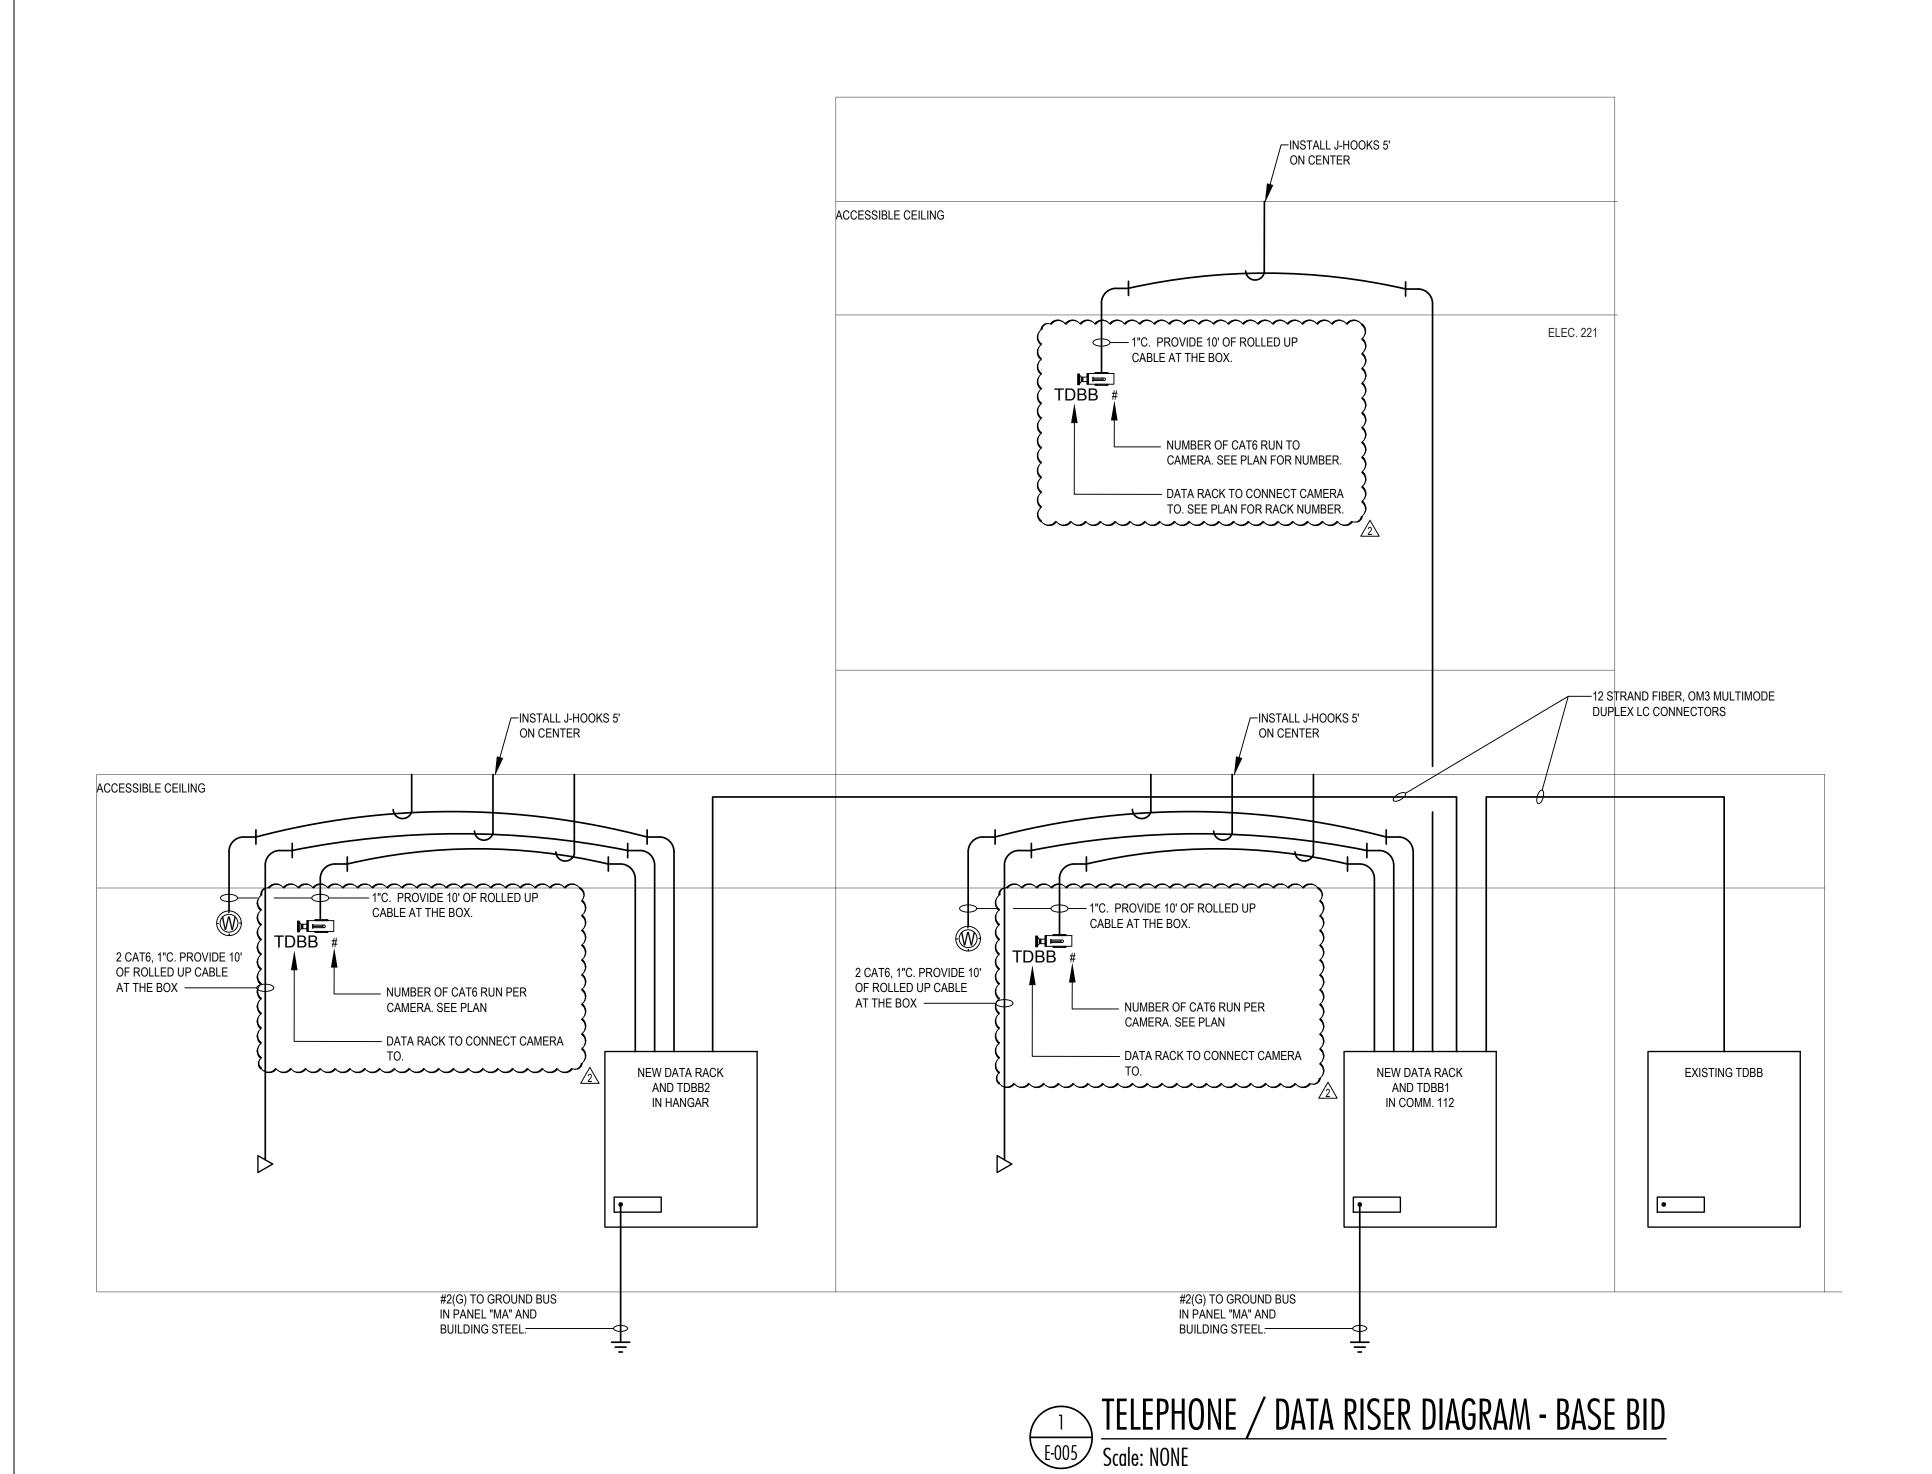

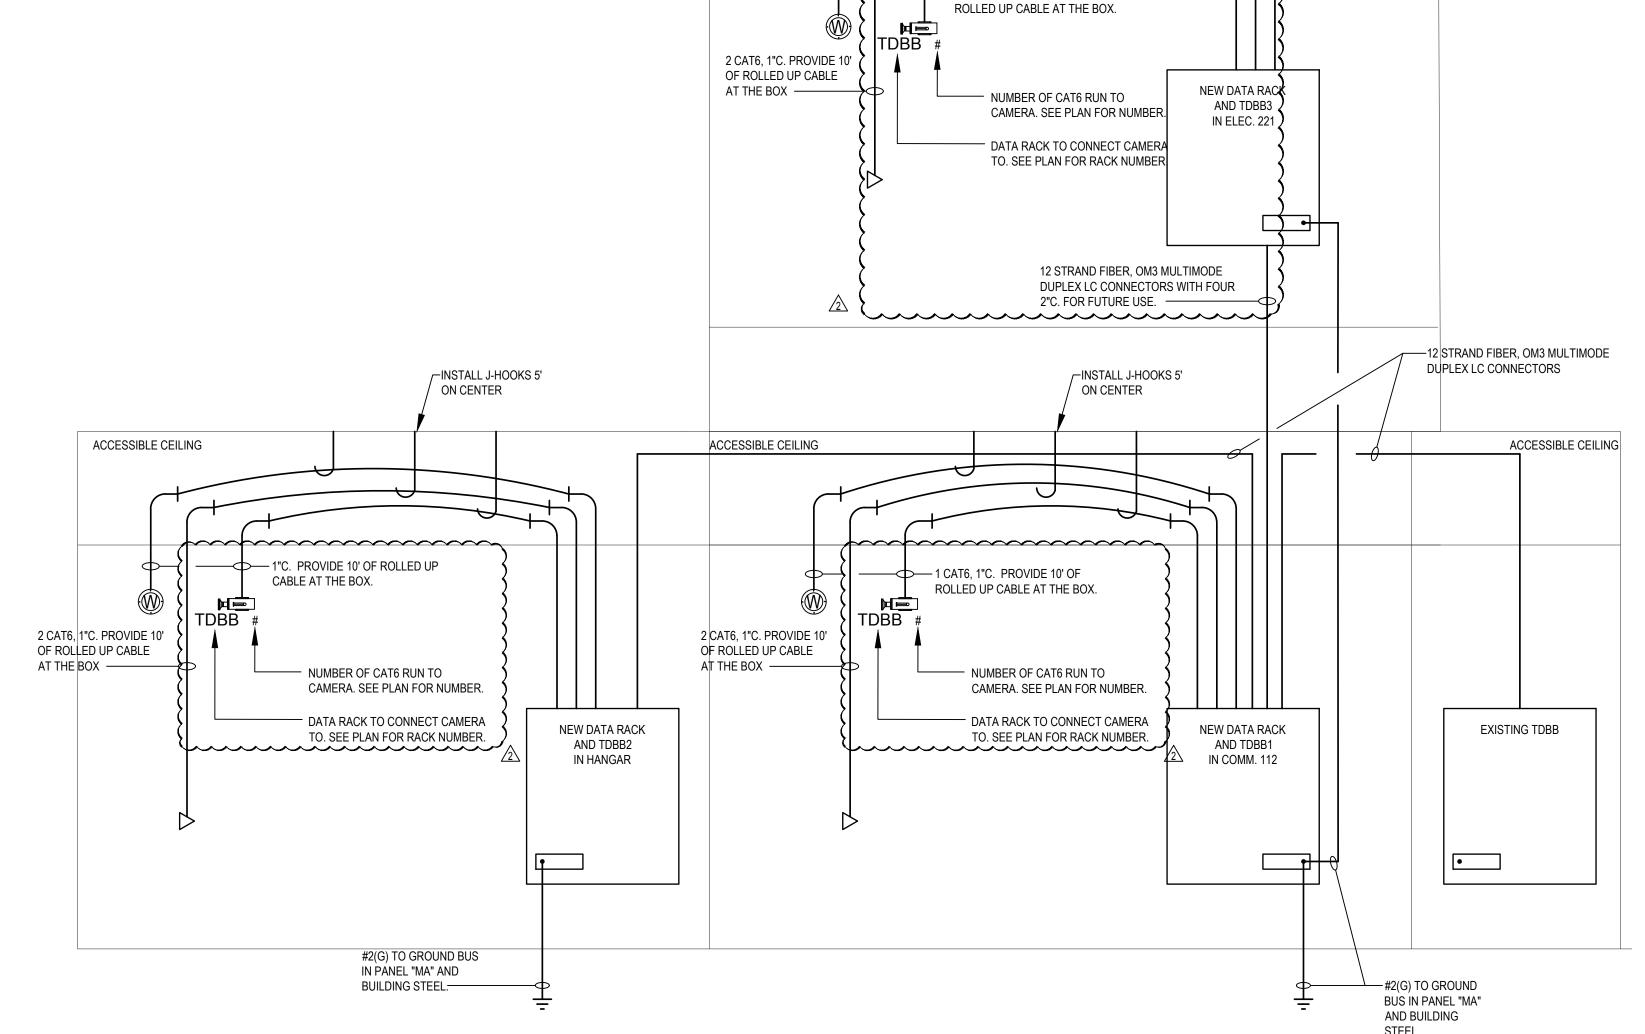

ACCESSIBLE CEILING

/-INSTALL J-HOOKS 5'

ON CENTER

- 1 CAT6, 1"C. PROVIDE 10' OF

TELEPHONE / DATA RISER DIAGRAM - ALTERNATE #4

Scale: NONE



19-006 3/03/2021

TRUE

KEY PLAN

PROJECT NORTH

PAI	NEL	II	ELECTRICAL ROOM			воттог							
I M	A	VOLT:	208Y/120V, 3Ø, 4W	MAIN BU			JGS ONL	Y			_		
141		BUS:	400A	MOUNTI		SURFAC				PANELBOARD AIC RA			1
CIRCUIT		EAKER	DESCRIPTION			PHASE L				DESCRIPTION		AKER	CIRCUIT
NO.	AMPS	POLES	BEGORII HOR	1	Д		В	(0	BEGOIN HOIV	AMPS	POLES	NO.
1	80	3	SPARE	0.0	3.4					ATO	60	3	2
3	-	-	-			0.0	3.4	1		-	-	-	4
5	-	-	-					0.0	3.4	-	-	-	6
7	80	3	ODU-1 (ALT #2)	4.7	1.7	7				EUH-5 (ALT #2)	20	3	8
9	-	-	-			4.7	1.7	1		-	-	-	10
11	-	-	-					4.7	1.7	-	-	-	12
13	20	2	IDU-1.01 THRU IDU-1.07 (ALT #2)	1.0	1.7	1			'	EUH-6 (ALT #2)	20	3	14
15	-	-	-			1.0	1.7	1		-	-	-	16
17	25	3	EWH-1 (ALT #2)					2.0	1.7	-	-	-	18
19	-	-	-	2.0	5.0	7				ODU-02a (ALT #4)	80	3	20
21	-	-	-			2.0	5.0	1		-	-	-	22
23	20	3	EUH-1 (ALT #2)					1.7	5.0	-	-	-	24
25	-	-	-	1.7	5.0	7				ODU-02b (ALT #4)	80	3	26
27	-	-	-			1.7	5.0	1		-	-	-	28
29	20	3	EUH-2 (ALT #2)					1.7	5.0	-	-	-	30
31	-	-	-	1.7	2.1	7				PROVISIONS FOR DUST COLLECTION (ALT #1)	35	3	32
33	-	-	-			1.7	2.1	1		-	-	-	34
35	20	3	EUH-3 (ALT #2)					1.7	2.1	-	-	-	36
37	-	-	-	1.7	0.0	7				SPARE	20	1	38
39	-	-	-			1.7	0.0	1		SPARE	20	1	40
41	20	3	EUH-4 (ALT #2)					1.7	0.0	SPARE	20	1	42
43	-	-	-	1.7	0.0	7				SPARE	20	1	44
45	-	-	-			1.7	0.0	1		SPARE	20	1	46
47	20	1	SPARE				1	0.0	0.0	SPARE	20	1	48
49	225	3	PANEL 'PA'	12.7	0.0	7				SPARE	20	1	50
51	-	-	-		1	12.3	0.0	1		SPARE	20	1	52
53	-	-	-				1	13.9	0.0	SPARE	20	1	54
TOTAL "			11	45	5.8	4:	5.5	46		* WITH AUXILIARY CONTACTS			-

PA	NEL		ELECTRICAL ROOM			BOTTO							
MB - 9	SEC. 1	VOLT:	208Y/120V, 3Ø, 4W	MAIN BU				Y W/FEE	D THRU L		TINIO (A)		
		BUS:	400A	MOUNTI		SURFAC				PANELBOARD AIC RA		22,000	
CIRCUIT		AKER	DESCRIPTION			PHASE L				DESCRIPTION		AKER	CIF
NO.	AMPS	POLES			A		В		С		AMPS	POLES	1
1	20	1	REC RECEPTION (ALT #4)	0.9	1.1					REC STORAGE (ALT #1)	20	1	
3	20	1	REC OFFICE 4 (ALT#4)			1.1	0.0			SPARE	20	1	
5	20	1	REC OFFICE 3 (ALT#4)					1.1	1.3	REC MEN&WOMEN RTR, ELEC, MECH (ALT#4)	20	1	
7	20	1	REC OFFICE 2 (ALT #4)	1.1	0.5					DRINKING FOUNTAIN (ALT#4)	20*	1	
9	20	1	REC OFFICE 1 (ALT#4)			1.1	0.5			DRINKING FOUNTAIN (ALT#4)	20*	1	
11	20	1	REC HALL, CONFERENCE (ALT#4)					0.9	0.5	TDBB (ALT#4)	20	1	
13	20	1	REC CONFERENCE (ALT#4)	0.4	0.5					TDBB (ALT#4)	20	1	
15	20	1	REC CONFERENCE (ALT#4)			0.2	1.1			REC LENS OFFICE (ALT#4)	20	1	
17	20	1	RP-2 (ALT #4)					1.2	1.1	REC HALL, STOR, LEN RTR, KITCHEN (ALT#4)	20	1	
19	20	1	EF-14 (ALT #4)	0.5	4.0					REC KITCHEN RANGE (ALT#4)	50	2	
21	20	2	IDU-2.01 THRU IDU-2.010 (ALT #4)			1.1	4.0			-	-	-	
23	-	-	-					1.1	0.2	REC KITCHEN(ALT #4)	20	1	
25	20	3	EWH-02 (ALT #4)	2.0	0.4					REC KITCHEN (ALT#4)	20	1	
27	-	-	-			2.0	0.8	1		REC KITCHEN REF. (ALT #4)	20	1	
29	-	-	-				,	2.0	0.4	REC CREW LOUNGE (ALT#4)	20	1	
31	20	2	IDU-2.11 THRU IDU-2.17 (ALT #4)	1.1	0.5				,	REC CREW LOUNGE (ALT#4)	20	1	
33	-	-	-			1.1	0.5	1		REC CREW LOUNGE (ALT#4)	20	1	
35	20	1	MOTORIZED DAMPERS (ALT #4)					0.5	0.2	REC CREW LOUNGE (ALT#4)	20	1	
37	20	1	MOTORIZED DAMPERS (ALT #4)	0.5	0.4					REC CREW LOUNGE (ALT#4)	20	1	
39	15	2	BS 2.1 & BS2.2 (ALT #4)			0.2	0.7	1		REC FLIGHT PLAN (ALT #4)	20	1	
41	-	-	-					0.2	0.7	REC LOG ROOM (ALT#4)	20	1	
43	20	1	LTS (ELEC. 221, MECH 220 ETC. ALT #4)	1.2	0.7	7				REC LOG ROOM (ALT#4)	20	1	Ī
45	20	1	LTS (CORR 217, MENS RR 219 ETC. ALT #4)			1.2	0.7	1		REC WORKROOM (ALT#4)	20	1	
47	20	1	LTS (WAITING 200, CONF 1 202, ETC ALT #4)					0.7	0.7	REC WORKROOM (ALT#4)	20	1	İ
49	20	1	POWER FOR ACCESS CONTROLS	0.5	0.7	7			·	REC WORKROOM (ALT#4)	20	1	İ
51 ~	~20~		POWER FOR ACCESS CONTROLS			0.5	0.2	1		REC WORKROOM (ALT#4)	20	1	
53	20	1	PROVISIONS FOR VRF TOUCHSCREEN - ALT #4	∥ }				0.5	0.7	REC WORKROOM (ALT#4)	20	1	
TOTAL				10	6.9	1	7.0	1:	3.9	* GFCI BREAKER			

	3 [7 7]	LOCATION: VOLT: BUS:	ELECTRICAL ROOM 208Y/120V, 3Ø, 4W 400A	LUG LOG MAIN: MOUNTI		TOP FE MAIN LU SURFAC	JGS ONLY	(PANELBOARD AIC R	ATING (A):	22,000)
CIRCUIT NO.	BRE AMPS	AKER POLES	DESCRIPTION		<u> </u>		OAD (KVA B	,	C	DESCRIPTION	BRE AMPS	AKER POLES	CIRCUIT NO.
55	20	1	SPARE	0.0	0.0					SPARE	20	1	56
57	20	1	SPARE			0.0	0.0			SPARE	20	1	58
59	20	1	SPARE					0.0	0.0	SPARE	20	1	60
61	20	1	SPARE	0.0	0.0				'	SPARE	20	1	62
63	20	1	SPARE			0.0	0.0			SPARE	20	1	64
65	20	1	SPARE					0.0	0.0	SPARE	20	1	66
67	20	1	SPARE	0.0	0.0					SPARE	20	1	68
69	20	1	SPARE			0.0	0.0			SPARE	20	1	70
71	20	1	SPARE					0.0	0.0	SPARE	20	1	72
73	20	1	SPARE	0.0	0.0	7			•	SPARE	20	1	74
75	20	1	SPARE			0.0	0.0			SPARE	20	1	76
77	20	1	SPARE					0.0	0.0	SPARE	20	1	78
79	20	1	SPARE	0.0	0.0	7			•	SPARE	20	1	80
81	20	1	SPARE			0.0	0.0			SPARE	20	1	82
83	20	1	SPARE					0.0	0.0	SPARE	20	1	84
85	20	1	SPARE	0.0	0.0	7				SPARE	20	1	86
87	20	1	SPARE			0.0	0.0			SPARE	20	1	88
89	20	1	SPARE					0.0	0.0	SPARE	20	1	90
91	20	1	SPARE	0.0	0.0					SPARE	20	1	92
93	20	1	SPARE			0.0	0.0			SPARE	20	1	94
95	20	1	SPARE					0.0	0.0	SPARE	20	1	96
97	20	1	SPARE	0.0	0.0	7				SPARE	20	1	98
99	20	1	SPARE			0.0	0.0			SPARE	20	1	100
101	110*	3	WEST ELEVATOR (ALT #1)					9.4	11.0	EAST ELEVATOR	125*	3	102
103	-	-	-	9.4	11.0					-	_	-	104
105	-	-	-			9.4	11.0			-	-	-	106
107			SHUNT TRIP COIL					0.0	0.0	SHUNT TRIP COIL			108
TOTAL				20	0.4	2	0.4	20	0.4	* WITH AUXILIARY CONTACTS			


PA			ELECTRICAL ROOM			BOTTON							
DA G	3 4 7	VOLT:	208Y/120V, 3Ø, 4W	MAIN BU				Y W/FEE	THRU L				
- A	JLG. 1	BUS:	225A	MOUNTI	NG:	SURFAC	Έ			PANELBOARD AIC R	ATING (A):	22,000	
CIRCUIT		AKER	DESCRIPTION		F	PHASE LO	OAD (KV)	,		DESCRIPTION		AKER	CIRCUIT
NO.	AMPS	POLES	DESCRIPTION	/	A	E	3	(0	DESCIVIF HON	AMPS	POLES	NO.
1	20	1	REC LAUNDRY (ALT#2)	0.2	0.4					REC EMPTY SHOP	20	1	2
3	20	1	NORTH ELEVATOR - SUMP PUMP (ALT #1)			0.5	0.2	1		REC EMPTY SHOP	20	1	4
5	20	1	NORTH ELEVATOR - PIT AND HOISTWAY LIGHTS (ALT #4)	1				0.5	0.2	REC EMPTY SHOP	20	1	6
7	20	1	NORTH ELEVATOR - CONTROL PANEL (ALT #4)	0.5	0.2	1				REC EMPTY SHOP	20	1	8
9	20	1	NORTH ELEVATOR - CAB LIGHTS (ALT #4)		'	0.5	1.5	1		DOOR MOTOR - EQUIPMENT (ALT #2)	20	1	10
11	20	1	SOUTH ELEVATOR - SUMP PUMP (ALT #1)	1			,	0.5	1.5	DOOR MOTOR - EQUIPMENT (ALT #2)	20	1	12
13	20	1	SOUTH ELEVATOR - PIT AND HOISTWAY LIGHTS (ALT #4)	0.5	0.4	1				REC EQUIPMENT (ALT #2)	20	1	14
15	20	1	SOUTH ELEVATOR - CONTROL PANEL (ALT #4)			0.5	0.4	1		REC EQUIPMENT (ALT #2)	20	1	16
17	20	1	SOUTH ELEVATOR - CAB LIGHTS (ALT #4)	1				0.5	0.5	REC MENS RTR, UNISEX 1&2 (ALT #2)	20	1	18
19	20	1	EF-1 & EF-2	0.5	0.2	1				REC SANDING ROOM (ALT #2)	20	1	20
21	20	1	EF-3 (ALT #2)			0.5	0.2			REC WASH ROOM (ALT #2)	20	1	22
23	20	1	EF-7 & SF-1(ALT #2)	1				1.0	0.4	REC MACHINE SHOP (ALT #2)	20	1	24
25	20	1	EF-8 (ALT #2)	0.5	0.4	1				REC MACHINE SHOP (ALT #2)	20	1	26
27	20	1	PROVISIONS FOR BAS			0.5	0.4	1		REC MACHINE SHOP (ALT #2)	20	1	28
29	20	1	RP-1 (ALT #2)	1			,	1.2	0.2	REC MACHINE SHOP (ALT #2)	20	1	30
31	20	1	MOTORIZED DAMPERS (ALT #2)	0.5	1.5					DOOR MOTOR - MACHINE SHOP (ALT #2)	20	1	32
33	20	1	REC EMPTY SHOP			0.4	0.7]		REC PARTS (ALT #2)	20	1	34
35	20	1	REC EMPTY SHOP	1				0.4	1.1	REC PARTS (ALT #2)	20	1	36
37	20	1	REC EMPTY SHOP	0.4	0.4					REC PARTS (ALT #2)	20	1	38
39	20	1	LTS (ELEC 110, LAUNDRY 109, ETC. ALT #2)			1.3	0.4]		REC PARTS (ALT #2)	20	1	40
41	20	1	LTS (MACHINE SHOP 107, ETC. ALT #2)					0.9	0.4	REC PARTS (ALT #2)	20	1	42
43	20	1	LTS (EQUIPMENT 101, ETC. ALT #2)	1.4	0.2					REC PARTS (ALT #2)	20	1	44
45	20	1	CONTACTOR C2			0.5	0.2			DOOR MOTOR - PARTS (ALT #2)	20	1	46
47	20	1	LTS (EMPTY SHOP SPACE 101)					1.5	0.5	REC ELECTRICAL (ALT #2)	20	1	48
49	20	1	LTS (EMPTY SHOP SPACE 101)	1.1	0.5					REC ELECTRICAL (ALT #2)	20	1	50
51	20	1	LTS (EMPTY SHOP SPACE 101)			1.1	0.0			REC LAUNDRY (ALT #2)	30	2	52
53	20	1	LTS (EMPTY SHOP SPACE 101 ALT #1)	1				0.9	0.0	-	-	-	54
TOTAL				9).6	9	.6	12	2.0				


			1											
	PAI	NEL	II .	ELECTRICAL ROOM		CATION:	TOP FEI							
Р	Δ - 9	EC. 2	VOLT:	208Y/120V, 3Ø, 4W	MAIN:			JGS ONL	Y					
	A - 0)LO. 2	BUS:	225A	MOUNTII	NG:	SURFAC	E			PANELBOARD AIC R	ATING (A):	22,000	
CIR	RCUIT	BRE	AKER	DESCRIPTION		F	PHASE L	OAD (KVA	4)		DESCRIPTION	BRE	AKER	CIRCUIT
	۷O.	AMPS	POLES	BEGGIAI HOIV		4		3	(DEGOIN HON	AMPS	POLES	NO.
	55	20	1	LTS (EMPTY SHOP SPACE 101 ALT #1)	1.2	0.0					POWER FOR ACCESS CONTROLS	20	1	56
	57	20	1	LTS (EMPTY SHOP SPACE 101 ALT #1)			0.9	0.5	1		LTS (EXTERIOR LIGHTING)	20	1	58
	59	20	1	CONTACTOR C3 ALT #1					0.5	0.5	LTS (EXTERIOR LIGHTING ALT#3)	20	1	60
	61	20	1	LTS (STORAGE 200 - ALT #1)	0.9	0.5	1				LTS (EXTERIOR LIGHTING ALT#3)	20	1	62
	63	20	1	LTS (STORAGE 200 - ALT #1)			0.9	0.5]		LTS (EXTERIOR LIGHTING ALT#3)	20	1	64
	65	~20~	~~	LTS-(STORAGE 200-ALT#1)	\downarrow				0.9	0.0	SPARE	20	1	66
	67	20	1	PROVISIONS FOR VRF TOUCHSCREEN - ALT #3	0.5	0.0	1				SPARE	20	1	68
	69~	~~20~~	~~~	~~~~~~~~~~~~~~~~~~~~~~~~~~~~~~~~~~~~~~			0.0	0.0	1		SPARE	20	1	70
	71	20	1	SPARE					0.0	0.0	SPARE	20	1	72
	73	20	1	SPARE	0.0	0.0	1				SPARE	20	1	74
	75	20	1	SPARE			0.0	0.0]		SPARE	20	1	76
	77	20	1	SPARE					0.0	0.0	SPARE	20	1	78
	79	20	1	SPARE	0.0	0.0	1				SPARE	20	1	80
	81	20	1	SPARE			0.0	0.0	1		SPARE	20	1	82
	83	20	1	SPARE					0.0	0.0	SPARE	20	1	84
	85	20	1	SPARE	0.0	0.0	1				SPARE	20	1	86
	87	20	1	SPARE			0.0	0.0]		SPARE	20	1	88
	89	20	1	SPARE					0.0	0.0	SPARE	20	1	90
	91	20	1	SPARE	0.0	0.0	1				SPARE	20	1	92
	93	20	1	SPARE		•	0.0	0.0			SPARE	20	1	94
	95	20	1	SPARE					0.0	0.0	SPARE	20	1	96
	97	20	1	SPARE	0.0	0.0	1				SPARE	20	1	98
	99	20	1	SPARE			0.0	0.0	1		SPARE	20	1	100
1	101	20	1	SPARE	1			•	0.0	0.0	SPARE	20	1	102
	103	20	1	SPARE	0.0	0.0	1				SPARE	20	1	104
	105	20	1	SPARE			0.0	0.0	1		SPARE	20	1	106
1	107	20	1	SPARE					0.0	0.0	SPARE	20	1	108
TC	DTAL				3	.1	2	.8	1	.9				

	NEL SEC. 1	LOCATION: VOLT: BUS:	ELECTRICAL ROOM 208Y/120V, 3Ø, 4W 400A	LUG LOO MAIN BU MOUNTII	JS:		JGS ONL	Y W/FEE	D THRU L	L UGS PANELBOARD AK	C RATING (A):	22,000)
CIRCUIT	BRE AMPS	EAKER POLES	DESCRIPTION		F A	PHASE LO	OAD (KV) 3	,	С	DESCRIPTION	BRE AMPS	AKER	CIRCUIT
NO.							<u> </u>		<u> </u>			+	NO.
1	60	3	REC HANGAR	0.5	1.0	0.5	1.0			HANGAR DOOR	30	3	2
3	-	-	-			0.5	1.0		1	-		-	4
5	-	-	-			-		0.5	1.0	-	-	-	6
7	60	3	REC HANGAR	0.5	1.0					HANGAR DOOR	30	3	8
9	-	-	-			0.5	1.0			-		-	10
11	-	-	-					0.5	1.0	-		-	12
13	60	3	REC HANGAR	0.5	0.5					REC HANGAR	60	3	14
15	-	-	-			0.5	0.5			-		-	16
17	-	-	-					0.5	0.5	-		-	18
19	20	2	REC HANGAR	0.5	0.5					REC HANGAR	60	3	20
21	-	_	-			0.5	0.5			-	-	-	22
23	20	2	REC HANGAR					0.5	0.5	-	-	-	24
25	-	-	-	0.5	0.5	1				REC HANGAR	60	3	26
27	20	2	REC HANGAR			0.5	0.5	1		-	-	-	28
29	-	-	-				•	0.5	0.5	-	-	-	30
31	20	2	REC HANGAR	0.5	0.5	1				REC HANGAR	60	3	32
33	-	-	-			0.5	0.5	1		-	-	-	34
35	20	1	REC HANGAR					0.7	0.5	-	_	-	36
37	20	1	REC HANGAR	0.4	0.5	1				REC HANGAR	60	3	38
39	20	1	REC HANGAR			0.2	0.5			-	-	-	40
41	20	1	REC HANGAR					0.4	0.5	-	-	-	42
43	20	1	REC HANGAR	0.4	0.5	1				REC HANGAR	60	3	44
45	20	1	REC HANGAR			0.2	0.5	1		-	_	-	46
47	20	1	REC HANGAR					0.2	0.5	-		-	48
49	20	1	REC HANGAR	0.4	0.5	1				REC HANGAR	60	3	50
51	20	2	REC HANGAR (ALT #2)		1	0.5	0.5	1		-	-	-	52
53	-	_	-				ı	0.5	0.5	-	_	-	54
TOTAL				9	.6	9	.4		9.8	* GFCI BREAKER	II .	+	

PA	NEL	II	ELECTRICAL ROOM	LUG LO	CATION:								
HP - S	SEC. 2	VOLT: BUS:	208Y/120V, 3Ø, 4W 400A	MAIN: MOUNTI	NG:	MAIN LU SURFAC	JGS ONL'	Y W/FEEI	D THRU L	LUGS PANELBOARD AIC	RATING (A):	22,000	
CIRCUIT	BRE	AKER	DECODIDATION		F	PHASE L	OAD (KVA	4)	-	DECORPTION	BRE	AKER	CIRCUIT
NO.	AMPS	POLES	DESCRIPTION	,	4		В	(С	DESCRIPTION	AMPS	POLES	NO.
55	20	2	REC HANGAR (ALT #2)	0.5	0.5					REC HANGAR (ALT #2)	60	3	56
57	-	-	-			0.5	0.5			-	-	-	58
59	20	1	REC HANGAR (ALT #2)	1				0.2	0.5	-	-	-	60
61	20*	1	REC HANGAR DRINK FOUNTIAN (ALT #2)	0.5	0.5	1				REC HANGAR (ALT #2)	60	3	62
63	20*	1	REC HANGAR DRINK FOUNTIAN (ALT #2)			0.5	0.5			-	-	-	64
65	20	1	REC HANGAR (ALT #2)	1				0.2	0.5	-	-	-	66
67	20	1	EXTERIOR HANGAR LIGHTS	1.2	1.6	1				HVLS-1	20	2	68
69	20	1	EXTERIOR HANGAR LIGHTS		•	1.2	1.6			-	-	-	70
71	20	1	EXTERIOR HANGAR LIGHTS	1				1.2	1.6	HVLS-2	20	2	72
73	60	3	WASH STATION RECEPTACLE	0.5	1.6	1				-	-	-	74
75	-	-	-			0.5	0.0			FIRE ALARM BELL	20	1	76
77	-	-	-	1				0.5	0.5	REC TDBB2	20	1	78
79	20	1	WASH STATION RECEPTACLE	0.2	0.5	1				MARKEGAT BBB2	~~20~	~ ^	~88~
81	20	1	LTS (HANGAR 100)			1.1	1.1		(LTS (HANGAR 100)	20	1	82
83	20	1	LTS (HANGAR 100)	1				1.1	1.1	LTS (HANGAR 100)	20	1	84
85	20	1	LTS (HANGAR 100)	1.1	1.1	1				LTS (HANGAR 100)	20	1	86
87	20	1	LTS (HANGAR 100)	1		1.1	1.1		ì	LTS (HANGAR 100)	20	1	88
89	20	1	LTS (HANGAR 100)	1				1.1	0.5	REC HANGAR	60	3	90
91	20	1	LTS (HANGAR 100)	1.1	0.5	1			(-	-	-	92
93	20	1	LTS (HANGAR 100)			1.1	0.5			_	-	-	94
95	20	1	LTS (HANGAR 100)	1				1.1	0.5	REC HANGAR	20	2	96
97	20	1	LTS (HANGAR 100)	1.1	0.5	1			(-	-	-	98
99	20	1	LTS (HANGAR 100)			1.1	1.7		`	MAR DRYER MARKET	~~~~~	~~~	7100
101	20	1	CONTACTOR C1	1				0.5	1.7	-	-	-	102
103	150	3	SPARE	0.0	11.1	1				AIR COMPRESSOR	150	3	104
105	-	-	-			0.0	11.1			-	-	-	106
107	-	-	-	1				0.0	11.1	-	-	-	108
TOTAL				24	1.0	2	5.0	23	3.7	* GFCI BREAKER			

P - SEC. 3 BUS. 400A MOUNTING: SURFACE PANELBOARD ALC RATING (A): 22,0					
AMPS POLES	PANELBOARD AIC RATING (A): 22,000				
AMPS POLES AMPS POLES AMPS POLES	CIRCUIT				
11	NO.				
13	110				
15	112				
17	114				
19	116				
REC HANGAR 20 2 2 2 2 2 2 2 2	118				
23 - - - - -	120				
25	122				
27 20 2 REC HANGAR 0.5 0.0	124				
29 - -	126				
31	128				
33 20 1	130				
SPARE SPAR	132				
37 20 1 SPARE 0.0 0.0 SPARE 20 1 39 20 1 SPARE 0.0 0.0 SPARE 20 1 41 20 1 SPARE 0.0 0.0 SPARE 20 1 43 20 1 SPARE 0.0 0.0 SPARE 20 1 45 20 1 SPARE 0.0 0.0 SPARE 20 1 47 20 1 SPARE 0.0 0.0 SPARE 20 1 49 20 1 SPARE 0.0 0.0 SPARE 20 1 51 20 1 SPARE 0.0 0.0 SPARE 20 1 53 20 1 SPARE 0.0 0.0 SPARE 20 1 55 20 1 SPARE 0.0 0.0 SPARE 20 1	134				
39 20 1 SPARE 0.0 0.0 0.0 SPARE 20 1 41 20 1 SPARE 0.0 0.0 SPARE 20 1 43 20 1 SPARE 0.0 0.0 SPARE 20 1 45 20 1 SPARE 0.0 0.0 SPARE 20 1 47 20 1 SPARE 0.0 0.0 SPARE 20 1 49 20 1 SPARE 0.0 0.0 SPARE 20 1 51 20 1 SPARE 0.0 0.0 SPARE 20 1 53 20 1 SPARE 0.0 0.0 SPARE 20 1 55 20 1 SPARE 0.0 0.0 SPARE 20 1	136				
41 20 1 SPARE 0.0 0.0 SPARE 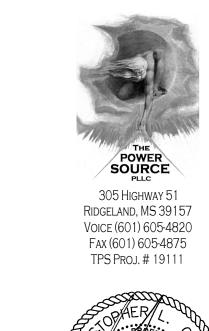

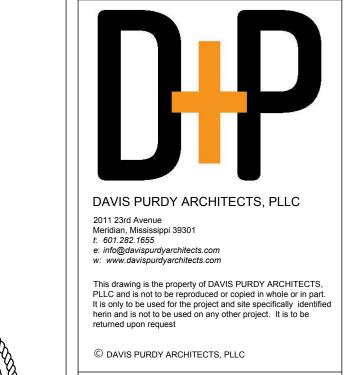

KEY PLAN



Description Date

ADDENDUM #2 03/18/21
1 100% Construction Doc. 03/03/21

MERIDIAN AIRPORT AUTHORITY

DEAN AIRCRAFT SERVICE

HANGAR ADDITIONS & ALTERATIONS

2913 Airport Blvd, South St. Meridian, MS 39307

TELEPHONE RISER
DIAGRAM


Date 19-006 3,


E-006

GENERAL NOTES


1. REFER TO ARCHITECTURAL DRAWINGS FOR BASE BID AND ALL ALTERNATE DESCRIPTIONS.


Mark

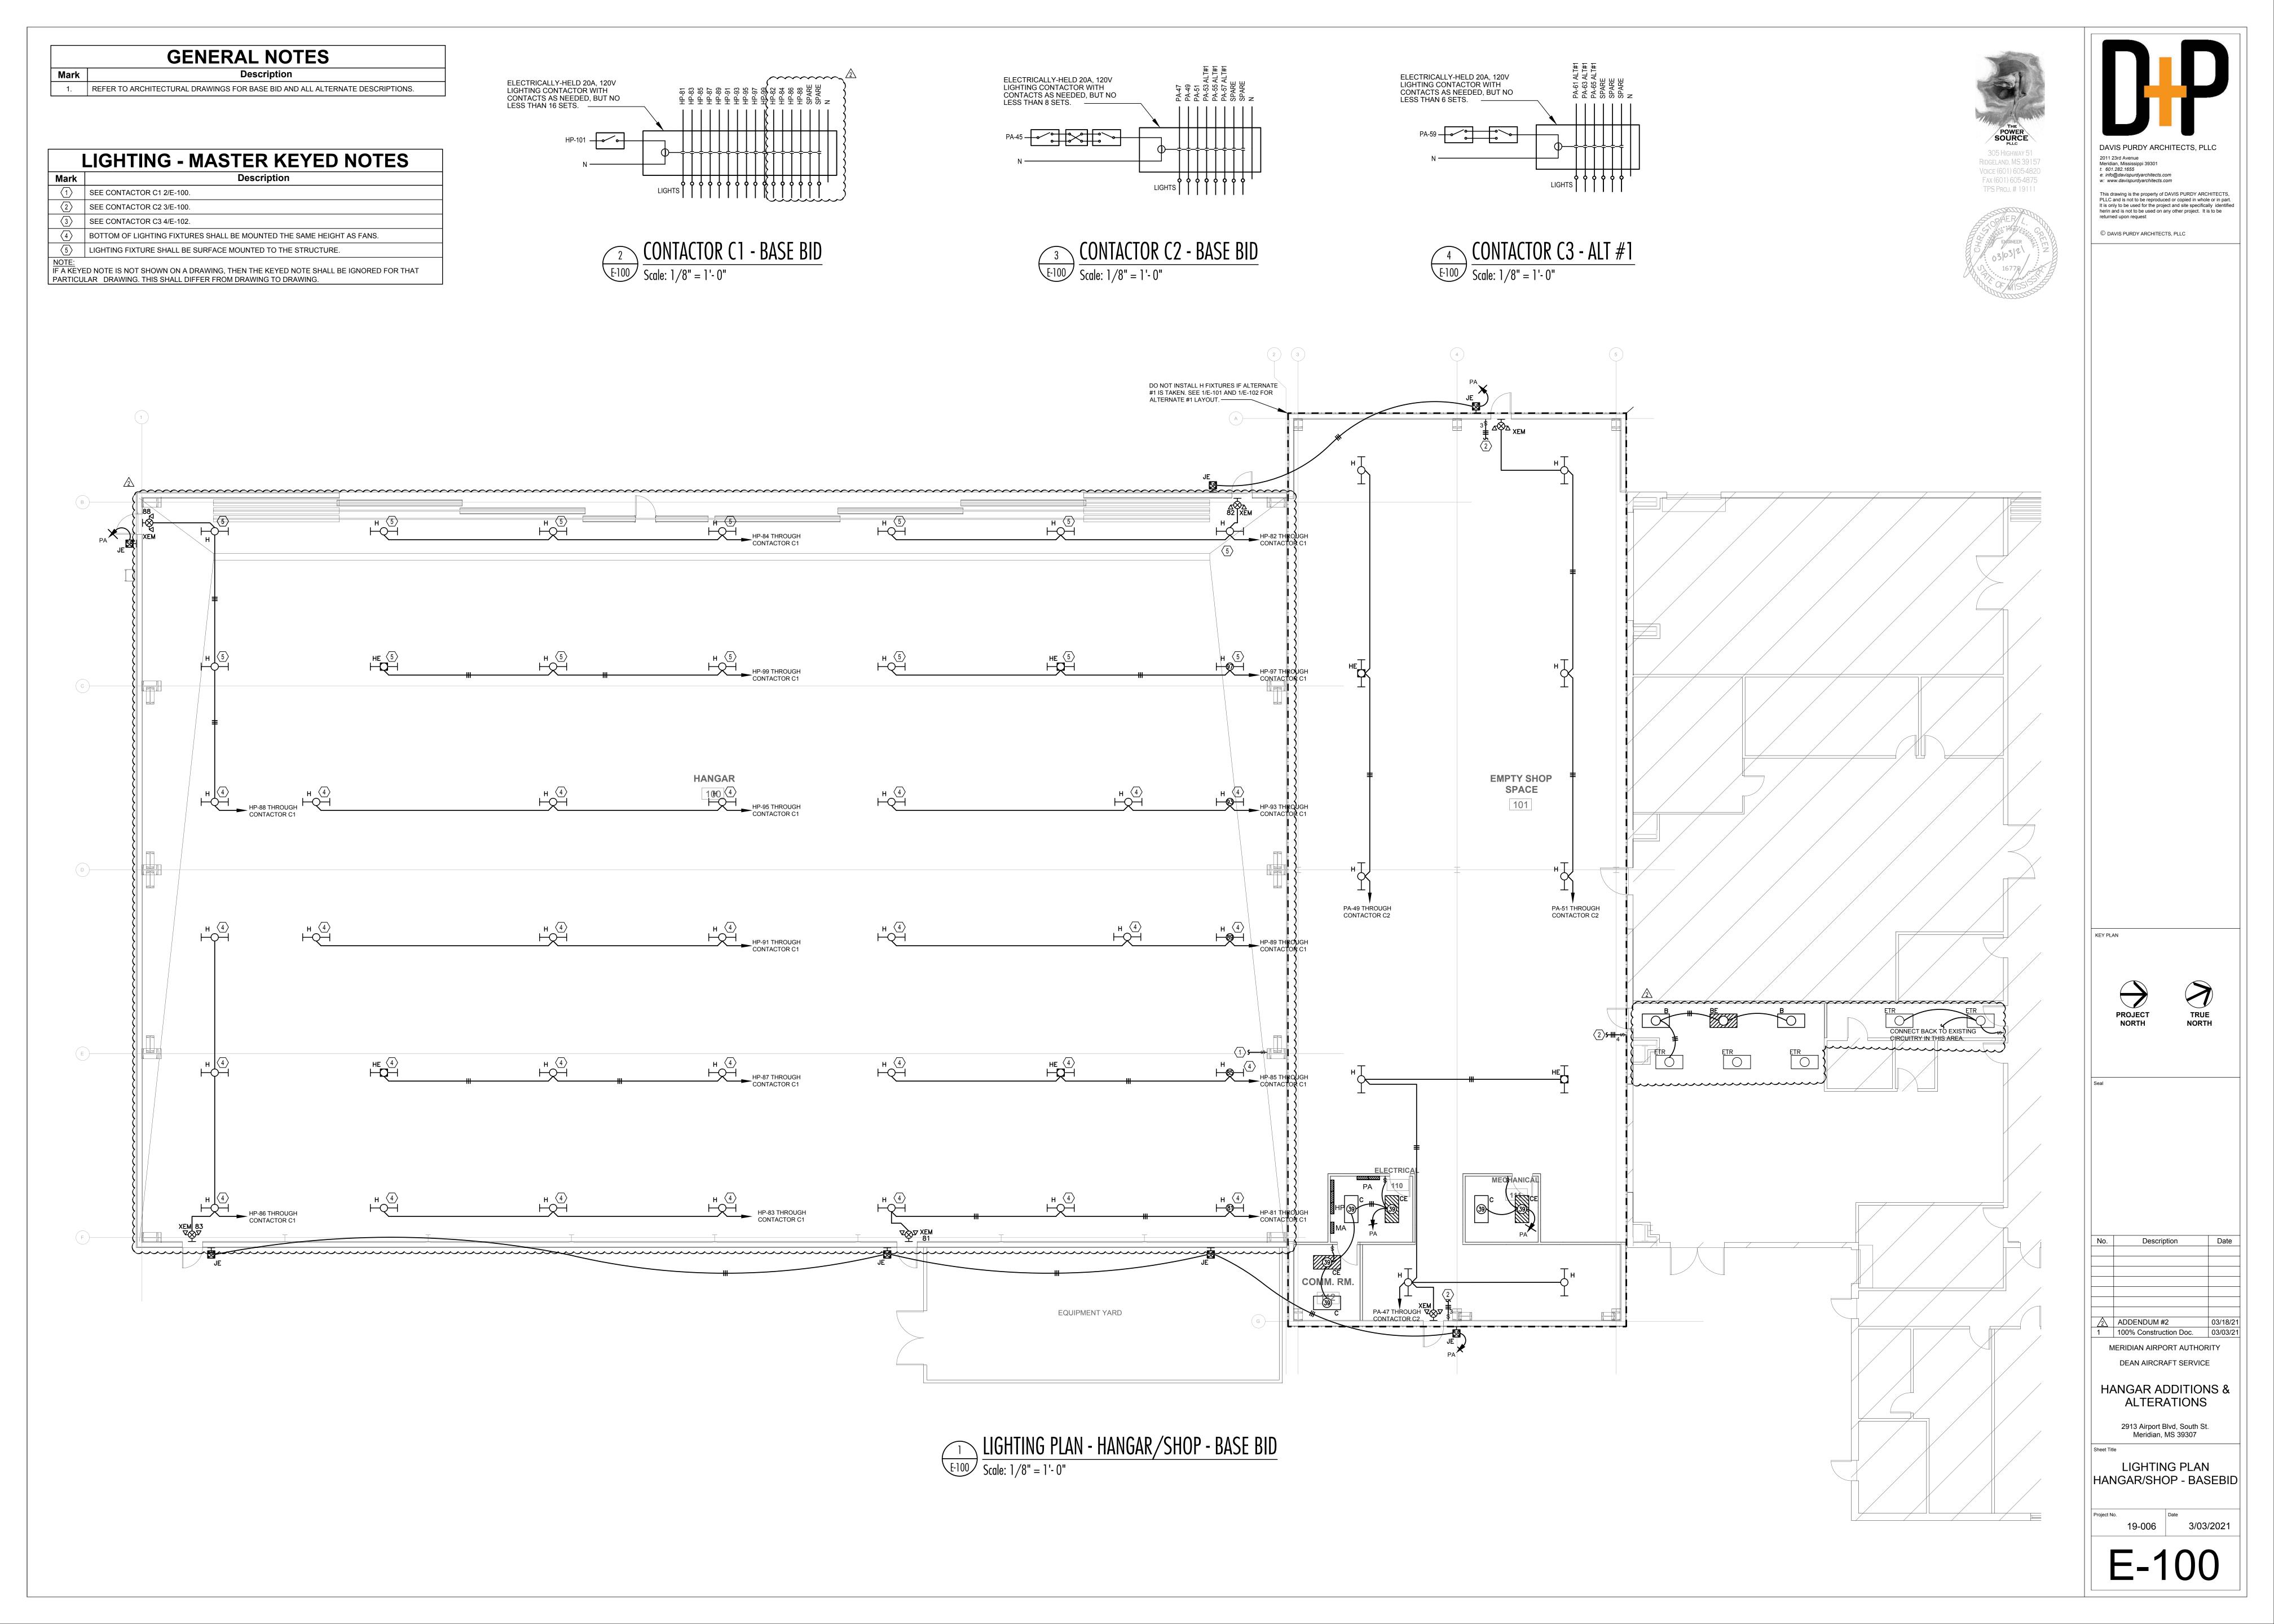

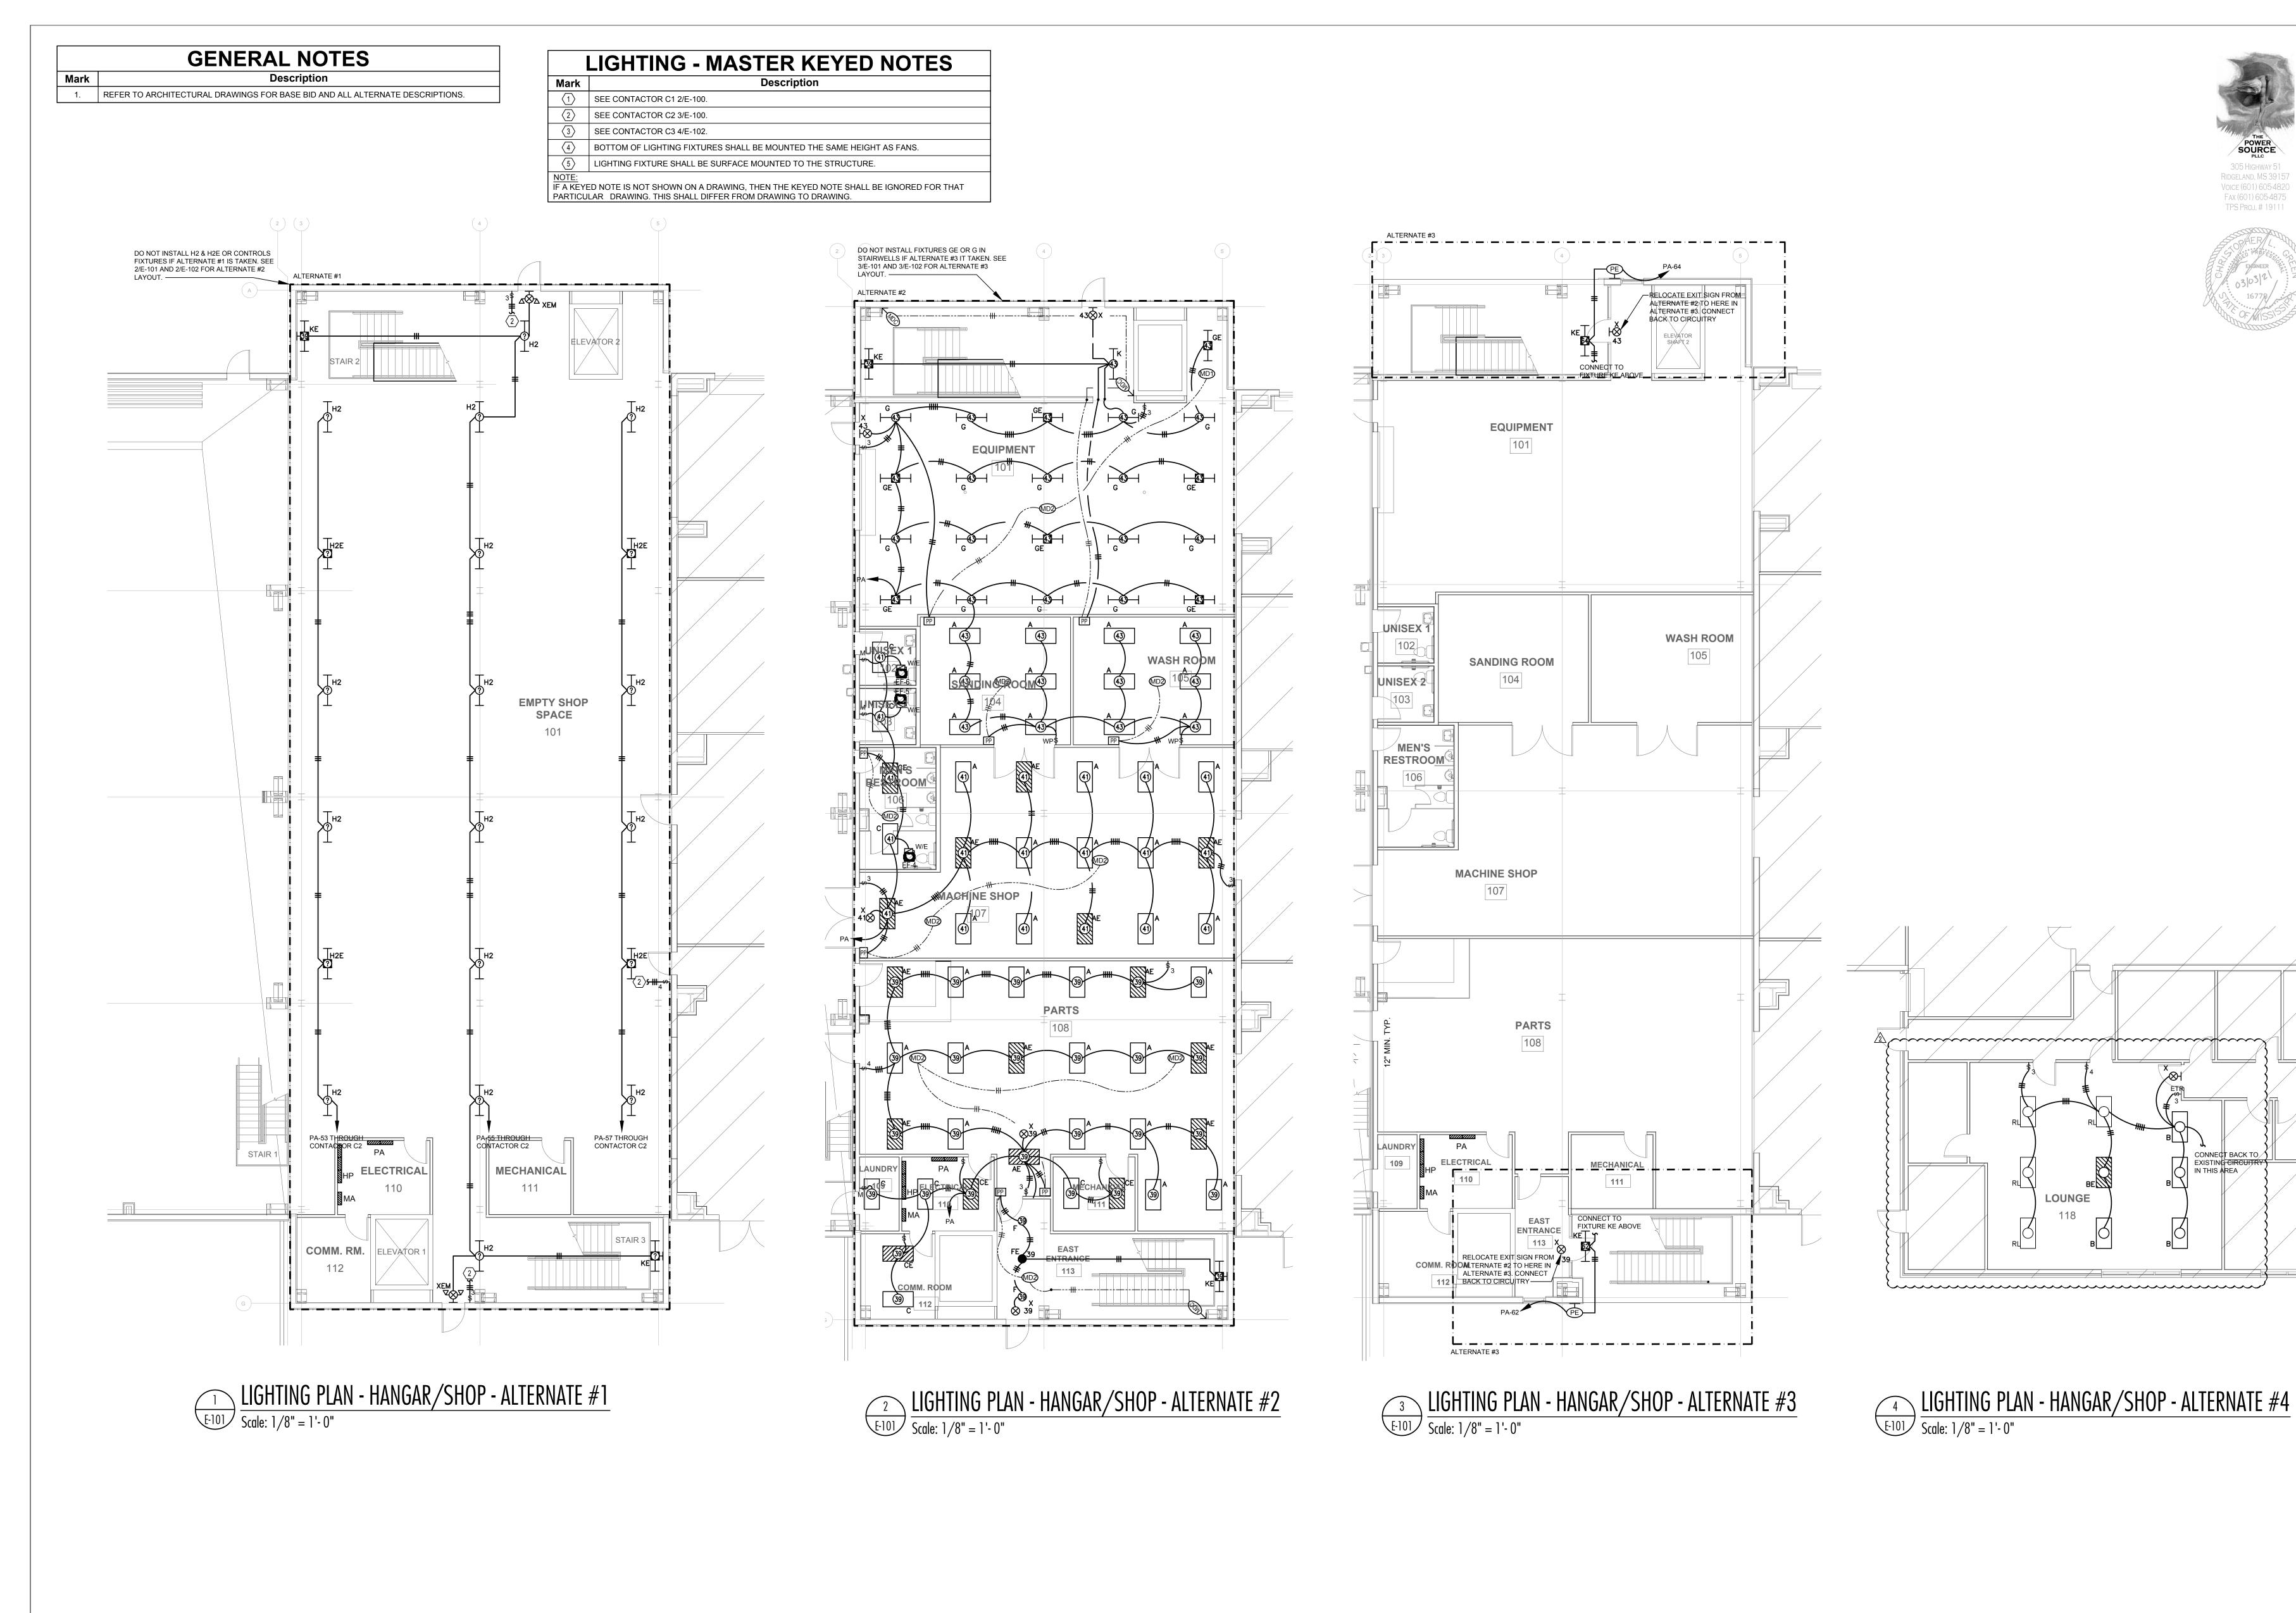



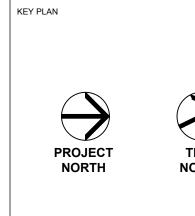

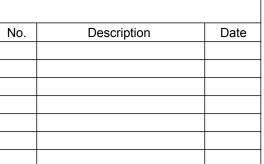

ADDENDUM #2 03/18
1 100% Construction Doc. 03/03

MERIDIAN AIRPORT AUTHORITY

DEAN AIRCRAFT SERVICE


HANGAR ADDITIONS &

HANGAR ADDITIONS
ALTERATIONS

2913 Airport Blvd, South St. Meridian, MS 39307

LIGHTING PLAN LEVEL 01 - ALTERNATE #1


L 101

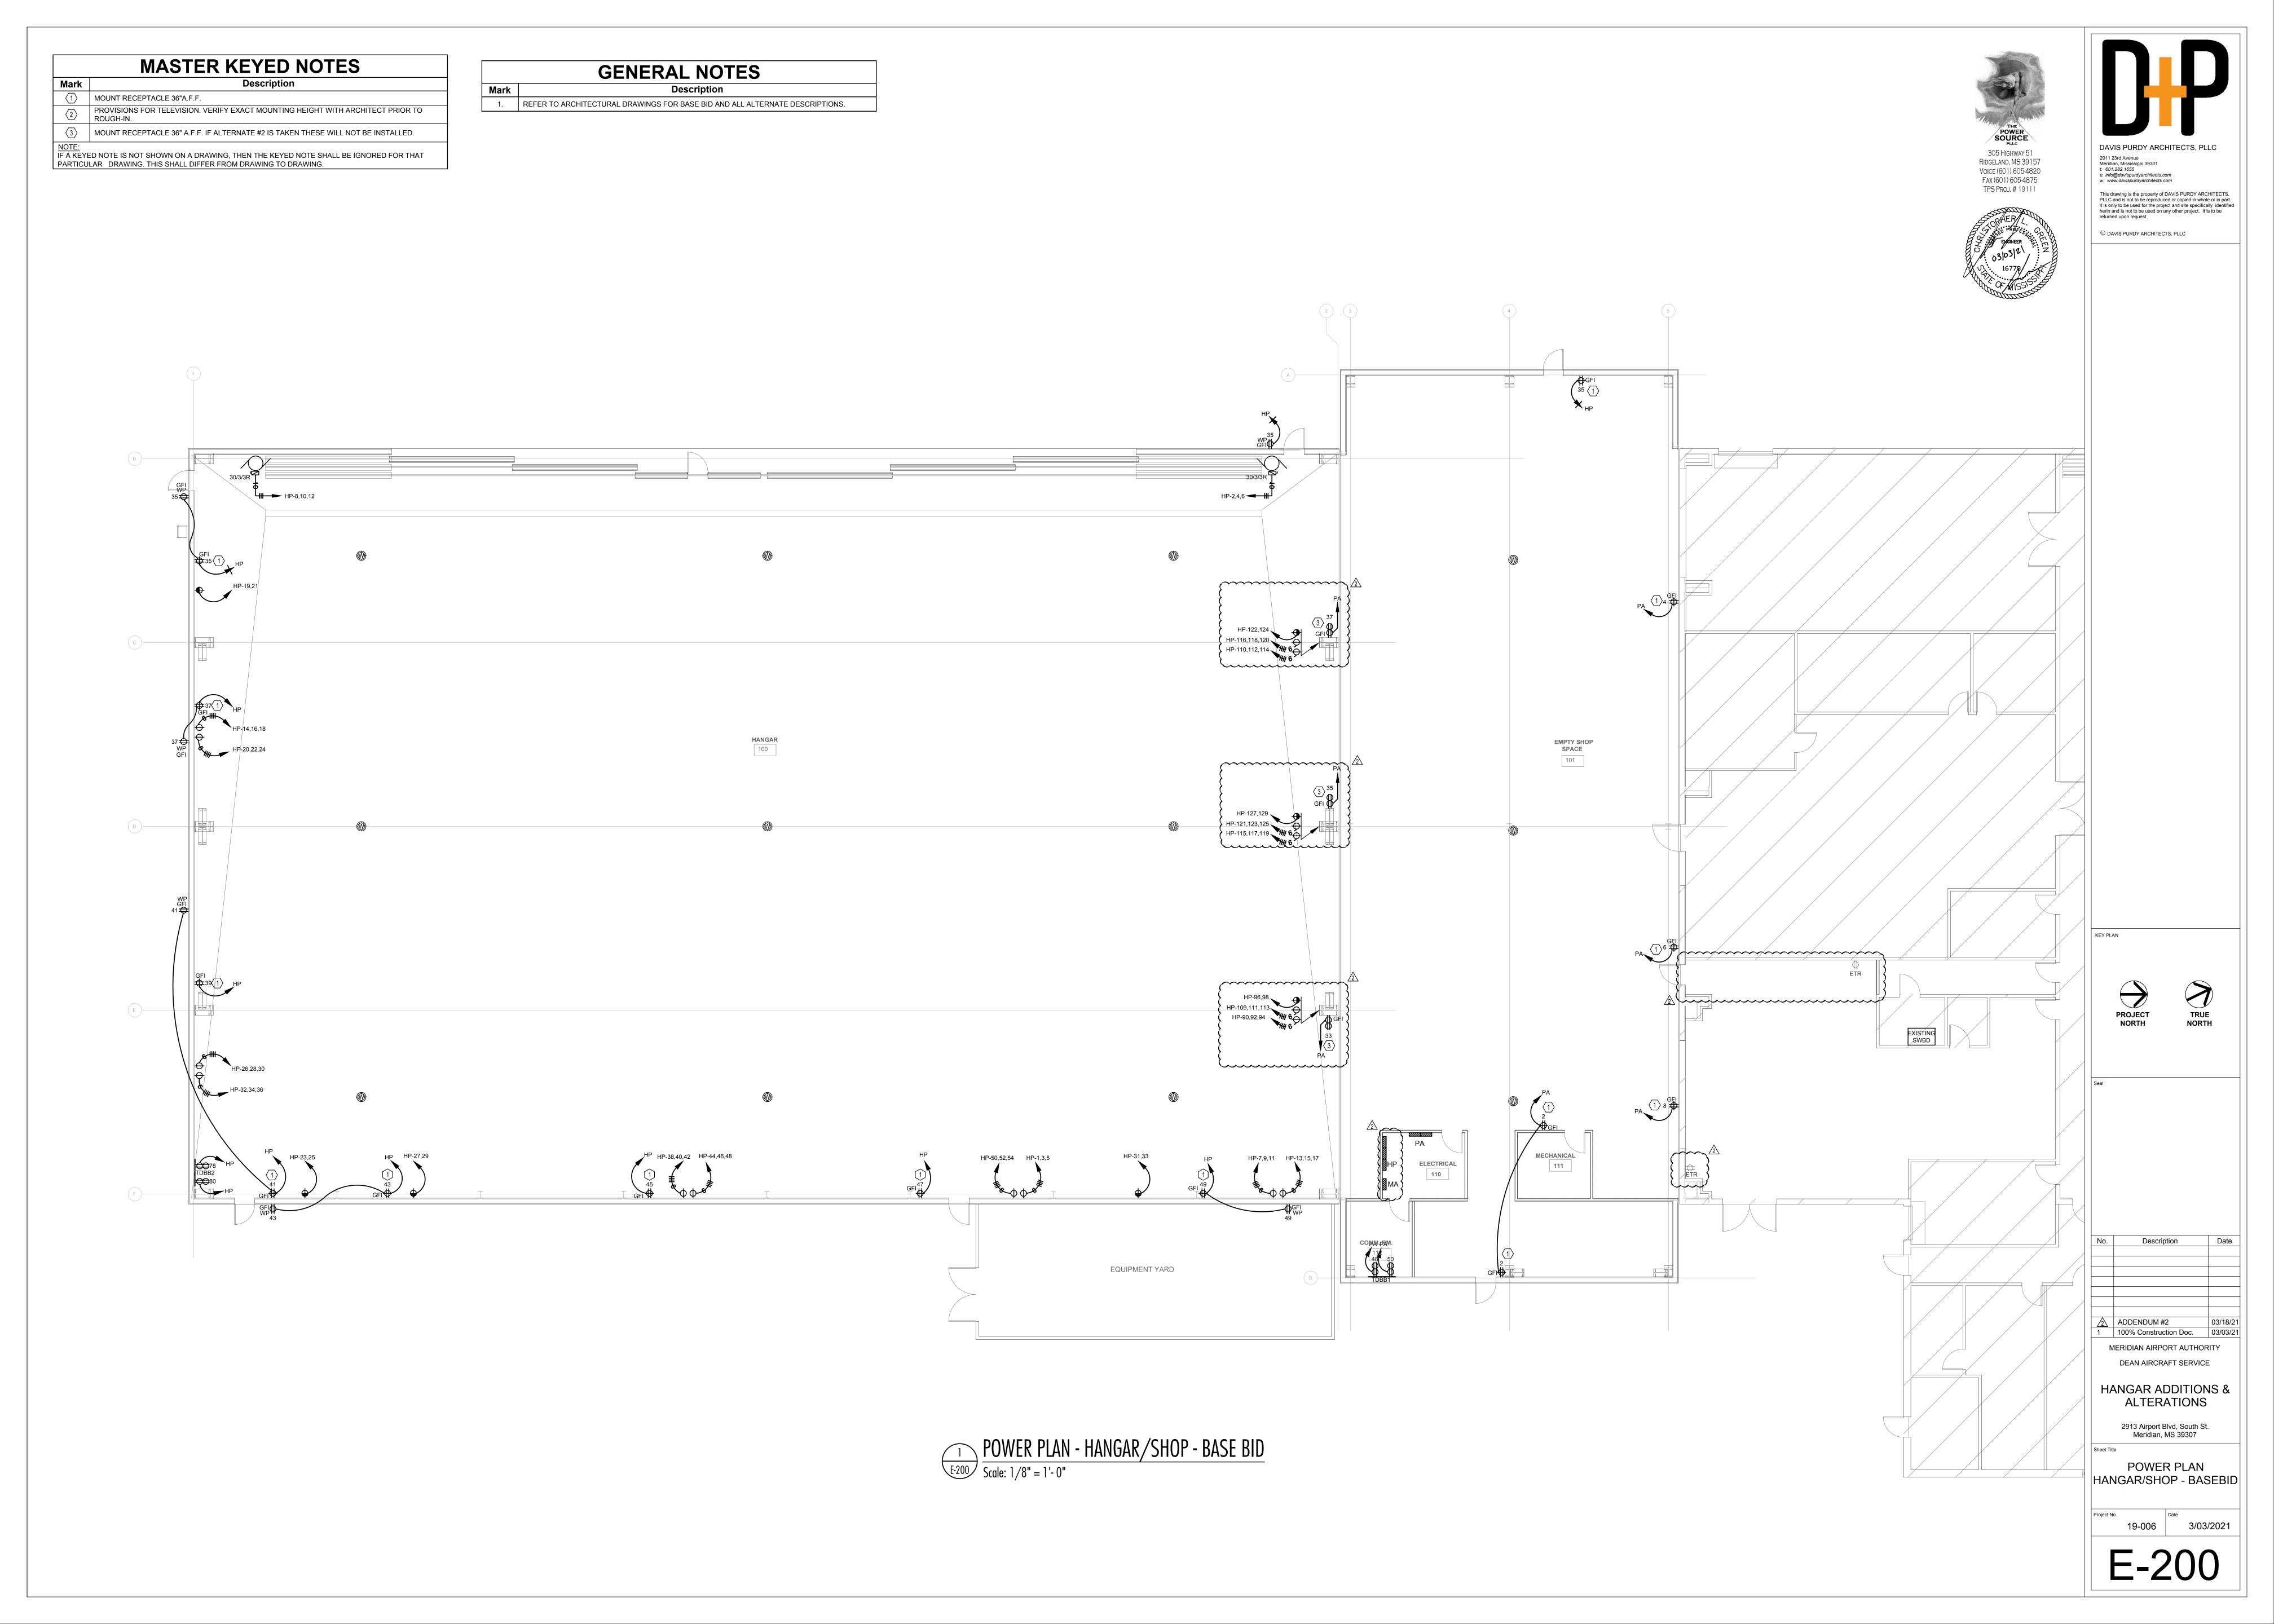


MASTER KEYED NOTES GENERAL NOTES Description Mark Mark MOUNT RECEPTACLE 36"A.F.F. 1. REFER TO ARCHITECTURAL DRAWINGS FOR BASE BID AND ALL ALTERNATE DESCRIPTIONS. PROVISIONS FOR TELEVISION. VERIFY EXACT MOUNTING HEIGHT WITH ARCHITECT PRIOR TO MOUNT RECEPTACLE 36" A.F.F. IF ALTERNATE #2 IS TAKEN THESE WILL NOT BE INSTALLED. IF A KEYED NOTE IS NOT SHOWN ON A DRAWING, THEN THE KEYED NOTE SHALL BE IGNORED FOR THAT

PARTICULAR DRAWING. THIS SHALL DIFFER FROM DRAWING TO DRAWING.



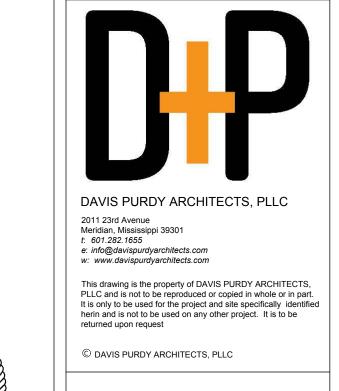



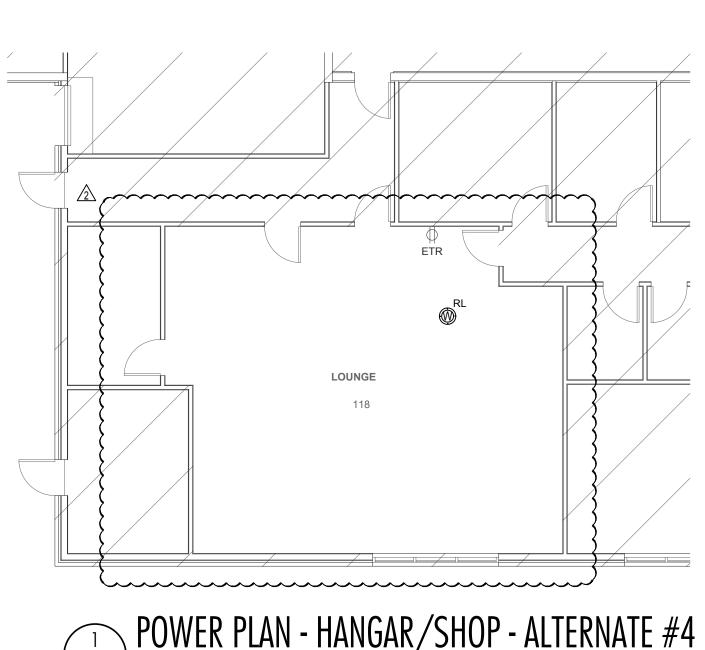

 $\frac{1}{\text{E-201}} \frac{\text{POWER PLAN - HANGAR/SHOP - ALTERNATE } \#4}{\text{Scale: } 1/8" = 1' - 0"}$

2913 Airport Blvd, South St. Meridian, MS 39307 POWER PLAN HANGAR/SHOP -ALTERNATE #1 3/03/2021

Description


MERIDIAN AIRPORT AUTHORITY

DEAN AIRCRAFT SERVICE

HANGAR ADDITIONS & ALTERATIONS

ADDENDUM #2 1 100% Construction Doc.

E-201

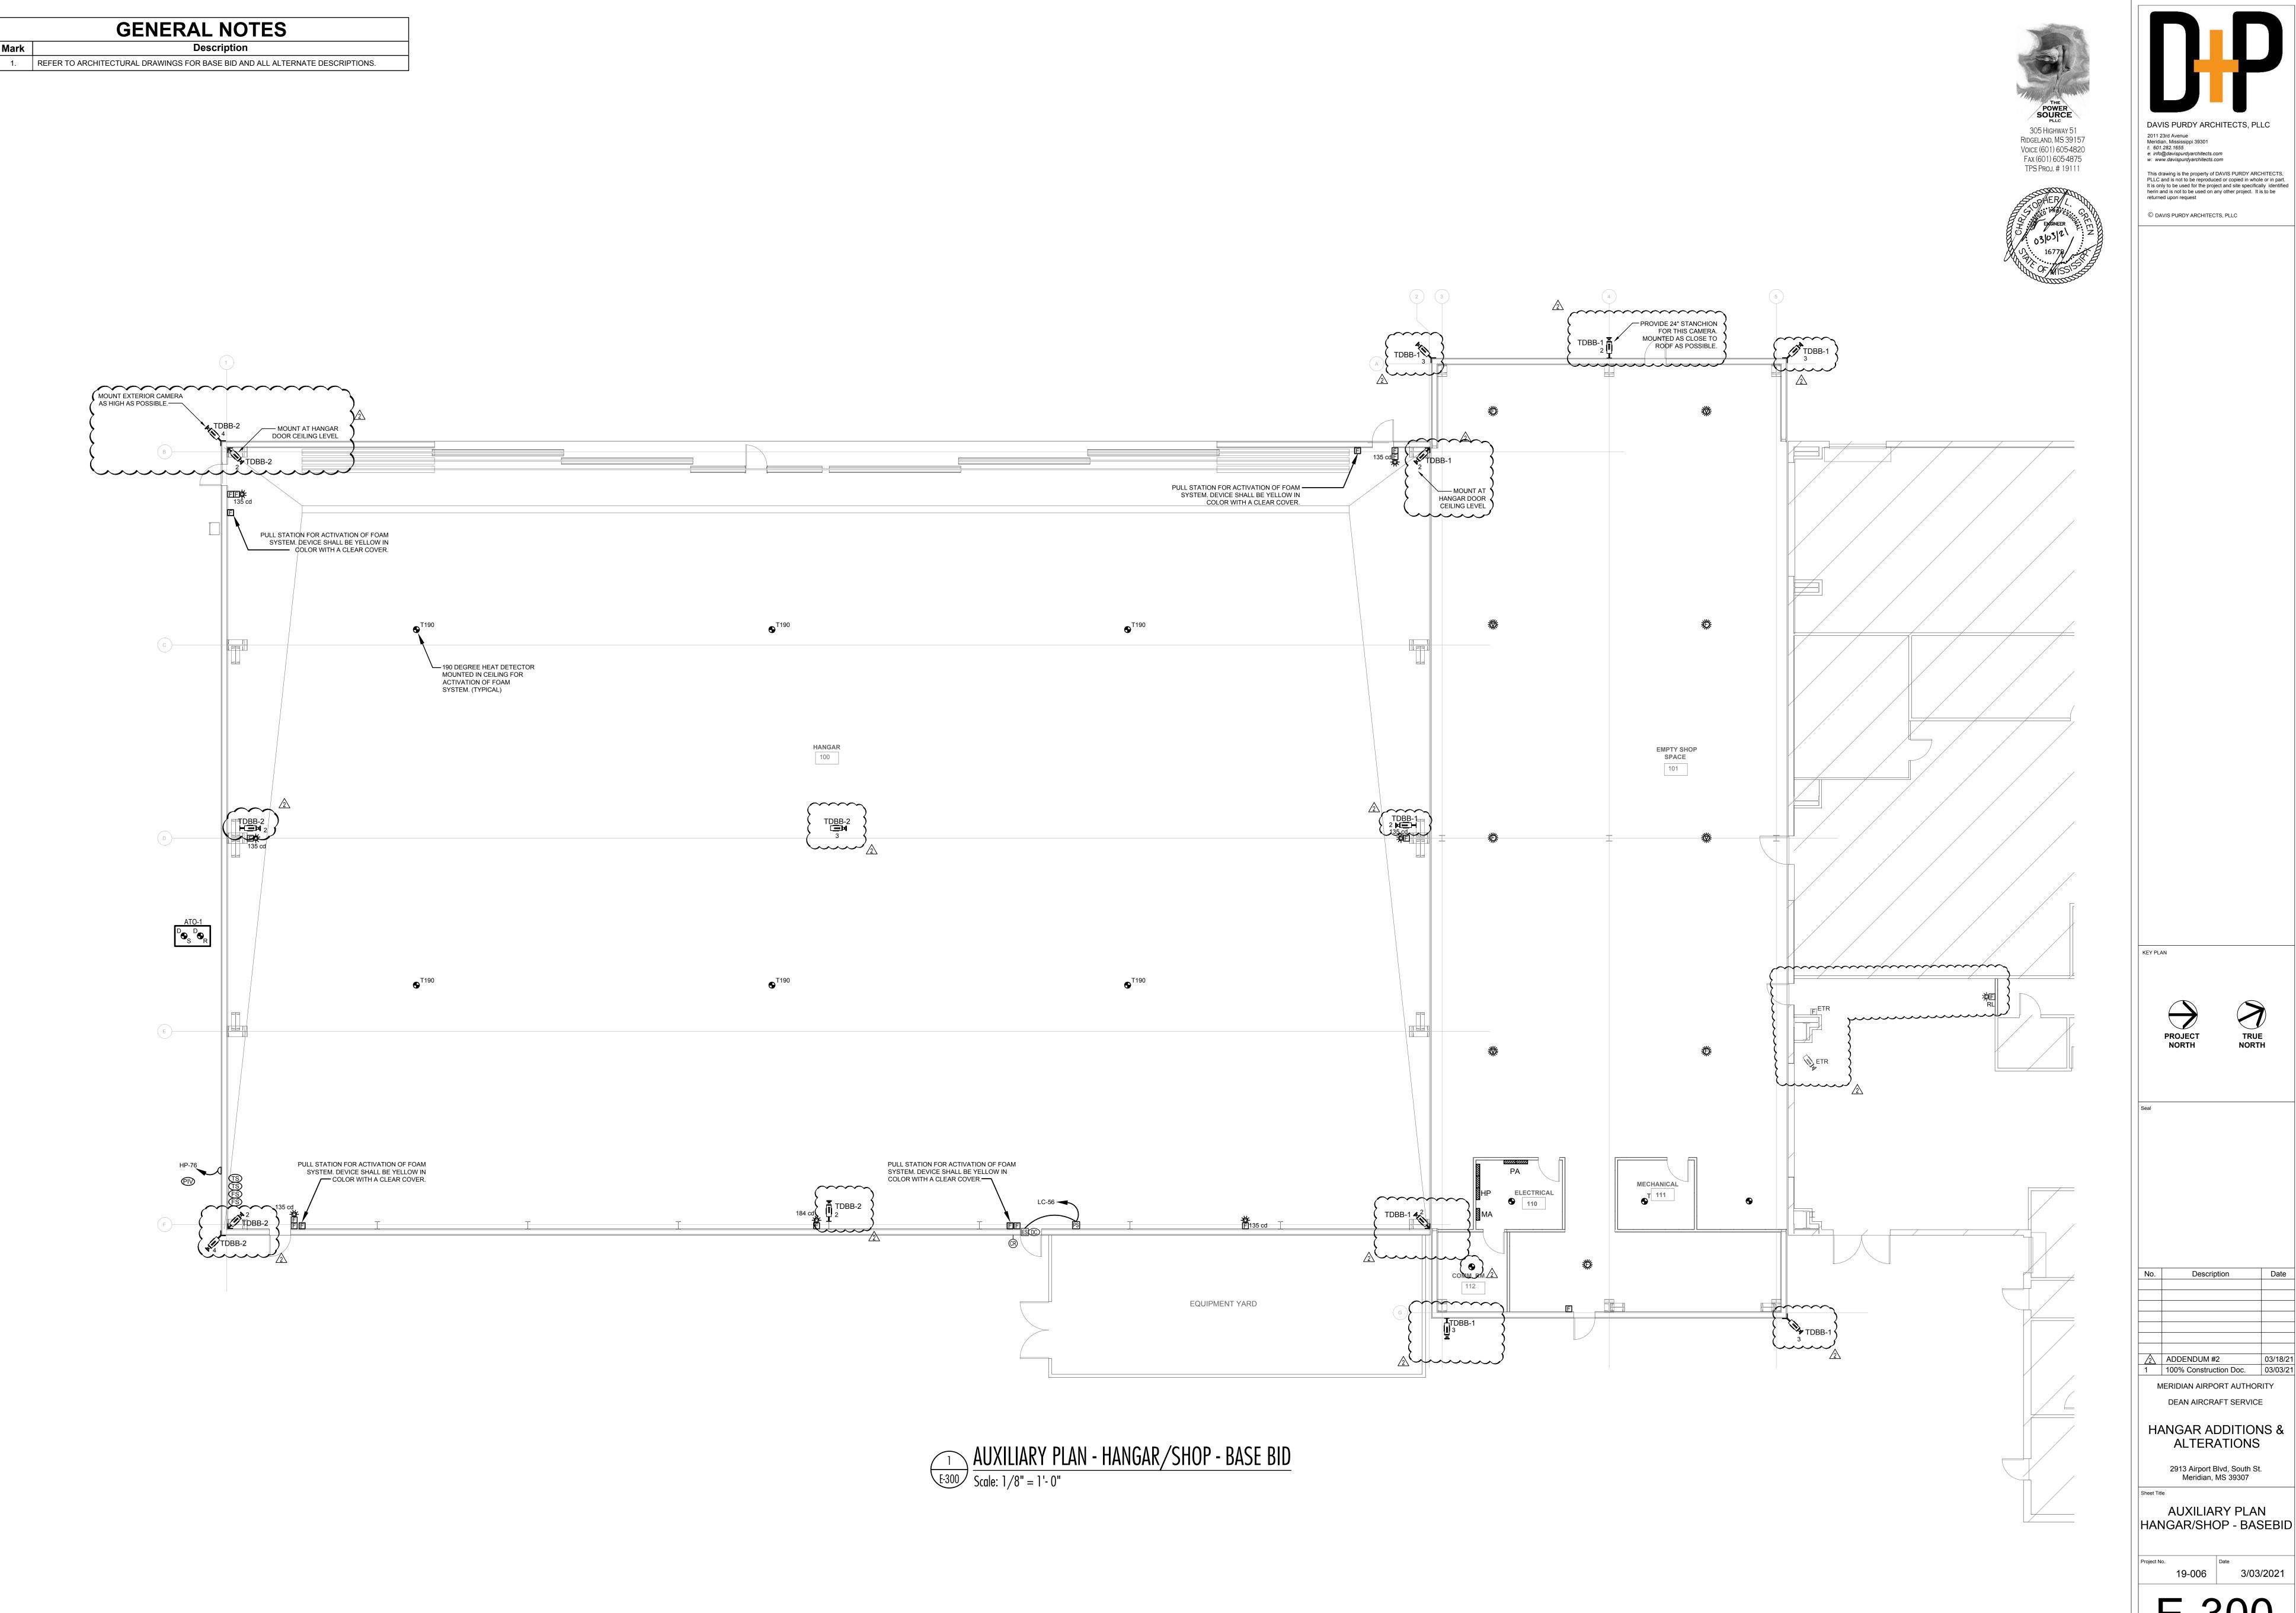

DAVIS PURDY ARCHITECTS, PLLC This drawing is the property of DAVIS PURDY ARCHITECTS, PLLC and is not to be reproduced or copied in whole or in part. It is only to be used for the project and site specifically identified herin and is not to be used on any other project. It is to be returned upon request


> MERIDIAN AIRPORT AUTHORITY DEAN AIRCRAFT SERVICE HANGAR ADDITIONS & ALTERATIONS

2913 Airport Blvd, South St. Meridian, MS 39307


19-006 3/03/2021

GENERAL NOTES


Description 1. REFER TO ARCHITECTURAL DRAWINGS FOR BASE BID AND ALL ALTERNATE DESCRIPTIONS.

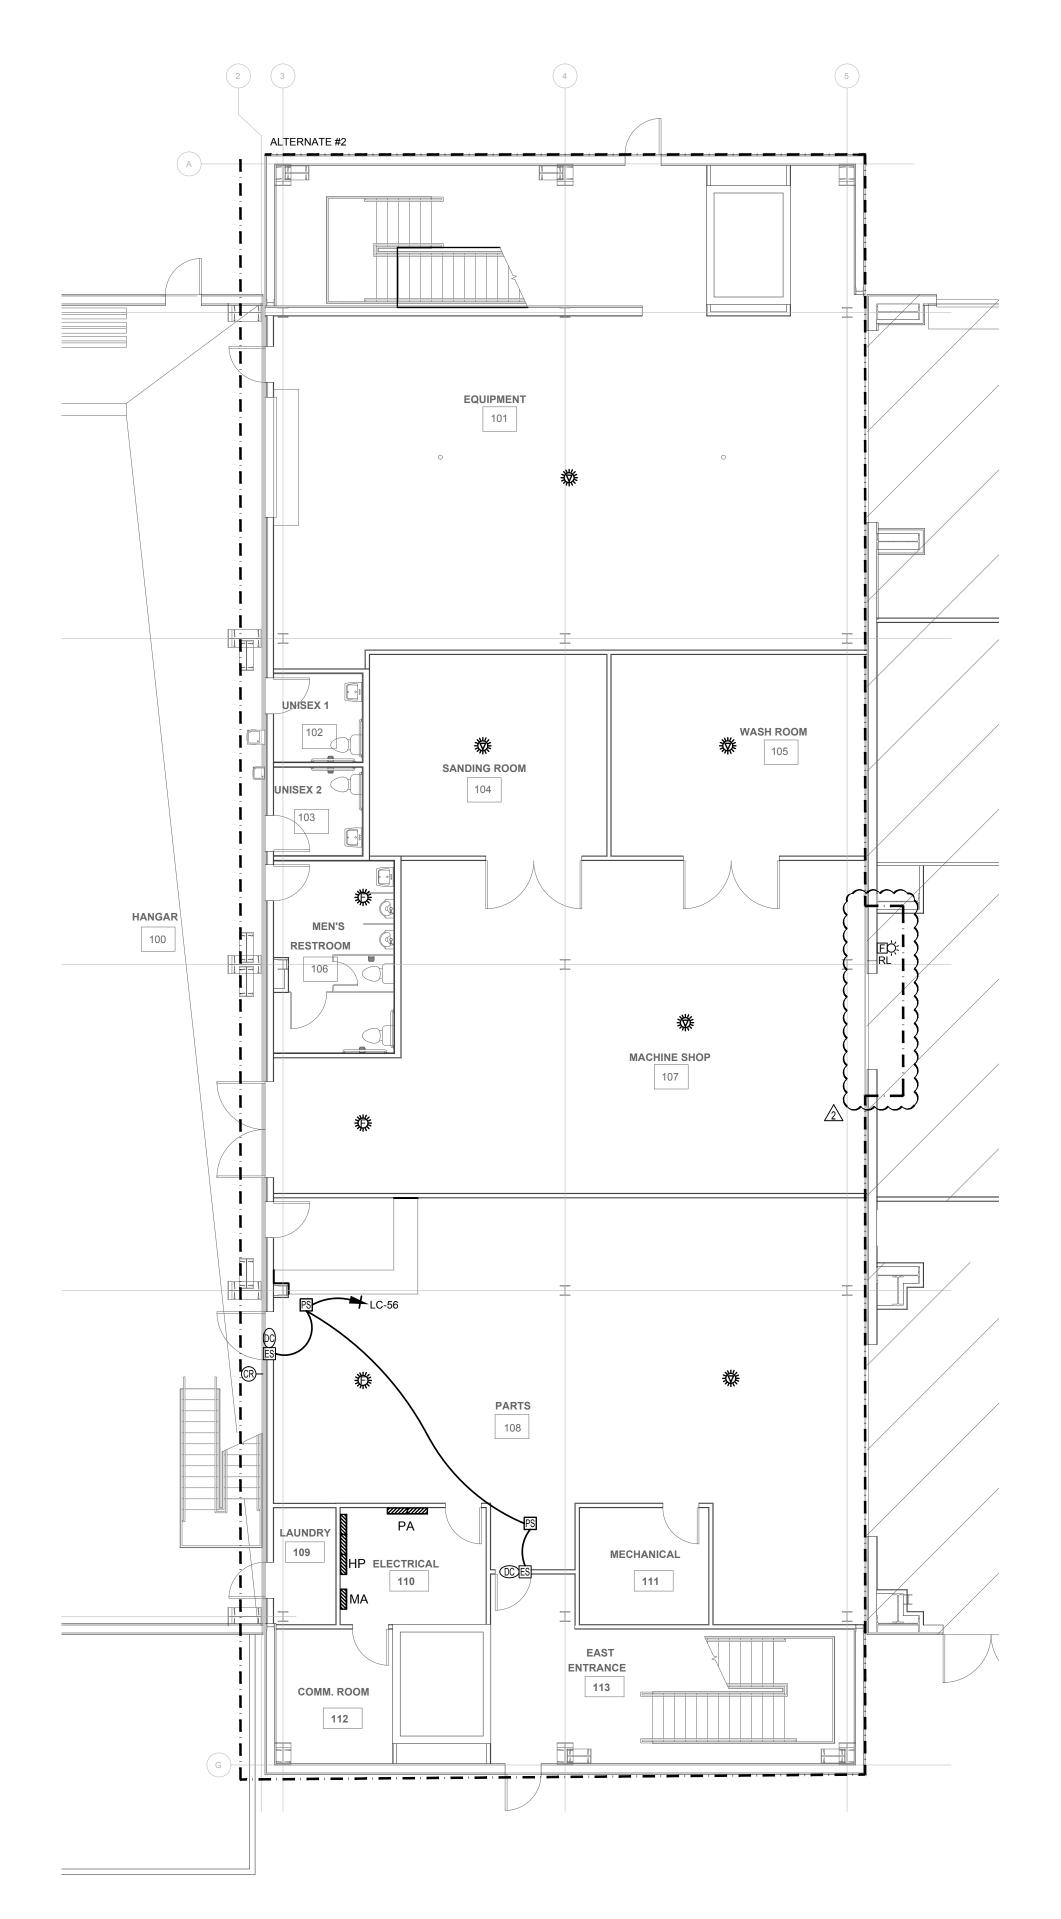


 $\frac{1}{\text{E-301}} \frac{\text{AUXILIARY PLAN - HANGAR/SHOP - ALTERNATE } \#2}{\text{Scale: } 1/8" = 1' - 0"}$

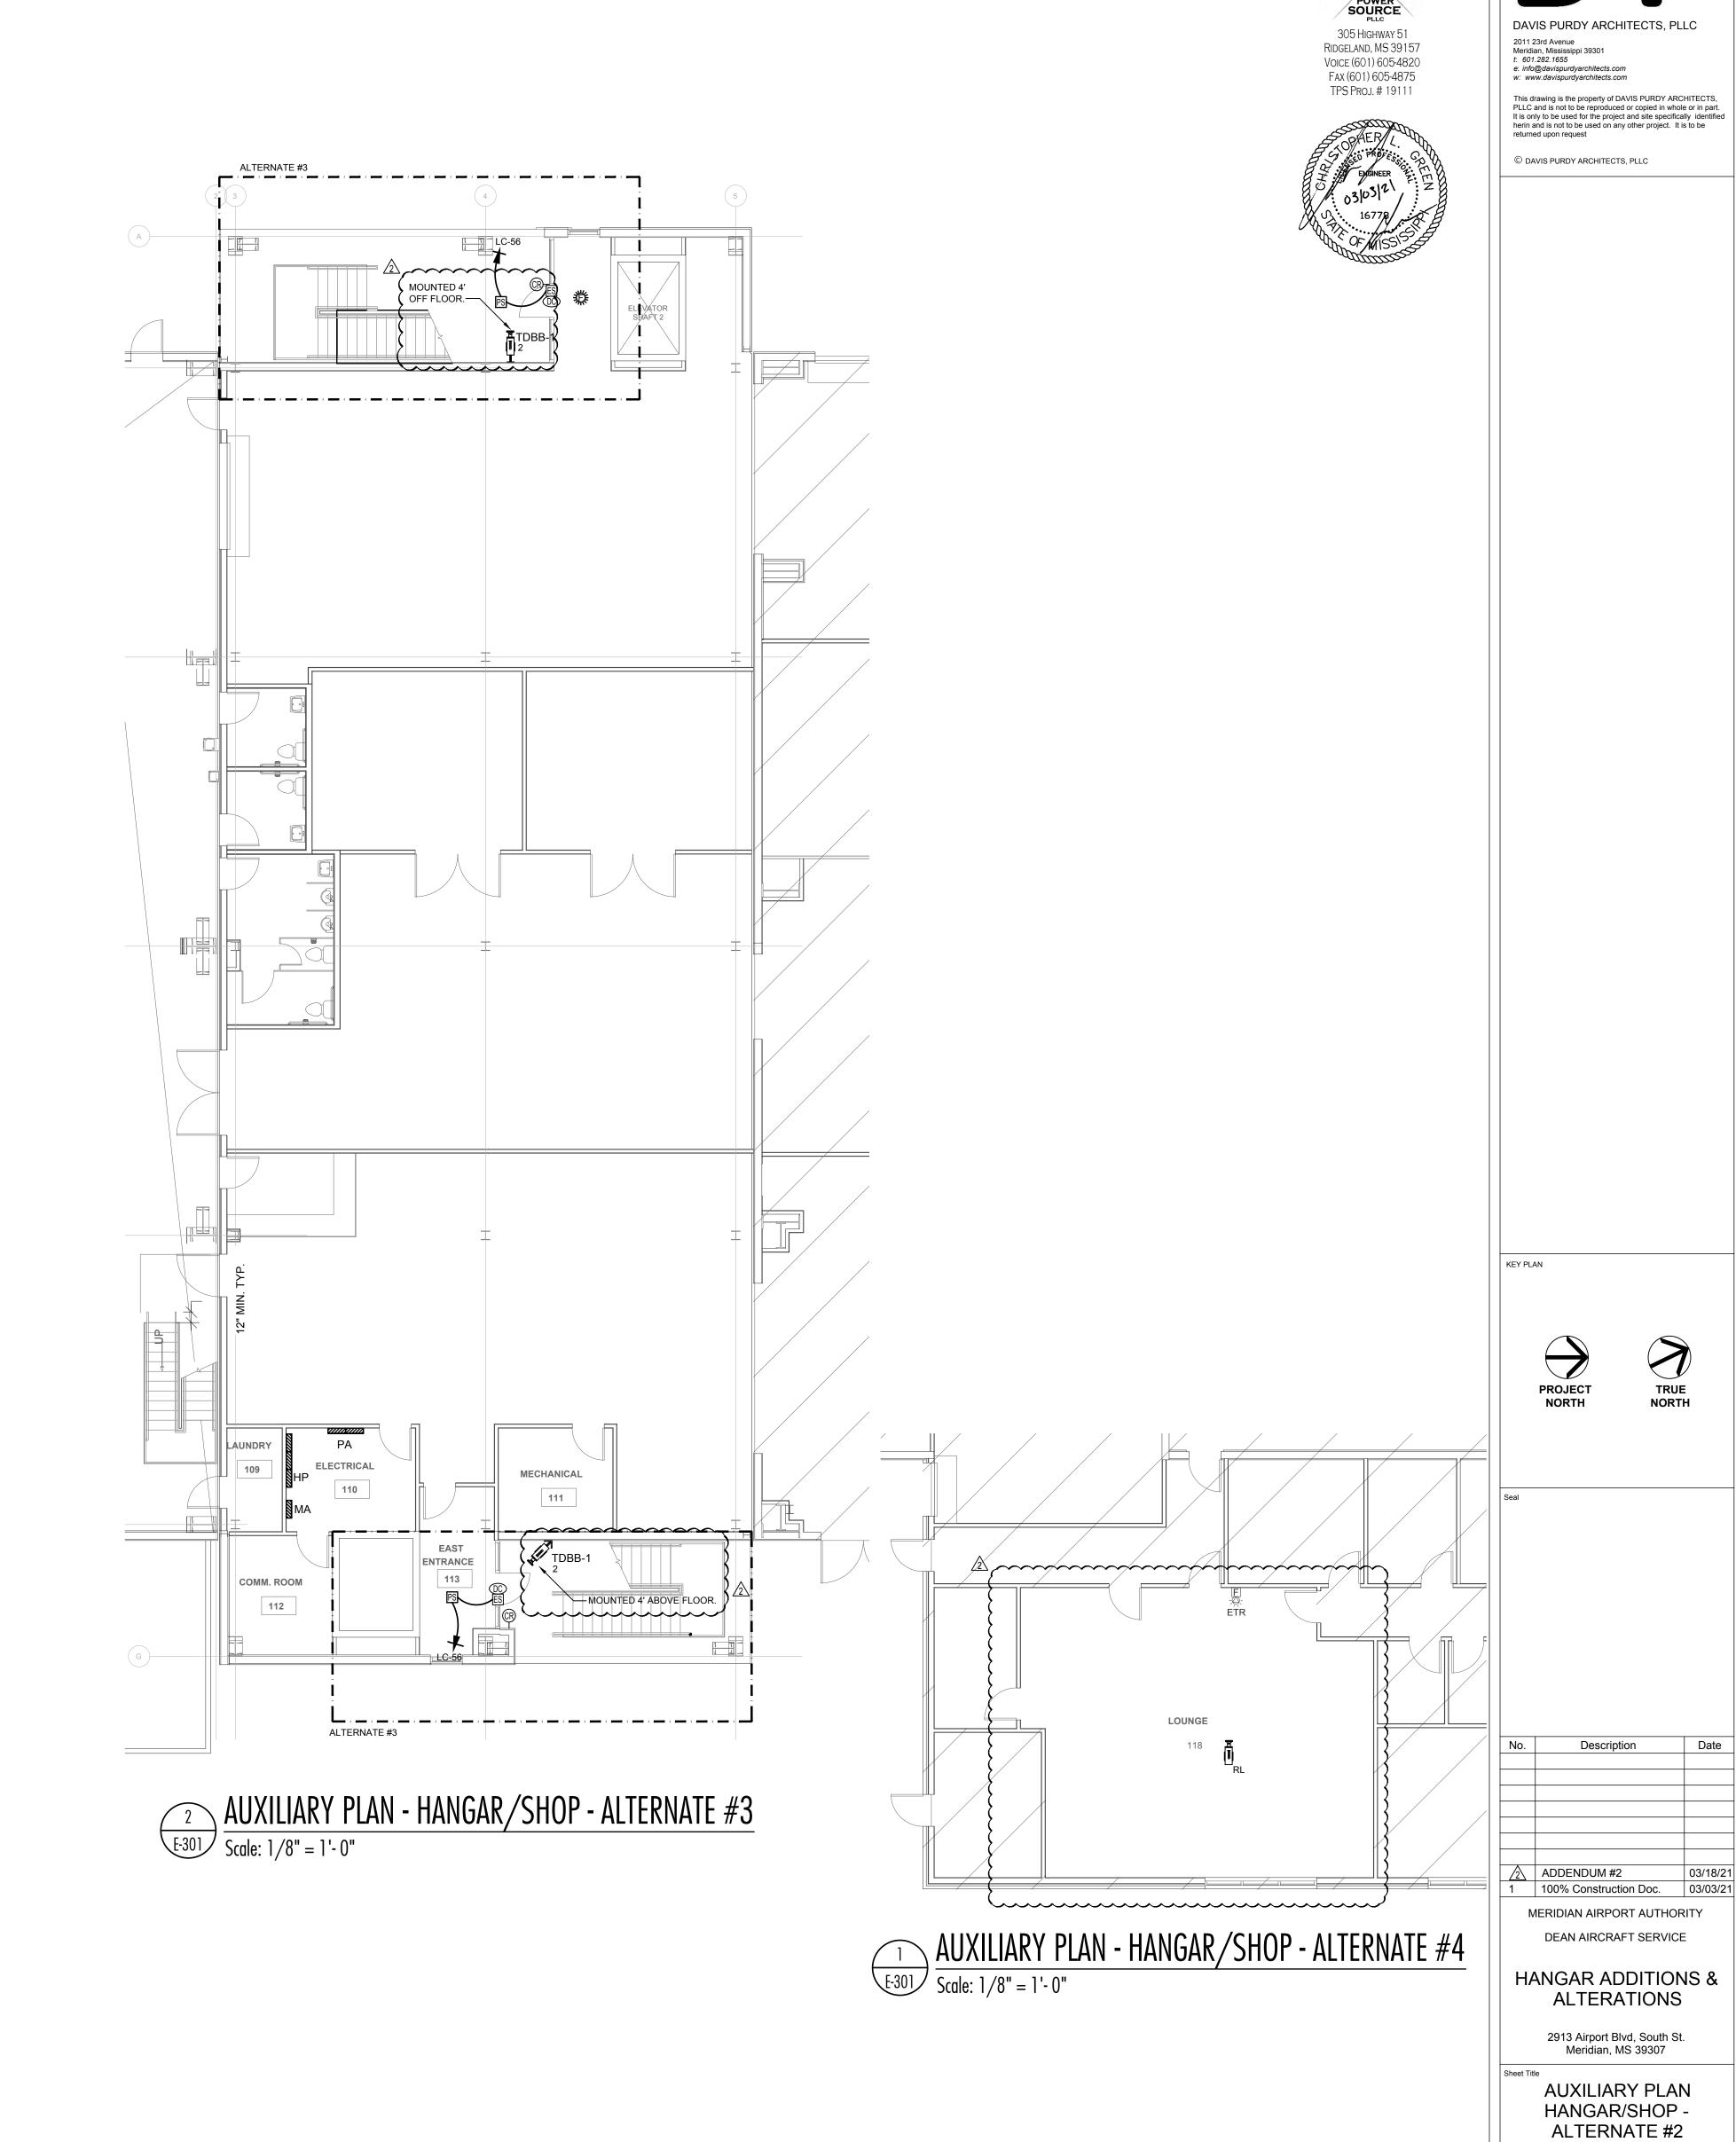

3/03/2021

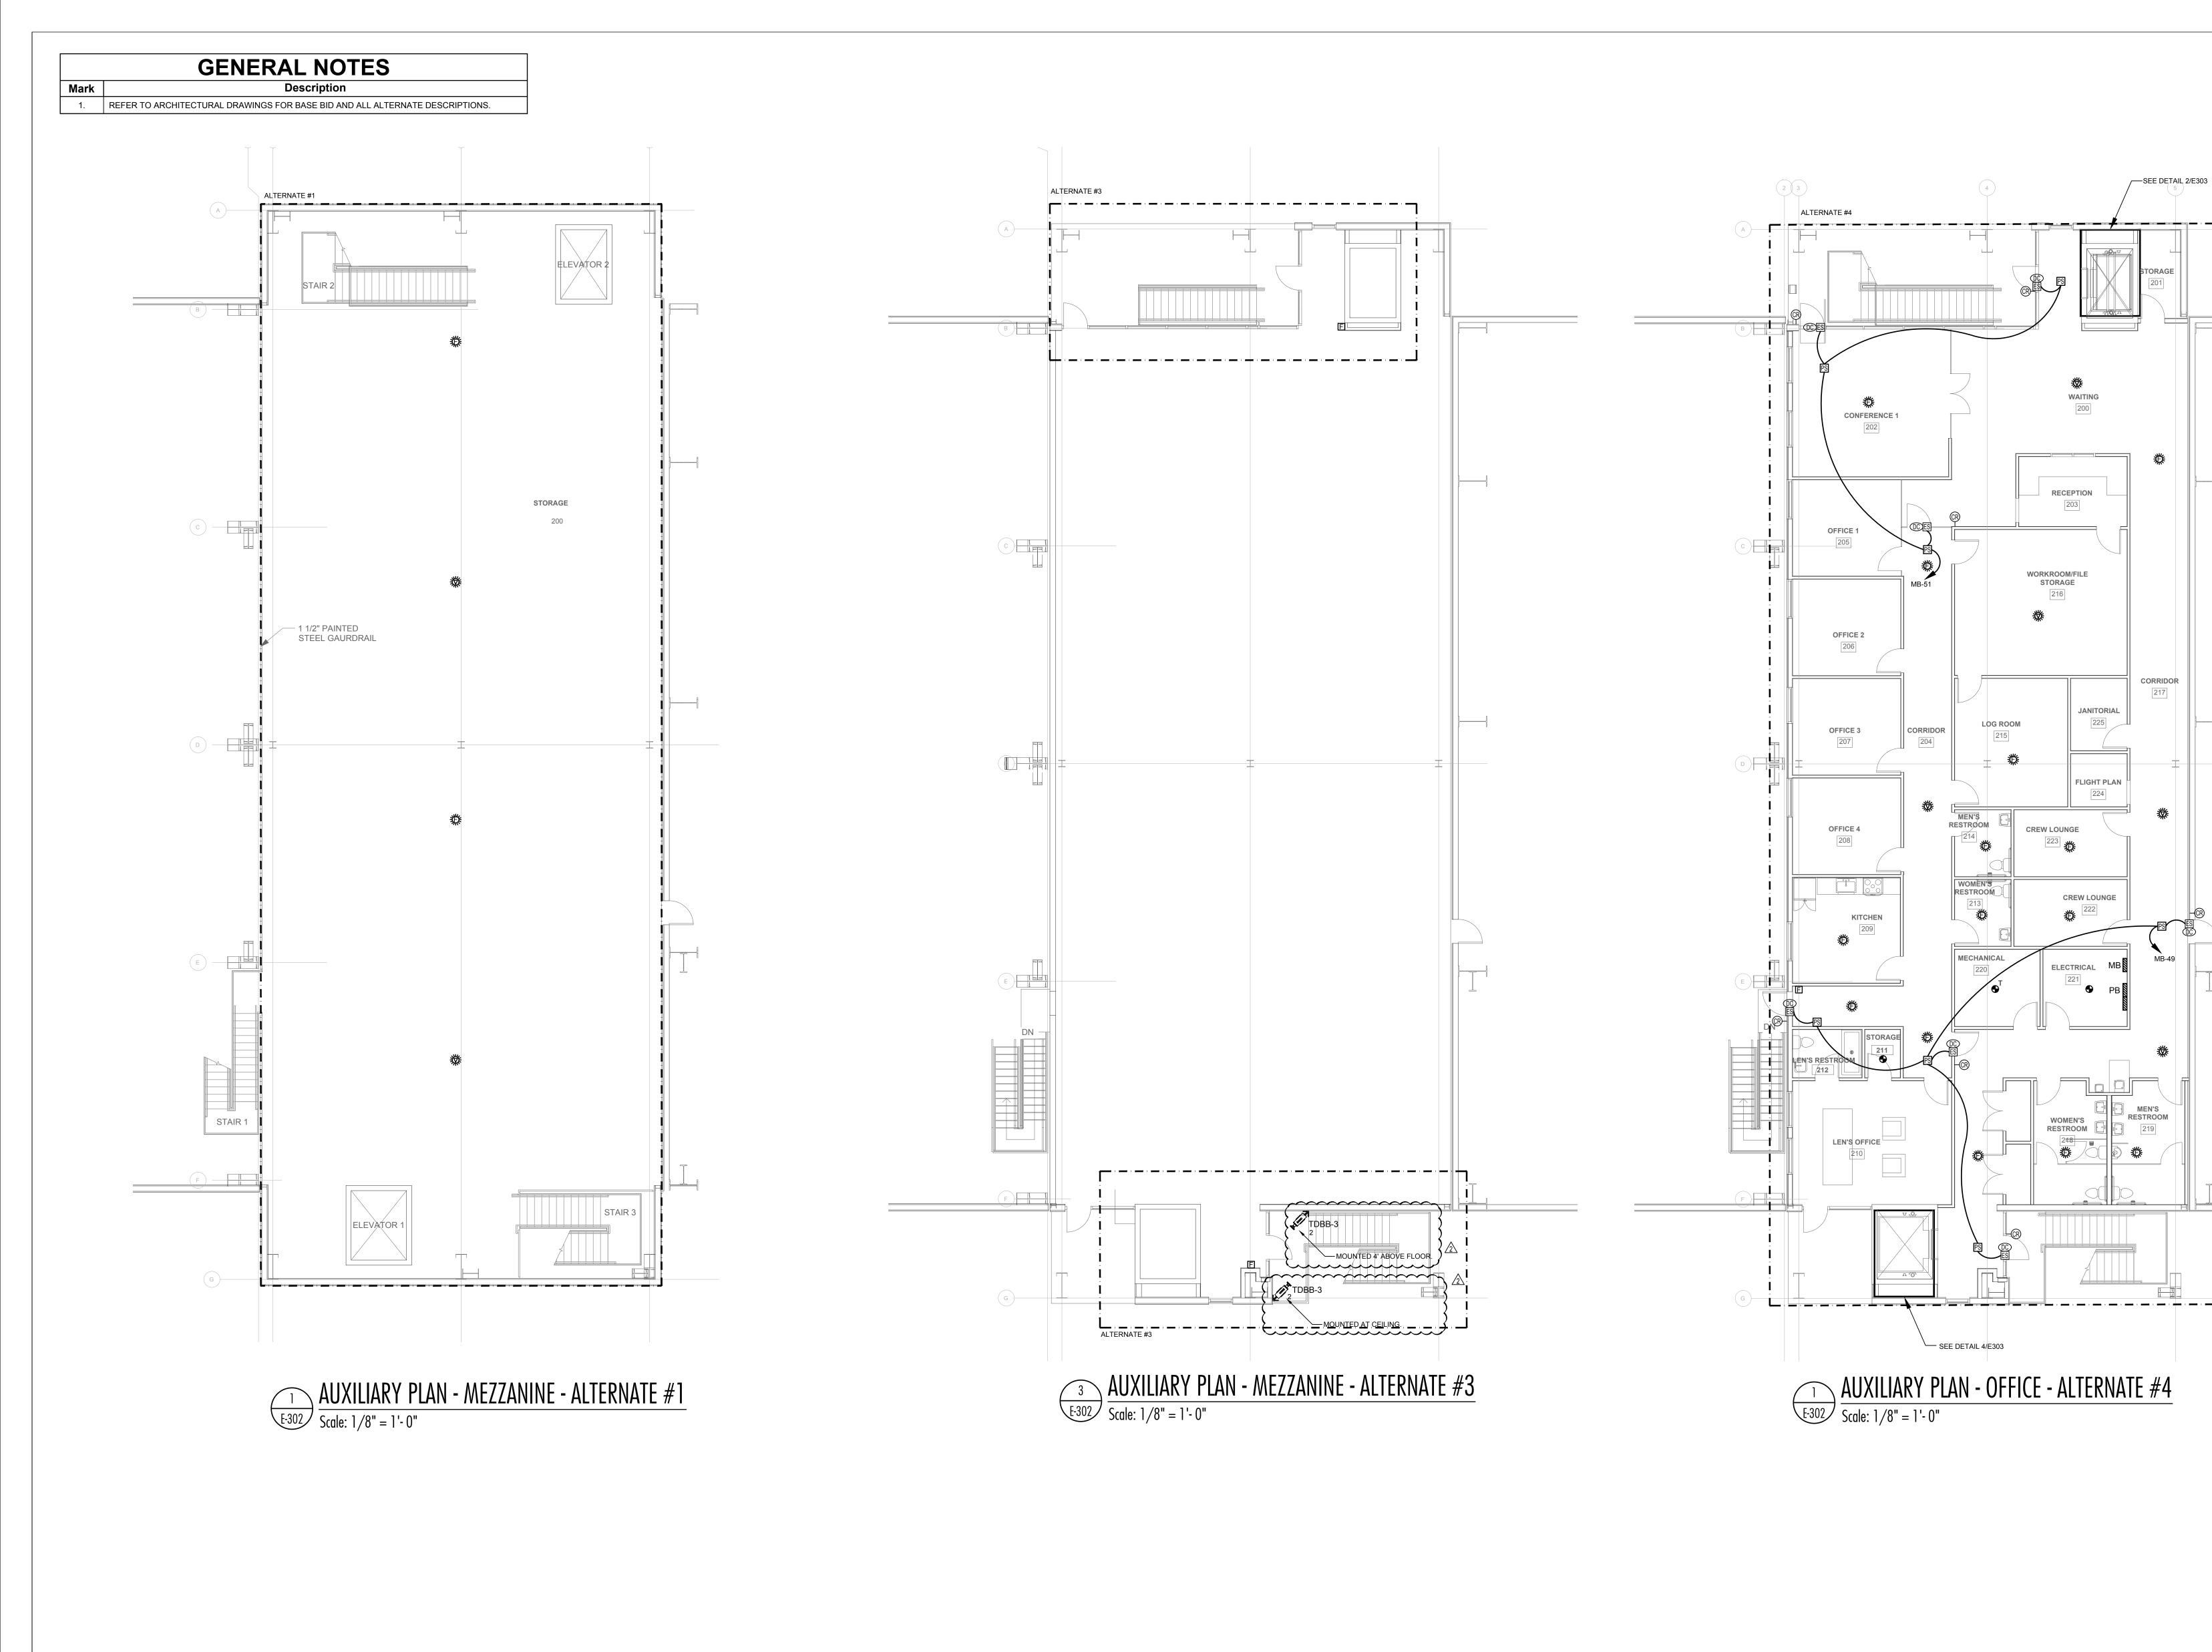

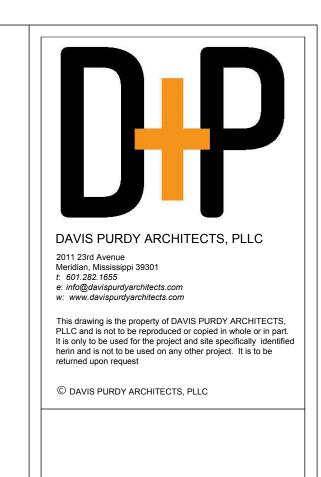

305 Highway 51

RIDGELAND, MS 39157

Voice (601) 605-4820

Fax (601) 605-4875 TPS PROJ. # 19111

> PROJECT NORTH

KEY PLAN

TRUE NORTH

No. Description Date

ADDENDUM #2 03/1
1 100% Construction Doc. 03/0

MERIDIAN AIRPORT AUTHORITY

MERIDIAN AIRPORT AUTHORITY

DEAN AIRCRAFT SERVICE

HANGAR ADDITIONS & ALTERATIONS


2913 Airport Blvd, South St. Meridian, MS 39307


AUXILIARY PLAN MEZZANINE - ALTERNATE #1,2,3 & 3

19-006 Date 3/03/2021

 Ξ -302

GENERAL NOTES Description 1. REFER TO ARCHITECTURAL DRAWINGS FOR BASE BID AND ALL ALTERNATE DESCRIPTIONS.

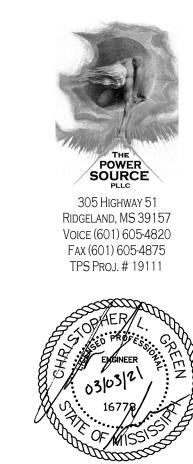

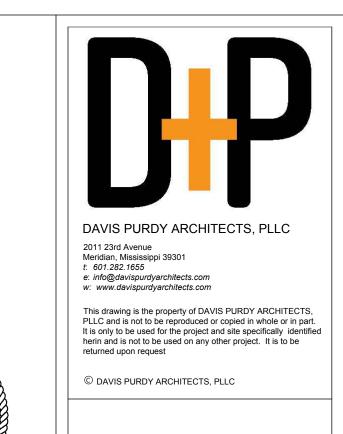



Description

ADDENDUM #2 1 100% Construction Doc. MERIDIAN AIRPORT AUTHORITY DEAN AIRCRAFT SERVICE

HANGAR ADDITIONS & ALTERATIONS

2913 Airport Blvd, South St. Meridian, MS 39307

MECHANICAL PLAN HANGAR/SHOP -ALTERNATE #1

E-401

