

GS#411-119
PARKING LOT IMPROVEMENTS AT BRADLEY SANDERS BUILDING
EAST MISSISSIPPI STATE HOSPITAL
MERIDIAN, MS

ADDENDUM NO. 1

TO: ALL BIDDERS ON THE ABOVE REFERENCED PROJECT

FROM: Keith McCraney, PE, Project Engineer

DATE: October 18, 2017

SUBJECT: **ADDENDUM NO. 1**


Clarifications and revisions to Proposal and Contract Documents and Plans for the referenced project are as follow:

1. **REPLACE:** Sheets 1.0, 2.0, 3.0, 4.0 shall be replaced with the attached sheets. Corrections to contours were made resulting in adjustments to the silt fence and clearing limits.
2. **CLARIFICTION:** Any area disturbed by construction activity shall receive solid sod as noted on sheet 3 note 10.
3. **CLARIFICATION:** Any excess material is to be hauled off site or may be used on the back slopes. Slopes may be extended if needed to use excess material. All fill material shall be placed and compacted as required by geotechnical report and noted on sheet 3. All requirements remain the same.
4. **CLARIFICATION:** All debris shall be properly disposed of off-site. Refer to note 2, sheet 2.0.
5. **COMMENTS from Pre-Bid meeting:**
 - A. Leave no blanks on the Bid Form. If the requested information is not relevant, then mark it as 'NA'. Bid will be rejected if you leave it blank.
 - B. Bureau of Buildings regulations require that Alternates be selected in the order listed. (i.e. If Alt 1 is selected then Alt. 2 may be selected, if 2 is selected then 3 may be selected...etc. However, if Alt 1 is not selected then Alt 2 or others cannot be selected.)

All other requirements remain the same.

BIDDER IS ADVISED THAT ADDENDUM ACKNOWLEDGMENT IS REQUIRED.
SIGNED ACKNOWLEDGEMENT SHALL BE INCLUDED IN THE BID PROPOSAL.
FAILURE TO PROPERLY ACKNOWLEDGE ADDENDA MAY BE GROUNDS
FOR REJECTION OF BID.

Submitted By:

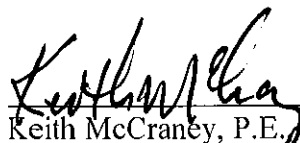

Keith McCraney, P.E., Project Engineer
Engineering Plus, Inc.

Acknowledged By:

Contractor

Date: _____

GS#411-119

CONSTRUCTION OF PARKING LOT IMPROVEMENTS

AT BRADLEY SANDERS BUILDING

FOR

EAST MISSISSIPPI STATE HOSPITAL

MERIDIAN, LAUDERDALE COUNTY, MS




PROJECT LOCATION

SCALE: 1" = 600'

PROJECT SITE

SHEET INDEX

SHEET 1.0-R1	TITLE SHEET
SHEET 2.0-R1	SITE AND DEMOLITION PLAN
SHEET 3.0-R1	GRADING AND STORM DRAINAGE PLAN
SHEET 4.0-R1	EROSION CONTROL PLAN
SHEET 5.0	STRIPING AND PARKING PLAN
SHEET 6.0	ELECTRICAL LIGHTING PLAN

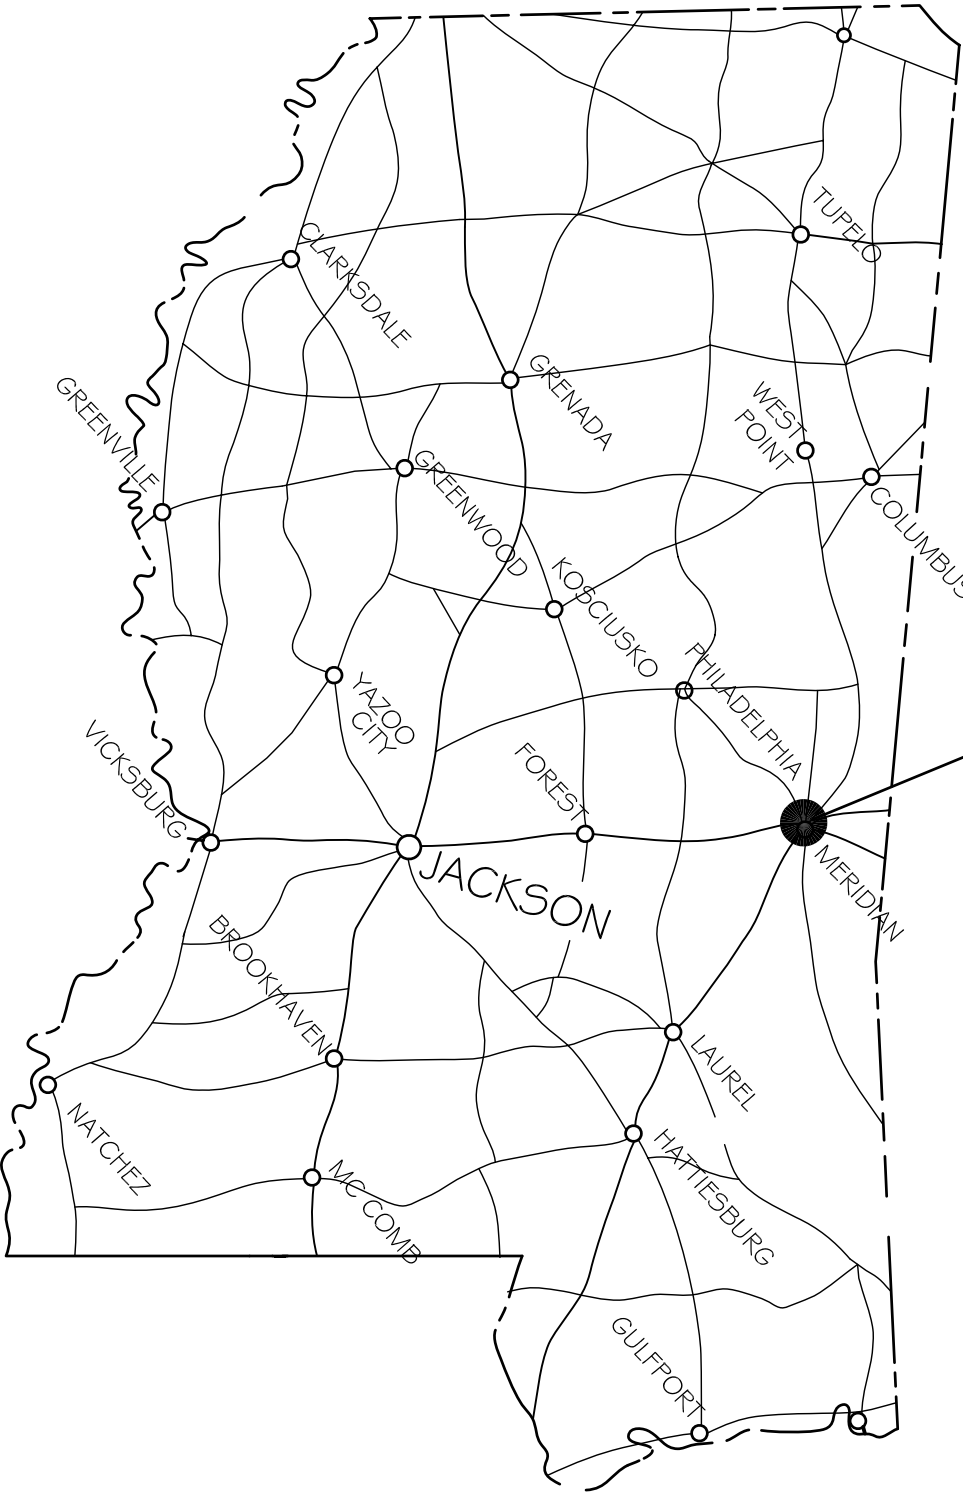

PROJECT LOCATION

SITE VICINITY

LIST OF DEDUCTIVE ALTERNATES

1. DELETE LIGHTING AND ASSOCIATED ELECTRICAL WORK AT PARKING LOT.
2. DELETE AUTOMOBILE WHEEL STOPS AT PARKING LOT.
3. DELETE GRASSING BY SOD FROM SITE AND PROVIDE GRASSING BY SEEDING
4. DELETE SITE STORM DRAINAGE SYSTEM - PROVIDE 100 L.F. 12" DIA. DRIVEWAY CULVERTS

PREPARED BY:

ENGINEERING PLUS, INC.

Planning • Surveying • Testing • Landscape Design

1724-B 23rd Ave. Meridian, Mississippi 39301 (601) 693-4234

APRIL 2017



Engineering Plus

Planning • Surveying • Testing • Landscape Design



1724-B 23rd Ave. Meridian, Mississippi 39301 (601) 693-4234

NO.	DATE	REVISION	DESCRIPTION	BY
1	10/17/17		REVISE INDEX	KHM
GS#411-119 PARKING LOT IMPROVEMENTS AT BRADLEY SANDERS BUILDING TITLE SHEET				
FOR: EAST MISSISSIPPI STATE HOSPITAL MERIDIAN, LAUDERDALE COUNTY, MS				
F.B.	P.	DATE: 8/8/2016		SHEET
DWG FILE: \Civil 3D Projects\Private Projects\2015 15-133 E MS Sanders\Coord\Acad-15-133 Bradley Sanders Building Parking Lot.dwg		DRAWN BY: KHM	CHECKED BY: KHM	1
JOB NO. 15-133				OF
DRAWING NO. D-4399		SCALE: AS SHOWN		6

F.B.	P.	DATE: 8/8/2016	SHEET
DWG FILE: \Civil 3D Projects\Private Projects\2015 \15-133 E MS Sanders\Coord-15-133 Bradley Sanders Building Parking Lot.dwg JOB NO. 15-133 DRAWING NO. D-4399		DRAWN BY: KHM CHECKED BY: KHM SCALE: AS SHOWN	2 OF 6

LEGEND:

CONTROL POINT COORDINATE (NORTH, EAST) (9861.12, 9646.96)
EXISTING GROUND CONTOUR
PROPOSED FINISH GRADE CONTOUR
PROPOSED FINISH GRADE ELEVATION

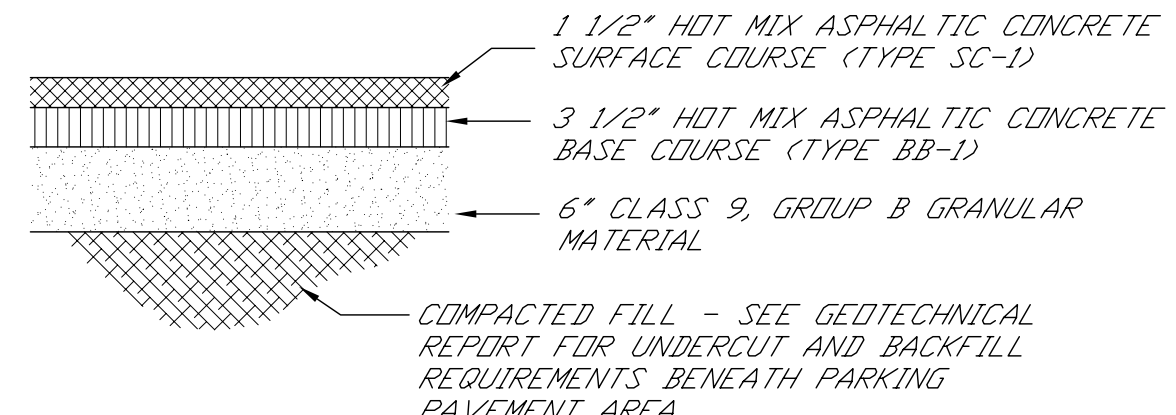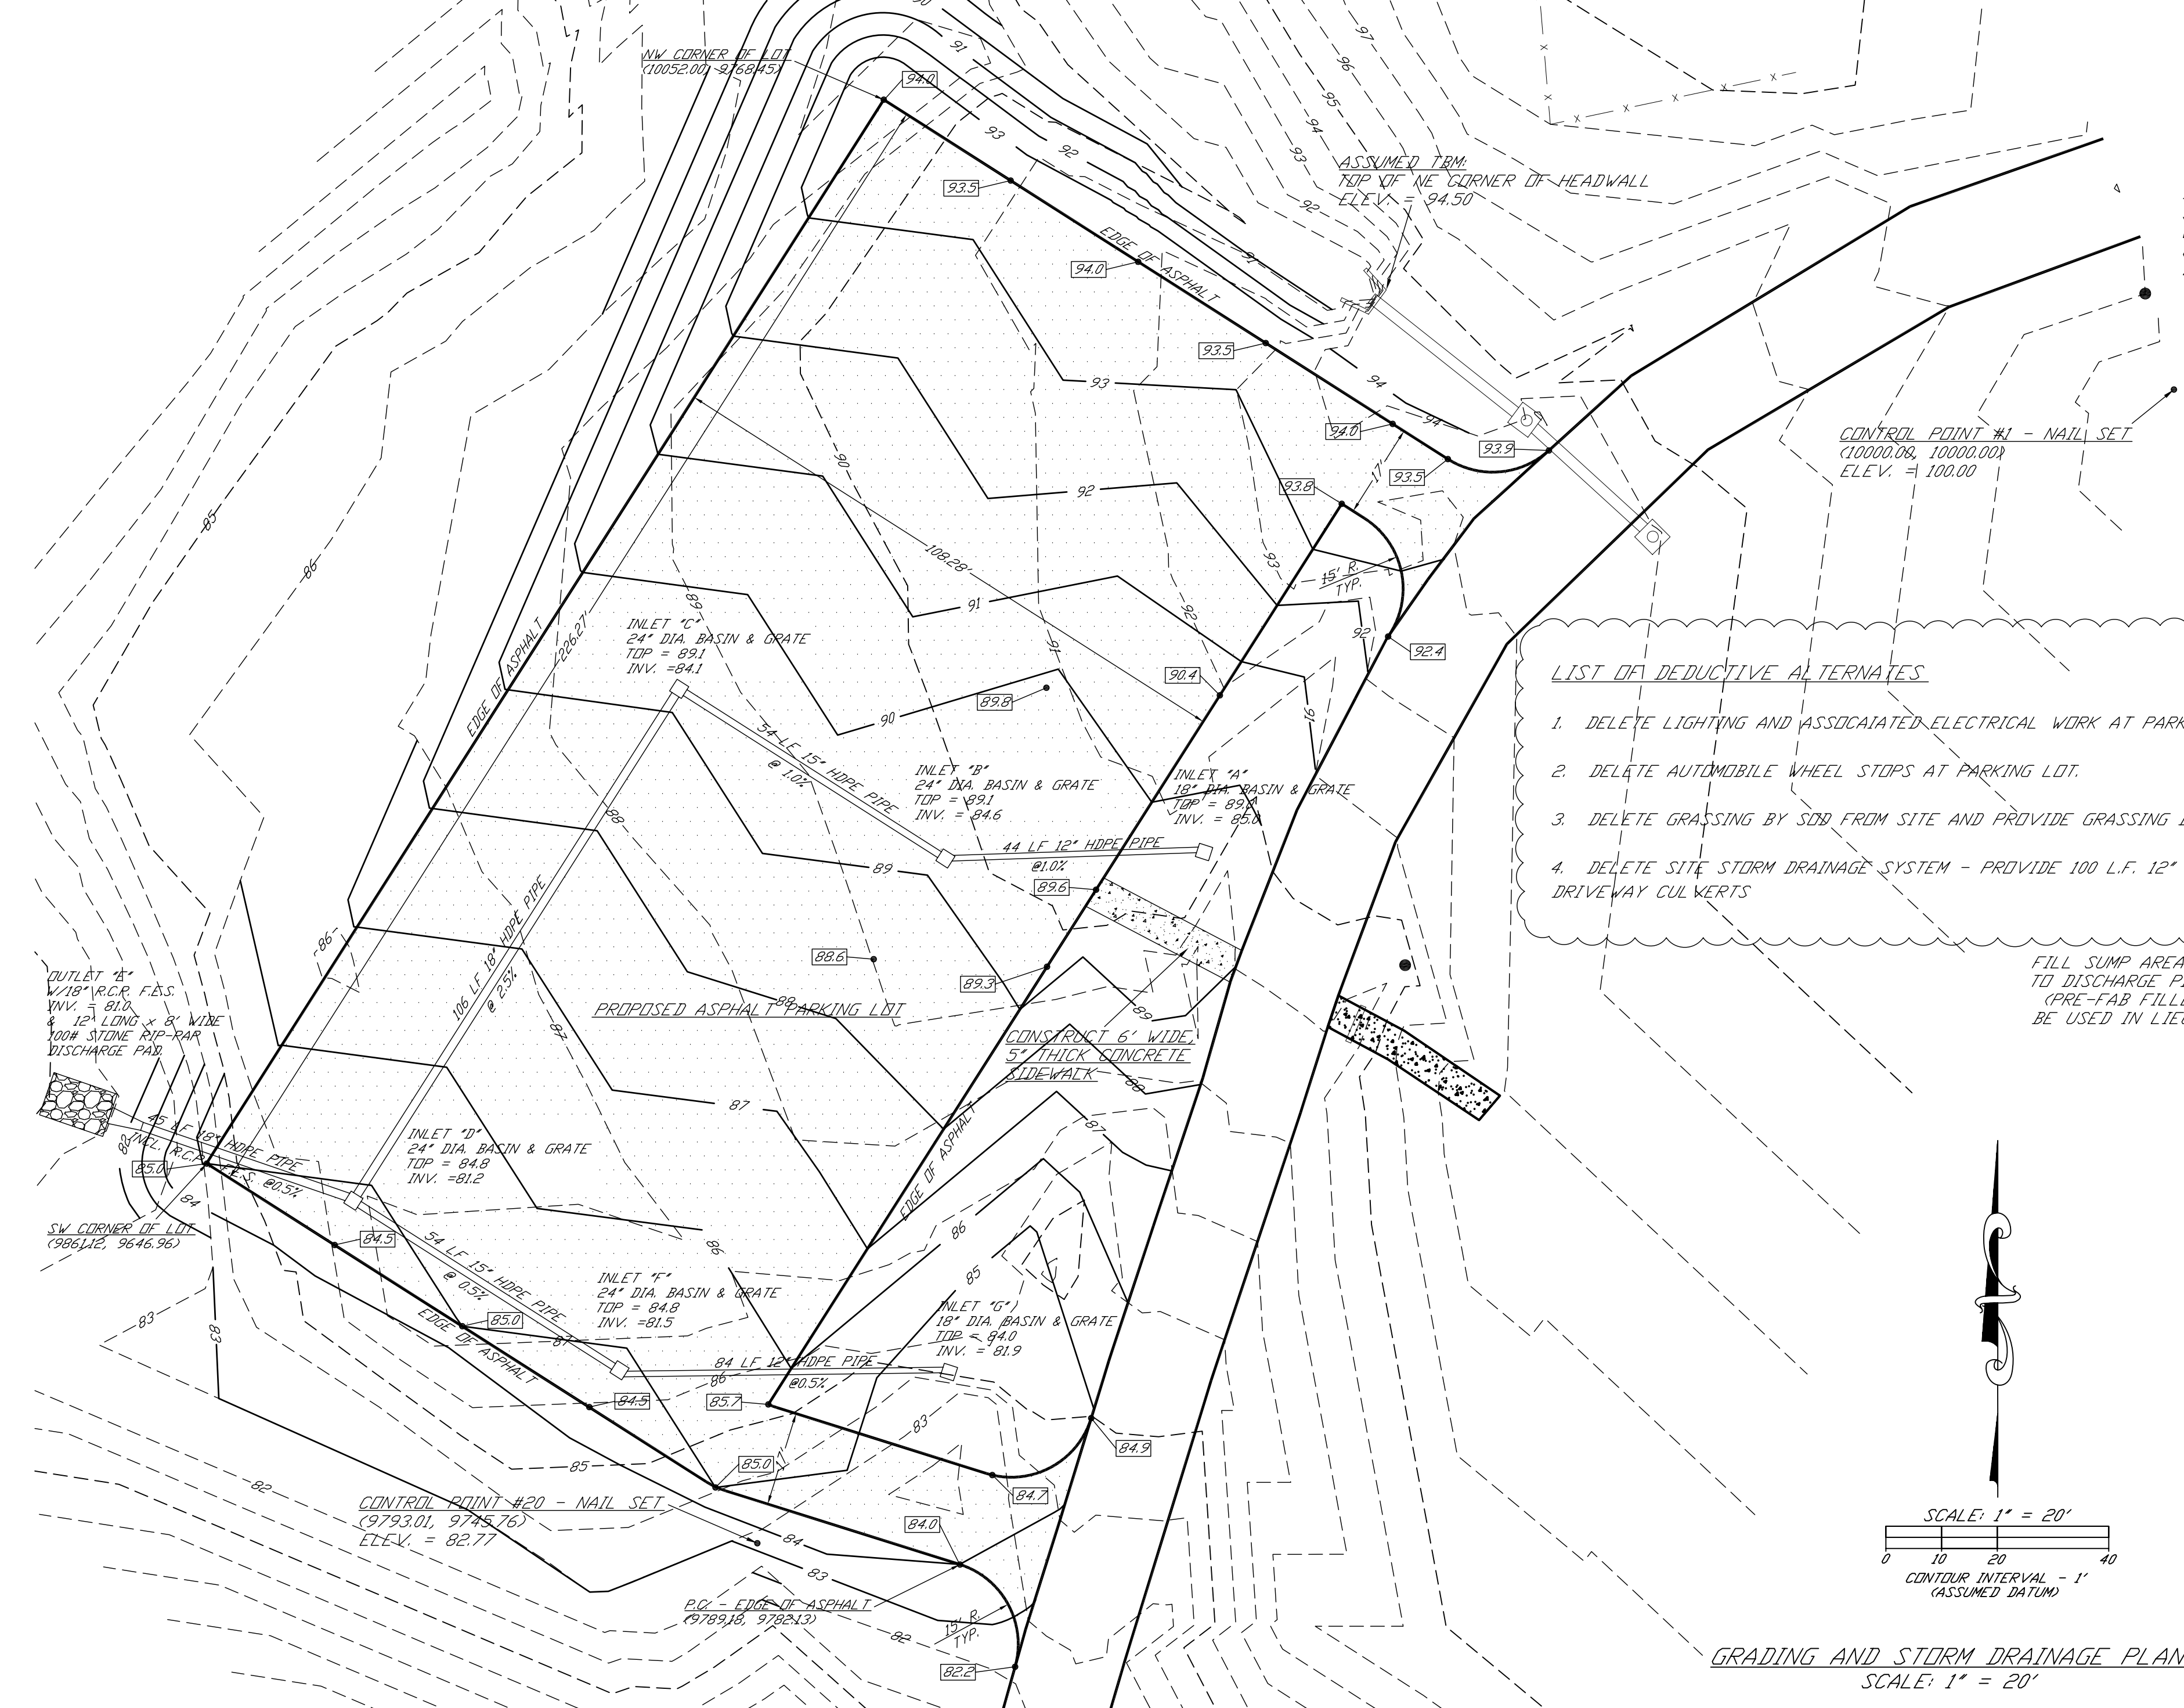


LIGHT DUTY ASPHALT PAVEMENT (FLEXIBLE)
(PARKING AREA)

*NOTE:
SOIL BORINGS IN PAVEMENT AREAS AND PAVEMENT RECOMMENDATIONS WERE INCLUDED AS A PART OF THE GEOTECHNICAL INVESTIGATION. CONTRACTOR SHALL NOTIFY PROJECT ENGINEER IMMEDIATELY SHOULD EXISTING SUBSURFACE CONDITIONS DIFFER FROM THOSE ANTICIPATED.

PAVEMENT DETAILS

TURF INLETS
DETAIL SHOWN PER
NYLOPLAST 18\"/>

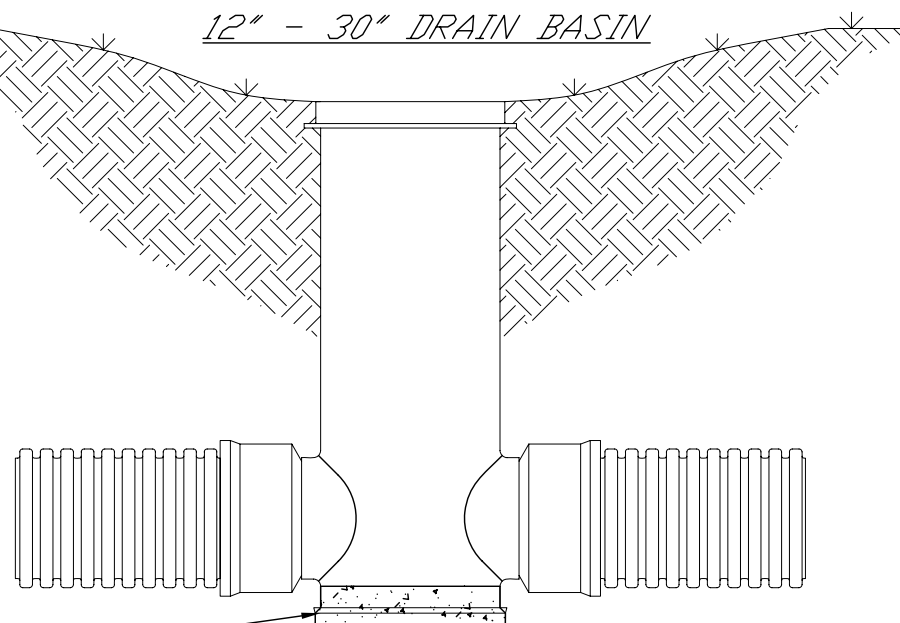


LIST OF DEDUCTIVE ALTERNATES

1. DELETE LIGHTING AND ASSOCIATED ELECTRICAL WORK AT PARKING LOT
2. DELETE AUTOMOBILE WHEEL STOPS AT PARKING LOT.
3. DELETE GRASSING BY SOD FROM SITE AND PROVIDE GRASSING BY SEEDING
4. DELETE SITE STORM DRAINAGE SYSTEM - PROVIDE 100 L.F. 12\"/>

FILL SUMP AREA WITH CONCRETE TO DISCHARGE PIPE FLOW LINE (PRE-FAB FILLER BY MANUF. MAY BE USED IN LIEU OF CONCRETE)

BACKFILL MATERIAL BELOW AND TO SIDES OF STRUCTURE SHALL BE NATIVE SOIL AND BE PLACED UNIFORMLY IN 12\"/>

NON-TRAFFIC, TURF INSTALLATION

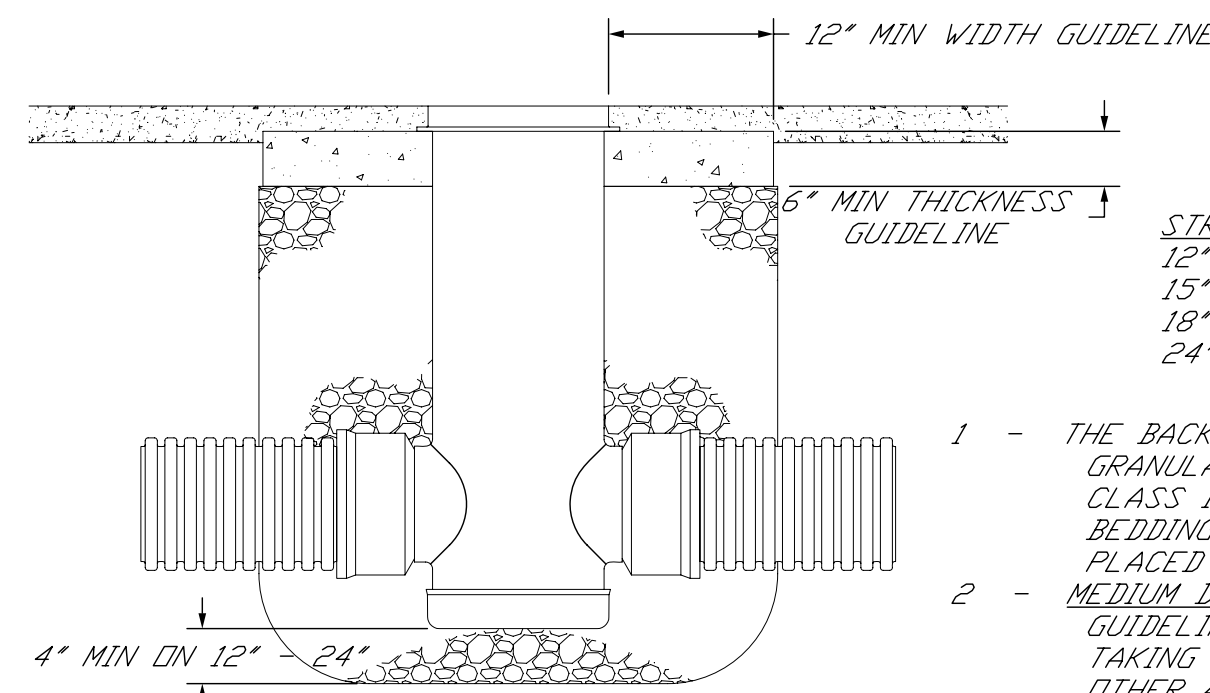

STRUCTURE	H-10 GRATE OPTIONS
12"	PEDESTRIAN
15"	PEDESTRIAN
18"	PEDESTRIAN
24"	PEDESTRIAN

- 1 - THE BACKFILL MATERIAL SHALL BE CRUSHED STONE OR OTHER GRANULAR MATERIAL MEETING THE REQUIREMENTS OF CLASS I, CLASS II, OR CLASS III MATERIAL AS DEFINED IN ASTM D2321.
- 2 - BEDDING & BEDDING FOR SURFACE DRAINAGE INLETS SHALL BE PLACED & COMPACTED UNIFORMLY IN ACCORDANCE WITH ASTM D2321.
- 3 - MEDIUM DUTY TRAFFIC LOADS: CONCRETE SLAB DIMENSIONS ARE FOR GUIDELINE PURPOSES ONLY. ACTUAL CONCRETE SLAB MUST BE DESIGNED TAKING INTO CONSIDERATION LOCAL SOIL CONDITIONS, TRAFFIC LOADING, & OTHER APPLICABLE DESIGN FACTORS.


ASPHALT DRAIN BASIN INSTALLATION

DRAIN BASIN DETAIL

GRADING AND STORM DRAINAGE PLAN
SCALE: 1" = 20'

NOTES:


1. ALL PIPE SYSTEMS SHALL BE INSTALLED IN ACCORDANCE WITH ASTM D2321, "STANDARD PRACTICE FOR UNDERGROUND INSTALLATION OF THERMOPLASTIC PIPE FOR SEWERS AND OTHER GRAVITY FLOW APPLICATIONS", LATEST EDITION.
2. MEASURES SHOULD BE TAKEN TO PREVENT MIGRATION OF NATIVE FINES INTO BACKFILL MATERIAL, WHEN REQUIRED.
3. FOUNDATION: WHERE THE TRENCH BOTTOM IS UNSTABLE, THE CONTRACTOR SHALL EXCAVATE TO A DEPTH REQUIRED BY THE ENGINEER AND REPLACE WITH SUITABLE MATERIAL AS SPECIFIED BY THE ENGINEER AS AN ALTERNATIVE AND AT THE DISCRETION OF THE DESIGN ENGINEER, THE TRENCH BOTTOM MAY BE STABILIZED USING A GEOTEXTILE MATERIAL.
4. BEDDING: SUITABLE MATERIAL SHALL BE CLASS I, II OR III. THE CONTRACTOR SHALL PROVIDE DOCUMENTATION FOR MATERIAL SPECIFICATION TO ENGINEER, UNLESS OTHERWISE NOTED BY THE ENGINEER. MINIMUM BEDDING THICKNESS SHALL BE 4" (100mm) FOR 4"-24" (100mm-600mm); 6" (150mm) FOR 30"-60" (750mm-900mm).
5. INITIAL BACKFILL: SUITABLE MATERIAL SHALL BE CLASS I, II OR III IN THE PIPE ZONE EXTENDING NOT LESS THAN 6" ABOVE CROWN OF PIPE. THE CONTRACTOR SHALL PROVIDE DOCUMENTATION FOR MATERIAL SPECIFICATION TO ENGINEER. MATERIAL SHALL BE INSTALLED AS REQUIRED IN ASTM D2321, LATEST EDITION.
6. MINIMUM COVER: MINIMUM COVER, H, IN NON-TRAFFIC APPLICATIONS (GRASS OR LANDSCAPE AREAS) IS 12" FROM THE TOP OF PIPE TO GROUND SURFACE. ADDITIONAL COVER MAY BE REQUIRED TO PREVENT FLOODING. FOR TRAFFIC APPLICATIONS, MINIMUM COVER, H, IS 12" UP TO 48" DIAMETER PIPE AND 24" OF COVER FOR 54"-60" DIAMETER PIPE, MEASURED FROM TOP OF PIPE TO BOTTOM OF FLEXIBLE PAVEMENT OR TO TOP OF RIGID PAVEMENT.

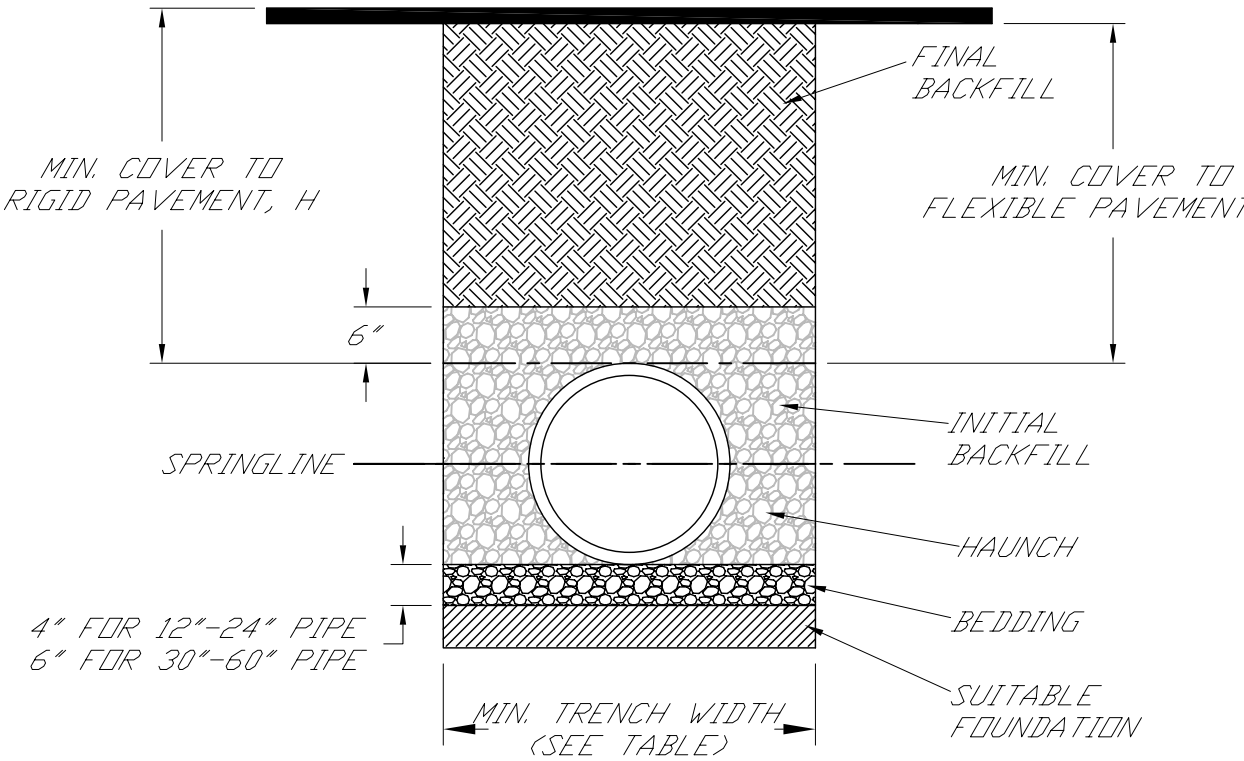

HDPE PIPE BEDDING DETAIL

MINIMUM TRENCH WIDTHS

PIPE DIAM.	TRENCH WIDTH
4"	21"
6"	23"
8"	26"
10"	28"
12"	30"
15"	34"
18"	39"
24"	48"
30"	56"
36"	64"
42"	72"
48"	80"
54"	88"
60"	96"

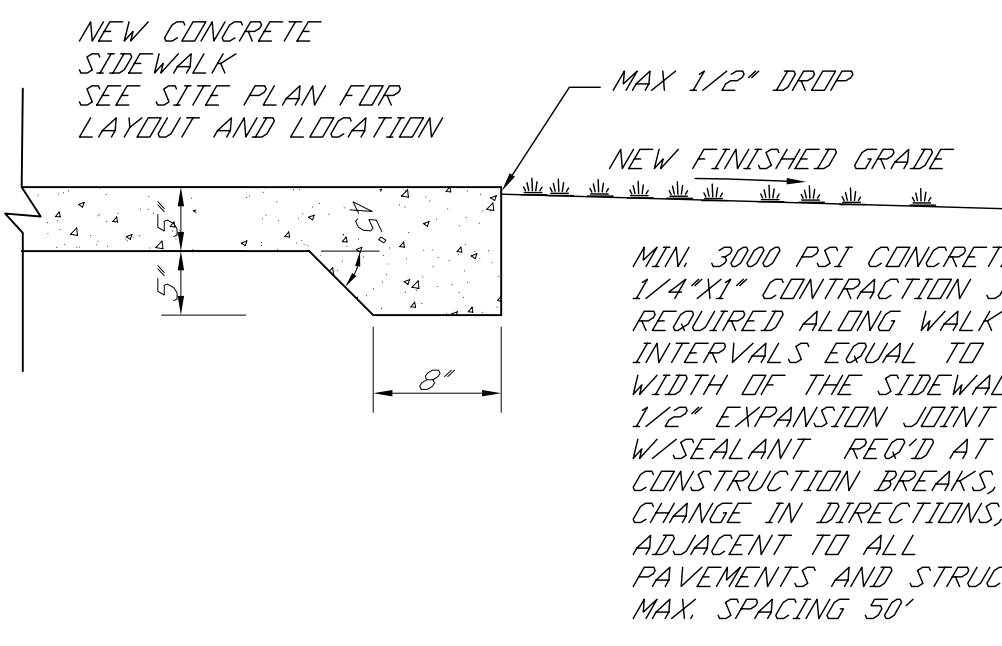

NEW CONCRETE SIDEWALK ADJACENT TO TURF

GENERAL SITE GRADING NOTES:

1. SITE SHALL BE GRADED TO LINES AND ELEVATIONS AS SHOWN, UNLESS OTHERWISE INDICATED. FINAL CONTOURS AND SPOT ELEVATIONS SHOWN ARE FINISHED GRADE ELEVATIONS. ELEVATIONS ALONG CURB LINE ARE SHOWN AT FLOW LINE/FACE OF CURB, UNLESS OTHERWISE INDICATED. DIMENSIONS ARE TO EDGE OF PAVEMENT, FACE OF CURB, FACE OF WALL AND/OR FACE OF BUILDING.
2. IT SHALL BE THE CONTRACTOR'S RESPONSIBILITY TO STAKEOUT THE CONSTRUCTION, ESTABLISH LINES AND GRADE, TEMPORARY BENCHMARKS, CENTERLINES AND REFERENCE POINTS FOR WORK AND VERIFY ALL DIMENSIONS RELATING TO INTERCONNECTION WITH EXISTING FEATURES. CONTRACTOR SHALL REPORT ANY INCONSISTENCIES IN THE PROPOSED GRADES, LINES AND DIMENSIONS TO THE ENGINEER BEFORE COMMENCING WORK.
3. A GEOTECHNICAL INVESTIGATION HAS BEEN PERFORMED ON THE SUBJECT PROPERTY BY ENGINEERING PLUS, INC. MERIDIAN, MS DATED SEPTEMBER 14, 2016. A COPY HAS BEEN INCLUDED IN THE CONTRACT DOCUMENTS. CONTRACTOR SHALL BE RESPONSIBLE FOR FAMILIARIZING HIMSELF WITH THE REQUIREMENTS AND CONDITIONS WITHIN THE REPORT.
4. STRIPPING AND UNDERCUTTING SHALL BE PERFORMED AS DESCRIBED IN THE GEOTECHNICAL REPORT. TOPSOIL TO BE REMOVED AT LEAST 12" BELOW EXISTING GRADE. CONTRACTOR SHALL NOTIFY GEOTECHNICAL ENGINEER TO OBSERVE EXCAVATION OPERATIONS AND ASSIST IN EVALUATING UNDERCUT REQUIREMENTS.
5. PAVEMENT AREA TO BE UNDERCUT SHALL BE REMOVED TO AT LEAST 2 FEET BELOW THE PAVEMENT FINISHED SUBGRADE ELEVATION.
6. IMPORTED FILL SOILS SHALL CONSIST OF SELECT, NONORGANIC AND DEBRIS-FREE SANDY IN NATURE SOILS WITH LESS THAN 25 PERCENT OF THE SOIL PARTICLES (BY WEIGHT) PASSING THE NO. 200 MESH SIEVE AND A LIQUID LIMIT OF LESS THAN 15.
7. BENEATH PAVEMENT AREAS: FILL MATERIAL SHALL BE PLACED IN MAX. 12 INCH LOOSE LIFTS AND COMPACTED TO NOT LESS THAN 95% OF STANDARD PROCTOR MAXIMUM DRY DENSITY (ASTM D 698). ALL FILL SHALL BE COMPACTED WITHIN ONE BELOW OF THREE PERCENTAGE POINTS ABOVE THE OPTIMUM MOISTURE CONTENT. FILL MATERIAL SHALL EXTEND LATERAL NOT LESS THAN 3' BEYOND PAVEMENT EDGES.
8. FILL OVER UTILITIES SHALL BE PLACED AND COMPACTED AS NOTED ABOVE EXCEPT LOOSE LIFTS THICKNESS SHALL BE NOT MORE THAN 4-5 INCHES WHEN HAND COMPACTORS ARE USED.
9. UNDERGROUND UTILITIES WERE LOCATED WHERE PHYSICAL EVIDENCE WAS AVAILABLE AND AS MARKED IN FIELD BY UTILITY REPRESENTATIVES. CONTRACTOR SHALL VERIFY DEPTH AND LOCATION OF EXISTING UTILITIES UPON EXCAVATION. CONTRACTOR SHALL NOTIFY PROJECT ENGINEER OF ANY DISCREPANCIES AND CONFLICTS FOUND UPON EXPOSURE OF EXISTING UTILITIES.
10. AREAS NOT INDICATED FOR OTHER SURFACE TREATMENT SHALL RECEIVE STRONGLY ROOTED SOD CONSISTING OF TIFWAY BERMUDA GRASS. SOD SHALL BE MACHINE CUT OF UNIFORM PAD SIZES; ANCHOR SOD ON SLOPES WITH WOOD STAKES TO PREVENT SLIPPAGE. BROKEN OR DAMAGED PADS WILL NOT BE ACCEPTED. REFER TO LANDSCAPE PLAN FOR ADDITIONAL REQUIREMENTS.

GENERAL NOTES:

- THE LOCATION OF ALL UTILITIES IS UNKNOWN. THE CONTRACTOR SHALL BE RESPONSIBLE FOR CONTACTING THE APPROPRIATE UTILITY COMPANIES TO DETERMINE THE EXACT LOCATION OF ALL UTILITIES AND UNDERGROUND STRUCTURES PRIOR TO THE COMMENCEMENT OF ANY CONSTRUCTION ACTIVITIES.
- 48 HOURS PRIOR TO STARTING ANY EXCAVATION, THE CONTRACTOR SHALL CALL MISSISSIPPI ONE CALL (811). THE CONTRACTOR SHALL ALSO ASSUME THE RESPONSIBILITY FOR ANY DAMAGE INCURRED BY ANY UTILITY COMPANY, TO THEIR LINES, DURING WORK ON THE PROJECT.
- CONTRACTOR SHALL VERIFY EXISTING SITE CONDITIONS AND NOTIFY ENGINEER OF ANY SIGNIFICANT DISCREPANCIES.
- CONTRACTOR SHALL COMPLY WITH ALL APPLICABLE LOCAL AND STATE REQUIREMENTS.



MINIMUM COVER BASED ON VEHICLE LOADING CONDITIONS		
PIPE DIAM.	H-25	HEAVY CONSTRUCTION (75T AXLE LOAD) *
12" - 48"	12"	48"
54" - 60"	24"	60"

Engineering Plus

Planning Surveying Testing • Landscape Design
1724-B 23rd Ave. Meridian, Mississippi 39301 (601) 693-4234

NO.	DATE	REVISION	DESCRIPTION	BY
1	10/17/17		MINOR REVISION	KHM

**GS#411-119 PARKING LOT IMPROVEMENTS AT
BRADLEY SANDERS BUILDING
GRADING AND STORM DRAINAGE PLAN**

FOR:


**EAST MISSISSIPPI STATE HOSPITAL
MERIDIAN, LAUDERDALE COUNTY, MS**

FB: P: DWG FILE: \\civl 3d Projects\\Private Projects\\2015\\15-133 E MS Sanders\\Coord\\Acad-15-133 Bradley Sanders Building Parking Lot.dwg JOB NO. 15-133 DRAWING NO. D-4399	DATE: 8/8/2016 DRAWN BY: KHM CHECKED BY: KHM SCALE: AS SHOWN	SHEET 3 OF 6
--	---	-----------------------

LEGEND:

EXISTING GROUND CONTOUR
PROPOSED FINISH GRADE CONTOUR

85
90

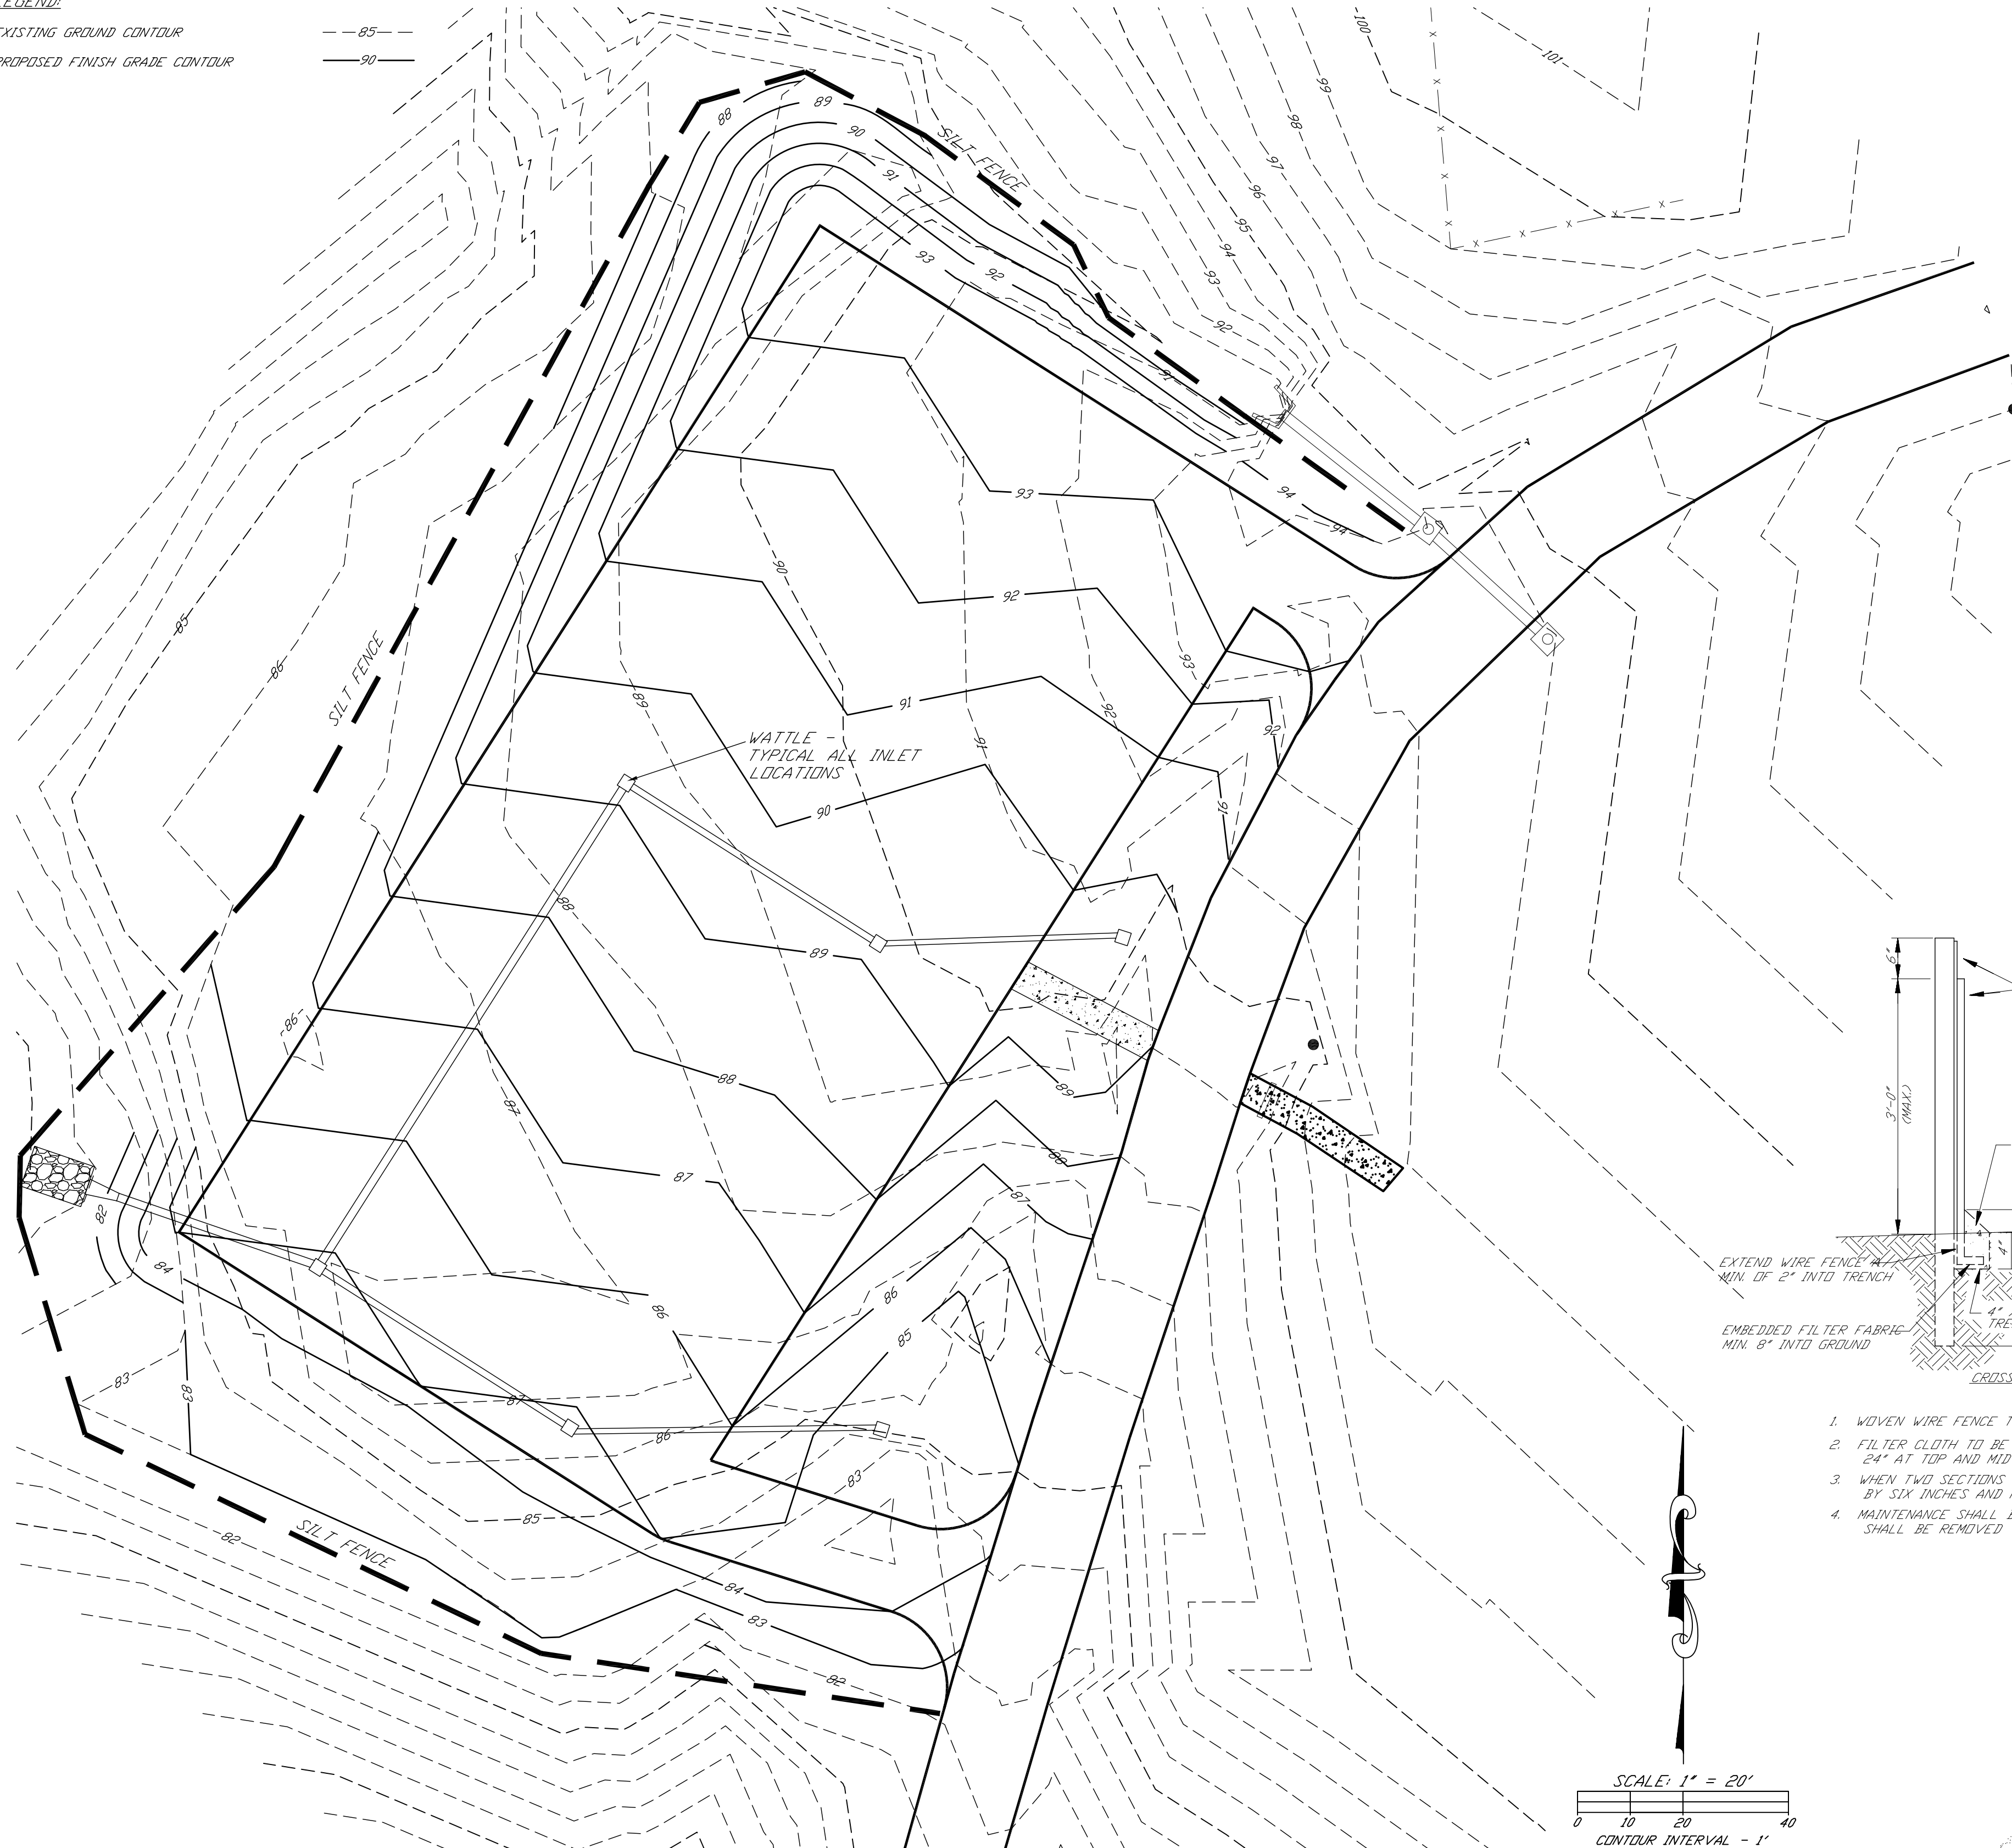

EROSION CONTROL PLAN
SCALE: 1" = 20'

LIST OF DEDUCTIVE ALTERNATES

- DELETE LIGHTING AND ASSOCIATED ELECTRICAL WORK AT PARKING LOT
- DELETE AUTOMOBILE WHEEL STOPS AT PARKING LOT.
- DELETE GRASSING BY SOD FROM SITE AND PROVIDE GRASSING BY SEEDING
- DELETE SITE STORM DRAINAGE SYSTEM - PROVIDE 100 L.F. 12" DIA. DRIVEWAY CULVERTS

Wattles:
1. Engineered composites of wood fibers and man-made fibers encased in heavy-duty mesh tubes. Min 6" diameter tubes.
2. Install per manufacturer's recommendations.
3. Contractor may provide other DEQ approved methods of inlet protection in lieu of wattles. Hay bales are not acceptable.

GENERAL EROSION CONTROL NOTES:

- CONTRACTOR SHALL IMPLEMENT BEST MANAGEMENT PRACTICES DESIGNED TO REMOVE SEDIMENT FROM STORM WATER AND PROTECT AGAINST EROSION IN ACCORDANCE WITH MISSISSIPPI DEPARTMENT OF ENVIRONMENTAL QUALITY LATEST REGULATIONS. BMP'S SHALL BE PLACED IN PHASES AS NEEDED TO ACCOMMODATE PROJECT SCHEDULING AND LAND DISTURBING ACTIVITIES.
PHASE I: BMP'S SHALL BE INSTALLED PRIOR TO COMMENCING ANY LAND DISTURBANCE ACTIVITIES. AS A MINIMUM THESE MEASURES SHALL INCLUDE SILT FENCE ALONG THE PERIMETER OF ALL AREAS SCHEDULED FOR DISTURBANCE; INSTALLATION OF SEDIMENT BASINS IN KEY DRAINAGE AREAS; CREATION OF DIVERSION DITCHES OR DIKES AS NEEDED AND PROTECTION OF DRAINAGE OUTLETS. CHECKS SHALL BE INSTALLED AS NEEDED TO PREVENT COLLECTION AND INCREASED VELOCITY OF WATER. SILT BASINS SHALL BE DE-SILED WHEN THEY REACH 50% OF THEIR CAPACITY.
PHASE II: AS PROJECT CLEARING AND GRADING OPERATIONS PROGRESS, CONTRACTOR SHALL INSTALL AND MAINTAIN ADDITIONAL TEMPORARY DEVICES SUCH AS CHECK DAMS, SILT FENCE, SLOPE PROTECTION, INLET PROTECTION AND OUTLET PROTECTION AS NEEDED. DISTURBED AREAS LEFT OVER 30 DAYS SHALL BE TEMPORARILY GRASSED. PERMANENT EROSION CONTROL SHALL BE ESTABLISHED AS SOON AS AN AREA BECOMES AVAILABLE.
PHASE III: AS FINAL GRADING IS ACHIEVED, PERMANENT EROSION CONTROL DEVICES SHALL BE PLACED INCLUDING GRASSING, LANDSCAPING, PAVED DITCHES, FLUMES AND OTHER MEASURES AS SHOWN ON PLANS.
- CONTRACTOR SHALL IMPLEMENT AND MAINTAIN BMP CONTROLS AS NEEDED TO PREVENT EROSION AND SEDIMENT FROM ADVERSELY AFFECTING DOWNSTREAM PROPERTY THROUGHOUT CONSTRUCTION OF PROJECT. WHEN WORK IS NOT BEING PERFORMED IN A DISTURBED AREA, CONTRACTOR SHALL INSTALL APPROPRIATE TEMPORARY AND/OR VEGETATIVE AND STRUCTURAL PRACTICES TO INSURE THAT EROSION AND SEDIMENT FROM CONSTRUCTION SITE DOES NOT FLOW ONTO ADJOINING PROPERTIES. ADDITIONAL CONTROLS SHALL MINIMIZE OFF-SITE VEHICLE TRACKING OF SEDIMENTS.
- CONTROLS AND MANAGEMENT PRACTICES USED TO MITIGATE ADVERSE IMPACTS FROM STORM WATER RUNOFF MAY INCLUDE BUT ARE NOT LIMITED TO, SILT FENCING, SEDIMENT TRAPS, WATTLES, INLET PROTECTION, INTERCEPTOR DIKES, SWALES AND OTHER PREFABRICATED DEVICES SPECIFICALLY DESIGNED FOR SEDIMENT CONTROL.
- CONTRACTOR SHALL BE RESPONSIBLE FOR ACQUIRING ANY NECESSARY PERMITS. THIS MAY INCLUDE STORM WATER RUNOFF PERMITS FROM THE MISSISSIPPI DEPARTMENT OF ENVIRONMENTAL QUALITY. CONTRACTOR SHALL BE RESPONSIBLE FOR ALL RECORD KEEPING AND DOCUMENTATION AS REQUIRED BY REGULATORY AGENCIES.
- ALL AREAS DISTURBED BY CONSTRUCTION AND NOT DESIGNATED FOR OTHER SURFACE TREATMENT SHALL RECEIVE SOLID SOD AS PERMANENT EROSION CONTROL. REFER TO LANDSCAPE PLAN FOR ADDITIONAL REQUIREMENTS.



GENERAL NOTES:

THE LOCATION OF ALL UTILITIES IS UNKNOWN. THE CONTRACTOR SHALL BE RESPONSIBLE FOR CONTACTING THE APPROPRIATE UTILITY COMPANIES TO DETERMINE THE EXACT LOCATION OF ALL UTILITIES AND UNDERGROUND STRUCTURES PRIOR TO THE COMMENCEMENT OF ANY CONSTRUCTION ACTIVITIES.

48 HOURS PRIOR TO STARTING ANY EXCAVATION, THE CONTRACTOR SHALL CALL MISSISSIPPI ONE CALL (811). THE CONTRACTOR SHALL ALSO ASSUME THE RESPONSIBILITY FOR ANY DAMAGE INCURRED BY ANY UTILITY COMPANY, TO THEIR LINES, DURING WORK ON THE PROJECT.


CONTRACTOR SHALL VERIFY EXISTING SITE CONDITIONS AND NOTIFY ENGINEER OF ANY SIGNIFICANT DISCREPANCIES.

CONTRACTOR SHALL COMPLY WITH ALL APPLICABLE LOCAL AND STATE REQUIREMENTS.

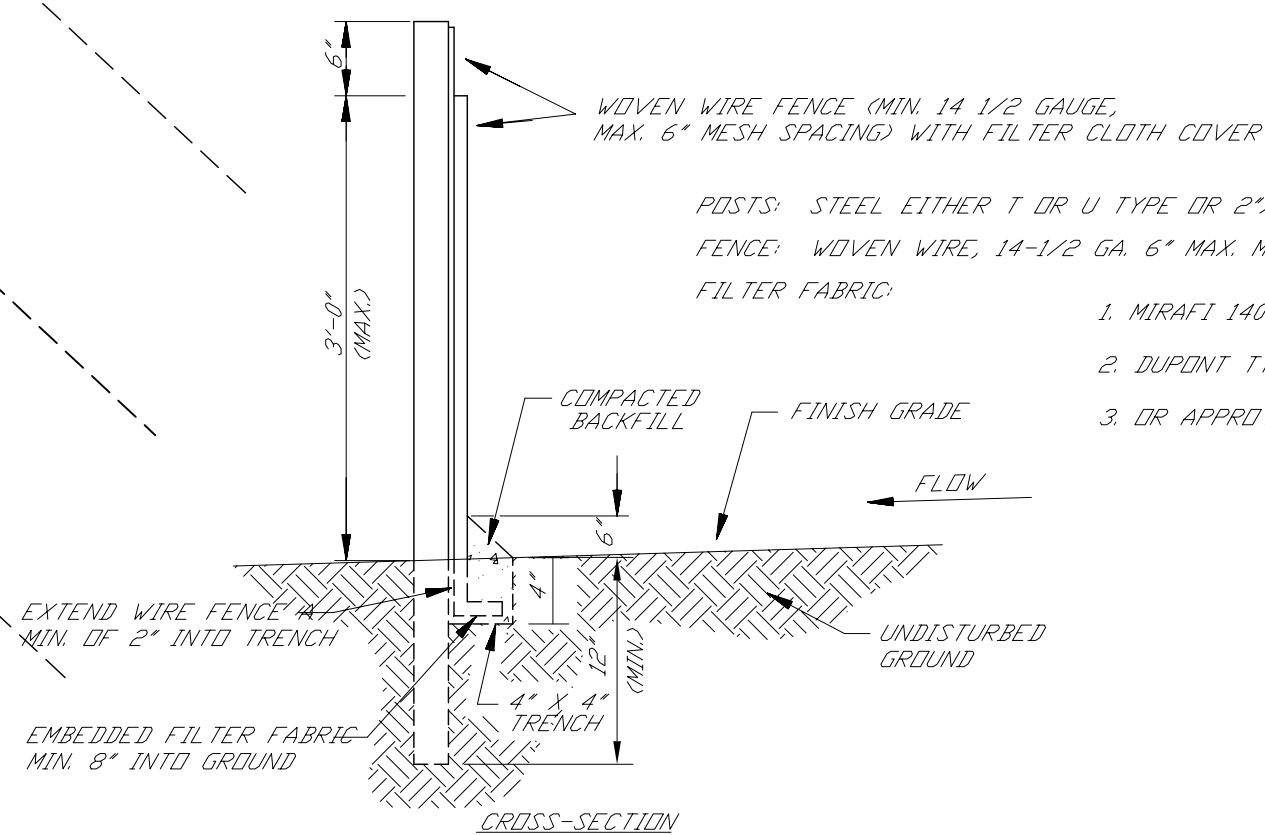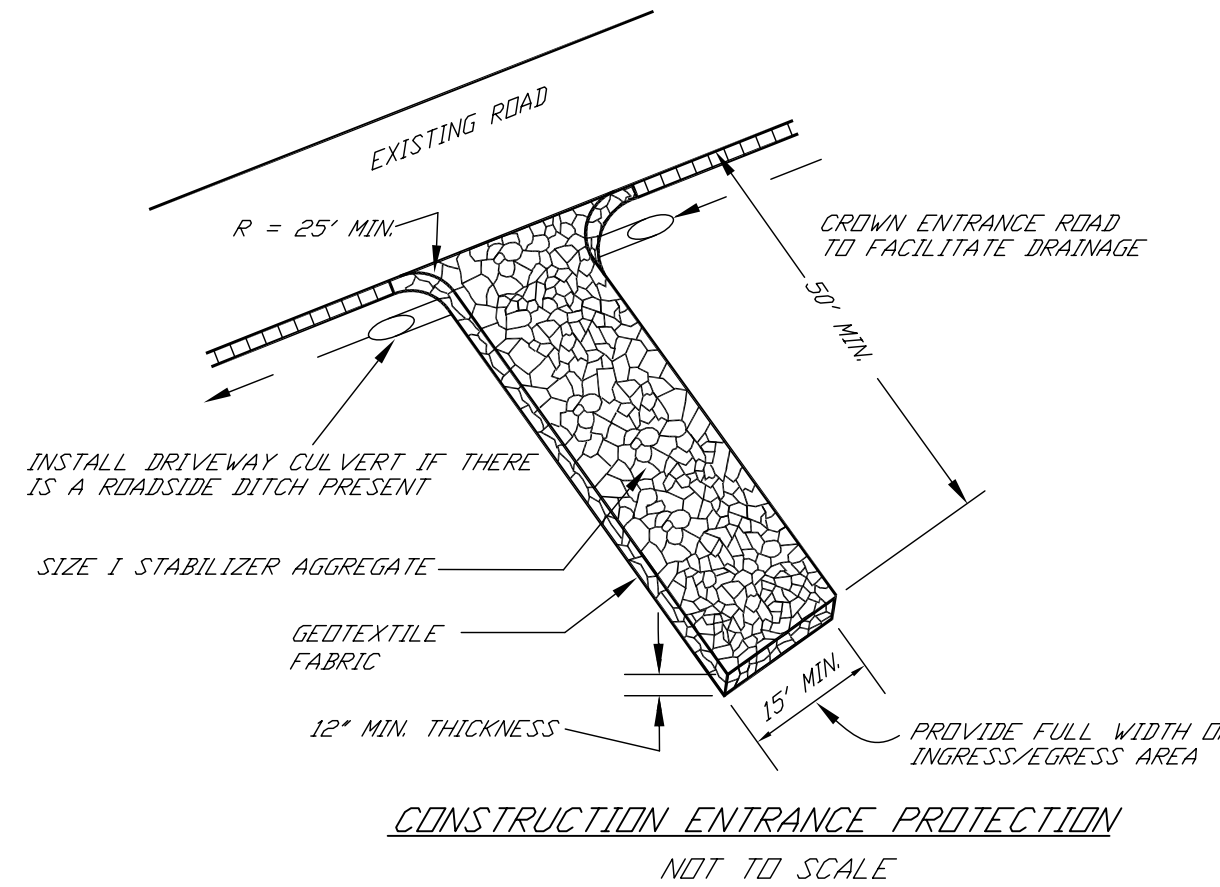

- WOVEN WIRE FENCE TO BE FASTENED SECURELY TO FENCE POSTS WITH WIRE TIES OR STAPLES.
- FILTER CLOTH TO BE FASTENED SECURELY TO WOVEN WIRE FENCE WITH TIES SPACED EVERY 24" AT TOP AND MID SECTION.
- WHEN TWO SECTIONS OF FILTER CLOTH ADJOIN EACH OTHER THEY SHALL BE OVERLAPPED BY SIX INCHES AND FOLDED.
- MAINTENANCE SHALL BE PERFORMED AS NOTED IN THE EROSION CONTROL PLAN. COLLECTED MATERIAL SHALL BE REMOVED WHEN "BULGES" DEVELOP IN THE SILT FENCE.

SEDIMENTATION/SILT FENCE
NOT TO SCALE

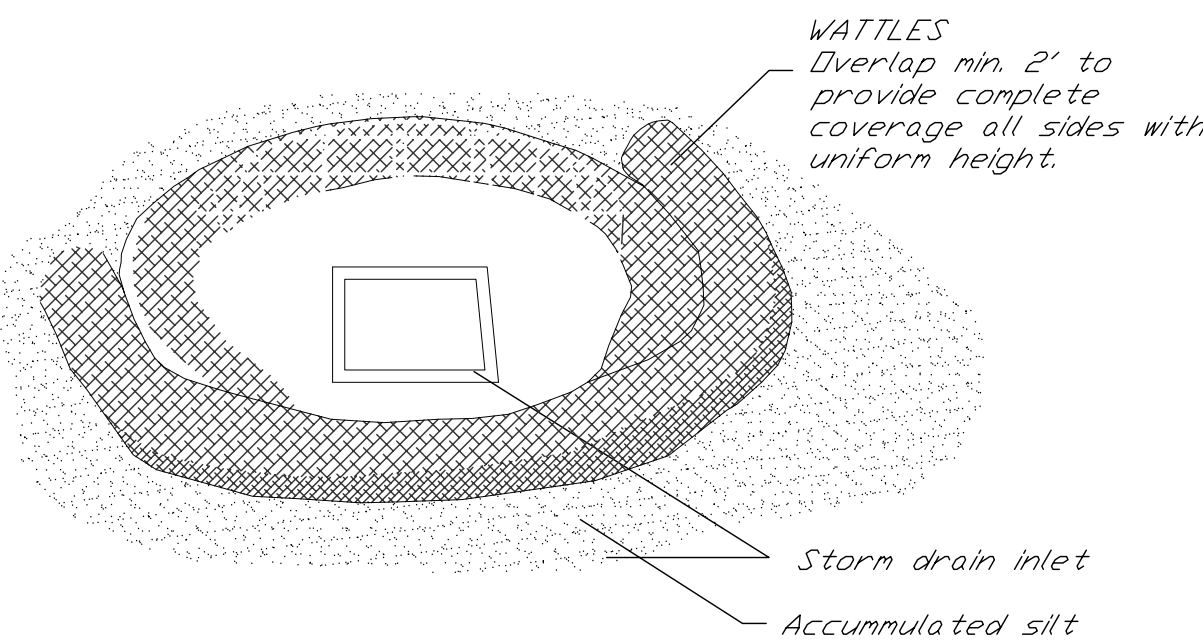

INLET PROTECTION - WATTLES

IN-LIEU OF STRAW WATTLES, CONTRACTOR MAY USED OTHER PRE-FABRICATED DEVICES DESIGNED SPECIFICALLY FOR SEDIMENT CONTROL AT INLETS



Engineering Plus

Planning • Surveying • Testing • Landscape Design
1724-B 23rd Ave. Meridian, Mississippi 39301 (601) 693-4234

NO.	DATE	REVISION	DESCRIPTION	BY
1	10/17/17		MINOR REVISION	KHM

GS#411-119 PARKING LOT IMPROVEMENTS AT
BRADLEY SANDERS BUILDING
EROSION CONTROL PLAN

FOR:

EAST MISSISSIPPI STATE HOSPITAL
MERIDIAN, LAUDERDALE COUNTY, MS

F.B.	P.	DATE: 8/8/2016	SHEET
DWG FILE: \Civil 3D Projects\Private Projects\2015\15-133 E MS Sanders\Coord\Acad-15-133 Bradley Sanders Building Parking Lot.dwg		DRAWN BY: KHM	4
JOB NO. 15-133		CHECKED BY: KHM	OF
DRAWING NO. D-4399		SCALE: AS SHOWN	6