October 16th, 2025

Project Name: PPSD CTE Renovations
Project Number: 25-009

REGISTERED ARCHITECT
JAMES RICHMON WIER, Jr.
4446
10/16/2025
STATE OF MISSISSIPPI

ADDENDUM NO. 3

NOTICE TO ALL DOCUMENT HOLDERS:

The following additions, deletions, changes and clarifications to the drawings and specifications are to be included as part of the Contract Documents.

DRAWINGS

ITEM NO. 01 **Sheet E200 | MECHANICAL PLAN**

REPLACE sheet E200: Mechanical Plan with the attached drawing

Clarification: Added additional fire alarm devices to the mechanical plan.

ITEM NO. 02 **Sheet E201 | MECHANICAL PLAN**

REPLACE sheet E201: Mechanical Plan with the attached drawing

Clarification: Added additional fire alarm devices to the mechanical plan.

Encl: E200 Mechanical Plan (24”x36”), E201 Mechanical Plan (24”x36”)

Cc: All document holders

THE POWER SOURCE PLLC
305 HIGHWAY 51
RIDGELAND, MS 39157
VOICE (601) 605-4820
FAX (601) 605-4875
TPS PROJ. # 25166

CHRISTOPHER A. GREEN
REGISTERED PROFESSIONAL ENGINEER
STATE OF MISSISSIPPI
16276
9/29/2025

WBA ARCHITECTURE

PPSD CTE RENOVATION

3603 US-80
PEARL, MS 39208

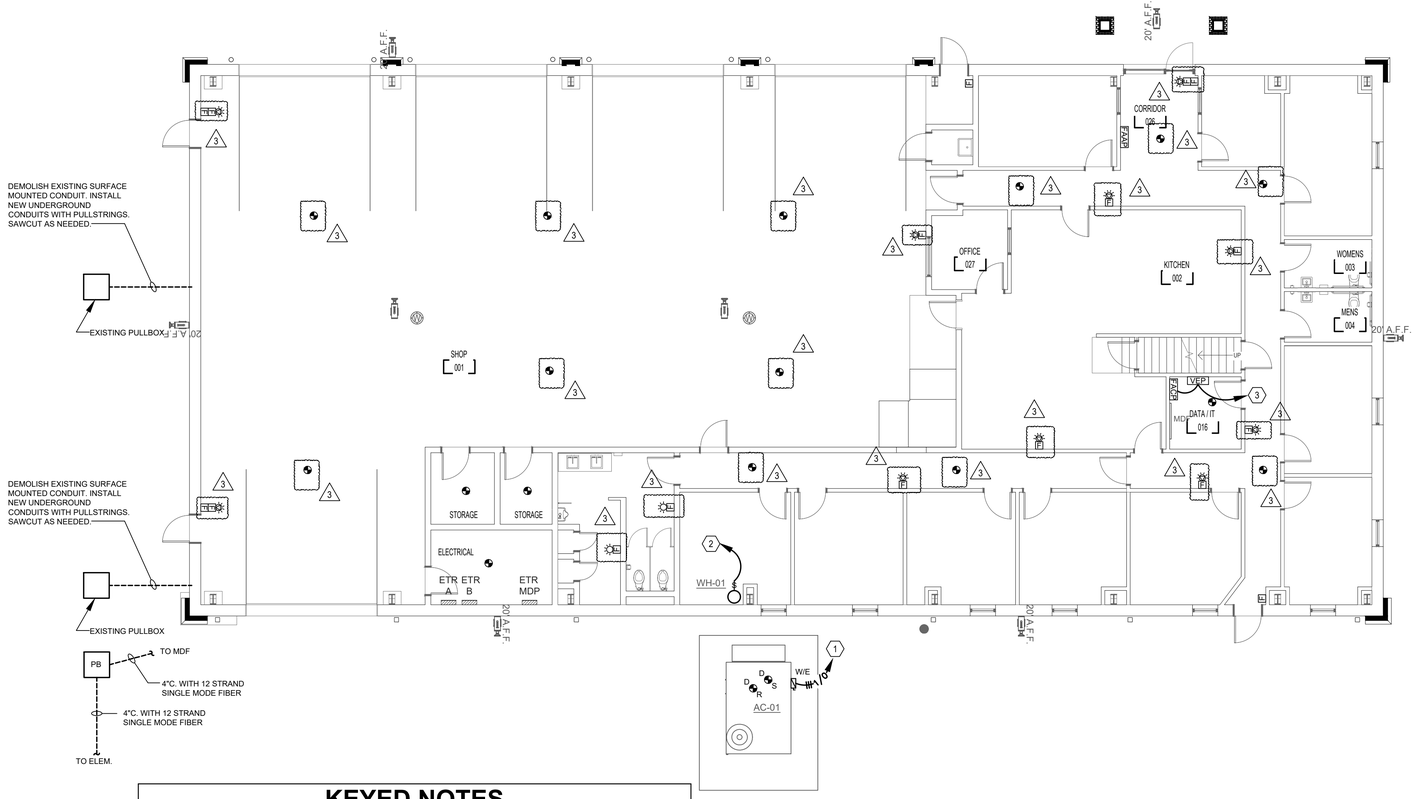

KEYED NOTES

Mark	Description
1	PROVIDE A NEW 150/3 BREAKER IN EXISTING PANEL "MDP".
2	PROVIDE A NEW 20/1 BREAKER IN EXISTING PANEL "B".
3	PROVIDE A NEW 20/1 BREAKER IN EXISTING PANEL "B". LABEL THE BREAKER WITH A RED LABEL READING FIRE ALARM PANEL.

1 / E200 MECHANICAL PLAN
Scale: 1/8" = 1'- 0"

9/29/2025
100% CONSTRUCTION DOCUMENTS
WBA # 25-009

REVISIONS

NO.	DESCRIPTION	DATE
1		2025-10-10
3	ADDENDUM #3	2025-10-16

E200

THE POWER SOURCE PLLC
305 HIGHWAY 51
RIDGELAND, MS 39157
VOICE (601) 605-4820
FAX (601) 605-4875
TPS PROJ. # 25166

CHRISTOPHER MICHAEL GREEN
REGISTERED PROFESSIONAL ENGINEER
9/29/2025
16776
STATE OF MISSISSIPPI

WBA ARCHITECTURE

PPSD CTE RENOVATION

3603 US-80
PEARL, MS 39208

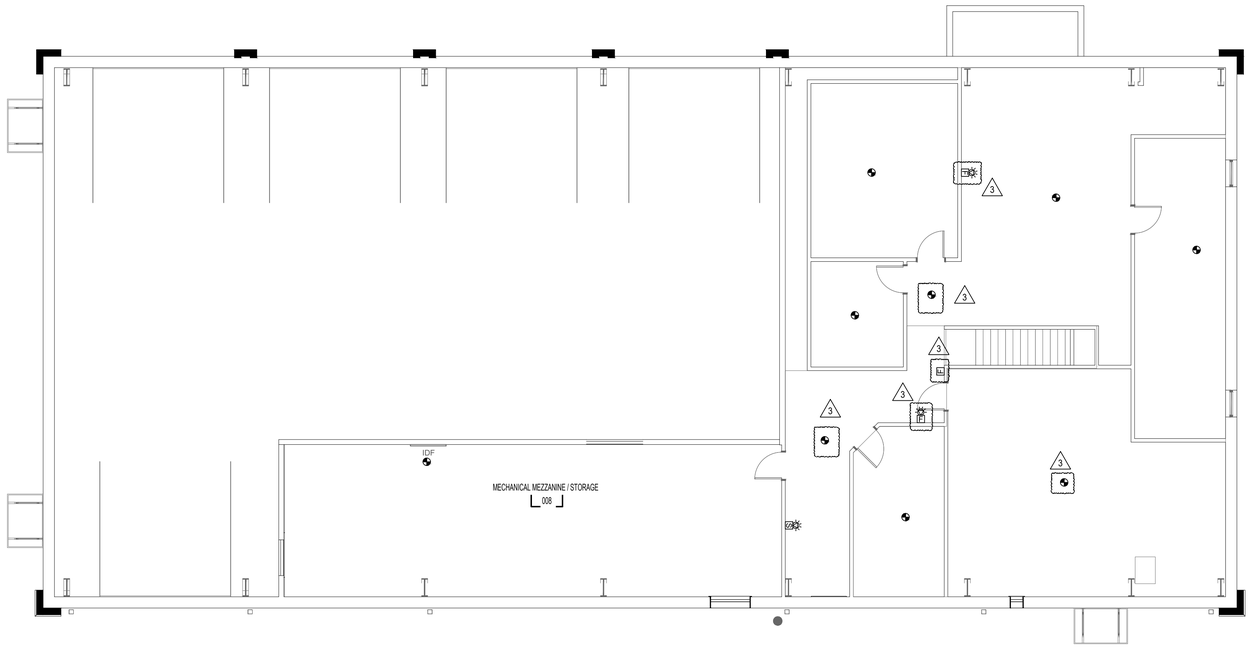

1 / E201 MECHANICAL PLAN - SECOND FLOOR
Scale: 1/8" = 1'-0"

9/29/2025
100% CONSTRUCTION DOCUMENTS
WBA # 25-009

REVISIONS

NO.	DESCRIPTION	DATE
1		2025-10-10
3	ADDENDUM #3	2025-10-16

E201